

ADDENDUM 3

ADDENDUM DATE: June 14, 2019

PROJECT: Trinity Middle School
Surrett Dr.
Trinity, NC 27370

OWNER: Randolph County School System
2222-c South Fayetteville St.
Asheboro, NC 27205

ARCHITECT: Smith Sinnett Architecture, P.A.
4600 Lake Boone Trail, Suite 205
Raleigh, North Carolina 27607

BIDS DUE: **Thursday, June 20th, 2019 at 2:00 p.m.**
Randolph County School System's Boardroom
2222-C S. Fayetteville St. Asheboro, NC 27205



Please note, Project Addendums and Bidders List are available at www.smithsinnett.com under the 'Documents' icon on the navigation bar.

This Addendum shall be included in the contract for the above referenced project. All General, Supplementary and Special Conditions, etc., as originally specified or as modified below shall apply to these items.

General

1. Refer to list of attachments on page 5.
2. Due to project schedule, the bid period will not be extended.
3. A Digital Data Release Form has been made available in the project documents tab on the website. Complete and return the form to obtain the site autocad file.
4. **Reminder: The period for questions and requests for substitutions has ended.**

Specifications

1. **General:** New Section added 32 32 23 Geogrid Interlocking Concrete Retaining Wall. See attachments. Refer also to note 5 in in the Drawing clarifications on page 3.
2. **Revision:** Section 00 01 10 Index – Add Section 32 32 23 Geogrid Interlocking Concrete Retaining Wall
3. **Revision:** Section 00 42 00 Proposal Forms – List of Alternates has been updated to include new alternate item L. See below.

4. **Revision:** Section 01 23 00 Alternates – Item B(Alternate 2) has been revised to specify Alerton as the only preferred HVAC Controls Manufacturer. Item L (Alternate 12; Owner Preferred Manufacturer(s) – Plumbing) has been added.
5. **Clarification:** Section 01 21 00 Allowances – Allowance A-16 Scoreboards – All electrical work associated with athletic scoreboards is to be included in the base contract.
6. **Clarification:** Section 01 21 00 Allowances – Allowance UP/A-6 has been increased to 4,000cy.
7. **Revision:** Section 09 68 31 Tile Carpeting - 2.1,D - Interface: Cubic “4287 – Shape” is to be the basis of design for CPT-1 and Interface:Cubic “4292 – Area” is to be the basis of design for CPT-2.
8. **Revision:** Section 04 20 00 Unit Masonry – Article 1.9 has been revised from the changes published in Addendum 2.
9. **Clarification:** Section 01 21 00 Allowances – Allowance A-17 – Dimensional lettering can be found on sheets A4-22 and 5-03.
10. **Clarification:** Section 12 35 53 Laboratory Casework – 2.2 E 2 – Square edge construction preferred.
11. **Clarification:** Section 12 35 53 Laboratory Casework – 2.2 E 11 b – Dovetail construction is acceptable.
12. **Clarification:** Section 12 35 53 Laboratory Casework – 2.2 E 11 e – Polycarbonate twin-pin shelf clips are acceptable.
13. **Clarification:** Section 09 30 00 Tiling - Refer to 2.4 for information regarding typical window sills.

Requests for Substitutions

1. 10 51 13 – Metal Lockers – Lockers Manufacturing is to be added to the list of equal manufacturers.
2. 09 65 66 - Resilient Athletic Flooring - Gerflor is to be added to the list of equal manufacturers.
3. 03 30 00 – Cast-in-Place Concrete - 2.7 - Textrude is to be added to the list of equal manufacturers.
4. 11 66 23 – Gymnasium Equipment – 2.2C- Progressive Sports Construction is to be added to the list of equal manufacturers.
5. 11 66 23 – Gymnasium Equipment – 2.3C- Progressive Sports Construction is to be added to the list of equal manufacturers.
6. 11 66 23 – Gymnasium Equipment – 2.4A- Progressive Sports Construction is to be added to the list of equal manufacturers.

7. 11 66 23 – Gymnasium Equipment – 2.4A- Sportsfield Specialties is to be added to the list of equal manufacturers.
8. 07 19 00 – Water Repellents – W.R. Meadows is to be added to the list of equal manufacturers.
9. 09 65 66 - Resilient Athletic Flooring – DynaCourt is to be added to the list of equal manufacturers.

Drawings

1. **New Sheet A7-03:** Includes details related to kitchen area and can wash.
2. **Revision:** Add A7-03 to sheet index.
3. **General Clarification:** All showers are to be tile floor and not pre-molded units. Please refer to new detail on revised sheet A4-02.
4. **General Clarification:** All coiling doors (counter and otherwise) which occur in rated walls shall be tied to the fire alarm.
5. **General Clarification:** All retaining walls except for the wall north of the baseball field(segmental) are to be cast-in-place.
6. **General Clarification:** Where drawings make reference to ground face concrete masonry(GFCMU), polished face is intended. Refer to specification.
7. **Revision:** Sheet G0-03 –UL Detail U467 has been deleted. Shaft liner is not required on this project. U906 has been deleted – refer to U905.
8. **Revision:** Sheets A1-01 – A1-02 – new wall types I and O have been added to the schedule on A1-02 for smoke partitions at classrooms. Partition tags updated on plans.
9. **Revision:** Sheets A1-03 – A1-09
 - Science room walls are now shown to indicate smoke partitions. Refer to revised door schedule.
 - Furring has been added to 2hr fire walls in the locations shown.

134 south wall	216 west wall
133 south and east walls	213 east wall
135 east wall	616 west wall
310 east wall	621 west and north
312 west wall	512 west wall
309 east wall	510 east wall
311 west wall	511 east wall
414 west wall	413 east wall
10. **Revision:** Sheet A7-07 – Floor finish in rooms 621 and 622 should be PC-1. To clarify, restrooms 608 and 609 are to receive tile/pattern MT-A although hatch is not showing.

11. **Revision:** Sheet A6-01 – The Hardware Sets column of the door schedule have been revised. Remarks have been updated. Various updates made to door panel and frame type references.
12. **Clarification:** General – Note that Item 18 of the General Equipment Schedule, wood shelving, is to be owner furnished.
13. **Revision:** Sheet 4-01 – Detail 3, note that a shower seat has been added in restroom 210. Accessory legend has been updated with shower seat information.
14. **Revision:** Sheet 4-02 – Detail 1, note that a shower seat has been added in toilet room 637 and that the shower wall has been modified to achieve a 3'x3' accessible shower. Accessory legend has been updated with shower seat information. New detail 11 has been added for typical shower threshold.
15. **Revision:** Sheet A9-01 – Information added to details 1 and 2. Refer to A4-01 for restroom accessory schedule.
16. **Revision:** Sheet A9-02 – Door schedule has been updated. A note has been added to Detail 13 regarding sectional door installation.
17. **Clarification:** Sheet A1-08 – Casework in room 518 Exploratory is to be solid wood.
18. **Revision:** Sheet A3-13 – Monumental sign detail has been modified with further notation. The monumental sign is included in the Base Bid.
19. **Revision/Clarification:** Sheet A6-02 – Door legend revised. Regarding note Glazing Note 8 – Blinds and shades requirements are listed at the bottom of the frame elevation, next to the title mark.
20. **General Clarification:** Sheet S3-24 – Detail 1 - Disregard level marker for Field House. This detail applies to the canopies at the school's main entrances.
21. **Revision:** Sheet A1-23 - Revision made to ceiling in clouded area.

End of Addendum 3

Attached:
Specifications:

00 42 00
01 21 00
01 23 00
04 20 00
09 68 31
32 32 23

Architectural:

A1-01
A1-02
A1-03
A1-04
A1-05
A1-06
A1-07
A1-08
A1-09
A1-23
A3-13
A4-01
A4-02
A6-01
A6-02
A7-07
A7-30
A9-01
A9-02

Civil: 2 pages, 6 sheets

Offsite Civil: 2 pages, 11 sheets

Structural: 1 page, 2 sheets

Plumbing: 2 pages, 7 sheets

Mechanical: 41 pages, 2 sheets

Electrical: 11 pages, 15 sheets

Food Service: 7 sheets

SECTION 00 42 00 - PROPOSAL FORM

PROJECT: Trinity Middle School
New Construction
PIN# 7708118367, Surrett Drive
Trinity, North Carolina 27370

OWNER: Randolph County School Board
2222-C S. Fayetteville Street
Asheboro, North Carolina 27205

ARCHITECT: Smith Sinnett Architecture
4600 Lake Boone Trail, Suite 205
Raleigh, North Carolina 27607

The undersigned, as bidder, hereby declares that the only person or persons interested in this proposal as principal or principals is or are named herein and that no other person than herein mentioned has any interest in this proposal or in the contract to be entered into; that this proposal is made without connection with any other person, company or parties making a bid or proposal; and that it is in all respects fair and in good faith without collusion or fraud. The bidder further declares that he has examined the site of the work and the contract documents relative thereto, and has read all special provisions furnished prior to the opening of bids; that he has satisfied himself relative to the work to be performed.

The Bidder proposes and agrees if this proposal is accepted to contract with Randolph County Board of Education in the form of contract specified below, to furnish all necessary materials, equipment, machinery, tools, apparatus, means of transportation and labor necessary to complete the construction of

Trinity Middle School – New Construction

in full in complete accordance with the plans, specifications and contract documents, to the full and entire satisfaction of the Randolph County Board of Education, and Smith Sinnett Architecture with a definite understanding that no money will be allowed for extra work except as set forth in the General Conditions and the contract documents.

The low Bidder will be determined by the total cost of the Contract with the lump sum prices of the alternates accepted being added to or deducted from the Base Bid to give the total cost of the Contract. Bidders are required to give a price for Base Bid, all Alternates, and all Unit Prices as applicable to their Contract. All Bidders are required to be licensed and in good standing with their respective North Carolina Licensing Board.

SINGLE PRIME CONTRACT:

BASE BID:

Amount: _____ Dollars (\$ _____)

ALTERNATE 1: Owner Preferred Manufacturer(s) – Door Hardware

Amount: _____ Dollars (\$ _____)

ALTERNATE 2: Owner Preferred Manufacturer(s) – HVAC

Amount: _____ Dollars (\$ _____)

ALTERNATE 3: Owner Preferred Manufacturer(s) – Electrical

Amount: _____ Dollars (\$ _____)

ALTERNATE 4: Terrazzo Flooring

Amount: _____ Dollars (\$ _____)

ALTERNATE 5: Spray-Applied Cavity Wall Insulation

Amount: _____ Dollars (\$ _____)

ALTERNATE 6: Concession Upfit

Amount: _____ Dollars (\$ _____)

ALTERNATE 7: Single Ply Roofing

Amount: _____ Dollars (\$ _____)

ALTERNATE 8: Additional Gymnasium Bleachers

Amount: _____ Dollars (\$ _____)

ALTERNATE 9: Maintenance Building

Amount: _____ Dollars (\$ _____)

ALTERNATE 10: Offsite Work

Amount: _____ Dollars (\$ _____)

ALTERNATE 11: Owner Preferred Manufacturer(s) – Kitchen Equipment

Amount: _____ Dollars (\$ _____)

ALTERNATE 12: Owner Preferred Manufacturer(s) – Plumbing

Amount: _____ Dollars (\$ _____)

MAJOR SUBCONTRACTORS if any (Name, City & State)

General Subcontractor:

_____ Lic _____

Plumbing Subcontractor:

_____ Lic _____

Mechanical Subcontractor:

_____ Lic _____

Electrical Subcontractor:

_____ Lic _____

GS143-128(d) requires all single prime bidders to identify their subcontractors for the above subdivisions of work. A contractor whose bid is accepted shall not substitute any person as subcontractor in the place of the subcontractor listed in the original bid, except (i) if the listed subcontractor's bid is later determined by the contractor to be non-responsible or non-responsive or the listed subcontractor refuses to enter into a contract for the complete performance of the bid work, or (ii) with the approval of the awarding authority for good cause shown by the contractor.

ALLOWANCES - (Refer to Division 01 Section 01 21 00 – Allowances for amounts to be included in bid shall be based on the Unit Prices provided as part of Section 01 22 00) Acknowledge Allowances have been included with in the Base Bid.

UP/A-1 _____ UP/A-2 _____ UP/A-3 _____ UP/A-4 _____ UP/A-5 _____

UP/A-6 _____ UP/A-7 _____ UP/A-8 _____ UP/A-9 _____ UP/A-10 _____

UP/A-11 _____ UP/A-12 _____ UP/A-13 _____ UP/A-14 _____ UP/A-15 _____

A-16 _____ A-17 _____ A-18 _____ A-19 _____ A-20 _____

UNIT PRICES - (Refer to Division 01 Section 01 22 00 - Unit Prices for Quantities)

Unit prices quoted and accepted shall apply throughout the life of the contract, except as otherwise specifically noted. Unit prices shall be applied, as appropriate, to compute the total value of changes in the base bid quantity of the work and in the given Allowances all in accordance with the contract documents.

Unit Price UP/A-1; Mass Rock removal and disposal off-site: per cy. Unit Price (\$)_____

Unit Price UP/A-2; Mass Rock removal and disposal on-site: per cy. Unit Price (\$)_____

Unit Price UP/A-3; Trench Rock removal and disposal off-site: per cy. Unit Price (\$)_____

Unit Price UP/A-4; Trench Rock removal and disposal on-site: per cy. Unit Price (\$)_____

Unit Price UP/A-5; Mass Rock Removal, Processed and placed on site: per cy. Unit Price (\$)_____

Unit Price UP/A-6; Unsuitable Soils Removal and Disposal off-site: per cy. Unit Price (\$)_____

Unit Price UP/A-7; Unsuitable Soils Removal and Disposal on-site: per cy. Unit Price (\$)_____

Unit Price UP/A-8; Replacement of Unsuitable Soils/Rock with on-site suitable soils: per cy. Unit Price (\$)_____

Unit Price UP/A-9; Replacement of Unsuitable Soils/Rock with off-site imported fills: per cy. Unit Price (\$)_____

Unit Price UP/A-10; Replacement of Authorized Excavation of Unsuitable Soils/Rock with (ABC) Stone Material: per cy. Unit Price (\$)_____

Unit Price UP/A-11; Replacement of Excavation of Unsuitable Soils/Rock with #57 Washed Stone Material: per cy. Unit Price (\$)_____

Unit Price UP/A-12; Geo-Grid in Place: per square yard. Unit Price (\$)_____

Unit Price UP/A-13; Woven Geotextile Fabric: per square yard. Unit Price (\$)_____

Unit Price UP/A-14; Replacement of Unsuitable Soils/Rock with lean concrete fill in place: per cy. Unit Price (\$)_____

Unit Price UP/A-15; High Capacity French Drain: per linear foot. Unit Price (\$)_____

The bidder further proposes and agrees hereby to commence work under this contract on a date to be specified in a written order of the designer and shall fully complete all work thereunder within the time specified in the Supplementary General Conditions Article 9. Applicable liquidated damages amount is also stated in the Supplementary General Conditions Article 9.

ADDENDUM

(Addendum received and used in computing bid)

Addendum No. 1 _____ Addendum No. 3 _____ Addendum No. 5 _____

Addendum No. 2 _____ Addendum No. 4 _____ Addendum No. 6 _____

Proposal Signature Page

The undersigned further agrees that in the case of failure on his part to execute the said contract and the bonds within ten (10) consecutive calendar days after being given written notice of the award of contract, the certified check, cash or bid bond accompanying this bid shall be paid into the funds of the owner's account set aside for the project, as liquidated damages for such failure; otherwise the certified check, cash or bid bond accompanying this proposal shall be returned to the undersigned. No proposal may be withdrawn after the scheduled closing time for the receipt of Bids for a period of ninety (90) days.

Respectfully submitted this day of _____

(Name of firm or corporation making bid)

WITNESS:

(Proprietorship or Partnership)

By: _____
Signature

Name: _____
Print or type

Title: _____
(Owner/Partner/Pres./V.Pres)

Address: _____

ATTEST:

By: _____

Title: _____
(Corp. Sec. or Asst. Sec. only)

License No. _____

Federal I.D. No. _____

(CORPORATE SEAL)

MINORITY BUSINESS PARTICIPATION REQUIREMENTS

Provide with the bid - Under GS 143-128.2(c) the undersigned bidder shall identify **on its bid** (Identification of Minority Business Participation Form) the minority businesses that it will use on the project with the total dollar value of the bids that will be performed by the minority businesses. **Also** list the good faith efforts (Affidavit **A**) made to solicit minority participation in the bid effort.

NOTE: A contractor that performs all of the work with its own workforce may submit an Affidavit (**B**) to that effect in lieu of Affidavit (**A**) required above. The MB Participation Form must still be submitted even if there is zero participation.

After the bid opening - The Owner will consider all bids and alternates and determine the lowest responsible, responsive bidder. Upon notification of being the apparent low bidder, the bidder shall then file within 72 hours of the notification of being the apparent lowest bidder, the following:

An Affidavit (**C**) that includes a description of the portion of work to be executed by minority businesses, expressed as a percentage of the total contract price, which is equal to or more than the 10% goal established. This affidavit shall give rise to the presumption that the bidder has made the required good faith effort and Affidavit **D** is not necessary;

*** OR ***

If less than the 10% goal, Affidavit (**D**) of its good faith effort to meet the goal shall be provided. The document must include evidence of all good faith efforts that were implemented, including any advertisements, solicitations and other specific actions demonstrating recruitment and selection of minority businesses for participation in the contract.

Note: Bidders must always submit **with their bid** the Identification of Minority Business Participation Form listing all MB contractors, vendors and suppliers that will be used. If there is no MB participation, then enter none or zero on the form. Affidavit A **or** Affidavit B, as applicable, also must be submitted with the bid. Failure to file a required affidavit or documentation with the bid or after being notified apparent low bidder is grounds for rejection of the bid.

END OF SECTION 00 42 00

SECTION 01 21 00 - ALLOWANCES

PART 1 - GENERAL

1.1 RELATED DOCUMENTS

- A. Drawings and general provisions of the Contract, including General and Supplementary Conditions and other Division 01 Specification Sections, apply to this Section.

1.2 SUMMARY

- A. This Section includes administrative and procedural requirements governing allowances.
 - 1. Certain items are specified in the Contract Documents by allowances. Allowances have been established in lieu of additional requirements and to defer selection of actual materials and equipment to a later date when additional information is available for evaluation. If necessary, additional requirements will be issued by Change Order.
 - 2. The Contractor shall include in the Contract Sum all allowances states in the Contract Documents. The Contractor's costs for unloading and handling at the site, labor, installation costs, overhead, profit and other expenses contemplated for the original allowance shall be included in the Contract Sum and not in the allowance, unless indicated otherwise herein. Coordinate allowance work with related work to ensure that each selection in completely integrated and interfaced with related work. Include all allowance amounts as a separate line item amount on each application for payment.
- B. Types of allowances include the following:
 - 1. Unit-cost allowances.
 - 2. Quantity allowances.
 - 3. Contingency Allowances.
- C. Related Sections include the following:
 - 1. Division 01 Section "Contract Modification Procedures" for procedures for submitting and handling Change Orders for allowances.
 - 2. Division 01 Section "Unit Prices" for procedures for using unit prices as bases to establish allowance value.
 - 3. Divisions 02 through 49 Sections for items of Work covered by allowances.
 - 4. Division 31 Section "Earth Moving for Sites" and "Earth Moving for Building" for procedures for measurements and payment for Unsuitable Soil Replacement.

1.3 SELECTION AND PURCHASE

- A. At the earliest practical date after award of the Contract, advise the Architect of the date when final selection and purchase of each product or system described by an allowance must be completed to avoid delaying the Work.
- B. At Architect's request, obtain proposals for each allowance for use in making final selections. Include recommendations that are relevant to performing the Work. **Provide a minimum of three (3) proposals for each allowance** for use in making final selections, unless instructed otherwise by the Architect. Furnish proposals in time so as not to delay the project. Include recommendations that are relevant to performing the Work.

- C. Purchase products and systems selected by Architect from the designated supplier.

1.4 SUBMITTALS

- A. Submit proposals for purchase of products or systems included in allowances, in the form specified for Change Orders.
- B. Submit invoices or delivery slips to show actual quantities of materials delivered to the site for use in fulfillment of each allowance.
- C. Coordinate and process submittals for allowance items in same manner as for other portions of the Work.

1.5 COORDINATION

- A. Coordinate allowance items with other portions of the Work. Furnish templates as required to coordinate installation.

1.6 ALLOWANCES

- A. Refer to Schedule of Allowances for Amounts and Quantities
- B. Quantity & Lump Sum Allowances
 - 1. Allowance shall include cost to Contractor of specific products and materials ordered by Owner under allowance and shall include taxes, freight, and delivery to Project site.
 - 2. Contractor's costs for receiving and handling at Project site, labor, installation, overhead and profit, and similar costs related to products and materials ordered by Owner under allowance shall be included as part of the Contract Sum and not part of the allowance.
- C. Unit-Cost Allowances
 - 1. Each change order amount for unit-cost type allowances shall be based solely on the difference between the actual unit purchase amount and the unit allowance, multiplied by the final measure or count of work-in-place, with reasonable allowances, where applicable, for cutting losses, tolerances, mixing wastes, normal product imperfections and similar margins.
 - 2. Include installation costs in the purchase amount only where indicated as a part of the allowance. When requested, prepare explanations and documentation to substantiate the margins as claimed. Prepare and submit substantiation of a change in the scope of work (if any) claimed in the change orders related to unit-cost type allowances. The Owner reserves the right to establish the actual quantity of work- in-place by an independent quantity survey, measure or count.
 - 3. Unit-Cost Allowances shall be based on the Unit Price value established.
- D. Contingency Allowances
 - 1. Use the contingency allowance only as directed by Architect for Owner's purposes and only by Change Orders that indicate amounts to be charged to the allowance.
 - 2. Contractor's related costs for products and equipment ordered by Owner under the contingency allowance are included in the allowance and are not part of the Contract Sum. These costs include delivery, installation, taxes, insurance, equipment rental, and similar costs.
 - 3. Allowances for overhead and profit shall be provided within the contract price and not included as part of any change order till the allowance amount has been spent.

1.7 CHANGE ORDER MARK-UP

- A. Except as otherwise indicated, comply with provisions of General Conditions and other requirements stated in this section. For each allowance, Contractor's claims for increased costs (for either purchase order amount or Contractor's handling, labor, installation, overhead, and profit), because of a change in scope or nature of the allowance work as described in contract documents, must be submitted within 60 days of initial change order authorizing work to proceed on that allowance; otherwise, such claims will be rejected.
- B. As a procedural restriction no mark-up (increase or decrease) shall be included in the change order amount for Contractor's increase or decrease in handling, labor, installation, overhead or profit unless purchase order amount varies by more than 15% from allowance amount.
- C. Change orders prepared to return unused allowance amounts to the Owner shall be subject to the same requirements for the return of appropriate profit and overhead as other change orders in accordance with the Conditions of the Contract. Where the Contractor has been directed not to include his related costs (profit and overhead) in the Contract Sum for contingency allowances, the return of profit and overhead shall not be excepted.

1.8 UNUSED MATERIALS

- A. Return unused materials purchased under an allowance to manufacturer or supplier for credit to Owner, after installation has been completed and accepted.
 - 1. If requested by Architect, prepare unused material for storage by Owner when it is not economically practical to return the material for credit. If directed by Architect, deliver unused material to Owner's storage space. Otherwise, disposal of unused material is Contractor's responsibility.

PART 2 - PRODUCTS (Not Used)

PART 3 - EXECUTION

3.1 EXAMINATION

- A. Examine products covered by an allowance promptly on delivery for damage or defects. Return damaged or defective products to manufacturer for replacement.

3.2 PREPARATION

- A. Coordinate materials and their installation for each allowance with related materials and installations to ensure that each allowance item is completely integrated and interfaced with related work.

3.3 SCHEDULE OF ALLOWANCES

- A. **Allowance UP/A-1:** Mass Rock removal and disposal off-site.
1. Purpose: To adjust the contract sum in case a quantity different from that indicated in the allowance is required.
 2. Unit of measurement: cubic yard measured before removal.
 3. Include the following in the unit price:
 - a. Excavation, loading, transport, and legal disposal of all materials.
 - b. All disposal fees.
 - c. Overhead and profit.
 4. Include all other related costs in the contract sum.
 5. Method of measurement: Quantities will be verified by a soils and materials engineer employed by the Owner.
 6. Quantity Allowance: Coordinate unit price with allowance adjustment requirements of Division 01 Section "Allowances."
 7. Allowance: 5,000-CY.
- B. **Allowance UP/A-2:** Mass Rock removal and disposal on-site.
1. Purpose: To adjust the contract sum in case a quantity different from that indicated in the allowance is required.
 2. Unit of measurement: cubic yard measured before removal.
 3. Include the following in the unit price:
 - a. Excavation, loading and transport of all materials.
 - b. Placement and compaction of materials in on-site disposal or fill area.
 - c. Overhead and profit.
 4. Include all other related costs in the contract sum.
 5. Method of measurement: Quantities will be verified by a soils and materials engineer employed by the Owner.
 6. Quantity Allowance: Coordinate unit price with allowance adjustment requirements of Division 01 Section "Allowances."
 7. Allowance: 5,000-CY.
- C. **Allowance UP/A-3:** Trench Rock removal and disposal off-site.
1. Purpose: To adjust the contract sum in case a quantity different from that indicated in the allowance is required.
 2. Unit of measurement: cubic yard measured before removal.
 3. Include the following in the unit price:
 - a. Excavation, loading, transport, and legal disposal of all materials.
 - b. All disposal fees.
 - c. Overhead and profit.
 4. Include all other related costs in the contract sum.
 5. Method of measurement: Quantities will be verified by a soils and materials engineer employed by the Owner.
 6. Quantity Allowance: Coordinate unit price with allowance adjustment requirements of Division 01 Section "Allowances."
 7. Allowance: 1000-CY.

- D. **Allowance UP/A-4:** Trench Rock removal and disposal on-site.
1. Purpose: To adjust the contract sum in case a quantity different from that indicated in the allowance is required.
 2. Unit of measurement: cubic yard measured before removal.
 3. Include the following in the unit price:
 - a. Excavation, loading and transport of all materials.
 - b. Placement and compaction of materials in on-site disposal or fill area.
 - c. Overhead and profit.
 4. Include all other related costs in the contract sum.
 5. Method of measurement: Quantities will be verified by a soils and materials engineer employed by the Owner.
 6. Quantity Allowance: Coordinate unit price with allowance adjustment requirements of Division 01 Section "Allowances."
 7. Allowance: 1000-CY.
- E. **Allowance UP/A-5:** Mass Rock Removal, processing to specified particle size and placement in on-site fill areas.
1. Purpose: To adjust the contract sum in case a quantity different from that indicated in the allowance is required.
 2. Unit of measurement: cubic yard measured before removal.
 3. Include the following in the unit price:
 - a. Excavation, loading and transport of all materials.
 - b. Processing of all rock material down to a particle size of no greater than 3-inches.
 - c. Placement and compaction of materials in on-site fill area.
 - d. Overhead and profit.
 4. Include all other related costs in the contract sum.
 5. Method of measurement: Quantities will be verified by a soils and materials engineer employed by the Owner.
 6. Quantity Allowance: Coordinate unit price with allowance adjustment requirements of Division 01 Section "Allowances."
 7. Allowance: 5,000-CY.
- F. **Allowance UP/A-6:** Unsuitable soils removal and disposal off-site.
1. Purpose: To adjust the contract sum in case a quantity different from that indicated in the allowance is required.
 2. Unit of measurement: cubic yard in place prior to excavation.
 3. Include the following in the unit price:
 - a. Excavation, loading, transport and disposal of all materials.
 - b. Overhead and profit.
 - c. Allowance shall be based on the unit price quoted in the Proposal.
 4. Include all other related costs in the contract sum.
 5. Method of measurement: Quantities will be verified by a soils and materials engineer employed by the Owner.
 6. Allowance Quantity: 4,000-CY.
- G. **Allowance UP/A-7:** Unsuitable soils removal and disposal on-site.
1. Purpose: To adjust the contract sum in case a quantity different from that indicated in the allowance is required.
 2. Unit of measurement: cubic yard in place prior to excavation.
 3. Include the following in the unit price:
 - a. Excavation, loading, transport, placement and compaction of all materials to a location to be determined on the school tract.
 - b. Overhead and profit.
 - c. Allowance shall be based on the unit price quoted in the Proposal.

4. Include all other related costs in the contract sum.
5. Method of measurement: Quantities will be verified by a soils and materials engineer employed by the Owner.
6. Allowance Quantity: 2,000-CY.

H. **Allowance UP/A-8:** Replacement of authorized excavation of unsuitable soils or rock with on-site suitable soils.

1. Purpose: To adjust the contract sum in case a quantity different from that indicated in the allowance is required.
2. Unit of measurement: cubic yard, compacted in place.
3. Include the following in the unit price:
 - a. Suitable soil materials from a location to be determined on the project site.
 - b. Excavation, loading, on-site transport, placement, moisture control and compaction of suitable soil materials.
 - c. Overhead and profit.
 - d. Allowance shall be based on the unit price quoted in the Proposal.
4. Include all other related costs in the contract sum. Unit price shall not include the excavation of unsuitable soil or rock.
5. Method of measurement: Quantities will be verified by a soils and materials engineer employed by the Owner.
6. Allowance Quantity: 8,000-CY.

I. **Allowance UP/A-9:** Replacement of authorized excavation of unsuitable soils or rock with off-site imported fill material.

1. Purpose: To adjust the contract sum in case a quantity different from that indicated in the allowance is required.
2. Unit of measurement: cubic yard, compacted in place.
3. Include the following in the unit price:
 - a. Suitable soil materials from Contractor's off-site source.
 - b. Excavation, loading, transport, placement, moisture control and compaction of suitable soil materials.
 - c. Overhead and profit.
 - d. Allowance shall be based on the unit price quoted in the Proposal.
4. Include all other related costs in the contract sum. Unit price shall not include the excavation of unsuitable soil or rock.
5. Method of measurement: Quantities will be verified by a soils and materials engineer employed by the Owner.
6. Allowance Quantity: 8,000-CY.

J. **Allowance UP/A-10:** Replacement of authorized excavation of unsuitable soils or rock with Aggregate Base Course (ABC) stone material.

1. Purpose: To adjust the contract sum in case a quantity different from that indicated in the allowance is required.
2. Unit of measurement: cubic yard, compacted in place.
3. Include the following in the unit price:
 - a. ABC materials from Contractor's off-site source.
 - b. Excavation, loading, transport, placement, moisture control and compaction of materials.
 - c. Overhead and profit.
 - d. Allowance shall be based on the unit price quoted in the Proposal.
4. Include all other related costs in the contract sum. Unit price shall not include the excavation of unsuitable soil or rock.

5. Method of measurement: Quantities will be verified by a soils and materials engineer employed by the Owner.
 6. Allowance Quantity: 1,000-CY.
- K. **Allowance UP/A-11:** Replacement of authorized excavation of unsuitable soils or rock with #57 Washed Stone material.
1. Purpose: To adjust the contract sum in case a quantity different from that indicated in the allowance is required.
 2. Unit of measurement: cubic yard, compacted in place.
 3. Include the following in the unit price:
 - a. #57 Washed Stone materials from Contractor's off-site source.
 - b. Excavation, loading, transport, placement, moisture control and compaction of materials.
 - c. Overhead and profit.
 - d. Allowance shall be based on the unit price quoted in the Proposal.
 4. Include all other related costs in the contract sum. Unit price shall not include the excavation of unsuitable soil or rock.
 5. Method of measurement: Quantities will be verified by a soils and materials engineer employed by the Owner.
 6. Allowance Quantity: 500-CY.
- L. **Allowance UP/A-12:** Geo-Grid in place.
1. Purpose: To adjust the contract sum in case a quantity different from that indicated in the allowance is required.
 2. Unit of measurement: square yard of ground surface covered. Overlap, waste or excess shall not be included in payment measurements.
 3. Include the following in the unit price:
 - a. Materials and transport to site.
 - b. Unloading, handling, and placement.
 - c. Overhead and profit.
 - d. Allowance shall be based on the unit price quoted in the Proposal.
 4. Include all other related costs in the contract sum.
 5. Method of measurement: Quantities will be verified by a soils and materials engineer employed by the Owner.
 6. Allowance Quantity: 2,000-SY.
- M. **Allowance UP/A-13:** Woven Geotextile Separation & Stabilization Fabric in-place.
1. Purpose: To adjust the contract sum in case a quantity different from that indicated in the allowance is required.
 2. Unit of measurement: square yard of ground surface covered. Overlap, waste or excess shall not be included in payment measurements.
 3. Include the following in the unit price:
 - a. Materials and transport to site.
 - b. Unloading, handling, and placement.
 - c. Overhead and profit.
 - d. Allowance shall be based on the unit price quoted in the Proposal.
 4. Include all other related costs in the contract sum.
 5. Method of measurement: Quantities will be verified by a soils and materials engineer employed by the Owner.
 6. Allowance Quantity: 2,000-SY.

- N. **Allowance UP/A-14:** Replacement of removed rock or unsuitable soils with Lean Concrete Fill in-place.
1. Purpose: To adjust the contract sum in case a quantity different from that indicated in the allowance is required.
 2. Unit of measurement: cubic yard of void to be filled.
 3. Include the following in the unit price:
 - a. Lean Concrete materials from contractor's off-site source.
 - b. Excavation, loading, transport, placement of Lean Concrete Fill into void remaining from removed rock or unsuitable soil.
 - c. Overhead and profit.
 4. Include all other related costs in the contract sum.
 5. Include costs related to removal of rock or unsuitable soil in other Unit Prices.
 6. Method of measurement: Quantities will be verified by a soils and materials engineer employed by the Owner based on volume of void to be filled.
 7. Quantity Allowance: Coordinate unit price with allowance adjustment requirements of Division 01 Section "Allowances."
 8. Allowance: 500-CY.
- O. **Allowance UP/A-15:** High Capacity French Drain.
1. Purpose: To adjust the contract sum in case a quantity different from that indicated in the allowance is required. French drains shown on the plan are to be included in this allowance.
 2. Unit of measurement: linear foot.
 3. Include the following in the unit price:
 - a. Materials (incl. pipe, stone, fabric) and transport to site.
 - b. Unloading, handling.
 - c. Excavation.
 - d. Installation per Division 33 Section "Storm Drainage Utilities."
 - e. Overhead and profit.
 4. Include all other related costs in the contract sum.
 5. Refer to Drawings for general locations of drains.
 6. Method of measurement: Quantities will be verified by a soils and materials engineer employed by the Owner.
 7. Quantity Allowance: Coordinate unit price with allowance adjustment requirements of Division 01 Section "Allowances."
 8. Allowance: 700-LF.
- P. **Allowance A-16:** Athletic Scoreboards
1. Allow a lump sum to furnish and install athletic scoreboards in locations shown in the construction documents.
 2. **Lump Sum: \$25,000.00.**
- Q. **Allowance A-17:** Signage & Mural Graphics
1. Allow a lump sum for purchase and/or construction of interior panel signage, fire extinguisher signage, and dimensional lettering, as defined by and specified in "Signage" section of Division 10. Signage material and applicable sales taxes will be paid for as part of this allowance. Note, Labor for Sign Installation shall be included in the Base Bid.
 2. **Lump Sum: \$35,000.00.**

- R. **Allowance A-18:** Access Control System
1. Allow a lump sum for purchase and installation of a complete Access Control System, as defined by and specified in contract documents. Provide all components necessary for a fully operational system.
 2. **Lump Sum: \$70,000.00**
- S. **Allowance A-19:** Bi-Directional Amplification System
1. Allow a lump sum for purchase and installation of a complete Bi-Directional Amplification system. This is inclusive of the complete system, both the backbone and horizontal cabling, as well as all required devices for a complete system.
 2. **Lump Sum: \$70,000.00**
- T. **Allowance A-20:** Contingency
1. Contingency allowance shall be provided as follows and the price shall be adjusted based on the actual cost of subcontracts, materials, and labor, excluding overhead and profit. Allowances for overhead and profit shall be provided within the contract price. If there is unused allowance at the conclusion of the project, the allowance plus 15% will be deducted from the contract.
 2. **Contingency: \$375,000.00**

END OF SECTION 01 21 00

SECTION 01 23 00 - ALTERNATES

PART 1 - GENERAL

1.1 RELATED DOCUMENTS

- A. Drawings and general provisions of the Contract, including General and Supplementary Conditions and other Division 01 Specification Sections, apply to this Section.

1.2 SUMMARY

- A. This Section includes administrative and procedural requirements for alternates.

1.3 DEFINITIONS

- A. Alternate: An amount proposed by bidders and stated on the Bid Form for certain work defined in the Bidding Requirements that may be added to the Base Bid amount if Owner decides to accept a corresponding change either in the amount of construction to be completed or in the products, materials, equipment, systems, or installation methods described in the Contract Documents.
 - 1. The cost or credit for each alternate is the net addition to the Contract Sum to incorporate alternate into the Work. No other adjustments are made to the Contract Sum.

1.4 PROCEDURES

- A. Coordination: Modify or adjust affected adjacent work as necessary to completely integrate work of the alternate into Project.
- B. Include as part of each alternate, miscellaneous devices, accessory objects, and similar items incidental to or required for a complete installation whether or not indicated as part of alternate.
- C. Notification: Immediately following award of the Contract, notify each party involved, in writing, of the status of each alternate. Indicate if alternates have been accepted, rejected, or deferred for later consideration. Include a complete description of negotiated modifications to alternates.
- D. Execute accepted alternates under the same conditions as other work of the Contract.
- E. Schedule: A Schedule of Alternates is included at the end of this Section. Specification Sections referenced in schedule contain requirements for materials necessary to achieve the work described under each alternate.

PART 2 - PRODUCTS (Not Used)

PART 3 - EXECUTION

3.1 SCHEDULE OF ALTERNATES

- A. **Alternate No. 1; Owner Preferred Manufacturer(s) – Door Hardware:** State the amount to be added to the Base Bid for providing all labor and materials indicated and required to accomplish Work involved in providing the Owner Preferred Manufacturers Listed Below:
1. Exit Devices: Manufacturer – Von Duprin 99 as stated in the Drawings and Specifications.
 2. Door Closers: Manufacturer – LCN as stated in the Drawings and Specifications.
 3. Locksets: Manufacturer – Schlage locksets with “E” Keyway with Interchangeable Core as stated in the Drawings and Specifications.
 4. Note that equal products are allowed ONLY in the Base Bid.
- B. **Alternate No. 2; Owner Preferred Manufacturer(s) - HVAC:** State the amount to be added to the Base Bid for providing all labor and materials indicated and required to accomplish Work involved in providing the Owner Preferred Manufacturers Listed Below:
1. HVAC Equipment for Chillers and Air Handlers: Manufacturer – Trane as stated in the Drawings and Specifications.
 2. HVAC Controls: Manufacturer – Alerton (Hoffman Building Technologies) as stated in the Drawings and Specifications.
 3. Note that equal products are allowed ONLY in the Base Bid.
- C. **Alternate No. 3; Owner Preferred Manufacturer(s) - Electrical:** State the amount to be added to the Base Bid for providing all labor and materials indicated and required to accomplish Work involved in providing the Owner Preferred Manufacturers Listed Below:
1. Fire Alarm System: Manufacturer – Fire Lite Fire Alarm by Honeywell as stated in the Drawings and Specifications.
 2. Electrical Equipment: Manufacturer – Square D as stated in the Drawings and Specifications.
 3. Intercom Equipment: Manufacturer – Ai-phone Video-Intercom System as stated in the Drawings and Specifications.
 4. Note that equal products are allowed ONLY in the Base Bid.
- D. **Alternate No. 4; Terrazzo Flooring:** State the amount to be added to the Base Bid for providing all labor and materials to install terrazzo flooring in lieu polished concrete flooring in areas shown and noted in the Contract Drawings per the plans and specifications.
- E. **Alternate No. 5; Spray-Applied Cavity Wall Insulation:** State the amount to be added to the Base Bid for providing all labor and materials to install spray-applied cavity wall insulation in lieu of rigid insulation and fluid applied air and vapor barrier above finish floor as shown and noted in the Contract Drawings per the plans and specifications.
- F. **Alternate No. 6; Concession Upfit:** State the amount to be added to the Base Bid for providing all labor and materials to install concession layout as shown and noted in the Contract Drawings per the plans and specifications.
- G. **Alternate No. 7; Single Ply Roofing:** State the amount to be added to the Base Bid for providing all labor and materials to install TPO membrane roofing in lieu of metal roofing as shown and noted in the Contract Drawings per the plans and specifications.

- H. **Alternate No. 8; Additional Gymnasium Bleachers:** State the amount to be added to the Base Bid for providing all labor and materials to install additional Gymnasium Bleachers as shown and noted in the Contract Drawings per the plans and specifications.
- I. **Alternate No. 9; Maintenance Building:** State the amount to be added to the Base Bid for providing all labor and materials to provide a Maintenance Building and noted in the Contract Drawings per the plans and specifications.
- J. **Alternate No. 10; Offsite Work:** State the amount to be added to the Base Bid for providing all labor and materials to provide all offsite development as defined in the Contract Drawings.
- K. **Alternate No. 11; Owner Preferred Manufacturer(s) - Kitchen Equipment:** State the amount to be added to the Base Bid for providing all labor and materials to provide owner preferred equipment as defined in the Contract Documents. Refer to specifications.
- L. **Alternate No. 12; Owner Preferred Manufacturer(s) - Plumbing:** State the amount to be added to the Base Bid for providing all labor and materials indicated and required to accomplish Work involved in providing the Owner Preferred Manufacturers Listed Below:
 - 1. Boilers:
 - a. Boiler Manufacturer – Weil-McLain
 - b. Burner Manufacturer - Webster

END OF SECTION 01 23 00

SECTION 04 20 00 - UNIT MASONRY

PART 1 - GENERAL

1.1 RELATED DOCUMENTS

- A. Drawings and general provisions of the Contract, including General and Supplementary Conditions and Division 01 Specification Sections, apply to this Section.

1.2 SUMMARY

- A. This Section includes unit masonry assemblies consisting of the following:
 - 1. Concrete masonry units (CMUs).
 - 2. Concrete brick.
 - 3. Face brick.
 - 4. Mortar and grout.
 - 5. Reinforcing steel.
 - 6. Masonry joint reinforcement.
 - 7. Ties and anchors.
 - 8. Embedded flashing.
 - 9. Miscellaneous masonry accessories.
- B. Related Sections include the following:
 - 1. Division 07 Section "Dampproofing" for dampproofing applied to cavity face of backup wythes of cavity walls.
 - 2. Division 07 Section "Water Repellents" for water repellents applied to unit masonry assemblies.
 - 3. Division 07 Section "Thermal Insulation" for cavity wall insulation type, thickness, and r value.
 - 4. Division 07 Section "Thermal Insulation" for Alternate cavity wall insulation.
 - 5. Division 07 Section "Sheet Metal Flashing and Trim" for **exposed** sheet metal flashing.
 - 6. Division 07 Section "Joint Sealants" for sealing control and expansion joints in unit masonry.
- C. Products furnished, but not installed, under this Section include the following:
 - 1. Anchor sections of adjustable masonry anchors for connecting to structural frame, installed under Division 05 Section "Structural Steel Framing."
- D. Products installed, but not furnished, under this Section include the following:
 - 1. Steel **lintels and shelf angles** for unit masonry, furnished under Division 05 Section "Metal Fabrications."

1.3 DEFINITIONS

- A. Reinforced Masonry: Masonry containing reinforcing steel in grouted cells.

1.4 PERFORMANCE REQUIREMENTS

- A. Provide structural unit masonry that develops indicated net-area compressive strengths (f'_m) at 28 days.
 - 1. Determine net-area compressive strength of masonry from average net-area compressive strengths of masonry units and mortar types (unit-strength method) according to TMS 602/ACI 530.1/ASCE 6.

1.5 SUBMITTALS

- A. Product Data: For each type of product indicated.
- B. Certification:
 - 1. The producer shall furnish a letter of certification stating the following;
 - a. All aggregate used in the manufacture of the units was produced by the rotary kiln process conforming to ASTM C 331 and ASTM C 330.
 - b. Product has been tested and certificated by ASTM C 90.
- C. Shop drawings:
 - 1. For reinforcing steel detail bending and placement of unit masonry reinforcing bars. Comply with ACI 315, "Details and Detailing of Concrete Reinforcement."
 - 2. Fabricated Flashing: Detail corner units, end-dam units, and other special applications.
- D. Samples for Verification: For each type and color of the following:
 - 1. Face brick, in the form of straps of five or more bricks.
 - 2. Decorative concrete masonry units, in the form of small-scale units.
 - 3. Colored mortar samples showing the full range of colors available.
 - 4. Weep holes/vents.
 - 5. Accessories embedded in masonry.
- E. List of Materials Used in Constructing Mockups: List generic product names together with manufacturers, manufacturers' product names, model numbers, lot numbers, batch numbers, source of supply, and other information as required to identify materials used. Include mix proportions for mortar and grout and source of aggregates.

1.6 QUALITY ASSURANCE

- A. Testing Agency Qualifications: An independent agency qualified according to ASTM C 1093 for testing indicated, as documented according to ASTM E 548.
- B. Source Limitations for Masonry Units: Obtain exposed masonry units of a uniform texture and color, or a uniform blend within the ranges accepted for these characteristics, through one source from a single manufacturer for each product required.
 - 1. Manufacturer shall not have less than 10 years of experience for each type of unit.
- C. Source Limitations for Mortar Materials: Obtain mortar ingredients of a uniform quality, including color for exposed masonry, from a single manufacturer for each cementitious component and from one source or producer for each aggregate.
- D. Source Limitations for Concrete Masonry Units: Obtain CMU units from a manufacturer with a demonstrated history for providing first quality CMU units suitable for use in exposed work of the type and scope of this project, with units showing dense uniform face texture, square sides, corners, edges and faces, and free of chipped edges and broken corners when delivered to the site. Manufacturers with outdated equipment and worn molds incapable of providing consistently high quality materials will not be considered.
- E. Fire-Resistance Ratings: Where indicated, provide materials and construction identical to those of assemblies with fire-resistance ratings determined per ASTM E 119 by a testing and inspecting agency, by equivalent concrete masonry thickness, or by other means, as acceptable to authorities having jurisdiction.
- F. Sample Panels: Build sample panels to verify selections made under sample submittals and to demonstrate aesthetic effects. Comply with requirements in Division 01 Section "Quality Requirements" for mockups.
 - 1. Build sample panels for typical exterior wall in sizes approximately **48 inches** long by **48 inches** high by full thickness.
 - 2. Where masonry is to match existing, erect panels adjacent and parallel to existing surface.
 - 3. Clean exposed faces of panels with masonry cleaner indicated.
 - 4. Protect approved sample panels from the elements with weather-resistant membrane.
 - 5. Approval of sample panels is for color, texture, and blending of masonry units; relationship of mortar and sealant colors to masonry unit colors; tooling of joints; aesthetic qualities of

workmanship; and other material and construction qualities specifically approved by Architect in writing.

- a. Approval of sample panels does not constitute approval of deviations from the Contract Documents contained in sample panels unless such deviations are specifically approved by Architect in writing.
- G. Preinstallation Conference: Conduct conference at Project site to comply with requirements in Division 01 Section "Project Management and Coordination."

1.7 DELIVERY, STORAGE, AND HANDLING

- A. Ordering: Comply with manufacture's ordering instructions and lead time requirements to avoid construction delays.
- B. Store masonry units on elevated platforms in a dry location. If units are not stored in an enclosed location, cover tops and sides of stacks with waterproof sheeting, securely tied. If units become wet, do not install until they are dry. Do not double stack pallets of masonry units.
- C. Store cementitious materials on elevated platforms, under cover, and in a dry location. Do not use cementitious materials that have become damp.
- D. Store aggregates where grading and other required characteristics can be maintained and contamination avoided.
- E. Store preblended, dry mortar mix in delivery containers on elevated platforms, under cover, and in a dry location or in a metal dispensing silo with weatherproof cover.
- F. Store masonry accessories, including metal items, to prevent corrosion and accumulation of dirt and oil.

1.8 PROJECT CONDITIONS

- A. Protection of Masonry: During construction, cover tops of walls, projections, and sills with waterproof sheeting at end of each day's work. Cover partially completed masonry when construction is not in progress.
 1. Extend cover a minimum of **24 inches** down both sides and hold cover securely in place.
- B. Do not apply uniform floor or roof loads for at least 12 hours and concentrated loads for at least 3 days after building masonry walls or columns.
- C. Stain Prevention: Prevent grout, mortar, and soil from staining the face of masonry to be left exposed or painted. Immediately remove grout, mortar, and soil that come in contact with such masonry.
 1. Protect base of walls from rain-splashed mud and from mortar splatter by spreading coverings on ground and over wall surface.
 2. Protect sills, ledges, and projections from mortar droppings.
 3. Protect surfaces of window and door frames, as well as similar products with painted and integral finishes, from mortar droppings.
 4. Turn scaffold boards near the wall on edge at the end of each day to prevent rain from splashing mortar and dirt onto completed masonry.
- D. Cold-Weather Requirements: Do not use frozen materials or materials mixed or coated with ice or frost. Do not build on frozen substrates. Remove and replace unit masonry damaged by frost or by freezing conditions. Comply with cold-weather construction requirements contained in **ACI 530.1/ASCE 6/TMS 602**.
 1. Cold-Weather Construction: When the ambient temperature is within the limits indicated, use the following procedures:
 - a. **40 to 32 deg F**: Heat mixing water or sand to produce mortar temperatures between **40 and 120 deg F**.
 - b. **32 to 25 deg F**: Heat mixing water and sand to produce mortar temperatures between **40 and 120 deg F**. Heat grout materials to produce grout temperatures between **40 and 120 deg F**. Maintain mortar and grout above freezing until used in masonry.
 - c. **25 to 20 deg F**: Heat mixing water and sand to produce mortar temperatures between **40 and 120 deg F**. Heat grout materials to produce grout temperatures between **40 and 120**

- deg F. Maintain mortar and grout above freezing until used in masonry. Heat masonry units to 40 deg F if grouting. Use heat on both sides of walls under construction.
- d. 20 deg F and Below: Heat mixing water and sand to produce mortar temperatures between 40 and 120 deg F. Heat grout materials to produce grout temperatures between 40 and 120 deg F. Maintain mortar and grout above freezing until used in masonry. Heat masonry units to 40 deg F. Provide enclosures and use heat on both sides of walls under construction to maintain temperatures above 32 deg F within the enclosures.
2. Cold-Weather Protection: When the mean daily temperature is within the limits indicated, provide the following protection:
 - a. 40 to 25 deg F : Cover masonry with a weather-resistant membrane for 48 hours after construction.
 - b. 25 to 20 deg F: Cover masonry with insulating blankets or provide enclosure and heat for 48 hours after construction to prevent freezing. Install wind breaks when wind velocity exceeds 15 mi./h .
 - c. 20 deg F and Below: Provide enclosure and heat to maintain temperatures above 32 deg F within the enclosure for 48 hours after construction.
 3. Cold-Weather Cleaning: Use liquid cleaning methods only when air temperature is 40 deg F and above and will remain so until masonry has dried, but not less than 7 days after completing cleaning.
- E. Hot-Weather Requirements: Comply with hot-weather construction requirements contained in ACI 530.1/ASCE 6/TMS 602.
1. Protect unit masonry work when temperature and humidity conditions produce excessive evaporation of water from mortar and grout. Provide artificial shade and wind breaks and use cooled materials as required. Do not apply mortar to substrates with temperatures of 100 deg F and above.

1.9 SPECIAL REQUIREMENTS

- A. The masonry subcontractor shall at all times when work is in progress, provide an individual from its own staff, acting as superintendent, designated by the North Carolina Masonry Contractors Association Masonry Contractor Certification Program as a “CMP-Certified Masonry Professional” or “CME-Certified Masonry Executive” (as described in the most current version of the NCMCA’s “Guide to Masonry Contractor Certification”) on-site to supervise work in progress.

PART 2 - PRODUCTS

2.1 MANUFACTURERS

- A. In other Part 2 articles where titles below introduce lists, the following requirements apply to product selection:

2.2 MASONRY UNITS, GENERAL

- A. Defective Units: Referenced masonry unit standards may allow a certain percentage of units to exceed tolerances and to contain chips, cracks, or other defects exceeding limits stated in the standard. Do not use units where such defects, including dimensions that vary from specified dimensions by more than stated tolerances, will be exposed in the completed Work or will impair the quality of completed masonry.

2.3 CONCRETE MASONRY UNITS (CMUs)

- A. Shapes: Provide shapes indicated and as follows:
1. Provide special shapes for lintels, corners, jambs, sashes, movement joints, headers, bonding, and other special conditions.
 2. Provide **square-edged** units for outside corners, unless otherwise indicated.
- B. Concrete Masonry Units: **ASTM C 90 (latest edition)**.
1. Unit Compressive Strength: Provide units with minimum average net-area compressive strength of 2000 psi net average of three units.
 2. Weight Classification: Units shall be lightweight blended with aggregates that comply with ASTM C331 and ASTM C33 with a total mix weight not more than 105 lbs./cuft. and not less than 90lbs/cuft.
 3. Size (Width): Manufactured to dimensions 3/8 inch less than nominal dimensions.
 4. Exposed Faces: Provide color and texture matching the range represented by Architect's sample.
 5. Aggregates: Do not use aggregates made from pumice, scoria, or tuff. All units will be free of organic impurities that will cause rusting, staining, or popouts and will not contain combustible material. All lightweight material to be manufactured by rotary kiln process. The use of coal cinders, coal ash, bottom ash or other similar waste products are not permitted and shall not be allowed.
 6. CMU used in fire rated walls shall meet UL Design Assembly criteria.
 7. Basis for Design: Adams an Oldcastle Company - Redline
 8. Approved Manufacturers:
 - a. Adams an Oldcastle Company
 - b. Johnson Concrete
 - c. York Building Products
 - d. Martinsville Concrete Products
 9. Products offered for substitution shall be pre-approved prior to bidding in accordance with the conditions of the contract documents and shall be so indicated in an addendum prior to bid only. Any other approval shall not be valid.
- C. Concrete Building Brick: **ASTM C 55**.
1. Unit Compressive Strength: Provide units with minimum average net-area compressive strength of **3500 psi**.
 2. Weight Classification: Normal Weight
 3. Size (Actual Dimensions): **3-5/8 inches** wide by **2-1/4 inches** high by **7-5/8 inches** long.

2.4 DECORATIVE CONCRETE MASONRY UNITS

- A. Decorative Concrete Masonry Units: **ASTM C 90 (latest edition)**.
1. Unit Compressive Strength: Provide units with minimum average net-area compressive strength of High Strength Unit. Average of three units 3000PSI, individual unit 2700 PSI. Exceeds ASTM C 90 standard average of three units 2000 PSI, individual unit 1800 PSI.
 2. Weight Classification: **Normal weight**. High Density Unit. not less than 125 lbs/CF.
 3. Size (Width): Manufactured to dimensions specified in "Concrete Masonry Units" Paragraph above and as listed below.
 - a. Size: Nominal 4"x8"x16" running bond. All exposed faces to be finished.
 4. Pattern and Texture:
 - a. Polished Face Texture in areas as indicated on the drawings
 5. Special Spaces:
 - a. Provide all special shapes as required. This includes but not limited to clipped sills.
 6. Colors: As selected from manufacturer's full range.
 - b. Units shall require the use of white cement in its manufacture. If a lesser priced unit is selected, the contract price will be modified by change order.
 7. Manufacture of Decorative Concrete Masonry Units: Provide decorative units as manufactured by Adams an Oldcastle Company or approved equal.
 - c. Approved Manufacturers:

- 1) Adams an Oldcastle Company
 - 2) York Building Products
 - 3) Martinsville Concrete Products
 - 4) Johnson Concrete Company
- d. Products offered for substitution shall be pre-approved prior to bidding in accordance with the conditions of the contract documents and shall be so indicated in an addendum prior to bid only. Any other approval shall not be valid.
- e. Products offered for substitution shall be judged on the variety of colors offered, brightness of colors offered, consistency of color, quality of splitting (four blade splitter required), weight, ability of manufacturer to offer and/or control color matching of mortars, method for blending water repellent admix into mixing process, and past performance.
8. Maximum Absorption: Low Absorption unit. The unit shall contain specific amounts of the integral water repellent compound so the absorption is less than (7.5%) and/or 10 lbs/CF.
9. Integral Water Repellent: Provide units produced with liquid polymeric, integral water-repellent admixture that does not reduce flexural bond strength. Units made with integral water repellent, when tested as a wall assembly made with mortar containing integral water-repellent manufacturer's mortar additive according to ASTM E 514, with test period extended to 24 hours, show no visible water or leaks on the back of the test specimen. Product: Subject to compliance with requirements, provide units made with Rainbloc by ACM Chemistries, Dry-Block by W.R. Grace & Co, or equal.
10. Aggregates: Do not use aggregates made from pumice, scoria, or tuff. All units will be free of organic impurities that will cause rusting, staining, or popouts and will not contain combustible material. All lightweight material to be manufactured by rotary kiln process. Coal Cinders are not permitted.

2.5 BRICK

- A. General: Provide shapes indicated and as follows:
1. For ends of sills and caps and for similar applications that would otherwise expose unfinished brick surfaces, provide units without cores or frogs and with exposed surfaces finished.
- B. Face Brick: **ASTM C 216**, Grade **SW** Type **FBS**.
1. Size (Actual Dimensions): **3-5/8 inches** wide by **3-5/8 inches** high by **11-5/8 inches** long.
 2. Bond Pattern: Unless otherwise indicated, lay exposed masonry in **one-third running bond**
 3. Provide for one of the following:
 - a. Palmetto Brick
 - 1) Dark Red Wirecut
 - b. Meridian
 - 1) 424 New Ashbury Wirecut
 - c. General Shale
 - 1) Winestone Velour

2.6 MASONRY LINTELS

- A. General: Provide masonry lintels complying with requirements below.
- B. Masonry Lintels: Prefabricated or built-in-place masonry lintels made from bond beam concrete masonry units with reinforcing bars placed as indicated and filled with coarse grout. Cure precast lintels before handling and installing. Temporarily support built-in-place lintels until cured.

2.7 MORTAR AND GROUT MATERIALS

- A. Portland Cement: ASTM C 150, Type I or II, except Type III may be used for cold-weather construction. Provide natural color or white cement as required to produce mortar color indicated.

- B. Hydrated Lime: **ASTM C 207**, Type S.
- C. Portland Cement-Lime Mix: Packaged blend of portland cement complying with ASTM C 150, Type I or Type III, and hydrated lime complying with ASTM C 207, Type S.
- D. Masonry Cement: **ASTM C 91**.
 - 1. Available Products:
 - a. Flamingo Color Masonry Cement. Brixment;
 - b. Holcim (US) Inc.;
 - c. Argos Cement Company
 - d. National Cement Company
 - e. Lehigh Cement Company
- E. Colored Cement Product: Packaged blend made from **masonry cement** and mortar pigments, all complying with specified requirements, and containing no other ingredients.
 - 1. Formulate blend as required to produce color indicated or, if not indicated, as selected from manufacturer's standard colors.
 - 2. Pigments shall not exceed 10 percent of portland cement by weight.
 - 3. Available Products:
 - a. Flamingo Color Masonry Cement. Brixment;
 - b. Holcim (US) Inc.;
 - c. Argos Cement Company
 - d. National Cement Company
 - e. Lehigh Cement Company
- F. Aggregate for Mortar: ASTM C 144.
 - 1. For mortar that is exposed to view, use washed aggregate consisting of natural sand or crushed stone.
- G. Aggregate for Grout: ASTM C 404.
 - 1. Cold-Weather Admixture: Nonchloride, noncorrosive, accelerating admixture complying with ASTM C 494/C 494M, Type C, and recommended by manufacturer for use in masonry mortar of composition indicated.
 - 2. Available Products:
 - a. Addiment Incorporated; Mortar Kick.
 - b. Euclid Chemical Company (The); Accelguard 80.
 - c. Grace Construction Products, a unit of W. R. Grace & Co. - Conn.; Morset.
 - d. Sonneborn, Div. of ChemRex; Trimix-NCA.
- H. Water-Repellent Admixture: Liquid water-repellent mortar admixture intended for use with concrete masonry units, containing integral water repellent by same manufacturer.
 - 1. Available Products:
 - a. Rainbloc by ACM Chemistries
 - b. Addiment Incorporated; Mortar Tite.
 - c. Grace Construction Products, a unit of W. R. Grace & Co. - Conn.; Dry-Block Mortar Admixture.
 - d. Master Builders, Inc.
- I. Water: Potable.

2.8 REINFORCEMENT

- A. Uncoated Steel Reinforcing Bars: ASTM A 615/A 615M, **Grade 60**.
- B. Masonry Joint Reinforcement, General: **ASTM A 951**.
 - 1. Interior Walls: galvanized, carbon steel.
 - 2. Exterior Walls: Hot-dip galvanized, carbon steel.
 - 3. Wire Size for Side Rods Interior: **0.148-inch** diameter.
 - 4. Wire Size for Side Rods Exterior: **0.188-inch** diameter.
 - 5. Wire Size for Cross Rods: **W1.7 or 0.148-inch** diameter.
 - 6. Wire Size for Veneer Ties: **0.188-inch** diameter.
 - 7. Spacing of Cross Rods, Tabs, and Cross Ties: Not more than **16 inches** o.c.
 - 8. Provide in lengths of not less than **10 feet, with prefabricated corner and tee units**.

- C. Masonry Joint Reinforcement for Single-Wythe Masonry: Truss type with single pair of side rods.
- D. Masonry Joint Reinforcement for Multiwythe Masonry:
 - 1. Adjustable (two-piece) type, truss design, with one side rod at each face shell of backing wythe and with separate ties that extend into facing wythe. Ties have two hooks that engage eyes or slots in reinforcement and resist movement perpendicular to wall. Ties extend at least halfway through facing wythe but with at least **5/8-inch** cover on outside face. **Ties have hooks or clips to engage a continuous horizontal wire in the facing wythe.**
- E. Masonry Joint Reinforcement for Veneers Anchored with Seismic Masonry-Veneer Anchors: Single **0.188-inch-** diameter, **hot-dip galvanized, carbon-**steel continuous wire.

2.9 TIES AND ANCHORS

- A. Materials: Provide ties and anchors specified in subsequent paragraphs that are made from materials that comply with eight subparagraphs below, unless otherwise indicated.
 - 1. Mill-Galvanized, Carbon-Steel Wire: ASTM A 82; with ASTM A 641/A 641M, Class 1 coating.
 - 2. Hot-Dip Galvanized, Carbon-Steel Wire: ASTM A 82; with ASTM A 153/A 153M, Class B-2 coating.
- B. Adjustable Anchors for Connecting to Structure: Provide anchors that allow vertical or horizontal adjustment but resist tension and compression forces perpendicular to plane of wall.
 - 1. Anchor Section for Welding to Steel Frame: Crimped **1/4-inch-** diameter, hot-dip galvanized steel wire. Mill-galvanized wire may be used at interior walls, unless otherwise indicated.
 - 2. Tie Section for Steel Frame: Triangular-shaped wire tie, sized to extend within **1 inch** of masonry face, made from **0.188-inch-** diameter, hot-dip galvanized steel wire. Mill-galvanized wire may be used at interior walls, unless otherwise indicated.
- C. Rigid Anchors: Fabricate from steel bars **1-1/2 inches** wide by **1/4 inch** thick by **24 inches** long, with ends turned up **2 inches** or with cross pins, unless otherwise indicated.
 - 1. Corrosion Protection: Hot-dip galvanized to comply with ASTM A 153/A 153M.
- D. Stone Anchors: Fabricate dowels, cramps, and other stone anchors from stainless steel.
- E. Adjustable Masonry-Veneer Anchors
 - 1. General: Provide anchors that allow vertical adjustment but resist tension and compression forces perpendicular to plane of wall, for attachment over sheathing to wood or metal studs, and as follows:
 - a. Structural Performance Characteristics: Capable of withstanding a **100-lbf** load in both tension and compression without deforming or developing play in excess of **0.05 inch**.
 - 2. Contractor's Option: Unless otherwise indicated, provide any of the following types of anchors:
 - 3. Screw-Attached, Masonry-Veneer Anchors: Units consisting of a wire tie and a metal anchor section.
 - a. Anchor Section: Rib-stiffened, sheet metal plate with screw holes top and bottom, **2-3/4 inches** wide by **3 inches** high; with projecting tabs having slotted holes for inserting vertical legs of wire tie specially formed to fit anchor section.
 - b. Anchor Section: Sheet metal plate, **1-1/4 inches** wide by **6 inches** long, with screw holes top and bottom and with raised rib-stiffened strap, **5/8 inch** wide by **3-5/8 inches** long, stamped into center to provide a slot between strap and plate for inserting wire tie.
 - c. Anchor Section: Gasketed sheet metal plate, **1-1/4 inches** wide by **6 inches** long, with screw holes top and bottom; top and bottom ends bent to form pronged legs of length to match thickness of insulation or sheathing; and raised rib-stiffened strap, **5/8 inch** wide by **6 inches** long, stamped into center to provide a slot between strap and plate for inserting wire tie. Provide anchor manufacturer's standard, self-adhering, modified bituminous gaskets manufactured to fit behind anchor plate and extend beyond pronged legs.
 - d. Anchor Section: Zinc-alloy barrel section with flanged head with eye and corrosion-resistant, self-drilling screw. Eye designed to receive wire tie and to serve as head for drilling fastener into framing. Barrel length to suit sheathing thickness, allowing screw to seat directly against framing with flanged head covering hole in sheathing.
 - e. Fabricate sheet metal anchor sections and other sheet metal parts from **0.067-inch-** thick, steel sheet, galvanized after fabrication **0.078-inch-** thick,.

- f. Wire Ties: Triangular-, rectangular-, or T-shaped wire ties fabricated from **0.25-inch-** diameter, **hot-dip galvanized steel** wire.
- 4. Available Products:
 - a. Dayton Superior Corporation, Dur-O-Wal Division; **D/A 213 or D/A 210 with D/A 700-708.**
 - b. Heckmann Building Products Inc.; **315-D with 316 or Pos-I-Tie.**
 - c. Hohmann & Barnard, Inc.; **DW-10 DW-10HS or DW-10-X.**
 - d. Wire-Bond; 1004, Type III or RJ-711.

2.10 EMBEDDED FLASHING MATERIALS

- A. Metal Flashing: Provide metal flashing **where flashing is exposed or partly exposed and where indicated,** complying with **Division 07 Section "Sheet Metal Flashing and Trim"**.
- B. Cavity Wall Flashing
 - 1. Metal Sub Flashing with integral Drip Edge: Provide continuous under Flexible Flashing. Fabricate from stainless steel. Extend at least 3 inches into wall inner wythe CMU backup and 1/2 inch out from wall, with outer edge bent down 30 degrees and hemmed.
 - a. Stainless Steel: ASTM A 240/A 240M, Type 304, **0.016 inch** thick.
 - b. Metal Flashing Terminations: Fabricate from stainless steel. Extend at least **3 inches** into wall and out to exterior face of wall. At exterior face of wall, bend metal back on itself for **3/4 inch** and down into joint **3/8 inch** to form a stop for retaining sealant backer rod.
 - 2. Flexible Flashing: For flashing not exposed to the exterior, use **one of** the following, unless otherwise indicated:
 - a. Rubberized-Asphalt Flashing: Composite flashing product consisting of a pliable, adhesive rubberized-asphalt compound, bonded to a high-density, cross-laminated polyethylene film to produce an overall thickness of not less than **0.040 inch.**
 - 1) Available Products:
 - a) Advanced Building Products Inc.; Peel-N-Seal.
 - b) Carlisle Coatings & Waterproofing; CCW-705-TWF Thru-Wall Flashing.
 - c) Dayton Superior Corporation, Dur-O-Wal Division; Dur-O-Barrier-44.
 - d) Grace Construction Products, a unit of W. R. Grace & Co. - Conn.; Perm-A-Barrier Wall Flashing.
 - e) Heckmann Building Products Inc.; No. 82 Rubberized-Asphalt Thru-Wall Flashing.
 - f) Henry Company; Blueskin TWF
 - g) Hohmann & Barnard, Inc.; Textroflash.
 - h) Polyguard Products, Inc.; Polyguard 300.
 - i) Polytite Manufacturing Corp.; Poly-Barrier Self-Adhering Wall Flashing.
 - j) Williams Products, Inc.; Everlastic MF-40.
 - b. Provide mechanically fastened stainless steel termination bar with continuous sealant at top.

2.11 MISCELLANEOUS MASONRY ACCESSORIES

- A. Preformed Control-Joint Gaskets: Made from styrene-butadiene-rubber compound, complying with ASTM D 2000, Designation M2AA-805 or PVC, complying with ASTM D 2287, Type PVC-65406 and designed to fit standard sash block and to maintain lateral stability in masonry wall; size and configuration as indicated.
- B. Bond-Breaker Strips: Asphalt-saturated, organic roofing felt complying with ASTM D 226, Type I (No. 15 asphalt felt).
- C. Weep/Vent Products: Use the following, unless otherwise indicated:
 - 1. Mesh Weep/Vent: Free-draining mesh; made from polyethylene strands, full height and width of head joint and depth **1/8 inch** less than depth of outer wythe; in color selected from manufacturer's standard.

- a. Provide at 32" o.c. unless otherwise noted.
- D. Cavity Drainage Material: Free-draining mesh, made from polymer strands that will not degrade within the wall cavity.
 - 1. Provide one of the following configurations:
 - a. Strips, full-depth of cavity and **10 inches** wide, with dovetail shaped notches **7 inches** deep that prevent mesh from being clogged with mortar droppings.
 - 2. Available Products:
 - a. Advanced Building Products Inc.; **Mortar Break II**.
 - b. Archovations, Inc.; CavClear Masonry Mat.
 - c. Dayton Superior Corporation, Dur-O-Wal Division; Polytite MortarStop.
 - d. Mortar Net USA, Ltd.; Mortar Net.
 - e. Hohmann & Barnard, Inc.

2.12 MASONRY CLEANERS

- A. Proprietary Acidic Cleaner: Manufacturer's standard-strength cleaner designed for removing mortar/grout stains, efflorescence, and other new construction stains from new masonry without discoloring or damaging masonry surfaces. Use product expressly approved for intended use by cleaner manufacturer and manufacturer of masonry units being cleaned.
 - 1. **Available** Manufacturers:
 - a. Diedrich Technologies, Inc.
 - b. EaCo Chem, Inc.
 - c. ProSoCo, Inc.

2.13 MORTAR AND GROUT MIXES

- A. General: Do not use admixtures, including pigments, air-entraining agents, accelerators, retarders, water-repellent agents, antifreeze compounds, or other admixtures, unless otherwise indicated.
 - 1. Do not use calcium chloride in mortar or grout.
 - 2. Limit cementitious materials in mortar to portland cement, **mortar cement**, and lime.
- B. Preblended, Dry Mortar Mix: Furnish dry mortar ingredients in form of a preblended mix. Measure quantities by weight to ensure accurate proportions, and thoroughly blend ingredients before delivering to Project site.
- C. Mortar for Unit Masonry: Comply with **ASTM C 270 BIA Technical Notes 8A**, Property Specification, Type S.
- D. Pigmented Mortar: Use colored cement product. **Do not add pigments to colored cement products.**
 - 1. Pigments shall not exceed 5 percent of **masonry cement or mortar cement** by weight.
 - 2. Mix to match Architect's sample.
- E. Colored-Aggregate Mortar: Produce required mortar color by using colored aggregates and natural color or white cement as necessary to produce required mortar color.
- F. Grout for Unit Masonry: Comply with **ASTM C 476**, Proportions Specifications. Provide grout with a slump of 8 to 11 inches when placed in the masonry

2.14 SOURCE QUALITY CONTROL

- A. Owner may engage a qualified independent testing agency to perform source quality-control testing indicated below:
 - 1. Payment for these services will be made **by Owner**.
 - 2. Retesting of materials failing to comply with specified requirements shall be done at Contractor's expense.
- B. Clay Masonry Unit Test: For each type of unit furnished, per ASTM C 67.
- C. Concrete Masonry Unit Test: For each type of unit furnished, per ASTM C 140.

PART 3 - EXECUTION

3.1 EXAMINATION

- A. Examine conditions, with Installer present, for compliance with requirements for installation tolerances and other conditions affecting performance of work.
- B. Before installation, examine rough-in and built-in construction for piping systems to verify actual locations of piping connections.
- C. Proceed with installation only after unsatisfactory conditions have been corrected.

3.2 INSTALLATION, GENERAL

- A. Thickness: Build cavity and composite walls and other masonry construction to full thickness shown. Build single-wythe walls to actual widths of masonry units, using units of widths indicated.
- B. Build chases and recesses to accommodate items specified in this and other Sections.
- C. Leave openings for equipment to be installed before completing masonry. After installing equipment, complete masonry to match the construction immediately adjacent to opening.
- D. Use full-size units without cutting if possible. If cutting is required to provide a continuous pattern or to fit adjoining construction, cut units with motor-driven saws; provide clean, sharp, unchipped edges. Allow units to dry before laying unless wetting of units is specified. Install cut units with cut surfaces and, where possible, cut edges concealed.
- E. Select and arrange units for exposed unit masonry to produce a uniform blend of colors and textures.
 - 1. Mix units from several pallets or cubes as they are placed.
- F. Matching Existing Masonry: Match coursing, bonding, color, and texture of existing masonry.
- G. Wetting of Brick: Wet brick before laying if initial rate of absorption exceeds **30 g/30 sq. in.** per minute when tested per ASTM C 67. Allow units to absorb water so they are damp but not wet at time of laying.
- H. Comply with construction tolerances in ACI 530.1/ASCE 6/TMS 602 and with the following:
 - 1. For conspicuous vertical lines, such as external corners, door jambs, reveals, and expansion and control joints, do not vary from plumb by more than **1/8 inch in 10 feet, 1/4 inch in 20 feet, or 1/2 inch** maximum.
 - 2. For vertical alignment of exposed head joints, do not vary from plumb by more than **1/4 inch in 10 feet, or 1/2 inch** maximum.
 - 3. For conspicuous horizontal lines, such as lintels, sills, parapets, and reveals, do not vary from level by more than **1/8 inch in 10 feet, 1/4 inch in 20 feet, or 1/2 inch** maximum.
 - 4. For exposed bed joints, do not vary from thickness indicated by more than plus or minus **1/8 inch**, with a maximum thickness limited to **1/2 inch**. Do not vary from bed-joint thickness of adjacent courses by more than **1/8 inch**.
 - 5. For exposed head joints, do not vary from thickness indicated by more than plus or minus **1/8 inch**. Do not vary from adjacent bed-joint and head-joint thicknesses by more than **1/8 inch**.
 - 6. For faces of adjacent exposed masonry units, do not vary from flush alignment by more than **1/16 inch** except due to warpage of masonry units within tolerances specified for warpage of units.
 - 7. For exposed bed joints and head joints of stacked bond, do not vary from a straight line by more than **1/16 inch** from one masonry unit to the next.

3.3 LAYING MASONRY WALLS

- A. Lay out walls in advance for accurate spacing of surface bond patterns with uniform joint thicknesses and for accurate location of openings, movement-type joints, returns, and offsets. Avoid using less-than-half-size units, particularly at corners, jambs, and, where possible, at other locations.
- B. Bond Pattern for Exposed Masonry: Unless otherwise indicated, lay exposed masonry in **one-third running bond for Brick and running bond for CMU (all types)**; do not use units with less than nominal **4-inch** horizontal face dimensions at corners or jambs.

- C. Stopping and Resuming Work: Stop work by racking back units in each course from those in course below; do not tooth. When resuming work, clean masonry surfaces that are to receive mortar, remove loose masonry units and mortar, and wet brick if required before laying fresh masonry.
- D. Built-in Work: As construction progresses, build in items specified in this and other Sections. Fill in solidly with masonry around built-in items.
- E. Fill space between steel frames and masonry solidly with mortar, unless otherwise indicated.
- F. Where built-in items are to be embedded in cores of hollow masonry units, place a layer of metal lath, wire mesh, or plastic mesh in the joint below and rod mortar or grout into core.
- G. Fill cores in hollow concrete masonry units with grout **24 inches** under bearing plates, beams, lintels, posts, and similar items, unless otherwise indicated.
- H. Build non-load-bearing interior partitions full height of story to underside of solid floor or roof structure above, unless otherwise indicated.
 - 1. Install compressible filler in joint between top of partition and underside of structure above.
 - 2. Fasten partition top anchors to structure above and build into top of partition. Grout cells of CMUs solidly around plastic tubes of anchors and push tubes down into grout to provide **1/2-inch** clearance between end of anchor rod and end of tube. Space anchors **48 inches** o.c., unless otherwise indicated.
 - 3. Wedge non-load-bearing partitions against structure above with small pieces of tile, slate, or metal. Fill joint with mortar after dead-load deflection of structure above approaches final position.
 - 4. At fire-rated partitions, treat joint between top of partition and underside of structure above to comply with Division 07 Section "Fire-Resistive Joint Systems."

3.4 MORTAR BEDDING AND JOINTING

- A. Lay hollow **concrete masonry units** as follows:
 - 1. With face shells fully bedded in mortar and with head joints of depth equal to bed joints.
 - 2. With webs fully bedded in mortar in all courses of piers, columns, and pilasters.
 - 3. With webs fully bedded in mortar in grouted masonry, including starting course on footings.
 - 4. With entire units, including areas under cells, fully bedded in mortar at starting course on footings where cells are not grouted.
- B. Lay solid masonry units with completely filled bed and head joints; butter ends with sufficient mortar to fill head joints and shove into place. Do not deeply furrow bed joints or slush head joints.
- C. Set trim units in full bed of mortar with full vertical joints. Fill dowel, anchor, and similar holes.
 - 1. Clean soiled surfaces with fiber brush and soap powder and rinse thoroughly with clear water.
 - 2. Allow cleaned surfaces to dry before setting.
 - 3. Wet joint surfaces thoroughly before applying mortar.
- D. Tool exposed joints slightly concave when thumbprint hard, using a jointer larger than joint thickness, unless otherwise indicated.

3.5 CAVITY WALLS

- A. Bond wythes of cavity walls together using one of the following methods:
 - 1. Individual Metal Ties: Provide ties as shown installed in horizontal joints, but not less than one metal tie for **2.67 sq. ft.** of wall area spaced not to exceed **16 inches** o.c. horizontally and **16 inches** o.c. vertically. Stagger ties in alternate courses. Provide additional ties within **12 inches** of openings and space not more than **36 inches** apart around perimeter of openings. At intersecting and abutting walls, provide ties at no more than **24 inches** o.c. vertically.
 - a. Where bed joints of wythes do not align, use adjustable (two-piece) type ties.
 - b. Where one wythe is of clay masonry and the other of concrete masonry, use adjustable (two-piece) type ties to allow for differential movement regardless of whether bed joints align.
 - 2. Masonry Joint Reinforcement: Installed in horizontal mortar joints.

- a. Where bed joints of both wythes align, use Truss type **reinforcement extending across both wythes**
 - b. Where bed joints of wythes do not align, use adjustable (two-piece) type reinforcement **with continuous horizontal wire in facing wythe attached to ties.**
- B. Keep cavities clean of mortar droppings and other materials during construction. Bevel beds away from cavity, to minimize mortar protrusions into cavity. Do not attempt to trowel or remove mortar fins protruding into cavity.
- C. Coat cavity face of backup wythe to comply with Division 07 Section "Bituminous Dampproofing."

3.6 INSTALLATION OF CAVITY WALL INSULATION: RIGID – BASE BID

- A. Installing Cavity-Wall Insulation: Place small dabs of adhesive, spaced approximately 12 inches o.c. both ways, on inside face of insulation boards, or attach with plastic fasteners designed for this purpose. Fit courses of insulation between wall ties and other confining obstructions in cavity, with edges butted tightly both ways. Press units firmly against inside wythe of masonry or other construction as shown.
1. Fill cracks and open gaps in insulation with crack sealer compatible with insulation and masonry. Tape joints.

3.7 MASONRY JOINT REINFORCEMENT

- A. General: Install entire length of longitudinal side rods in mortar with a minimum cover of **5/8 inch** on exterior side of walls, **1/2 inch** elsewhere. Lap reinforcement a minimum of **6 inches**.
1. Space reinforcement not more than **16 inches** o.c.
Provide reinforcement not more than **8 inches** above and below wall openings and extending **12 inches** beyond openings.
 - a. Reinforcement above is in addition to continuous reinforcement.
- B. Interrupt joint reinforcement at control and expansion joints, unless otherwise indicated.
- C. Provide continuity at wall intersections by using prefabricated T-shaped units.
- D. Provide continuity at corners by using prefabricated L-shaped units.
- E. Cut and bend reinforcing units as directed by manufacturer for continuity at **corners**, returns, offsets, column fireproofing, pipe enclosures, and other special conditions.

3.8 ANCHORING MASONRY TO STRUCTURAL MEMBERS

- A. Anchor masonry to structural members where masonry abuts or faces structural members to comply with the following:
1. Provide an open space not less than **1/2 inch** in width between masonry and structural member, unless otherwise indicated. Keep open space free of mortar and other rigid materials.
 2. Anchor masonry to structural members with anchors embedded in masonry joints and attached to structure.
 3. Space anchors as indicated, but not more than **24 inches** o.c. vertically and horizontally.

3.9 ANCHORING MASONRY VENEERS

- A. Anchor masonry veneers to **wall framing concrete and masonry backup** with **seismic** masonry-veneer anchors to comply with the following requirements:

3.10 CONTROL AND EXPANSION JOINTS

- A. General: Install control and expansion joint materials in unit masonry as masonry progresses. Do not allow materials to span control and expansion joints without provision to allow for in-plane wall or partition movement.
- B. Form control joints in concrete masonry **as follows**:
 - 1. Fit bond-breaker strips into hollow contour in ends of concrete masonry units on one side of control joint. Fill resultant core with grout and rake out joints in exposed faces for application of sealant.
 - 2. Install preformed control-joint gaskets designed to fit standard sash block.
 - 3. Install interlocking units designed for control joints. Install bond-breaker strips at joint. Keep head joints free and clear of mortar or rake out joint for application of sealant.
 - 4. Install temporary foam-plastic filler in head joints and remove filler when unit masonry is complete for application of sealant.
 - 5. Where control joints extend from window or door head lintels and shelf angles, install bond breaker of building felt in horizontal joint below lintel and rake horizontal joint at lintel for installation of sealant.
- C. Form expansion joints in brick made from clay or shale as follows:
 - 1. Build flanges of metal expansion strips into masonry. Lap each joint **4 inches (100 mm)** in direction of water flow. Seal joints below grade and at junctures with horizontal expansion joints if any.
 - 2. Build flanges of factory-fabricated, expansion-joint units into masonry.
 - 3. Build in compressible joint fillers where indicated.
 - 4. Form open joint full depth of brick wythe and of width indicated, but not less than **3/8 inch** for installation of sealant and backer rod specified in Division 07 Section "Joint Sealants."

3.11 LINTELS

- A. Install steel lintels where indicated.
- B. Provide **masonry** lintels where shown and where openings of more than **12 inches** for brick-size units and **24 inches** for block-size units are shown without structural steel or other supporting lintels.
- C. Provide minimum bearing of **8 inches** at each jamb, unless otherwise indicated.

3.12 FLASHING, WEEP HOLES, CAVITY DRAINAGE, AND VENTS

- A. General: Install embedded flashing and weep holes in masonry at shelf angles, lintels, ledges, other obstructions to downward flow of water in wall, and where indicated. **Install vents at shelf angles, ledges, and other obstructions to upward flow of air in cavities, and where indicated.**
- B. Install flashing as follows, unless otherwise indicated:
 - 1. Prepare masonry surfaces so they are smooth and free from projections that could puncture flashing. Where flashing is within mortar joint, place through-wall flashing on sloping bed of mortar and cover with mortar. Before covering with mortar, seal penetrations in flashing with adhesive, sealant, or tape as recommended by flashing manufacturer.
 - 2. At multiwythe masonry walls, including cavity walls, extend flashing through outer wythe, turned up a minimum of **8 inches**, and through inner wythe to within **1/2 inch** of the interior face of wall in exposed masonry. Where interior face of wall is to receive furring or framing, carry flashing completely through inner wythe and turn flashing up approximately **2 inches** on interior face.
 - 3. At multiwythe masonry walls, including cavity walls, extend flashing through outer wythe, turned up a minimum of **8 inches**, and **1-1/2 inches** into the inner wythe.
 - 4. At masonry-veneer walls, extend flashing through veneer, across air space behind veneer, and up face of sheathing at least **8 inches**; with upper edge tucked under building paper or building wrap, lapping at least **4 inches**.

5. At lintels and shelf angles, extend flashing a minimum of **6 inches** into masonry at each end. At heads and sills, extend flashing **6 inches** at ends and turn up not less than **2 inches** to form end dams.
 6. Interlock end joints of ribbed sheet metal flashing by overlapping ribs not less than **1-1/2 inches** or as recommended by flashing manufacturer, and seal lap with elastomeric sealant complying with requirements in Division 07 Section "Joint Sealants" for application indicated.
 7. Install metal **drip edges and sealant stops** with ribbed sheet metal flashing by interlocking hemmed edges to form hooked seam. Seal seam with elastomeric sealant complying with requirements in Division 07 Section "Joint Sealants" for application indicated.
 8. Install metal sub flashing and integral drip edges beneath flexible flashing at exterior face of wall. Stop flexible flashing **1/2 inch** back from outside face of wall and adhere flexible flashing to metal for the entire length.
 9. Cut flexible flashing off flush with face of wall after masonry wall construction is completed.
 10. Install flexible flashing with continuous stainless steel termination bar with continuous sealant at top.
- C. Place cavity drainage material in cavities to comply with configuration requirements for cavity drainage material in Part 2 "Miscellaneous Masonry Accessories" Article.
- D. Install vents in head joints in exterior wythes at spacing indicated. Use **specified weep/vent products**.

3.13 REINFORCED UNIT MASONRY INSTALLATION

- A. Temporary Formwork and Shores: Construct formwork and shores as needed to support reinforced masonry elements during construction.
1. Construct formwork to provide shape, line, and dimensions of completed masonry as indicated. Make forms sufficiently tight to prevent leakage of mortar and grout. Brace, tie, and support forms to maintain position and shape during construction and curing of reinforced masonry.
 2. Do not remove forms and shores until reinforced masonry members have hardened sufficiently to carry their own weight and other temporary loads that may be placed on them during construction.
- B. Placing Reinforcement: Comply with requirements in **ACI 530.1/ASCE 6/TMS 602**.
- C. Grouting: Do not place grout until entire height of masonry to be grouted has attained enough strength to resist grout pressure.
1. Comply with requirements in **ACI 530.1/ASCE 6/TMS 602** for cleanouts and for grout placement, including minimum grout space and maximum pour height.
 2. Limit height of vertical grout pours to not more than **60 inches**.

3.14 SPECIAL INSPECTIONS

- A. Special Inspections and tests shall be performed by the Special Inspector or Special Inspection Agency.
- B. Preconstruction Testing: Perform preconstruction testing as follows:
1. Concrete Masonry Unit Test: For each type of unit required, according to ASTM C 140 for compressive strength.
 2. Mortar Test (Property Specification): For each mix required, according to ASTM C 780 for compressive strength.
 3. Grout Test (Compressive Strength): For each mix required, according to ASTM C 1019.
- C. Construction Testing: Perform construction testing as follows:
1. Testing Frequency: One set of tests for each 5000 sq. ft. of wall area or portion thereof.
 2. Concrete Masonry Unit Test: For each type of unit provided, according to ASTM C 140 for compressive strength.
 3. Mortar Test (Property Specification): For each mix provided, according to ASTM C 780. Test mortar for compressive strength.
 4. Grout Test (Compressive Strength): For each mix provided, according to ASTM C 1019.
- D. Verification and inspection of masonry construction shall be Level 1 in accordance with Table 1704.5.1 of North Carolina State Building Code 2012 and as follows:

1. Perform periodic inspections of the installed masonry construction to verify compliance with the details shown on the construction documents such as use of proper mortar and grout, construction of mortar joints, size, location, spacing and lapping of reinforcing steel, installation of anchors into masonry construction.
2. Perform continuous inspections during grout placement to verify use of proper grout mix, locations of grout, cleanliness of grout spaces, cleanouts as required and proper consolidation of grout.
 - a. Begin masonry construction only after inspectors have verified proportions of site-prepared mortar.
 - b. Place grout only after inspectors have verified compliance of grout spaces and of grades, sizes, and locations of reinforcement.
 - c. Place grout only after inspectors have verified proportions of site-prepared grout.
- E. Correct deficiencies in Work that test reports and inspections indicate does not comply with the Contract Documents.
- F. Additional testing performed to determine compliance of corrected work with specified requirements shall be at Contractor's expense.

3.15 REPAIRING, POINTING, AND CLEANING

- A. Remove and replace masonry units that are loose, chipped, broken, stained, or otherwise damaged or that do not match adjoining units. Install new units to match adjoining units; install in fresh mortar, pointed to eliminate evidence of replacement.
- B. Pointing: During the tooling of joints, enlarge voids and holes, except weep holes, and completely fill with mortar. Point up joints, including corners, openings, and adjacent construction, to provide a neat, uniform appearance. Prepare joints for sealant application, where indicated.
- C. In-Progress Cleaning: Clean unit masonry as work progresses by dry brushing to remove mortar fins and smears before tooling joints.
- D. Final Cleaning: After mortar is thoroughly set and cured, clean exposed masonry as follows:
 1. Remove large mortar particles by hand with wooden paddles and nonmetallic scrape hoes or chisels.
 2. Test cleaning methods on sample wall panel; leave one-half of panel uncleaned for comparison purposes. Obtain Architect's approval of sample cleaning before proceeding with cleaning of masonry.
 3. Protect adjacent stone and non-masonry surfaces from contact with cleaner by covering them with liquid strippable masking agent or polyethylene film and waterproof masking tape.
 4. Wet wall surfaces with water before applying cleaners; remove cleaners promptly by rinsing surfaces thoroughly with clear water.
 5. Clean brick by bucket-and-brush hand-cleaning method described in BIA Technical Notes 20.
 6. Clean masonry with a proprietary acidic cleaner applied according to manufacturer's written instructions.
 7. Clean concrete masonry by cleaning method indicated in NCMA TEK 8-2A applicable to type of stain on exposed surfaces.
 8. Clean stone trim to comply with stone supplier's written instructions.
 9. Clean limestone units to comply with recommendations in ILI's "Indiana Limestone Handbook."

3.16 MASONRY WASTE DISPOSAL

- A. Salvageable Materials: Unless otherwise indicated, excess masonry materials are Contractor's property. At completion of unit masonry work, remove from Project site.
- B. Waste Disposal as Fill Material: Dispose of clean masonry waste, including excess or soil-contaminated sand, waste mortar, and broken masonry units, by crushing and mixing with fill material as fill is placed.
 1. Crush masonry waste to less than **4 inches** in each dimension.
 2. Mix masonry waste with at least two parts of specified fill material for each part of masonry waste. Fill material is specified in Division 31 Section "Earth Moving."

3. Do not dispose of masonry waste as fill within **18 inches** of finished grade.
- C. Excess Masonry Waste: Remove excess clean masonry waste that cannot be used as fill, as described above, and other masonry waste, and legally dispose of off Owner's property.

END OF SECTION 04 20 00

SECTION 09 68 13 - TILE CARPETING

PART 1 - GENERAL

1.1 RELATED DOCUMENTS

- A. Drawings and general provisions of the Contract, including General and Supplementary Conditions and Division 01 Specification Sections, apply to this Section.

1.2 SUMMARY

- A. This Section includes modular, fusion-bonded, tufted carpet tile.
- B. Related Sections include the following:
 - 1. Division 09 Section "Resilient Base and Accessories" for resilient wall base and accessories installed with carpet tile.

1.3 SUBMITTALS

- A. Product Data: For each type of product indicated. Include manufacturer's written data on physical characteristics, durability, and fade resistance. Include installation recommendations for each type of substrate.
- B. Shop Drawings: Show the following:
 - 1. Columns, doorways, enclosing walls, or partitions, built-in cabinets, and locations where cutouts are required in carpet tiles.
 - 2. Existing flooring materials to be removed.
 - 3. Existing flooring materials to remain.
 - 4. Carpet tile type, color, and dye lot.
 - 5. Type of subfloor.
 - 6. Type of installation.
 - 7. Pattern of installation.
 - 8. Pattern type, location, and direction.
 - 9. Pile direction.
 - 10. Type, color, and location of insets and borders.
 - 11. Type, color, and location of edge, transition, and other accessory strips.
 - 12. Transition details to other flooring materials.
- C. Samples: For each of the following products and for each color and texture required. Label each Sample with manufacturer's name, material description, color, pattern, and designation indicated on Drawings and in schedules.
 - 1. Carpet Tile: Full-size Sample.
 - 2. Exposed Edge, Transition, and other Accessory Stripping: **12-inch-** long Samples.
- D. Product Schedule: For carpet tile. Use same designations indicated on Drawings.
- E. Qualification Data: For Installer.
- F. Product Test Reports: Based on evaluation of comprehensive tests performed by a qualified testing agency.
- G. Maintenance Data: For carpet tiles to include in maintenance manuals. Include the following:
 - 1. Methods for maintaining carpet tile, including cleaning and stain-removal products and procedures and manufacturer's recommended maintenance schedule.
 - 2. Precautions for cleaning materials and methods that could be detrimental to carpet tile.
- H. Warranty: Special warranty specified in this Section.

1.4 QUALITY ASSURANCE

- A. Installer Qualifications: An experienced installer who is certified by the Floor Covering Installation Board or who can demonstrate compliance with its certification program requirements.
- B. Fire-Test-Response Characteristics: Provide products with the critical radiant flux classification indicated in Part 2, as determined by testing identical products per ASTM E 648 by an independent testing and inspecting agency acceptable to authorities having jurisdiction.
- C. Mockups: Before installing carpet tile, build mockups to verify selections made under sample submittals and to demonstrate aesthetic effects and set quality standards for materials and execution.
 - 1. Approved mockups may become part of the completed Work if undamaged at time of Substantial Completion.
- D. Preinstallation Conference: Conduct conference at Project site to comply with requirements in Division 01 Section "Project Management and Coordination." Review methods and procedures related to carpet tile installation including, but not limited to, the following:
 - 1. Review delivery, storage, and handling procedures.
 - 2. Review ambient conditions and ventilation procedures.
- E. Carpet submittals, actual products, and installation shall be tested by a 3rd party testing agency hired by the Owner. All documentation and materials shall be provided suitable for 3rd party testing. Carpet shall be tested for compliance with the standards and requirements of Term Contract No. 360A of the State of North Carolina Department of Administration Division and Purchase and Contract.

1.5 DELIVERY, STORAGE, AND HANDLING

- A. Comply with CRI 104, Section 5, "Storage and Handling."

1.6 PROJECT CONDITIONS

- A. Comply with CRI 104, Section 7.2, "Site Conditions; Temperature and Humidity" and Section 7.12, "Ventilation."
- B. Environmental Limitations: Do not install carpet tiles until wet work in spaces is complete and dry, and ambient temperature and humidity conditions are maintained at the levels indicated for Project when occupied for its intended use.
- C. Do not install carpet tiles over concrete slabs until slabs have cured and are sufficiently dry to bond with adhesive and concrete slabs have pH range recommended by carpet tile manufacturer.
- D. Where demountable partitions or other items are indicated for installation on top of carpet tiles, install carpet tiles before installing these items.

1.7 WARRANTY

- A. Special Warranty for Carpet Tiles: Manufacturer's standard form in which manufacturer agrees to repair or replace components of carpet tile installation that fail in materials or workmanship within specified warranty period.
 - 1. Warranty does not include deterioration or failure of carpet tile due to, vandalism, or abuse.
 - 2. Failures include, but are not limited to, more than 10 percent loss of face fiber, edge raveling, snags, runs, loss of tuft bind strength, dimensional stability, excess static discharge, and delamination.
 - 3. Warranty Period: Lifetime.

1.8 EXTRA MATERIALS

- A. Furnish extra materials described below, before installation begins, that match products installed and that are packaged with protective covering for storage and identified with labels describing contents.
1. Carpet Tile: Full-size units equal to 5 percent of amount installed for each type indicated, but not less than 10 sq. yd..

PART 2 - PRODUCTS

2.1 CARPET TILE

- A. Carpet Tile shall be listed and comply with the specified requirements of Term Contract 360A of the State of North Carolina Department of Administration Division of Purchase and Contract.
- B. Available Products: Subject to compliance with requirements, products that may be incorporated into the Work include the following:
1. Patcraft
 2. Interface
 3. Shaw Contract Group
 4. Cambridge
 5. Bolyu
 6. Mannington
 7. The Mohawk Company (including LEES, and Bigelow Brands)
 8. Milliken
- C. Carpet Type CPT-1:
1. Basis of design: Manufacturer: Interface
 - a. Collection Cubic "4287 - Shape", Style/Pattern "1380102500"
 2. Pile Construction/Surface: Multi-level pattern loop
 3. Pile Fiber and Type: eco solution q nylon or equal.
 4. Dye Method: 100% Solution Dyed
 5. Density: min 5,600
 6. Gage: 1/12"
 7. Stitches per Inch: min. 8
 8. Face Weight: min. 14 oz/yd²
 9. Protective Treatment: Manufacturer's recommended standard for product
 10. Size: 24" x 24" Tiles
 11. Warranty: Wearability - Lifetime
 12. ADA Compliance: Yes
 13. Installation Method: Non Directional
- D. Carpet Type CPT-2:
1. Basis of design: Manufacturer: Interface
 - a. Collection Cubic "4292 - Area", Style/Pattern "1380102500"
 2. Pile Construction/Surface: Tufted, Texture Loop
 3. Pile Fiber and Type: Aquafil econyl nylon type 6 or equal
 4. Dye Method: 100% Solution Dyed
 5. Density: min 7,400
 6. Gage: 1/12"
 7. Stitches per Inch: min. 8
 8. Face Weight: min. 16 oz/yd²
 9. Protective Treatment: Manufacturer's recommended standard for product
 10. Size: min. 19.7" x 19.7" Tiles, 24" x 24" tiles acceptable
 11. Warranty: Wearability - Lifetime
 12. ADA Compliance: Yes
 13. Installation Method: Non Directional

- E. Carpet Type CPT-3: Not Used

2.2 INSTALLATION ACCESSORIES

- A. Trowelable Leveling and Patching Compounds: Latex-modified, hydraulic-cement-based formulation provided or recommended by carpet tile manufacturer.
- B. Adhesives: Water-resistant, mildew-resistant, nonstaining, pressure-sensitive type to suit products and subfloor conditions indicated, that complies with flammability requirements for installed carpet tile and is recommended by carpet tile manufacturer for releasable installation.

PART 3 - EXECUTION

3.1 EXAMINATION

- A. Examine substrates, areas, and conditions, with Installer present, for compliance with requirements for maximum moisture content, alkalinity range, installation tolerances, and other conditions affecting carpet tile performance. Examine carpet tile for type, color, pattern, and potential defects.
- B. Concrete Subfloors: Verify that concrete slabs comply with ASTM F 710 and the following:
 - 1. Slab substrates are dry and free of curing compounds, sealers, hardeners, and other materials that may interfere with adhesive bond. Determine adhesion and dryness characteristics by performing bond and moisture tests recommended by carpet tile manufacturer.
 - 2. Subfloor finishes comply with requirements specified in Division 03 Section "Cast-in-Place Concrete" for slabs receiving carpet tile.
 - 3. Subfloors are free of cracks, ridges, depressions, scale, and foreign deposits.
- C. Proceed with installation only after unsatisfactory conditions have been corrected.

3.2 PREPARATION

- A. General: Comply with CRI 104, Section 6.2, "Site Conditions; Floor Preparation," and with carpet tile manufacturer's written installation instructions for preparing substrates indicated to receive carpet tile installation.
- B. Use trowelable leveling and patching compounds, according to manufacturer's written instructions, to fill cracks, holes, depressions, and protrusions in substrates. Fill or level cracks, holes and depressions **1/8 inch** wide or wider and protrusions more than **1/32 inch**, unless more stringent requirements are required by manufacturer's written instructions.
- C. Remove coatings, including curing compounds, and other substances that are incompatible with adhesives and that contain soap, wax, oil, or silicone, without using solvents. Use mechanical methods recommended in writing by carpet tile manufacturer.
- D. Clean metal substrates of grease, oil, soil and rust, and prime if directed by adhesive manufacturer. Rough sand painted metal surfaces and remove loose paint. Sand aluminum surfaces, to remove metal oxides, immediately before applying adhesive.
- E. Broom and vacuum clean substrates to be covered immediately before installing carpet tile.

3.3 INSTALLATION

- A. General: Comply with CRI 104, Section 14, "Carpet Modules," and with carpet tile manufacturer's written installation instructions.
- B. Installation Method: As recommended in writing by carpet tile manufacturer Glue down; install every tile with full-spread, releasable, pressure-sensitive adhesive.
- C. Maintain dye lot integrity. Do not mix dye lots in same area.

- D. Cut and fit carpet tile to butt tightly to vertical surfaces, permanent fixtures, and built-in furniture including cabinets, pipes, outlets, edgings, thresholds, and nosings. Bind or seal cut edges as recommended by carpet tile manufacturer.
- E. Extend carpet tile into toe spaces, door reveals, closets, open-bottomed obstructions, removable flanges, alcoves, and similar openings.
- F. Maintain reference markers, holes, and openings that are in place or marked for future cutting by repeating on finish flooring as marked on subfloor. Use nonpermanent, nonstaining marking device.
- G. Install pattern parallel to walls and borders.
- H. Stagger joints of carpet tiles so carpet tile grid is offset from access flooring panel grid. Do not fill seams of access flooring panels with carpet adhesive; keep seams free of adhesive.

3.4 INSTALLATION METHOD

- A. Confirm with Architect prior to installation whether tile is to be installed monolithic or quarter turn.

3.5 CLEANING AND PROTECTION

- A. Perform the following operations immediately after installing carpet tile:
 - 1. Remove excess adhesive, seam sealer, and other surface blemishes using cleaner recommended by carpet tile manufacturer.
 - 2. Remove yarns that protrude from carpet tile surface.
 - 3. Vacuum carpet tile using commercial machine with face-beater element.
- B. Protect installed carpet tile to comply with CRI 104, Section 16, "Protection of Indoor Installations."
- C. Protect carpet tile against damage from construction operations and placement of equipment and fixtures during the remainder of construction period. Use protection methods indicated or recommended in writing by carpet tile manufacturer.

END OF SECTION 09 68 13

SECTION 32 32 23 - GEOGRID INTERLOCKING CONCRETE RETAINING WALL

PART 1- GENERAL

1.1 SUMMARY

- A. Work shall consist of designing, furnishing and construction of a retaining wall as indicated on the drawings, equal to the basis of design: **KEYSTONE Standard II Unit Retaining Wall System, in accordance with these specifications and in reasonably close conformity with the lines, grades, design, and dimensions shown on the plans.**
- B. Work includes preparing foundation soil, furnishing and installing leveling pad, unit drainage fill and backfill to the lines and grades shown on the construction drawings.
- C. Work includes furnishing and installing geogrid soil reinforcement of the type, size, location, and lengths designated on the construction drawings.

1.2 RELATED SECTIONS

- A. Section 31 00 00 – Earthwork
- B. Section 01 41 00- Special Inspection Services

1.3 REFERENCE DOCUMENTS

- A. American Society for Testing and Materials (ASTM)
 - 1. ASTM C140 Sampling and Testing Concrete Masonry Units
 - 2. ASTM C1372 Specification for Dry-Cast Segmental Retaining Wall Units
 - 3. ASTM D422 Particle-Size Analysis of Soils
 - 4. ASTM D698 Laboratory Compaction Characteristics of Soil -Standard Effort
 - 5. ASTM D1557 Laboratory Compaction Characteristics of Soil -Modified Effort
 - 6. ASTM D3034 Polyvinyl Chloride Pipe (PVC)
 - 7. ASTM D4318 Liquid Limit, Plastic Limit and Plasticity Index of Soils
 - 8. ASTM D4475 Horizontal Shear Strength of Pultruded Reinforced Plastic Rods
 - 9. ASTM D4476 Flexural Properties of Fiber Reinforced Pultruded Plastic Rods
 - 10. ASTM D4595 Tensile Properties of Geotextiles - Wide Width Strip
 - 11. ASTM D5262 Unconfined Tension Creep Behavior of Geosynthetics
 - 12. ASTM D5818 Evaluate Installation Damage of Geosynthetics
 - 13. ASTM D6637 Tensile Properties of Geogrids – Single or Multi-Rib
 - 14. ASTM D6638 Connection Strength - Reinforcement/Segmental Units
 - 15. ASTM D6706 Geosynthetic Pullout Resistance in Soil
 - 16. ASTM D6916 Shear Strength Between Segmental Concrete Units
- B. American Association of State Highway and Transportation Officials (AASHTO)
 - 1. AASHTO M 252 Corrugated Polyethylene Drainage Pipe
 - 2. AASHTO M 288 Geotextile Specification for Highway Applications
- C. National Concrete Masonry Association (NCMA)
 - 1. NCMA SRWU-1 Test Method for Determining Connection Strength of SRW

2. NCMA SRWU-2 Test Method for Determining Shear Strength of SRW

1.4 SUBMITTALS/CERTIFICATION

- A. Contractor shall submit a Manufacturer's certification, prior to start of work, that the retaining wall system components meet the requirements of this specification and the structure design.
- B. Contractor shall submit construction drawings and design calculations for the retaining wall system prepared and stamped by a Professional Engineer registered in North Carolina. The engineering designs, techniques, and material evaluations shall be in accordance with the System Manufacturer's Design Manual.

1.5 QUALITY ASSURANCE

- A. Contractor shall submit a list of five (5) previously constructed projects of similar size and magnitude by the wall installer where the Standard or Compac retaining wall system has been constructed successfully. Contact names and telephone numbers shall be listed for each project.
- B. Contractor shall provide evidence that the design engineer has a minimum of five years of documental experience in the design for reinforced soil structures. The design engineer shall provide proof of current professional liability insurance with an aggregate coverage limit of not less than \$2,000,000.
- C. Owner shall/may provide soil testing and quality assurance inspection during earthwork and wall construction operations. Contractor shall provide any quality control testing or inspection not provided by the Owner. Owner's quality assurance program does not relieve the contractor of responsibility for quality control and wall performance.

1.6 DELIVERY, STORAGE AND HANDLING

- A. Contractor shall check all materials upon delivery to assure that the proper type, grade, color, and certification have been received.
- B. Contractor shall protect all materials from damage due to jobsite conditions and in accordance with manufacturer's recommendations. Damaged materials shall not be incorporated into the work.

PART 2 – PRODUCTS

2.1 MANUFACTURERS

- A. Manufacturers: Subject to compliance with requirements, available manufacturers offering products that may be incorporated into the Work include the following:
 - 1. Keystone Retaining Wall Systems. Basis of Design.
 - 2. Anchor Wall Systems.
 - 3. Allan Block.
 - 4. VERSA-LOK

2.2 DEFINITIONS

- A. Standard Unit - a concrete retaining wall element machine made from Portland cement, water, and aggregates.

- B. Structural Geogrid - a structural element formed by a regular network of integrally connected tensile elements with apertures of sufficient size to allow interlocking with surrounding soil, rock, or earth and function primarily as reinforcement.
- C. Unit Drainage Fill - drainage aggregate that is placed within and immediately behind the Geogrid interlocking concrete units.
- D. Reinforced Backfill - compacted soil that is placed within the reinforced soil volume as outlined on the plans.

2.3 GEOGRID INTERLOCKING CONCRETE RETAINING WALL UNITS

- A. Geogrid interlocking concrete units shall conform to the following architectural requirements:
 - 1. Face color - concrete gray, unless otherwise specified. The Owner may specify standard manufacturers' color.
 - 2. Face finish – hard split in angular tri-plane or straight face configuration. Other face finishes will not be allowed without written approval of Owner.
 - 3. Bond configuration - running with bonds nominally located at midpoint vertically adjacent units, in both straight and curved alignments.
 - 4. Exposed surfaces of units shall be free of chips, cracks or other imperfections when viewed from a distance of 10 feet under diffused lighting.
- B. Geogrid interlocking concrete materials shall conform to the requirements of ASTM C1372 - Standard Specifications for Segmental Retaining Wall Units.
- C. Geogrid interlocking concrete units shall conform to the following structural and geometric requirements measured in accordance with ASTM C140 Sampling and Testing Concrete Masonry Units:
 - 1. Compressive strength: ≥ 3000 psi (21 MPa);
 - 2. Absorption: ≤ 8 % for standard weight aggregates;
 - 3. Dimensional tolerances: $\pm 1/8$ " (3 mm) from nominal unit dimensions not including rough split face;
 - 4. Unit size: 8" (203 mm) (H) x 18" (457 mm)(W) x 18" (457 mm)(D) minimum;
 - 5. Unit weight: 90-lbs/unit (41 kg/unit) minimum for standard weight aggregates.
- D. Geogrid interlocking concrete units shall conform to the following performance testing:
 - 1. Inter-unit shear strength in accordance with ASTM D6916 (NCMA SRWU-2): 1500-plf (21 kN/m) minimum at 2-psi (13 kPa) normal pressure;
 - 2. Geogrid/unit peak connection strength in accordance with ASTM D6638 (NCMA SRWU-1): 900-plf (13 kN/m) minimum at 2-psi (13 kPa) normal force.
- E. Geogrid interlocking concrete units shall conform to the following constructability requirements:
 - 1. Vertical setback: $1/8$ " (3 mm) \pm per course (near vertical) or 1" (25 mm) + per course per the design;
 - 2. Alignment and grid positioning mechanism: fiberglass pins, two per unit;
 - 3. Horizontal gap between erected units shall be $\leq 1/2$ inch (13 mm).

2.4 SHEAR AND REINFORCEMENT PIN CONNECTORS

- A. Shear and reinforcement pin connectors shall be 1/2-inch (12 mm) diameter thermoset isophthalic polyester resin-pultruded fiberglass reinforcement rods to provide connection between vertically and horizontally adjacent units and the geosynthetic reinforcement, with the following requirements:
 - 1. Flexural Strength in accordance with ASTM D4476: 128,000 psi (882 MPa) minimum;
 - 2. Short Beam Shear in accordance with ASTM D4475: 6,400 psi (44 MPa) minimum.

- B. Shear and reinforcement pin connectors shall be capable of holding the geogrid in the proper design position during grid pre-tensioning and backfilling.

2.5 BASE LEVELING PAD MATERIAL

- A. Material shall consist of a compacted crushed stone base or non-reinforced concrete as shown on the construction drawings.

2.6 UNIT DRAINAGE FILL

- A. Unit drainage fill shall consist of clean 1" (25 mm) minus crushed stone or crushed gravel meeting the following gradation tested in accordance with ASTM D-422:

<u>Sieve Size</u>	<u>Percent Passing</u>
1 inch (25 mm)	100
3/4-inch (19 mm)	75-100
No. 4 (4.75 mm)	0 - 10
No. 50 (300um)	0 - 5

- B. Drainage fill shall be placed within the cores of, between, and behind the units as indicated on the design drawings. Not less than 1.2 cubic foot (0.033 m³), of drainage fill shall be used for each square foot (0.093 m²) of wall face unless otherwise specified.

2.7 REINFORCED BACKFILL

- A. Reinforced backfill shall be free of debris and meet the following gradation tested in accordance with ASTM D-422:

<u>Sieve Size</u>	<u>Percent Passing</u>
2 inch (50 mm)	100
3/4-inch (19 mm)	100-75
No. 40 (425 um)	0-60
No. 200 (75 um)	0-35

Plasticity Index (PI) <15 and Liquid Limit <40 per ASTM D-4318.

- B. The maximum aggregate size shall be limited to 3/4 inch (19 mm) unless installation damage tests have been performed to evaluate potential strength reductions to the geogrid design due to damage during construction.
- C. Material can be site-excavated soils where the above requirements can be met. Unsuitable soils for backfill (high plastic clays or organic soils) shall not be used in the backfill or in the reinforced soil mass.
- D. Contractor shall submit reinforced fill sample and laboratory test results to the Architect/Engineer for approval prior to the use of any proposed reinforced fill material.

2.8 GEOGRID SOIL REINFORCEMENT

- A. Geosynthetic reinforcement shall consist of geogrids manufactured specifically for soil reinforcement applications and shall be manufactured from high tenacity polyester yarn or high density polyethylene. Polyester geogrid shall be knitted from high tenacity polyester filament yarn with a molecular weight exceeding 25,000 g/m and a carboxyl end group values less than 30. Polyester geogrid shall be coated with an impregnated PVC coating that resists peeling, cracking, and stripping.
- B. Ta, Long Term Allowable Tensile Design Load, of the geogrid material shall be determined as follows:
- $Ta = Tult / (RFcr * RFd * RFid * FS)$
Ta shall be evaluated based on a 75-year design life.
1. Tult, Short Term Ultimate Tensile Strength shall be determined in accordance with ASTM D4595 or ASTM D6637.
Tult is based on the minimum average roll values (MARV).
 2. RFcr, Reduction Factor for Long Term Tension Creep
RFcr shall be determined from 10,000-hour creep testing performed in accordance with ASTM D5262. Reduction value = 1.45 minimum.
 3. RFd, Reduction Factor for Durability
RFd shall be determined from polymer specific durability testing covering the range of expected soil environments. RFd = 1.10 minimum.
 4. RFid, Reduction Factor for Installation Damage
RFid shall be determined from product specific construction damage testing performed in accordance with ASTM D5818. Test results shall be provided for each product to be used with project specific or more severe soil type. RFid = 1.05 minimum.
 5. FS, Overall Design Factor of Safety
FS shall be 1.5 unless otherwise noted for the maximum allowable working stress calculation.
- C. The maximum design tensile load of the geogrid shall not exceed the laboratory tested ultimate strength of the geogrid/facing unit connection divided by a factor of safety of 1.5. The connection strength testing and computation procedures shall be in accordance with ASTM D6638 Connection Strength between Geosynthetic Reinforcement and Segmental Concrete Units (NCMA SRWU-1).
- D. Soil Interaction Coefficient, Ci
Ci values shall be determined per ASTM D6706 at a maximum 0.75-inch (19 mm) displacement.
- E. Manufacturing Quality Control
The geogrid manufacturer shall have a manufacturing quality control program that includes QC testing by an independent laboratory.
The QC testing shall include:
Tensile Strength Testing
Melt Flow Index (HDPE)
Molecular Weight (Polyester)

2.9 DRAINAGE PIPE

- A. If required, the drainage pipe shall be perforated or slotted PVC pipe manufactured in accordance with ASTM D-3034 or corrugated HDPE pipe manufactured in accordance with AASHTO M252.

2.10 GEOTEXTILE FILTER FABRIC

- A. When required, geotextile filter fabric shall be a needle punched, nonwoven fabric that meets the requirements of AASHTO M288.

PART 3 - EXECUTION

3.1 EXCAVATION

- A. Contractor shall excavate to the lines and grades shown on the construction drawings. Owner's representative shall inspect the excavation and approve prior to placement of leveling material or fill soils. Proof roll foundation area as directed to determine if remedial work is required.
- B. Over-excavation and replacement of unsuitable foundation soils and replacement with approved compacted fill will be compensated as agreed upon with the Owner.

3.2 BASE LEVELING PAD

- A. Leveling pad material shall be placed to the lines and grades shown on the construction drawings, to a minimum thickness of 6 inches (150 mm) and extend laterally a minimum of 6" (150 mm) in front and behind the Geogrid interlocking wall unit.
- B. Soil leveling pad materials shall be compacted to a minimum of 95 % Standard Proctor density per ASTM D-698 or 92% Modified Proctor Density per ASTM D1557.
- C. Leveling pad shall be prepared to insure full contact to the base surface of the concrete units.

3.3 GEOGRID INTERLOCKING UNIT INSTALLATION

- A. First course of units shall be placed on the leveling pad at the appropriate line and grade. Alignment and level shall be checked in all directions and insure that all units are in full contact with the base and properly seated.
- B. Place the front of units side-by-side. Do not leave gaps between adjacent units. Layout of corners and curves shall be in accordance with manufacturer's recommendations.
- C. Install shear/connecting devices per manufacturer's recommendations.
- D. Place and compact drainage fill within and behind wall units. Place and compact backfill soil behind drainage fill. Follow wall erection and drainage fill closely with structure backfill.
- E. Maximum stacked vertical height of wall units, prior to unit drainage fill and backfill placement and compaction, shall not exceed two courses.

3.4 STRUCTURAL GEOGRID INSTALLATION

- A. Geogrid shall be oriented with the highest strength axis perpendicular to the wall alignment.

- B. Geogrid reinforcement shall be placed at the strengths, lengths, and elevations shown on the construction design drawings or as directed by the Engineer.
- C. The geogrid shall be laid horizontally on compacted backfill and attached to the Geogrid interlocking wall pins and within 1 inch of the face of the units. Place the next course of Geogrid interlocking concrete units over the geogrid. The geogrid shall be pulled taut, and anchored prior to backfill placement on the geogrid.
- D. Geogrid reinforcements shall be continuous throughout their embedment lengths and placed side-by-side to provide 100% coverage at each level. Spliced connections between shorter pieces of geogrid or gaps greater than 2 inches between adjacent pieces of geogrid are not permitted.

3.5 REINFORCED BACKFILL PLACEMENT

- A. Reinforced backfill shall be placed, spread, and compacted in such a manner that minimizes the development of slack in the geogrid and installation damage.
- B. Reinforced backfill shall be placed and compacted in lifts not to exceed 6 inches (150 mm) where hand compaction is used, or 8 - 10 inches (200 to 250 mm) where heavy compaction equipment is used. Lift thickness shall be decreased to achieve the required density as required.
- C. Reinforced backfill shall be compacted to a minimum of 95 % Standard Proctor density per ASTM D-698 or 92% Modified Proctor Density per ASTM D1557. The moisture content of the backfill material prior to and during compaction shall be uniformly distributed throughout each layer and shall be dry of optimum, + 0%, - 3%.
- D. Only lightweight hand-operated equipment shall be allowed within 3 feet (1 m) from the tail of the Geogrid interlocking concrete unit.
- E. Tracked construction equipment shall not be operated directly upon the geogrid reinforcement. A minimum fill thickness of 6 inches (150 mm) is required prior to operation of tracked vehicles over the geogrid. Tracked vehicle turning should be kept to a minimum to prevent tracks from displacing the fill and damaging the geogrid.
- F. Rubber tired equipment may pass over geogrid reinforcement at slow speeds, less than 10 MPH (15 KPH). Sudden braking and sharp turning shall be avoided.
- G. At the end of each day's operation, the Contractor shall slope the last lift of reinforced backfill away from the wall units to direct runoff away from wall face. The Contractor shall not allow surface runoff from adjacent areas to enter the wall construction site.

3.6 CAP INSTALLATION

- A. Cap units shall be glued to underlying units with an all-weather concrete construction adhesive.

3.7 AS-BUILT CONSTRUCTION TOLERANCES

- A. Vertical alignment: $\pm 1.5"$ (40 mm) over any 10' (3 m) distance.
- B. Wall Batter: within 2 degrees of design batter.

- C. Horizontal alignment: ± 1.5 " (40 mm) over any 10' (3 m) distance.
Corners, bends & curves: ± 1 foot (300 mm) to theoretical location.
- D. Maximum horizontal gap between erected units shall be 1/2 inch (13 mm).

3.8 FIELD QUALITY CONTROL

- A. Quality Assurance - The Owner shall/may engage inspection and testing services, including independent laboratories, to provide quality assurance and testing services during construction. This does not relieve the Contractor from securing the necessary construction quality control testing.
- B. Quality Assurance should include foundation soil inspection. Verification of geotechnical design parameters, and verification that the contractor's quality control testing is adequate as a minimum. Quality assurance shall also include observation of construction for general compliance with design drawings and project specifications. (*Quality Assurance is usually best performed by the site geotechnical engineer.*)
- C. Quality Control – The Contractor shall engage inspection and testing services to perform the minimum quality control testing described in the retaining wall design plans and specifications. Only qualified and experienced technicians and engineers shall perform testing and inspection services.
- D. Quality Control testing shall include soil and backfill testing to verify soil types and compaction and verification that the retaining wall is being constructed in accordance with the design plans and project specifications.

3.9 WASTE DISPOSAL

- B. Salvageable Materials: Unless otherwise indicated, excess materials are Contractor's property. At completion of retaining wall work, remove from Project site.
- C. Waste Disposal as Fill Material: Dispose of clean masonry unit waste, including excess or soil-contaminated sand, and broken masonry units, by crushing and mixing with fill material as fill is placed and as permitted by retaining wall system engineer's instruction.
 - 1. Crush masonry waste to less than 4 inches in each dimension.
 - 2. Mix masonry waste with at least two parts of specified fill material for each part of masonry waste.
 - 3. Do not dispose of masonry waste as fill within 18 inches of finished grade.
- D. Excess Masonry Waste: Remove all other waste that cannot be used as fill, as described above, and other masonry waste, and legally dispose of off Owner's property.

END OF SECTION 32 32 23

WALL TYPE LEGEND

MARKER	A	B	C	D	E	F	G	H	I	J	K	L
PLAN SYMBOL												
SECTION												
DESCRIPTION	8" CMU WALL UP TO BOTTOM OF DECK - SEE STRUCTURAL DRAWINGS FOR LOAD-BEARING LOCATIONS AND REQUIREMENTS NON-RATED	12" CMU WALL UP TO BOTTOM OF DECK - SEE STRUCTURAL DRAWINGS FOR LOAD-BEARING LOCATIONS AND REQUIREMENTS NON-RATED	3 5/8" METAL STUD WITH ONE LAYER 5/8" GYP BOARD EACH SIDE NON-RATED	8" CMU WALL ONE HOUR FIRE RATED UP TO BOTTOM OF DECK UL DESIGN #905 - 2 HOUR	8" CMU FIRE WALL (2) INDEPENDENT 2 HOUR FIRE RATED UP TO BOTTOM OF DECK UL DESIGN #905 - 2 HOUR	3 5/8" METAL STUD WITH ONE LAYER OF 5/8" GYP BOARD EACH SIDE UP TO 8" ABOVE CEILING UL DESIGN #419 - 1 HOUR	3 5/8" METAL STUD WITH 5/8" GYP BOARD ON ONE SIDE UP TO BOTTOM OF DECK NON-RATED	8" CMU WALL UP TO BOTTOM OF DECK WITH 4" FACE BRICK VENEER TO 8" ABOVE CEILING NON-RATED	8" CMU WALL ONE HOUR FIRE RATED UP TO BOTTOM OF DECK UL DESIGN #906 - SMOKE PARTITION	8" CMU WALL UP TO MIN. 8" ABOVE CEILING NON-RATED	6" METAL STUD WITH METAL CLADDING NON-RATED	6" CMU WALL TO BOTTOM OF DECK NON-RATED

MARKER	M	N	O	P
PLAN SYMBOL				
SECTION				
DESCRIPTION	8" METAL STUD WITH ONE LAYER 5/8" GYP BOARD EACH SIDE NON-RATED	6" METAL STUD WITH ONE LAYER 5/8" GYP BOARD EACH SIDE NON-RATED	6" METAL STUD WITH ONE LAYER 5/8" GYP BOARD EACH SIDE SMOKE PARTITION	8" METAL STUD WITH ONE LAYER OF 5/8" GYP BOARD EACH SIDE UP TO 8" ABOVE CEILING NON-RATED

NOTES:


- ALL CMU WALLS GOING UP TO BOTTOM OF DECK ARE TO PROVIDE A 1" GAP FOR DEFLECTION.
- FILL 1" GAP WITH MINERAL WOOL INSULATION ALONG THE ENTIRE LENGTH OF WALL.
- ON RATED WALLS SEAL ENDS WITH SPRAY APPLIED FIRE SEALANT BOTH SIDES ALONG THE ENTIRE LENGTH OF WALL.
- AT ALL METAL STUD WALLS TERMINATING AT BOTTOM OF DECK PROVIDE A DEFLECTION TRACK SECURED TO THE UNDERSIDE OF THE DECKING, NEST TOP TRACK BUT DO NOT ATTACH TO DEFLECTION TRACK.
- SEE FINISH SCHEDULE FOR WALL, FLOOR BASE AND CEILING TYPES AND FINISHES.
- REFER TO STRUCTURAL DRAWINGS FOR LOCATION OF REINFORCING, BOND BEAMS, BRACING, ETC.

ROOM LEGEND - 400 WING		
Number	Name	Area
400A	CORRIDOR	998 SF
400B	CORRIDOR	2253 SF
401	VESTIBULE	381 SF
402	MEN	173 SF
403	WOMEN	172 SF
404	JAN	77 SF
405	READING	251 SF
406	CLOSET	21 SF
407	READING	311 SF
408	CLOSET	21 SF
409	EXPLORATORY	1332 SF
410	MDF	127 SF
411	STORAGE	76 SF
412	MECHANICAL	1637 SF
413	8th LA/SS/MA	849 SF


ROOM LEGEND - 400 WING		
Number	Name	Area
414	8th LA/SS/MA	843 SF
415	STORAGE	402 SF
416	8th LA/SS/MA	843 SF
417	8th SCIENCE	1154 SF
418	7th LA/SS/MA	848 SF
419	TOILET	48 SF
420	TOILET	48 SF
421	7th SCIENCE PREP	299 SF
422	7th LA/SS/MA	838 SF
423	7th SCIENCE	1255 SF
424	RESOURCE	473 SF
425	7th LA/SS/MA	849 SF
427	MEN	171 SF
428	WOMEN	170 SF
429	RESOURCE	501 SF

ROOM LEGEND - 400 WING		
Number	Name	Area
455	READING	308 SF
456	READING	770 SF

ROOM LEGEND - 500 WING		
Number	Name	Area
500A	CORRIDOR	643 SF
500B	CORRIDOR	2016 SF
501	VESTIBULE	377 SF
502	WOMEN	170 SF
503	MEN	172 SF
504	JANITOR	55 SF
505	MEDIA WORKROOM	414 SF
506	STORAGE	182 SF
507	IDF	61 SF
508	COMPUTER	838 SF
509	OFFICE	151 SF
510	8th LA/SS/MA	848 SF
511	8th LA/SS/MA	847 SF
512	8th SCIENCE	1165 SF
513	MECHANICAL	1623 SF
514	8th SCIENCE PREP	299 SF
515	TOILET	49 SF
516	TOILET	49 SF
517	8th LA/SS/MA	824 SF
518	EXPLORATORY	1168 SF
519	7th LA/SS/MA	Not Placed
520	7th LA/SS/MA	Not Placed
521	7th LA/SS/MA	Not Placed
522	7th LA/SS/MA	Not Placed
530	LIBRARY	2606 SF
531	COMMONS	2762 SF
551	ELEV.	75 SF
552A	TEACHER RESOURCE	404 SF
552B	TEACHER RESOURCE	414 SF
553	STORAGE	186 SF

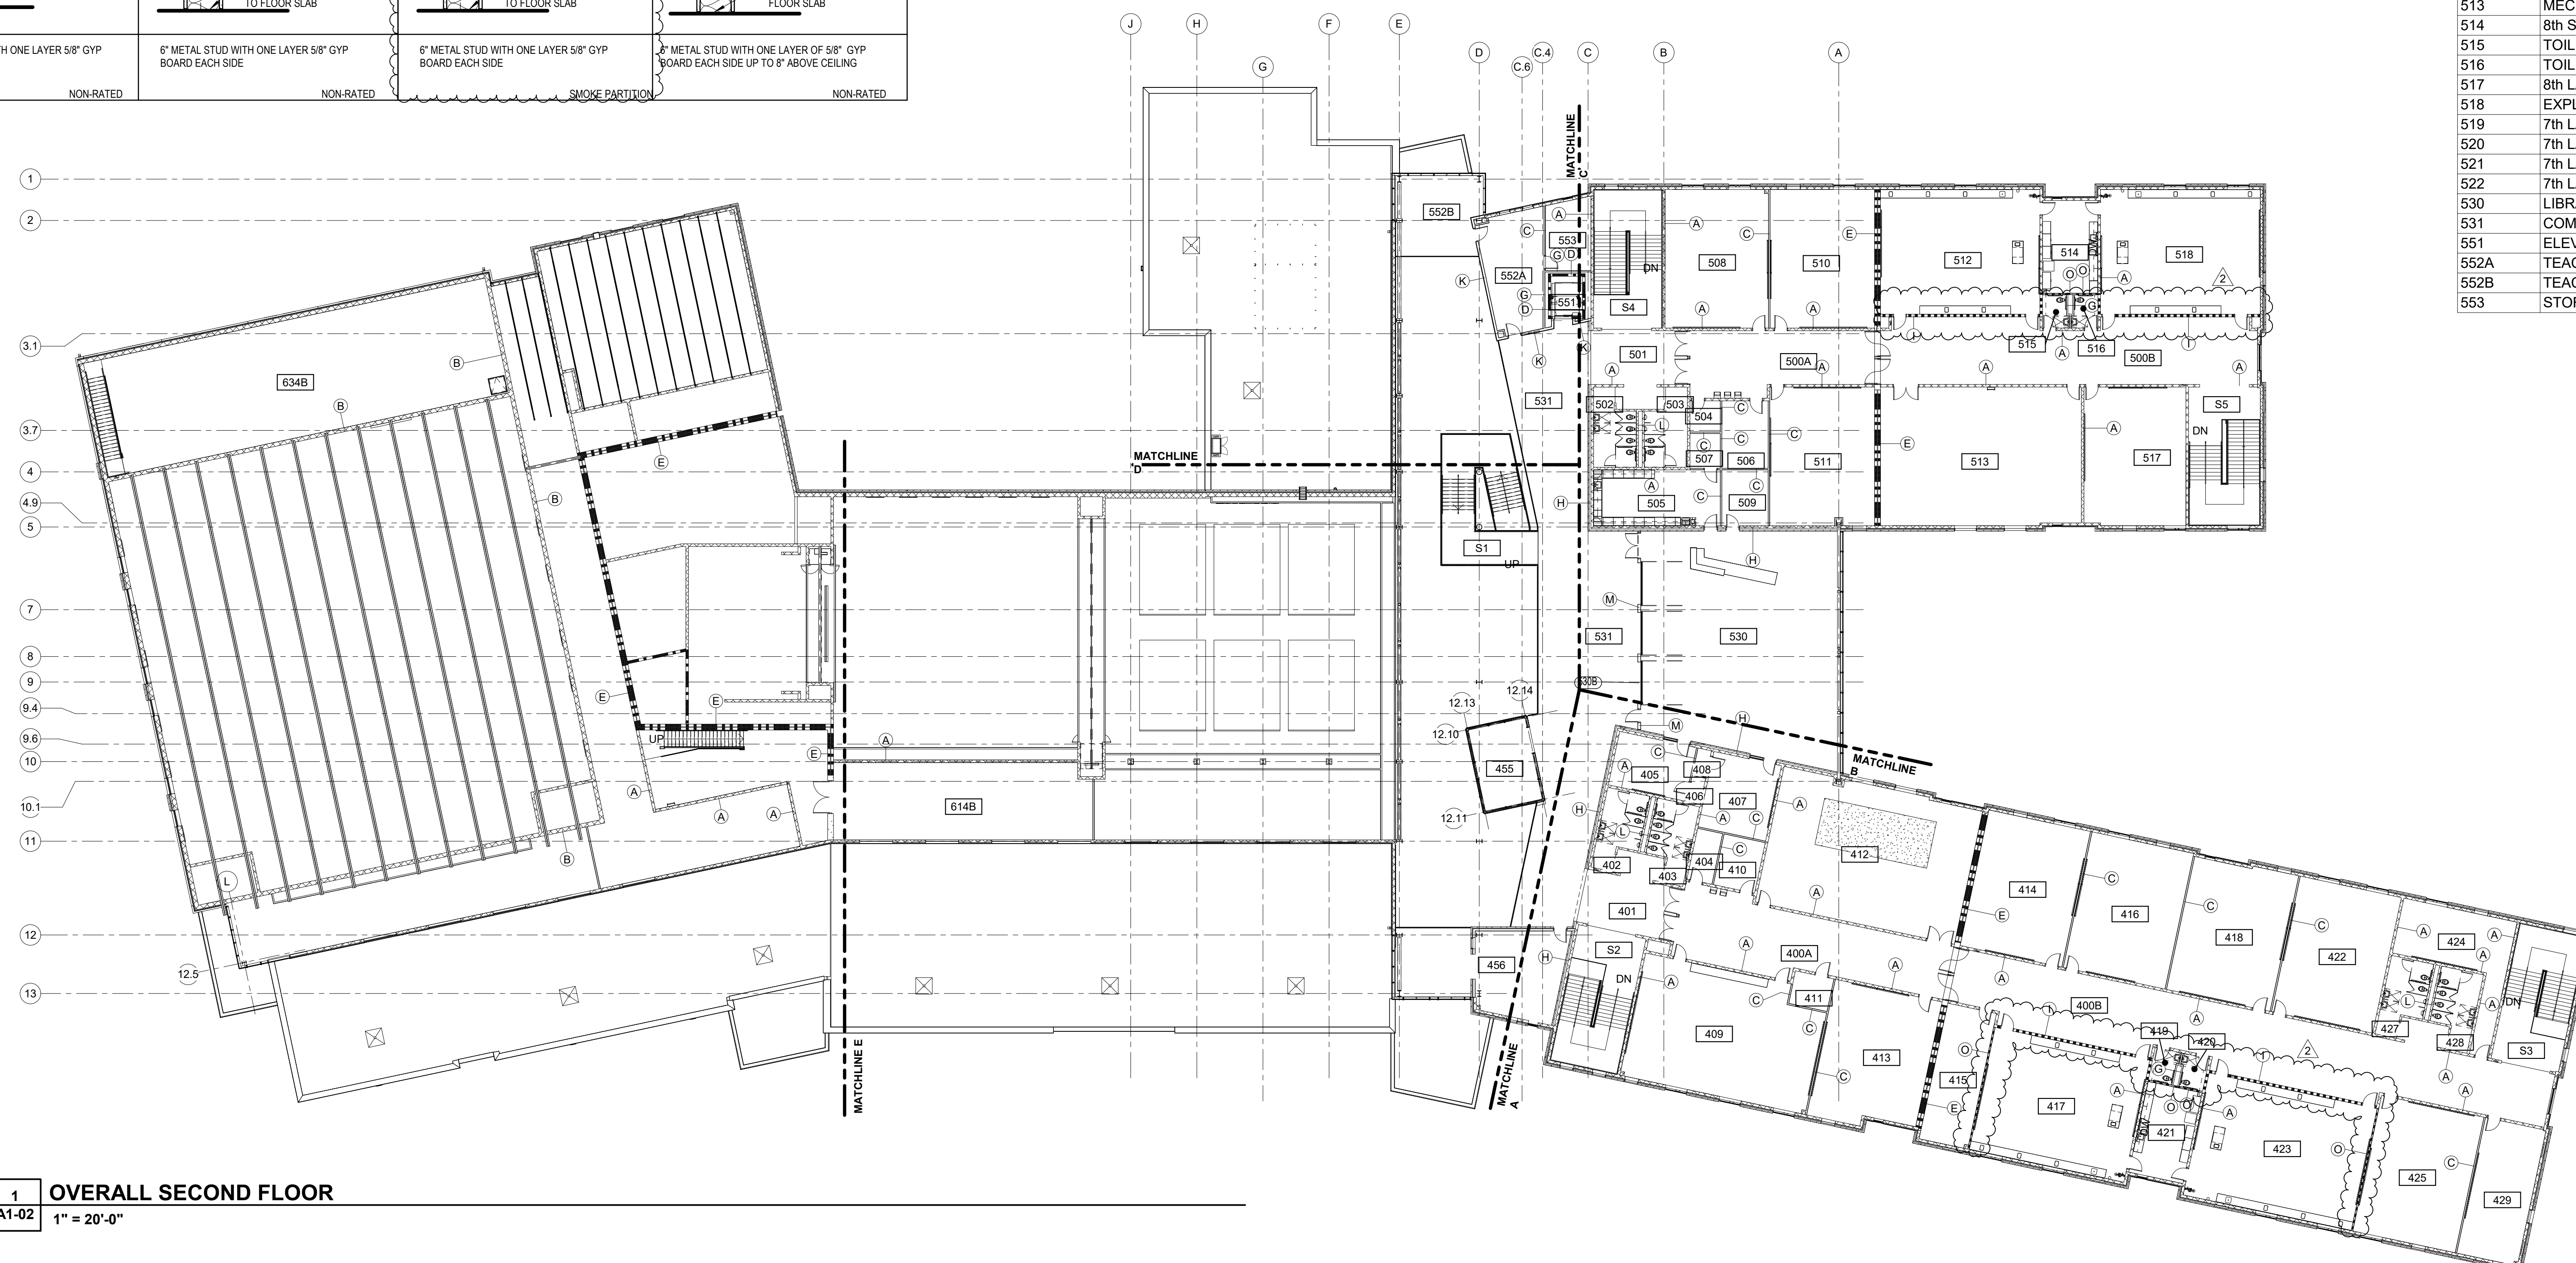

1 OVERALL SECOND FLOOR
A1-02 1" = 20'-0"

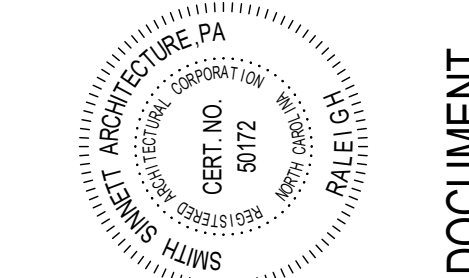


VOLUME I

The drawings on this sheet were prepared by Smith Sinnett Architecture, P.A., the reproduction or use of this project without the written consent of Smith Sinnett Architecture, P.A. is prohibited. Any infringement of the copyright rights in this drawing shall be subject to legal action. All copies of this drawing shall be made by Smith Sinnett Architecture at the completion of the contract.
Smith Sinnett Architecture, P.A., 2018
THIS DRAWING IS FORMATTED TO BE PRINTED ON A 30" X 42" SHEET

TRINITY MIDDLE SCHOOL
RANDOLPH COUNTY SCHOOL SYSTEM


Parcel PIN 7708118367
Surrett Drive
Trinity, NC 27370

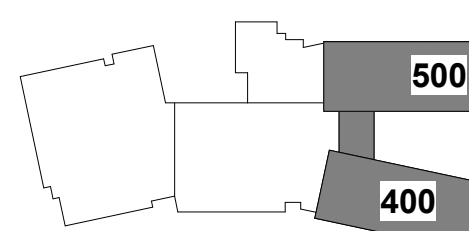

KEY PLAN
NO SCALE

6/14/19 ADDENDUM 3
ID DATE DESCRIPTION
DRAWN BY: LP, JS, DW
CHECKED BY: DW

OVERALL FLOOR
PLANS & WALL
TYPE LEGEND

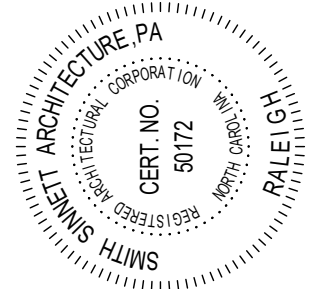

VOLUME I


The drawings on this sheet were prepared by Smith Sinnett Architecture, P.A. in the preparation of the project. The user of this drawing shall be responsible for the accuracy of the information. Any reproduction of this drawing without the written consent of Smith Sinnett Architecture, P.A. is prohibited. All rights reserved. Smith Sinnett Architecture, P.A. is not responsible for the accuracy of the information. All rights reserved. Smith Sinnett Architecture, P.A. is not responsible for the accuracy of the information. All rights reserved.

Smith Sinnett Architecture, P.A. 2018

THIS DRAWING IS CONTRACTED TO BE PRINTED ON A 30" X 42" SHEET

**TRINITY MIDDLE SCHOOL
RANDOLPH COUNTY SCHOOL SYSTEM**

Parcel PIN 7708118367
Surrett Drive
Trinity, NC 27370

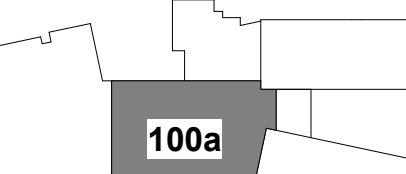

**KEY PLAN
NO SCALE**

ID	DATE	DESCRIPTION
1	6/14/19	ADDENDUM 3

DRAWN BY: LP, JS, DW
CHECKED BY: DW

FLOOR PLAN

GENERAL PLAN NOTES

- SEE WALL TYPES LEGEND ON SHEET A1-02 FOR TYPES INDICATED BY SYMBOL.
- ALL DOOR FRAMES SHALL BE 4" FROM THE FACE OF PERPENDICULAR WALLS UNLESS OTHERWISE INDICATED.
- ALL DIMENSIONS TAKEN FROM THE FINISHED FACE OF THE WALL (E.G. SURFACE OF CMU OR GYPSUM FOR STUD WALLS) AND THE CENTERLINE OF COLUMNS.
- ALL RATED WALL CONSTRUCTION TO COMPLY WITH U.L. REQUIREMENTS.
- REFER TO EXTERIOR ELEVATIONS FOR EXTERIOR MASONRY CONTROL FOR INTERIOR CONTROL JOINTS.
- ALL EXTERIOR WINDOWS TO RECEIVE BLINDS AS SPECIFIED. INTERIOR WINDOWS MARKED "BL" TO RECEIVE BLINDS.
- FURNISHINGS SHOWN WITH DASHED LINES NOT IN CONTRACT UNLESS OTHERWISE NOTED.
- PROVIDE 1" RADIUS BULLNOSE UP TO A HEIGHT OF 8" AT ALL OUTSIDE CMU CORNERS FOR INTERIOR WALLS.
- FIELD VERIFY AND COORDINATE FIELD CONDITIONS AND DIMENSIONS PRIOR TO FABRICATION, INSTALLATION AND CONSTRUCTION OF BUILDING COMPONENTS. THE GC IS TO INFORM THE ARCHITECT OF ANY DISCREPANCIES PRIOR TO PROCEEDING WITH THE WORK.
- FIRE RATED WALLS SHALL HAVE RATINGS STENCILED ABOVE THE CEILING FOR IDENTIFICATION. STENCIL LETTERS SHALL BE RED, 2" HIGH AT 10'-0" OC MAX ALONG WALL. IE "4 HR. RATED WALL". REFER TO GC-01 FOR STANDARD ABBREVIATIONS AND NOTATIONS.
- GENERAL CONTRACTOR SHALL PROVIDE LINTELS FOR MASONRY OPENINGS AND WALL PENETRATIONS AS SHOWN ON ALL DRAWINGS.
- DIMENSIONS FOR MASONRY OPENINGS ON PLANS ARE GIVEN AS "ROUGH" OPENINGS. GC AND ALL SUBCONTRACTORS RESPONSIBLE FOR FABRICATION OF BUILDING COMPONENTS TO ALLOW FOR SHIM AND INSULATION SPACE.
- NOTE SLAB DEPRESSIONS FOR TILE AND ATHLETIC FLOORS AS INDICATED BY PLAN KEYNOTES AND INDICATED ON STRUCTURAL DRAWINGS.
- ALL BLOCKING AND PLYWOOD UTILIZED SHALL BE FIRE RETARDANT TREATED WOOD.
- ALL RATED CMU WALLS TO BE D-2 CLASSIFIED CMU.
- ALL EXTERIOR CONCRETE WALKS TO BE BEDDED ON 4" OF #57 STONE ON COMPACTED SUBGRADE WITHIN 6'-0" OF THE BUILDING. ADJOINING WALKS ON COMPACTED SUBGRADE. SEE CIVIL DRAWINGS.
- GC SHALL PROVIDE FIRE RETARDANT 3/4" PLYWOOD TO MOUNT PANELS AND EQUIPMENT.
- ALL EXTERIOR STEEL COMPONENTS TO BE HOT-DIPPED GALVANIZED, INCLUDING BUT NOT LIMITED TO ALL EXTERIOR STAIR AND HANDRAIL GUARDRAIL COMPONENTS AND STEEL LINTELS.


PLAN KEYNOTES

- SLAB RECESSED IN THIS ROOM TO ACCOMMODATE SPECIALTY FLOORING - REFER TO FINISH PLAN. GC TO CONFIRM DEPTH OF RECESS WITH FLOORING MANUFACTURER PRIOR TO POURING THE SLAB.
- MECHANICAL LOUVER. REFER TO MECHANICAL DRAWINGS. GC TO COORDINATE OPENING SIZE AND PROVIDE LINTEL AND FLASHING.
- BUILDING EXPANSION JOINT. PROVIDE BLOCKOUTS IN SLAB FOR FLOOR TO FLOOR JOINTS; FLOOR TO FLOOR JOINTS: 2 HR. RATED 1" JOINT C/S GROUP MULTIFLEX MFX-1F OR EQUAL - - WALL TO WALL JOINTS: 2 HR. RATED 1" JOINT, C/S GROUP MULTIFLEX MFX-1FW OR EQUAL - WALL TO JOINT.
- ROLLING COUNTER DOOR. SEE SPECIFICATIONS.
- ADA ACTUATOR. ELECTRICAL CONTRACTOR PROVIDE BACKER BOXES AND CONDUIT. COORDINATE W/ GC & HARDWARE SUPPLIER.
- PROVIDE MAGNETIC DOOR HOLD OPENS FOR THIS DOOR ASSEMBLY. REFER TO ELECTRICAL DRAWINGS AND DOOR SCHEDULE FOR SPECIFICATIONS.
- GC TO PROVIDE BOND-BEAM LINTEL OVER THIS OPENING.
- PROVIDE MECHANICAL DOOR HOLD OPENS FOR THIS DOOR ASSEMBLY.
- RECESS FLOOR 4 1/4" - COORDINATE WITH COOLER/FREEZER UNIT MANUFACTURER PRIOR TO POURING SLABS AND NOTIFY ARCHITECT OF DISCREPANCIES.
- LADDER - MEANS OF ESCAPE FROM MECHANICAL PLATFORM ABOVE.
- ROOF ACCESS LADDER - REFER TO ROOF PLAN A1-40.
- 4" WIDE SELF-CLOSING SAFETY GATE PER OSHA REQUIREMENTS.
- SLOPE SLAB TO DRAIN. SEE STRUCTURAL DRAWINGS FOR MINIMUM CONCRETE COVERAGE AT DRAIN LOCATION(S).
- COLUMN FEATURE: COUNTER AND WRAP. REFER TO DETAIL 15A5-01.
- PIPE BOLLARD - SEE CIVIL DRAWINGS.
- OPERABLE PARTITION.
- NURSE EXAM CURTAIN.
- PROVIDE ELECTRONIC LOCKSET FOR SECURITY INTEGRATION THIS DOOR ASSEMBLY.


GENERAL EQUIPMENT SCHEDULE

Mark	Description and/or Detail Reference	Furnished By	Installed By	Remarks
1	MOTORIZED RECESSED PROJECTION SCREEN.	CFCI		
2	FIRE EXTINGUISHER AND SEMI-RECESSED FIRE EXT. CABINET. REFER TO TYPICAL DETAIL 61A5-01.	CFCI		
3	FIRE EXTINGUISHER AND FIRE EXT. BRACKET. REFER TO TYPICAL DETAILS 61A5-01.	CFCI		
4	COPY MACHINE	OFOI		
5	METAL LOCKER SYSTEM. REFER TO DETAIL 11A4-02. COLOR AS SELECTED BY ARCHITECT.	CFCI		
6	12"-0" TACK STRIP. REFER TO SPECIFICATIONS.	CFCI		
7	WALL MOUNTED ROOF ACCESS LADDER AND ROOF ACCESS HATCH. REFER TO DETAIL 61A5-40.	CFCI		
8	12"-0" MARKER BOARD. 6"-0" TACKBOARD. REFER TO SPECIFICATIONS.	CFCI		
9	6"-0" MARKER BOARD. REFER TO SPECIFICATIONS.	CFCI		
10	8"-0" MARKER BOARD. REFER TO SPECIFICATIONS.	CFCI		
11	12"-0" MARKER BOARD. REFER TO SPECIFICATIONS.	CFCI		
12	16"-0" MARKER BOARD. REFER TO SPECIFICATIONS.	CFCI		
13	3"-0" TACKBOARD. REFER TO SPECIFICATIONS.	CFCI		
14	4"-0" TACKBOARD. REFER TO SPECIFICATIONS.	CFCI		
15	8"-0" SMART BOARD.	OFOI		
16	FULL SIZED REFRIGERATOR. 21.7 CUBIC FT. COORDINATE WITH PLUMBING AND ELECTRICAL.	OFOI		
17	MICROWAVE. COORDINATE W/ ELECTRICAL.	OFOI		
18	PREMANUFACTURED OPEN WOOD SHELVING UNITS. REFER TO TYPICAL DETAIL 41A4-01.	OFOI		
19	LAPTOP STORAGE CART	OFOI		
20	TALL TEACHER WARDROBE. SIZE - 24D X 84H X 36W	CFCI		
21	MOBILE SHEET LIBRARY AND SORTING RACK CABINET - 24D X 36H X 48W	OFOI		
22	30"X60" INSTRUCTOR'S DESK W/ SINK	CFCI		
23	ELECTRIC KILN, 6.4 CUBIC FOOT FIRING CHAMBER. WITH DOWN DRAFT VENTILATION SYSTEM AND KILN SHELVES. SKUTT OR EQUAL. 6.4 CF FIRING CHAMBER.	CFCI		
24	ATHLETIC WASHER AND DRYER ASSEMBLY BY OWNER.	OFOI		
25	UTILITY SINK BASIN WITH SUPPORT LEGS. REFER TO PLUMBING DRAWINGS.	CFCI	3	
26	FABRIC COVERED ACOUSTICAL WALL PANELS. CONSULT W/ ARCHITECT FOR FINAL LAYOUT. SEE SPECIFICATIONS.	CFCI	2	
27	WASHER AND DRYER ASSEMBLY BY OWNER.	OFOI	2	


- SCHEDULE ABBREVIATIONS**
- CFCI- CONTRACTOR FURNISHED CONTRACTOR INSTALLED
 - OFOI- OWNER FURNISHED CONTRACTOR INSTALLED
 - OFOI- OWNER FURNISHED OWNER INSTALLED
- NOTES**
- GC TO PROVIDE 3/4" FIRE RETARDANT PLYWOOD PANEL TO MOUNT EQUIPMENT.
 - GC TO PROVIDE NECESSARY BLOCKING & REINFORCING PLATES IN G/W WALLS & REINFORCING IN CMU WALLS.
 - PROVIDE CLAY SINK TRAP THIS LOCATION. SEE PLUMBING DRAWINGS.

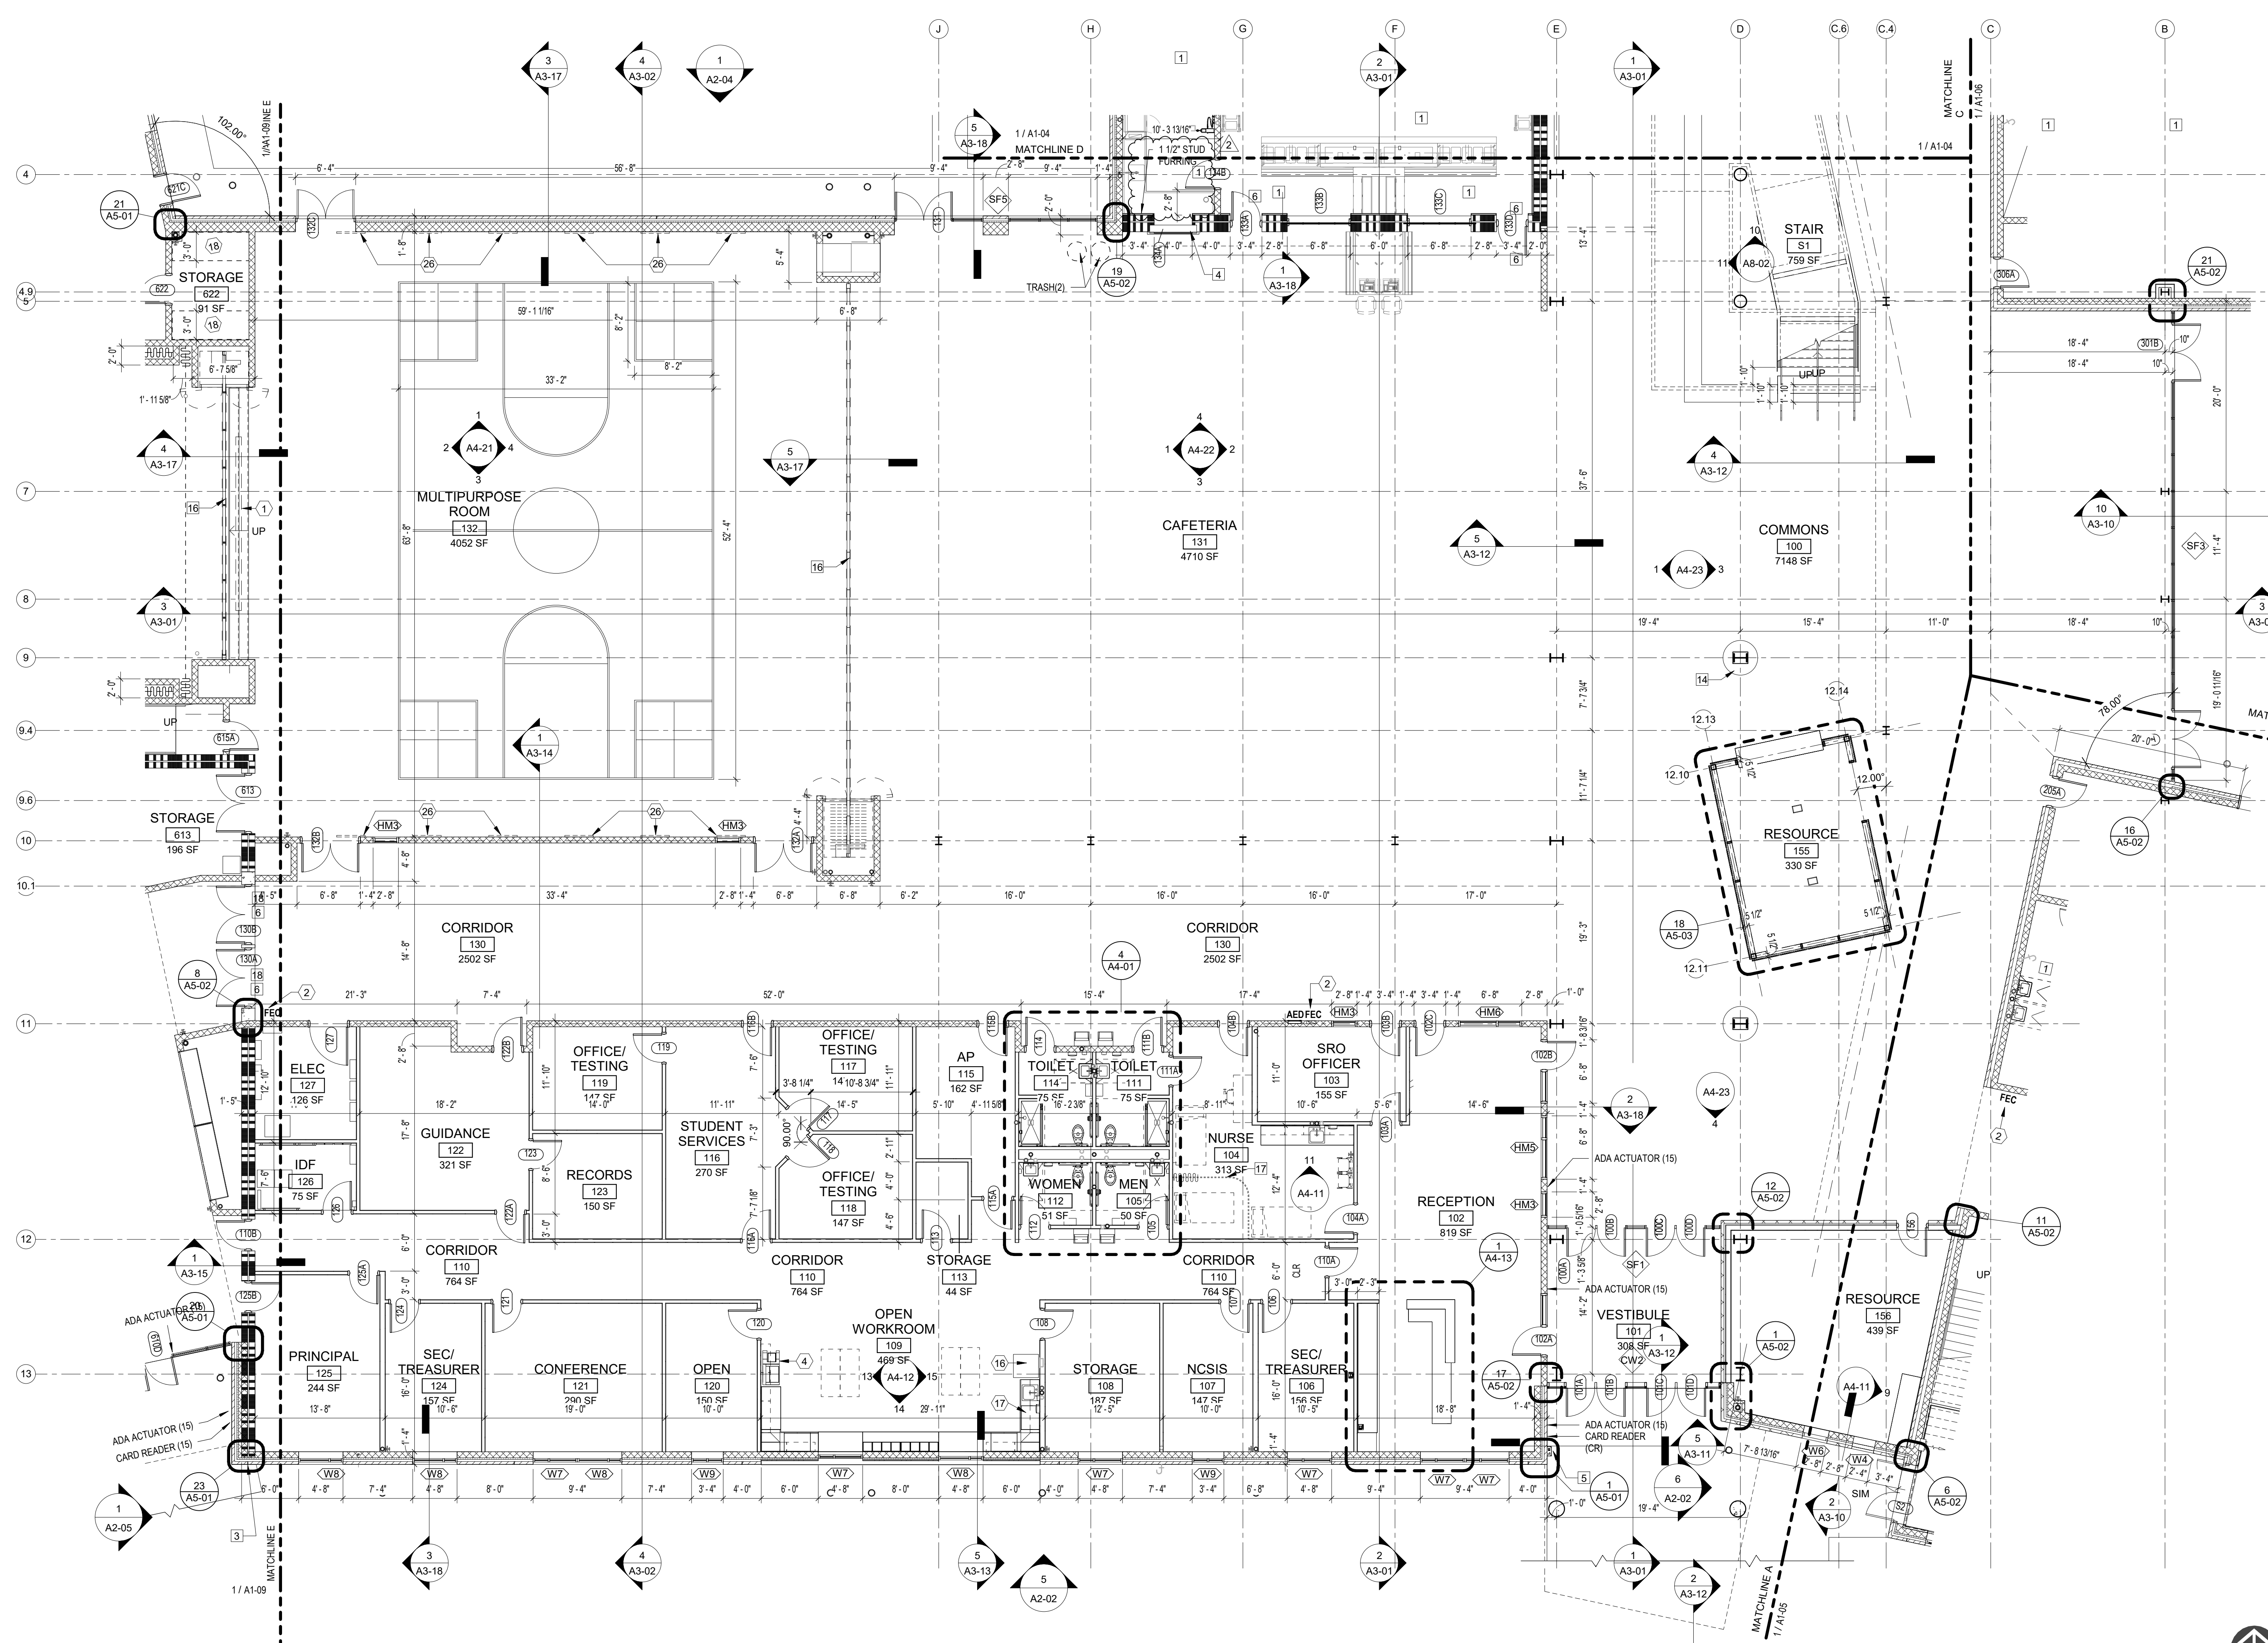


1 100A WING - FIRST FLOOR PLAN
A1-03 1/8" = 1'-0"

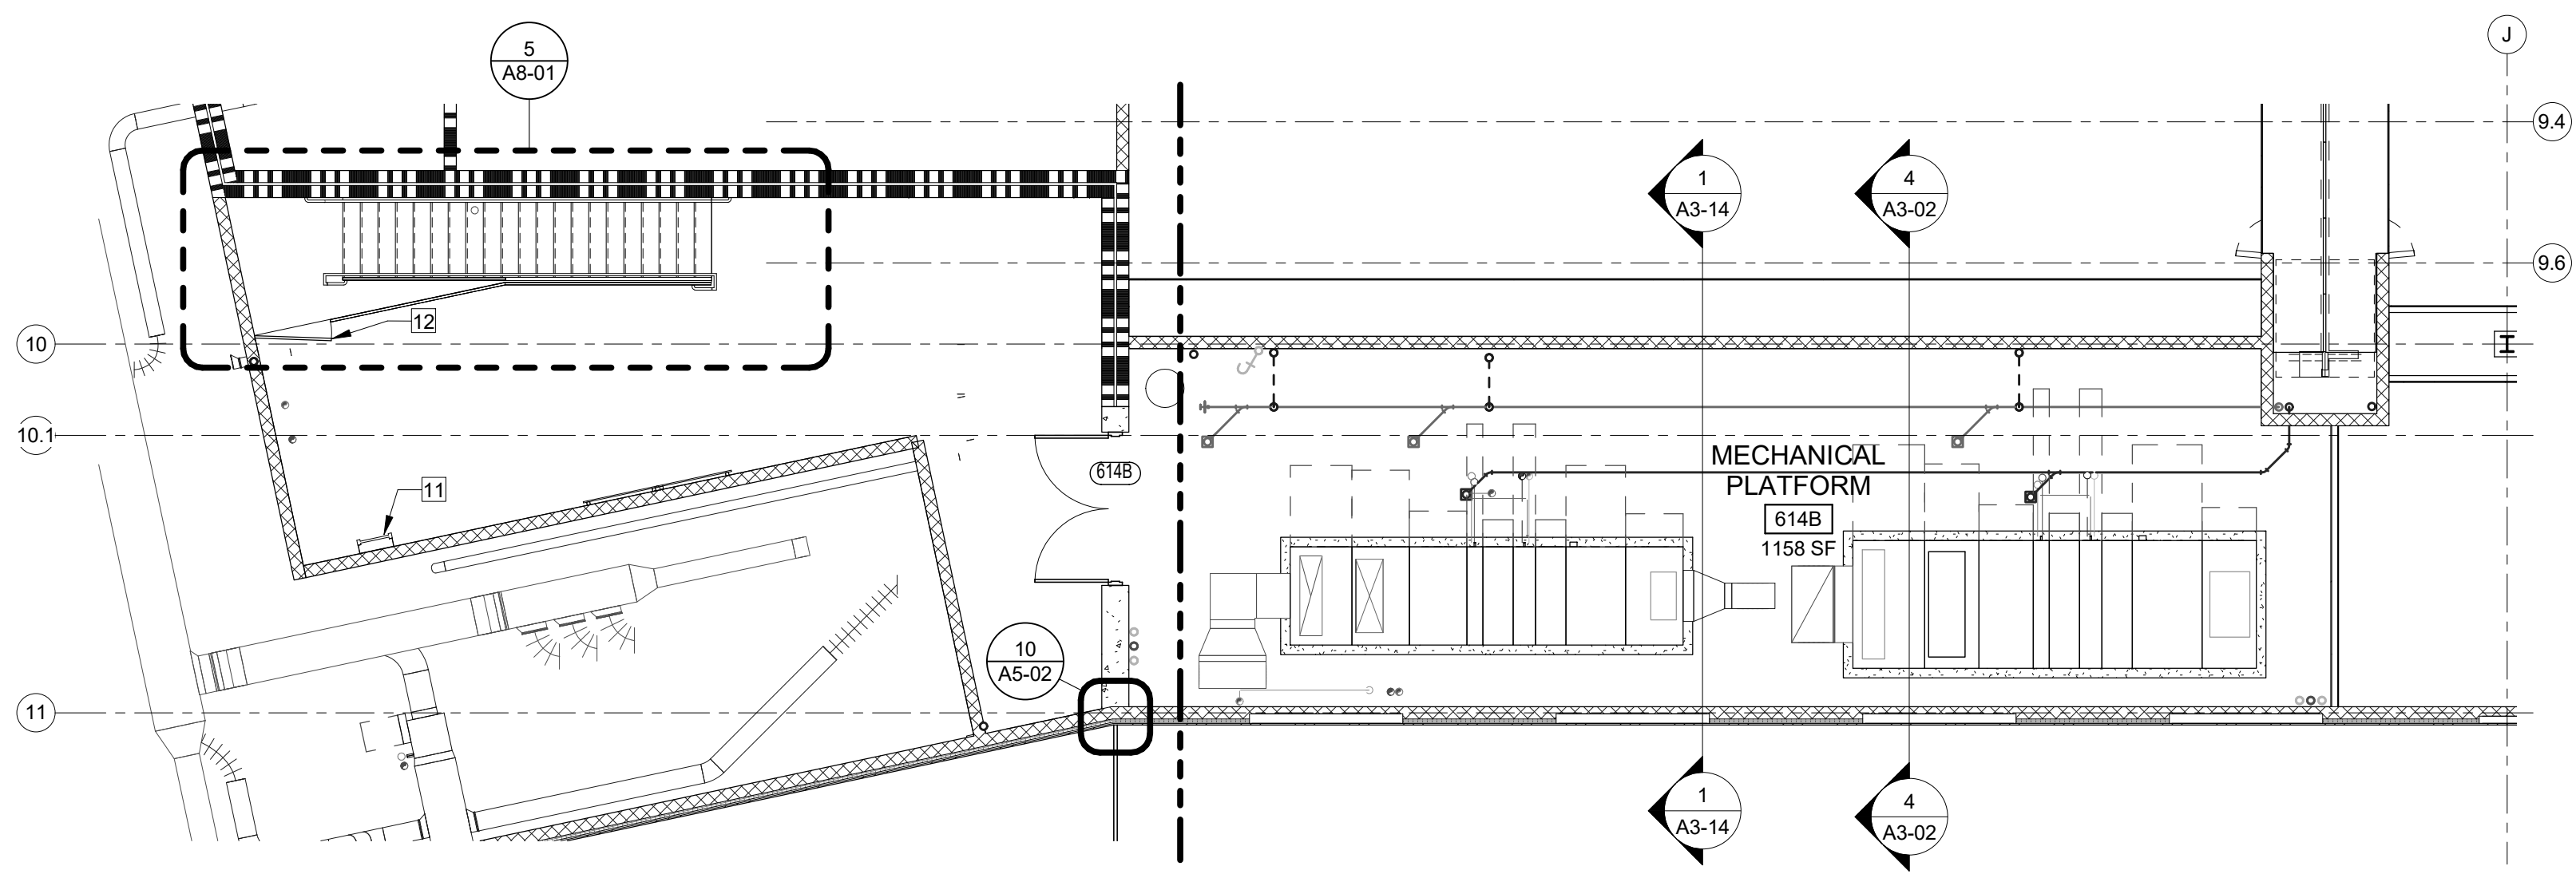

4 100A WING - MECHANICAL PLATFORM
A1-04 1/8" = 1'-0"

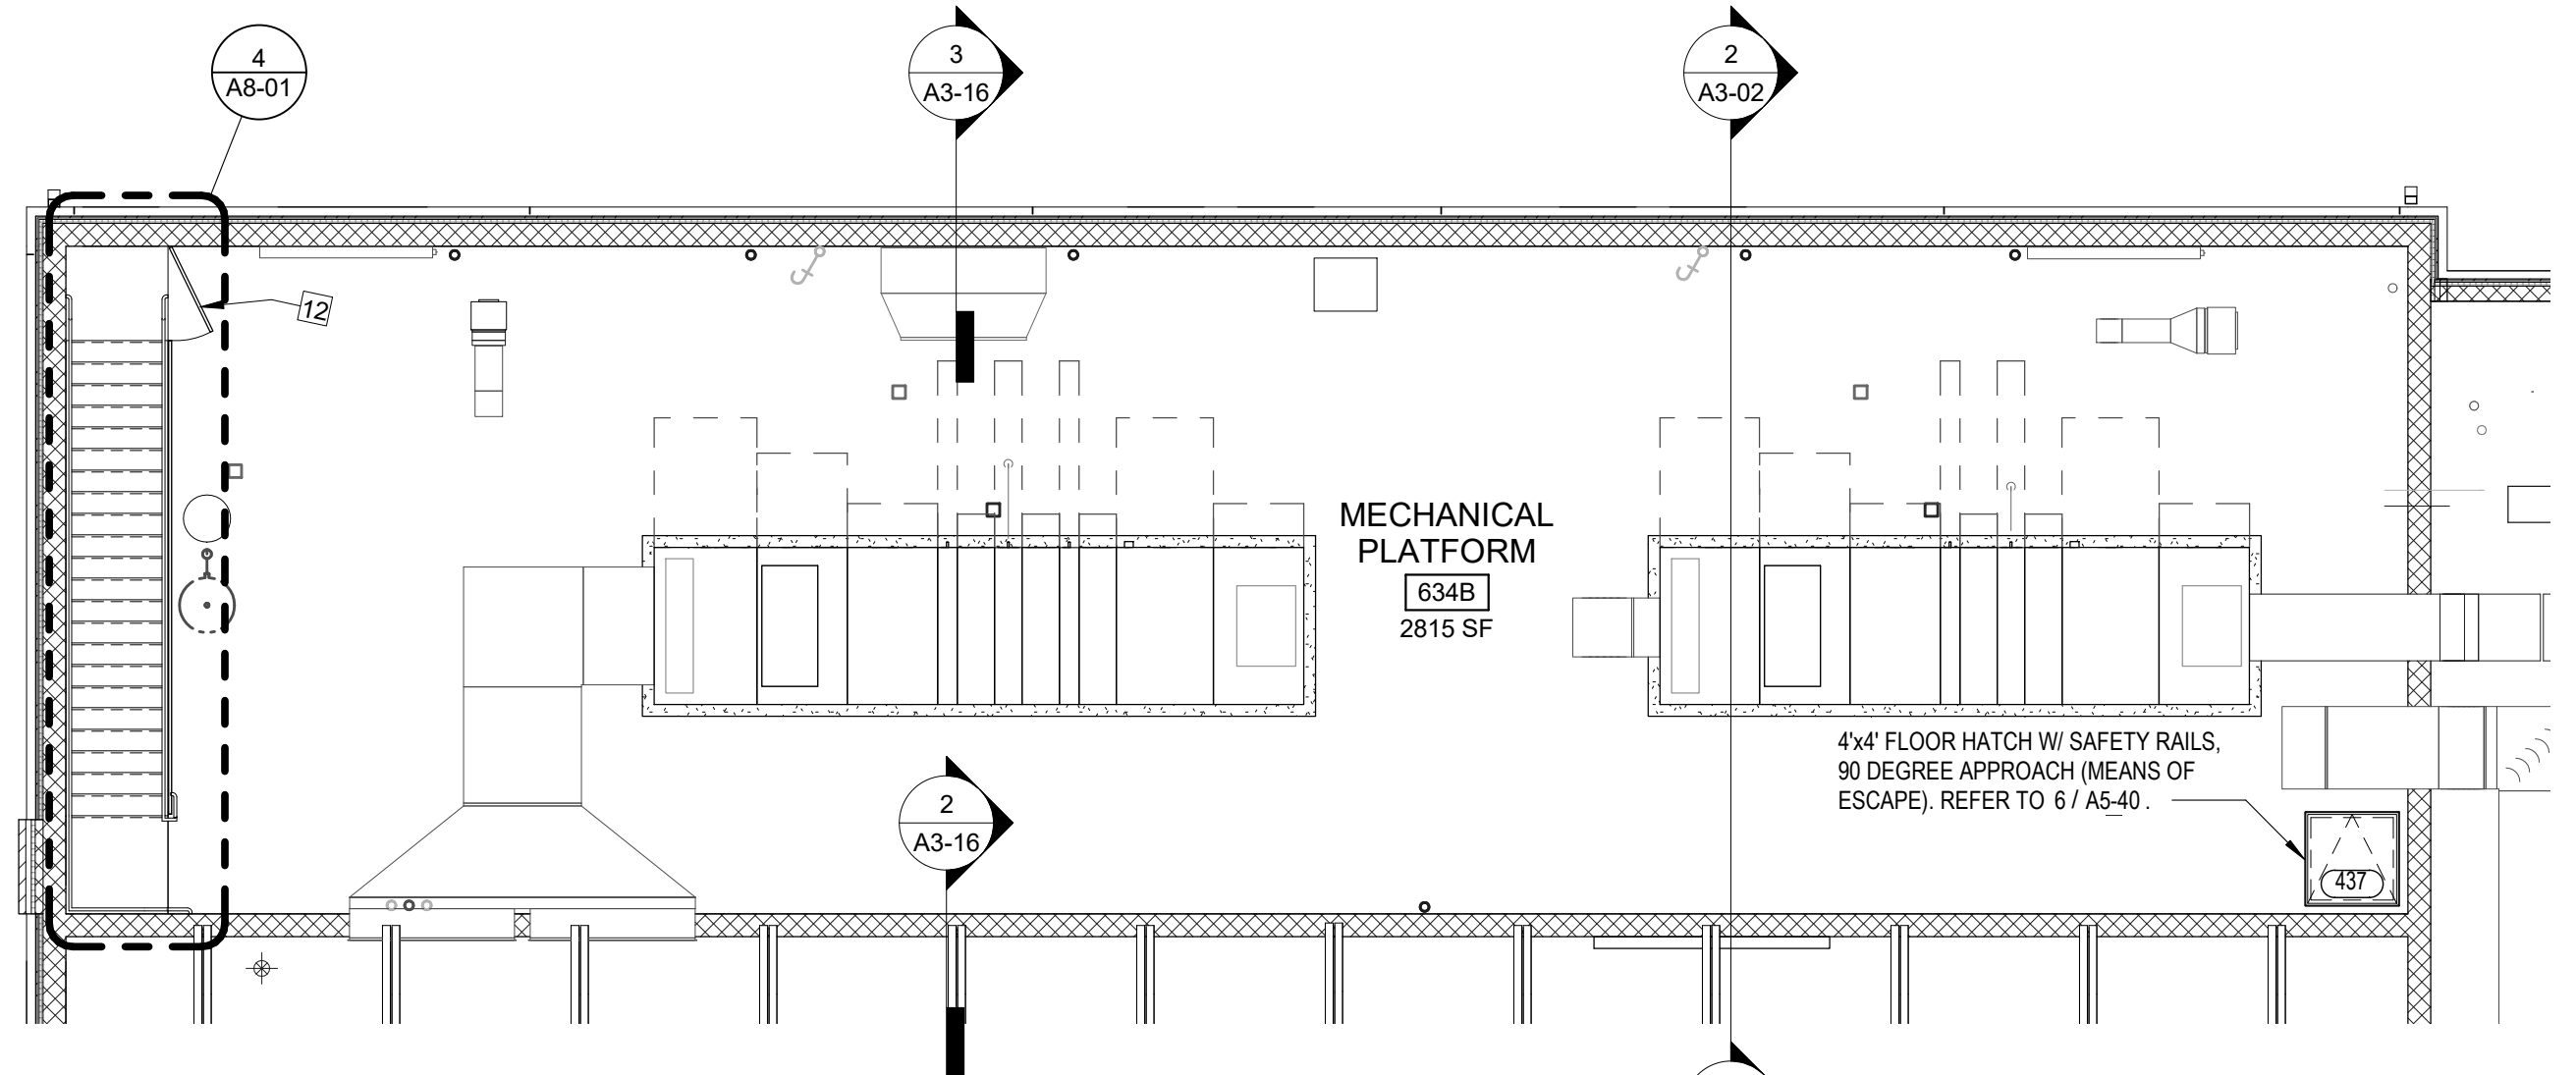

3 600 WING - MECHANICAL PLATFORM
A1-04 1/8" = 1'-0"

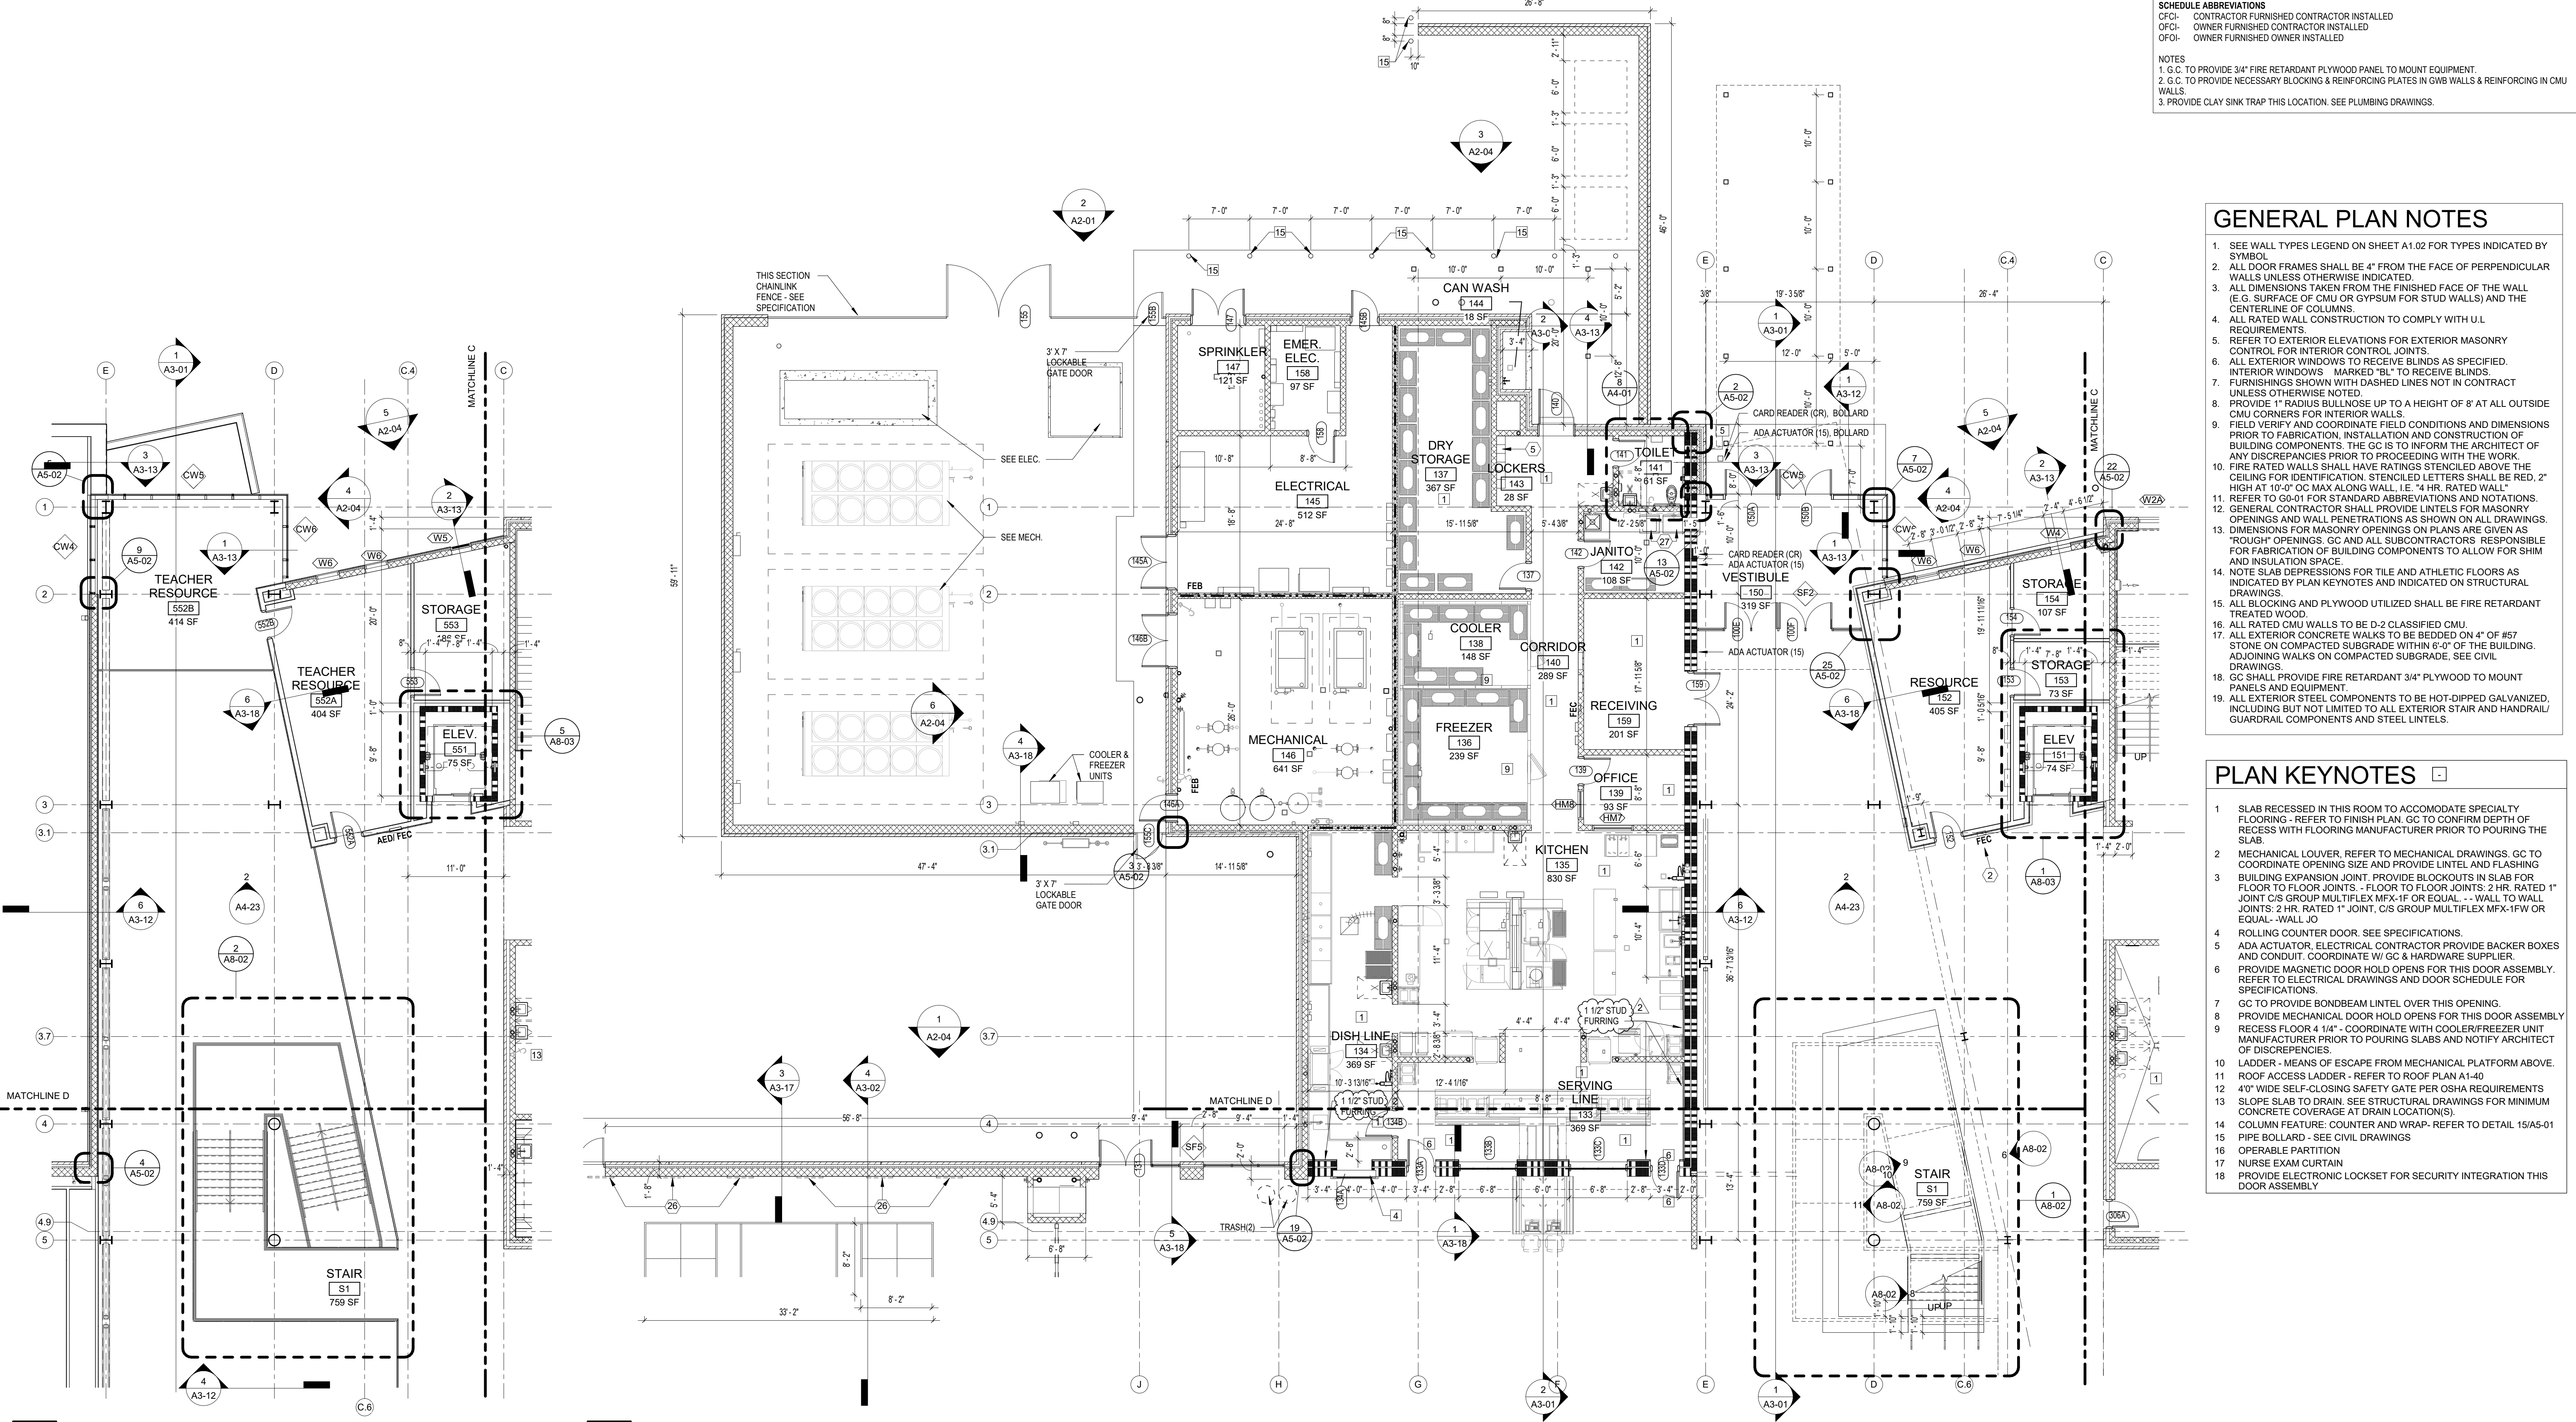

2 100B WING - SECOND FLOOR
A1-04 1/8" = 1'-0"

1 100B WING - FIRST FLOOR PLAN
A1-04 1/8" = 1'-0"

GENERAL EQUIPMENT SCHEDULE

Mark	Description and/or Detail Reference	Furnished By	Installed By	Remarks
1	MOTORIZED RECESSED PROJECTION SCREEN	CFCI		
2	FIRE EXTINGUISHER AND SEMI-RECESSED FIRE EXT. CABINET. REFER TO TYPICAL DETAIL 6/A5-01	CFCI		
3	FIRE EXTINGUISHER AND FIRE EXT. BRACKET. REFER TO TYPICAL DETAILS 6/A5-01	CFCI		
4	COPY MACHINE	OFOI		
5	METAL LOCKER SYSTEM. REFER TO DETAIL 11/A4-02. COLOR AS SELECTED BY ARCHITECT.	CFCI		
6	12'-0" TACK STRIP. REFER TO SPECIFICATIONS.	CFCI		
7	WALL MOUNTED ROOF ACCESS LADDER AND ROOF ACCESS HATCH. REFER TO DETAIL 6/A5-02	CFCI		
8	12'-0" MARKER BOARD, 6'-0" TACKBOARD. REFER TO SPECIFICATIONS.	CFCI		
9	6'-0" MARKER BOARD. REFER TO SPECIFICATIONS.	CFCI		
10	8'-0" MARKER BOARD. REFER TO SPECIFICATIONS.	CFCI		
11	12'-0" MARKER BOARD. REFER TO SPECIFICATIONS.	CFCI		
12	16'-0" MARKER BOARD. REFER TO SPECIFICATIONS.	CFCI		
13	3'-0" TACKBOARD. REFER TO SPECIFICATIONS.	CFCI		
14	4'-0" TACKBOARD. REFER TO SPECIFICATIONS.	CFCI		
15	8'-0" SMART BOARD	OFOI		
16	FULL SIZE REFRIGERATOR, 21.7 CUBIC FT. COORDINATE WITH PLUMBING AND ELECTRICAL.	OFOI		
17	MICROWAVE, COORDINATE W/ ELECTRICAL.	OFOI		
18	PREMANUFACTURED OPEN WOOD SHELVING UNITS, REFER TO TYPICAL DETAIL 4/A4-01	OFOI		
19	LAPTOP STORAGE CART	OFOI		
20	TALL TEACHER WARDROBE, SIZE - 24D X 84H X 36W	CFCI		
21	MOBILE SHEET LIBRARY AND SORTING RACK CABINET - 24D X 36H X 48W	OFOI		
22	30"x60" INSTRUCTOR'S DESK W/ SINK	CFCI		
23	ELECTRIC KILN, 6.4 CUBIC FOOT FIRING CHAMBER, WITH DOWN DRAFT VENTILATION SYSTEM AND KILN SHELVES. SKUTT OR EQUAL, 6.4 CF FIRING CHAMBER.	CFCI		
24	ATHLETIC WASHER AND DRYER ASSEMBLY BY OWNER.	OFOI		
25	UTILITY SINK BASIN WITH SUPPORT LEGS. REFER TO PLUMBING DRAWINGS.	CFCI	3	
26	FABRIC COVERED ACOUSTICAL WALL PANELS, CONSULT W/ ARCHITECT FOR FINAL LAYOUT. SEE SPECIFICATIONS.	CFCI	2	
27	WASHER AND DRYER ASSEMBLY BY OWNER	OFOI	2	

SCHEDULE ABBREVIATIONS
CFCI- CONTRACTOR FURNISHED CONTRACTOR INSTALLED
OFCI- OWNER FURNISHED CONTRACTOR INSTALLED
OFOI- OWNER FURNISHED OWNER INSTALLED

NOTES
1. G.C. TO PROVIDE 3/4" FIRE RETARDANT PLYWOOD PANEL TO MOUNT EQUIPMENT.
2. G.C. TO PROVIDE NECESSARY BLOCKING & REINFORCING PLATES IN GWB WALLS & REINFORCING IN CMU WALLS
3. PROVIDE CLAY SINK TRAP THIS LOCATION. SEE PLUMBING DRAWINGS.

GENERAL PLAN NOTES

- SEE WALL TYPES LEGEND ON SHEET A1-02 FOR TYPES INDICATED BY SYMBOL
- ALL DOOR FRAMES SHALL BE 4" FROM THE FACE OF PERPENDICULAR WALLS UNLESS OTHERWISE INDICATED.
- ALL DIMENSIONS TAKEN FROM THE FINISHED FACE OF THE WALL (E.G. SURFACE OF CMU OR GYPSUM FOR STUD WALLS) AND THE CENTERLINE OF COLUMNS.
- ALL RATED WALL CONSTRUCTION TO COMPLY WITH U.I. REQUIREMENTS.
- REFER TO EXTERIOR ELEVATIONS FOR EXTERIOR MASONRY CONTROL FOR INTERIOR CONTROL JOINTS.
- ALL EXTERIOR WINDOWS TO RECEIVE BLINDS AS SPECIFIED. INTERIOR WINDOWS MARKED "BI" TO RECEIVE BLINDS.
- FURNISHINGS SHOWN WITH DASHED LINES NOT IN CONTRACT UNLESS OTHERWISE NOTED.
- PROVIDE 1" RADIUS BULLNOSE UP TO A HEIGHT OF 8" AT ALL OUTSIDE CMU CORNERS FOR INTERIOR WALLS.
- FIELD VERIFY AND COORDINATE FIELD CONDITIONS AND DIMENSIONS PRIOR TO FABRICATION. INSTALLATION AND CONSTRUCTION OF BUILDING COMPONENTS. THE GC IS TO INFORM THE ARCHITECT OF ANY DISCREPANCIES PRIOR TO PROCEEDING WITH THE WORK.
- FIRE RATED WALLS SHALL HAVE RATINGS STENCILED ABOVE THE CEILING FOR IDENTIFICATION. STENCILED LETTERS SHALL BE RED, 2" HIGH AT 18" OC MAX ALONG WALL. I.E. "4 HR. RATED WALL"
- REFER TO G0-01 FOR STANDARD ABBREVIATIONS AND NOTATIONS.
- GENERAL CONTRACTOR SHALL PROVIDE LINTELS FOR MASONRY OPENINGS AND WALL PENETRATIONS AS SHOWN ON ALL DRAWINGS.
- DIMENSIONS FOR MASONRY OPENINGS ON PLANS ARE GIVEN AS "ROUGH" OPENINGS. GC AND ALL SUBCONTRACTORS RESPONSIBLE FOR FABRICATION OF BUILDING COMPONENTS TO ALLOW FOR SHIM AND INSULATION SPACE.
- NOTE SLAB DEPRESSIONS FOR TILE AND ATHLETIC FLOORS AS INDICATED BY PLAN KEYNOTES AND INDICATED ON STRUCTURAL DRAWINGS.
- ALL BLOCKING AND PLYWOOD UTILIZED SHALL BE FIRE RETARDANT TREATED WOOD.
- ALL RATED CMU WALLS TO BE D-2 CLASSIFIED CMU.
- ALL EXTERIOR CONCRETE WALKS TO BE BEDDED ON 4" OF #57 STONE ON COMPACTED SUBGRADE WITHIN 6'-0" OF THE BUILDING. ADJOINING WALKS ON COMPACTED SUBGRADE. SEE CIVIL DRAWINGS.
- GC SHALL PROVIDE FIRE RETARDANT 3/4" PLYWOOD TO MOUNT PANELS AND EQUIPMENT.
- ALL EXTERIOR STEEL COMPONENTS TO BE HOT-DIPPED GALVANIZED, INCLUDING BUT NOT LIMITED TO ALL EXTERIOR STAIR AND HANDRAIL GUARDRAIL COMPONENTS AND STEEL LINTELS.

PLAN KEYNOTES

- SLAB RECESSED IN THIS ROOM TO ACCOMMODATE SPECIALTY FLOORING - REFER TO FINISH PLAN. GC TO CONFIRM DEPTH OF RECESS WITH FLOORING MANUFACTURER PRIOR TO POURING THE SLAB.
- MECHANICAL LOUVER. REFER TO MECHANICAL DRAWINGS. GC TO COORDINATE OPENING SIZE AND PROVIDE LINTEL AND FLASHING.
- BUILDING EXPANSION JOINT. PROVIDE BLOCKOUTS IN SLAB FOR FLOOR TO FLOOR JOINTS - FLOOR TO FLOOR JOINTS: 2 HR. RATED 1" JOINT. CS GROUP MULTIFLEX MFX-1F OR EQUAL - WALL TO WALL JOINTS: 2 HR. RATED 1" JOINT, CS GROUP MULTIFLEX MFX-1FW OR EQUAL - WALL JOINT
- ROLLING COUNTER DOOR. SEE SPECIFICATIONS.
- ADA ACTUATOR. ELECTRICAL CONTRACTOR PROVIDE BACKER BOXES AND CONDUIT. COORDINATE W/ GC & HARDWARE SUPPLIER.
- PROVIDE MAGNETIC DOOR HOLD OPENS FOR THIS DOOR ASSEMBLY. REFER TO ELECTRICAL DRAWINGS AND DOOR SCHEDULE FOR SPECIFICATIONS.
- GC TO PROVIDE BONDBEAM LINTEL OVER THIS OPENING.
- PROVIDE MECHANICAL DOOR HOLD OPENS FOR THIS DOOR ASSEMBLY.
- RECESS FLOOR 4 1/4" - COORDINATE WITH COOLER/FREEZER UNIT MANUFACTURER PRIOR TO POURING SLABS AND NOTIFY ARCHITECT OF DISCREPANCIES.
- LADDER - MEANS OF ESCAPE FROM MECHANICAL PLATFORM ABOVE.
- ROOF ACCESS LADDER - REFER TO ROOF PLAN A1-40.
- 4'-0" WIDE SELF-CLOSING SAFETY GATE PER OSHA REQUIREMENTS.
- SLOPE SLAB TO DRAIN. SEE STRUCTURAL DRAWINGS FOR MINIMUM CONCRETE COVERAGE AT DRAIN LOCATION(S).
- COLUMN FEATURE: COUNTER AND WRAP. REFER TO DETAIL 15/A5-01
- PIPE BOLLARD - SEE CIVIL DRAWINGS
- OPERABLE PARTITION
- NURSE EXAM CURTAIN
- PROVIDE ELECTRONIC LOCKSET FOR SECURITY INTEGRATION THIS DOOR ASSEMBLY

smith sinnett ARCHITECTURE
1 919 781 8582
4600 Lake Boone Trail
Suite 205
Raleigh, NC 27607
info@smithsinnett.com

ARCHITECTURE PA
REGISTERED PROFESSIONAL
DESIGN NO. 50172
EXPIRES 12/31/2019

CONSTRUCTION DOCUMENT

ENERGY STAR PARTNER


VOLUME I

The drawings on this sheet show the work to be done by the Contractor. The Contractor shall be responsible for the coordination of all trades and the proper installation of all equipment. Any refrigeration of the equipment shall be subject to local codes. All equipment shall be installed in accordance with the manufacturer's instructions. The Architect is not responsible for the contract.

Smith Sinnett Architecture, P.A. 2018
THIS DRAWING IS FORMATTED TO BE PRINTED ON A 30" X 42" SHEET

**TRINITY MIDDLE SCHOOL
RANDOLPH COUNTY SCHOOL SYSTEM**

Parcel PIN 7708118367
Surrett Drive
Trinity, NC 27370

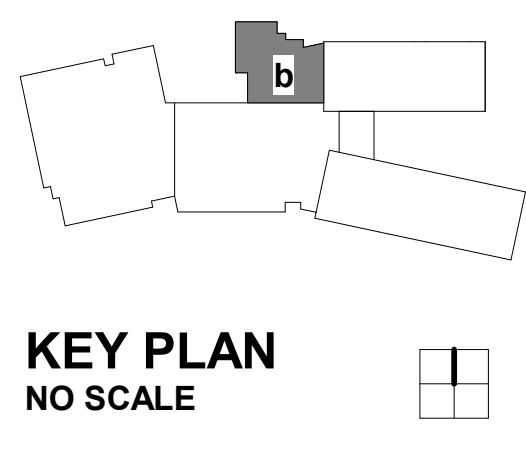


**KEY PLAN
NO SCALE**

2017032 20 MAY 2019

ADDENDUM 3
ID DATE DESCRIPTION
DRAWN BY: LP, JS, DW
CHECKED BY: DW

FLOOR PLAN

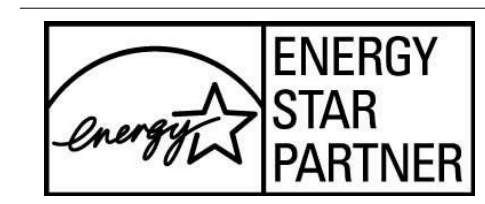


VOLUME I

The drawings on this sheet show the location of the Energy Star Partner logo. The logo is a mark of approval for the manufacturer of the equipment. Any equipment of the manufacturer shown on this drawing is subject to legal action. All copies of this drawing are subject to the terms and conditions of the contract.

Smith Sinnett Architecture, P.A. 2018
THIS DRAWING IS FORMATTED TO BE PRINTED ON A 30" X 42" SHEET

TRINITY MIDDLE SCHOOL
RANDOLPH COUNTY SCHOOL SYSTEM
Parcel PIN 7708118367
Surrett Drive
Trinity, NC 27370

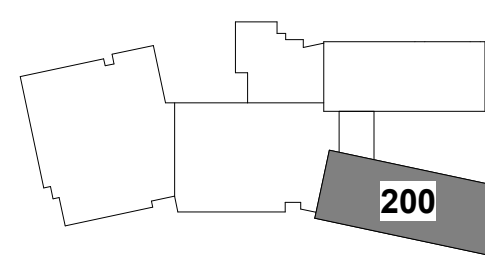

KEY PLAN
NO SCALE

6/14/19 ADDENDUM 3
ID DATE DESCRIPTION
DRAWN BY: LP, JS, DW
CHECKED BY: DW

FLOOR PLAN

GENERAL EQUIPMENT SCHEDULE

Mark	Description and/or Detail Reference	Furnished By	Remarks
1	MOTORIZED RECESSED PROJECTION SCREEN.	CFCI	
2	FIRE EXTINGUISHER AND SEMI-RECESSED FIRE EXT. CABINET. REFER TO TYPICAL DETAIL 6/A5-01.	CFCI	
3	FIRE EXTINGUISHER AND FIRE EXT. BRACKET. REFER TO TYPICAL DETAILS 6/A5-01.	CFCI	
4	COPY MACHINE	OFOI	
5	METAL LOCKER SYSTEM. REFER TO DETAIL 11/A4-02. COLOR AS SELECTED BY ARCHITECT.	CFCI	
6	12'-0" TACK STRIP. REFER TO SPECIFICATIONS.	CFCI	
7	WALL MOUNTED ROOF ACCESS LADDER AND ROOF ACCESS HATCH. REFER TO DETAIL 6/A5-40.	CFCI	
8	12'-0" MARKER BOARD. 6'-0" TACKBOARD. REFER TO SPECIFICATIONS.	CFCI	
9	6'-0" MARKER BOARD. REFER TO SPECIFICATIONS.	CFCI	
10	8'-0" MARKER BOARD. REFER TO SPECIFICATIONS.	CFCI	
11	12'-0" MARKER BOARD. REFER TO SPECIFICATIONS.	CFCI	
12	16'-0" MARKER BOARD. REFER TO SPECIFICATIONS.	CFCI	
13	3'-0" TACKBOARD. REFER TO SPECIFICATIONS.	CFCI	
14	4'-0" TACKBOARD. REFER TO SPECIFICATIONS.	CFCI	
15	8'-0" SMART BOARD.	OFOI	
16	FULL SIZED REFRIGERATOR. 21.7 CUBIC FT. COORDINATE WITH PLUMBING AND ELECTRICAL.	OFOI	
17	MICROWAVE. COORDINATE W/ ELECTRICAL.	OFOI	
18	PREMANUFACTURED OPEN WOOD SHELVING UNITS. REFER TO TYPICAL DETAIL 4/A4-01.	OFOI	
19	LAPTOP STORAGE CART	OFOI	
20	TALL TEACHER WARDROBE. SIZE - 24D X 84H X 36W	CFCI	
21	MOBILE SHEET LIBRARY AND SORTING RACK CABINET - 24D X 36H X 48W	OFOI	
22	30"X60" INSTRUCTOR'S DESK W/ SINK	CFCI	
23	ELECTRIC KILN. 6.4 CUBIC FOOT FIRING CHAMBER. WITH DOWN DRAFT VENTILATION SYSTEM AND KILN SHELVES. SKUTT OR EQUAL. 6.4 CF FIRING CHAMBER.	CFCI	
24	ATHLETIC WASHER AND DRYER ASSEMBLY BY OWNER	OFOI	
25	UTILITY SINK BASIN WITH SUPPORT LEGS. REFER TO PLUMBING DRAWINGS.	CFCI	3
26	FABRIC COVERED ACOUSTICAL WALL PANELS. CONSULT W/ ARCHITECT FOR FINAL LAYOUT. SEE SPECIFICATIONS.	CFCI	2
27	WASHER AND DRYER ASSEMBLY BY OWNER	OFOI	2

SCHEDULE ABBREVIATIONS
CFCI- CONTRACTOR FURNISHED CONTRACTOR INSTALLED
OFCI- OWNER FURNISHED CONTRACTOR INSTALLED
OFOI- OWNER FURNISHED OWNER INSTALLED


NOTES
1. G.C. TO PROVIDE 3/4" FIRE RETARDANT PLYWOOD PANEL TO MOUNT EQUIPMENT.
2. G.C. TO PROVIDE NECESSARY BLOCKING & REINFORCING PLATES IN GWB WALLS & REINFORCING IN CMU WALLS.
3. PROVIDE CLAY SINK TRAP THIS LOCATION. SEE PLUMBING DRAWINGS.

GENERAL PLAN NOTES


- SEE WALL TYPES LEGEND ON SHEET A1.02 FOR TYPES INDICATED BY SYMBOL.
- ALL DOOR FRAMES SHALL BE 4" FROM THE FACE OF PERPENDICULAR WALLS UNLESS OTHERWISE INDICATED.
- ALL DIMENSIONS TAKEN FROM THE FINISHED FACE OF THE WALL (E.G. SURFACE OF CMU OR GYPSUM FOR STUD WALLS) AND THE CENTERLINE OF COLUMNS.
- ALL RATED WALL CONSTRUCTION TO COMPLY WITH U.L. REQUIREMENTS.
- REFER TO EXTERIOR ELEVATIONS FOR EXTERIOR MASONRY CONTROL FOR INTERIOR CONTROL JOINTS.
- ALL EXTERIOR WINDOWS TO RECEIVE BLINDS AS SPECIFIED. INTERIOR WINDOWS - MARKED 'BL' TO RECEIVE BLINDS.
- FURNISHINGS SHOWN WITH DASHED LINES NOT IN CONTRACT UNLESS OTHERWISE NOTED.
- PROVIDE 1" RADIUS BULLNOSE UP TO A HEIGHT OF 8" AT ALL OUTSIDE CMU CORNERS FOR INTERIOR WALLS.
- FIELD VERIFY AND COORDINATE FIELD CONDITIONS AND DIMENSIONS PRIOR TO FABRICATION, INSTALLATION AND CONSTRUCTION OF BUILDING COMPONENTS. THE GC IS TO INFORM THE ARCHITECT OF ANY DISCREPANCIES PRIOR TO PROCEEDING WITH THE WORK.
- FIRE RATED WALLS SHALL HAVE RATINGS STENCILED ABOVE THE CEILING FOR IDENTIFICATION. STENCILED LETTERS SHALL BE RED. 2" HIGH AT 10'-0" OC MAX ALONG WALL. I.E. 3 HR. RATED WALL.
- REFER TO G0-01 FOR STANDARD ABBREVIATIONS AND NOTATIONS.
- GENERAL CONTRACTOR SHALL PROVIDE LINTELS FOR MASONRY OPENINGS AND WALL PENETRATIONS AS SHOWN ON ALL DRAWINGS.
- DIMENSIONS FOR MASONRY OPENINGS ON PLANS ARE GIVEN AS "ROUGH" OPENINGS. GC AND ALL SUBCONTRACTORS RESPONSIBLE FOR FABRICATION OF BUILDING COMPONENTS TO ALLOW FOR SHIM AND INSULATION SPACE.
- NOTE SLAB DEPRESSIONS FOR TILE AND ATHLETIC FLOORS AS INDICATED BY PLAN KEYNOTES AND INDICATED ON STRUCTURAL DRAWINGS.
- ALL BLOCKING AND PLYWOOD UTILIZED SHALL BE FIRE RETARDANT TREATED WOOD.
- ALL RATED CMU WALLS TO BE D-2 CLASSIFIED CMU.
- ALL EXTERIOR CONCRETE WALKS TO BE BEDDED ON 4" OF #57 STONE ON COMPACTED SUBGRADE WITHIN 6'-0" OF THE BUILDING. ADJOINING WALKS ON COMPACTED SUBGRADE. SEE CIVIL DRAWINGS.
- GC SHALL PROVIDE FIRE RETARDANT 3/4" PLYWOOD TO MOUNT PANELS AND EQUIPMENT.
- ALL EXTERIOR STEEL COMPONENTS TO BE HOT-DIPPED GALVANIZED, INCLUDING BUT NOT LIMITED TO ALL EXTERIOR STAIR AND HANDRAIL/GUARDRAIL COMPONENTS AND STEEL LINTELS.

PLAN KEYNOTES

- SLAB RECESSED IN THIS ROOM TO ACCOMMODATE SPECIALTY FLOORING - REFER TO FINISH PLAN. GC TO CONFIRM DEPTH OF RECESS WITH FLOORING MANUFACTURER PRIOR TO POURING THE SLAB.
- MECHANICAL LOUVER. REFER TO MECHANICAL DRAWINGS. GC TO COORDINATE OPENING SIZE AND PROVIDE LINTEL AND FLASHING.
- BUILDING EXPANSION JOINT. PROVIDE BLOCKOUTS IN SLAB FOR FLOOR TO FLOOR JOINTS - FLOOR TO FLOOR JOINTS: 2 HR. RATED 1" JOINT C/S GROUP MULTIFLEX MFX-1F OR EQUAL - WALL TO WALL JOINTS: 2 HR. RATED 1" JOINT. C/S GROUP MULTIFLEX MFX-1F OR EQUAL - WALL JO.
- ROLLING COUNTER DOOR. SEE SPECIFICATIONS.
- ADA ACTUATOR. ELECTRICAL CONTRACTOR PROVIDE BACKER BOXES AND CONDUIT. COORDINATE W/ GC & HARDWARE SUPPLIER.
- PROVIDE MAGNETIC DOOR HOLD OPENS FOR THIS DOOR ASSEMBLY. REFER TO ELECTRICAL DRAWINGS AND DOOR SCHEDULE FOR SPECIFICATIONS.
- GC TO PROVIDE BOND-BEAM LINTEL OVER THIS OPENING.
- PROVIDE MECHANICAL DOOR HOLD OPENS FOR THIS DOOR ASSEMBLY. RECESS FLOOR 4 1/4" - COORDINATE WITH COOL-FREEZER UNIT MANUFACTURER PRIOR TO POURING SLABS AND NOTIFY ARCHITECT OF DISCREPANCIES.
- LADDER - MEANS OF ESCAPE FROM MECHANICAL PLATFORM ABOVE.
- ROOF ACCESS LADDER - REFER TO ROOF PLAN A1-40
- 4" WIDE SELF-CLOSING SAFETY GATE PER OSHA REQUIREMENTS
- SLOPE SLAB TO DRAIN. SEE STRUCTURAL DRAWINGS FOR MINIMUM CONCRETE COVERAGE AT DRAIN LOCATION(S)
- COLUMN FEATURE: COUNTER AND WRAP- REFER TO DETAIL 15/A5-01
- PIPE BOLLARD - SEE CIVIL DRAWINGS
- OPERABLE PARTITION
- NURSE EXAM CURTAIN
- PROVIDE ELECTRONIC LOCKSET FOR SECURITY INTEGRATION THIS DOOR ASSEMBLY
- SIDEWALK. SEE CIVIL DRAWINGS FOR CONTINUATION

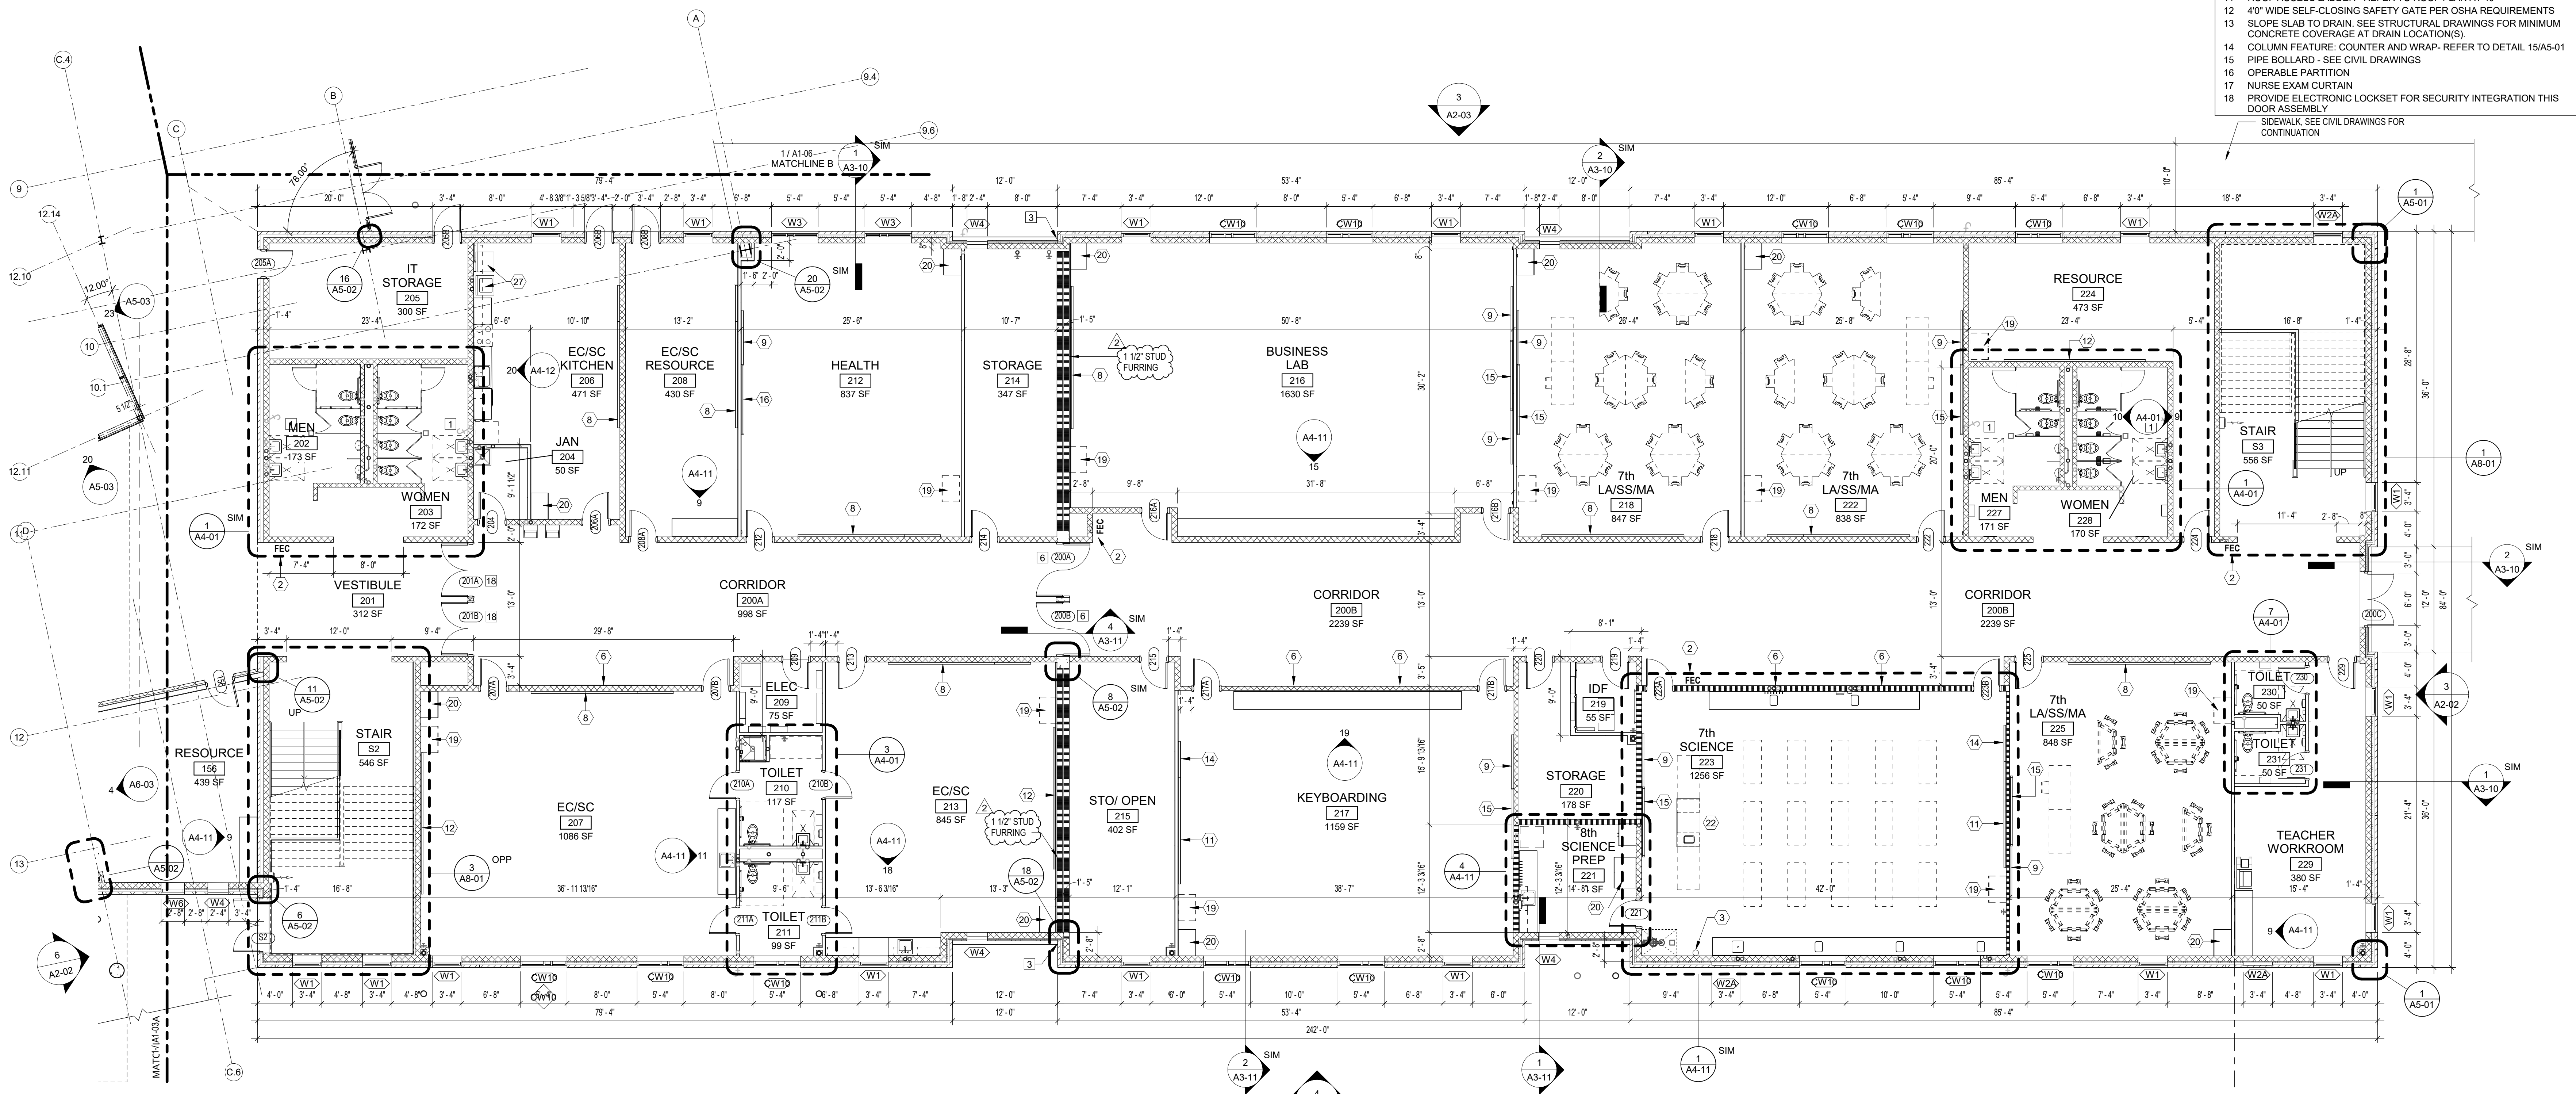

1 200 WING - FIRST FLOOR PLAN
A1-05 1/8" = 1'-0"

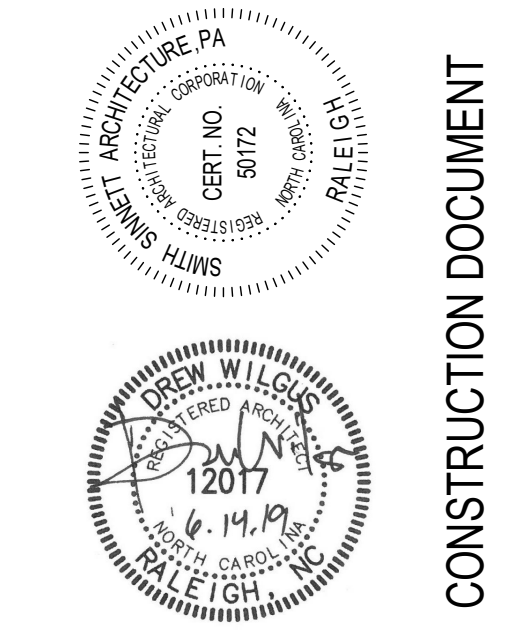


VOLUME I

The drawings on this sheet show the work to be done by the Contractor. It is the responsibility of the Contractor to verify the accuracy of the information shown on this drawing. Any discrepancy between the information shown on this drawing and the actual conditions of the site shall be the responsibility of the Contractor. The drawings are to be used for construction purposes only. Any other use is prohibited. Smith Sinnett Architecture, P.A. 2018

THIS DRAWING IS FORMATTED TO BE PRINTED ON A 30" X 42" SHEET

**TRINITY MIDDLE SCHOOL
RANDOLPH COUNTY SCHOOL SYSTEM**
Parcel PIN 7708118367
Surrett Drive
Trinity, NC 27370

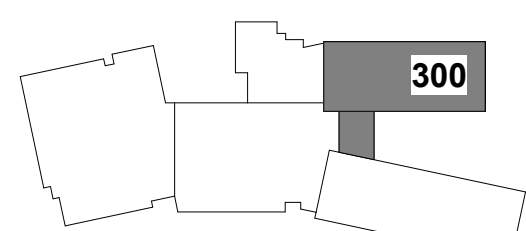


**KEY PLAN
NO SCALE**

6/14/19 ADDENDUM 3
ID DATE DESCRIPTION
DRAWN BY: LP, JS, DW
CHECKED BY: DW

FLOOR PLAN

2017032 20 MAY 2019

A1-06

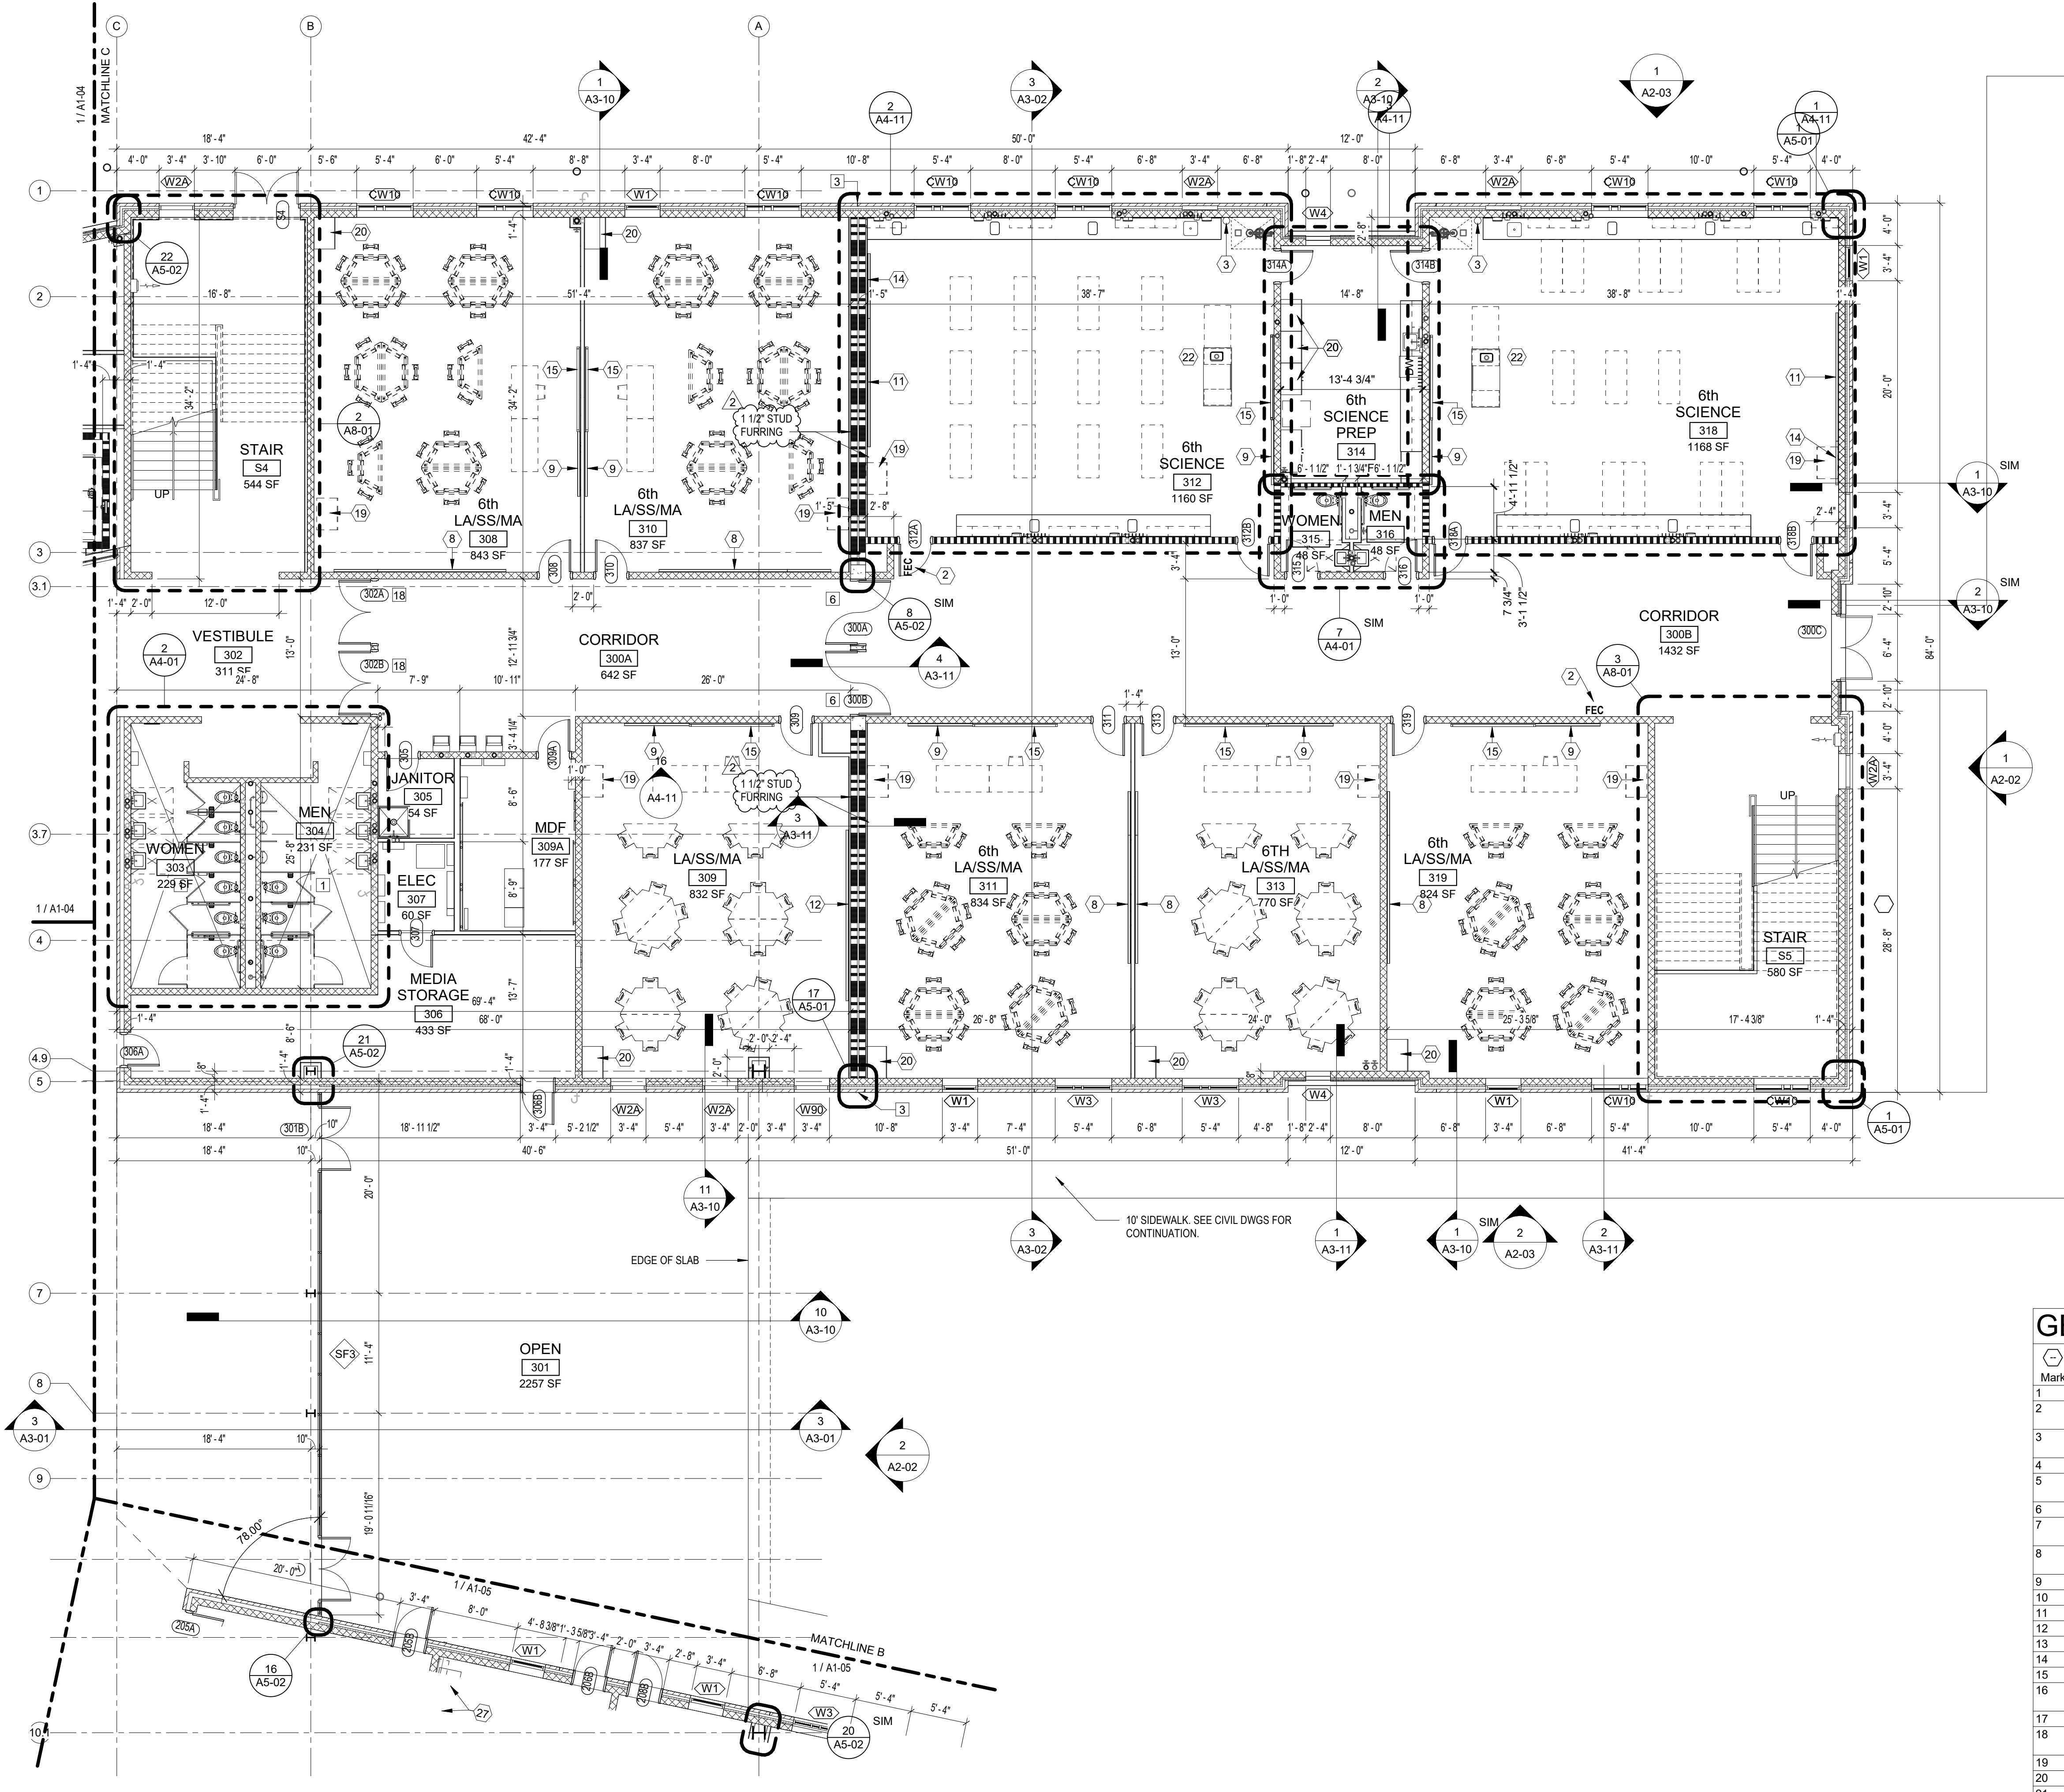

1 300 WING - FIRST FLOOR PLAN
1/8" = 1'-0"

GENERAL EQUIPMENT SCHEDULE

Mark	Description and/or Detail Reference	Furnished By/Installed By	Remarks
1	MOTORIZED RECESSED PROJECTION SCREEN	CFCI	
2	FIRE EXTINGUISHER AND SEMI-RECESSED FIRE EXT. CABINET. REFER TO TYPICAL DETAIL 6/A5-01.	CFCI	
3	FIRE EXTINGUISHER AND FIRE BRACKET. REFER TO TYPICAL DETAIL 6/A5-01.	CFCI	
4	COPY MACHINE	OFIOI	
5	METAL LOCKER SYSTEM. REFER TO DETAIL 11/A4-02. COLOR AS SELECTED BY ARCHITECT.	CFCI	
6	12'-0" TACK STRIP. REFER TO SPECIFICATIONS.	CFCI	
7	WALL MOUNTED ROOF ACCESS LADDER AND ROOF ACCESS HATCH. REFER TO DETAIL 6/A5-40.	CFCI	
8	12'-0" MARKER BOARD, 6'-0" TACKBOARD. REFER TO SPECIFICATIONS.	CFCI	
9	6'-0" MARKER BOARD. REFER TO SPECIFICATIONS.	CFCI	
10	8'-0" MARKER BOARD. REFER TO SPECIFICATIONS.	CFCI	
11	12'-0" MARKER BOARD. REFER TO SPECIFICATIONS.	CFCI	
12	16'-0" MARKER BOARD. REFER TO SPECIFICATIONS.	CFCI	
13	3'-0" TACKBOARD. REFER TO SPECIFICATIONS.	CFCI	
14	4'-0" TACKBOARD. REFER TO SPECIFICATIONS.	CFCI	
15	8'-0" SMART BOARD.	OFIOI	
16	FULL SIZED REFRIGERATOR, 21.7 CUBIC FT. COORDINATE WITH PLUMBING AND ELECTRICAL.	OFIOI	
17	MICROWAVE. COORDINATE W/ ELECTRICAL.	OFIOI	
18	PREMANUFACTURED OPEN WOOD SHELVING UNITS. REFER TO TYPICAL DETAIL 4/A4-01.	OFIOI	
19	LAPTOP STORAGE CART	OFIOI	
20	TALL TEACHER WARDROBE. SIZE - 24D X 84H X 36W	CFCI	
21	MOBILE SHEET LIBRARY AND SORTING DACK CABINET - 24D X 36H X 48W	OFIOI	
22	30"x60" INSTRUCTOR'S DESK W/ SINK	CFCI	
23	ELECTRIC KILN, 6.4 CUBIC FOOT FIRING CHAMBER, WITH DOWN DRAFT VENTILATION SYSTEM AND KILN SHELVES. SKUTT OR EQUAL, 6.4 CF FIRING CHAMBER.	CFCI	
24	ATHLETIC WASHER AND DRYER ASSEMBLY BY OWNER.	OFIOI	
25	UTILITY SINK BASIN WITH SUPPORT LEGS. REFER TO PLUMBING DRAWINGS.	CFCI	3
26	FABRIC COVERED ACOUSTICAL WALL PANELS. CONSULT W/ ARCHITECT FOR FINAL LAYOUT. SEE SPECIFICATIONS.	CFCI	2
27	WASHER AND DRYER ASSEMBLY BY OWNER	OFIOI	2

SCHEDULE ABBREVIATIONS
CFCI - CONTRACTOR FURNISHED CONTRACTOR INSTALLED
OFIOI - OWNER FURNISHED CONTRACTOR INSTALLED
OFOW - OWNER FURNISHED OWNER INSTALLED




NOTES
1. G.C. TO PROVIDE 3/4" FIRE RETARDANT PLYWOOD PANEL TO MOUNT EQUIPMENT.
2. G.C. TO PROVIDE NECESSARY BLOCKING & REINFORCING PLATES IN G/W WALLS & REINFORCING IN CMU WALLS.
3. PROVIDE CLAY SINK TRAP THIS LOCATION. SEE PLUMBING DRAWINGS.

GENERAL PLAN NOTES

- SEE WALL TYPES LEGEND ON SHEET A1-02 FOR TYPES INDICATED BY SYMBOL.
- ALL DOOR FRAMES SHALL BE 4" FROM THE FACE OF PERPENDICULAR WALLS UNLESS OTHERWISE INDICATED.
- ALL DIMENSIONS TAKEN FROM THE FINISHED FACE OF THE WALL (E.G. SURFACE OF CMU OR GYPSUM FOR STUD WALLS) AND THE CENTERLINE OF COLUMNS.
- ALL RATED WALL CONSTRUCTION TO COMPLY WITH U.L. REQUIREMENTS.
- REFER TO EXTERIOR ELEVATIONS FOR EXTERIOR MASONRY CONTROL FOR INTERIOR CONTROL JOINTS.
- ALL EXTERIOR WINDOWS TO RECEIVE BLINDS AS SPECIFIED. INTERIOR WINDOWS MARKED "BL" TO RECEIVE BLINDS.
- FURNISHINGS SHOWN WITH DASHED LINES NOT IN CONTRACT UNLESS OTHERWISE NOTED.
- PROVIDE 1" RADIUS BULLNOSE UP TO A HEIGHT OF 8" AT ALL OUTSIDE CMU CORNERS FOR INTERIOR WALLS.
- FIELD VERIFY AND COORDINATE FIELD CONDITIONS AND DIMENSIONS PRIOR TO FABRICATION AND CONSTRUCTION OF BUILDING COMPONENTS. THE GC IS TO INFORM THE ARCHITECT OF ANY DISCREPANCIES PRIOR TO PROCEEDING WITH THE WORK.
- FIRE RATED WALLS SHALL HAVE RATINGS STENCILED ABOVE THE CEILING FOR IDENTIFICATION. STENCILED LETTERS SHALL BE RED, 2" HIGH AT 10'-0" OC MAX ALONG WALL, I.E. "4 HR. RATED WALL."
- REFER TO G0-01 FOR STANDARD ABBREVIATIONS AND NOTATIONS.
- GENERAL CONTRACTOR SHALL PROVIDE LINTELS FOR MASONRY OPENINGS AND WALL PENETRATIONS AS SHOWN ON ALL DRAWINGS.
- DIMENSIONS FOR MASONRY OPENINGS ON PLANS ARE GIVEN AS "ROUGH" OPENINGS. GC AND ALL SUBCONTRACTORS RESPONSIBLE FOR FABRICATION OF BUILDING COMPONENTS TO ALLOW FOR SHIM AND INSULATION SPACE.
- NOTE SLAB DEPRESSIONS FOR TILE AND ATHLETIC FLOORS AS INDICATED BY PLAN KEYNOTES AND INDICATED ON STRUCTURAL DRAWINGS.
- ALL BLOCKING AND PLYWOOD UTILIZED SHALL BE FIRE RETARDANT TREATED WOOD.
- ALL RATED CMU WALLS TO BE D-2 CLASSIFIED CMU.
- ALL EXTERIOR CONCRETE WALKS TO BE REBEDD ON 4" OF #57 STONE ON COMPACTED SUBGRADE WITHIN 6'-0" OF THE BUILDING. ADJOINING WALKS ON COMPACTED SUBGRADE. SEE CIVIL DRAWINGS.
- GC SHALL PROVIDE FIRE RETARDANT 3/4" PLYWOOD TO MOUNT PANELS AND EQUIPMENT.
- ALL EXTERIOR STEEL COMPONENTS TO BE HOT-DIPPED GALVANIZED, INCLUDING BUT NOT LIMITED TO ALL EXTERIOR STAIR AND HANDRAIL/GUARDRAIL COMPONENTS AND STEEL LINTELS.

PLAN KEYNOTES

- SLAB RECESSED IN THIS ROOM TO ACCOMMODATE SPECIALTY FLOORING - REFER TO FINISH PLAN. GC TO CONFIRM DEPTH OF RECESS WITH FLOORING MANUFACTURER PRIOR TO POURING THE SLAB.
- MECHANICAL LOUVER, REFER TO MECHANICAL DRAWINGS. GC TO COORDINATE OPENING SIZE AND PROVIDE LINTEL AND FLASHING BUILDING EXPANSION JOINT. PROVIDE BLOCKOUTS IN SLAB FOR FLOOR TO FLOOR JOINTS. FLOOR TO FLOOR JOINTS: 2 HR. RATED 1" JOINT C/S GROUP MULTIFLEX MF-X-1F OR EQUAL. - WALL TO WALL JOINTS: 2 HR. RATED 1" JOINT, C/S GROUP MULTIFLEX MF-X-1FW OR EQUAL - WALL TO
- ROLLING COUNTER DOOR. SEE SPECIFICATIONS.
- ADA ACTUATOR, ELECTRICAL CONTRACTOR PROVIDE BACKER BOXES AND CONDUIT. COORDINATE W/ GC & HARDWARE SUPPLIER.
- PROVIDE MAGNETIC DOOR HOLD OPENS FOR THIS DOOR ASSEMBLY. REFER TO ELECTRICAL DRAWINGS AND DOOR SCHEDULE FOR SPECIFICATIONS.
- GC TO PROVIDE BOND-BEAM LINTEL OVER THIS OPENING.
- PROVIDE MECHANICAL DOOR HOLD OPENS FOR THIS DOOR ASSEMBLY.
- RECESS FLOOR 4 1/4" - COORDINATE WITH COOLER/FREEZER UNIT MANUFACTURER PRIOR TO POURING SLABS AND NOTIFY ARCHITECT OF DISCREPANCIES.
- LADDER - MEANS OF ESCAPE FROM MECHANICAL PLATFORM ABOVE.
- ROOF ACCESS LADDER - REFER TO ROOF PLAN A1-40
- 4'-0" WIDE SELF-CLOSING SAFETY GATE PER OSHA REQUIREMENTS
- SLOPE SLAB TO DRAIN. SEE STRUCTURAL DRAWINGS FOR MINIMUM CONCRETE COVER AT DRAIN LOCATIONS.
- COLUMN FEATURE: COUNTER AND WRAP. REFER TO DETAIL 15/A5-01
- PIPE BOLLARD - SEE CIVIL DRAWINGS
- OPERABLE PARTITION
- NURSE EXAM CURTAIN
- PROVIDE ELECTRONIC LOCKSET FOR SECURITY INTEGRATION THIS DOOR ASSEMBLY.

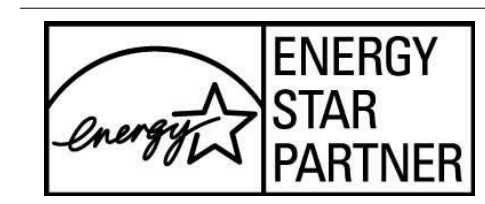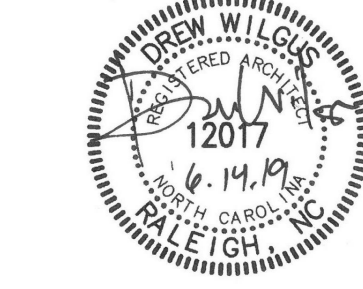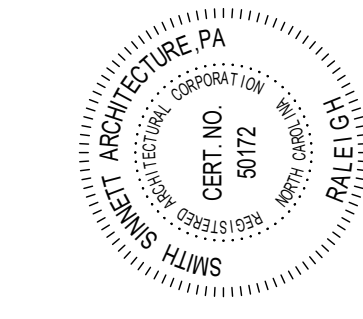


VOLUME I

This drawing is the property of Smith Sinnett Architecture, P.A. Its reproduction or use in any form without the written consent of Smith Sinnett Architecture, P.A. is prohibited. Any infringement of the copyright rights in this drawing shall be subject to legal action. All copies of this drawing must be approved by the Architect at the completion of the project.

Smith Sinnett Architecture, P.A. 2018
THIS DRAWING IS FORMATTED TO BE PRINTED ON A 30" X 42" SHEET

TRINITY MIDDLE SCHOOL
RANDOLPH COUNTY SCHOOL SYSTEM
Parcel PIN 7708 118367
Surrett Drive
Trinity, NC 27370

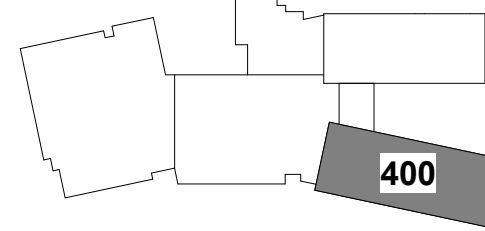

KEY PLAN
NO SCALE

6/14/19 ADDENDUM 3
ID DATE DESCRIPTION
DRAWN BY: LP, JS, DW
CHECKED BY: DW
FLOOR PLAN

GENERAL EQUIPMENT SCHEDULE

Mark	Description and/or Detail Reference	Furnished By	Remarks
1	MOTORIZED RECESSED PROJECTION SCREEN.	OFCI	
2	FIRE EXTINGUISHER AND SEMI-RECESSED FIRE EXT. CABINET. REFER TO TYPICAL DETAIL 6/A5-01.	OFCI	
3	FIRE EXTINGUISHER AND FIRE EXT. BRACKET. REFER TO TYPICAL DETAILS 6/A5-01.	OFCI	
4	COPY MACHINE	OFCI	
5	METAL LOCKER SYSTEM. REFER TO DETAIL 11/A4-02. COLORS AS SELECTED BY ARCHITECT.	OFCI	
6	12'-0" TACK STRIP. REFER TO SPECIFICATIONS.	OFCI	
7	WALL MOUNTED ROOF ACCESS LADDER AND ROOF ACCESS HATCH. REFER TO DETAIL 6/A5-40.	OFCI	
8	12'-0" MARKER BOARD, 6'-0" TACKBOARD. REFER TO SPECIFICATIONS.	OFCI	
9	6'-0" MARKER BOARD. REFER TO SPECIFICATIONS.	OFCI	
10	8'-0" MARKER BOARD. REFER TO SPECIFICATIONS.	OFCI	
11	12'-0" MARKER BOARD. REFER TO SPECIFICATIONS.	OFCI	
12	16'-0" MARKER BOARD. REFER TO SPECIFICATIONS.	OFCI	
13	3'-0" TACKBOARD. REFER TO SPECIFICATIONS.	OFCI	
14	4'-0" TACKBOARD. REFER TO SPECIFICATIONS.	OFCI	
15	8'-0" SMART BOARD.	OFCI	
16	FULL SIZE REFRIGERATOR, 21.7 CUBIC FT., COORDINATE WITH PLUMBING AND ELECTRICAL.	OFCI	
17	MICROWAVE. COORDINATE W/ ELECTRICAL.	OFCI	
18	PREMANUFACTURED OPEN WOOD SHELVING UNITS. REFER TO TYPICAL DETAIL 4/A4-01.	OFCI	
19	LAPTOP STORAGE CART	OFCI	
20	TALL TEACHER WARDROBE. SIZE - 24D X 84H X 36W	OFCI	
21	MOBILE SHEET LIBRARY AND SORTING RACK CABINET - 24D X 36H X 48W	OFCI	
22	30"x60" INSTRUCTOR'S DESK W/ SINK	OFCI	
23	ELECTRIC KILN, 6.4 CUBIC FOOT FIRING CHAMBER, WITH DOWN DRAFT VENTILATION SYSTEM AND KILN SHELVES. SKUTT OR EQUAL. 6.4 CF FIRING CHAMBER.	OFCI	
24	ATHLETIC WASHER AND DRYER ASSEMBLY BY OWNER.	OFCI	
25	UTILITY SINK BASIN WITH SUPPORT LEGS. REFER TO PLUMBING DRAWINGS	OFCI	3
26	FABRIC COVERED ACOUSTICAL WALL PANELS. CONSULT W/ ARCHITECT FOR FINAL LAYOUT. SEE SPECIFICATIONS.	OFCI	2
27	WASHER AND DRYER ASSEMBLY BY OWNER	OFCI	2

SCHEDULE ABBREVIATIONS
 OFCI - CONTRACTOR FURNISHED CONTRACTOR INSTALLED
 OFCI - OWNER FURNISHED CONTRACTOR INSTALLED
 OFOI - OWNER FURNISHED OWNER INSTALLED


NOTES
 1. G.C. TO PROVIDE 3/4" FIRE RETARDANT PLYWOOD PANEL TO MOUNT EQUIPMENT.
 2. G.C. TO PROVIDE NECESSARY BLOCKING & REINFORCING PLATES IN GWB WALLS & REINFORCING IN CMU WALLS.
 3. PROVIDE CLAY SINK TRAP THIS LOCATION. SEE PLUMBING DRAWINGS.

GENERAL PLAN NOTES

- SEE WALL TYPES LEGEND ON SHEET A1-02 FOR TYPES INDICATED BY SYMBOL.
- ALL DOOR FRAMES SHALL BE 4" FROM THE FACE OF PERPENDICULAR WALLS UNLESS OTHERWISE INDICATED.
- ALL DIMENSIONS TAKEN FROM THE FINISHED FACE OF THE WALL (E.G. SURFACE OF CMU OR GYPSUM FOR STUD WALLS) AND THE CENTERLINE OF COLUMNS.
- ALL RATED WALL CONSTRUCTION TO COMPLY WITH U.L. REQUIREMENTS.
- REFER TO EXTERIOR ELEVATIONS FOR EXTERIOR MASONRY CONTROL FOR INTERIOR CONTROL JOINTS.
- ALL EXTERIOR WINDOWS TO RECEIVE BLINDS AS SPECIFIED. INTERIOR WINDOWS MARKED "BL" TO RECEIVE BLINDS.
- FURNISHINGS SHOWN WITH DASHED LINES NOT IN CONTRACT UNLESS OTHERWISE NOTED.
- PROVIDE 1" RADIUS BULLNOSE UP TO A HEIGHT OF 8" AT ALL OUTSIDE CMU CORNERS FOR INTERIOR WALLS.
- FIELD VERIFY AND COORDINATE FIELD CONDITIONS AND DIMENSIONS PRIOR TO FABRICATION. INSTALLATION AND CONSTRUCTION OF BUILDING COMPONENTS. THE GC IS TO INFORM THE ARCHITECT OF ANY DISCREPANCIES PRIOR TO PROCEEDING WITH THE WORK.
- FIRE RATED WALLS SHALL HAVE RATINGS STENCILED ABOVE THE CEILING FOR IDENTIFICATION. STENCILED LETTERS SHALL BE RED, 2" HIGH AT 10'-0" OC MAX ALONG WALL. I.E. 1 HR. RATED WALL.
- REFER TO G0-01 FOR STANDARD ABBREVIATIONS AND NOTATIONS.
- GENERAL CONTRACTOR SHALL PROVIDE LINTELS FOR MASONRY OPENINGS AND WALL PENETRATIONS AS SHOWN ON ALL DRAWINGS.
- DIMENSIONS FOR MASONRY OPENINGS ON PLANS ARE GIVEN AS "ROUGH" OPENINGS. GC AND ALL SUBCONTRACTORS RESPONSIBLE FOR FABRICATION OF BUILDING COMPONENTS TO ALLOW FOR SHIM AND INSULATION SPACE.
- NOTE SLAB DEPRESSIONS FOR TILE AND ATHLETIC FLOORS AS INDICATED BY PLAN KEYNOTES AND INDICATED ON STRUCTURAL DRAWINGS.
- ALL BLOCKING AND PLYWOOD UTILIZED SHALL BE FIRE RETARDANT TREATED WOOD.
- ALL RATED CMU WALLS TO BE D-2 CLASSIFIED CMU.
- ALL EXTERIOR CONCRETE WALKS TO BE BEDDED ON 4" OF #57 STONE ON COMPACTED SUBGRADE WITHIN 6'-0" OF THE BUILDING. ADJOINING WALKS ON COMPACTED SUBGRADE. SEE CIVIL DRAWINGS.
- GC SHALL PROVIDE FIRE RETARDANT 3/4" PLYWOOD TO MOUNT PANELS AND EQUIPMENT.
- ALL EXTERIOR STEEL COMPONENTS TO BE HOT-DIPPED GALVANIZED, INCLUDING BUT NOT LIMITED TO ALL EXTERIOR STAIR AND HANDRAIL GUARDRAIL COMPONENTS AND STEEL LINTELS.

PLAN KEYNOTES

- SLAB RECESSED IN THIS ROOM TO ACCOMMODATE SPECIALTY FLOORING - REFER TO FINISH PLAN. GC TO CONFIRM DEPTH OF RECESS WITH FLOORING MANUFACTURER PRIOR TO POURING THE SLAB.
- MECHANICAL LOUVER. REFER TO MECHANICAL DRAWINGS. GC TO COORDINATE OPENING SIZE AND PROVIDE LINTEL AND FLASHINGS.
- BUILDING EXPANSION JOINT. PROVIDE BLOCKOUTS IN SLAB FOR FLOOR TO FLOOR JOINTS - FLOOR TO FLOOR JOINTS: 2 HR. RATED 1" JOINT C/S GROUP MULTIFLEX MFX-1F OR EQUAL. - WALL TO WALL JOINTS: 2 HR. RATED 1" JOINT. C/S GROUP MULTIFLEX MFX-1F OR EQUAL. - WALL JOINT
- ROLLING COUNTER DOOR. SEE SPECIFICATIONS.
- ADA ACTUATOR. ELECTRICAL CONTRACTOR PROVIDE BACKER BOXES AND CONDUIT. COORDINATE W/ GC & HARDWARE SUPPLIER.
- PROVIDE MAGNETIC DOOR HOLD OPENS FOR THIS DOOR ASSEMBLY. REFER TO ELECTRICAL DRAWINGS AND DOOR SCHEDULE FOR SPECIFICATIONS.
- GC TO PROVIDE BOND-BEAM LINTEL OVER THIS OPENING.
- PROVIDE MECHANICAL DOOR HOLD OPENS FOR THIS DOOR ASSEMBLY.
- RECESS FLOOR 4 1/4" - COORDINATE WITH COOLER/FREEZER UNIT MANUFACTURER PRIOR TO POURING SLABS AND NOTIFY ARCHITECT OF DISCREPANCIES.
- LADDER - MEANS OF ESCAPE FROM MECHANICAL PLATFORM ABOVE.
- ROOF ACCESS LADDER - REFER TO ROOF PLAN A1-40.
- 4" WIDE SELF-CLOSING SAFETY GATE PER OSHA REQUIREMENTS.
- SLOPE SLAB TO DRAIN. SEE STRUCTURAL DRAWINGS FOR MINIMUM CONCRETE COVERAGE AT DRAIN LOCATION(S).
- COLUMN FEATURE: COUNTER AND WRAP. REFER TO DETAIL 15/A5-01.
- PIPE BOLLARD - SEE CIVIL DRAWINGS.
- OPERABLE PARTITION.
- NURSE EXAM CURTAIN.
- PROVIDE ELECTRONIC LOCKSET FOR SECURITY INTEGRATION THIS DOOR ASSEMBLY.

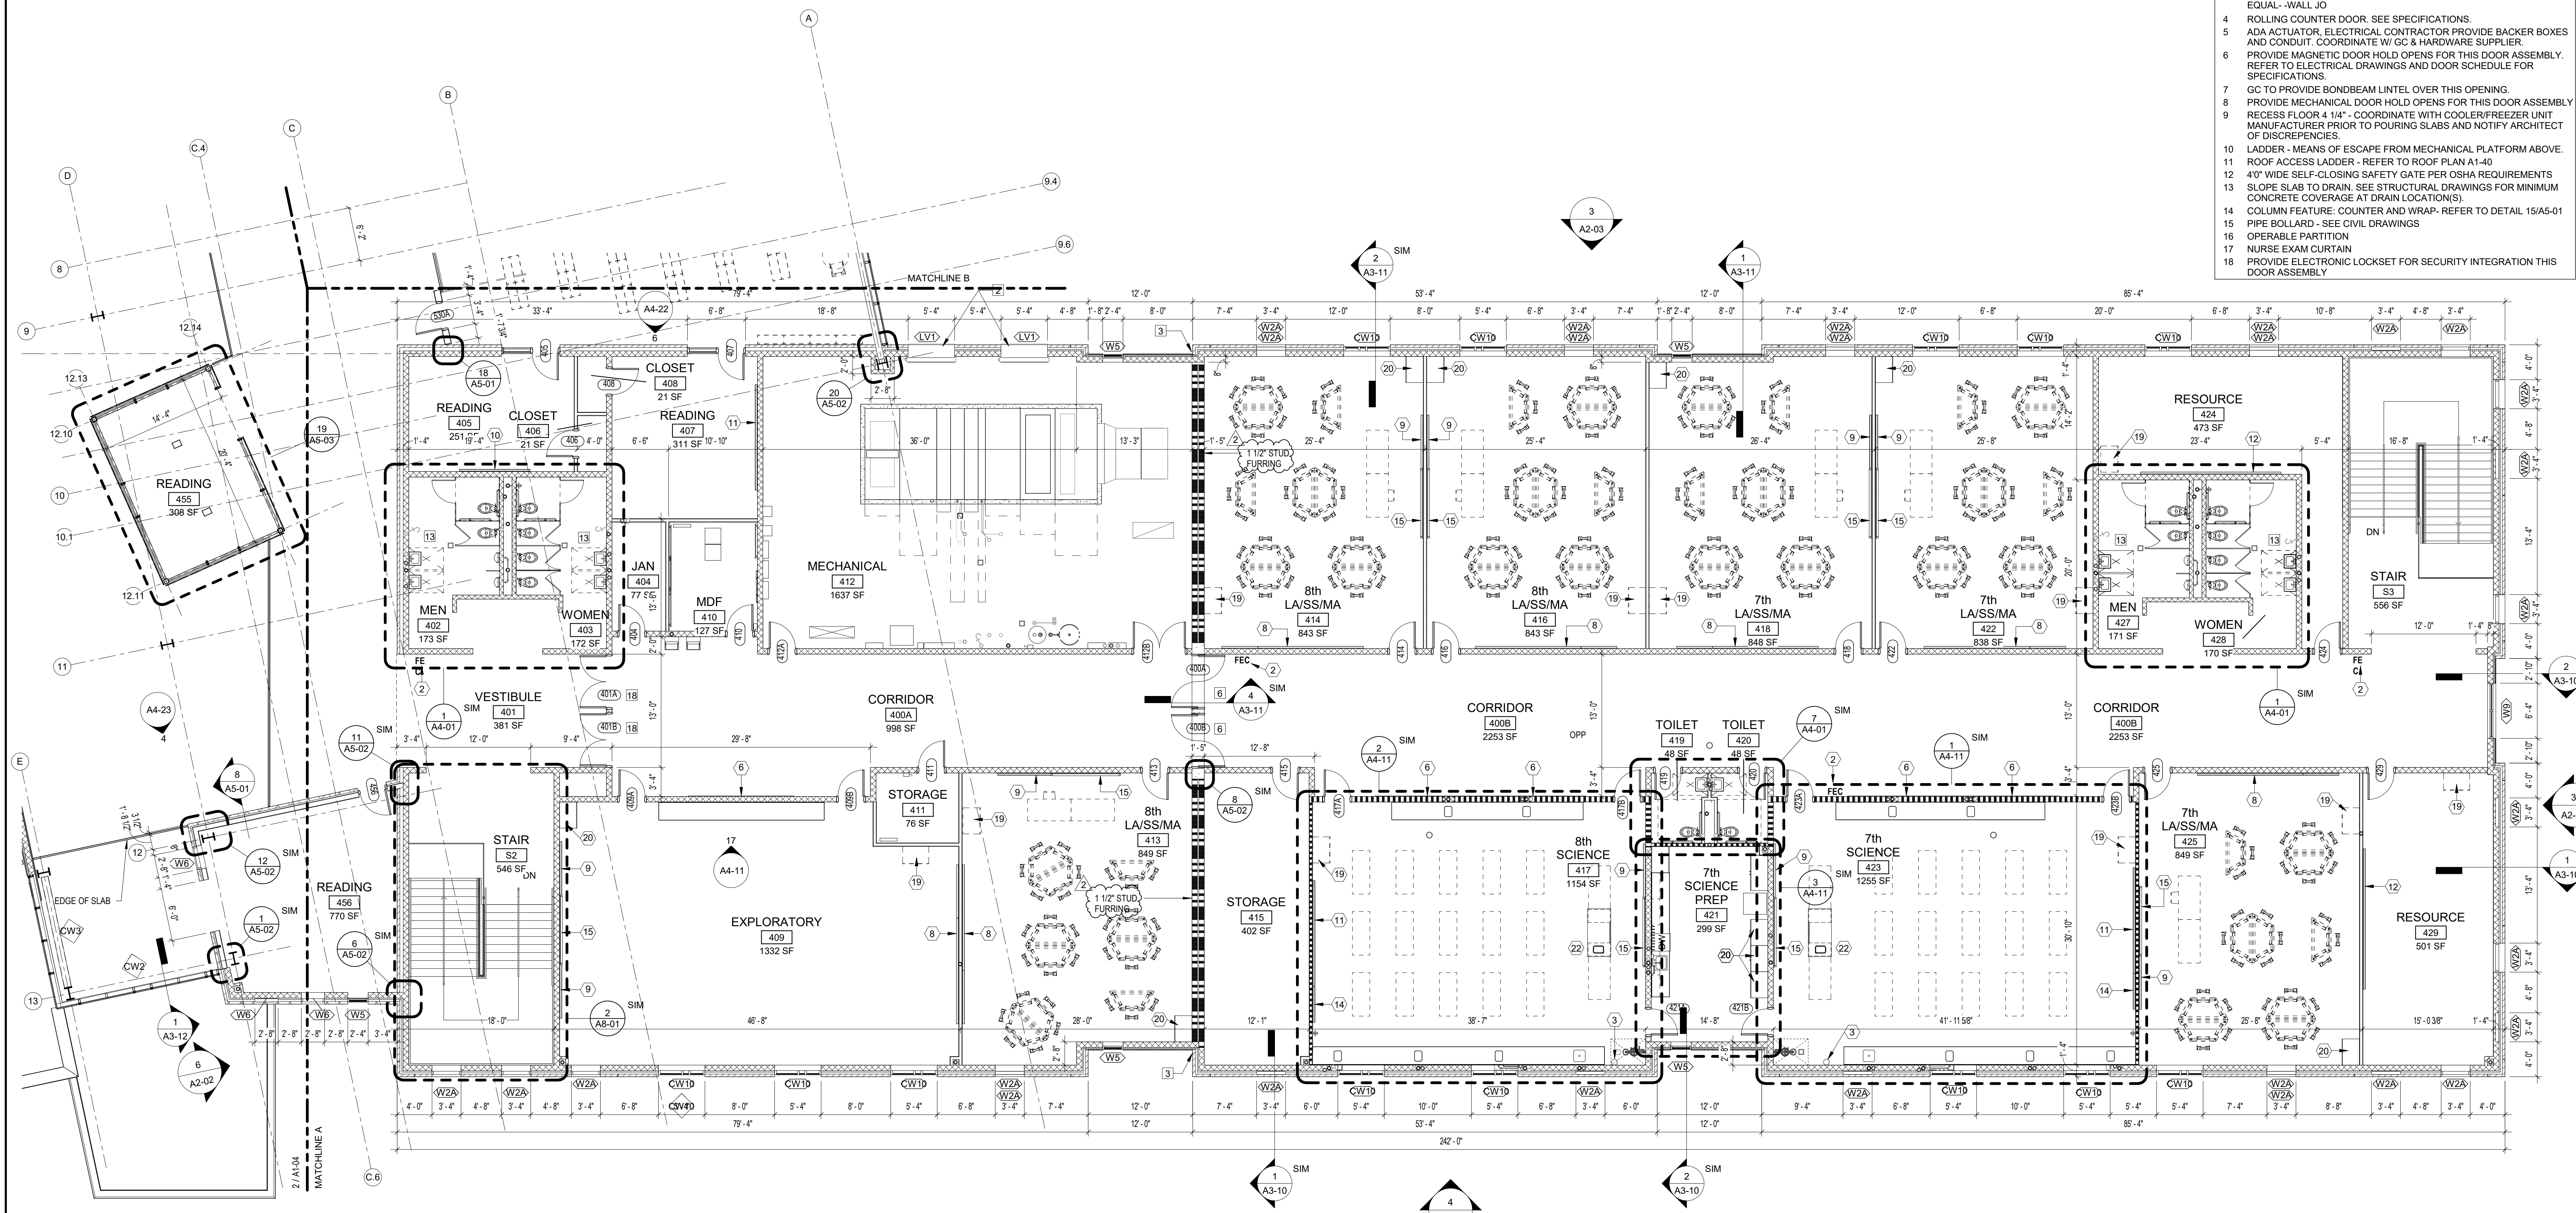


1 400 WING - SECOND FLOOR
 A1-07 1/8" = 1'-0"



The drawings on this sheet show the work of Smith Sinnett Architecture, P.A. The reproduction or use of this drawing without the written consent of Smith Sinnett Architecture, P.A. is prohibited. Any reproduction of this drawing without the written consent of Smith Sinnett Architecture, P.A. is prohibited. This drawing is to be printed on a 30" x 42" sheet.


TRINITY MIDDLE SCHOOL
RANDOLPH COUNTY SCHOOL SYSTEM
Parcel PIN 7708118367
Surrett Drive
Trinity, NC 27370

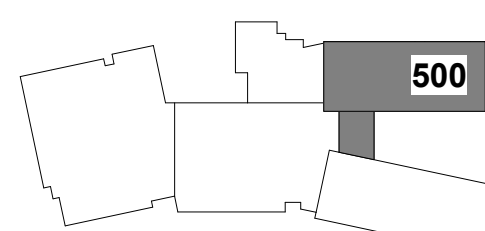

KEY PLAN
NO SCALE

6/14/19 ADDENDUM 3
ID DATE DESCRIPTION
DRAWN BY: LP, JS, DW
CHECKED BY: DW

FLOOR PLAN
2017032 20 MAY 2019
A1-08

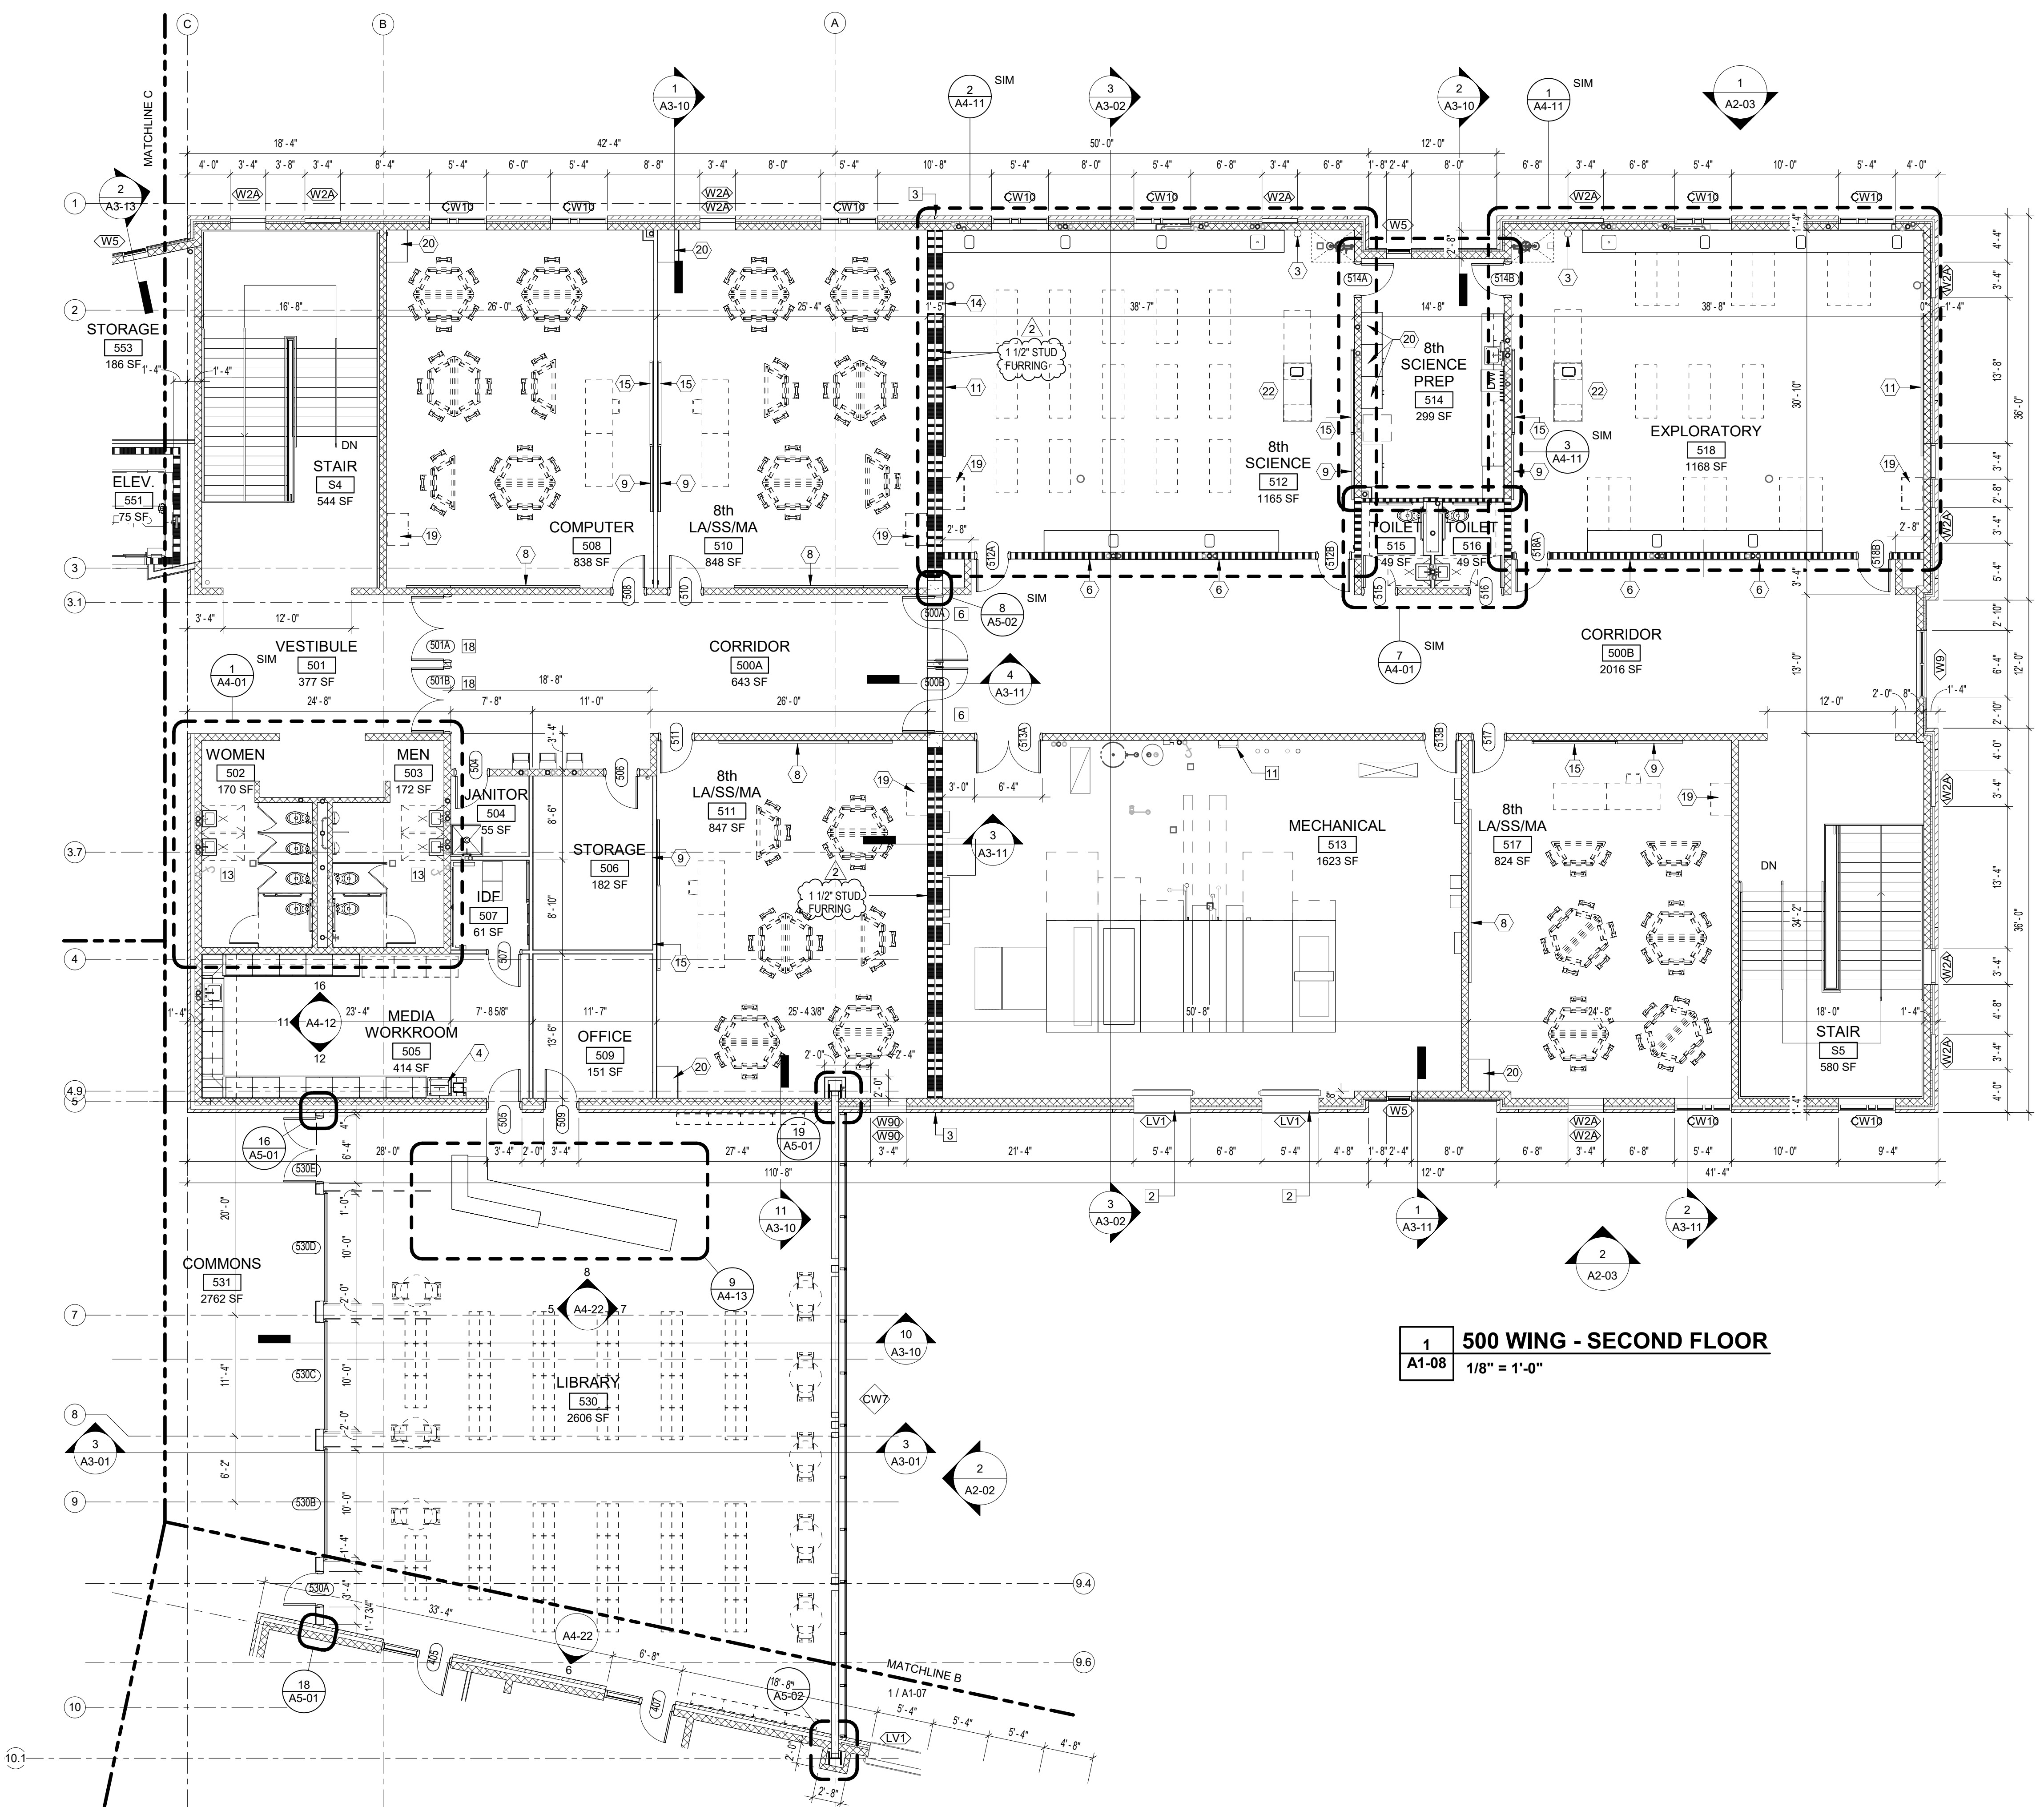

1 500 WING - SECOND FLOOR
A1-08 1/8" = 1'-0"

GENERAL EQUIPMENT SCHEDULE

Mark	Description and/or Detail Reference	Furnished By	Remarks
1	MOTORIZED RECESSED PROJECTION SCREEN	CFCI	
2	FIRE EXTINGUISHER AND SEMI-RECESSED FIRE EXT. CABINET. REFER TO TYPICAL DETAIL 6/A5-01.	CFCI	
3	FIRE EXTINGUISHER AND FIRE EXT. BRACKET. REFER TO TYPICAL DETAIL 6/A5-01.	CFCI	
4	COPY MACHINE	OFOI	
5	METAL LOCKER SYSTEM. REFER TO DETAIL 11/A4-02. COLOR AS SELECTED BY ARCHITECT.	CFCI	
6	12'-0" TACK STRIP. REFER TO SPECIFICATIONS.	CFCI	
7	WALL MOUNTED ROOF ACCESS LADDER AND ROOF ACCESS HATCH. REFER TO DETAIL 6/A5-40.	CFCI	
8	12'-0" MARKER BOARD, 6'-0" TACKBOARD. REFER TO SPECIFICATIONS.	CFCI	
9	6'-0" MARKER BOARD. REFER TO SPECIFICATIONS.	CFCI	
10	8'-0" MARKER BOARD. REFER TO SPECIFICATIONS.	CFCI	
11	12'-0" MARKER BOARD. REFER TO SPECIFICATIONS.	CFCI	
12	16'-0" MARKER BOARD. REFER TO SPECIFICATIONS.	CFCI	
13	3'-0" TACKBOARD. REFER TO SPECIFICATIONS.	CFCI	
14	4'-0" TACKBOARD. REFER TO SPECIFICATIONS.	CFCI	
15	8'-0" SMART BOARD.	OFOI	
16	FULL SIZED REFRIGERATOR. 21.7 CUBIC FT. COORDINATE WITH PLUMBING AND ELECTRICAL.	OFOI	
17	MICROWAVE. COORDINATE W/ ELECTRICAL.	OFOI	
18	PREMANUFACTURED OPEN WOOD SHELVING UNITS. REFER TO TYPICAL DETAIL 4/A4-01.	OFOI	
19	LAPTOP STORAGE CART	OFOI	
20	TALL TEACHER WARDROBE. SIZE - 24D X 84H X 36W	CFCI	
21	MOBILE SHEET LIBRARY AND SORTING RACK CABINET - 24D X 36H X 48W	OFOI	
22	30"x60" INSTRUCTOR'S DESK W/ SINK	CFCI	
23	ELECTRIC KILN. 6.4 CUBIC FOOT FIRING CHAMBER. WITH DOWN DRAFT VENTILATION SYSTEM AND KILN SHELVES. SKUITZ OR EQUAL. 6.4 CF FIRING CHAMBER.	CFCI	
24	ATHLETIC WASHER AND DRYER ASSEMBLY BY OWNER.	OFOI	
25	UTILITY SINK BASIN WITH SUPPORT LEGS. REFER TO PLUMBING DRAWINGS.	CFCI	3
26	FABRIC COVERED ACOUSTICAL WALL PANELS. CONSULT W/ ARCHITECT FOR FINAL LAYOUT. SEE SPECIFICATIONS.	CFCI	2
27	WASHER AND DRYER ASSEMBLY BY OWNER	OFOI	2

SCHEDULE ABBREVIATIONS
CFCI - CONTRACTOR FURNISHED CONTRACTOR INSTALLED
OFOI - OWNER FURNISHED CONTRACTOR INSTALLED
OFOI - OWNER FURNISHED OWNER INSTALLED


NOTES
1. G.C. TO PROVIDE 3/4" FIRE RETARDANT PLYWOOD PANEL TO MOUNT EQUIPMENT.
2. G.C. TO PROVIDE NECESSARY BLOCKING & REINFORCING PLATES IN GWS WALLS & REINFORCING IN CMU WALLS.
3. PROVIDE CLAY SINK TRAP THIS LOCATION. SEE PLUMBING DRAWINGS.

GENERAL PLAN NOTES

- SEE WALL TYPES LEGEND ON SHEET A1-02 FOR TYPES INDICATED BY SYMBOL.
- ALL DOOR FRAMES SHALL BE 4" FROM THE FACE OF PERPENDICULAR WALLS UNLESS OTHERWISE INDICATED.
- ALL DIMENSIONS TAKEN FROM THE FINISHED FACE OF THE WALL (E.G. SURFACE OF CMU OR GYPSUM FOR STUD WALLS) AND THE CENTERLINE OF COLUMNS.
- ALL RATED WALL CONSTRUCTION TO COMPLY WITH U.L. REQUIREMENTS.
- REFER TO EXTERIOR ELEVATIONS FOR EXTERIOR MASONRY CONTROL FOR INTERIOR CONTROL JOINTS.
- ALL EXTERIOR WINDOWS TO RECEIVE BLINDS AS SPECIFIED. INTERIOR WINDOWS - MARKED "BL" TO RECEIVE BLINDS.
- FURNISHINGS SHOWN WITH DASHED LINES NOT IN CONTRACT UNLESS OTHERWISE NOTED.
- PROVIDE 1" RADIUS BULLNOSE UP TO A HEIGHT OF 8" AT ALL OUTSIDE CMU CORNERS FOR INTERIOR WALLS.
- FIELD VERIFY AND COORDINATE FIELD CONDITIONS AND DIMENSIONS PRIOR TO FABRICATION. INSTALLATION AND CONSTRUCTION OF BUILDING COMPONENTS. THE GC IS TO INFORM THE ARCHITECT OF ANY DISCREPANCIES PRIOR TO PROCEEDING WITH THE WORK.
- FIRE RATED WALLS SHALL HAVE RATINGS STENCILED ABOVE THE CEILING FOR IDENTIFICATION. STENCILED LETTERS SHALL BE RED, 2" HIGH AT 10'-0" OC MAX ALONG WALL. I.E. "4 HR. RATED WALL"
- REFER TO G0-01 FOR STANDARD ABBREVIATIONS AND NOTATIONS.
- GENERAL CONTRACTOR SHALL PROVIDE LITTELS FOR MASONRY OPENINGS AND WALL PENETRATIONS AS SHOWN ON ALL DRAWINGS.
- DIMENSIONS FOR MASONRY OPENINGS ON PLANS ARE GIVEN AS "ROUGH" OPENINGS. GC AND ALL SUBCONTRACTORS RESPONSIBLE FOR FABRICATION OF BUILDING COMPONENTS TO ALLOW FOR SHIM AND INSULATION SPACE.
- NOTE SLAB DEPRESSIONS FOR TILE AND ATHLETIC FLOORS AS INDICATED BY PLAN KEYNOTES AND INDICATED ON STRUCTURAL DRAWINGS.
- ALL BLOCKING AND PLYWOOD UTILIZED SHALL BE FIRE RETARDANT TREATED WOOD.
- ALL RATED CMU WALLS TO BE D-2 CLASSIFIED CMU.
- ALL EXTERIOR CONCRETE WALKS TO BE BEDDED ON 4" OF #57 STONE ON COMPACTED SUBGRADE WITHIN 6'-0" OF THE BUILDING. ADJOINING WALKS ON COMPACTED SUBGRADE. SEE CIVIL DRAWINGS.
- GC SHALL PROVIDE FIRE RETARDANT 3/4" PLYWOOD TO MOUNT PANELS AND EQUIPMENT.
- ALL EXTERIOR STEEL COMPONENTS TO BE HOT-DIPPED GALVANIZED, INCLUDING BUT NOT LIMITED TO ALL EXTERIOR STAIR AND HANDRAIL/GUARDRAIL COMPONENTS AND STEEL LITTELS.

PLAN KEYNOTES

- SLAB RECESSED IN THIS ROOM TO ACCOMMODATE SPECIALTY FLOORING - REFER TO FINISH PLAN. GC TO CONFIRM DEPTH OF RECESS WITH FLOORING MANUFACTURER PRIOR TO POURING THE SLAB.
- MECHANICAL LOUVER. REFER TO MECHANICAL DRAWINGS. GC TO COORDINATE OPENING SIZE AND PROVIDE LINTEL AND FLASHING.
- BUILDING EXPANSION JOINT. PROVIDE BLOCKOUTS IN SLAB FOR FLOOR TO FLOOR JOINTS - FLOOR TO FLOOR JOINTS. 2 HR. RATED 1" JOINT C/S GROUP MULTIFLEX MF-X-1F OR EQUAL - WALL TO WALL JOINTS. 2 HR. RATED 1" JOINT. C/S GROUP MULTIFLEX MF-X-1FW OR EQUAL - WALL JO
- ROLLING COUNTER DOOR. SEE SPECIFICATIONS.
- ADA ACTUATOR. ELECTRICAL CONTRACTOR PROVIDE BACKER BOXES AND CONDUIT. COORDINATE W/ GC & HARDWARE SUPPLIER.
- RECESS FLOOR 4 1/4" - COORDINATE WITH COOLER/FREEZER UNIT MANUFACTURER PRIOR TO POURING SLABS AND NOTIFY ARCHITECT OF DISCREPANCIES.
- LADDER - MEANS OF ESCAPE FROM MECHANICAL PLATFORM ABOVE.
- ROOF ACCESS LADDER - REFER TO ROOF PLAN A1-40.
- 40" WIDE SELF-CLOSING SAFETY GATE PER OSHA REQUIREMENTS.
- SLOPE SLAB TO DRAIN. SEE STRUCTURAL DRAWINGS FOR MINIMUM CONCRETE COVERAGE AT DRAIN LOCATION(S).
- COLUMN FEATURE. COUNTER AND WRAP. REFER TO DETAIL 15/A5-01.
- PIPE BOLLARD - SEE CIVIL DRAWINGS.
- OPERABLE PARTITION.
- NURSE EXAM CURTAIN.
- PROVIDE ELECTRONIC LOCKSET FOR SECURITY INTEGRATION THIS DOOR ASSEMBLY.

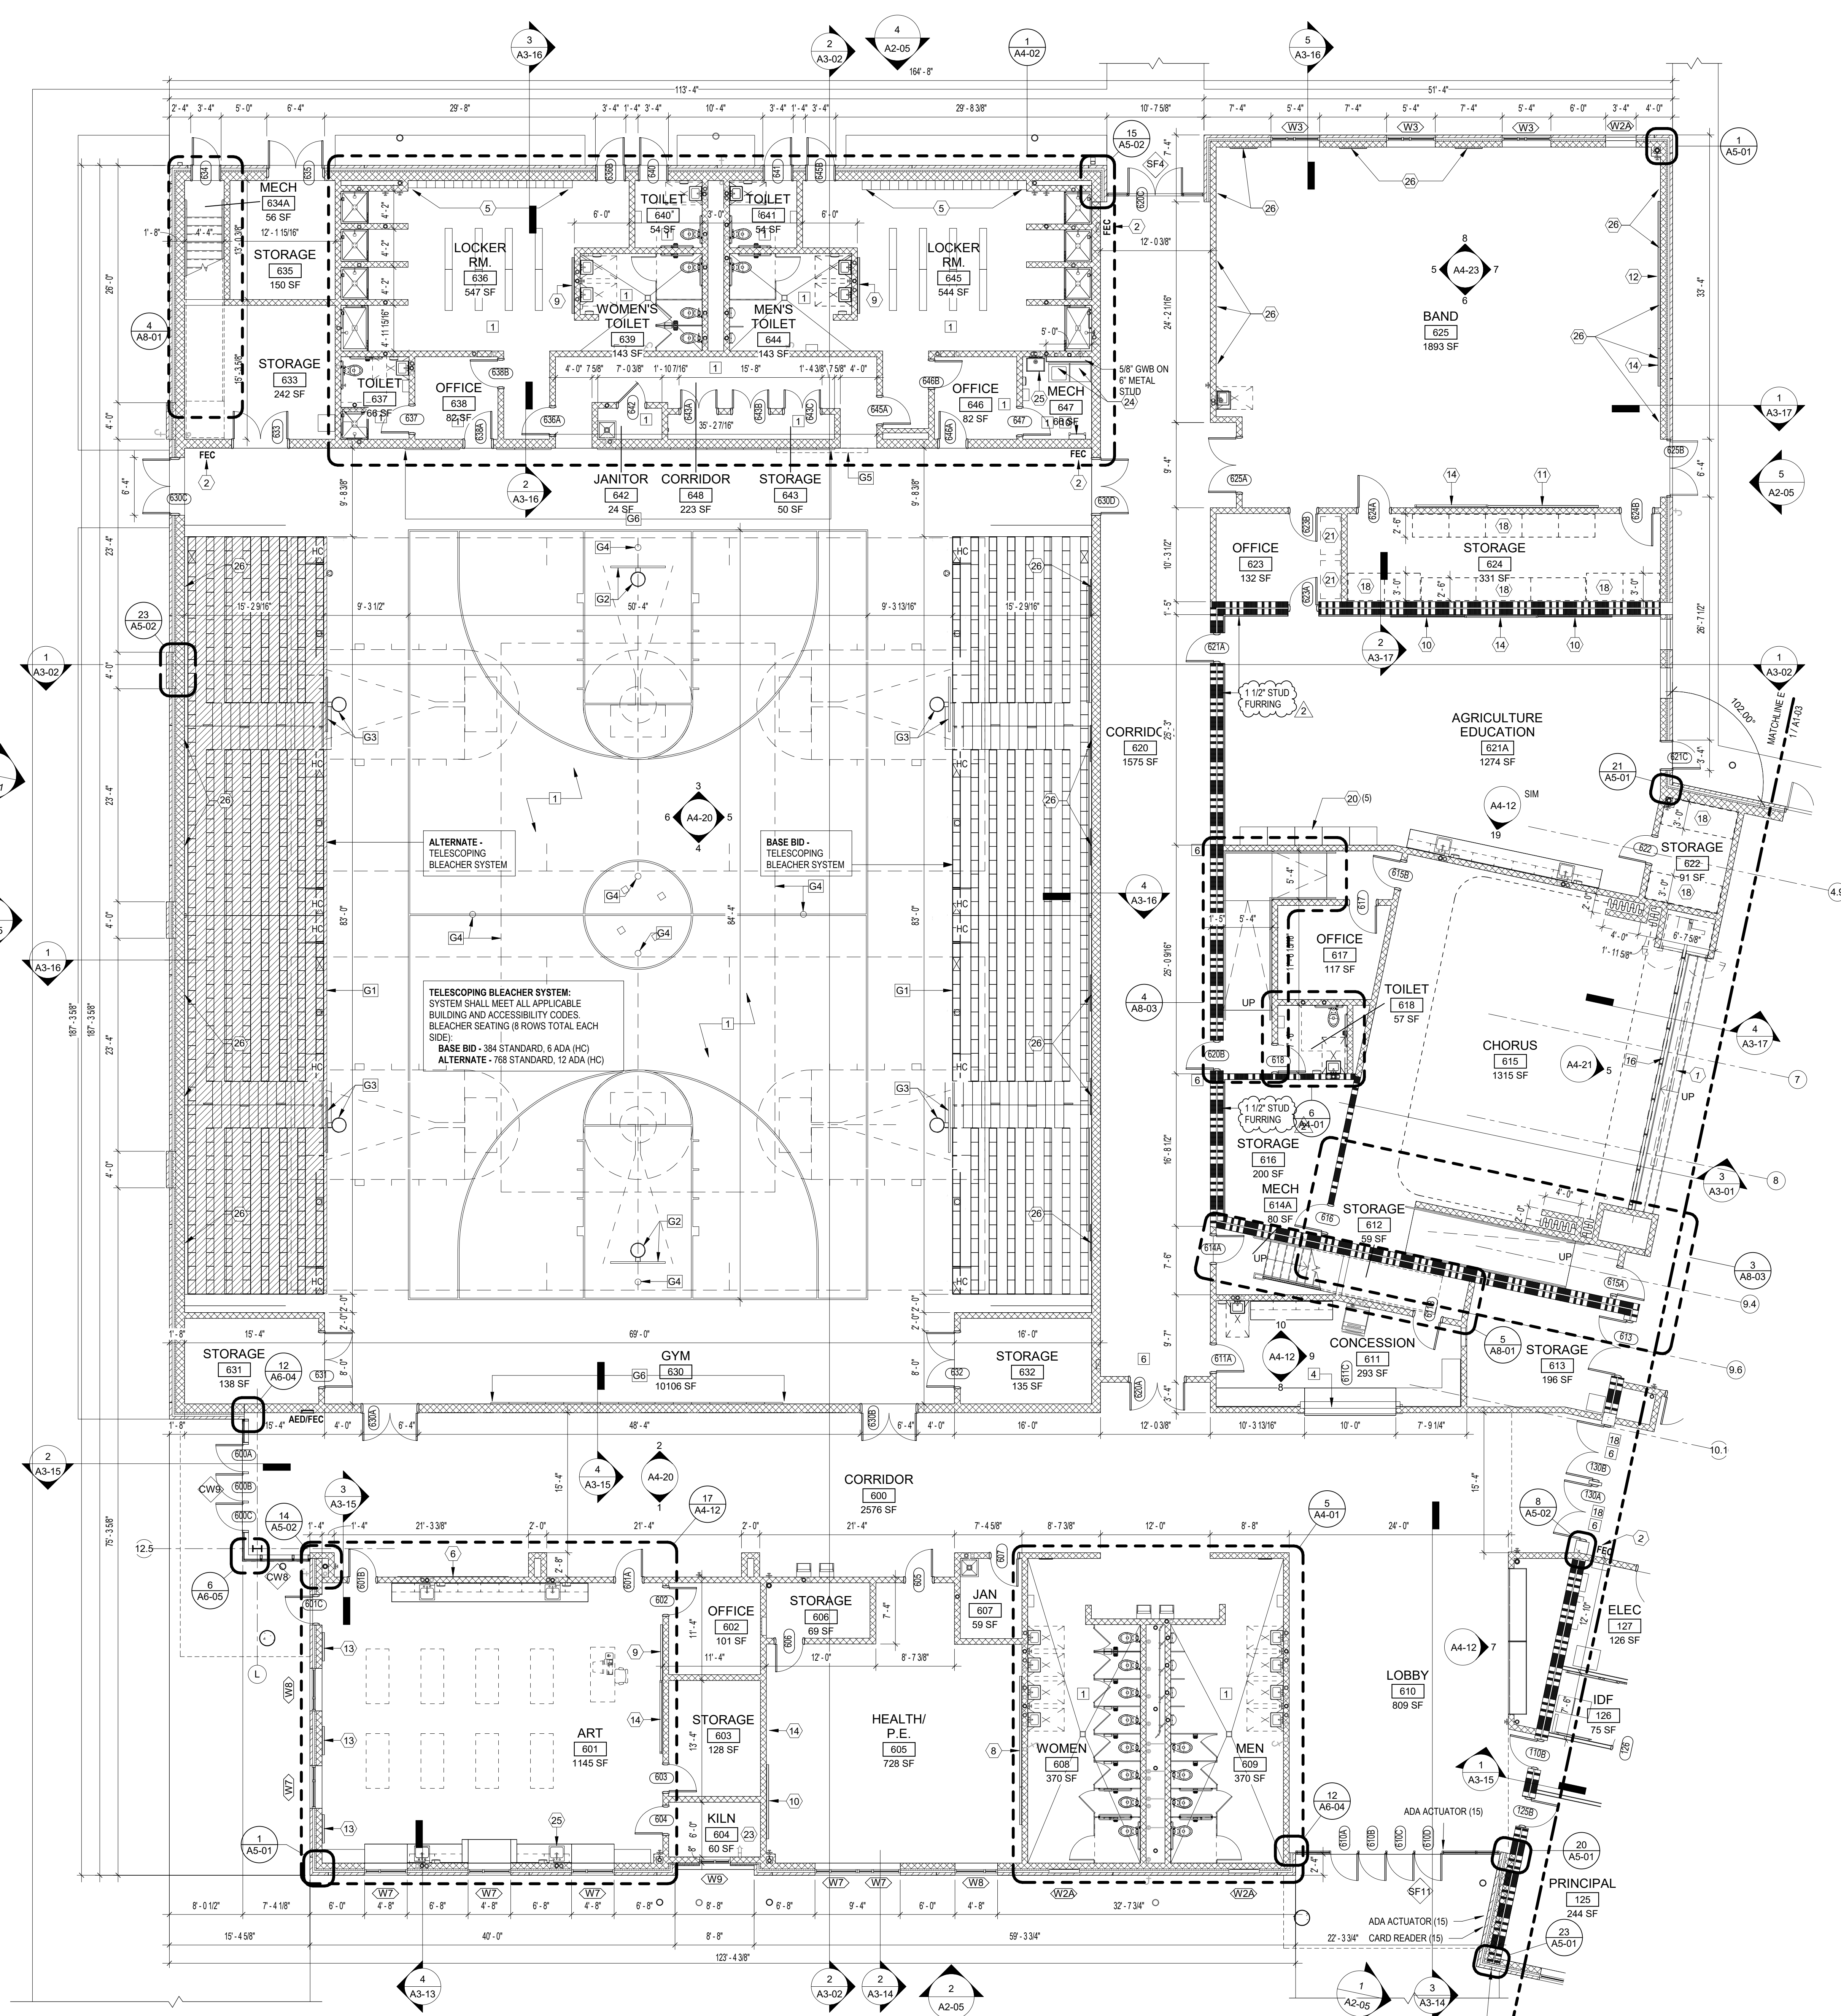

1 600 WING - FIRST FLOOR PLAN
 A1-09 1/8" = 1'-0"

GENERAL PLAN NOTES

- SEE WALL TYPES LEGEND ON SHEET A1.02 FOR TYPES INDICATED BY SYMBOL.
- ALL DOOR FRAMES SHALL BE 4" FROM THE FACE OF PERPENDICULAR WALLS UNLESS OTHERWISE INDICATED.
- ALL DIMENSIONS TAKEN FROM THE FINISHED FACE OF THE WALL (E.G. SURFACE OF CMU OR GYPSUM FOR STUD WALLS) AND THE CENTERLINE OF COLUMNS.
- ALL RATED WALL CONSTRUCTION TO COMPLY WITH U.L. REQUIREMENTS.
- REFER TO EXTERIOR ELEVATIONS FOR EXTERIOR MASONRY CONTROL JOINTS FOR INTERIOR CONTROL JOINTS.
- ALL EXTERIOR WINDOWS TO RECEIVE BLINDS AS SPECIFIED. INTERIOR WINDOWS MARKED "BL" TO RECEIVE BLINDS.
- FURNISHINGS SHOWN WITH DASHED LINES NOT IN CONTRACT UNLESS OTHERWISE NOTED.
- PROVIDE 1" RADIUS BULLNOSE UP TO A HEIGHT OF 8" AT ALL OUTSIDE CMU CORNERS FOR EXTERIOR WALLS.
- FIELD VERIFY AND COORDINATE FIELD CONDITIONS AND DIMENSIONS PRIOR TO FABRICATION, INSTALLATION AND CONSTRUCTION OF BUILDING COMPONENTS. THE GC IS TO INFORM THE ARCHITECT OF ANY DISCREPANCIES PRIOR TO PROCEEDING WITH THE WORK.
- FIRE RATED WALLS SHALL HAVE RATINGS STENCILED ABOVE THE CEILING FOR IDENTIFICATION. STENCILED LETTERS SHALL BE RED, 2" HIGH AT 10'-0" OC MAX ALONG WALL, I.E. "4 HR. RATED WALL."
- REFER TO G-01 FOR STANDARD ABBREVIATIONS AND NOTATIONS.
- GENERAL CONTRACTOR SHALL PROVIDE LITELLS FOR MASONRY OPENINGS AND WALL PENETRATIONS AS SHOWN ON ALL DRAWINGS. DIMENSIONS FOR MASONRY OPENINGS ON PLANS ARE GIVEN AS "ROUGH" OPENINGS. GC AND ALL SUBCONTRACTORS RESPONSIBLE FOR FABRICATION OF BUILDING COMPONENTS TO ALLOW FOR SHIM AND INSULATION SPACE.
- NOTE SLAB DEPRESSIONS FOR TILE AND ATHLETIC FLOORS AS INDICATED BY PLAN KEYNOTES AND INDICATED ON STRUCTURAL DRAWINGS.
- ALL BLOCKING AND PLYWOOD UTILIZED SHALL BE FIRE RETARDANT TREATED WOOD.
- ALL RATED CMU WALLS TO BE D-2 CLASSIFIED CMU.
- ALL EXTERIOR CONCRETE WALKS TO BE BEDDED ON 4" OF #57 STONE ON COMPACTED SUBGRADE WITHIN 6'-0" OF THE BUILDING. ADJOINING WALKS ON COMPACTED SUBGRADE, SEE CIVIL DRAWINGS.
- GC SHALL PROVIDE FIRE RETARDANT 3/4" PLYWOOD TO MOUNT PANELS AND EQUIPMENT.
- ALL EXTERIOR STEEL COMPONENTS TO BE HOT-DIPPED GALVANIZED, INCLUDING BUT NOT LIMITED TO ALL EXTERIOR STAIR AND HANDRAIL/GUARDRAIL COMPONENTS AND STEEL LITELLS.

PLAN KEYNOTES

- SLAB RECESSED IN THIS ROOM TO ACCOMMODATE SPECIALTY FLOORING - REFER TO FINISH PLAN. GC TO CONFIRM DEPTH OF RECESS WITH FLOORING MANUFACTURER PRIOR TO POURING THE SLAB.
- MECHANICAL LOUVER - REFER TO MECHANICAL DRAWINGS. GC TO COORDINATE OPENING SIZE AND FLASHING.
- BUILDING EXPANSION JOINT - PROVIDE BLOCKING IN SLAB FOR FLOOR TO FLOOR JOINTS - FLOOR TO FLOOR JOINTS: 2 HR. RATED 1" JOINT C/S GROUP MULTIFLEX MFX-1F OR EQUAL - WALL TO WALL JOINTS: 2 HR. RATED 1" JOINT, C/S GROUP MULTIFLEX MFX-1F OR EQUAL - WALL JOINT.
- ROLLING COUNTER DOOR - SEE SPECIFICATIONS.
- ADA ACTUATOR - ELECTRICAL CONTRACTOR PROVIDE BACKER BOXES AND CONDUIT, COORDINATE W/ GC & HARDWARE SUPPLIER.
- PROVIDE MAGNETIC DOOR HOLD OPENS FOR THIS DOOR ASSEMBLY. REFER TO ELECTRICAL DRAWINGS AND DOOR SCHEDULE FOR SPECIFICATIONS.
- GC TO PROVIDE BONDBEAM LITEL OVER THIS OPENING.
- PROVIDE MECHANICAL DOOR HOLD OPENS FOR THIS DOOR ASSEMBLY.
- RECESS FLOOR 4 1/4" - COORDINATE WITH COOLER/FREEZER UNIT MANUFACTURER PRIOR TO POURING SLAB AND NOTIFY ARCHITECT OF DISCREPANCIES.
- LADDER - MEANS OF ESCAPE FROM MECHANICAL PLATFORM ABOVE.
- ROOF ACCESS LADDER - REFER TO ROOF PLAN A1-40.
- 4" WIDE SELF-CLOSING SAFETY GATE PER OSHA REQUIREMENTS
- SLOPE SLAB TO DRAIN. SEE STRUCTURAL DRAWINGS FOR MINIMUM CONCRETE COVERAGE AT DRAIN LOCATION(S).
- COLUMN FEATURE: COUNTER AND WRAP - REFER TO DETAIL 15A-A-01
- PIPE BOLLARD - SEE CIVIL DRAWINGS
- OPERABLE PARTITION
- NURSE EXAM CURTAIN
- PROVIDE ELECTRONIC LOCKSET FOR SECURITY INTEGRATION THIS DOOR ASSEMBLY

EQUIPMENT SCHEDULE - ATHLETIC EQUIP.

- G1 MANUAL TELESCOPING COMPOSITE BLEACHER SYSTEM, CFCI
- G2 MAIN COURT, MOTORIZED FOLDING BACKSTOP SYSTEM W/ GLASS BACKBOARD, EDGE PADDING, RIM, HEIGHT ADJUSTMENT WINCH, FOLD UP WINCH AND SAFETY STRAPS, CFCI
- G3 CROSS COURT, MOTORIZED FOLDING BACKSTOP SYSTEM W/ GLASS BACKBOARD, EDGE PADDING, RIM, HEIGHT ADJUSTMENT WINCH, FOLD UP WINCH AND SAFETY STRAPS, CFCI
- G4 ALUMINUM VOLLEYBALL, TENNIS STANDARDS, NETS, AND FLOOR INSERTS, SEE DETAIL 11/A1-20, CFCI
- G5 2'-4" X 6'-0", L.E.D. SCORE BOARD W/ REMOTE CONTROL CONSOLE, REFER TO ALLOWANCES
- G6 2 x 6 SAFETY WALL PANELS. COLOR AS SELECTED BY ARCHITECT. (35 TOTAL), CFCI

SCHEDULE ABBREVIATIONS
 CFCI- CONTRACTOR FURNISHED CONTRACTOR INSTALLED
 OFCI- OWNER FURNISHED CONTRACTOR INSTALLED
 OFOI- OWNER FURNISHED OWNER INSTALLED

- NOTES
- G.C. IS RESPONSIBLE FOR COORDINATING TELESCOPING BLEACHER SUPERSTRUCTURE AND LOCATIONS OF UNDER BLEACHER CHASE DOORS AND ELECTRICAL OUTLETS.
 - PROVIDE THREE (3) PAIRS OF VOLLEYBALL FLOOR INSERTS AND TWO (2) SETS OF STANDARDS AND NETS.
 - MAIN COURT STRIPING SHALL COMPLY WITH THE NORTH CAROLINA DEPARTMENT OF PUBLIC INSTRUCTION MIDDLE/JR. HIGH ATHLETICS MANUAL AND THE NORTH CAROLINA HIGH SCHOOL ATHLETICS ASSOCIATION STANDARDS WHEN NOT OTHERWISE INDICATED.

GENERAL EQUIPMENT SCHEDULE


Mark	Description and/or Detail Reference	Furnished By	Remarks
1	MOTORIZED RECESSED PROJECTION SCREEN.	CFCI	
2	FIRE EXTINGUISHER AND SEMI-RECESSED FIRE EXT. CABINET. REFER TO TYPICAL DETAIL 6/A5-01.	CFCI	
3	FIRE EXTINGUISHER AND FIRE EXT. BRACKET. REFER TO TYPICAL DETAIL 6/A5-01.	CFCI	
4	COPY MACHINE	OFCI	
5	METAL LOCKER SYSTEM. REFER TO DETAIL 11/A4-02. COLOR AS SELECTED BY ARCHITECT.	CFCI	
6	12'-0" TACK STRIP. REFER TO SPECIFICATIONS.	CFCI	
7	WALL MOUNTED ROOF ACCESS LADDER AND ROOF ACCESS HATCH. REFER TO DETAIL 6/A5-40.	CFCI	
8	12'-0" MARKER BOARD, 6'-0" TACKBOARD. REFER TO SPECIFICATIONS.	CFCI	
9	6'-0" MARKER BOARD. REFER TO SPECIFICATIONS.	CFCI	
10	8'-0" MARKER BOARD. REFER TO SPECIFICATIONS.	CFCI	
11	12'-0" MARKER BOARD. REFER TO SPECIFICATIONS.	CFCI	
12	16'-0" MARKER BOARD. REFER TO SPECIFICATIONS.	CFCI	
13	3'-0" TACKBOARD. REFER TO SPECIFICATIONS.	CFCI	
14	4'-0" TACKBOARD. REFER TO SPECIFICATIONS.	CFCI	
15	8'-0" SMART BOARD.	OFCI	
16	FULL SIZED REFRIGERATOR. 21.7 CUBIC FT. COORDINATE WITH PLUMBING AND ELECTRICAL.	OFCI	
17	MICROWAVE. COORDINATE W/ ELECTRICAL.	OFCI	
18	PREMANUFACTURED OPEN WOOD SHELVING UNITS. REFER TO TYPICAL DETAIL 4/A4-01.	OFCI	
19	LAPTOP STORAGE CART	OFCI	
20	TALL TEACHER WARDROBE. SIZE - 24D X 84H X 36W	CFCI	
21	SHELVE SHEET LIBRARY AND SORTING RACK CABINET - 24D X 84H X 48W	OFCI	
22	30"x60" INSTRUCTOR'S DESK W/ SINK	CFCI	
23	ELECTRIC KILN, 6.4 CUBIC FOOT FIRING CHAMBER, WITH DOWN DRAFT VENTILATION SYSTEM AND KILN SHELVES. SKUTT OR EQUAL. 6.4 CF FIRING CHAMBER.	OFCI	
24	ATHLETIC WASHER AND DRYER ASSEMBLY BY OWNER.	OFCI	
25	UTILITY SINK BASIN WITH SUPPORT LEGS. REFER TO PLUMBING DRAWINGS.	CFCI	3
26	FABRIC COVERED ACOUSTICAL WALL PANELS. CONSULT W/ ARCHITECT FOR FINAL LAYOUT. SEE SPECIFICATIONS.	CFCI	2
27	WASHER AND DRYER ASSEMBLY BY OWNER.	OFCI	2

SCHEDULE ABBREVIATIONS
 CFCI- CONTRACTOR FURNISHED CONTRACTOR INSTALLED
 OFCI- OWNER FURNISHED CONTRACTOR INSTALLED
 OFOI- OWNER FURNISHED OWNER INSTALLED

- NOTES
- G.C. TO PROVIDE 3/4" FIRE RETARDANT PLYWOOD PANEL TO MOUNT EQUIPMENT.
 - G.C. TO PROVIDE NECESSARY BLOCKING & REINFORCING PLATES IN GWB WALLS & REINFORCING IN CMU WALLS.
 - PROVIDE CLAY SINK TRAP THIS LOCATION. SEE PLUMBING DRAWINGS.




1 919 781 8582
 4600 Lake Boone Trail
 Suite 205
 Raleigh, NC 27607
 info@smithsinnett.com

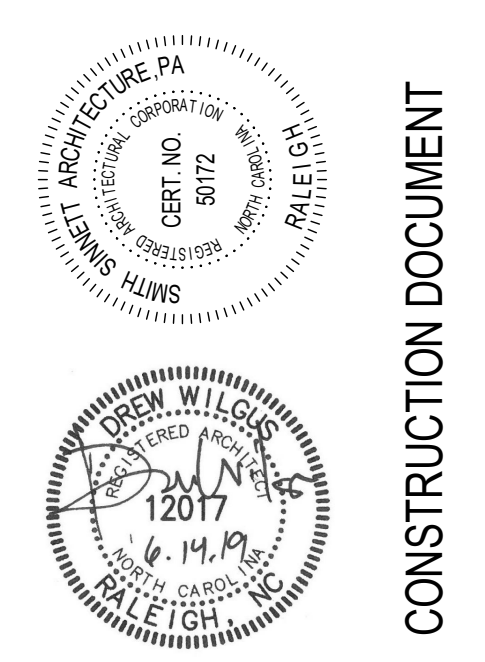

VOLUME I

This drawing is the property of Smith Sinnett Architecture, P.A. Its reproduction or use for any purpose without the written consent of Smith Sinnett Architecture, P.A. is prohibited. Any infringement of the copyright rights of Smith Sinnett Architecture, P.A. will be subject to legal action. All copies of this drawing are to be made at the completion of the contract.
 Smith Sinnett Architecture, P.A. 2018
 THIS DRAWING IS FORWARDED TO BE PRINTED ON A 30" X 42" SHEET

TRINITY MIDDLE SCHOOL
 RANDOLPH COUNTY SCHOOL SYSTEM
 Parcel PIN 7708118367
 Surratt Drive
 Trinity, NC 27370



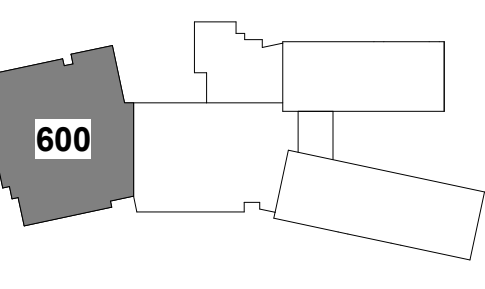


KEY PLAN
 NO SCALE

600

FLOOR PLAN

2017032 20 MAY 2019
 A1-09

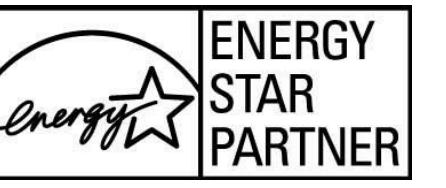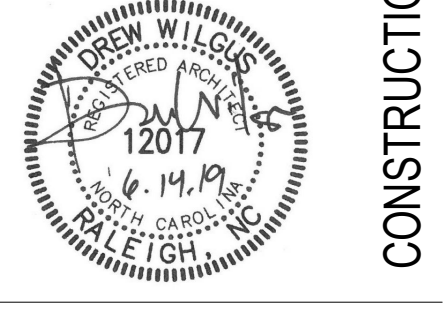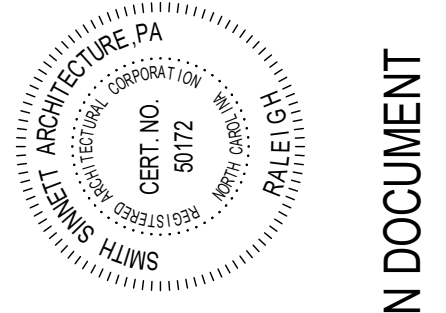


VOLUME I

The drawings and their contents are the property of Smith Sinnett Architecture, P.A. The reproduction or use of this project without the written consent of Smith Sinnett Architecture, P.A. is prohibited. Any infringement of the copyright rights will be subject to legal action. All copies are subject to the terms and conditions of the contract.
Smith Sinnett Architecture, P.A. 2018
THIS DRAWING IS FORMATTED TO BE PRINTED ON A 30" X 42" SHEET

TRINITY MIDDLE SCHOOL
RANDOLPH COUNTY SCHOOL SYSTEM


Parcel PIN 7708118367
Surrett Drive
Trinity, NC 27370

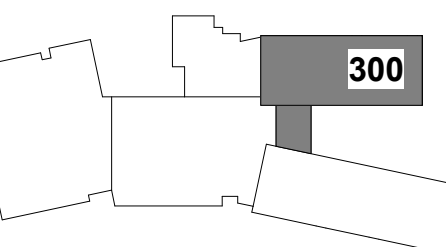

KEY PLAN
NO SCALE

6/14/19 ADDENDUM 3
ID DATE DESCRIPTION
DRAWN BY: LP, JS, DW
CHECKED BY: DW

REFLECTED
CEILING PLAN

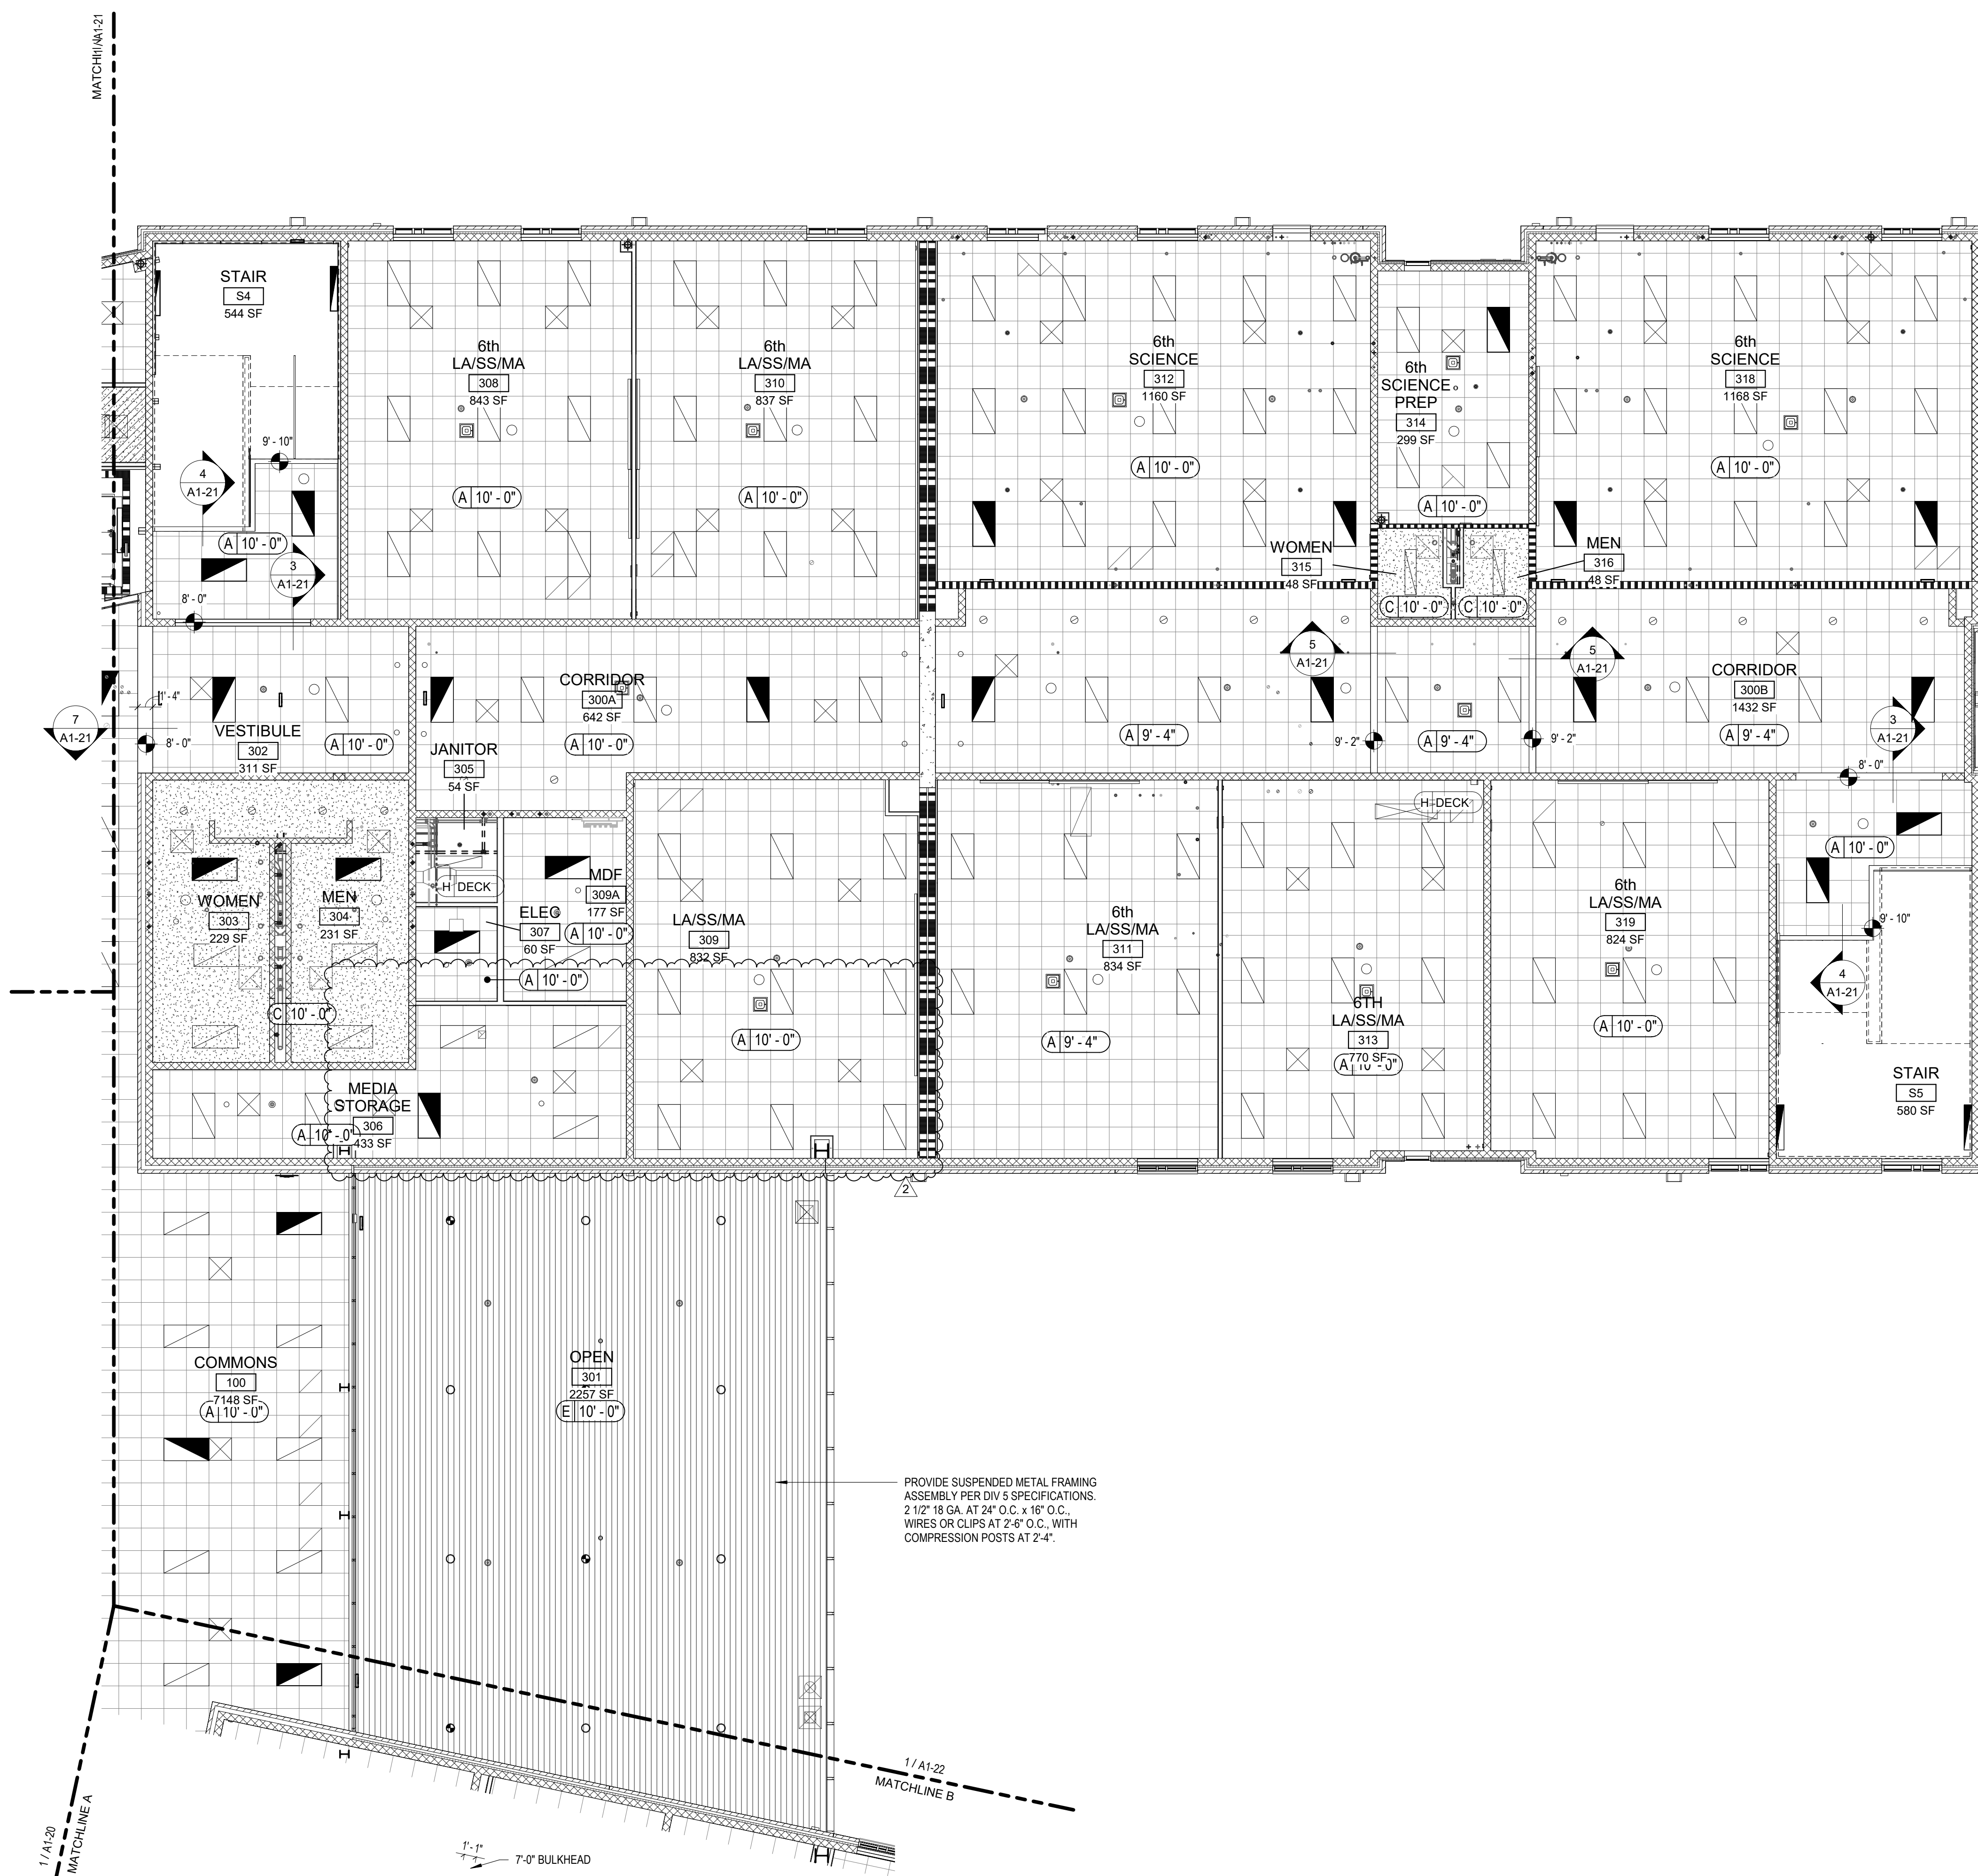

1 300 WING - FIRST FLOOR CEILING PLAN
A1-23 1/8" = 1'-0"

REFLECTED CEILING PLAN NOTES

- CURTAIN TRACK
- NO CEILING REQ'D OVER FREEZER / COOLER AREA.
- KITCHEN HOOD. REFER TO MECHANICAL PLANS.
- SMOKE VENTS ABOVE - COORDINATE LOCATION OF RELEASE CABLE AND CRANK W/ CURTAIN TRACK AND STRUCTURE.
- ATHLETIC EQUIPMENT
- DUCTWORK, SEE MECHANICAL
- MANUAL OPERABLE PARTITION.
- S.S. CLOSURE PANEL FROM TOP OF FREEZER / COOLER TO CEILING AS SCHEDULED BY FOOD SERVICE EQUIP. PROVIDER.
- PRE-MANUFACTURED POST SUPPORTED CANOPY.
- CEILING CLOUD. 6" VERTICAL PERIMETER TRIM, TYP.
- RECESSED PROJECTION SCREEN.
- RECESS IN GYPSUM BULKHEAD AT STEEL COLUMN. SEE DETAIL 10/A1-21
- CEILING ACCESS PANEL. 2x2
- 1HR. RATED GYPSUM FURRING AT UNDERSIDE OF STAIRS


REFLECTED CEILING LEGEND AND NOTES

CEILING TYPE		
A 10'-0" CEILING HEIGHT		
SYMBOL	TYPE	DESCRIPTION
[Grid Pattern]	A	ACT-1, 2x2 CEILING TILE, WHITE FINISH
[Grid Pattern]	B	ACT-2, 2x2 VINYL COVERED TILE AND GRID, WHITE FINISH, HOLD DOWN CLIPS
[Stippled Pattern]	C	MOISTURE RESISTANT GYP WALLBOARD
[Stippled Pattern]	D	ONE (1) HOUR RATED GYP WALLBOARD CEILING SYSTEM - REFER TO NER-258
[Horizontal Lines]	E	METAL SOFFIT PANEL - PERFORATED
[Horizontal Lines]	--	
[Empty Box]	F	EXPOSED - STRUCTURE, PLUMBING, DUCTWORK AND METAL DECKING PAINTED WHITE
[Empty Box]	G	EXPOSED - STRUCTURE, PLUMBING, DUCTWORK AND METAL DECKING PAINTED BLACK
[Empty Box]	H	EXPOSED - NO FINISH
SYMBOL	DESCRIPTION	
[Rectangle]	1 X 4 LIGHT FIXTURE	
[Rectangle]	2 X 4 LIGHT FIXTURE	
[Square]	RETURN AIR GRILLE	
[Square]	SUPPLY AIR DIFFUSER	
[Square]	EXHAUST DIFFUSER	
[Circle]	CAN STYLE FIXTURE	
[Circle]	CEILING ACOUSTICAL DIFFUSER PANEL	
[Circle]	PENDANT LIGHT	
[Horizontal Line]	DIRECT/INDIRECT LINEAR PENDANT	
[Horizontal Line]	HANGING LIGHT FIXTURE	
[Horizontal Line]	WALL MOUNTED UPLIGHT	






- REFER TO PLUMBING, MECHANICAL, AND ELECTRICAL DRAWINGS FOR COMPLETE SCOPE OF CEILING PENETRATIONS AND FIXTURES.
- REFER TO PROJECT SPECIFICATIONS FOR COMPLETE DESCRIPTION OF CEILING MATERIAL.

GENERAL WALL SECTION NOTES


- COORDINATE ALL LINTEL AND BOND BEAM REQUIREMENTS WITH STRUCTURAL DRAWINGS AND SPECIFICATIONS
- SEE STRUCTURAL DRAWINGS FOR FOUNDATION AND FOOTING REQUIREMENTS
- PROVIDE HORIZONTAL JOINT REINFORCEMENT, TIES AND OTHER ANCHORAGE AND REINFORCING PER SPECIFICATIONS

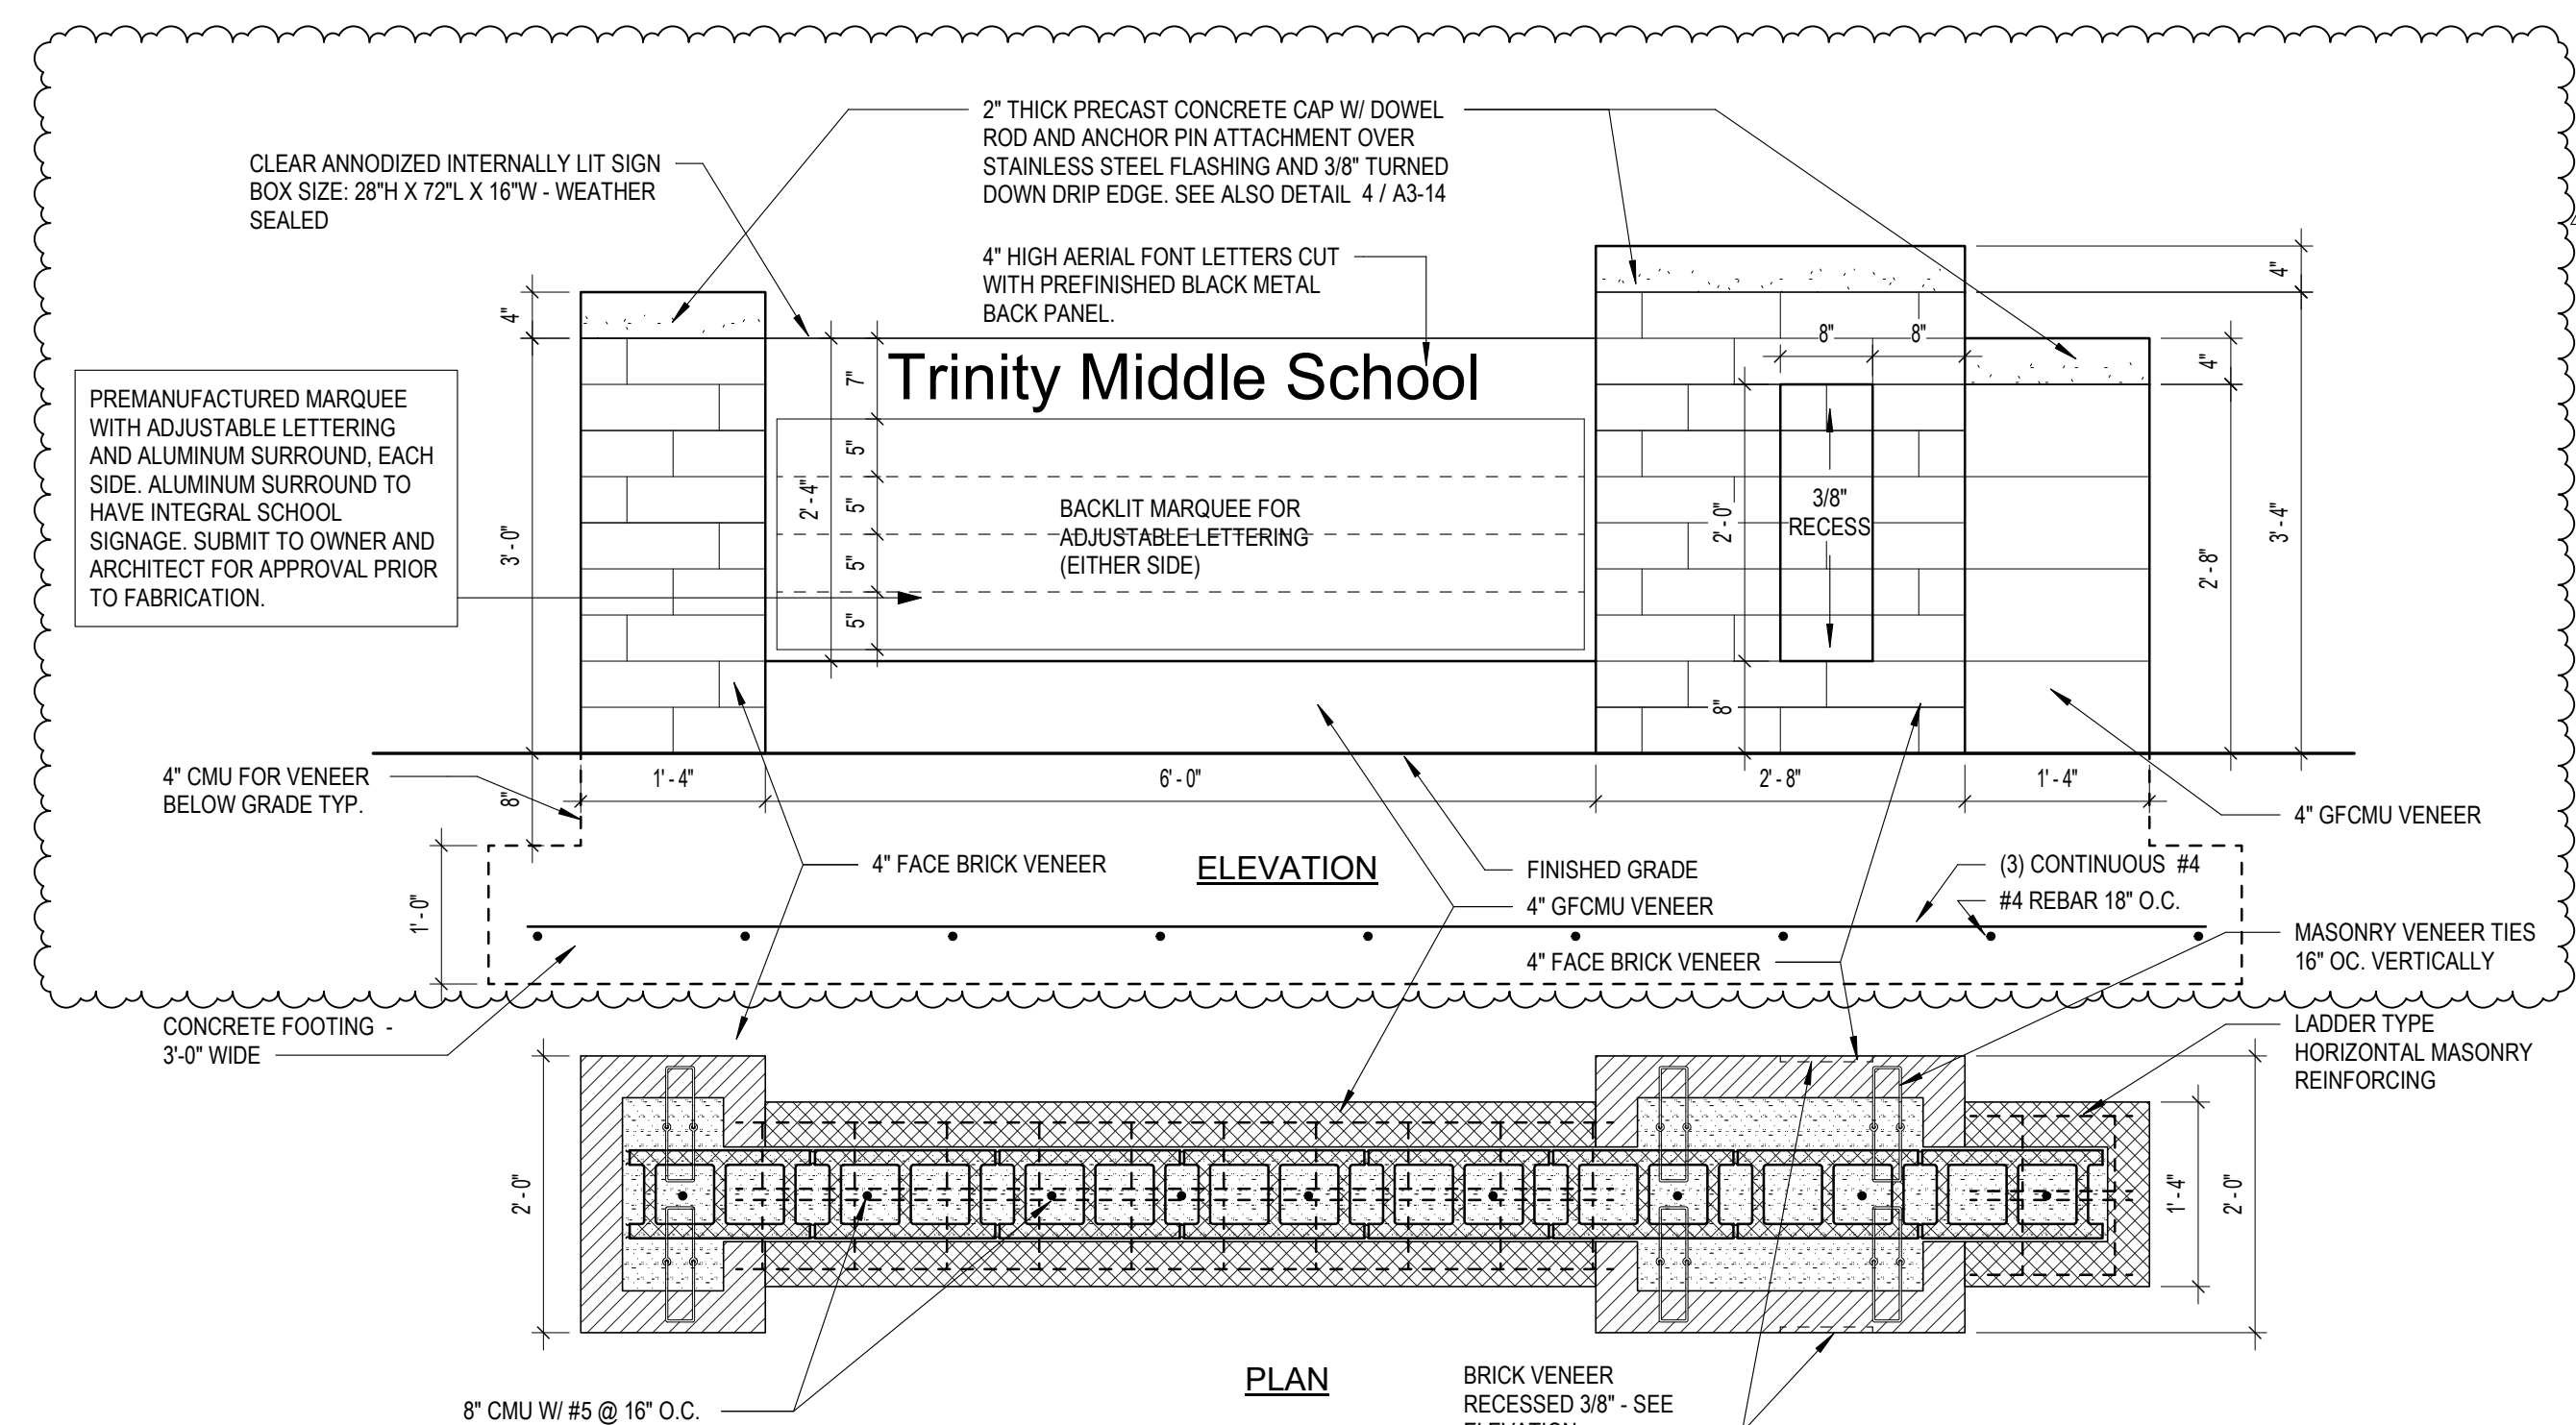

7 MONUMENTAL SIGN
A3-13 3/4" = 1'-0"

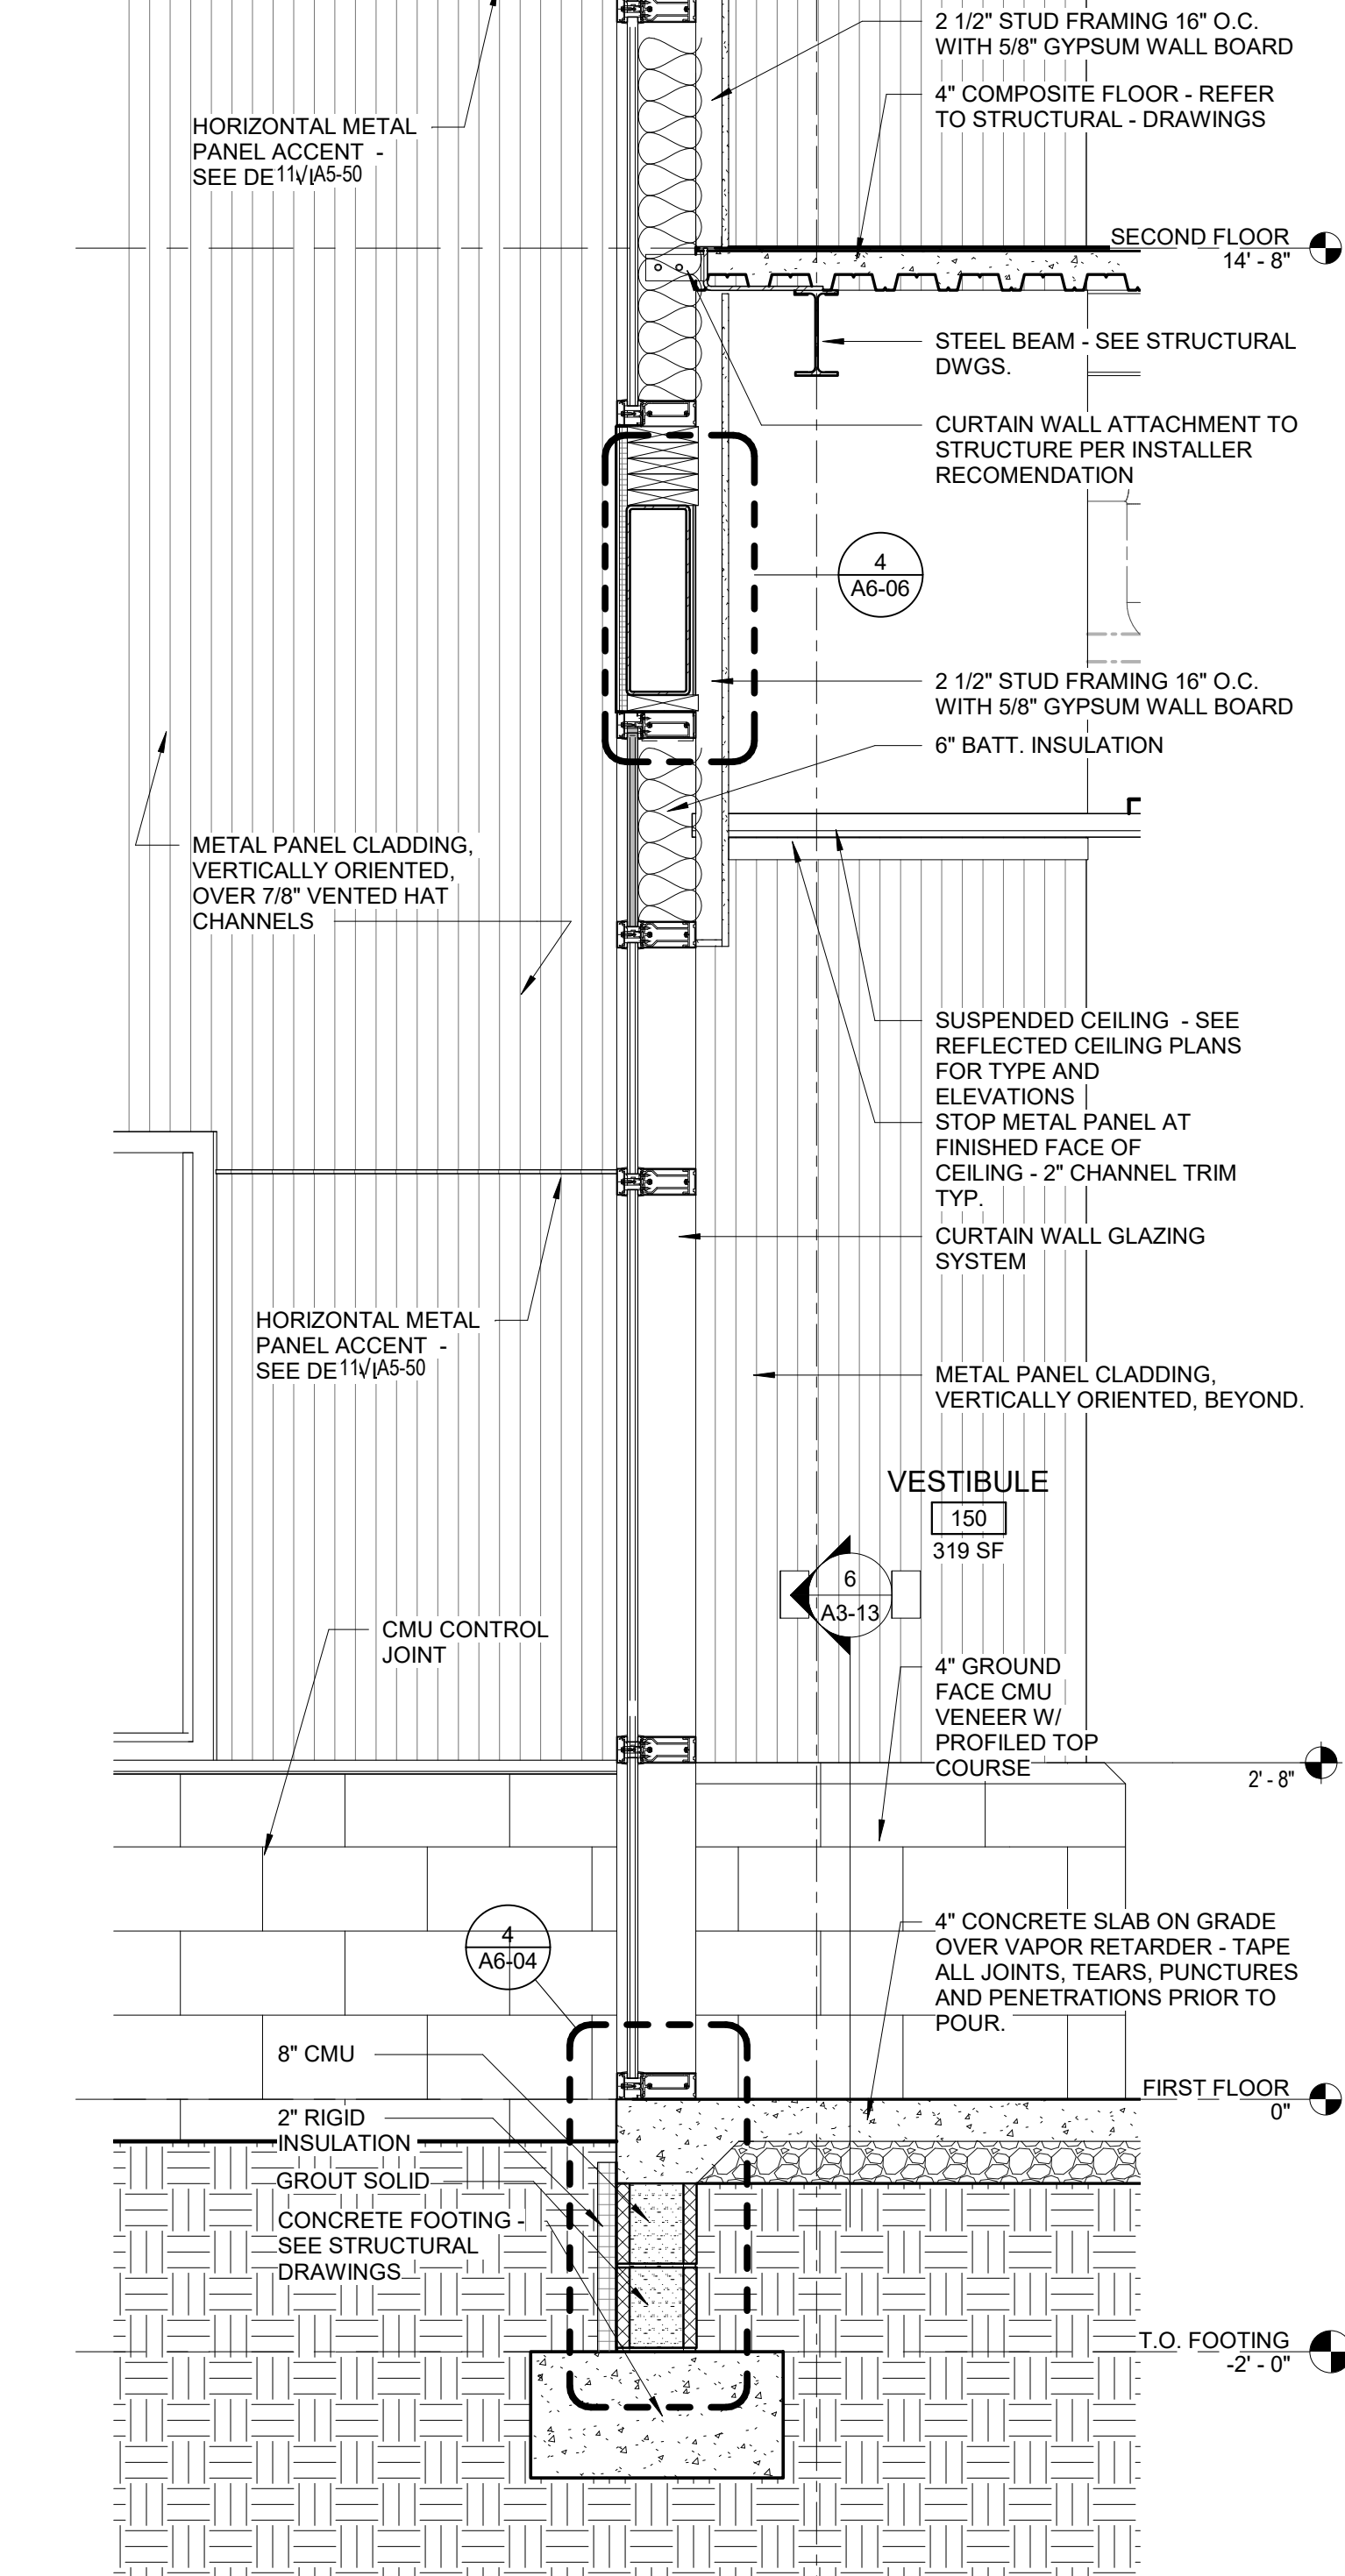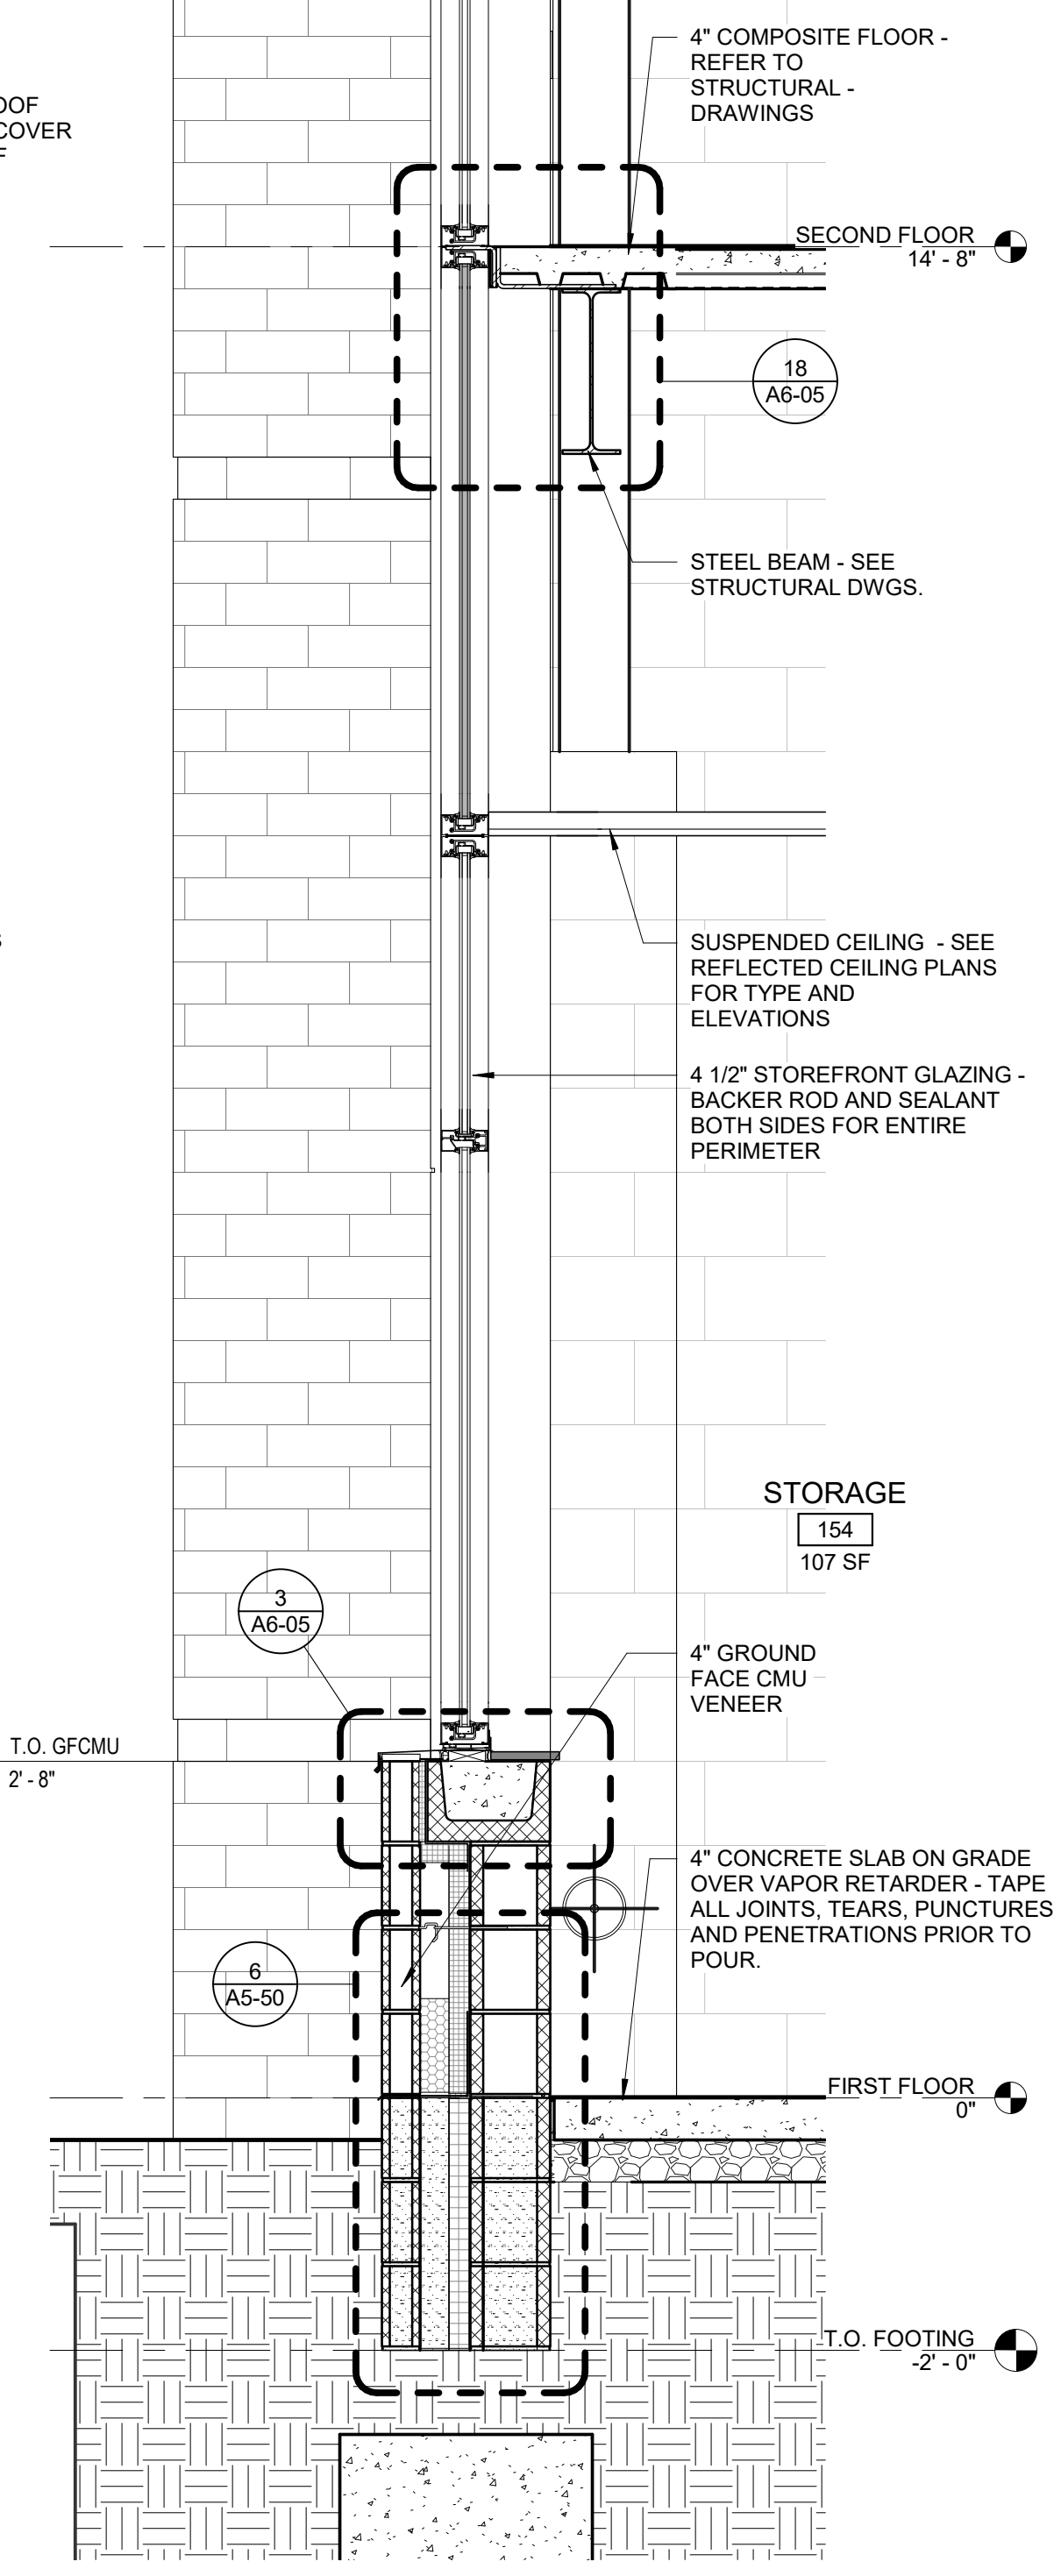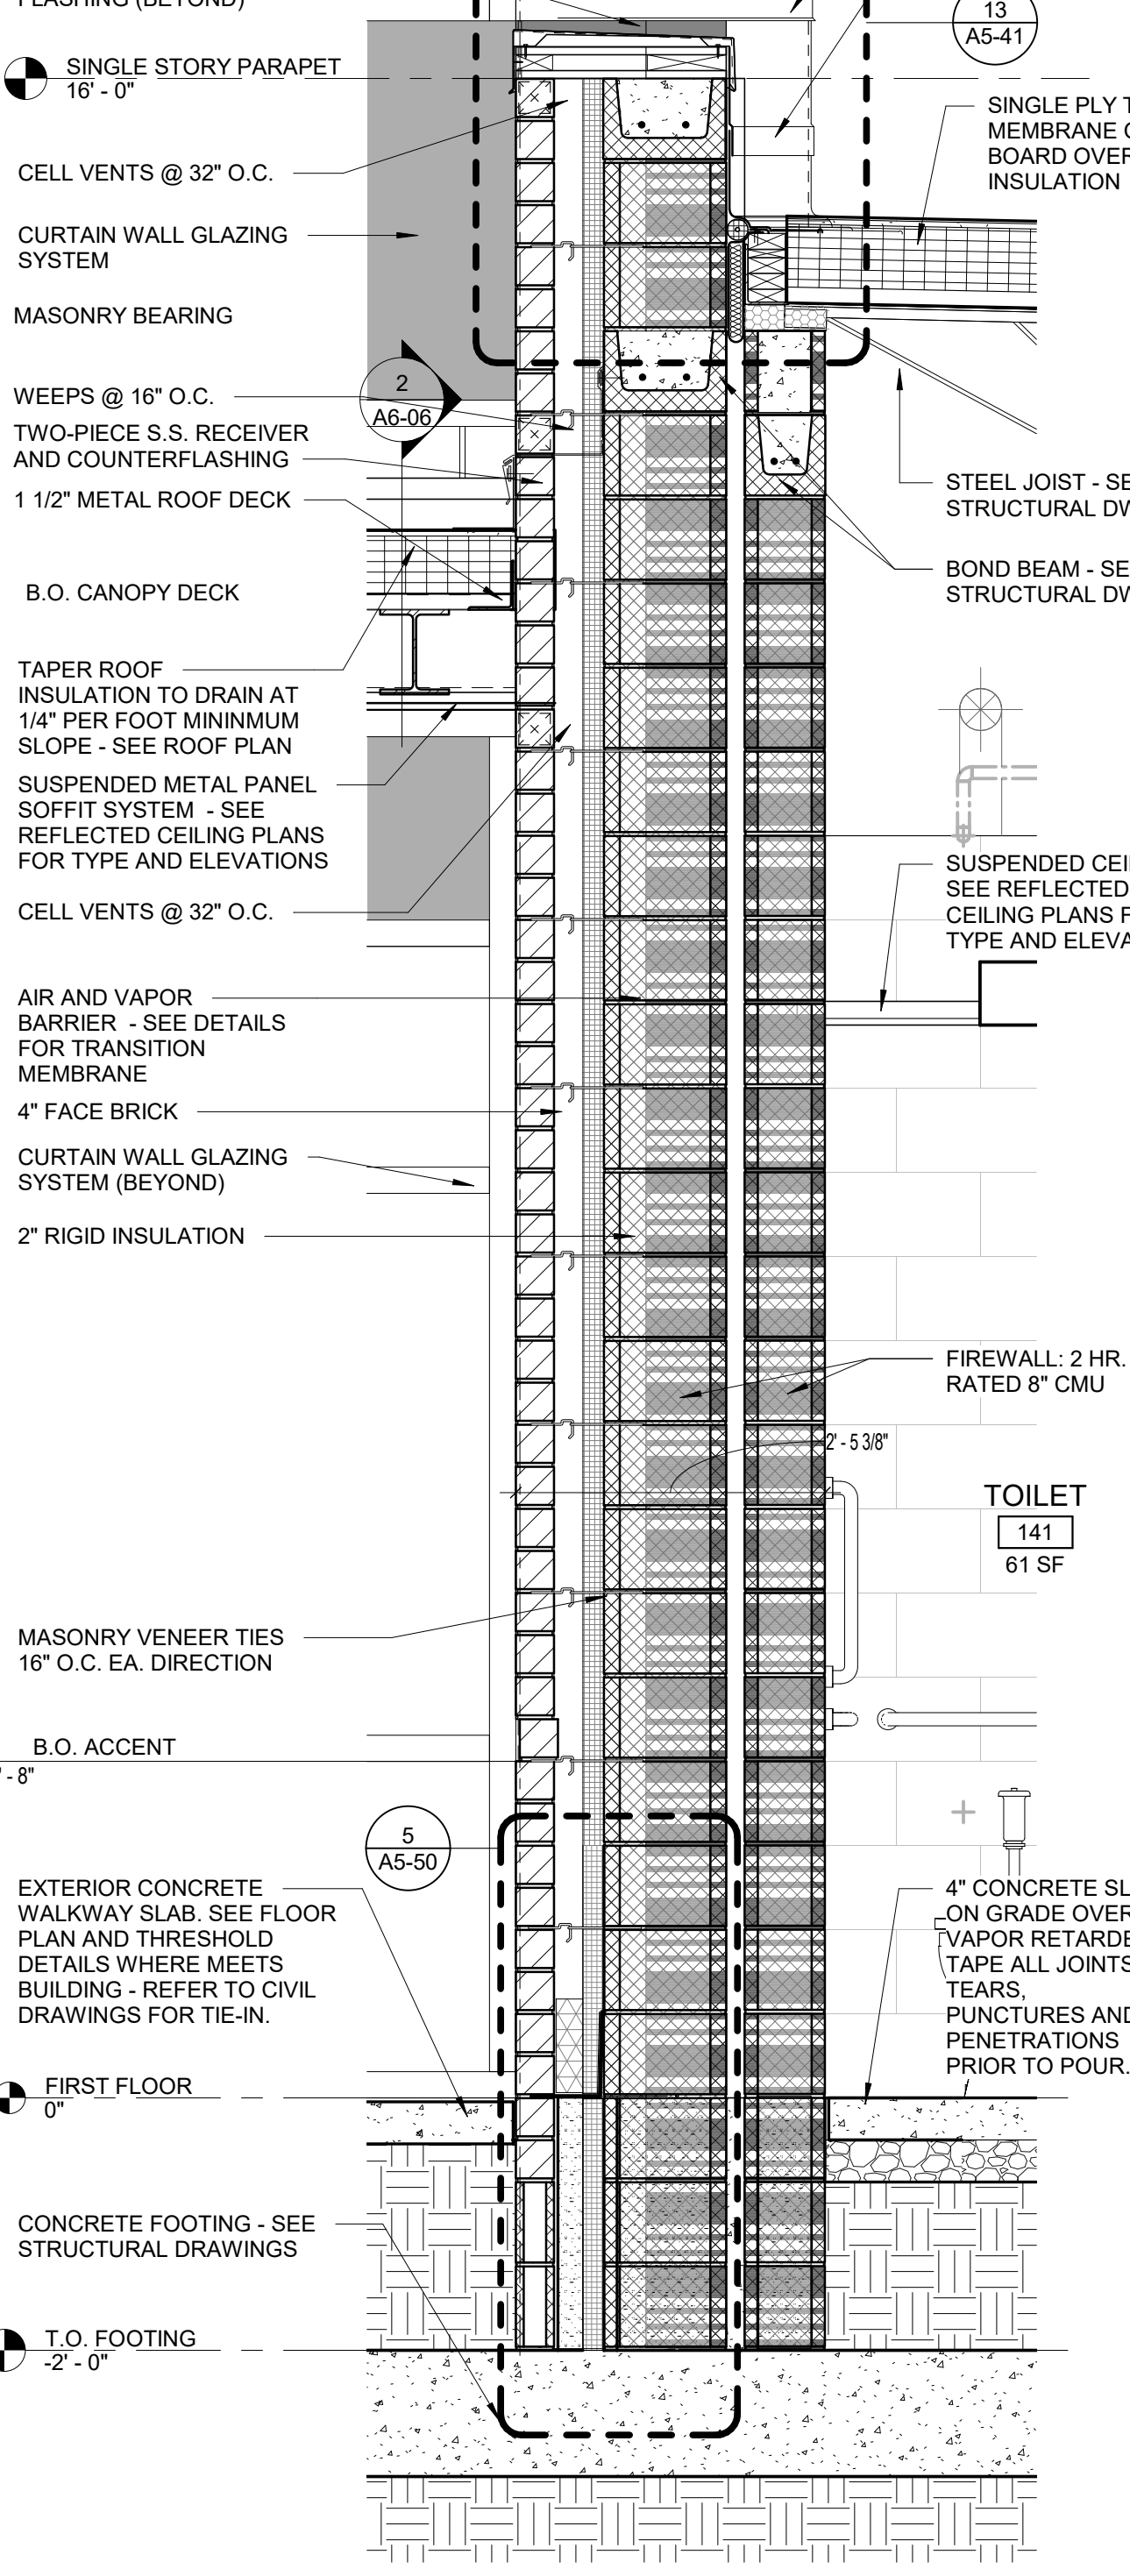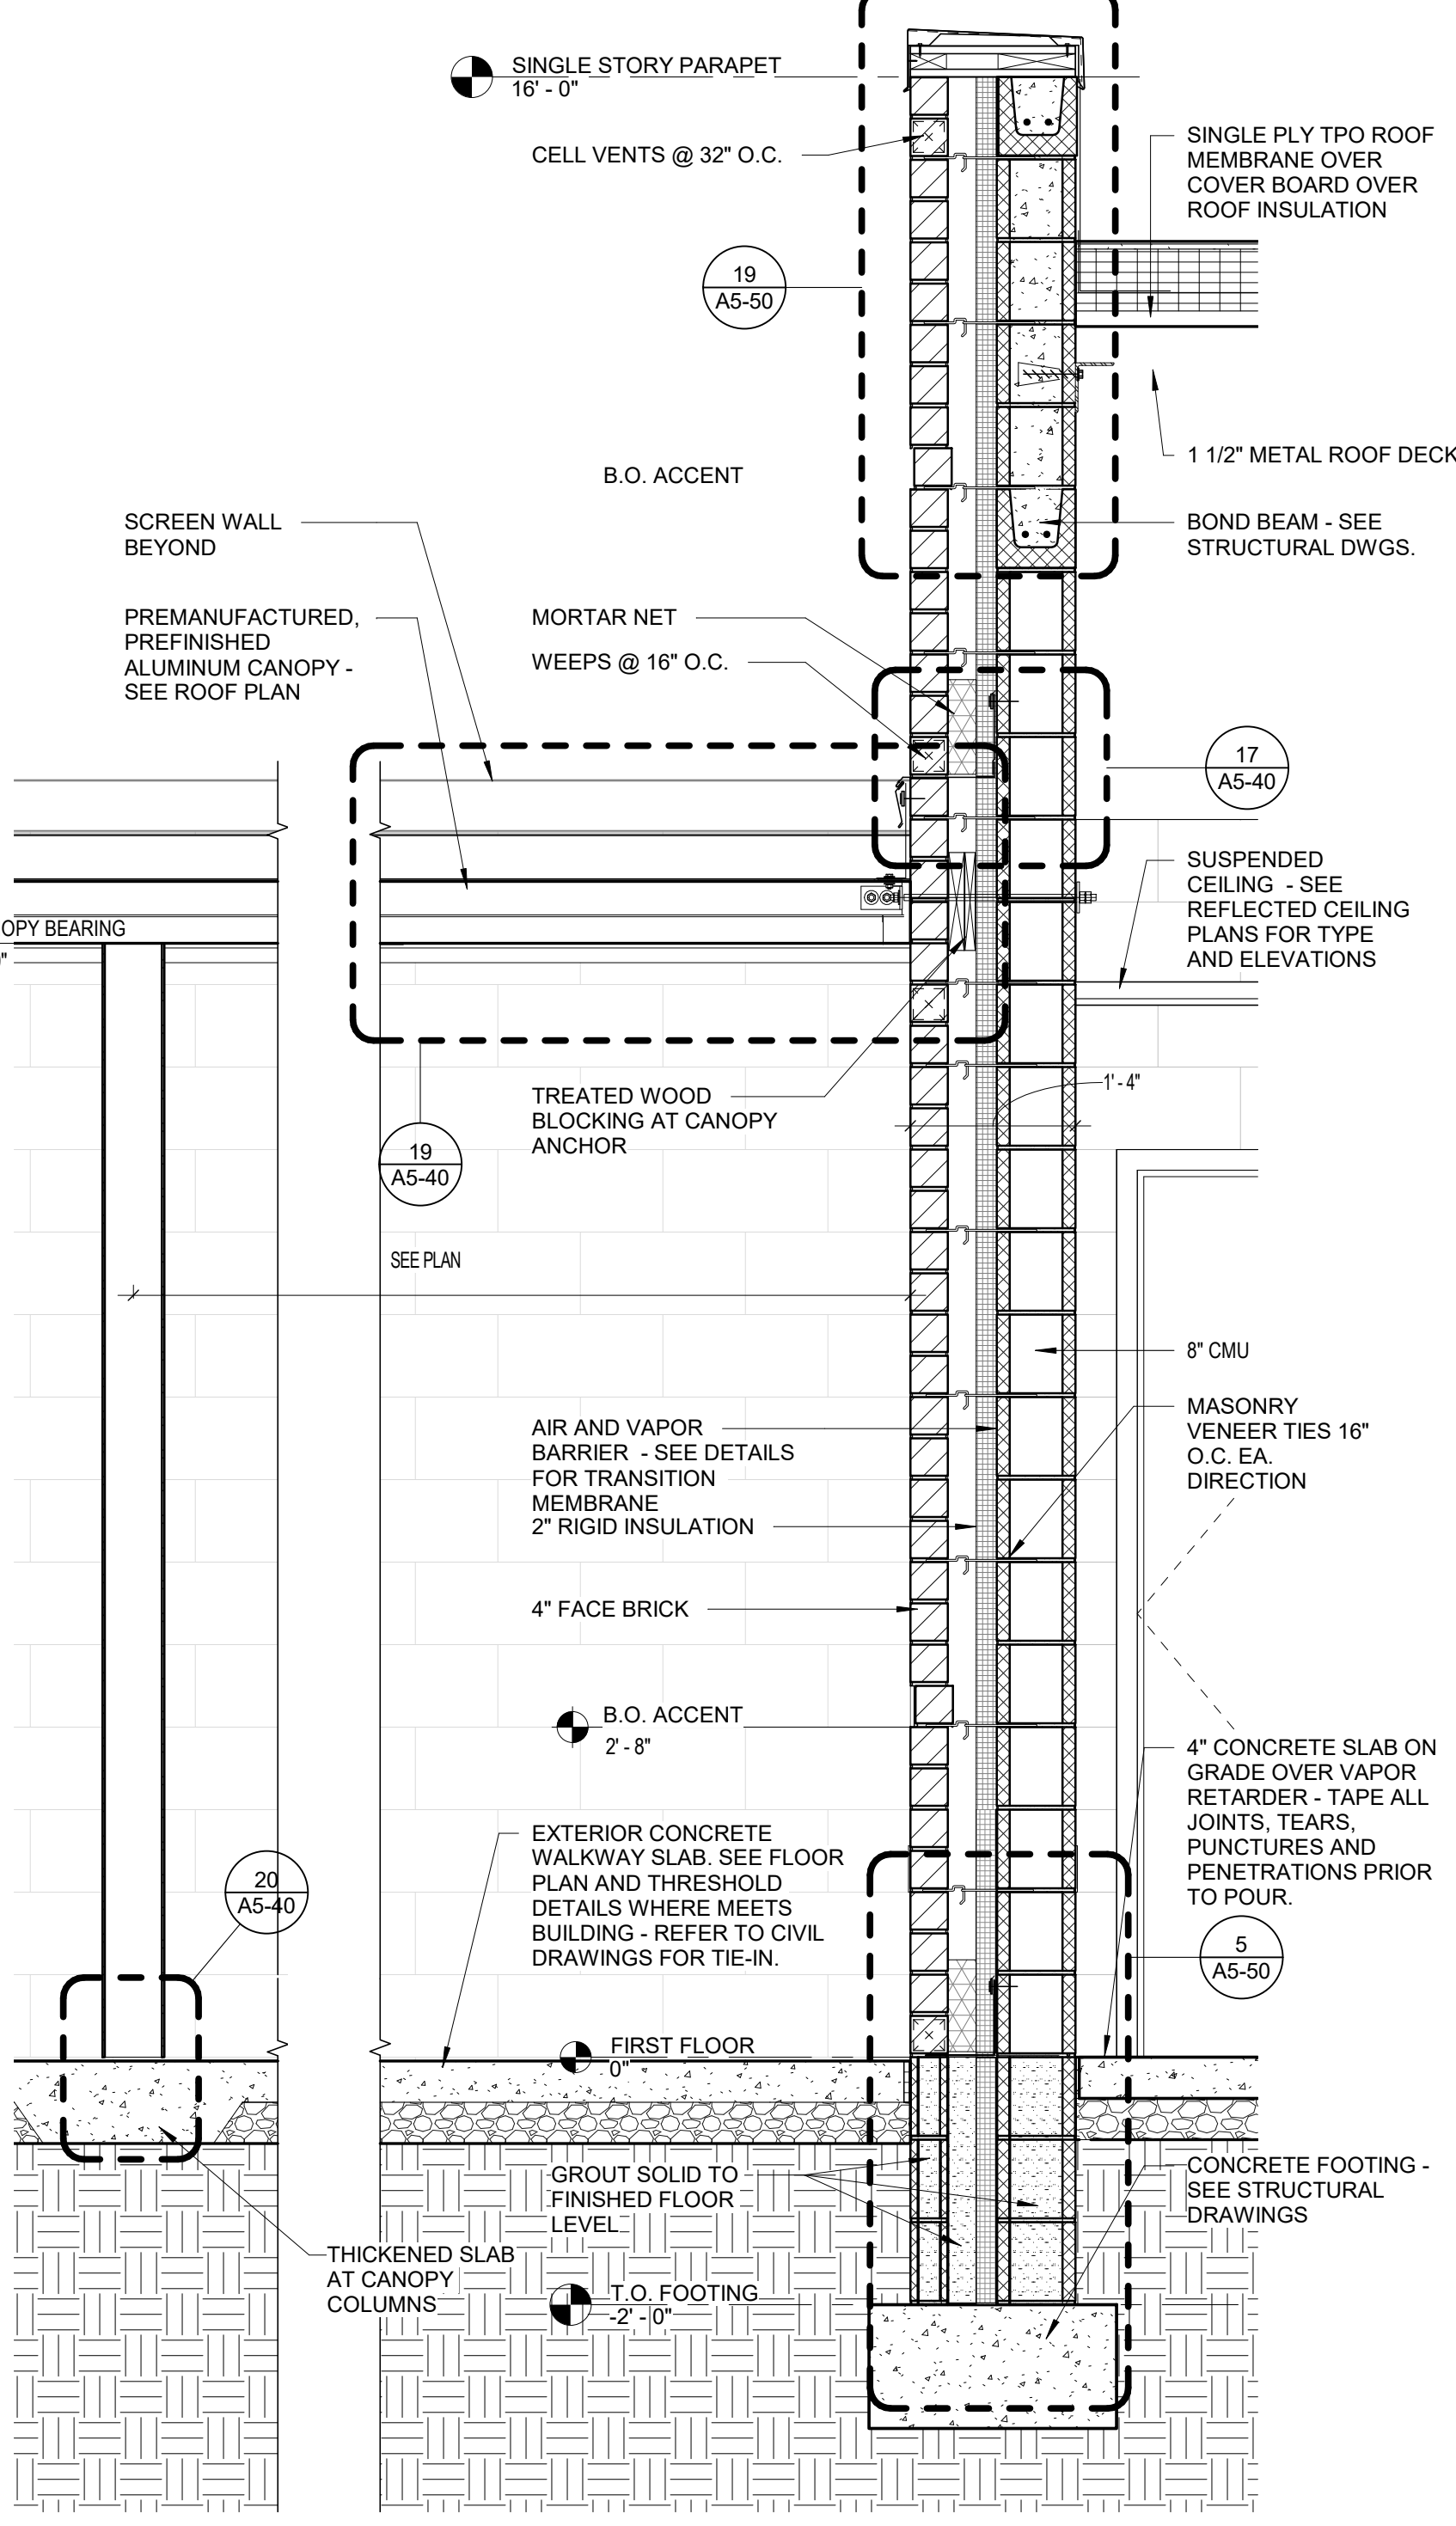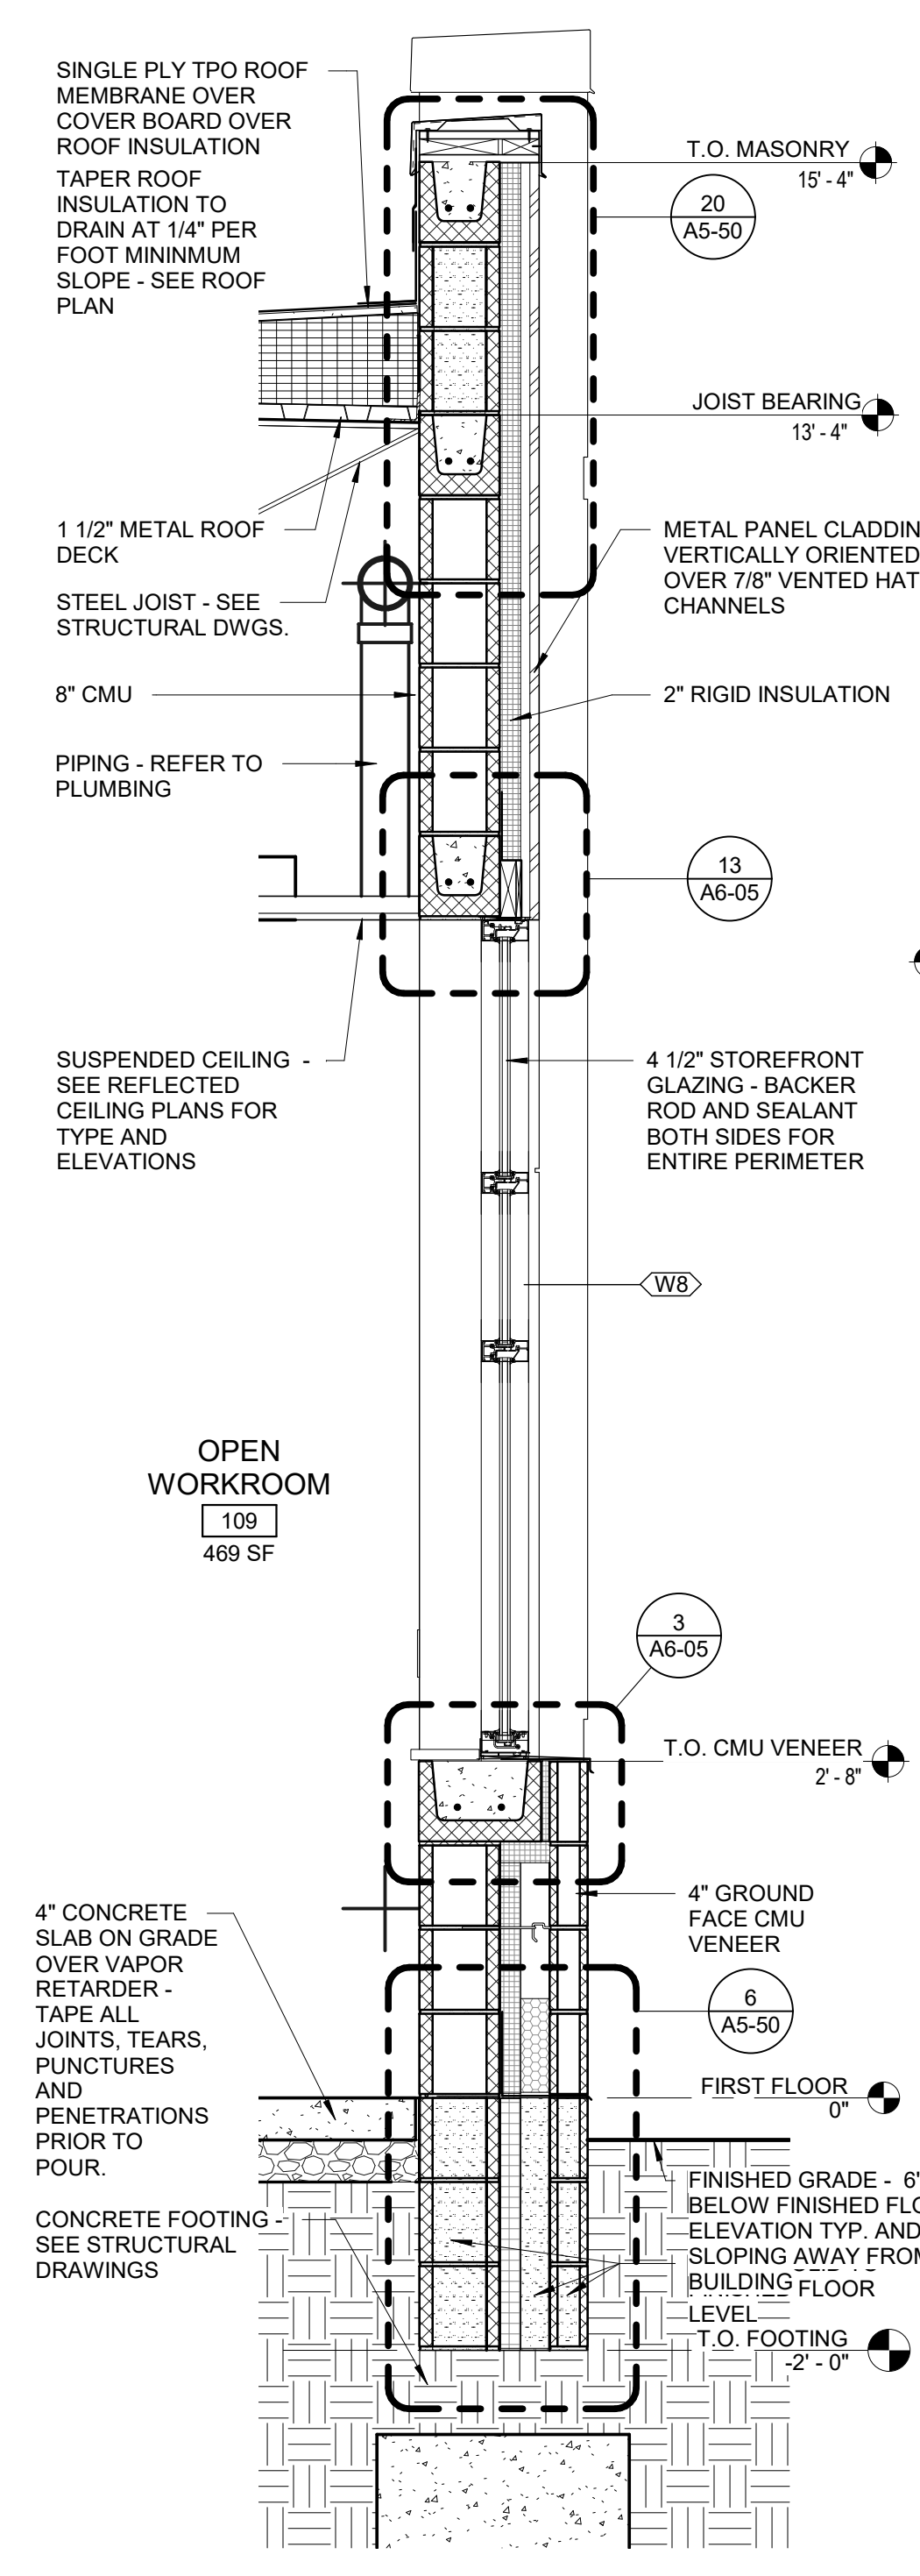




6 INTERIOR MASONRY BASE
A3-13 1" = 1'-0"

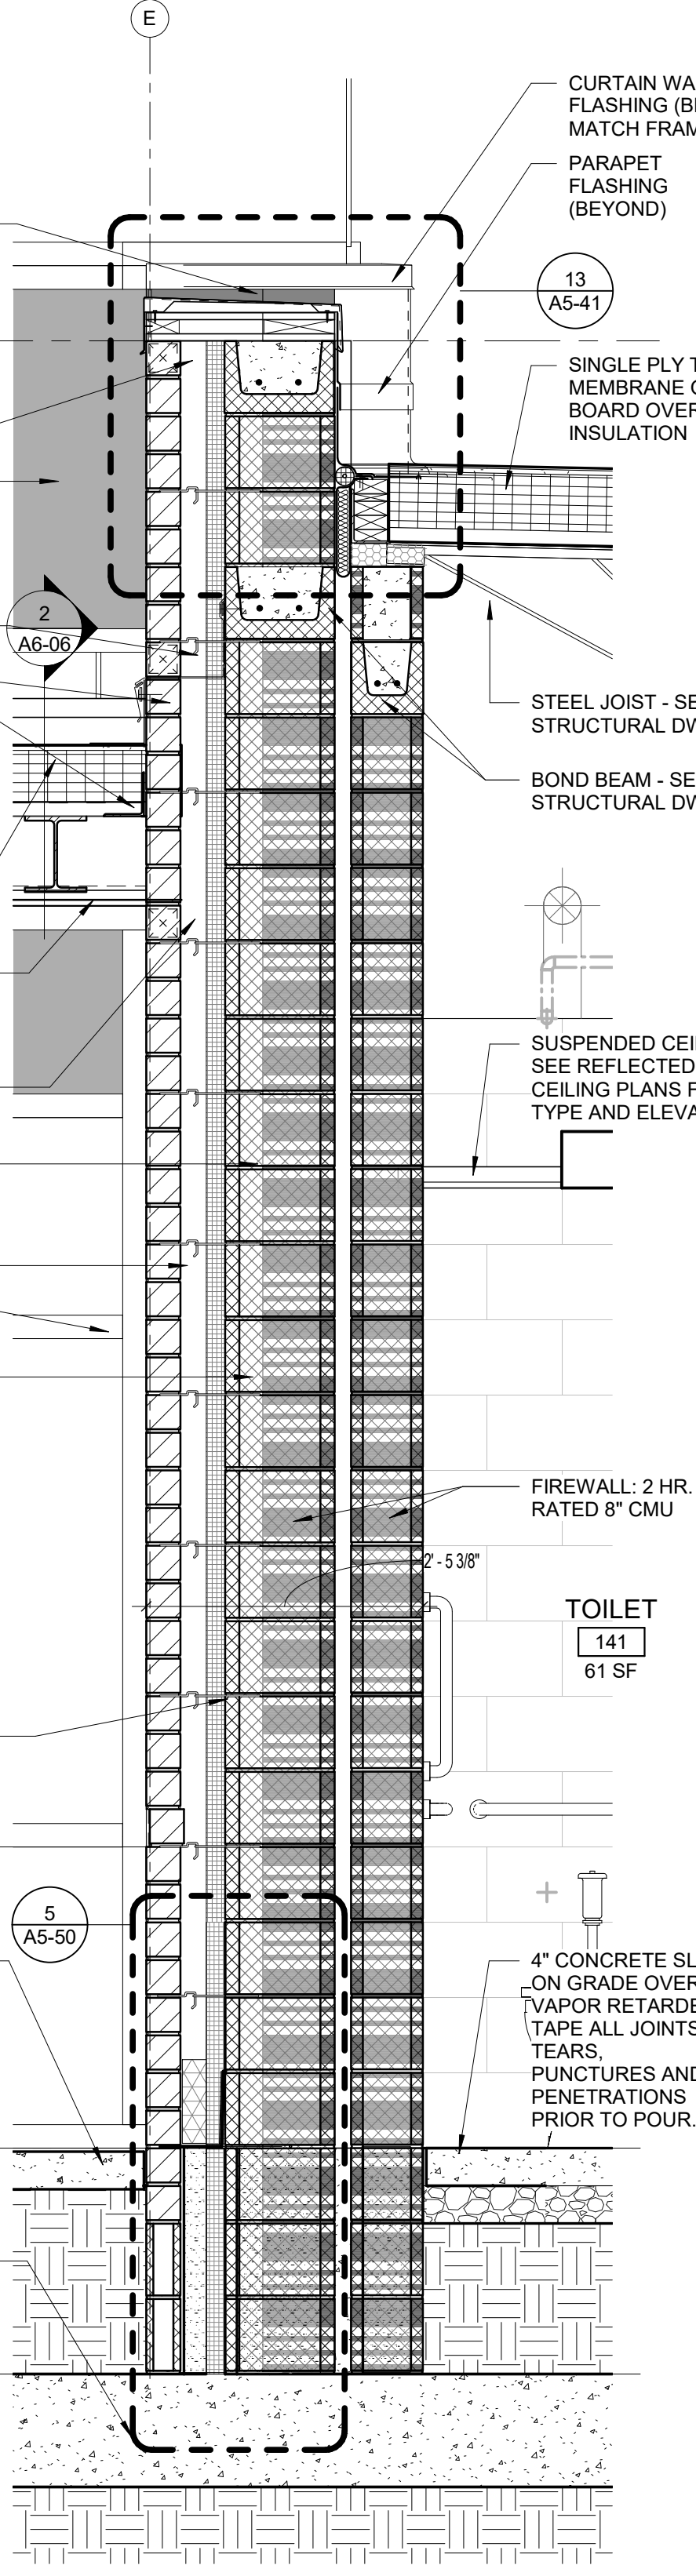




The drawings and their contents are the property of Smith Sinnett Architecture, P.A. The reproduction or use of this project without the written consent of Smith Sinnett Architecture, P.A. is prohibited. Any infringement of the copyright rights will be subject to legal action. All copies are to be made from the original drawings. Architect at the completion of the contract.
Smith Sinnett Architecture, P.A. 2018
THIS DRAWING IS FORMATTED TO BE PRINTED ON A 30" X 42" SHEET

CONSTRUCTION DOCUMENT

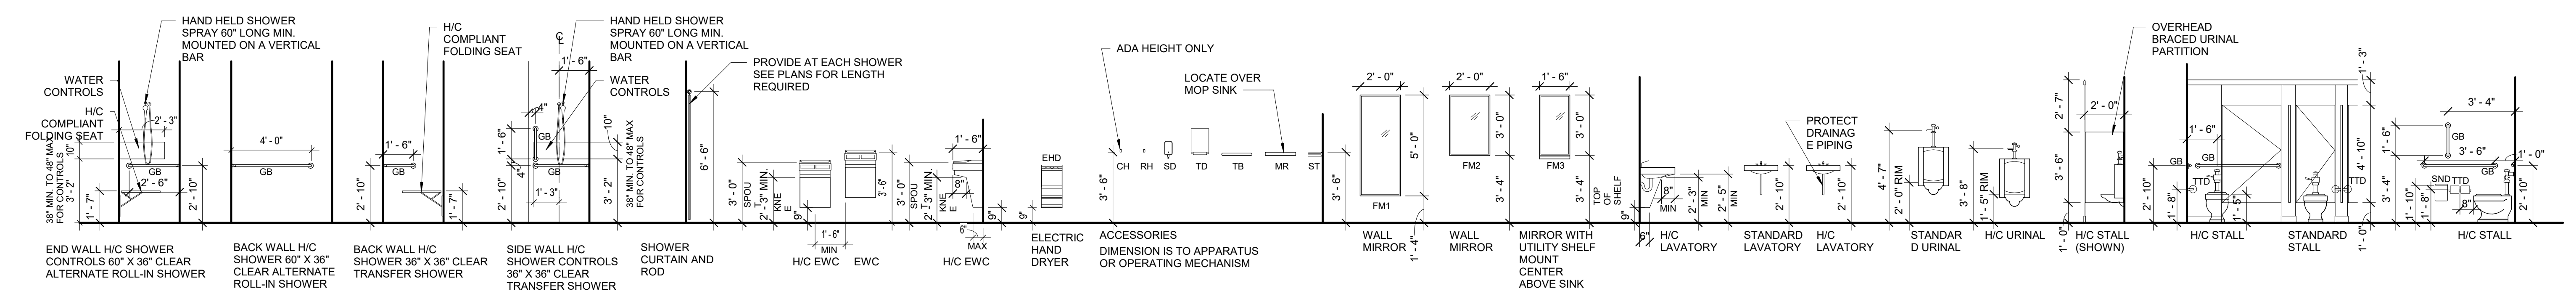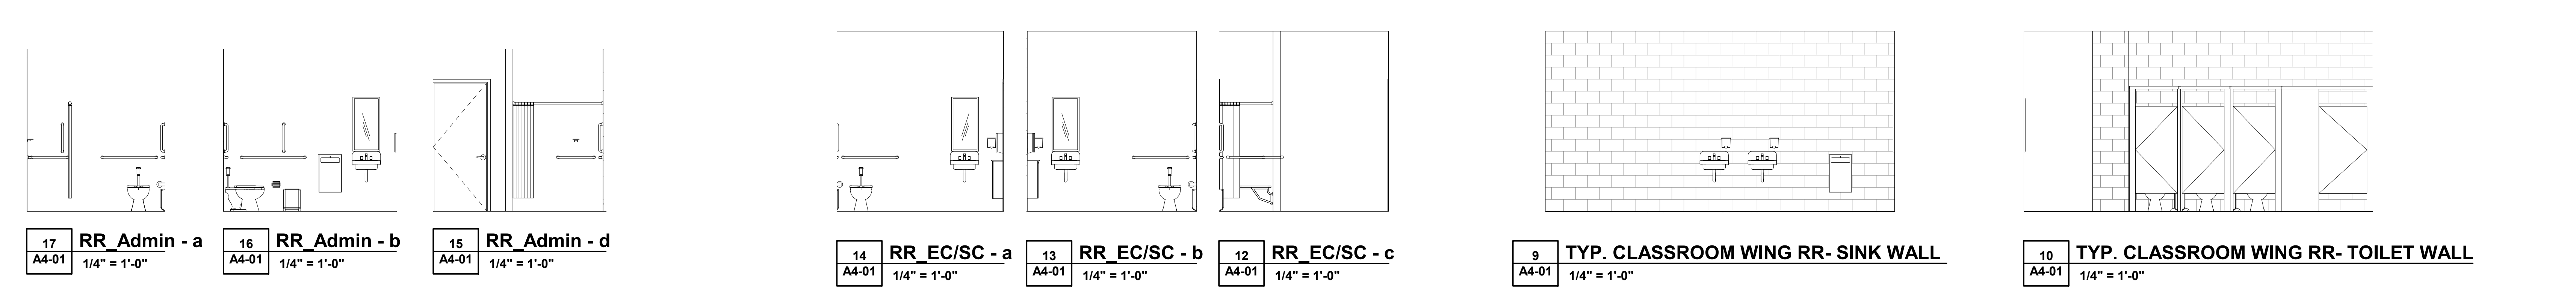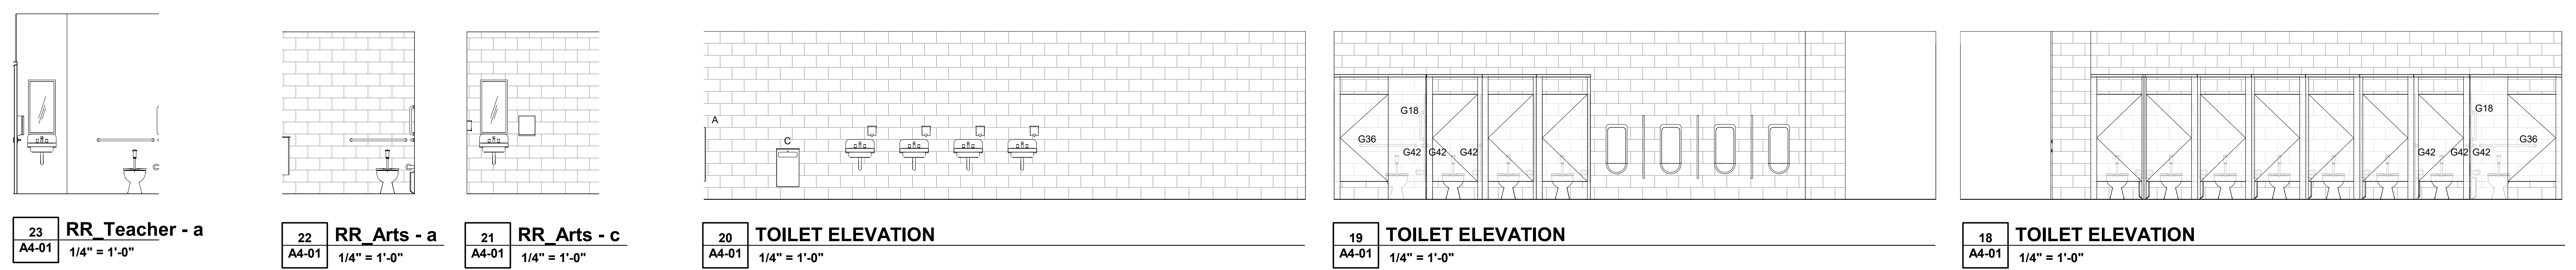


MOUNTING HEIGHTS
1/4" = 1'-0"


MARK	DESCRIPTION	FURNISHED BY/INSTALLED BY	MOUNTING HEIGHT	REMARKS
A	24" x 60" MIRROR, 1/2" CHANNEL FRAME, 1/4" LAMINATED SAFETY GLASS, THEFT RESISTANT MOUNT.	CFCI	18" A.F.F. TO BOTTOM OF UNIT	
A1	24" x 36" MIRROR, 1/2" CHANNEL FRAME, 1/4" LAMINATED SAFETY GLASS, THEFT RESISTANT MOUNT.	CFCI	40" A.F.F. TO BOTTOM OF UNIT	
C	S.S. SURFACE MOUNTED WASTE RECEPTACLE	OFOI	16" A.F.F. TO BOTTOM MIN.	
D	DRYER BY OWNER	OFOI	---	
E	S.S. SURFACE MOUNTED SANITARY NAPKIN RECEPTACLE	OFOI	32" A.F.F. TO TOP OF UNIT	
F	SINGLE ROLL TISSUE DISPENSER	OFOI	32" A.F.F. TO TOP OF UNIT	
G18	1 1/2" DIA. X 18" S.S. VERTICAL GRAB BAR - PEENED	CFCI	40" A.F.F. TO BOTTOM OF BAR	
G24	1 1/2" DIA. X 24" S.S. GRAB BAR - PEENED	CFCI	36" A.F.F. TO TOP OF BAR	
G36	1 1/2" DIA. X 36" S.S. GRAB BAR - PEENED	CFCI	36" A.F.F. TO TOP OF BAR	
G42	1 1/2" DIA. X 42" S.S. GRAB BAR - PEENED	CFCI	36" A.F.F. TO TOP OF BAR	
H	PAPER TOWEL DISPENSER	OFOI	40" A.F.F. TO POINT OF DISPENSION	
J	S.S. SOAP DISH	OFOI	48" A.F.F. TO TOP	
K1	60"-72" HEAVY DUTY S.S. SHOWER CURTAIN ROD, VINYL CURTAIN, AND S.S. HOOKS	CFCI	74 1/2" A.F.F. TO C.L.	
K2	42" HEAVY DUTY S.S. SHOWER CURTAIN ROD, VINYL CURTAIN, AND S.S. HOOKS	CFCI	74 1/2" A.F.F. TO C.L.	
REF	REFRIGERATOR BY OWNER	OFOI	---	
SS	REVERSIBLE FOLDING SHOWER SEAT	CFCI	17"-19" A.F.F. TO TOP OF SEAT	
W, OFOI	WASHER BY OWNER	OFOI	---	

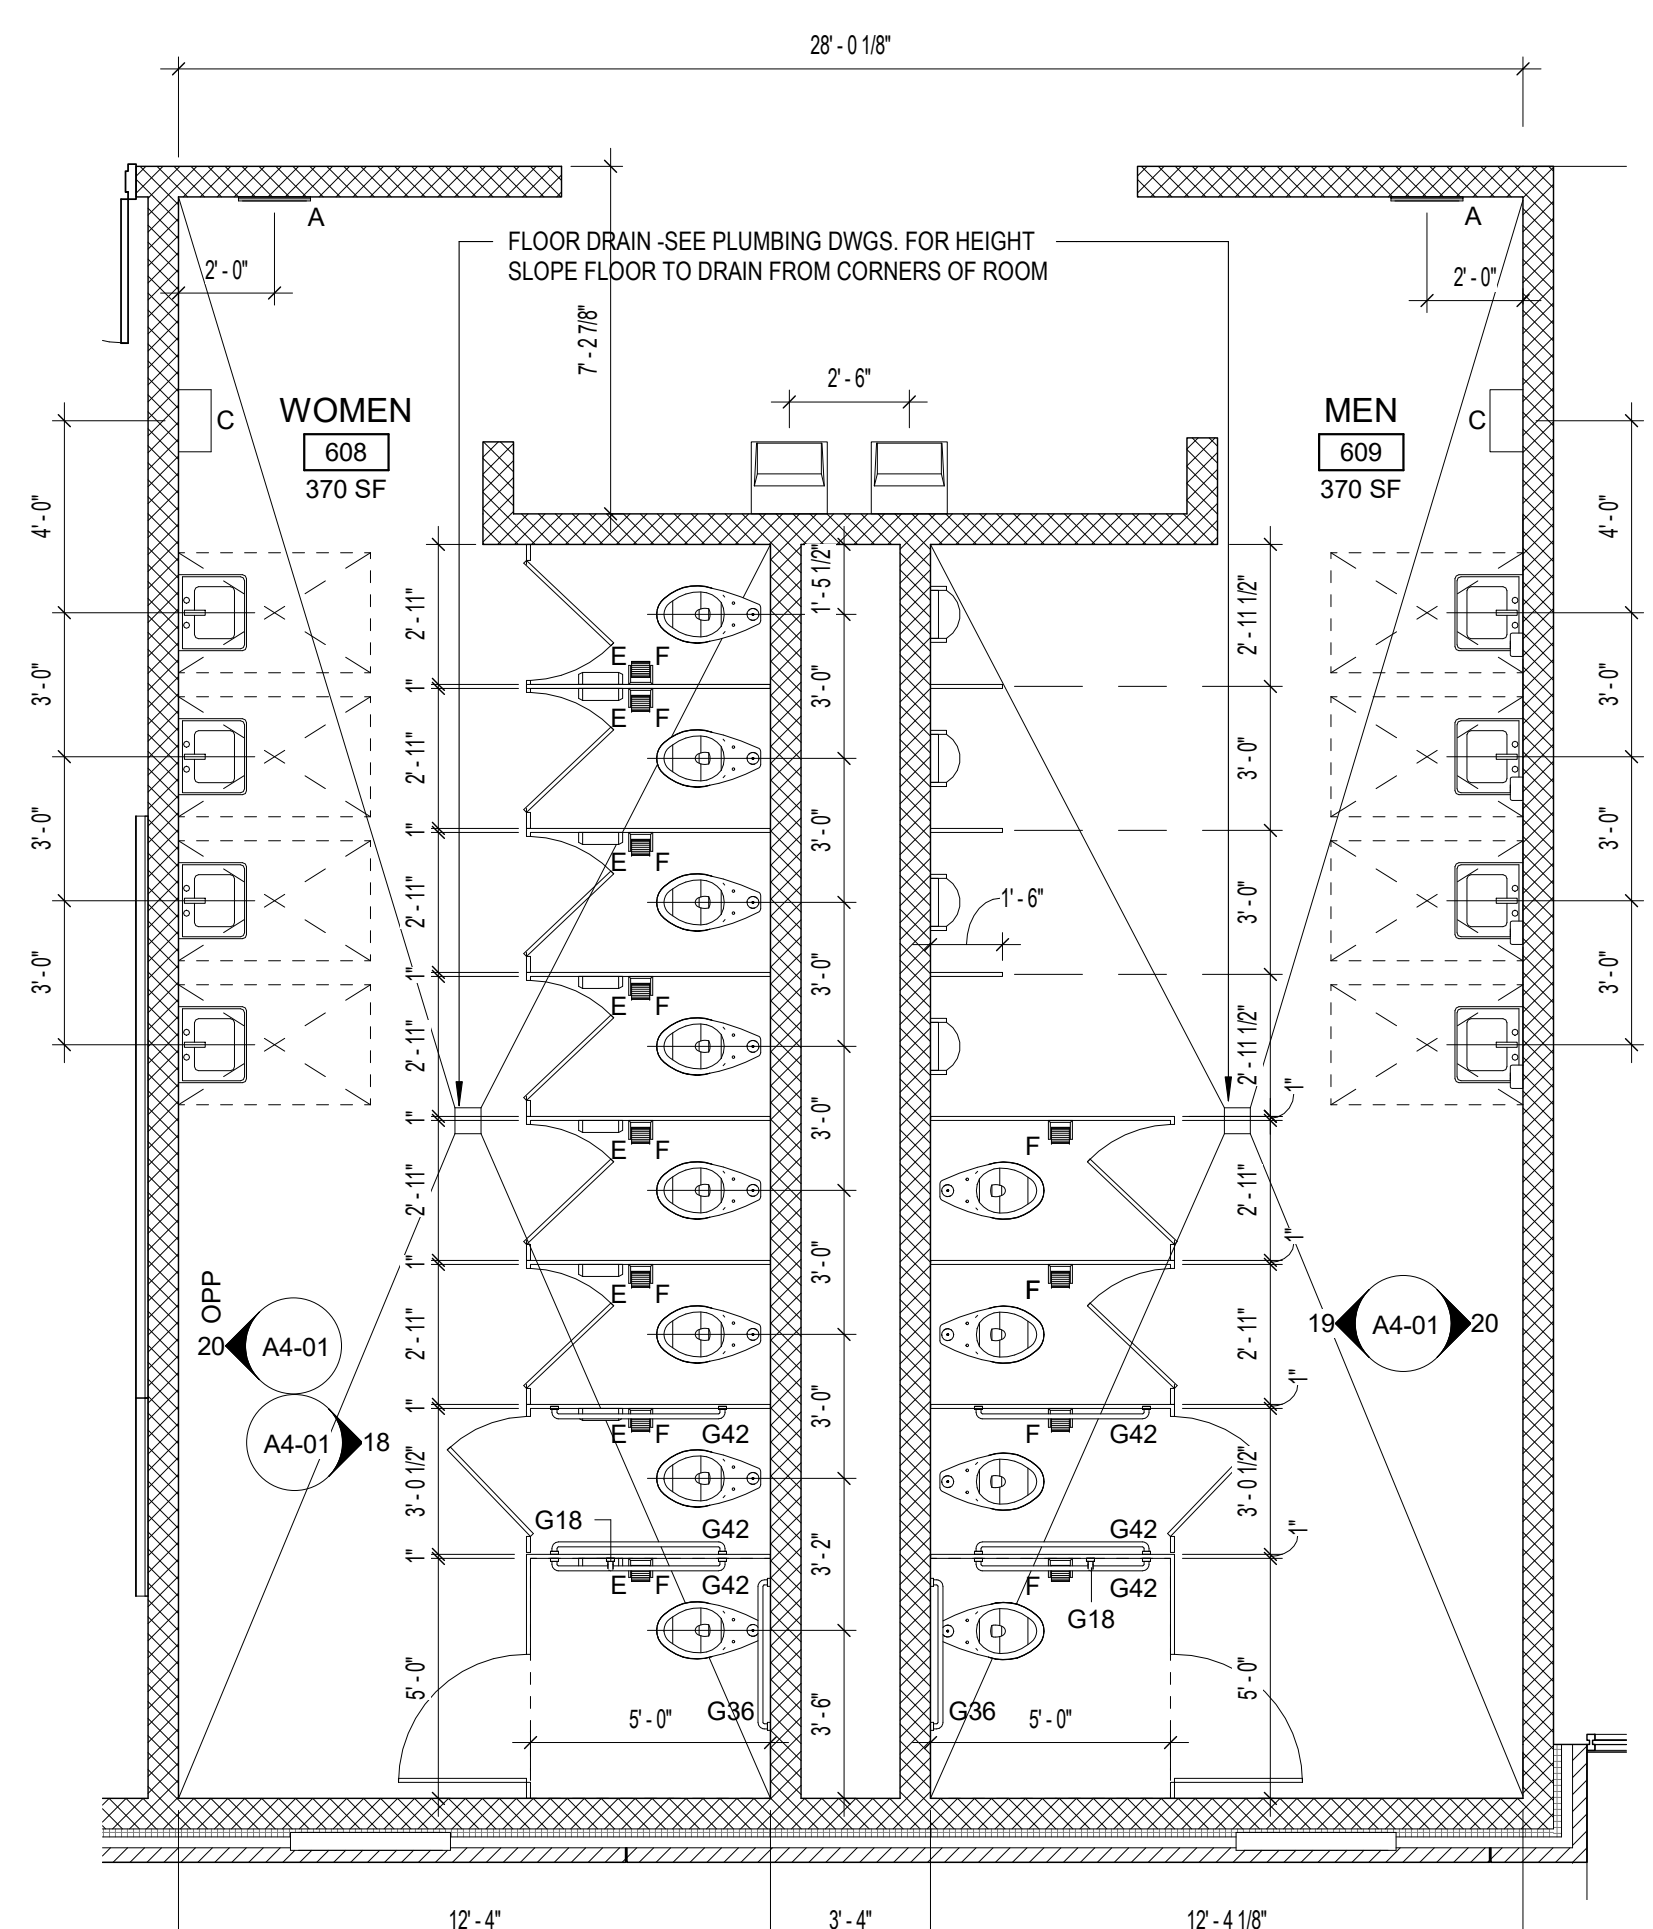


5 ENLARGED TOILET PLAN
A4-01 1/4" = 1'-0"

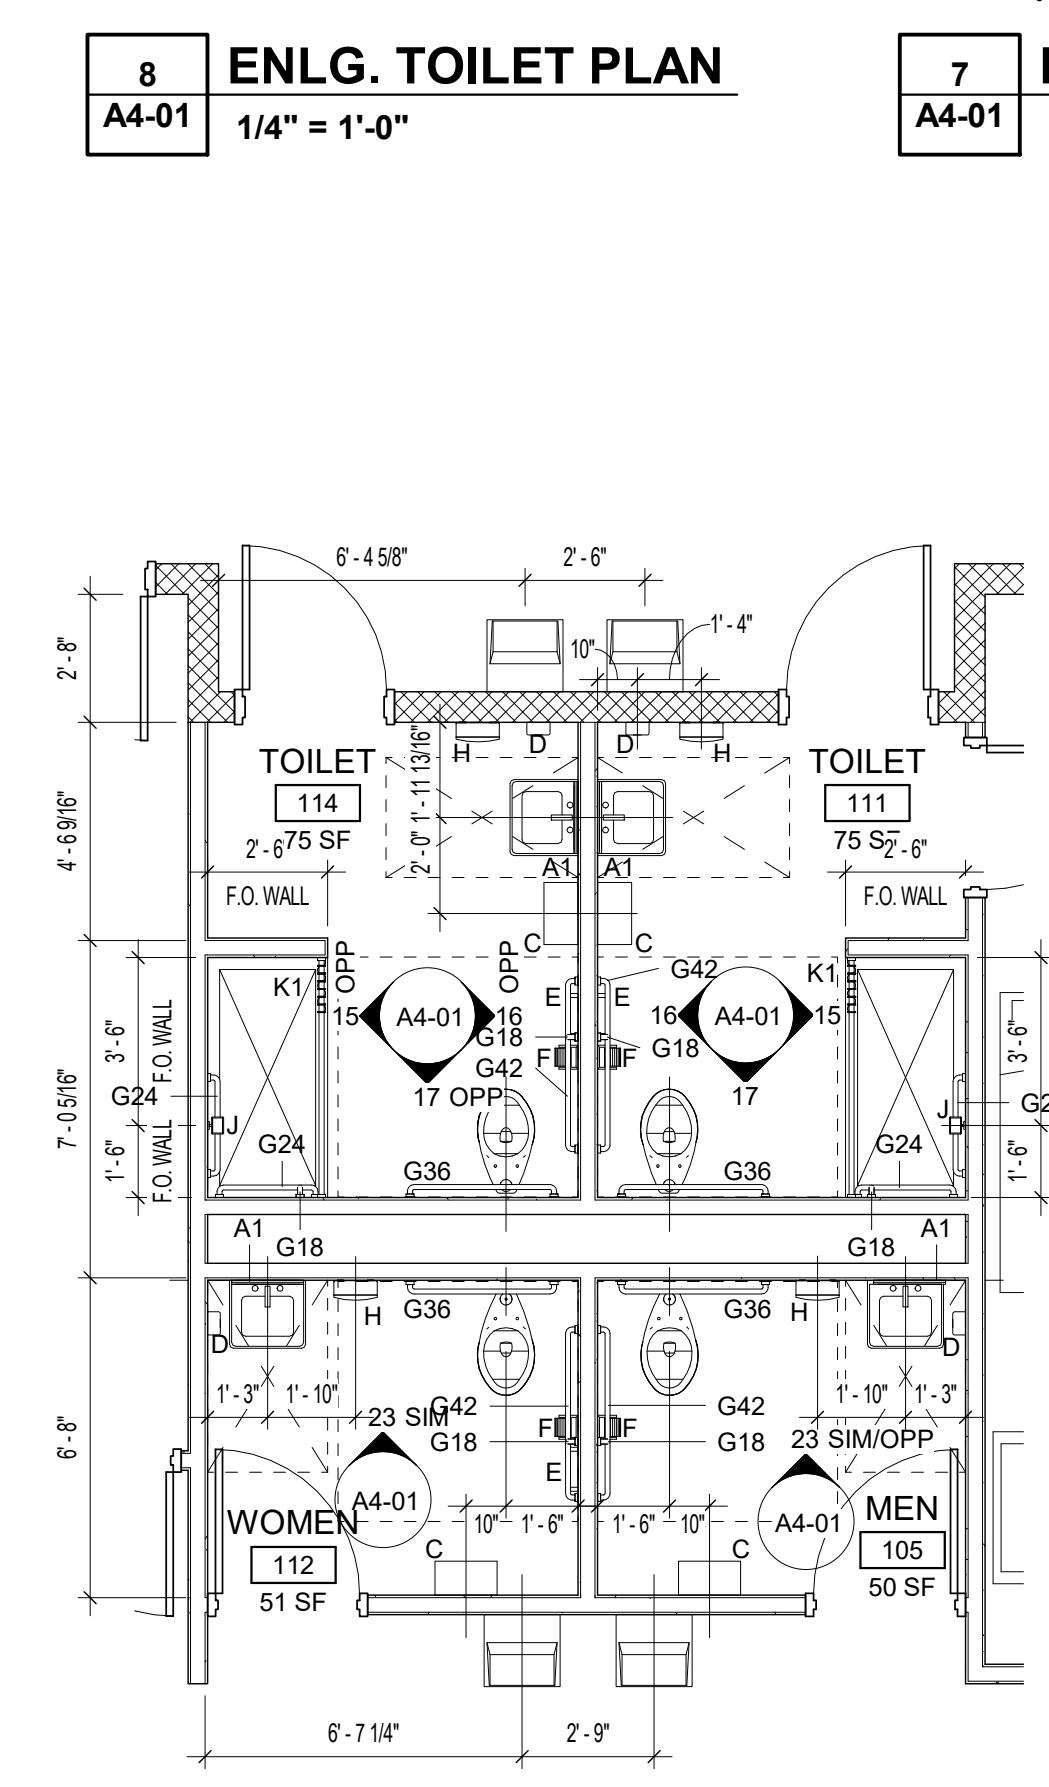


4 ENLARGED TOILET PLAN
A4-01 1/4" = 1'-0"

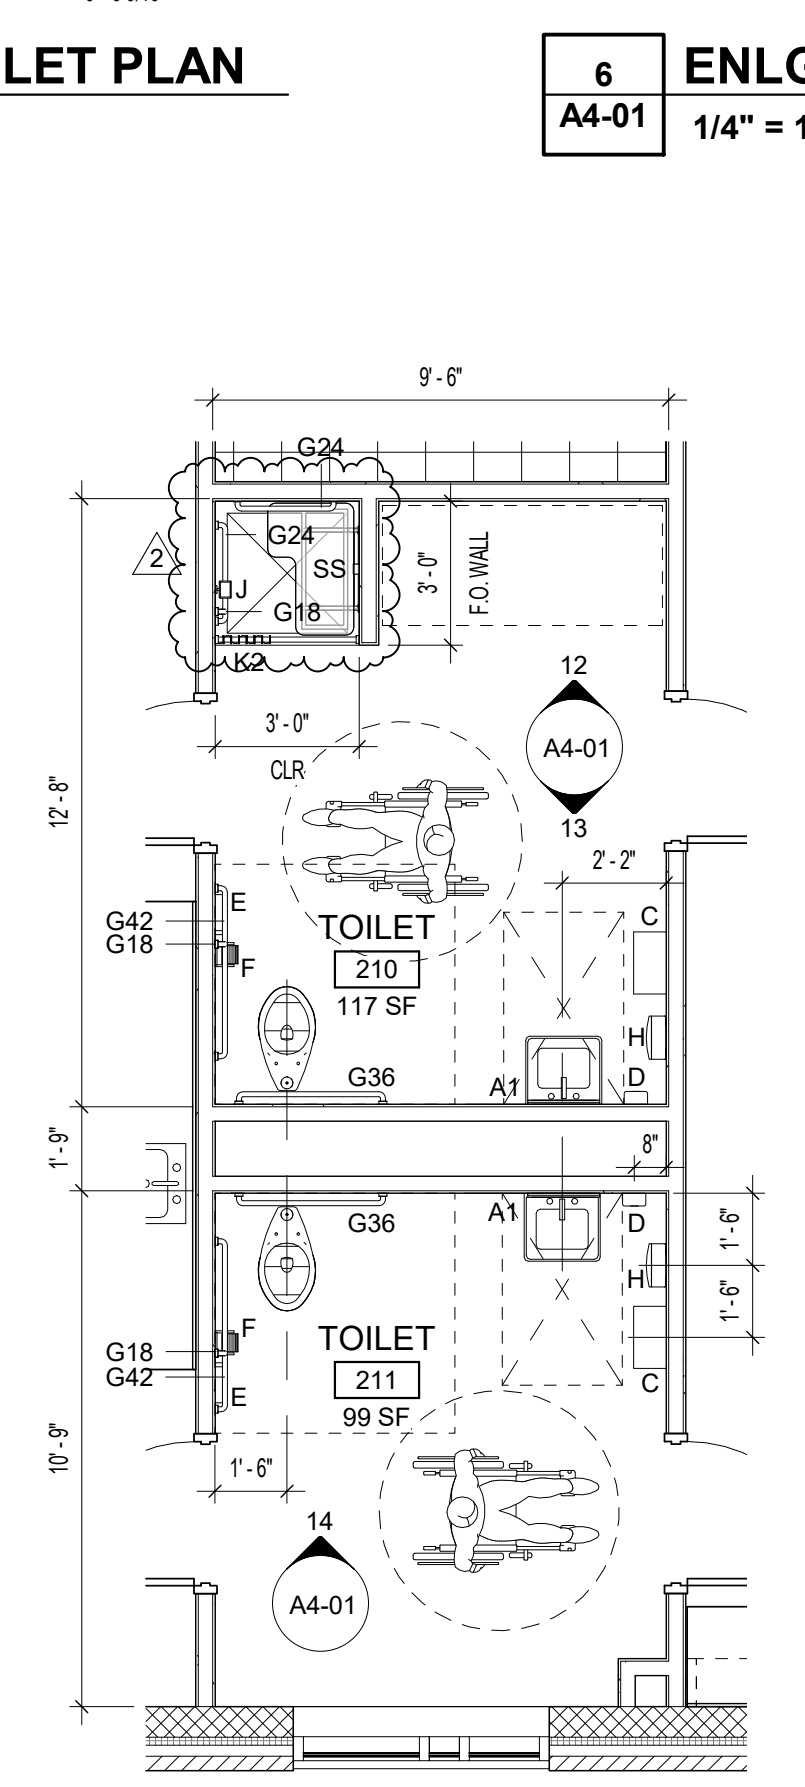

3 ENLARGED TOILET PLAN
A4-01 1/4" = 1'-0"

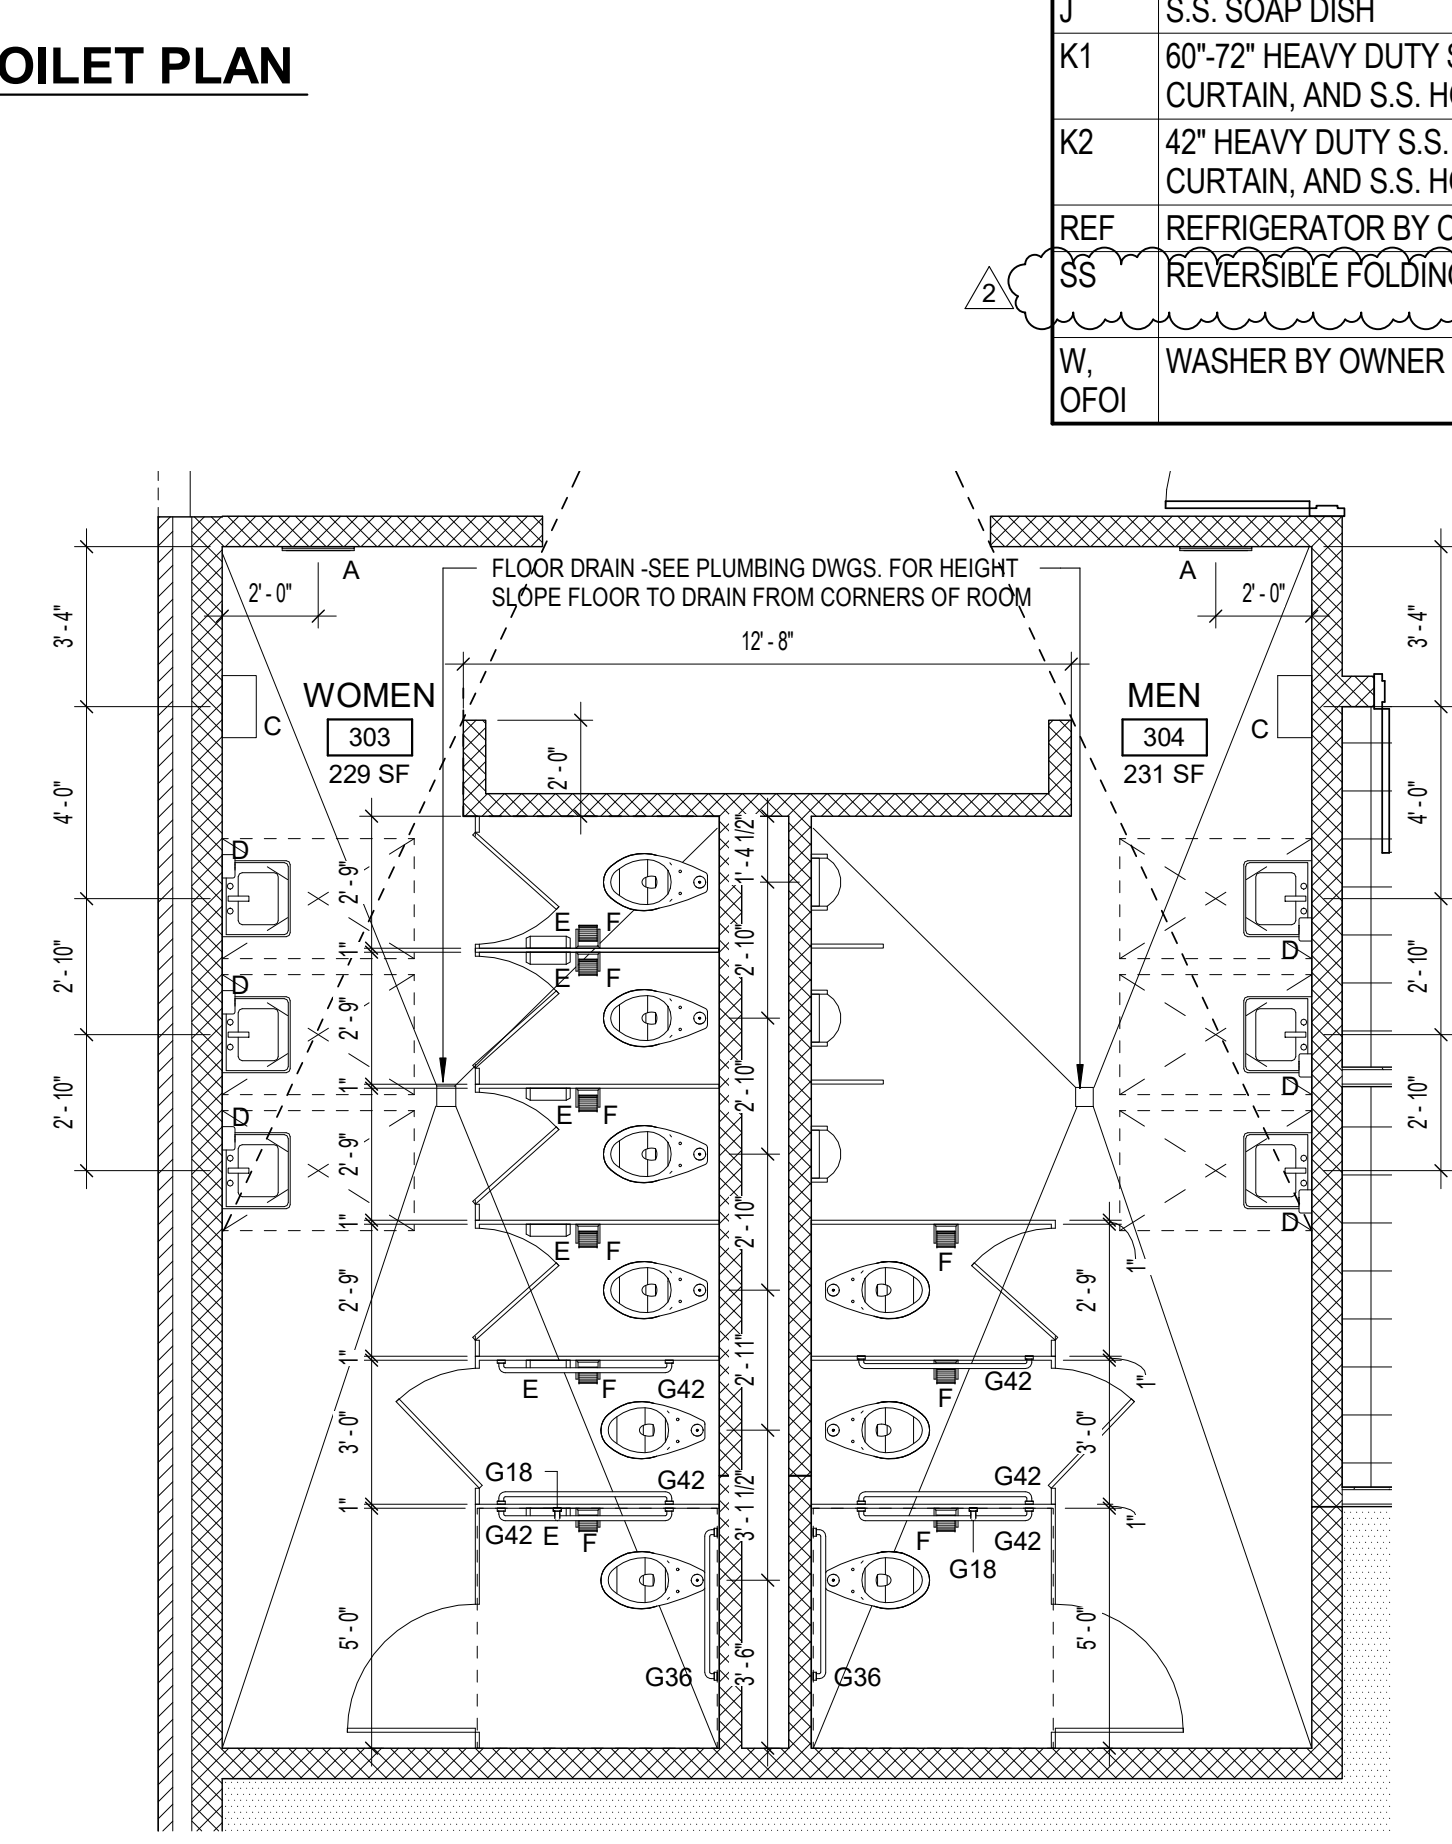

2 ENLARGED TOILET PLAN
A4-01 1/4" = 1'-0"

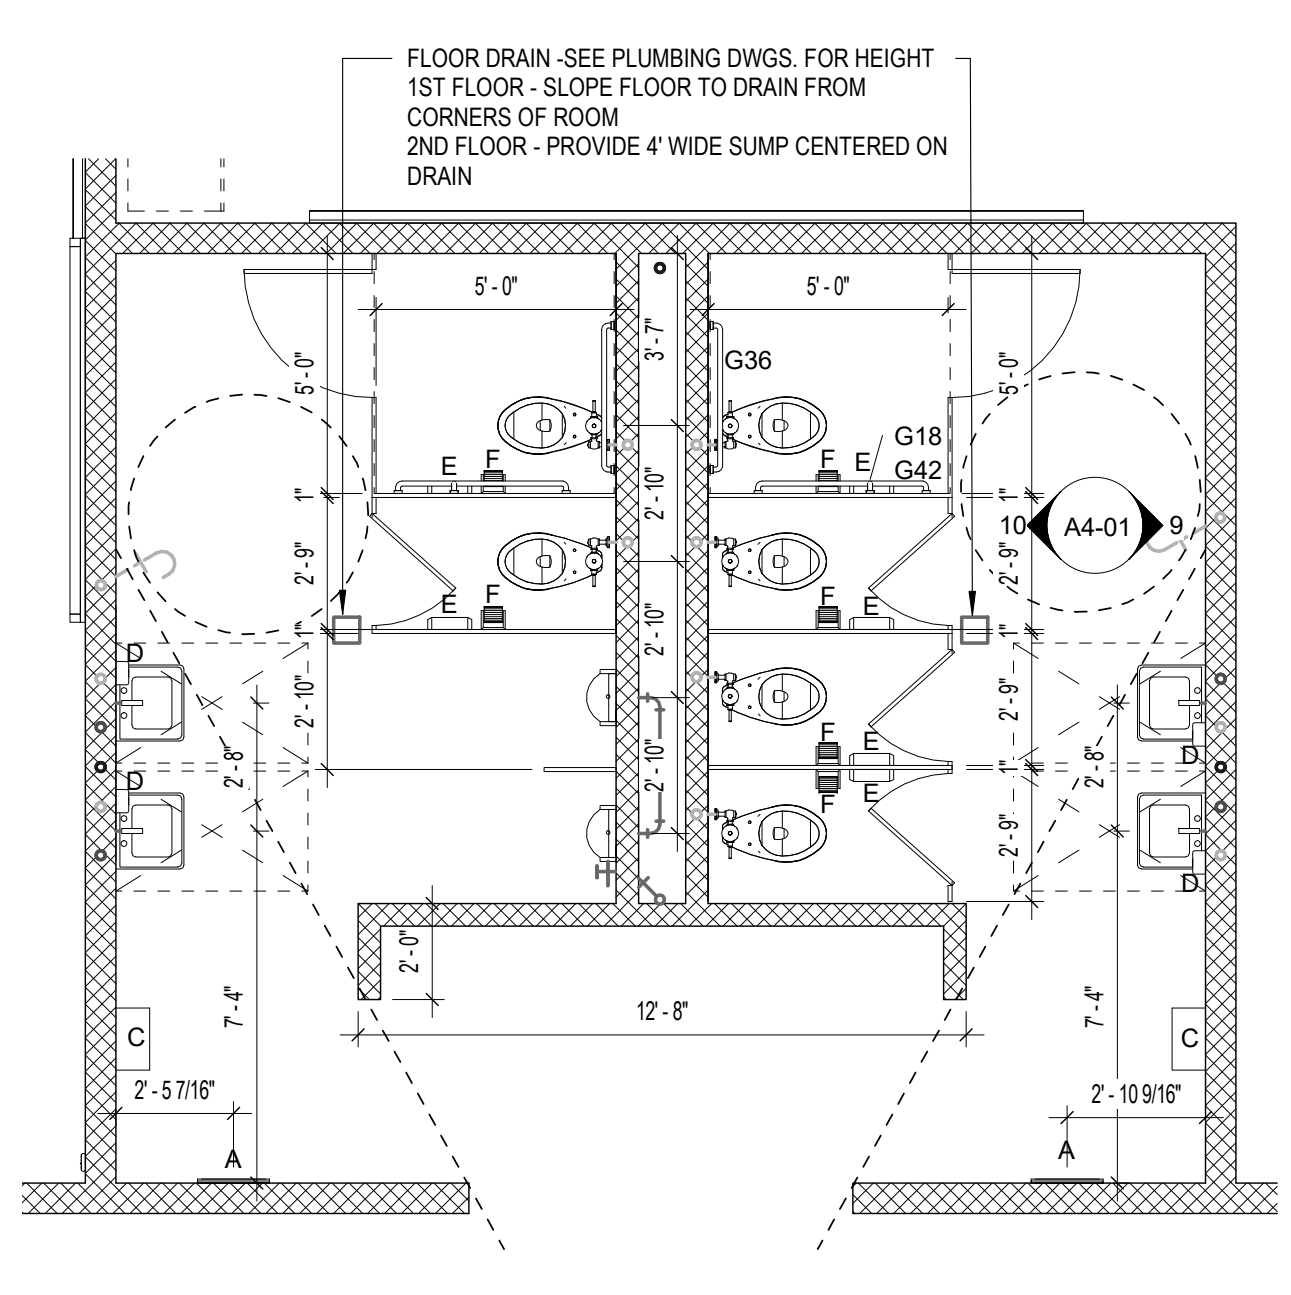


1 ENLARGED TOILET PLAN
A4-01 1/4" = 1'-0"

TRINITY MIDDLE SCHOOL
RANDOLPH COUNTY SCHOOL SYSTEM


Parcel PIN 7708 118367
Surrett Drive
Trinity, NC 27370

KEY PLAN
NO SCALE


6/14/19 ADDENDUM 3
ID DATE DESCRIPTION
DRAWN BY: LP, JS, DW
CHECKED BY: DW
ENLARGED TOILET PLANS

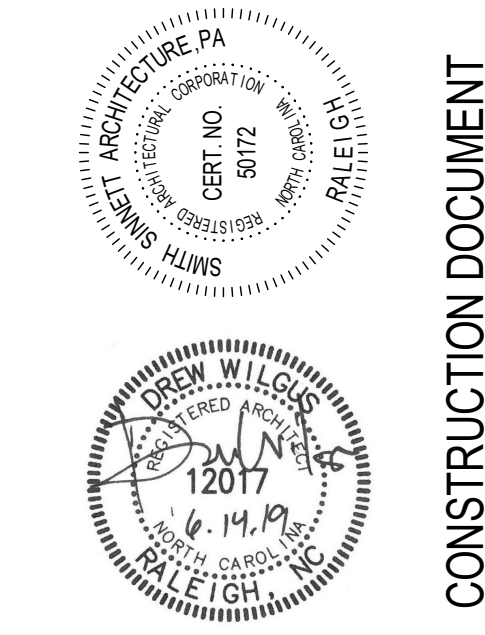


The drawings and specifications herein are the property of Smith Sinnett Architecture, P.A. The reproduction or use of this project without the written consent of Smith Sinnett Architecture, P.A. is prohibited. Any infringement of the copyright rights will be subject to legal action. All copies are subject to the terms and conditions of the contract.
Smith Sinnett Architecture, P.A. 2018
THIS DRAWING IS FORWARDED TO BE PRINTED ON A 30" x 42" SHEET

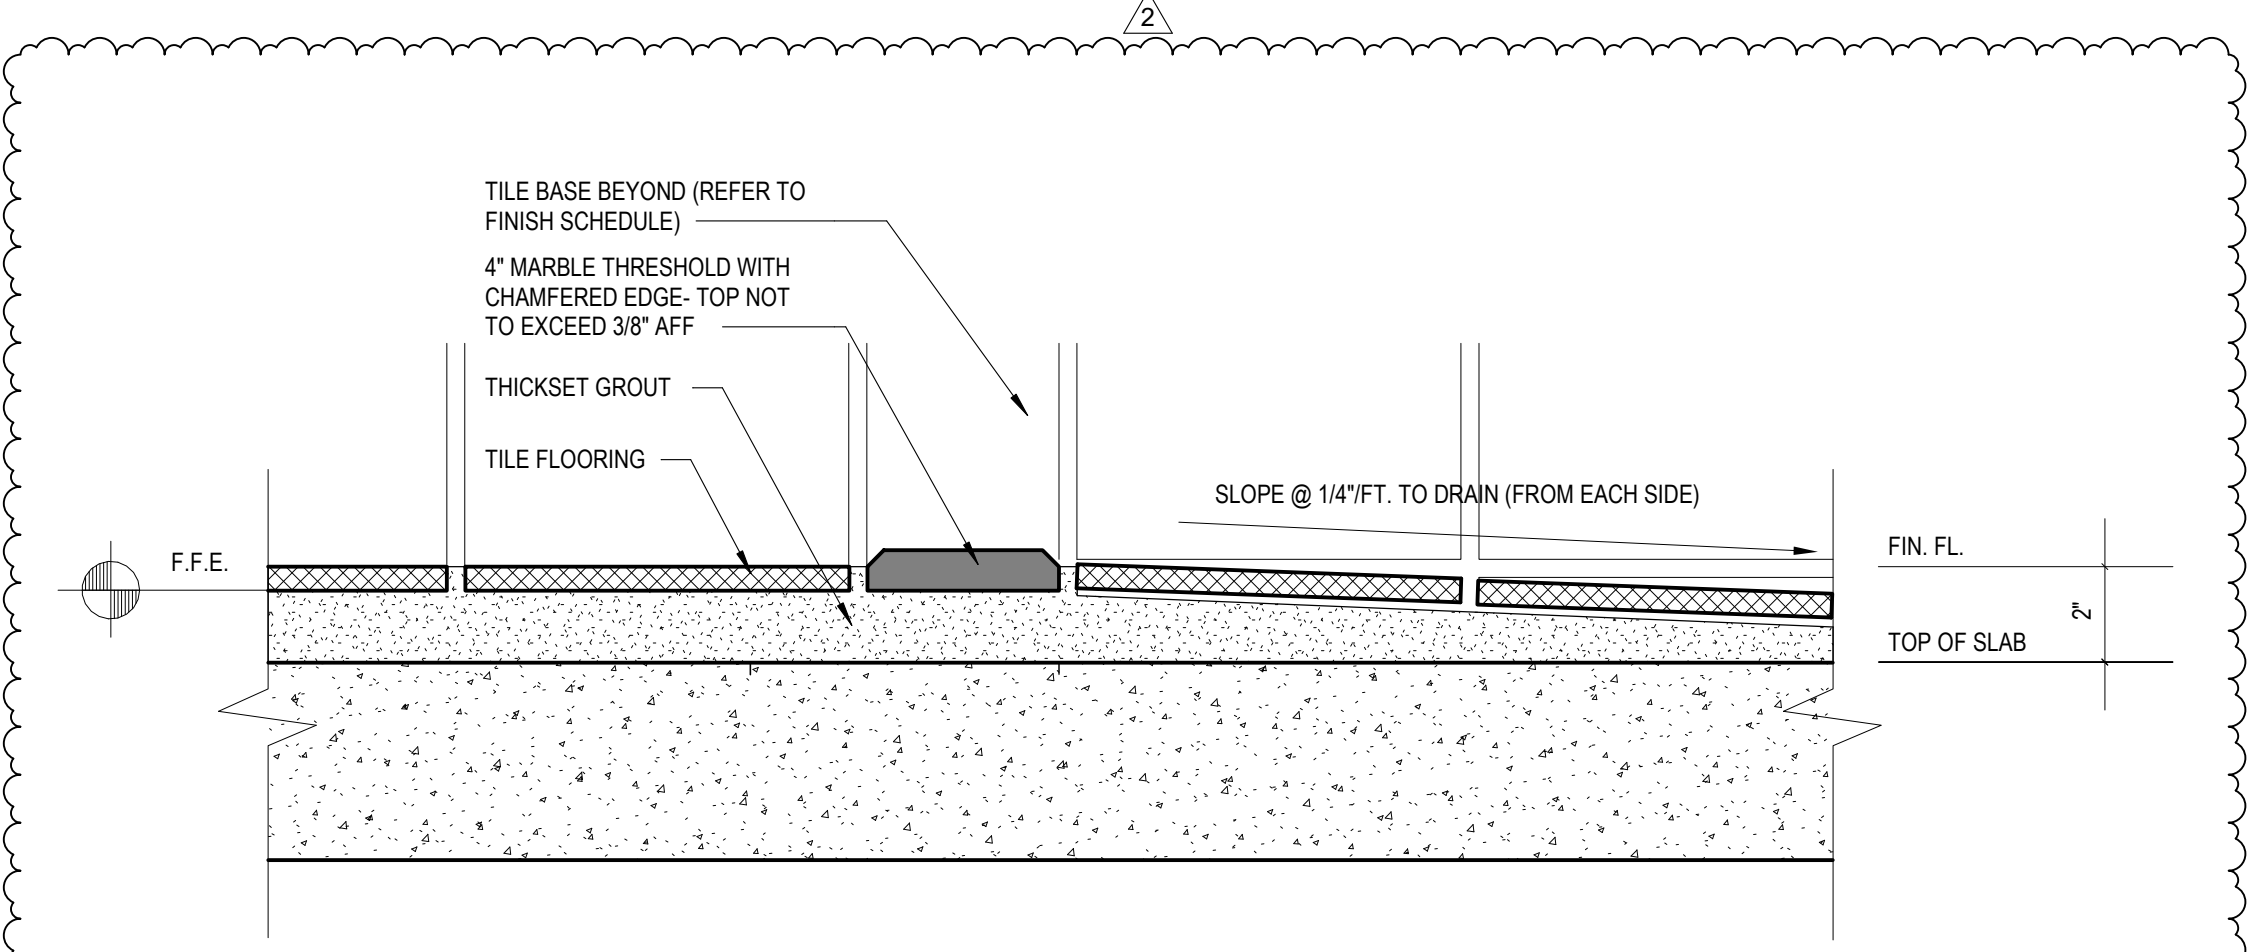




11 SHOWER FLOOR DETAIL
A4-02 3" = 1'-0"

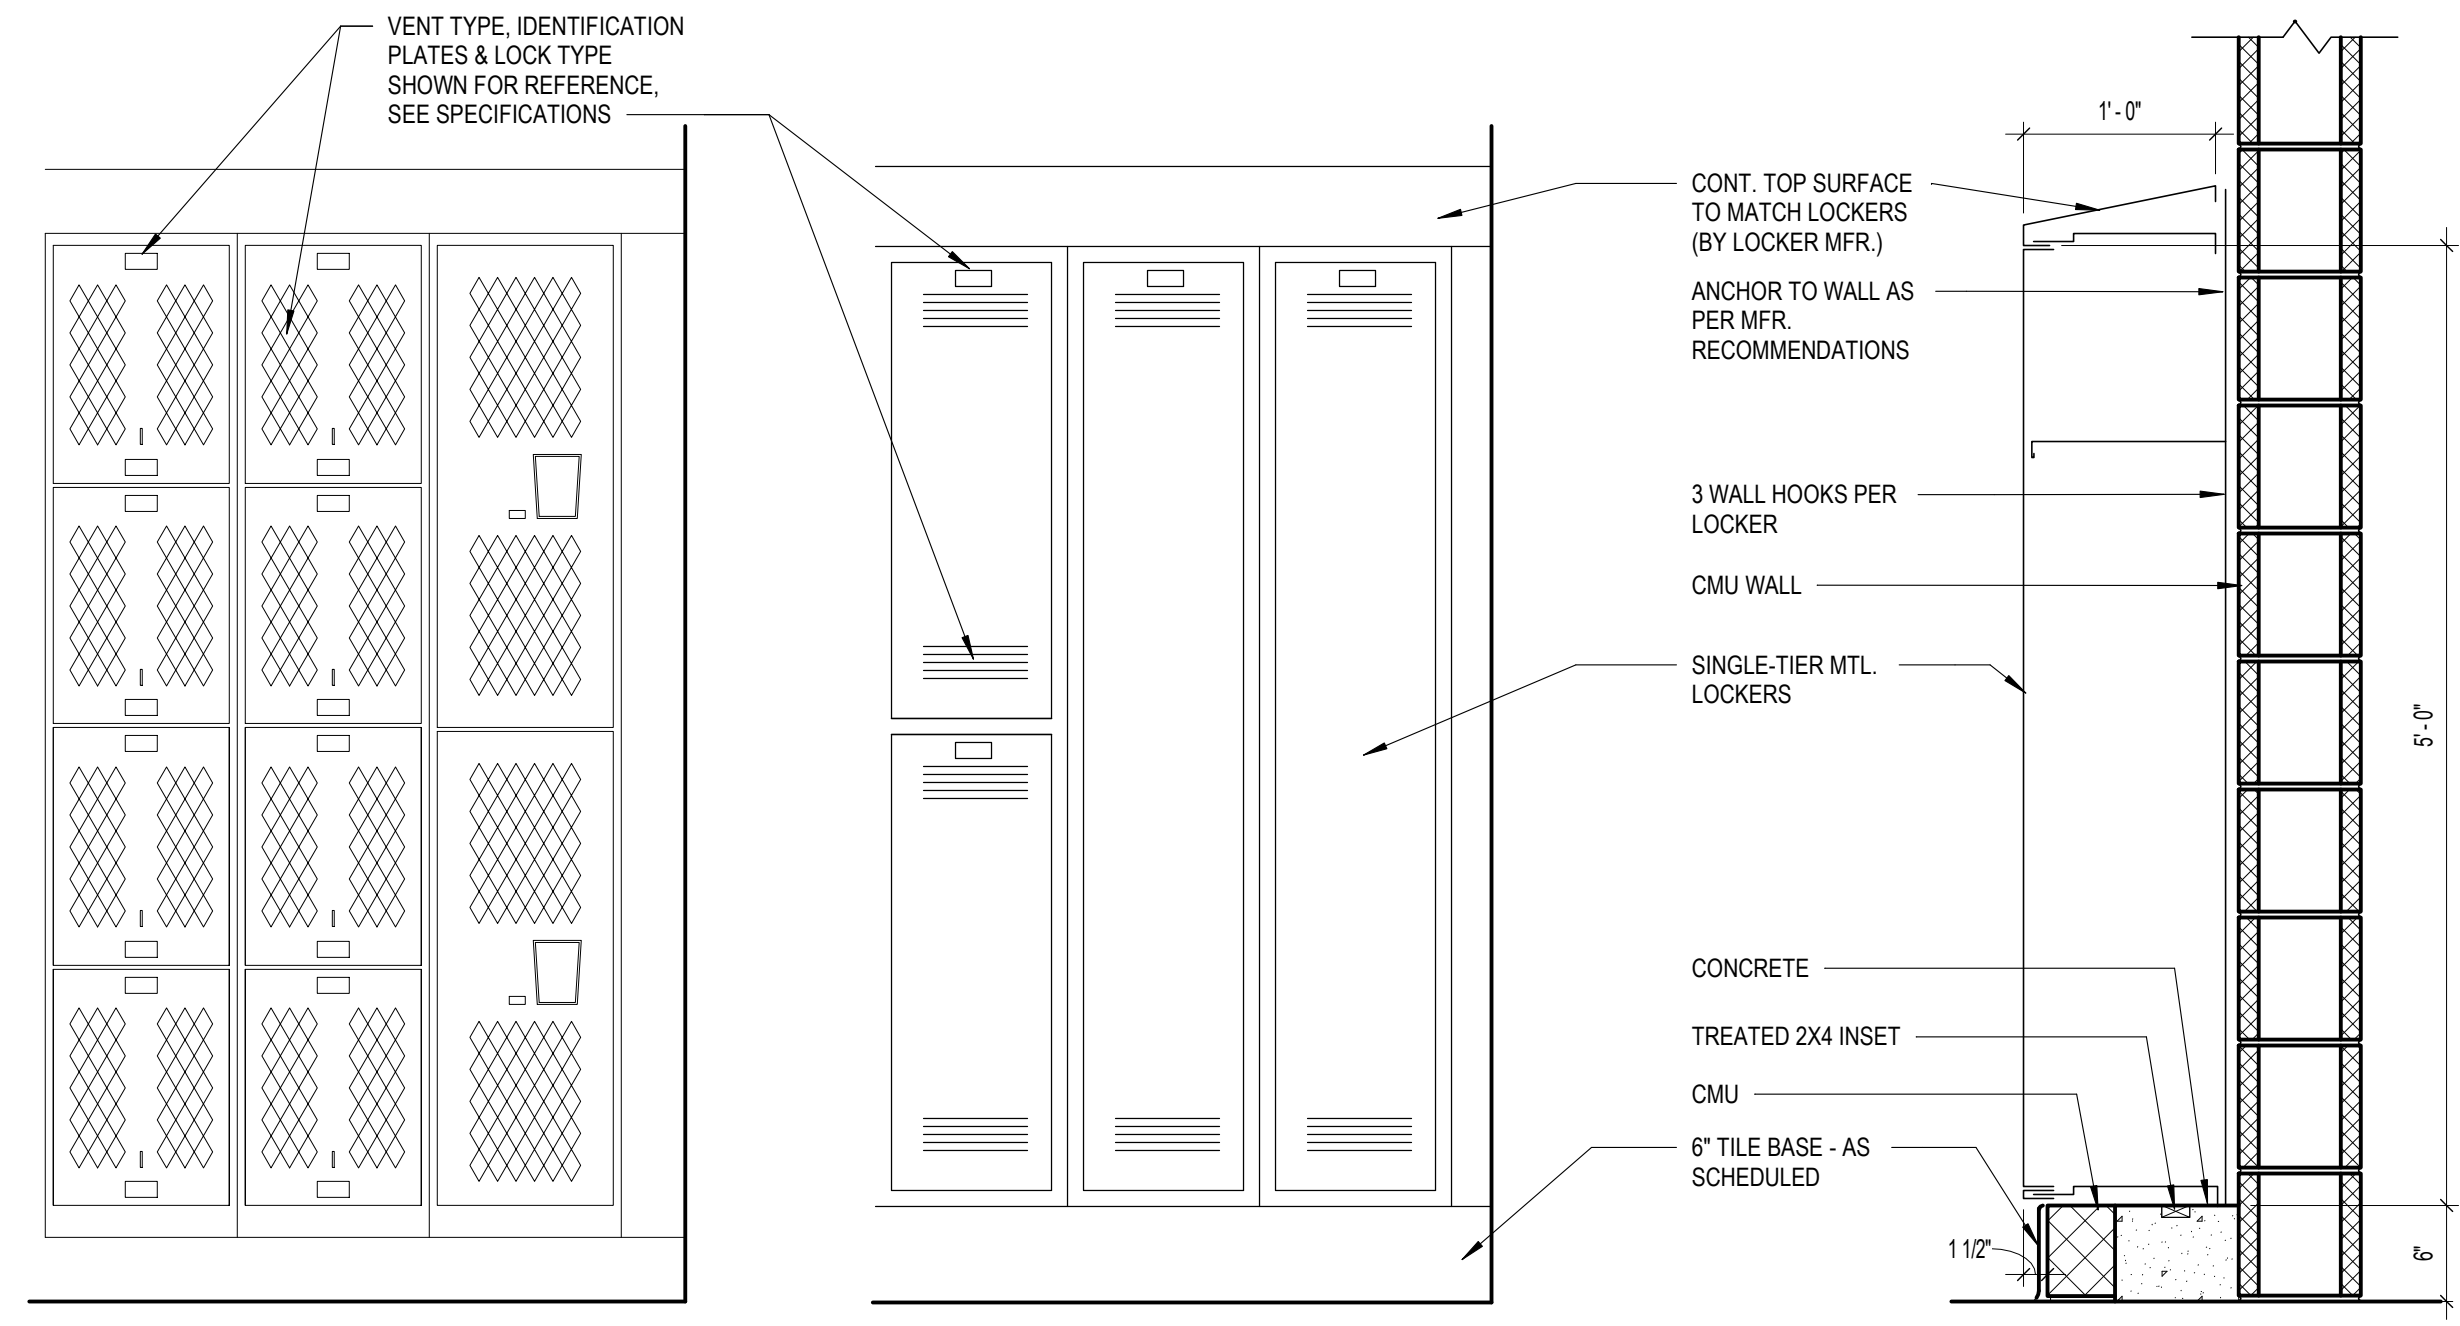


10 LOCKER DETAIL
A4-02 1" = 1'-0"

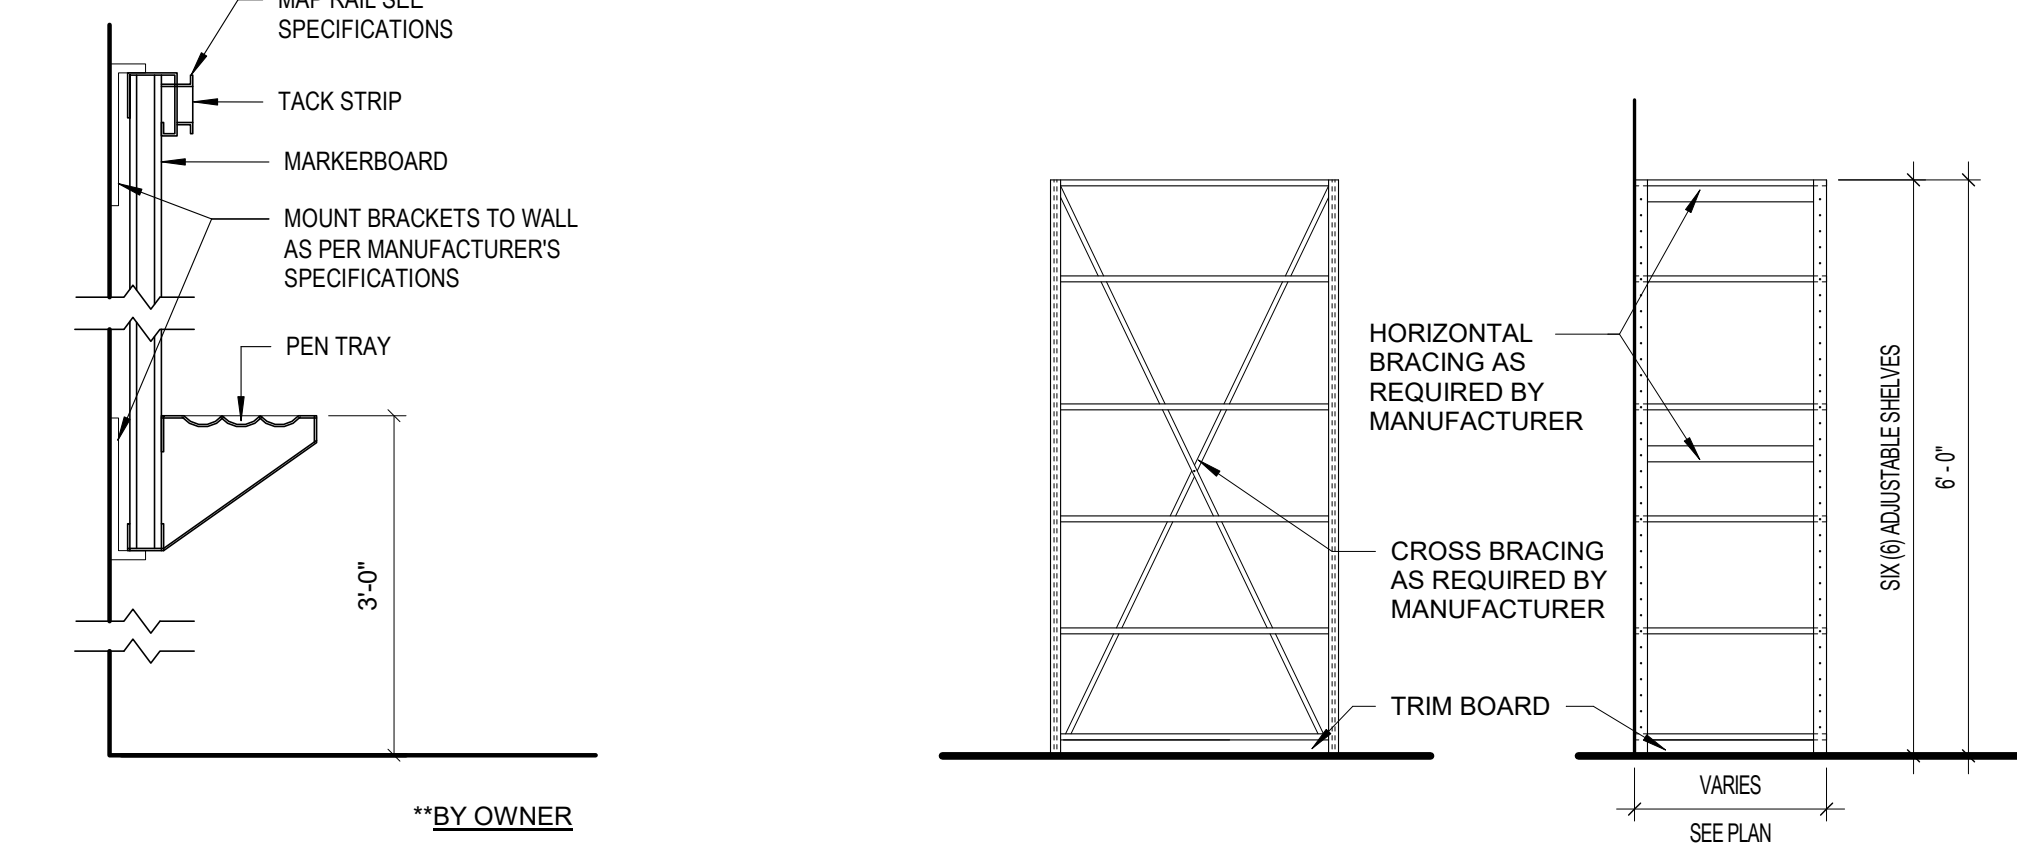

MARK	DESCRIPTION	FURNISHED BY/INSTALLED BY	MOUNTING HEIGHT	REMARKS
A	24" x 60" MIRROR, 1/2" CHANNEL FRAME, 1/4" LAMINATED SAFETY GLASS, THEFT RESISTANT MOUNT.	CFCI	18" A.F.F. TO BOTTOM OF UNIT	
A1	24" x 36" MIRROR, 1/2" CHANNEL FRAME, 1/4" LAMINATED SAFETY GLASS, THEFT RESISTANT MOUNT.	CFCI	40" A.F.F. TO BOTTOM OF UNIT	
C	S.S. SURFACE MOUNTED WASTE RECEPTACLE	OFOI	16" A.F.F. TO BOTTOM MIN.	
D				
D1	DRYER BY OWNER	OFOI	---	
E	S.S. SURFACE MOUNTED SANITARY NAPKIN RECEPTACLE	OFOI	32" A.F.F. TO TOP OF UNIT	
F	SINGLE ROLL TISSUE DISPENSER	OFOI	32" A.F.F. TO TOP OF UNIT	
G18	1 1/2" DIA. X 18" S.S. VERTICAL GRAB BAR - PEENED	CFCI	40" A.F.F. TO BOTTOM OF BAR	
G24	1 1/2" DIA. X 24" S.S. GRAB BAR - PEENED	CFCI	36" A.F.F. TO TOP OF BAR	
G36	1 1/2" DIA. X 36" S.S. GRAB BAR - PEENED	CFCI	36" A.F.F. TO TOP OF BAR	
G42	1 1/2" DIA. X 42" S.S. GRAB BAR - PEENED	CFCI	36" A.F.F. TO TOP OF BAR	
H	PAPER TOWEL DISPENSER	OFOI	40" A.F.F. TO POINT OF DISPERSION	
J	S.S. SOAP DISH	OFOI	48" A.F.F. TO TOP	
K1	60"-72" HEAVY DUTY S.S. SHOWER CURTAIN ROD, VINYL CURTAIN, AND S.S. HOOKS	CFCI	74 1/2" A.F.F. TO C.L.	
K2	42" HEAVY DUTY S.S. SHOWER CURTAIN ROD, VINYL CURTAIN, AND S.S. HOOKS	CFCI	74 1/2" A.F.F. TO C.L.	
REF	REFRIGERATOR BY OWNER	OFOI	---	
SS	REVERSIBLE FOLDING SHOWER SEAT	CFCI	17'-19" A.F.F. TO TOP OF SEAT	
W,	WASHER BY OWNER	OFOI	---	
OFOI				

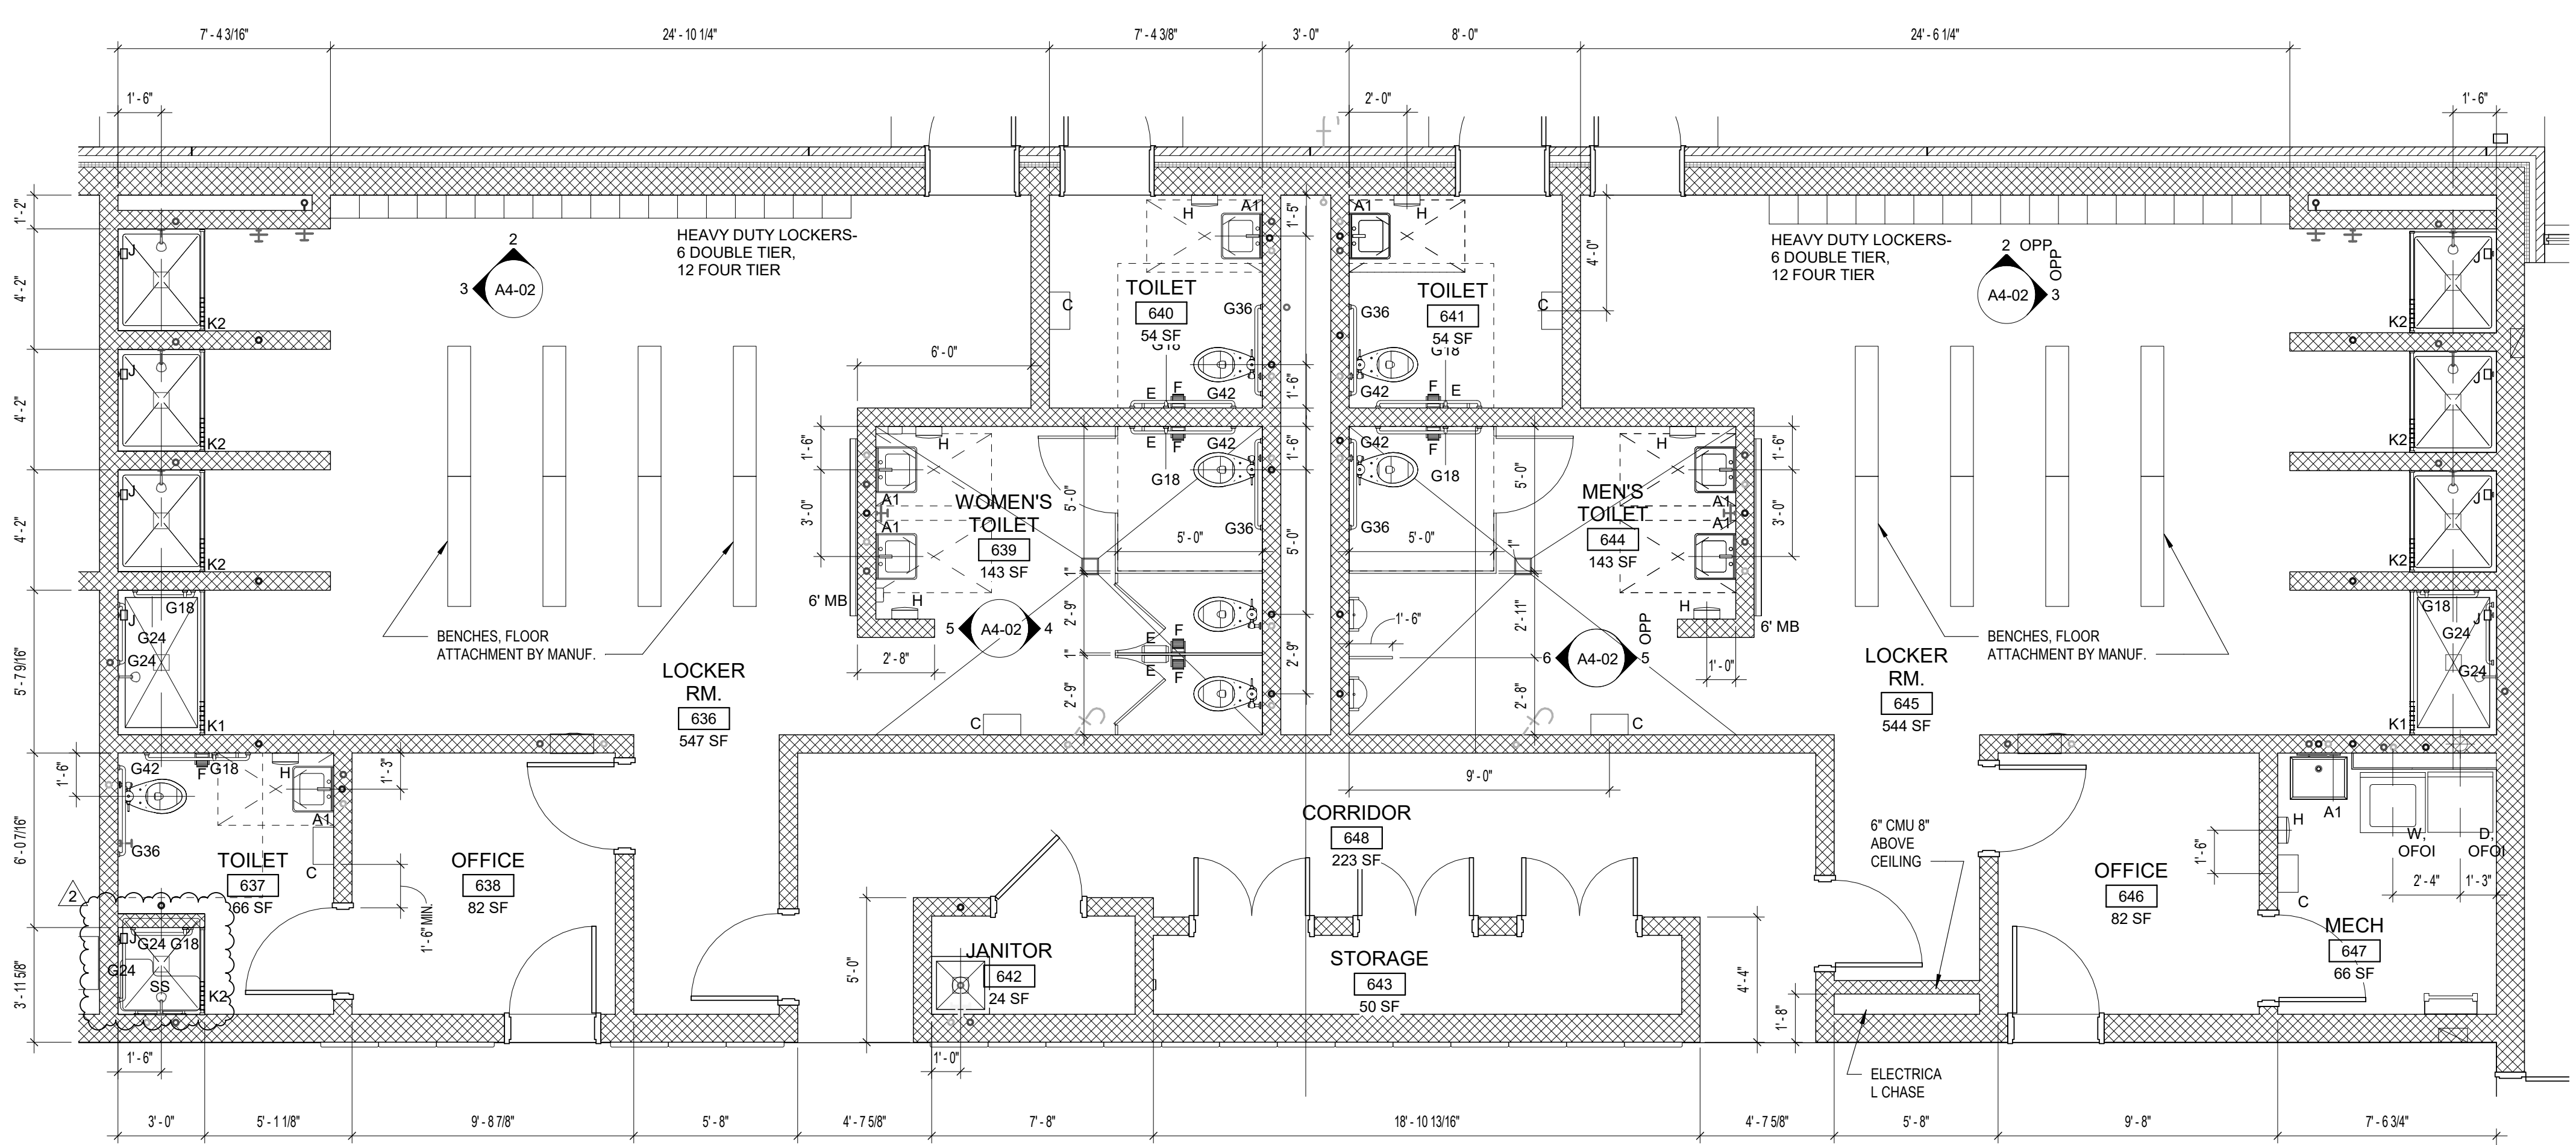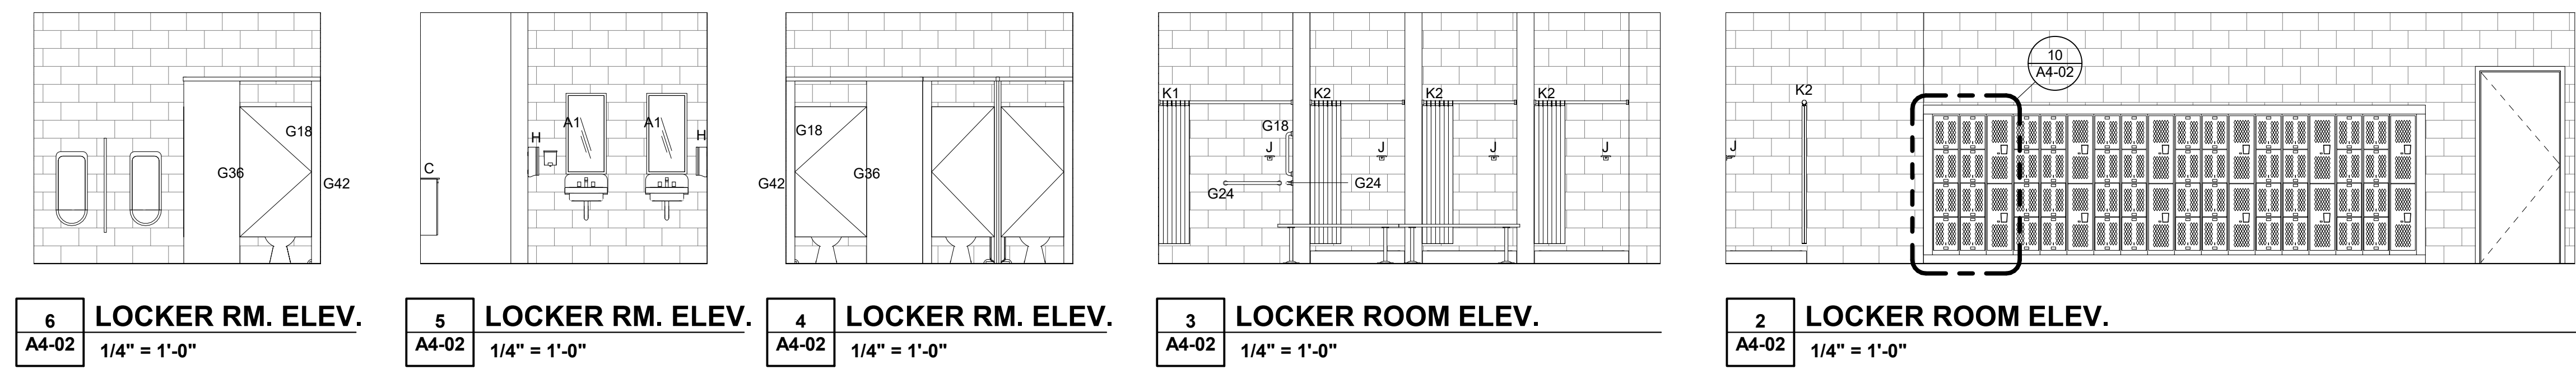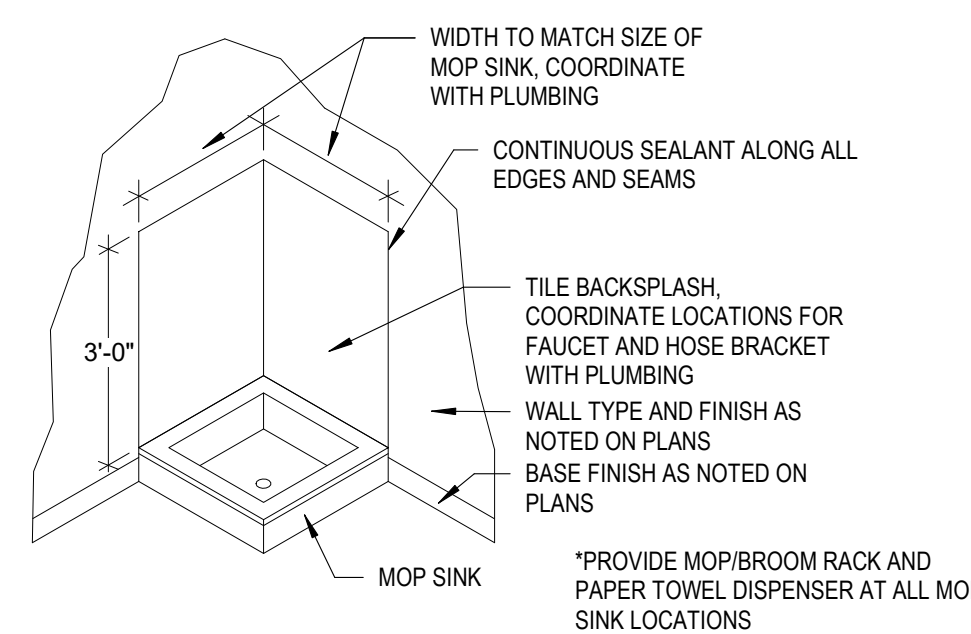

TRINITY MIDDLE SCHOOL
RANDOLPH COUNTY SCHOOL SYSTEM
Parcel PIN 7708118367
Surrett Drive
Trinity, NC 27370

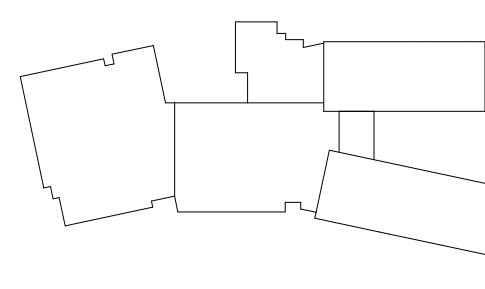


KEY PLAN
NO SCALE

6/14/19 ADDENDUM 3
ID DATE DESCRIPTION
DRAWN BY: LP, JS, DW
CHECKED BY: DW

ENLARGED TOILET PLANS & EQUIPMENT DETAILS
2017032 20 MAY 2019

DOOR SCHEDULE

MARK	DOOR SIZE	WIDTH	HEIGHT	THK	MAT	TYPE	LVS	MAT	TYPE	DETAILS	HEAD	JAMB	THRESH	HARDWARE	FIRE RATING	REMARKS
100A	3'-0"	7'-2"	1'-3/4"		ALUM	FG1	1	ALUM	SF1	18/A6-04				03	2.7	
100B	3'-0"	7'-2"	1'-3/4"		ALUM	FG1	1	ALUM	SF1	18/A6-04				04		
100C	3'-0"	7'-2"	1'-3/4"		ALUM	FG1	1	ALUM	SF1	18/A6-04				04		
100D	3'-0"	7'-2"	1'-3/4"		ALUM	FG1	1	ALUM	SF1	18/A6-04				04		
100E	3'-0"	7'-2"	1'-3/4"		ALUM	FG1	1	ALUM	SF2	18/A6-04				07	2.7	
100EE	3'-0"	7'-2"	1'-3/4"		ALUM	FG1	1	ALUM	SF2	18/A6-04				08		
100F	3'-0"	7'-2"	1'-3/4"		ALUM	FG1	1	ALUM	SF2	18/A6-04				08		
100FF	3'-0"	7'-2"	1'-3/4"		ALUM	FG1	1	ALUM	SF2	18/A6-04				08		
101A	3'-0"	7'-2"	1'-3/4"		ALUM	FG1	1	ALUM	CW2	12/A6-04	11/A6-04	2/A6-04		01	2.3,7	
101B	3'-0"	7'-2"	1'-3/4"		ALUM	FG1	1	ALUM	CW2	12/A6-04	11/A6-04	2/A6-04		02		
101C	3'-0"	7'-2"	1'-3/4"		ALUM	FG1	1	ALUM	CW2	12/A6-04	11/A6-04	2/A6-04		02		
101D	3'-0"	7'-2"	1'-3/4"		ALUM	FG1	1	ALUM	CW2	12/A6-04	11/A6-04	2/A6-04		02		
102A	3'-0"	7'-2"	1'-3/4"		SCWD	FG1	1	HM	HM3	32/A6-04	8/A6-04			18		
102B	3'-0"	7'-2"	1'-3/4"		SCWD	FG1	1	HM	HM3	32/A6-04	8/A6-04	T4		76		
102C	3'-0"	7'-2"	1'-3/4"		SCWD	FG1	1	HM	HM1	32/A6-04	25/A6-04			75		
103A	3'-0"	7'-2"	1'-3/4"		SCWD	N	1	HM	HM1	30/A6-04	23/A6-04			52		
103B	3'-0"	7'-2"	1'-3/4"		SCWD	N	1	HM	HM1	32/A6-04	25/A6-04	T4		52		
104A	3'-0"	7'-2"	1'-3/4"		SCWD	N	1	HM	HM1	30/A6-04	23/A6-04	T4		56		
104B	3'-0"	7'-2"	1'-3/4"		SCWD	F	1	HM	HM1	32/A6-04	25/A6-04	T6		56		
105	3'-0"	7'-2"	1'-3/4"		SCWD	F	1	HM	HM1	30/A6-04	23/A6-04	T2		49	4	
106	3'-0"	7'-2"	1'-3/4"		SCWD	N	1	HM	HM1	30/A6-04	23/A6-04			52		
107	3'-0"	7'-2"	1'-3/4"		SCWD	N	1	HM	HM1	30/A6-04	23/A6-04			52		
108	3'-0"	7'-2"	1'-3/4"		SCWD	N	1	HM	HM1	30/A6-04	23/A6-04			52		
108A	3'-0"	7'-2"	1'-3/4"		SCWD	N	1	HM	HM1	30/A6-04	23/A6-04			54		
110B	3'-0"	7'-2"	1'-3/4"		SCWD	NFR	1	HM	HM1	5/A6-04	6/A6-04	T4		61	90 MIN	
111A	3'-0"	7'-2"	1'-3/4"		SCWD	F	1	HM	HM1	30/A6-04	23/A6-04	T1		48	4	
111B	3'-0"	7'-2"	1'-3/4"		SCWD	F	1	HM	HM1	32/A6-04	25/A6-04	T1		47	4	
112	3'-0"	7'-2"	1'-3/4"		SCWD	F	1	HM	HM1	30/A6-04	23/A6-04	T2		49	4	
113	3'-0"	7'-2"	1'-3/4"		SCWD	F	1	HM	HM1	30/A6-04	23/A6-04	T4		62		
114	3'-0"	7'-2"	1'-3/4"		SCWD	F	1	HM	HM1	32/A6-04	25/A6-04	T1		47	4	
115A	3'-0"	7'-2"	1'-3/4"		SCWD	N	1	HM	HM1	30/A6-04	23/A6-04			55		
125A	3'-0"	7'-2"	1'-3/4"		SCWD	N	1	HM	HM1	30/A6-04	23/A6-04			52		
125B	3'-0"	7'-2"	1'-3/4"		SCWD	F	1	HM	HM1	5/A6-04	6/A6-04	T4		60	90 MIN	
126	3'-0"	7'-2"	1'-3/4"		SCWD	F	1	HM	HM1	30/A6-04	23/A6-04	T4		78		
127	4'-0"	7'-2"	1'-3/4"		SCWD	N	2	HM	HM1	32/A6-04	25/A6-04	T6		79		
130A	6'-0"	7'-2"	1'-3/4"		SCWD	NFR	2	HM	HM2	7/A6-04	8/A5-02			43	90 MIN	5
130B	6'-0"	7'-2"	1'-3/4"		SCWD	NFR	2	HM	HM2	7/A6-04	8/A5-02			44	90 MIN	5
131	6'-0"	7'-2"	1'-3/4"		ALUM	FG1	2	ALUM	SF5	27/A6-04	20/A6-04	1/A6-04		19	3	
132A	6'-0"	7'-2"	1'-3/4"		SCWD	N	2	HM	HM1	5/A6-04	6/A6-04	T5		24	24	
132B	6'-0"	7'-2"	1'-3/4"		SCWD	N	2	HM	HM1	32/A6-04	25/A6-04			24		
132C	6'-0"	7'-2"	1'-3/4"		ALUM	FG1	2	ALUM	AL1	30/A6-04	23/A6-04	1/A6-04		19	3	
133A	3'-0"	7'-2"	1'-3/4"		SCWD	E	1	HM	HM1	5/A6-04	6/A6-04	T3		65	90 MIN	
133B	6'-8"	8'-0"	1'-2"		STL		1	STL	HM1					88	90 MIN	
133C	6'-8"	8'-0"	1'-2"		STL		1	STL	HM1					88	90 MIN	
133D	3'-0"	7'-2"	1'-3/4"		SCWD	F	1	HM	HM1	5/A6-04	6/A6-04	T3		64	90 MIN	
134A	4'-0"	4'-6"	1'-2"		SCWD	F	1	HM	HM1					68	90 MIN	
134B	3'-0"	7'-2"	1'-3/4"		SCWD	F	1	HM	HM1					68		
137	3'-0"	7'-2"	1'-3/4"		SCWD	F	1	HM	HM1					62		
139	3'-0"	7'-2"	1'-3/4"		SCWD	F	1	HM	HM1	32/A6-04	25/A6-04			52		
140	4'-0"	7'-2"	1'-3/4"		SCWD	N	1	HM	HM1	28/A6-04	21/A6-04	3/A6-04		17	3.7	
141	3'-0"	7'-2"	1'-3/4"		SCWD	F	1	HM	HM1	32/A6-04	25/A6-04			46	4	
142	3'-0"	7'-2"	1'-3/4"		SCWD	F	1	HM	HM1	32/A6-04	25/A6-04			83		
145A	6'-0"	7'-2"	1'-3/4"		SCWD	N	2	HM	HM1	28/A6-04	21/A6-04	1/A6-04		13	3	
145B	3'-0"	7'-2"	1'-3/4"		SCWD	F	1	HM	HM1	28/A6-04	21/A6-04	1/A6-04		14		
146A	6'-0"	7'-2"	1'-3/4"		SCWD	N	1	HM	HM1	28/A6-04	21/A6-04	1/A6-04		32	3	
146B	6'-0"	7'-2"	1'-3/4"		SCWD	F	2	HM	HM1	28/A6-04	21/A6-04	1/A6-04		29	3	
147	6'-0"	7'-2"	1'-3/4"		SCWD	L	2	HM	HM1	28/A6-04	21/A6-04	1/A6-04		29		
150A	6'-0"	7'-2"	1'-3/4"		ALUM	FG1	2	ALUM	CW5	12/A6-04	11/A6-04	2/A6-04		05	2.3,7	
150B	6'-0"	7'-2"	1'-3/4"		ALUM	FG1	2	ALUM	CW5	12/A6-04	11/A6-04	2/A6-04		06	3	
152	3'-0"	7'-2"	1'-3/4"		SCWD	F	1	HM	HM1	30/A6-04	23/A6-04			70		
153	3'-0"	7'-2"	1'-3/4"		SCWD	F	1	HM	HM1	30/A6-04	23/A6-04	T4		63	45 MIN	
154	3'-0"	7'-2"	1'-3/4"		SCWD	F	1	HM	HM1	30/A6-04	23/A6-04	T4		62		
155	12'-0"	10'-0"	1'-2"		GATE									90	SEE 5/A6-02	
155B	3'-0"	7'-2"	1'-3/4"		GATE											
155C	3'-0"	7'-2"	1'-3/4"		GATE											
156	3'-0"	7'-2"	1'-3/4"		SCWD	F	1	HM	HM1	29/A6-04	22/A6-04	T4		70		
158	3'-0"	7'-2"	1'-3/4"		SCWD	F	1	HM	HM1					36	90 MIN	
159	6'-0"	7'-2"	1'-3/4"		SCWD	F	2	HM	HM1					85	90 MIN	
200A	6'-0"	7'-2"	1'-3/4"		SCWD	NFR	2	HM	HM2	7/A6-04	8/A5-02	11/A5-01		25	90 MIN	1
200B	6'-0"	7'-2"	1'-3/4"		SCWD	NFR	2	HM	HM1	7/A6-04	8/A5-02	11/A5-01		25	90 MIN	1
200C	6'-0"	7'-2"	1'-3/4"		ALUM	FG1	2	ALUM	AL1	27/A6-04	20/A6-04	1/A6-04		10	3.7	
201A	6'-0"	7'-2"	1'-3/4"		SCWD	N	2	HM	HM1	32/A6-04	25/A6-04			38	5	
201B	6'-0"	7'-2"	1'-3/4"		SCWD	N	2	HM	HM1	32/A6-04	25/A6-04			37	5	
202A	3'-0"	7'-2"	1'-3/4"		SCWD	F	1	HM	HM1	32/A6-04	25/A6-04			82		

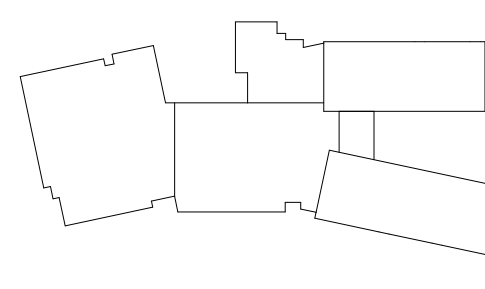

KEY PLAN
NO SCALE

ID	DATE	DESCRIPTION
6/14/19	ADDENDUM 3	
DRAWN BY:	LP, JS, DW	
CHECKED BY:	DW	

DOOR SCHEDULE,
WINDOW AND
FRAME
ELEVATIONS

2017032 20 MAY 2019


A6-02

LEGEND


W... FRAME DESIGNATION
SF... ALUMINUM STOREFRONT
CW... ALUMINUM CURTAIN WALL
HM... HOLLOW METAL
TG... TRANSLUCENT GLAZING

GLAZING AND FRAME NOTES







- 1 ALL GLAZING TO BE 1" LOW E, INSULATED, UNLESS OTHERWISE NOTED
- 2 1" INSULATED, LOW E, TEMPERED GLAZING
- 3 1/4" TEMPERED GLAZING
- 4 ALL FRAMES SHALL BE THERMALLY BROKEN
- 5 90 MIN RATED WINDOW ASSEMBLY/FIRE GLASS
- 6 SPANDREL GLAZING SYSTEM
- 7 STRUCTURAL SILICON GLAZED (SSG) FRAME
- 8 BLINDS OR ROLLER SHADES WHERE INDICATED
- 9 REFER TO BUILDING ELEVATIONS FOR ATYPICAL SPANDREL LOCATIONS

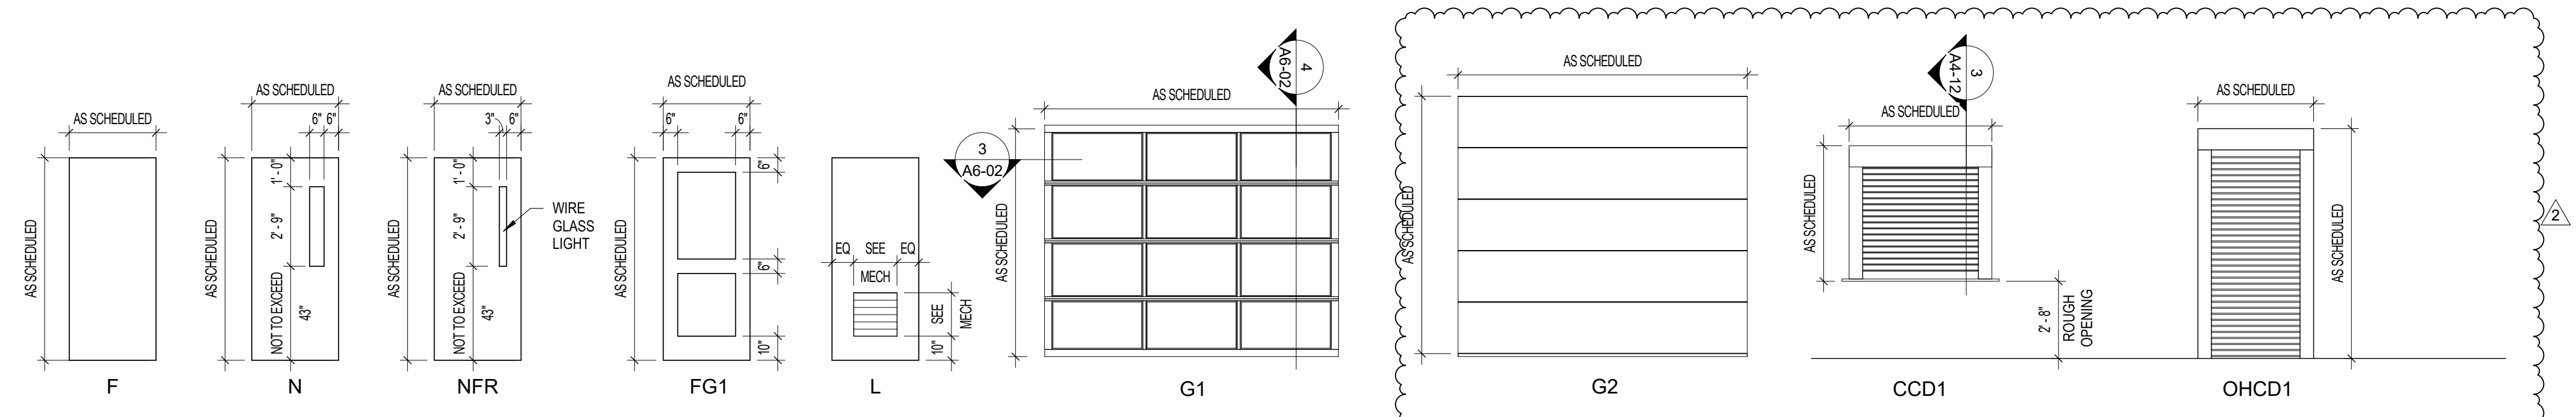

DOOR LEGEND
1/4" = 1'-0"




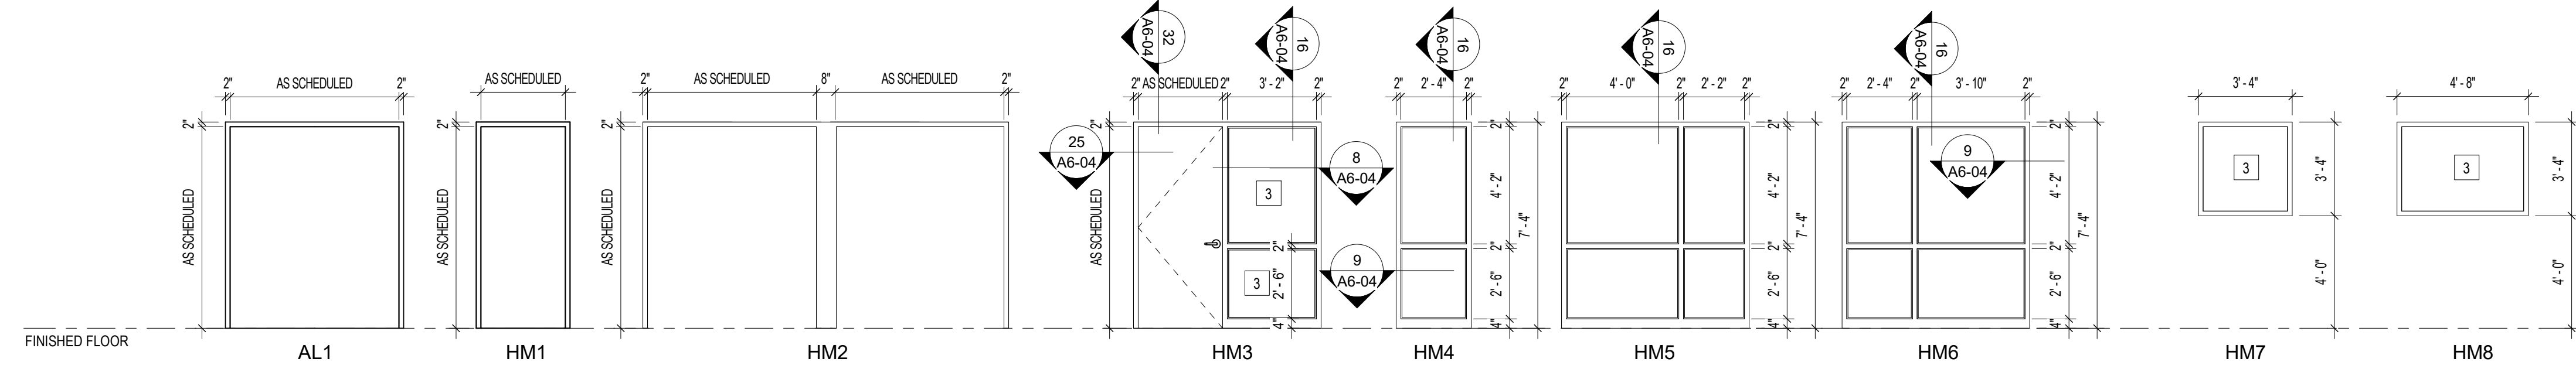


FRAME LEGEND
1/4" = 1'-0"

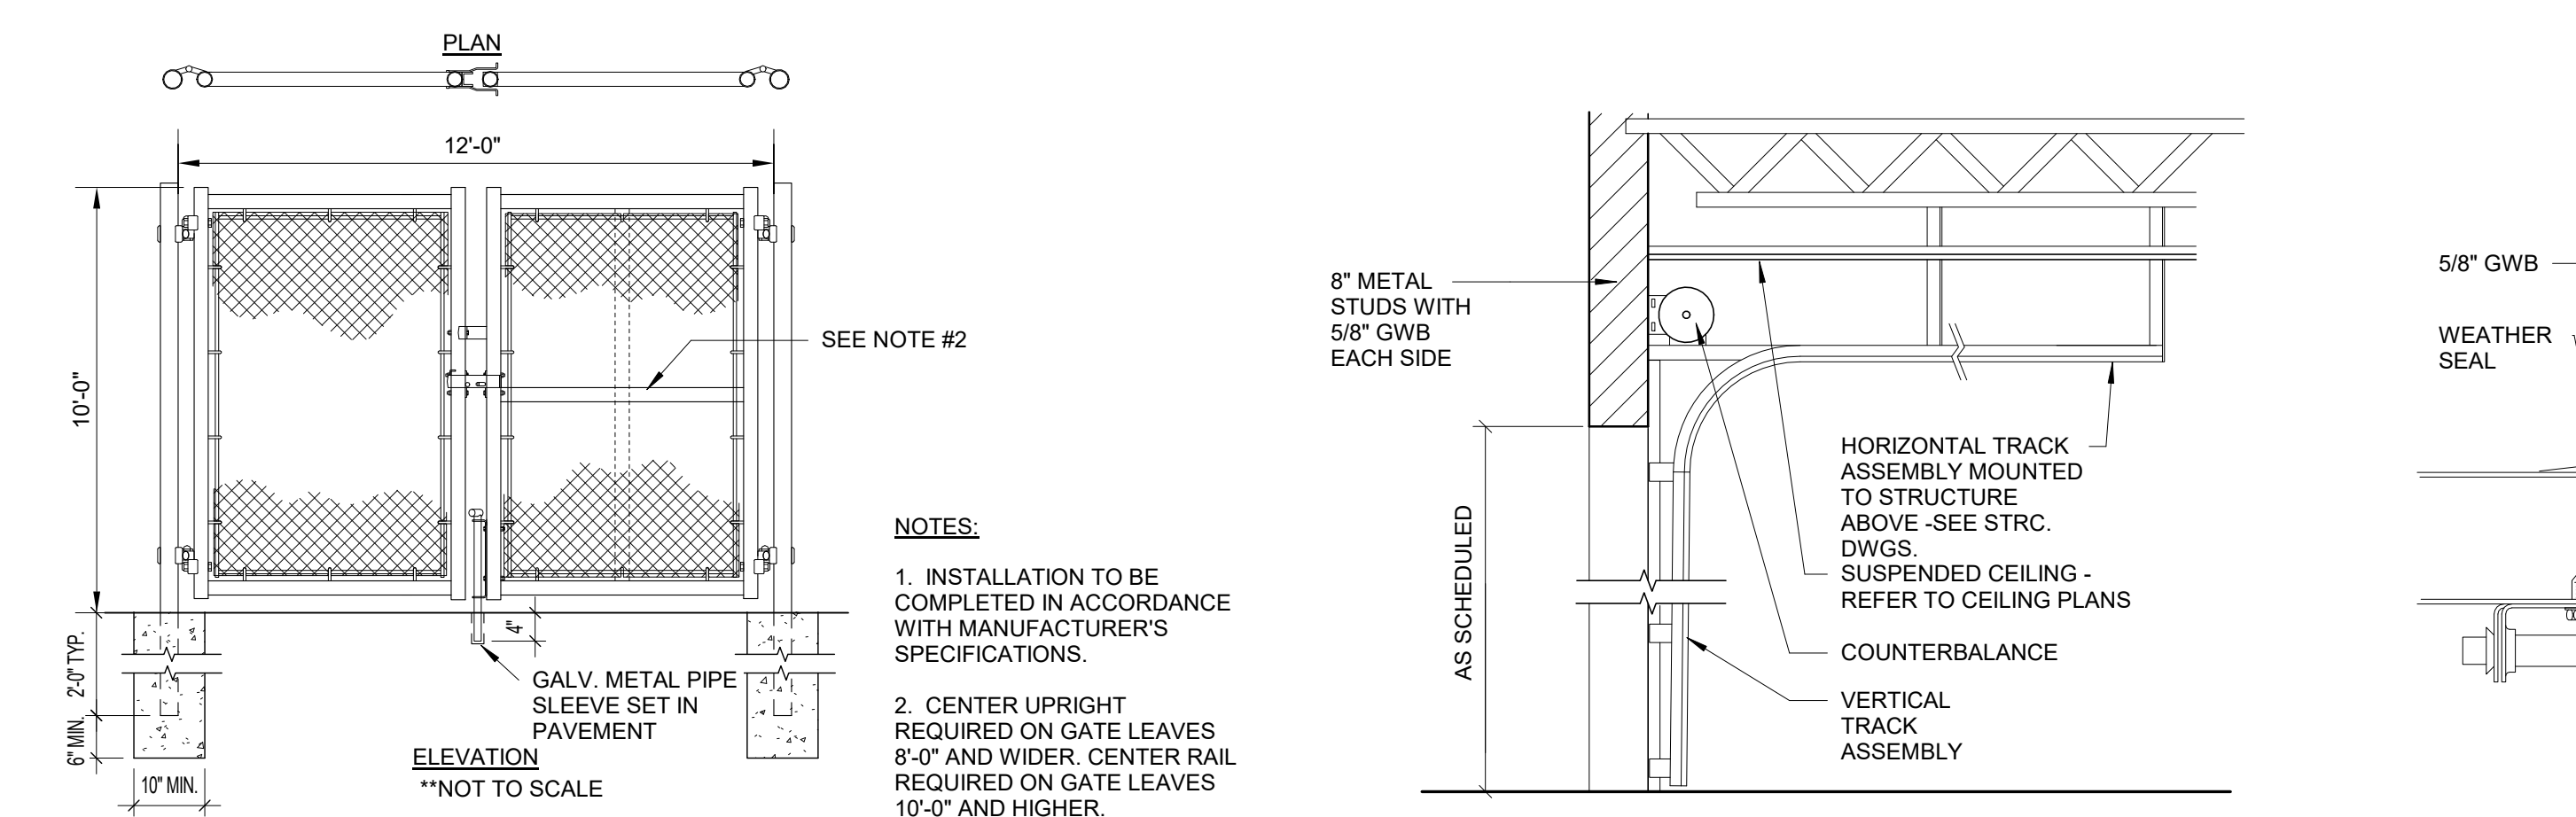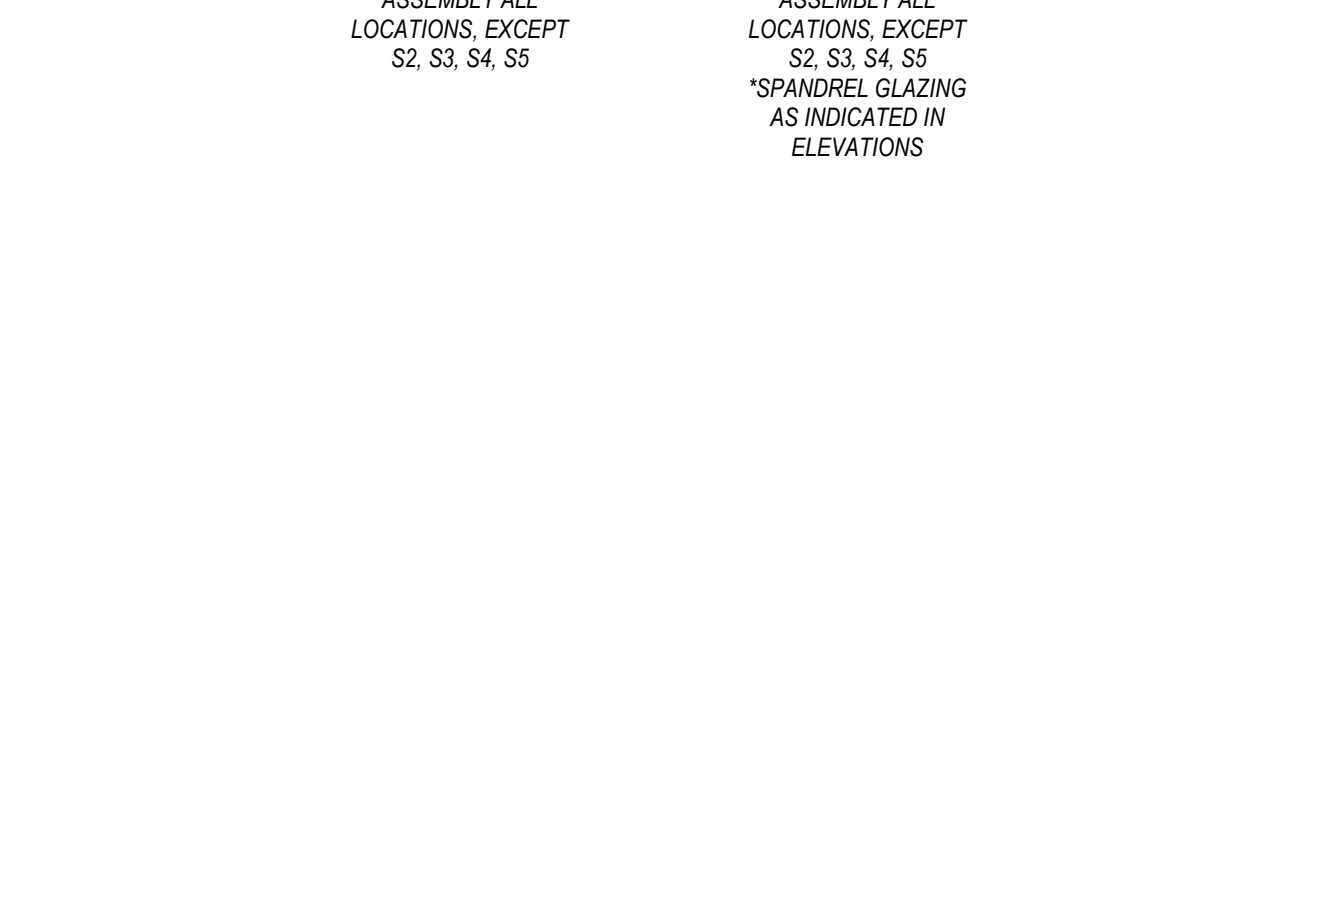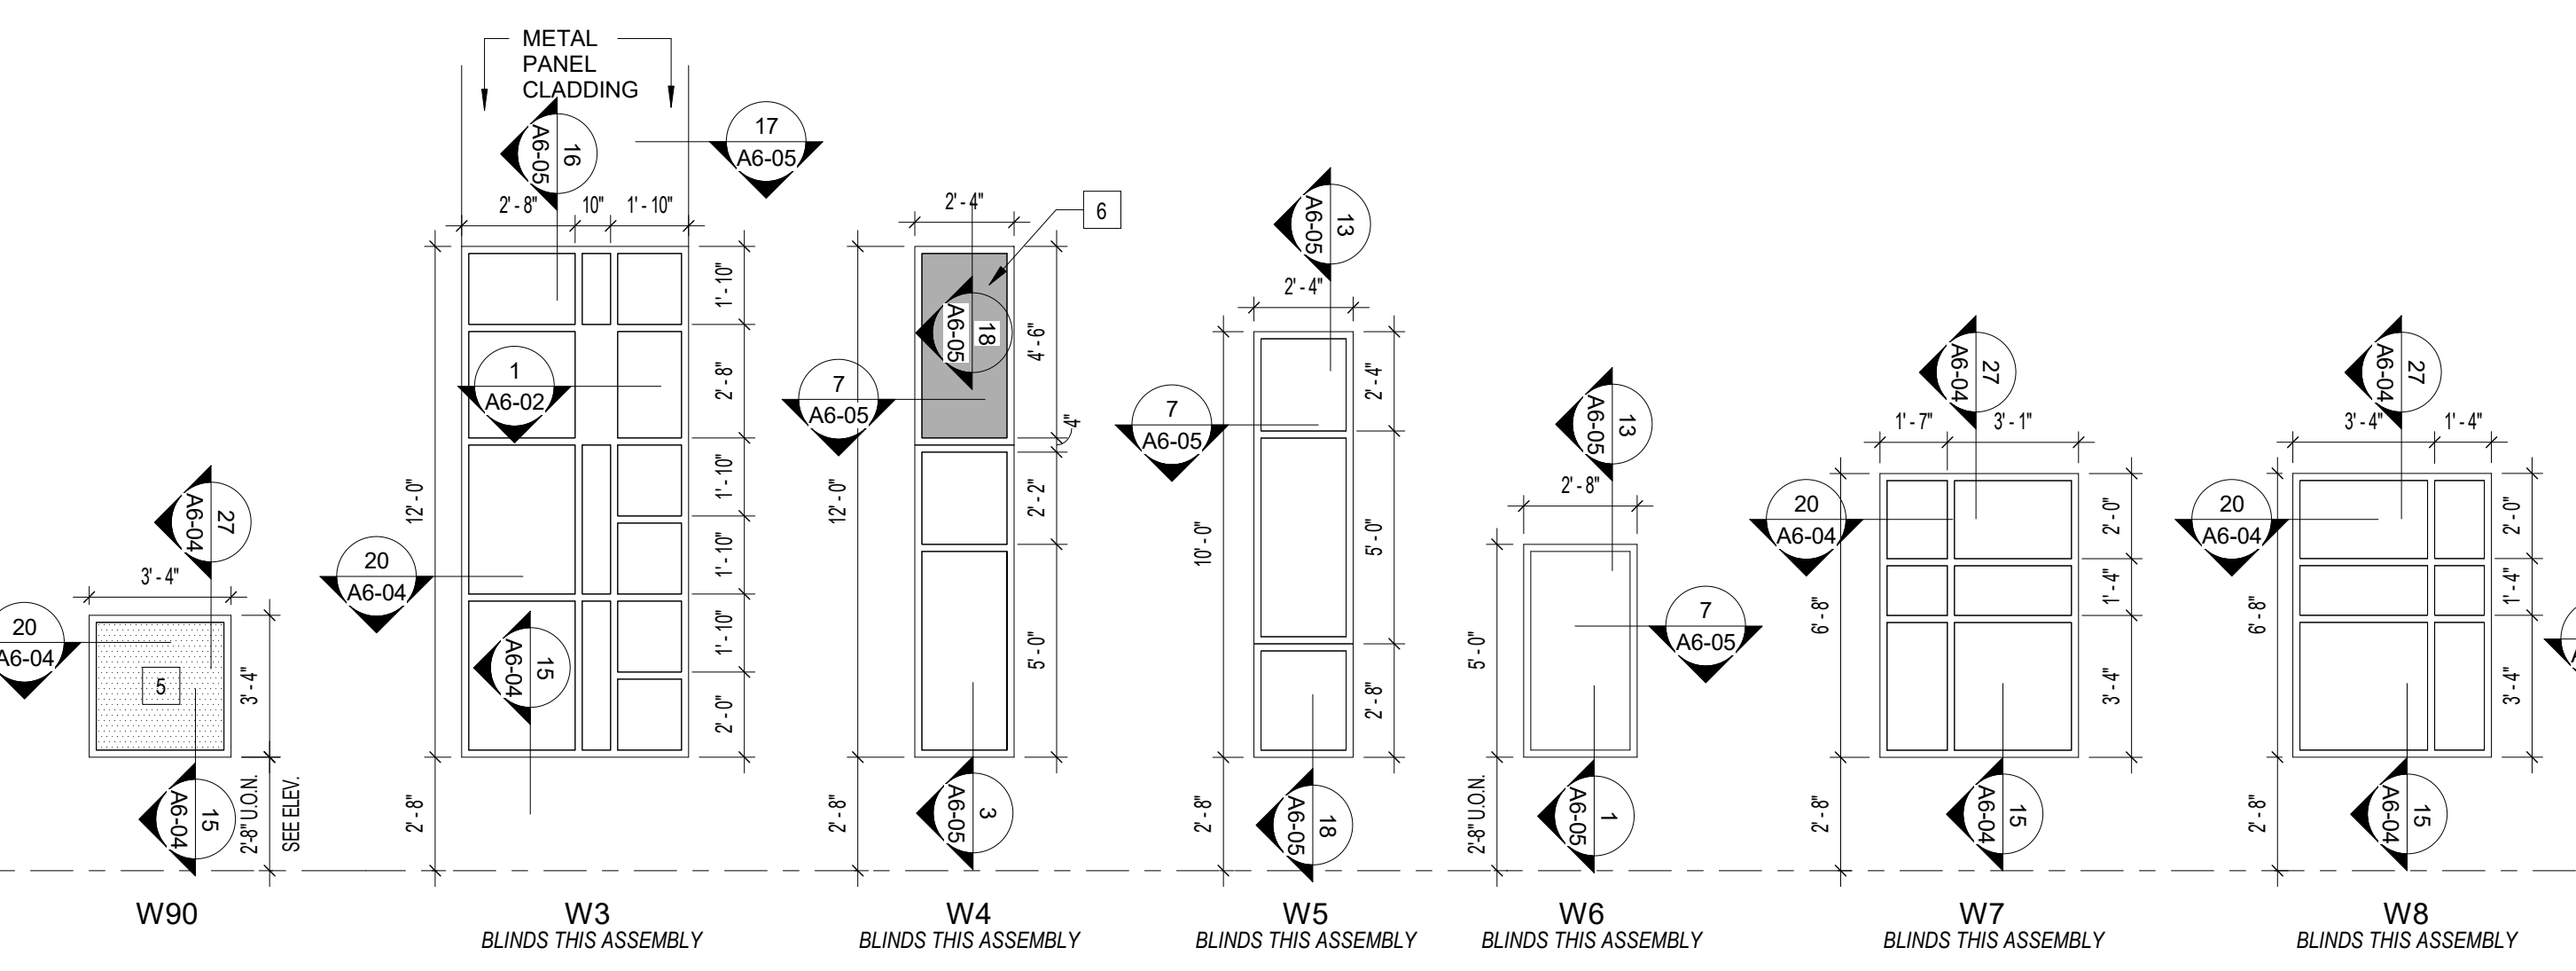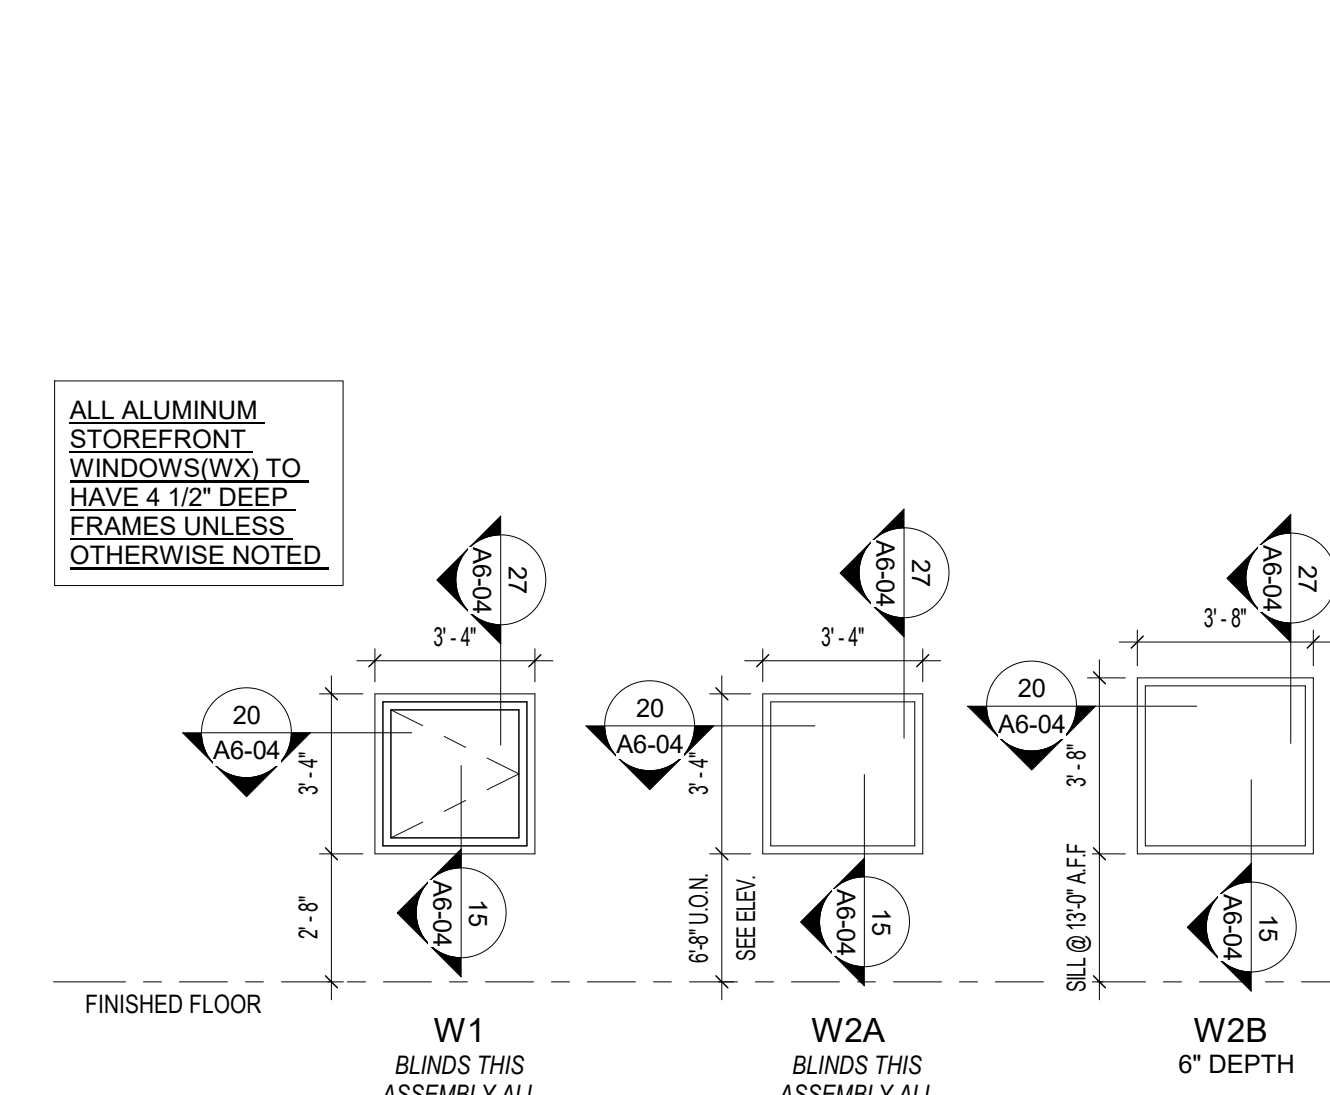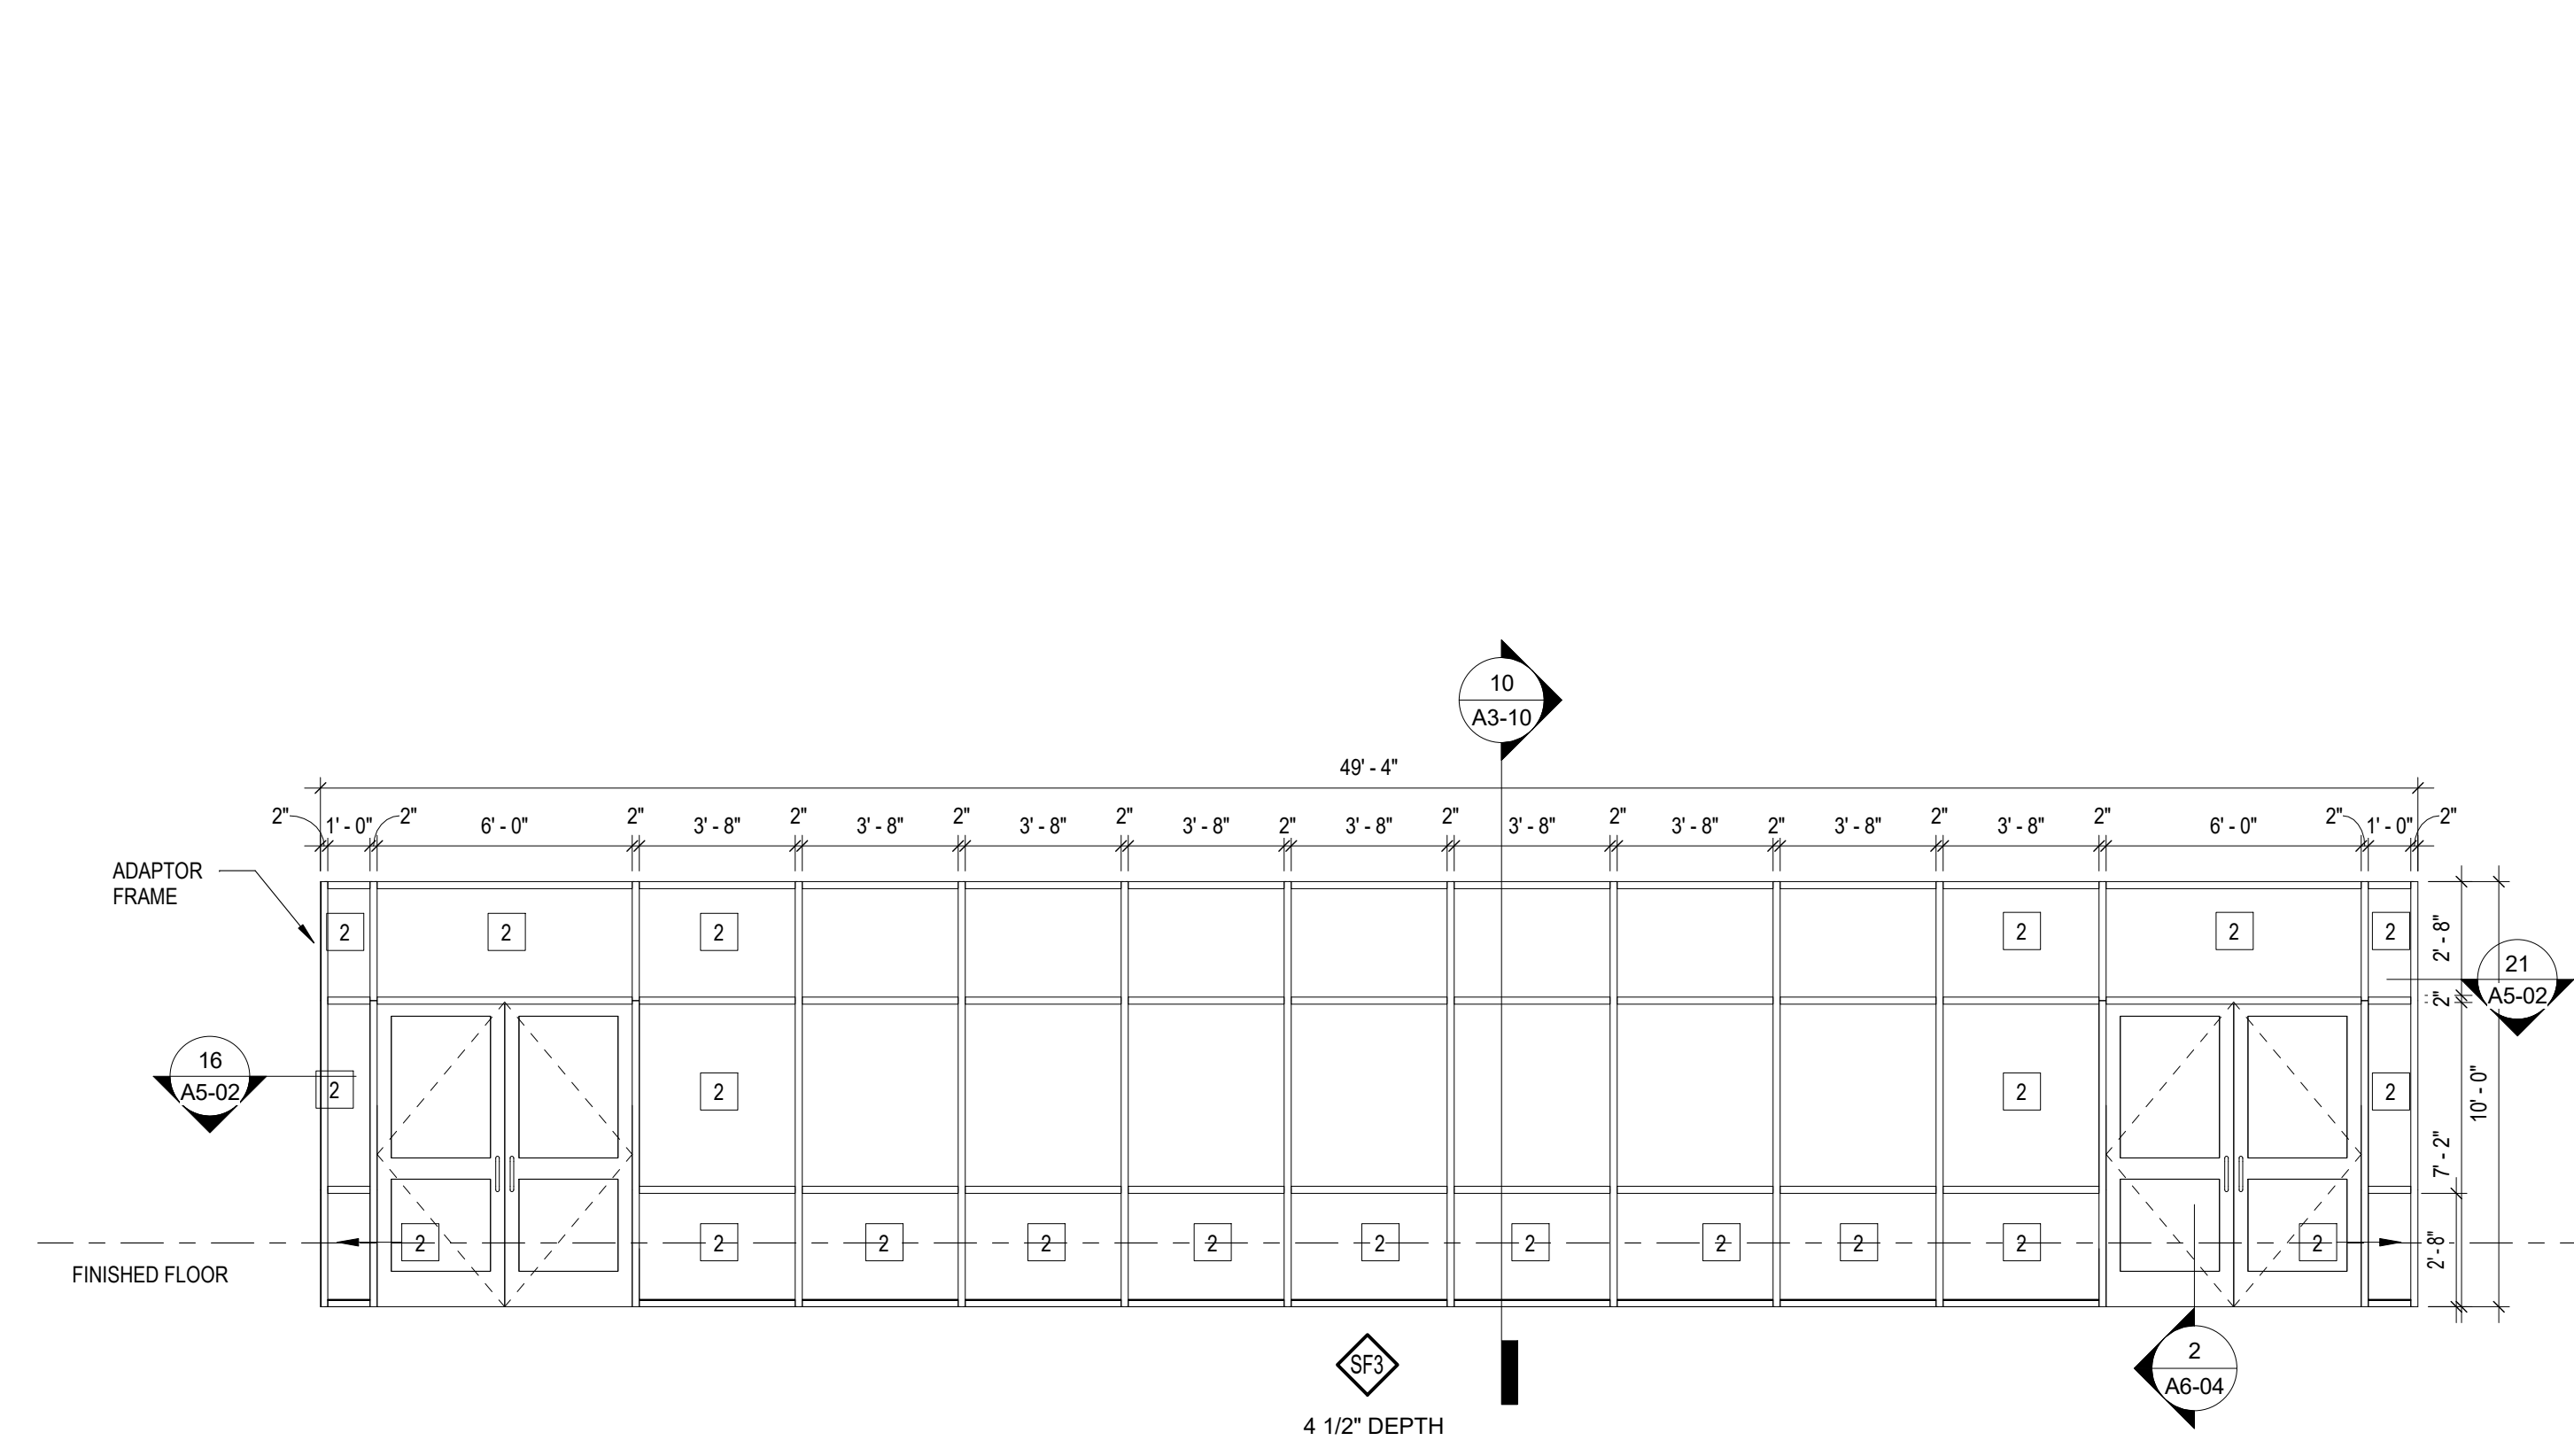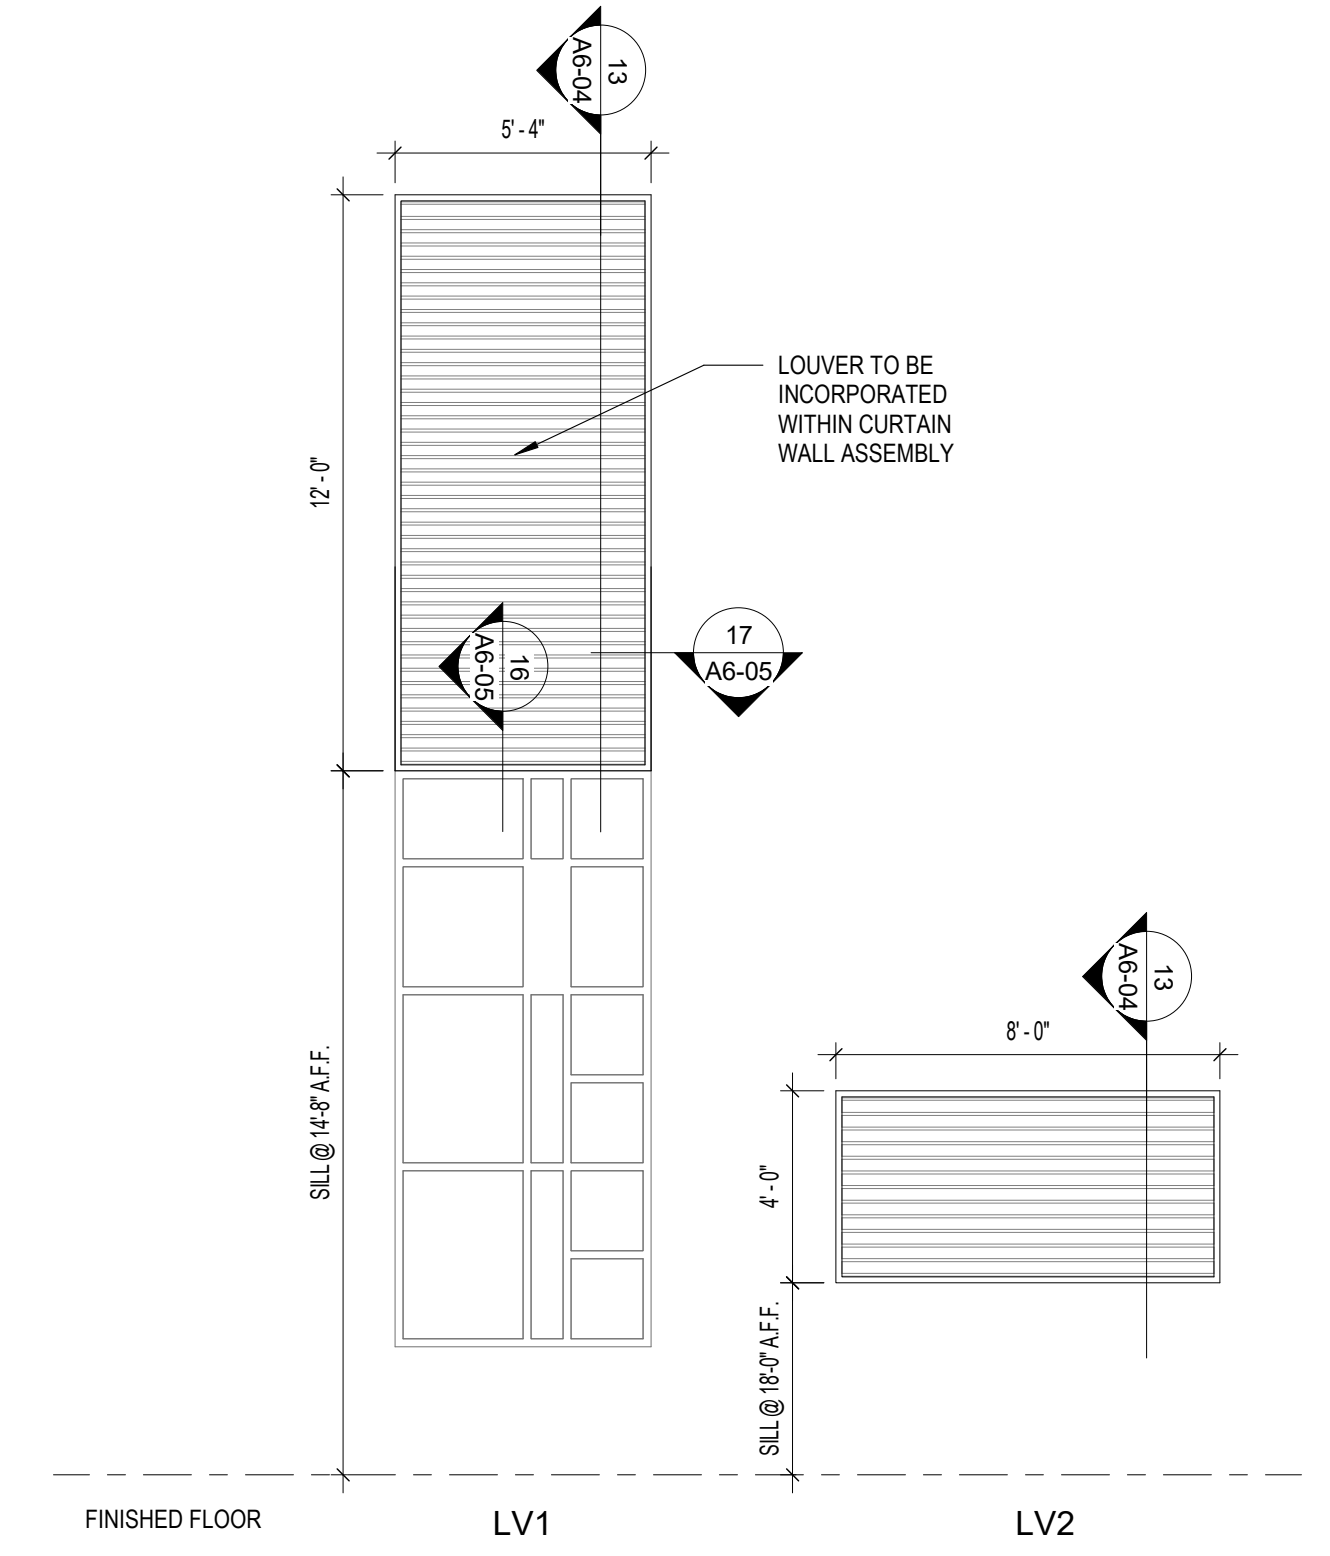

5 SERVICE YARD GATE
A6-02 1/2" = 1'-0"



4 SECTIONAL DOOR TRACK
A6-02 3/4" = 1'-0"

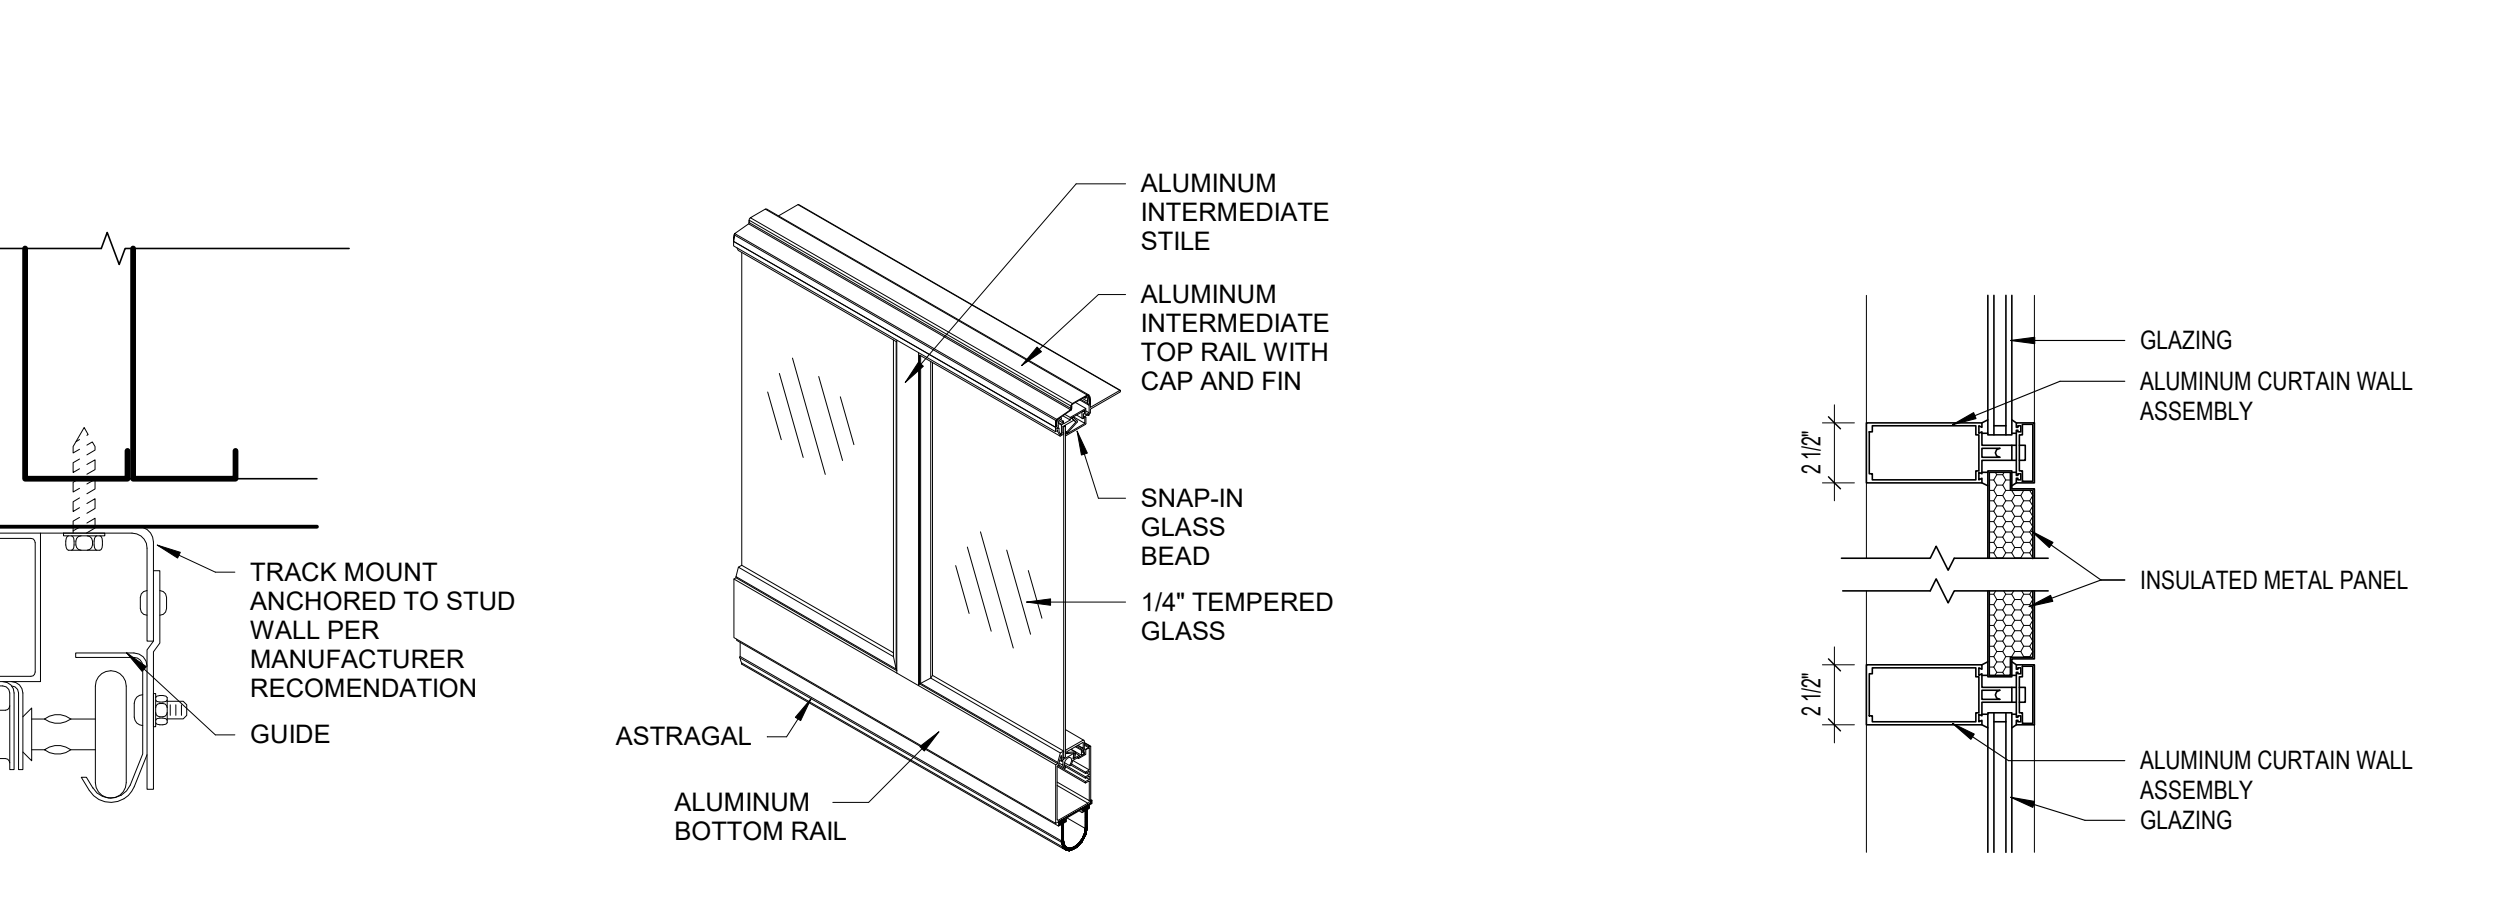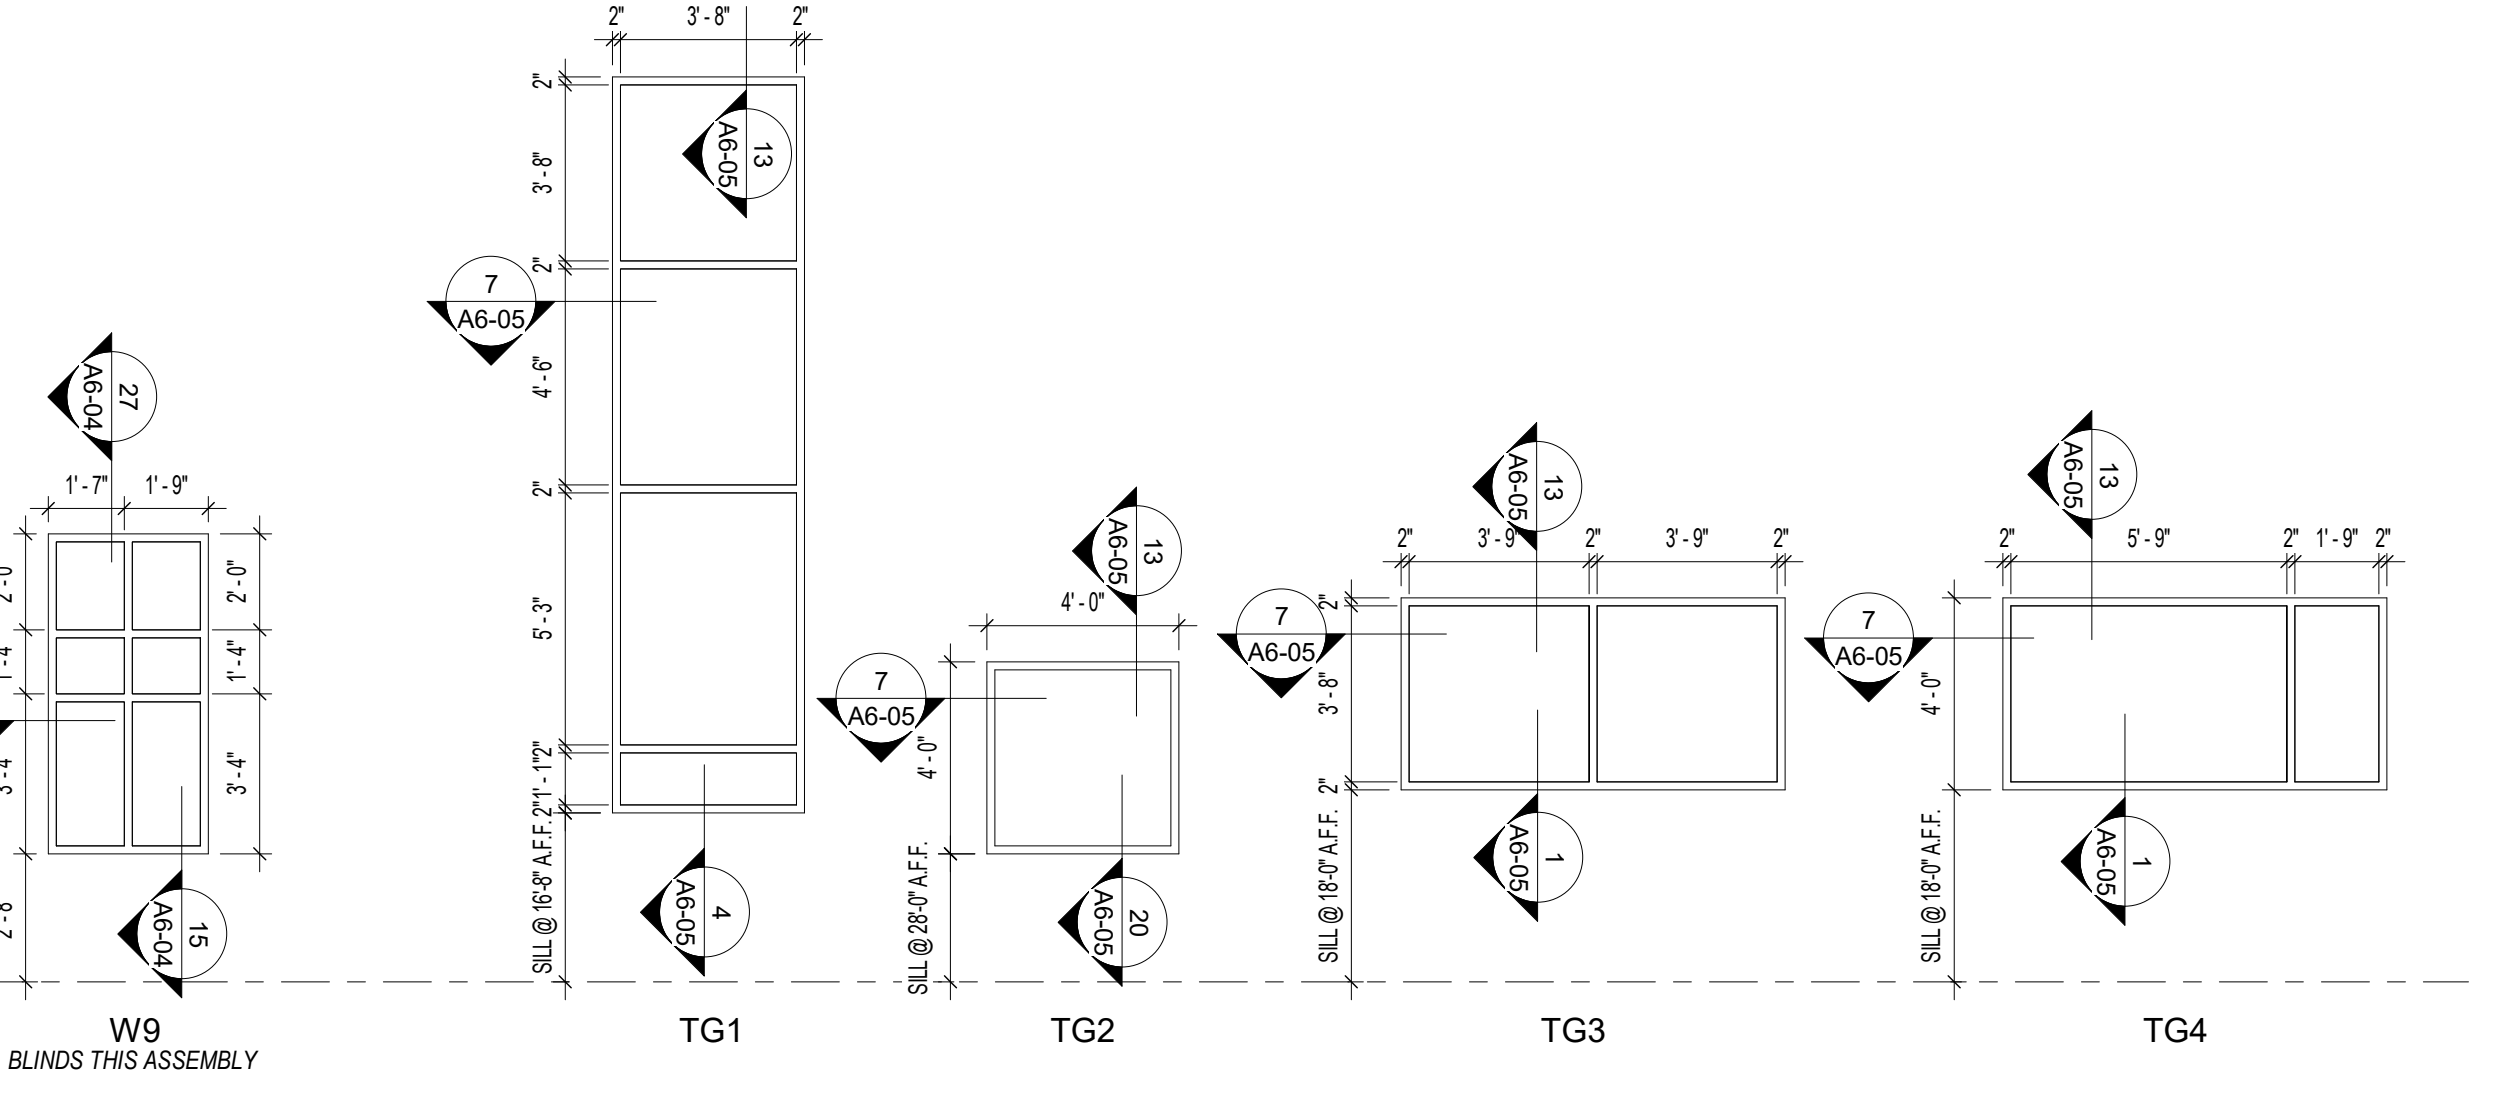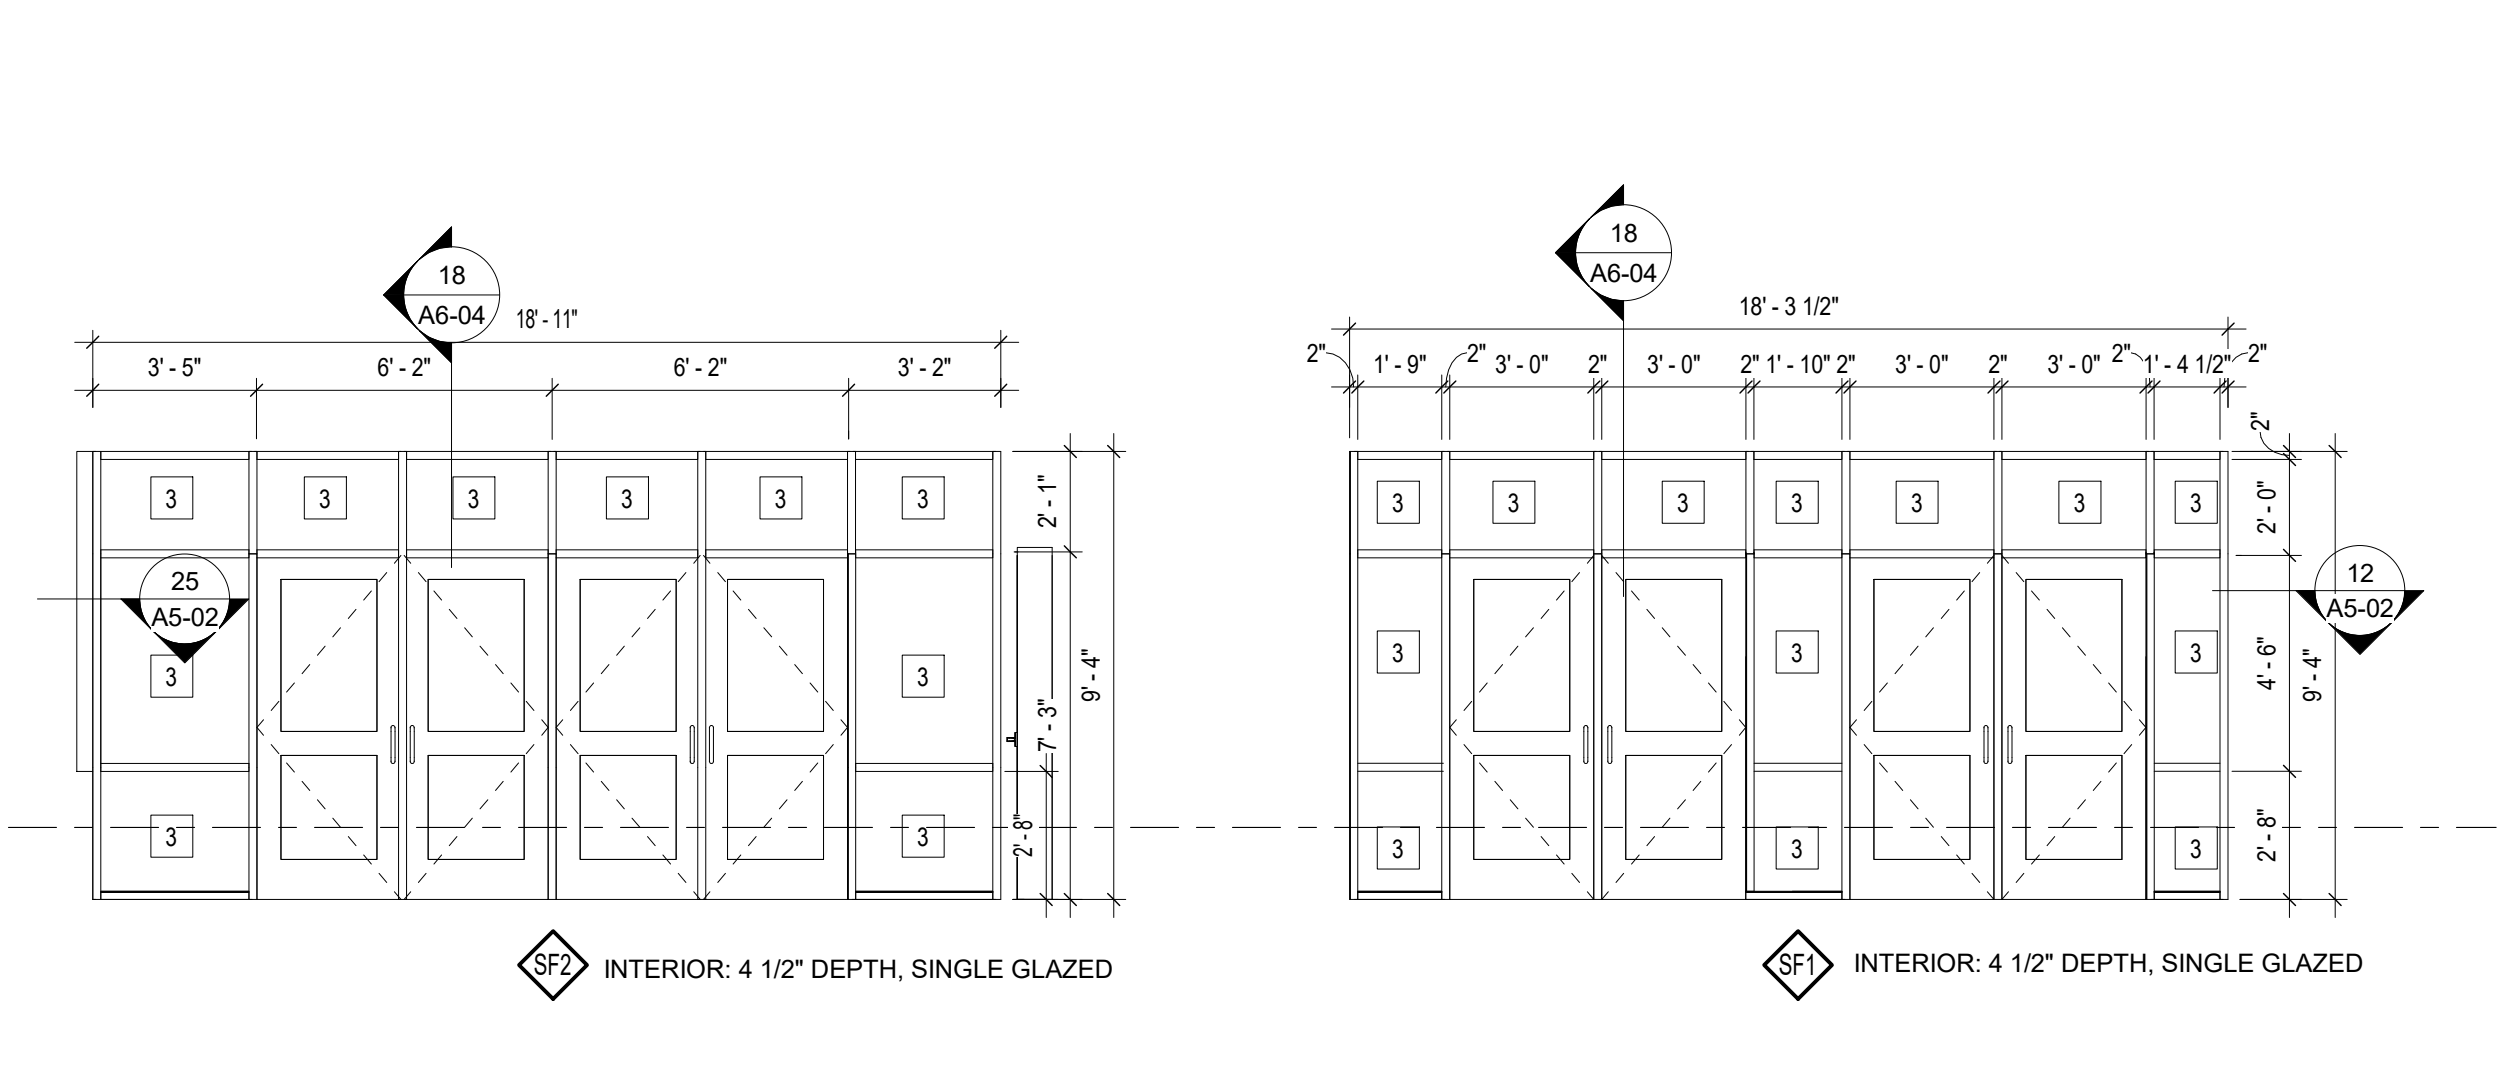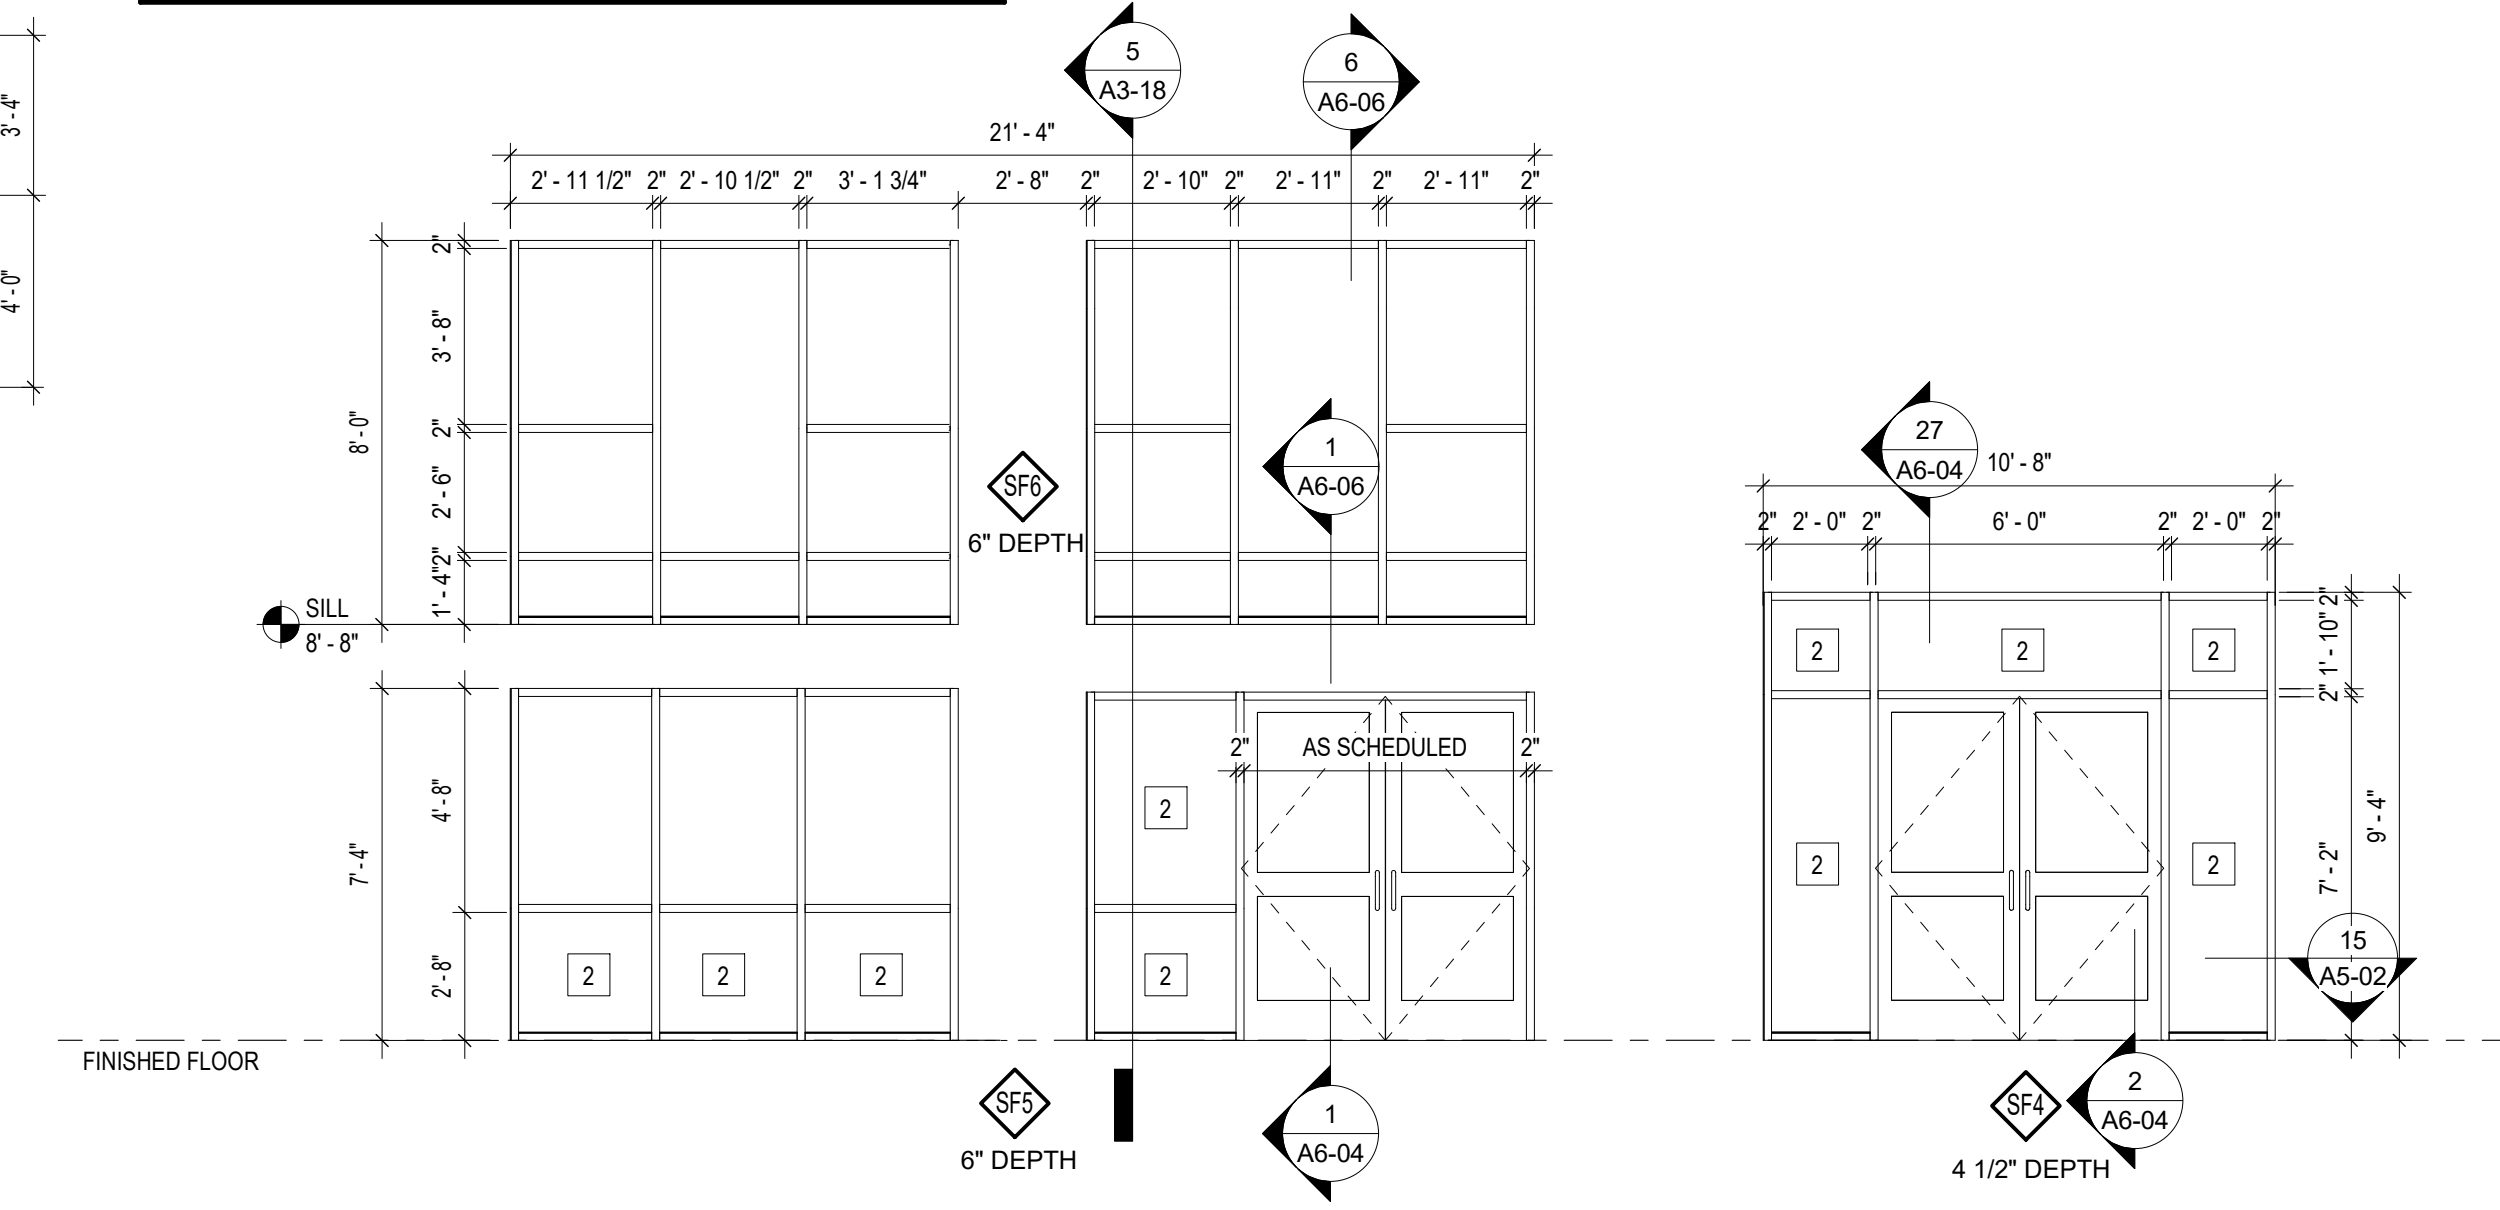

3 SECTIONAL DOOR JAMB
A6-02 1" = 1'-0"

2 SECTIONAL DOOR PANEL ISO
A6-02 1" = 1'-0"

1 INSULATED METAL PANEL DETAIL
A6-02 1 1/2" = 1'-0"

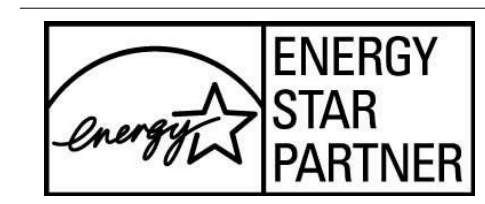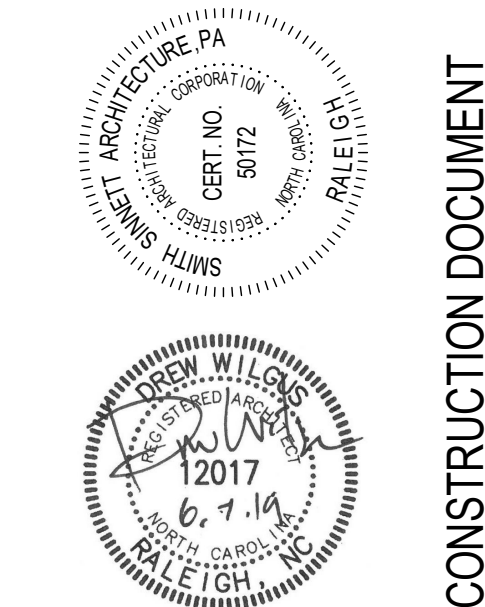


VOLUME I

The drawings on this sheet show the work to be done by the Contractor. It is the responsibility of the Contractor to verify the accuracy of the information shown on this drawing. Any information on this drawing that is not shown on the drawing is the responsibility of the Contractor. Smith Sinnett Architecture, P.A. 2018

THIS DRAWING IS FORMATTED TO BE PRINTED ON A 30" x 42" SHEET

**TRINITY MIDDLE SCHOOL
RANDOLPH COUNTY SCHOOL SYSTEM**
Parcel PIN 7708118367
Surrett Drive
Trinity, NC 27370

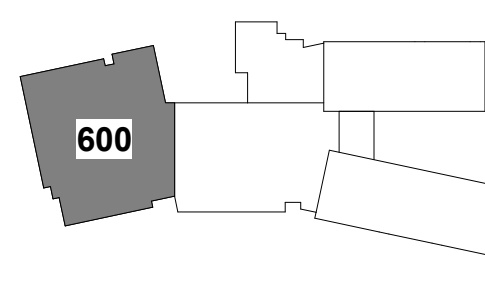

**KEY PLAN
NO SCALE**

6/14/19	ADDENDUM 3
6/7/19	ADDENDUM 2
ID	DATE DESCRIPTION
DRAWN BY:	LP, JS, DW
CHECKED BY:	DW

FINISH LEGEND

WALL FINISHES BASED ON PLAN LOCATION

ROOM NAME	ROOM NUMBER
North	East
Room	Area

INDICATES ACCENT PAINT OR WALL TILE

PAINT

PT-1/EPT-1	INTERIOR FIELD PAINTERPOXY PAINT
PT-1A	INTERIOR FIELD PAINTERPOXY SHOWER PAINT
PT-2/EPT-2	INTERIOR ACCENT PAINTERPOXY PAINT
PT-3/EPT-3	INTERIOR ACCENT PAINTERPOXY PAINT
PT-4/EPT-4	INTERIOR ACCENT PAINTERPOXY PAINT
PT-5/EPT-5	INTERIOR ACCENT PAINTERPOXY PAINT
PT-6/EPT-6	INTERIOR ACCENT PAINTERPOXY PAINT
PT-7/EPT-7	INTERIOR ACCENT PAINTERPOXY PAINT
PT-8/EPT-8	INTERIOR ACCENT PAINTERPOXY PAINT
PT-9	INTERIOR CEILING PAINT - 1
PT-10	INTERIOR CEILING PAINT - 2
PT-11	EXTERIOR FIELD PAINT
PT-12	INTERIOR ACCENT PAINT
PT-13	INTERIOR ACCENT PAINT
PT-14	INTERIOR ACCENT PAINT
PT-15	INTERIOR ACCENT PAINT
PT-16	INTERIOR ACCENT PAINT

FLOOR FINISH

SC	SEALED CONCRETE - FIELD
PC-1	POLISHED CONCRETE - ACCENT
PC-2	POLISHED CONCRETE - ACCENT
VCT-A	VCT PATTERN - A (SEE DIAGRAM)
VCT-B	VCT PATTERN - B (SEE DIAGRAM)
VCT-1	VINYL COMPOSITE TILE - FIELD 1/ACCENT
VCT-2	VINYL COMPOSITE TILE - FIELD 2
VCT-3	VINYL COMPOSITE TILE - ACCENT
VCT-4	VINYL COMPOSITE TILE - ACCENT
VCT-5	VINYL COMPOSITE TILE - ACCENT
VCT-6	VINYL COMPOSITE TILE - ACCENT
VCT-7	VINYL COMPOSITE TILE - ACCENT
VCT-8	VINYL COMPOSITE TILE - ACCENT
VCT-9	VINYL COMPOSITE TILE - FIELD 3
MT-A	CERAMIC TILE PATTERN - A
MT-1	CERAMIC TILE - 1
MT-2	CERAMIC TILE - 2
MT-3	CERAMIC TILE - 3
MT-4	CERAMIC TILE - 4
MT-5	CERAMIC TILE - 5
MT-6	CERAMIC TILE - 6
QT	QUARRY TILE
CPT-1	CARPET TILE - 1
CPT-2	CARPET TILE - 2
AFL-1	ATHLETIC FLOORING
AFL-2	ATHLETIC FLOORING - ACCENT
AFL-3	ATHLETIC FLOORING - ACCENT
WFL	WOOD FLOOR
WD	WOOD STAIR TREAD
TRZ-2	TERRAZZO - ACCENT 1 (ALTERNATE)
TRZ-3	TERRAZZO - ACCENT 2 (ALTERNATE)

WALL BASE







RB	RUBBER BASE
RBT	RUBBER TREAD
VRB	VENTED RUBBER BASE
CTB-1	CERAMIC TILE BASE - FIELD COLOR
CTB-2	CERAMIC TILE COVE BASE - ACCENT COLOR
QTB	QUARRY TILE BASE

SURFACE FINISH


PLM-1	PLASTIC LAMINATE - BASE (MAPLE)
PLM-2	PLASTIC LAMINATE - COUNTER
PLM-3	PLASTIC LAMINATE - UPPER
PLM-4	PLASTIC LAMINATE - ACCENT
PLM-5	PLASTIC LAMINATE - ACCENT
PLM-6	PLASTIC LAMINATE - ACCENT
SS-1	SOLID SURFACE - COUNTER

GENERAL FINISH NOTES


- ALL GIBB CEILINGS AND BULKHEADS BE PT-1 U.O.N.
- ALL CEILINGS WITH EXPOSED TO STRUCTURE TO BE PT-9 OR PT-10 AS INDICATED.
- ARCHITECT SHALL HAVE THE OPTION OF SELECTING FROM A MINIMUM OF THREE APPROVED PLASTIC LAMINATE MANUFACTURER'S PRODUCTS. THE ARCHITECT SHALL BE ABLE TO COMBINE LAMINATES FROM DIFFERENT MANUFACTURERS AS DESIRED DURING SHOP DRAWING PHASE. FINISH MATERIALS SUBMITTED AS EQUALS TO THE LISTED MANUFACTURERS WILL BE APPROVED OR REJECTED BASED ON COLOR INTEGRITY AND TACTILE CHARACTERISTICS IN ADDITION TO TECHNICAL SPECIFICATIONS.
- ROOMS WILL HAVE MILLWORK DESIGNS WITH MORE THAN THREE LAMINATE COLORS. EXACT LOCATION OF EACH TYPE TO BE DETERMINED DURING SHOP DRAWING PHASE. FINISHES ARE CONTINGENT ON FINAL OWNER AND ARCHITECT APPROVAL.

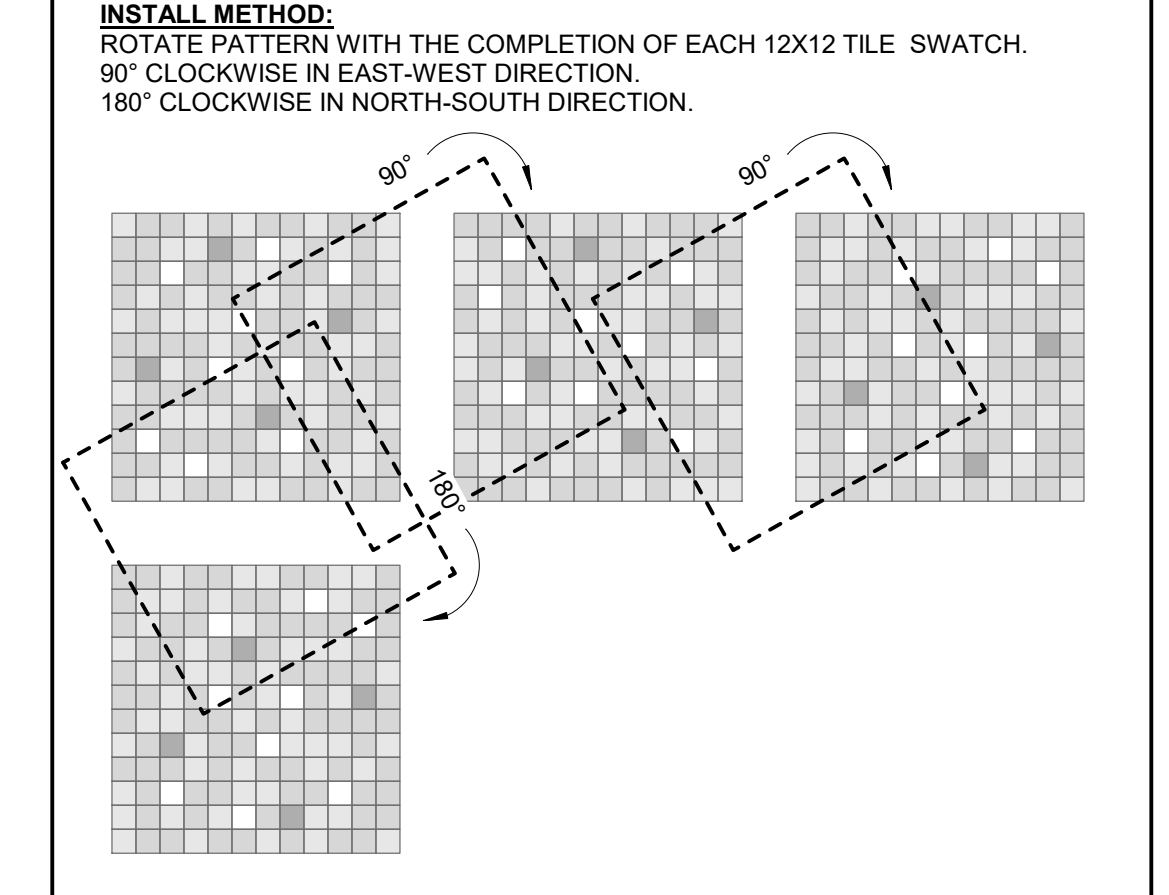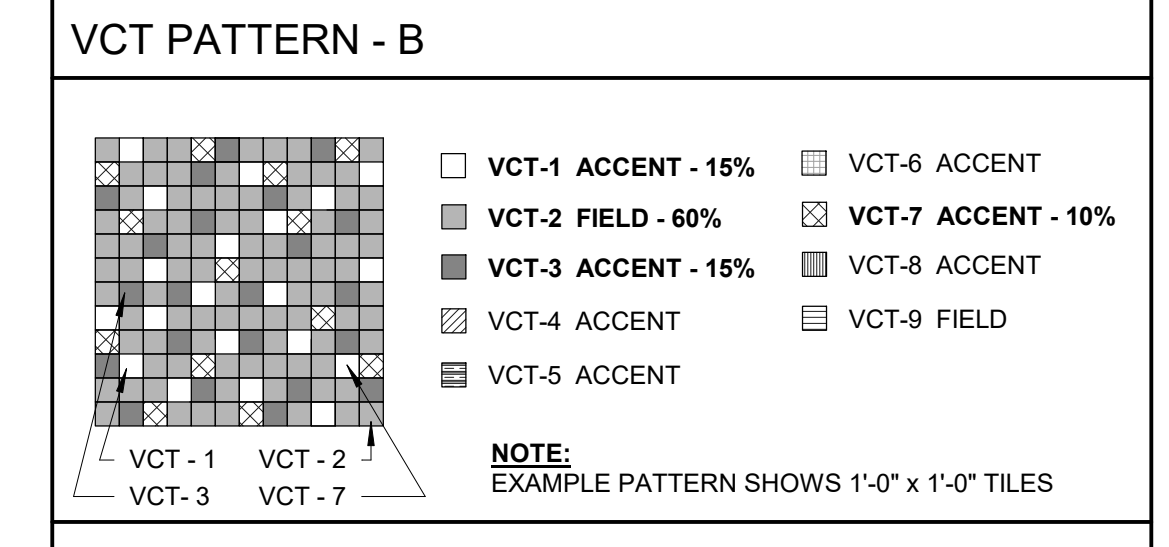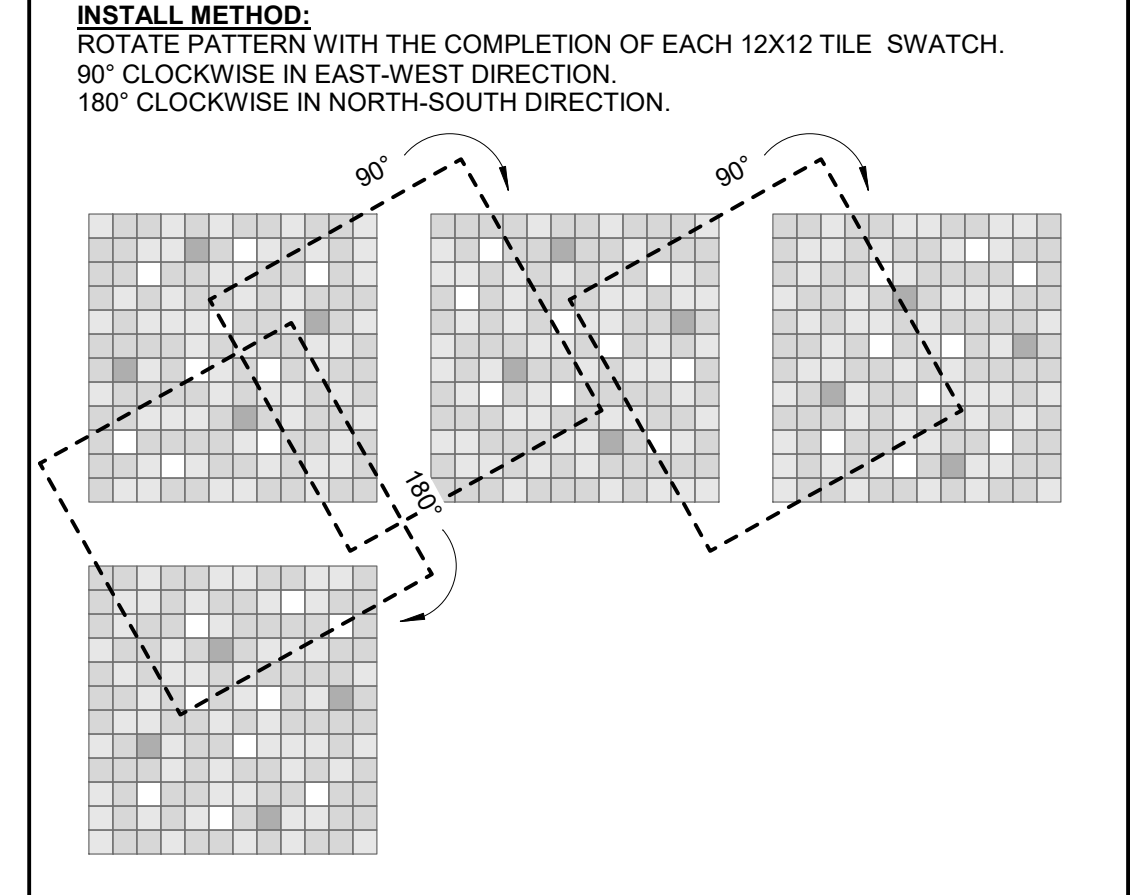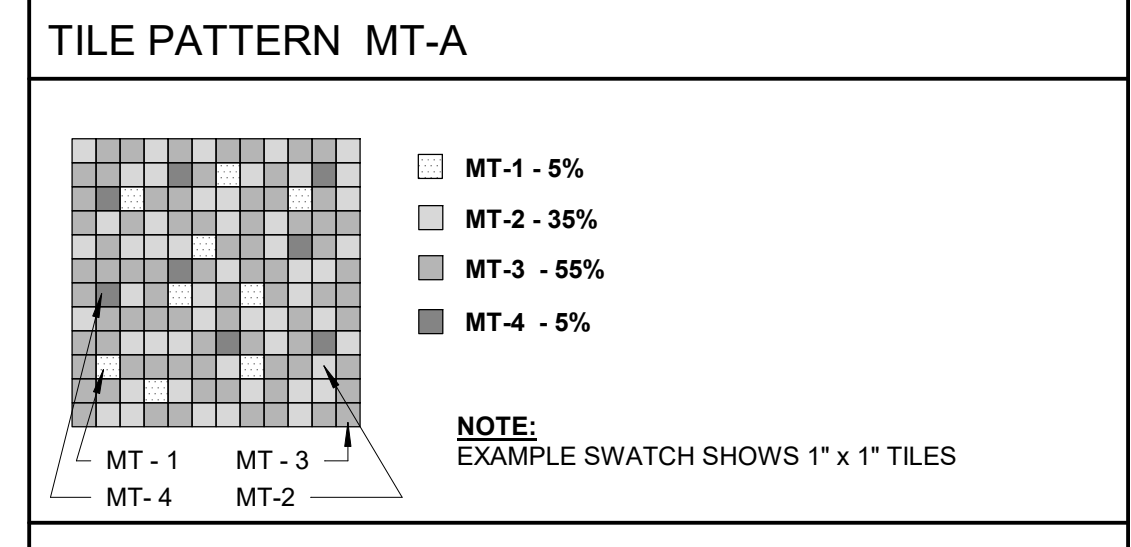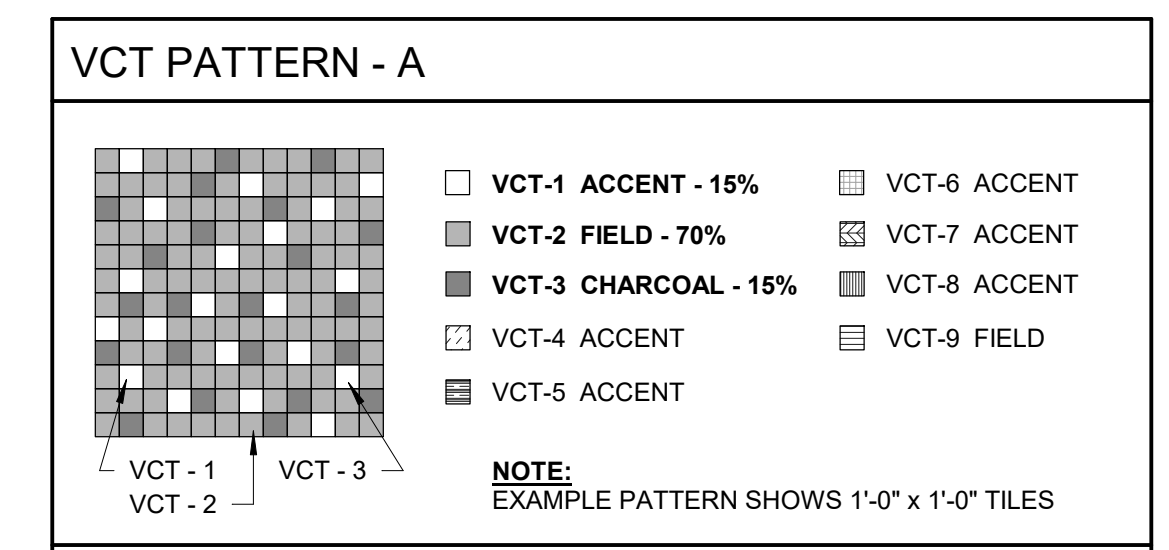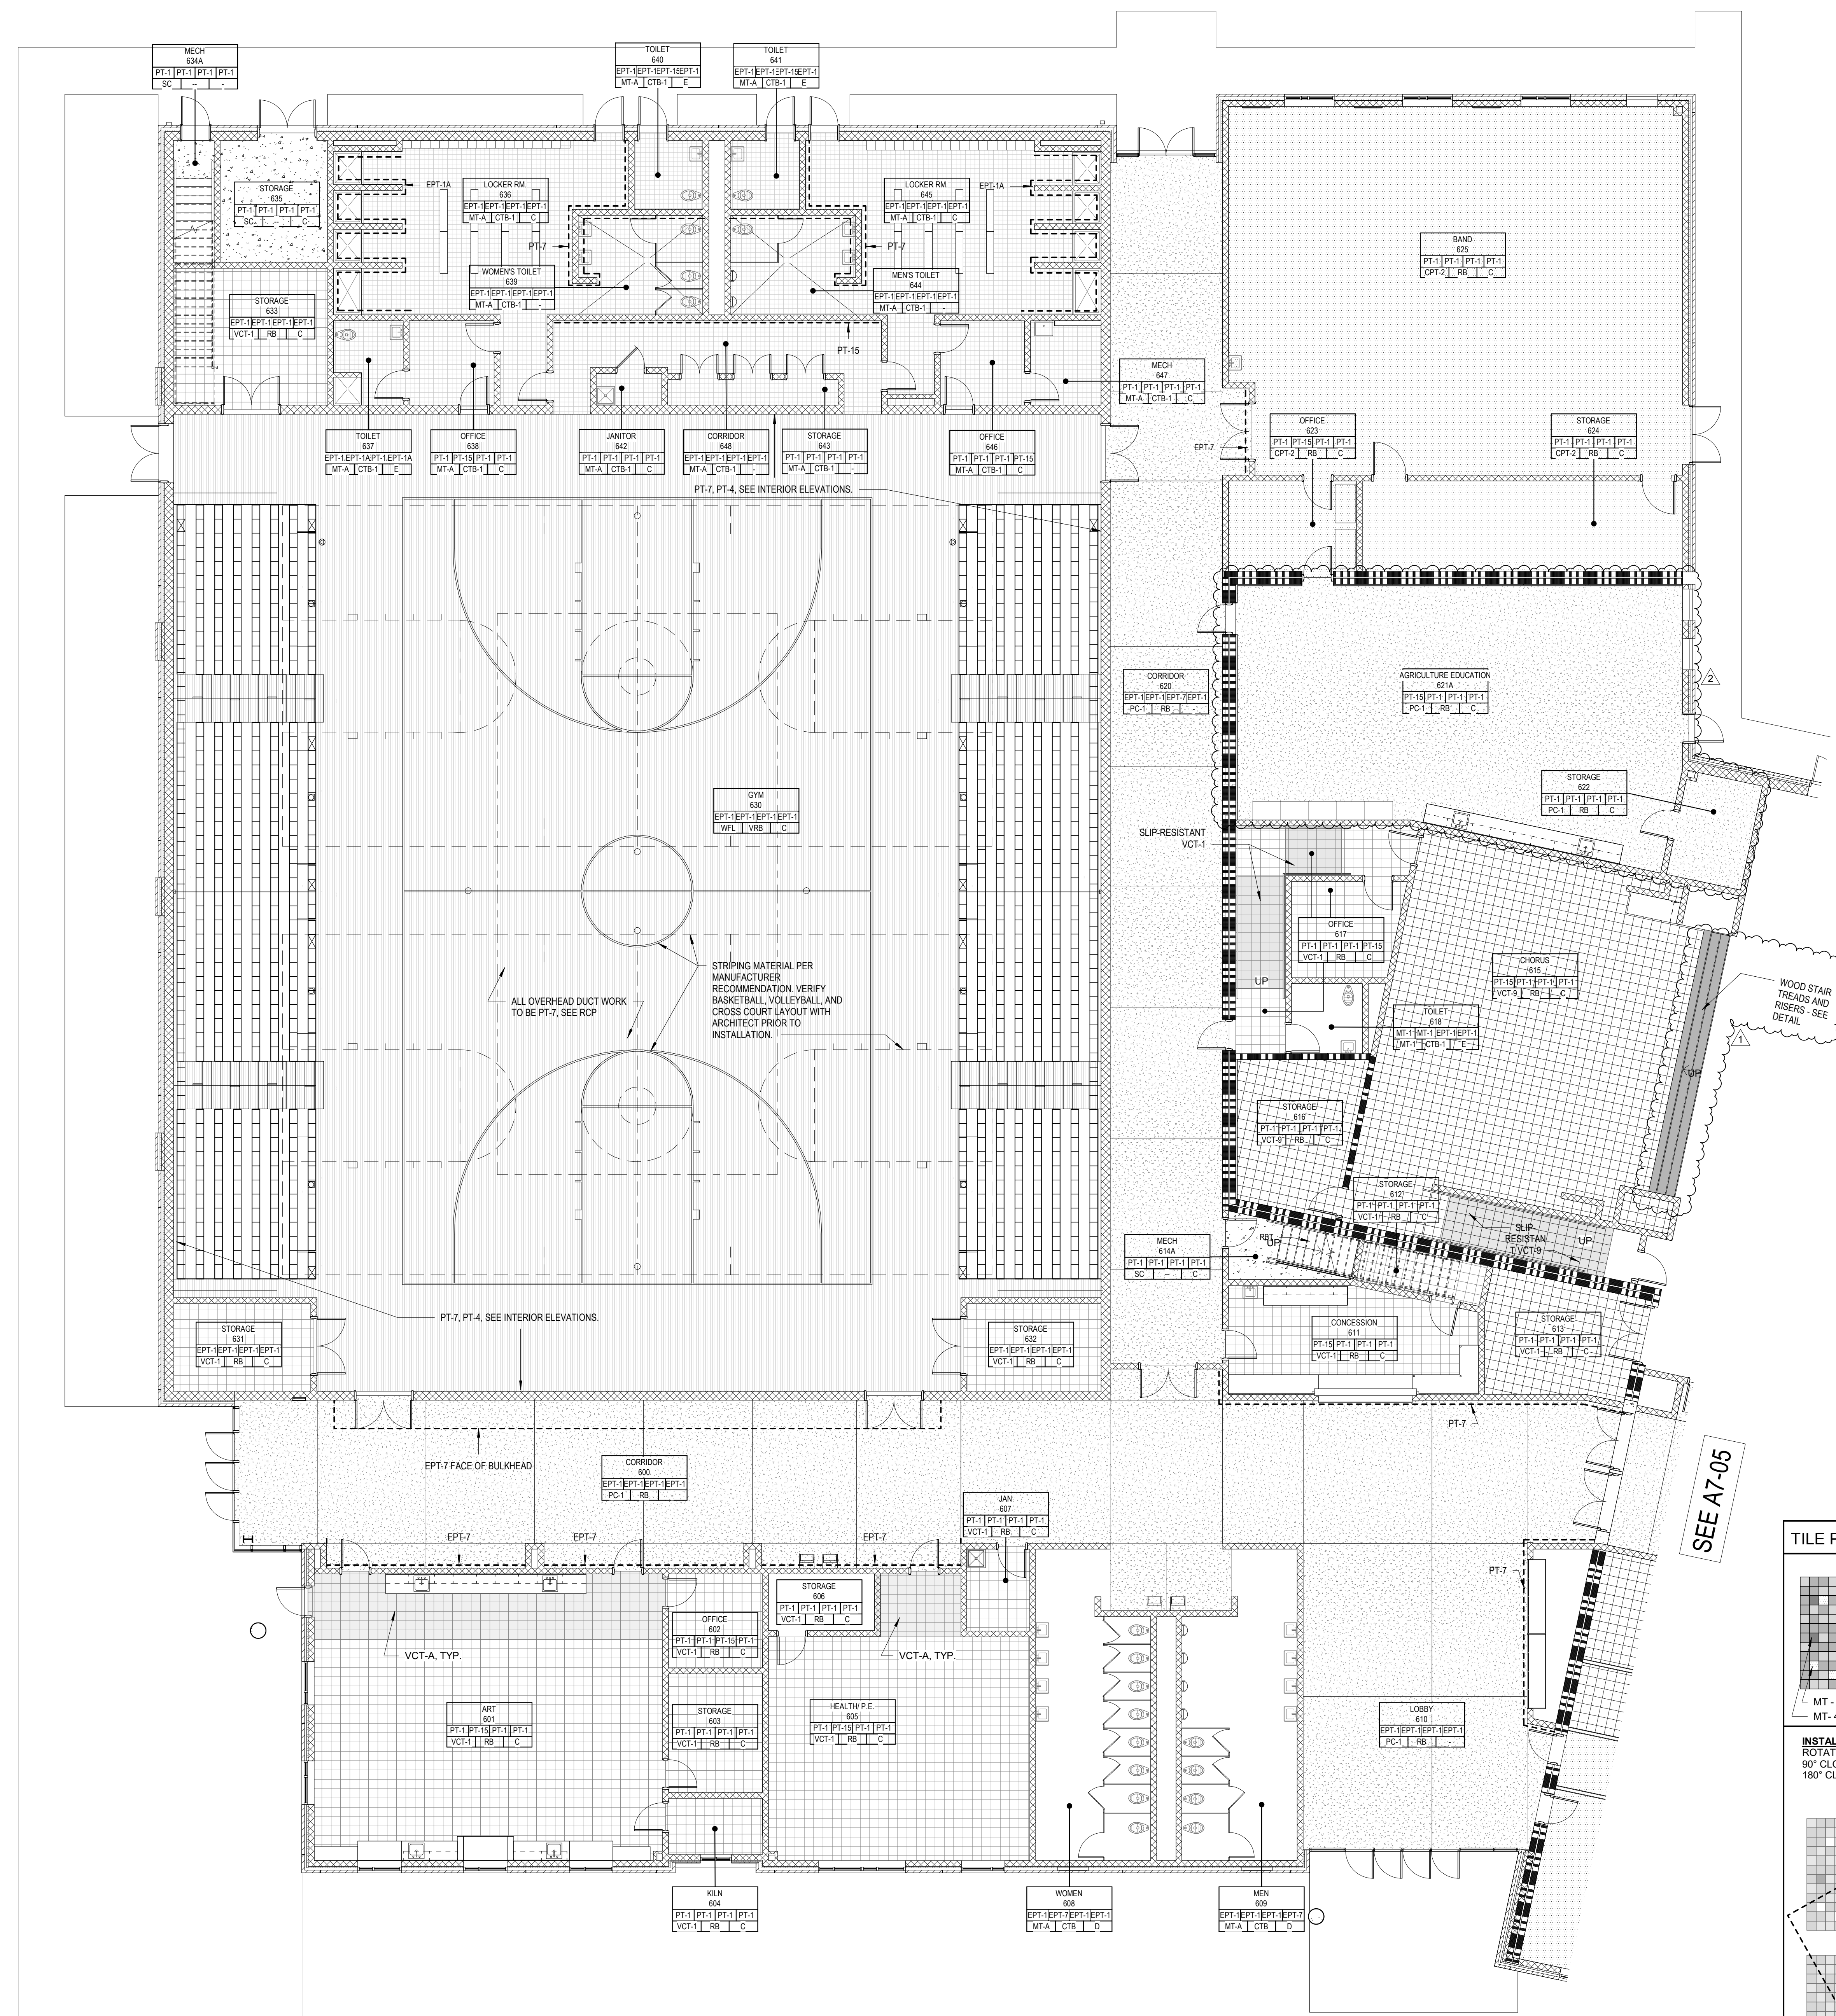


1 600 WING - FIRST FLOOR (FINISH)
A7-07 1/8" = 1'-0"

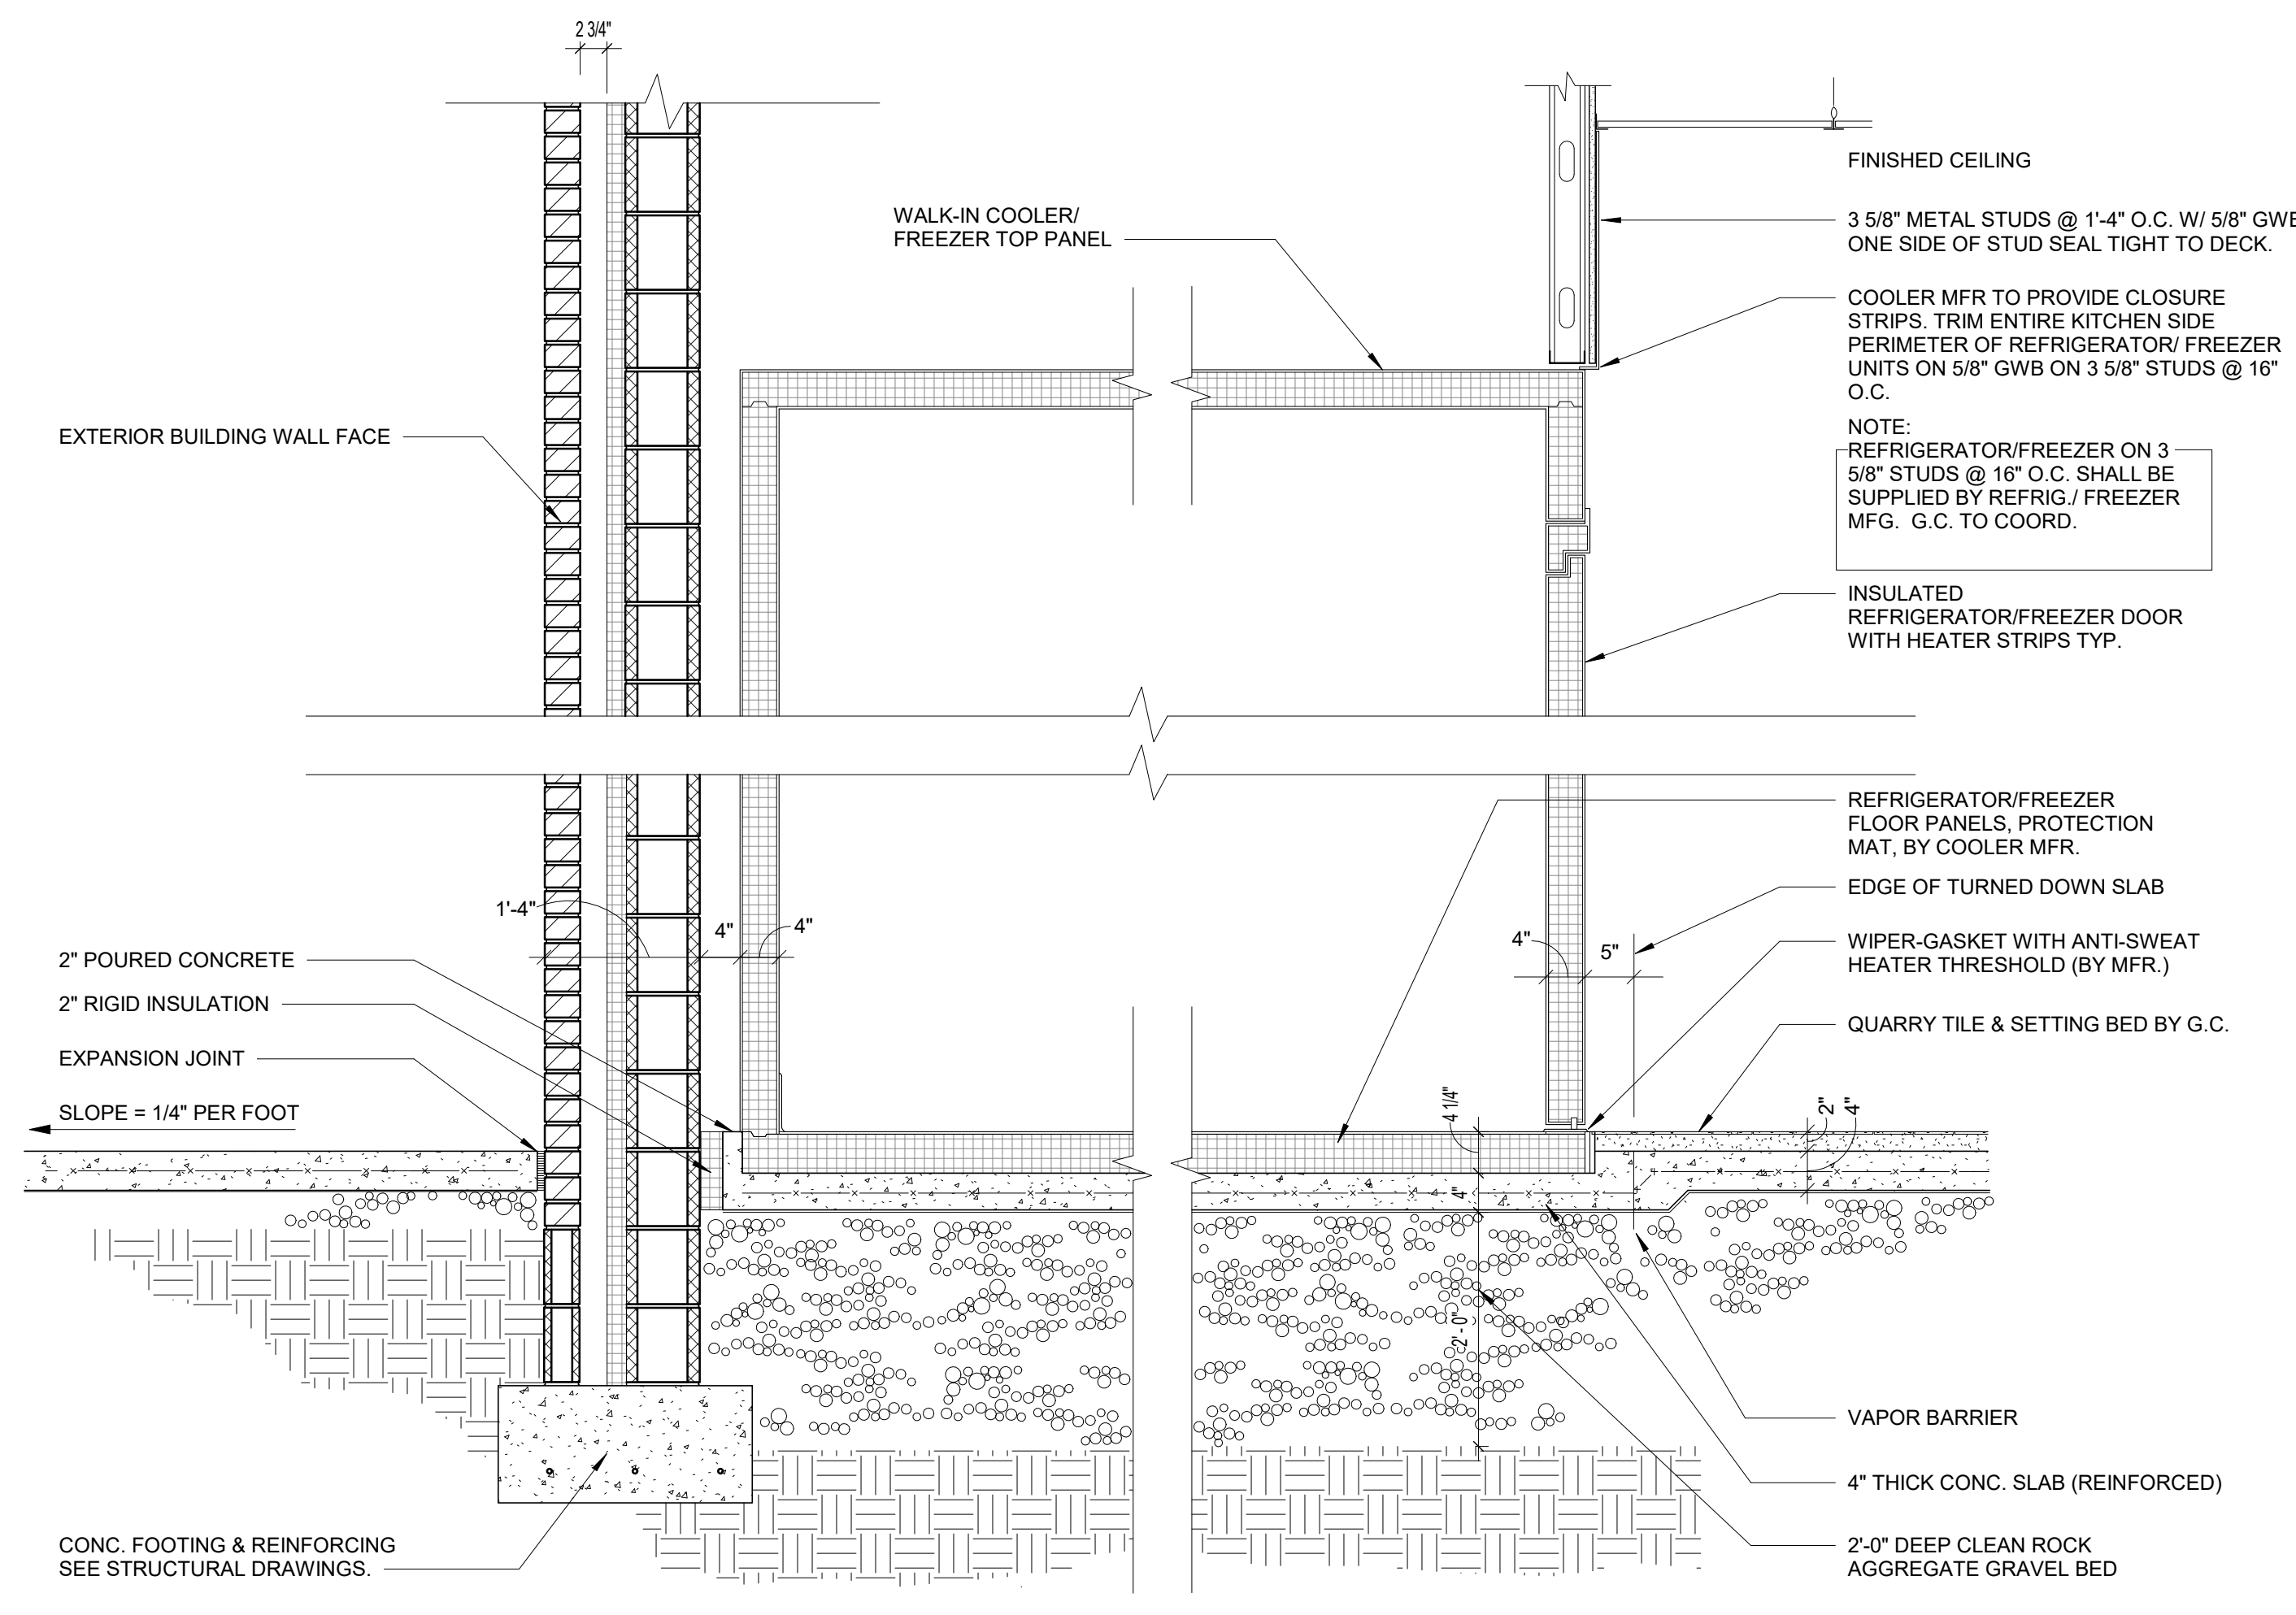


13 SECTION AT WALK-IN FREEZER/COOLER
A7-30 3/4" = 1'-0"

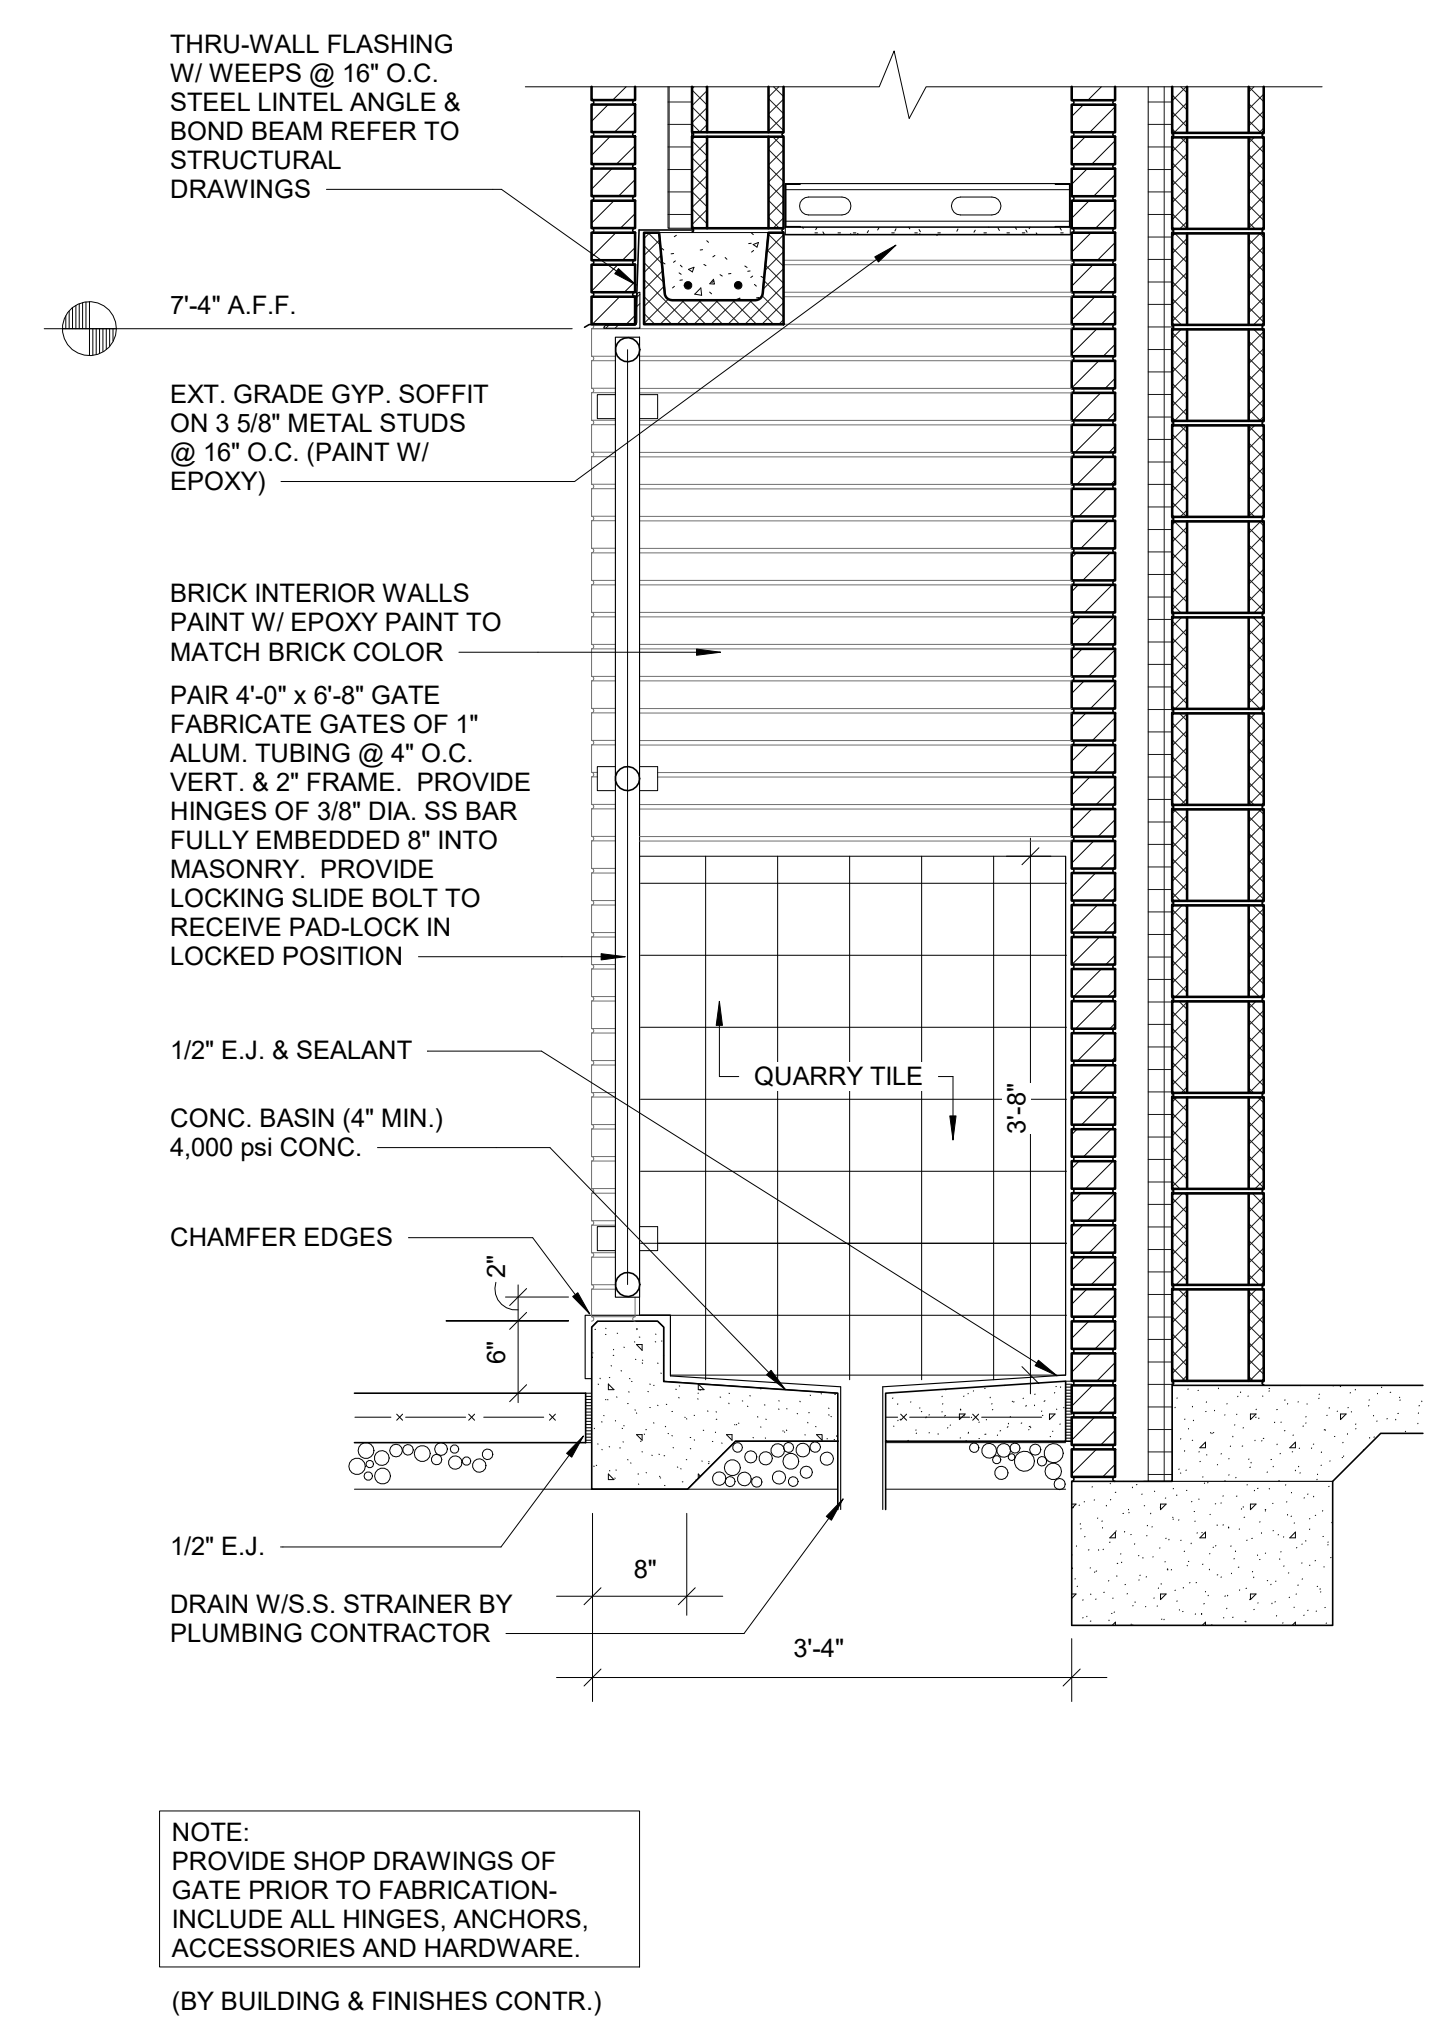


12 SECTION @ CAN WASH
A7-30 3/4" = 1'-0"

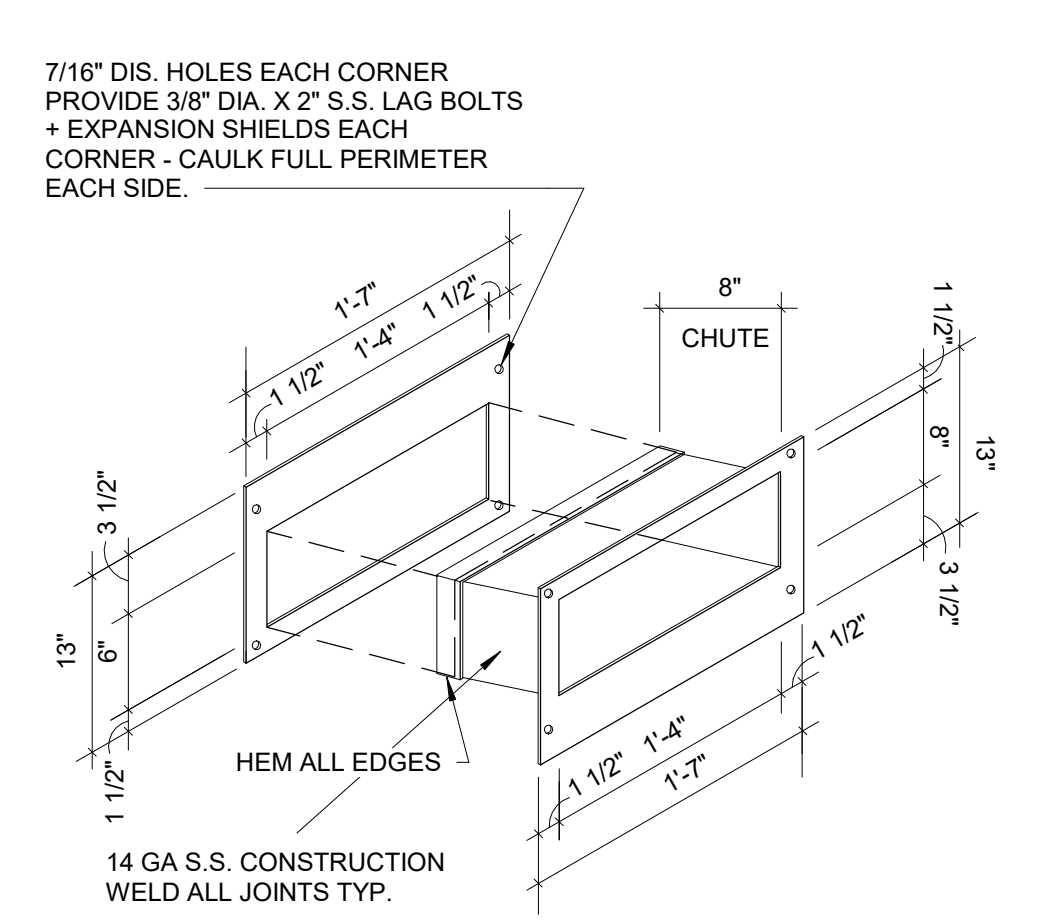


11 SILVERWARE DEPOSIT CHUTE
A7-30 1" = 1'-0"

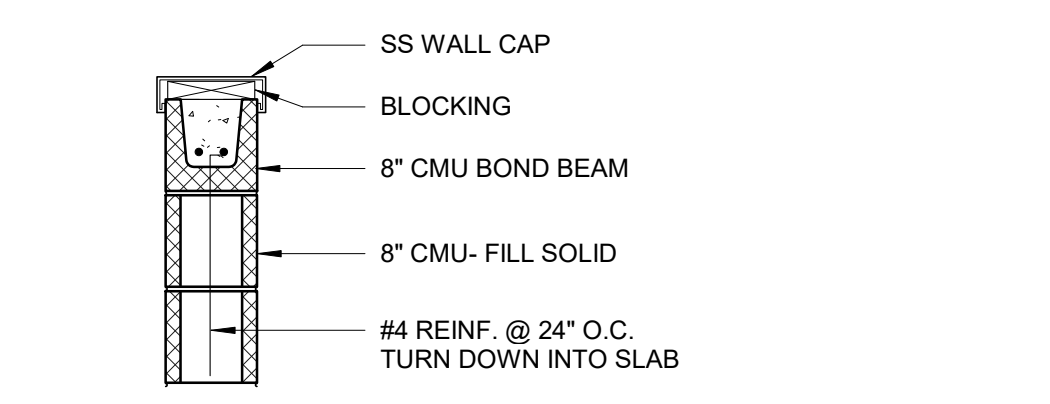


10 SS WALL CAP
A7-30 3/4" = 1'-0"

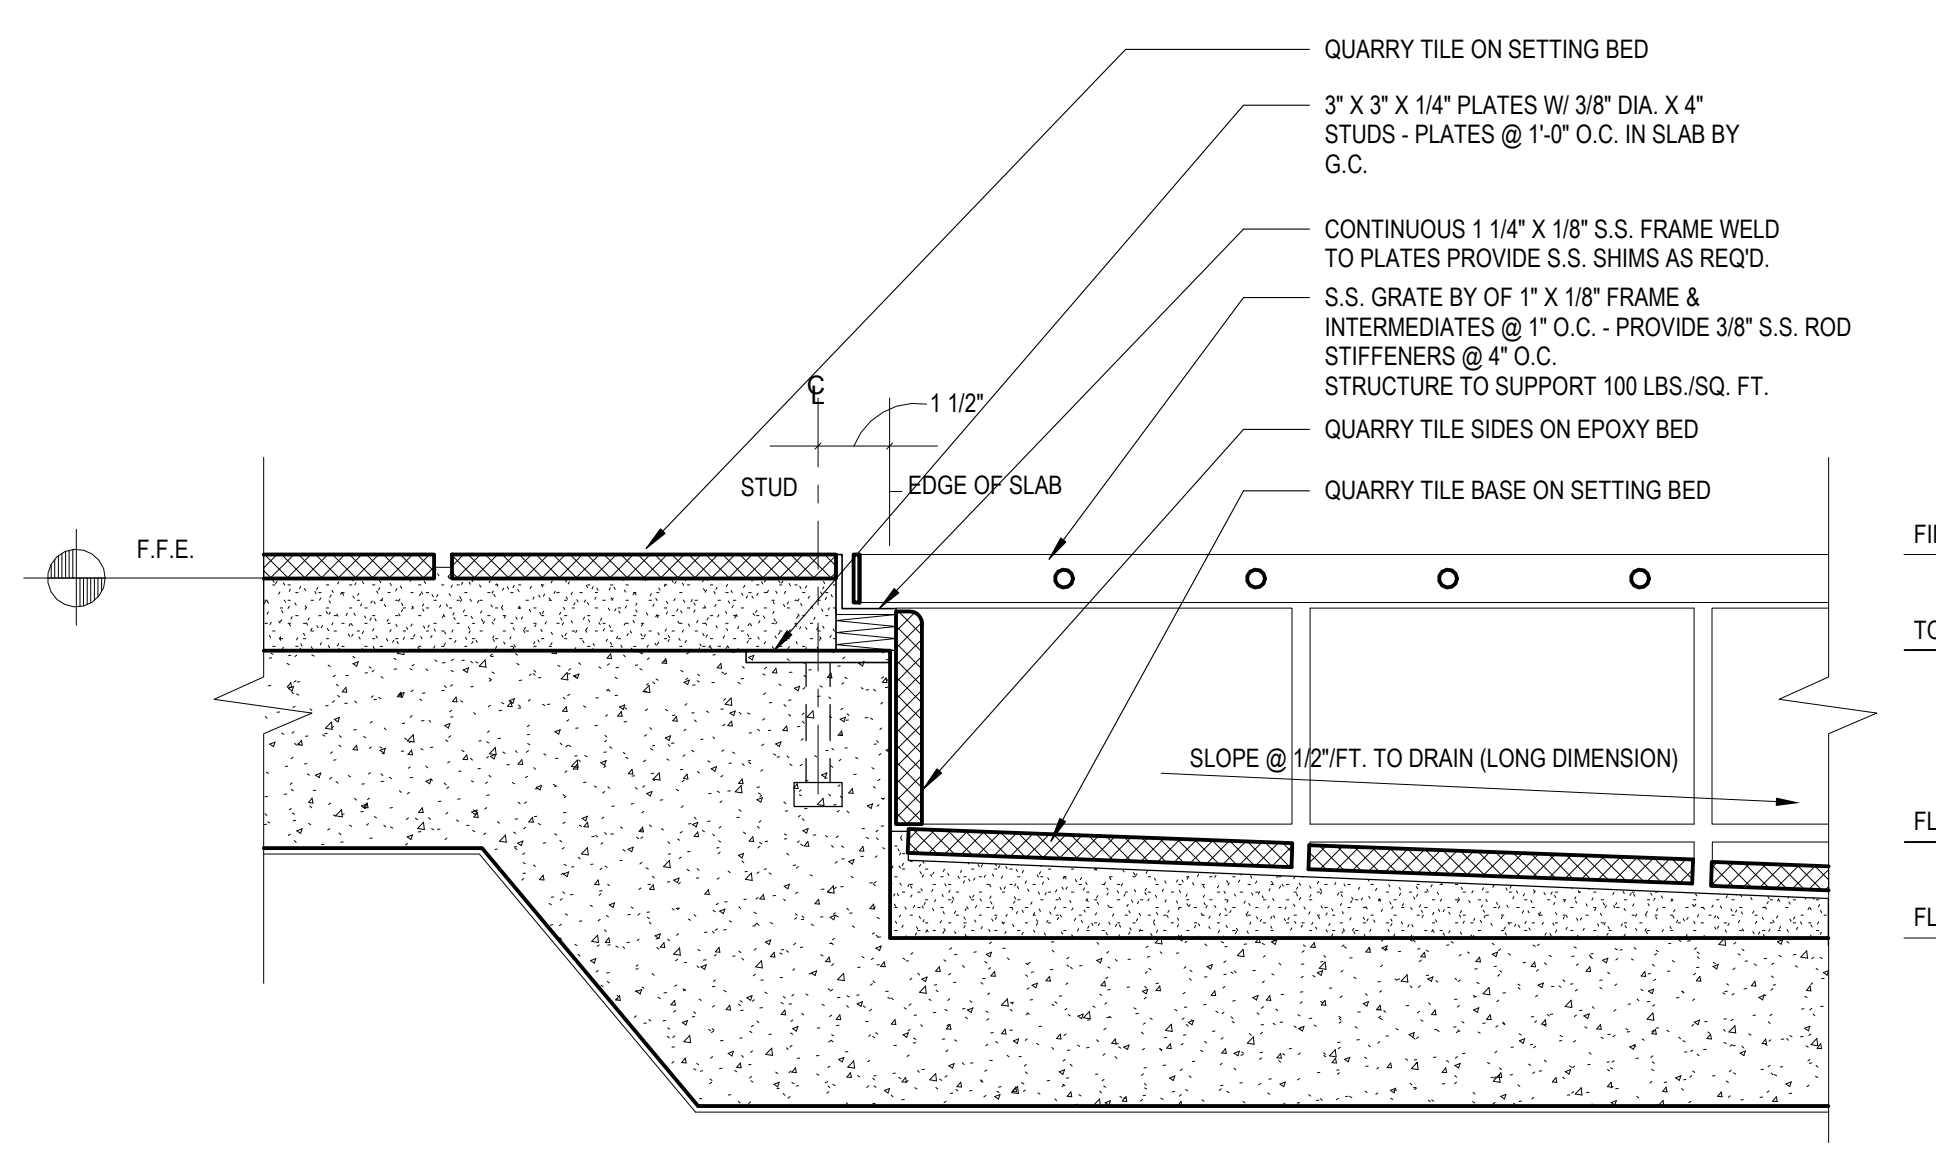


8 K-106 DETAIL AT TRENCH DRAIN
A7-30 3" = 1'-0"

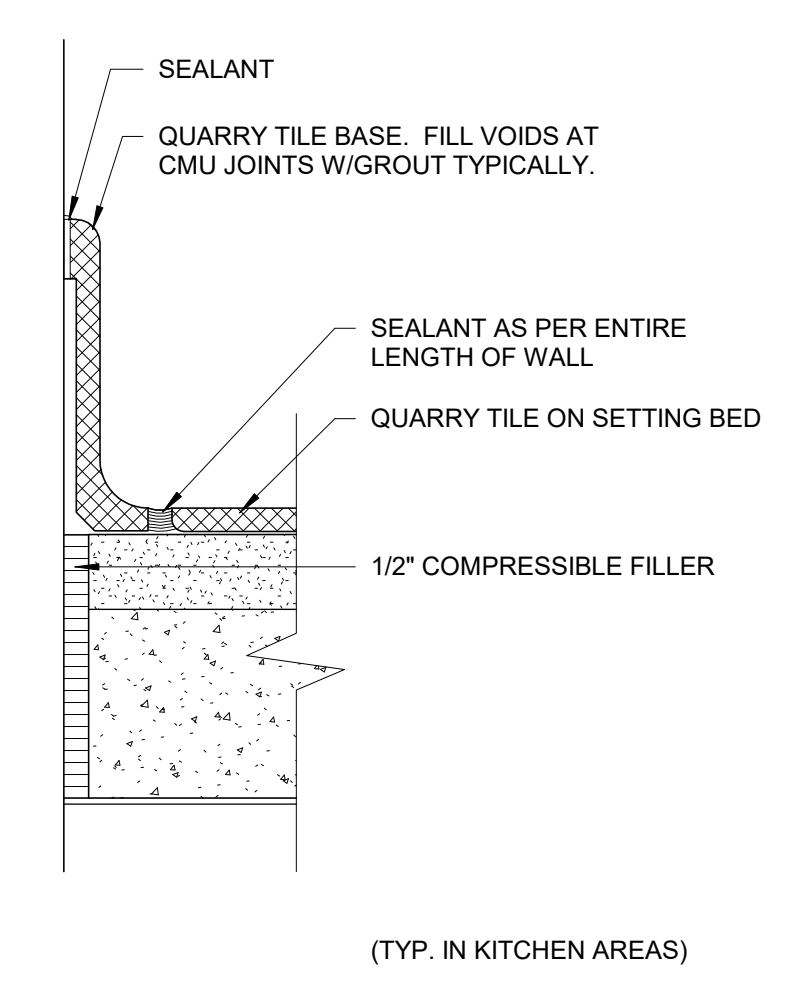


7 Q.T. BASE DETAIL
A7-30 3" = 1'-0"

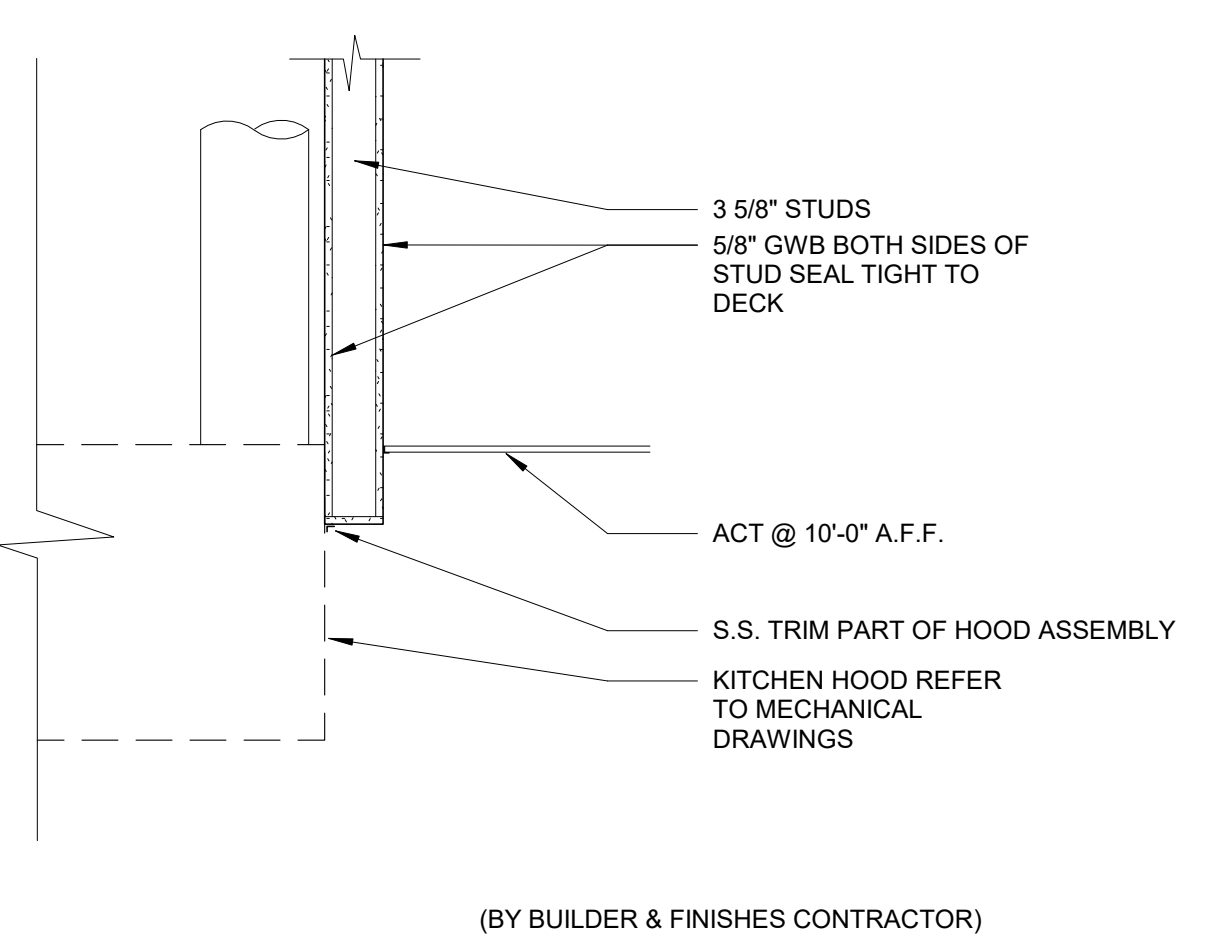


6 SECTION @ HOOD - ITEM #34
A7-30 3/4" = 1'-0"

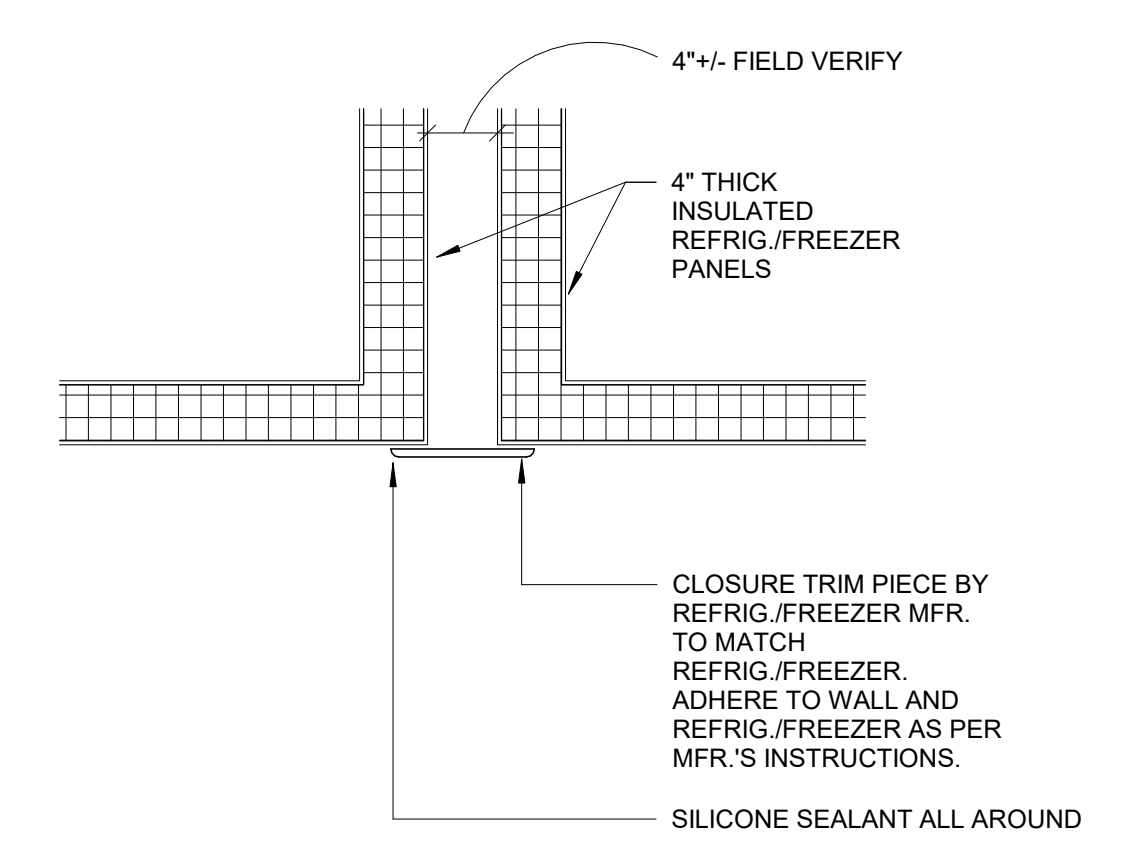


5 CLOSURE DETAIL
A7-30 1" = 1'-0"

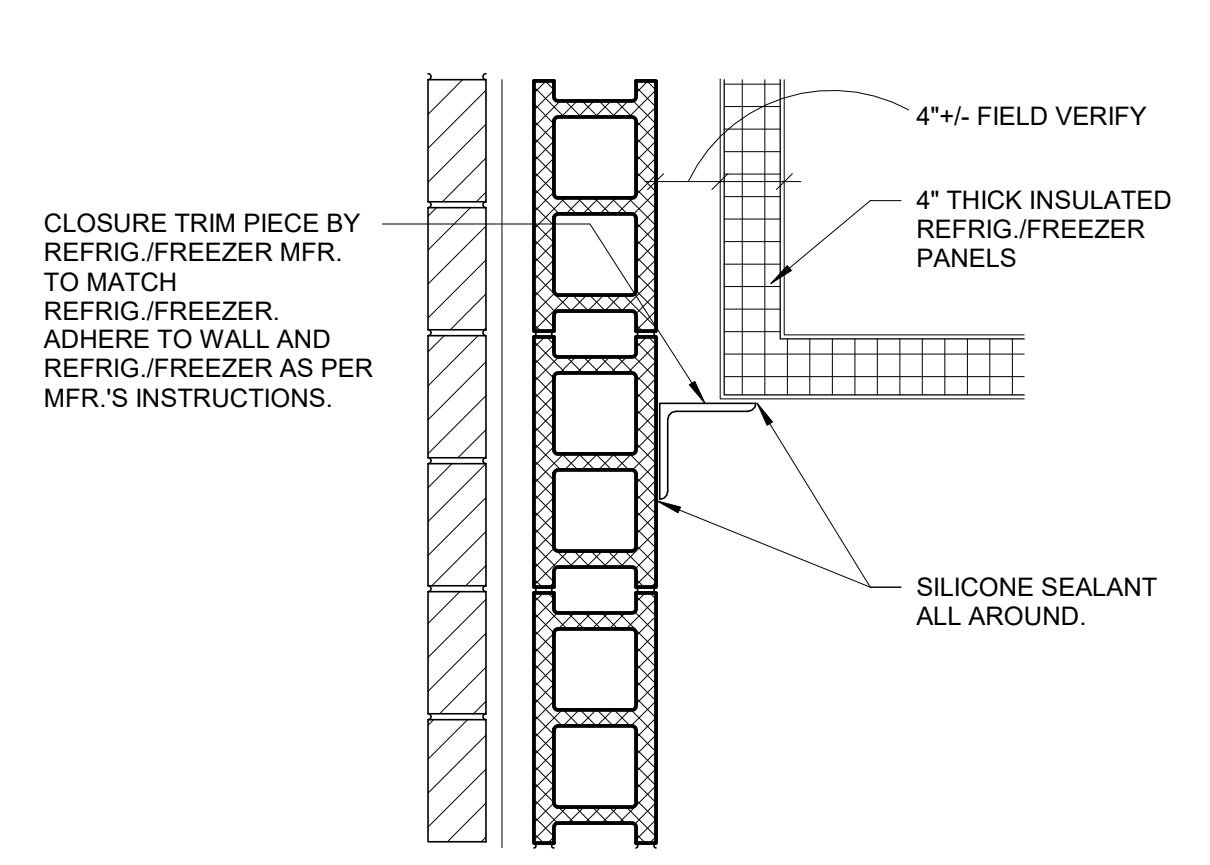


4 CLOSURE DETAIL 2
A7-30 1" = 1'-0"

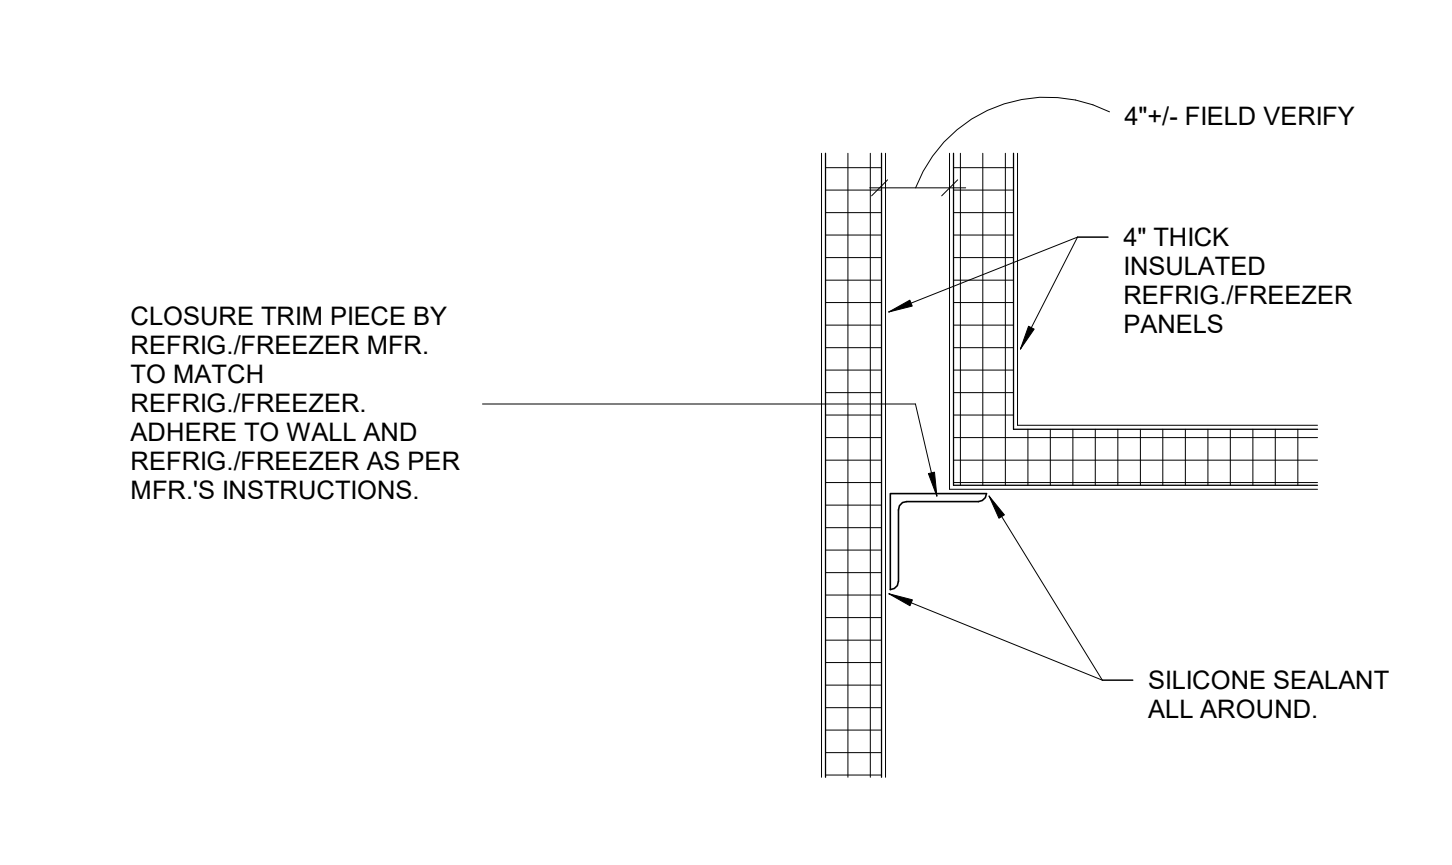

3 CLOSURE DETAIL 3
A7-30 1" = 1'-0"

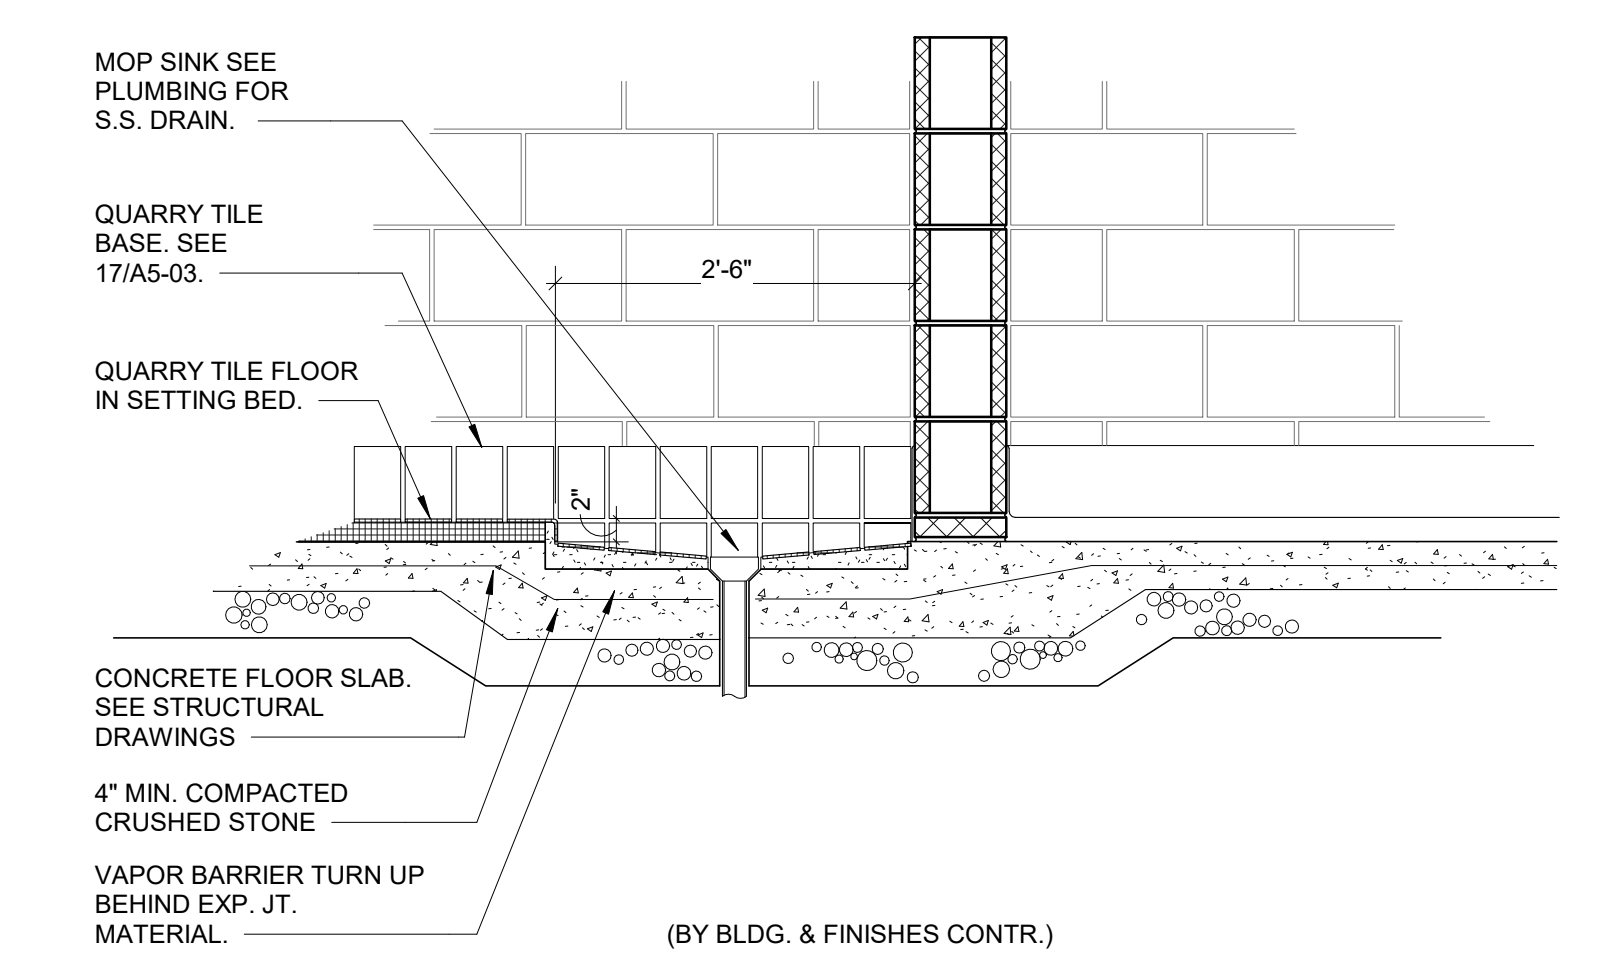

2 MOP SINK DETAIL 2
A7-30 3/4" = 1'-0"

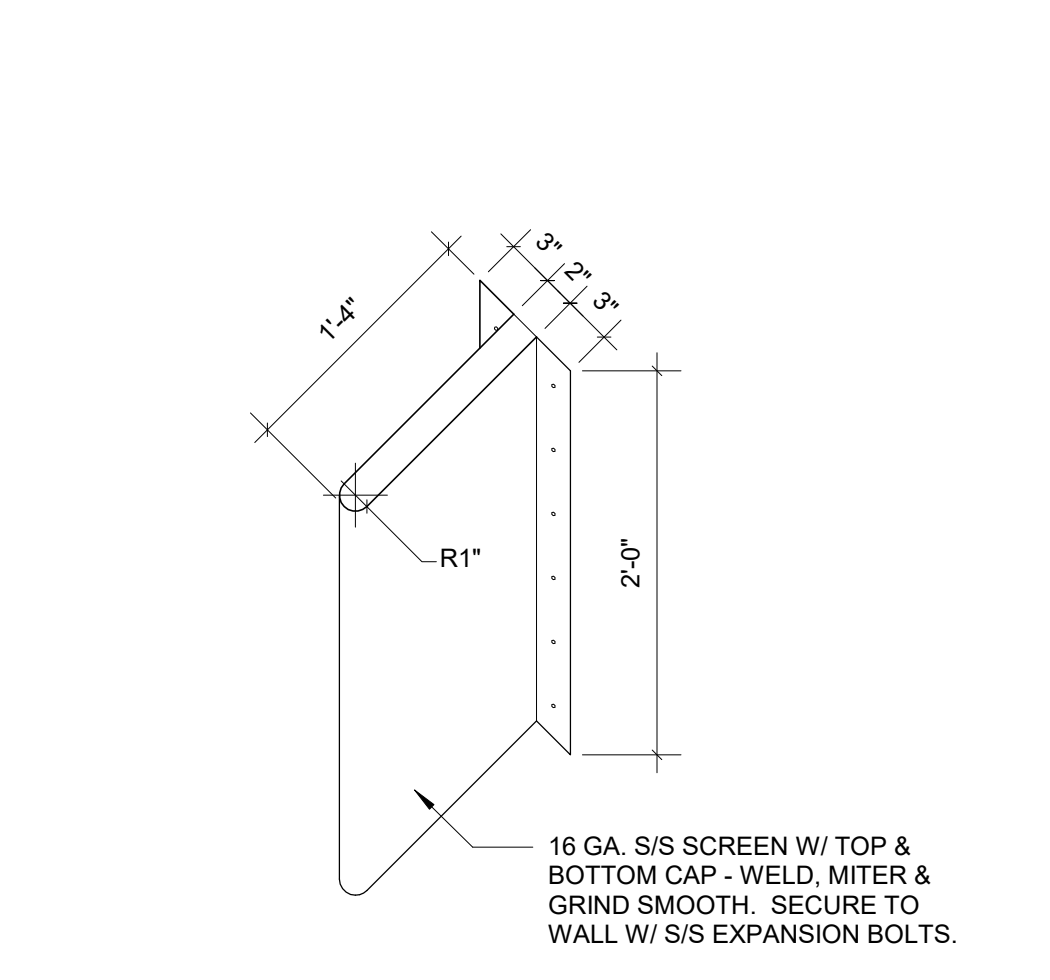

1 SPLASH GUARD
A7-30 1" = 1'-0"

ROOF GENERAL NOTES

- 1 ALL ROOF SADDLES TO SLOPE 1/2" PER FOOT. CRICKETS TO SLOPE 1/4" PER FOOT. DRAWINGS ARE INTENDED TO SHOW DESIGN INTENT. CONTRACTOR SHALL PROVIDE SUBMITTAL DRAWINGS OF TAPERED INSULATION PRIOR TO INSTALL TO ENSURE POSITIVE SLOPE TO DRAINS
- 2 REFER TO PLUMBING DRAWINGS FOR ROOF LEADER TIES AND CIVIL DRAWINGS FOR DRAINAGE AWAY FROM BUILDING
- 3 PROVIDE CRICKET AT ALL ROOF CURBS. SLOPE 1/2" PER FOOT TYP.

ROOF PLAN KEYNOTES

- 1 ROOF ACCESS LADDER - REFER TO DETAIL 2/A5-40
- 2 WALKWAY MAT
- 3 ROOF HATCH - REFER TO DETAIL 6/A5-40
- 4 HOOD - SEE MECH. DWGS. AND ROOF CURB DETAIL 1/A5-40
- 5 PRE-MANUFACTURED, PREFINISHED ALUMINUM CANOPY AND SUPPORT STRUCTURE
- 6 ALUMINUM GUTTER - REFER TO DETAIL 18/A5-40
- 7 PREFINISHED METAL COPING WALL CAP
- 8 THRU-WALL SCUPPER WITH CONDUCTOR BOX AND DOWNSPOUT DRAINING TO ROOF BELOW - PROVIDE SPLASH BLOCK
- 9 NOT USED
- 10 DASHED LINE INDICATES EDGE OF WALL BELOW ROOF OVERHANG
- 11 SMOKE RELIEF VENTS - REFER TO CURB DETAIL 1/A5-40
- 12 SCUPPER AT CANOPY GRAVEL STOP - SEE DETAIL 14/A5-41
- 13 CANOPY TO DRAIN ONLY TO COLUMNS AT DASHED LINE INDICATED - REFER TO PLAN AND DETAILS
- 14 MECH EQUIPMENT - SEE MECH. DWGS. AND ROOF CURB DETAIL 1/A5-40


REFLECTED CEILING LEGEND AND NOTES

CEILING TYPE		CEILING HEIGHT	
SYMBOL	TYPE	DESCRIPTION	
	A	ACT-1, 2x2 CEILING TILE, WHITE FINISH	
	B	ACT-2, 2x2 VINYL COVERED TILE AND GRID, WHITE FINISH, HOLD DOWN CLIPS	
	C	MOISTURE RESISTANT GYP WALLBOARD	
	D	ONE (1) HOUR RATED GYP WALLBOARD CEILING SYSTEM - REFER TO NER-258	
	E	METAL SOFFIT PANEL - PERFORATED	
	F	EXPOSED - STRUCTURE, PLUMBING, DUCTWORK AND METAL DECKING PAINTED WHITE	
	G	EXPOSED - STRUCTURE, PLUMBING, DUCTWORK AND METAL DECKING PAINTED BLACK	
	H	EXPOSED - NO FINISH	
SYMBOL	DESCRIPTION		
	1 X 4 LIGHT FIXTURE		
	2 X 4 LIGHT FIXTURE		
	RETURN AIR GRILLE		
	SUPPLY AIR DIFFUSER		
	EXHAUST DIFFUSER		
	CAN STYLE FIXTURE		
	CEILING ACOUSTICAL DIFFUSER PANEL		
	PENDANT LIGHT		
	DIRECT/INDIRECT LINEAR PENDANT		
	HANGING LIGHT FIXTURE		
	WALL MOUNTED LIGHT		


1. REFER TO PLUMBING, MECHANICAL, AND ELECTRICAL DRAWINGS FOR COMPLETE SCOPE OF CEILING PENETRATIONS AND FIXTURES
2. REFER TO PROJECT SPECIFICATIONS FOR COMPLETE DESCRIPTION OF CEILING MATERIAL

DOOR SCHEDULE ALTERNATES


DOOR			FRAME										
MARK	DOOR SIZE	HEIGHT	THK	MAT	TYPE	LVS	MAT	TYPE	DETAILS	HARDWARE	FIRE RATING	REMARKS	
901	3'-0"	7'-2"	1 3/4"	STL	F	1	HM	HM1	32/A6-04	25/A6-04	2/A6-04	39	
901A	8'-0"	4'-8"	1 3/4"	STL	CCD1	1	STL	STL	32/A6-04	25/A6-04	2/A6-04	88	
902	3'-0"	7'-2"	1 3/4"	STL	F	1	HM	HM1	32/A6-04	25/A6-04	2/A6-04	39	
902A	8'-0"	8'-0"	1 1/2"	STL	G2	1	STL	STL	32/A6-04	25/A6-04	2/A6-04	88	
903	3'-0"	7'-2"	1 3/4"	STL	F	1	HM	HM1	32/A6-04	25/A6-04	2/A6-04	27	
904	3'-0"	7'-2"	1 3/4"	STL	F	1	HM	HM1	32/A6-04	25/A6-04	2/A6-04	27	
905	3'-0"	7'-2"	1 3/4"	STL	F	1	HM	HM1	32/A6-04	25/A6-04	2/A6-04	27	
906	8'-0"	7'-2"	1 3/4"	STL	L	1	HM	HM1	32/A6-04	25/A6-04	2/A6-04	30	
920	3'-0"	7'-2"	1 3/4"	STL	F	1	HM	HM1	32/A6-04	25/A6-04	2/A6-04	39	ALTERNATE
920A	8'-0"	8'-0"	1 1/2"	STL	G2	1	STL	STL	32/A6-04	25/A6-04	2/A6-04	88	ALTERNATE

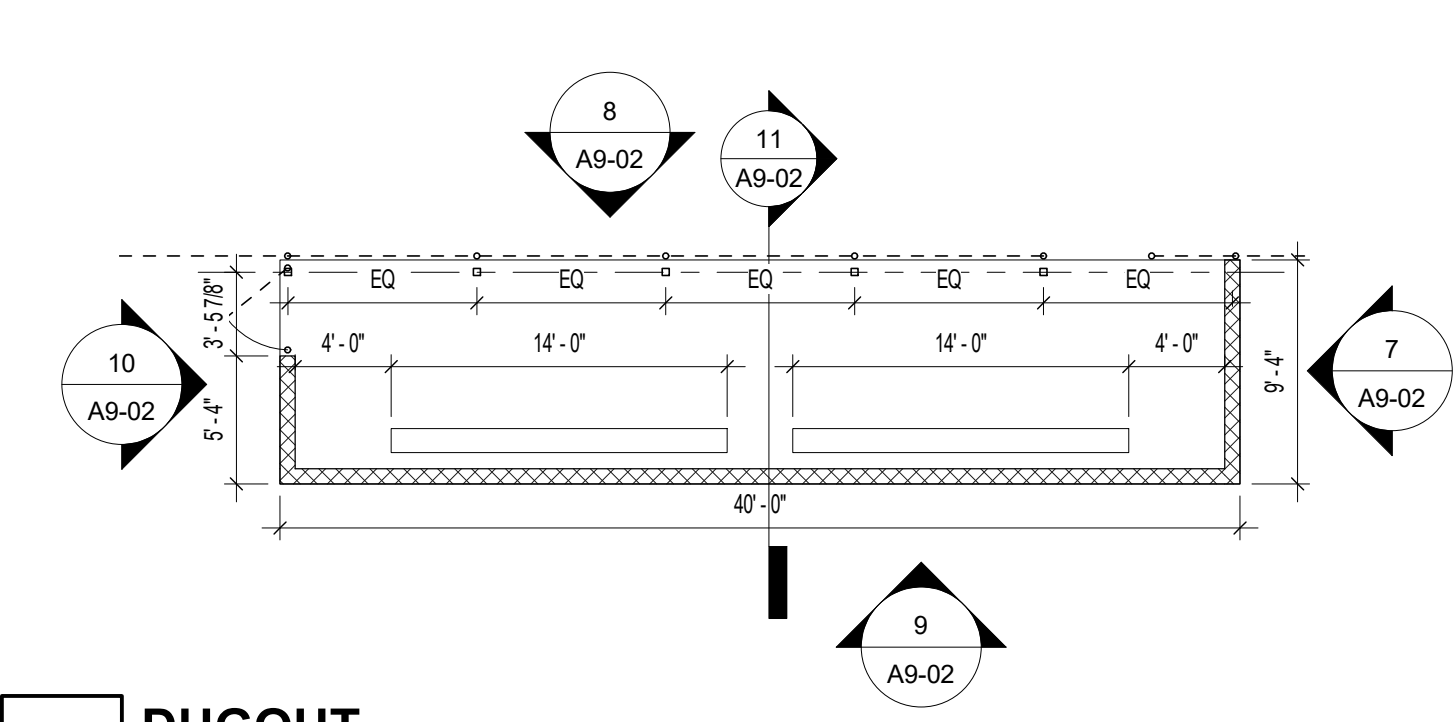


6 DUGOUT
A9-02 1/8" = 1'-0"
**TWO (2) DUGOUTS REQUIRED, MIRRORED. SEE CIVIL DRAWINGS FOR LOCATION

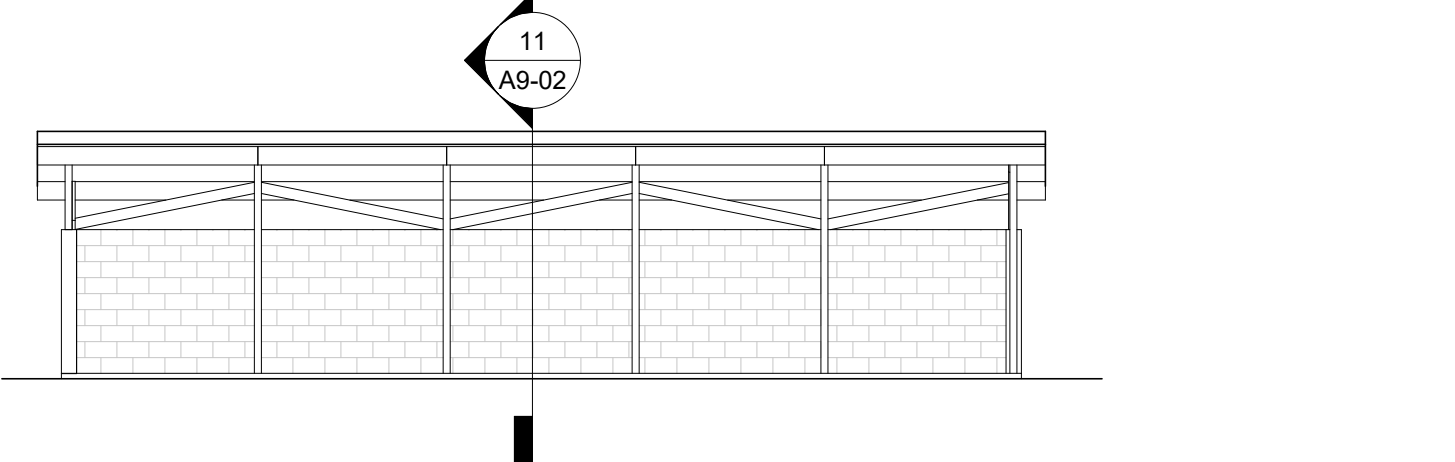


8 DUGOUT NORTH
A9-02 1/8" = 1'-0"

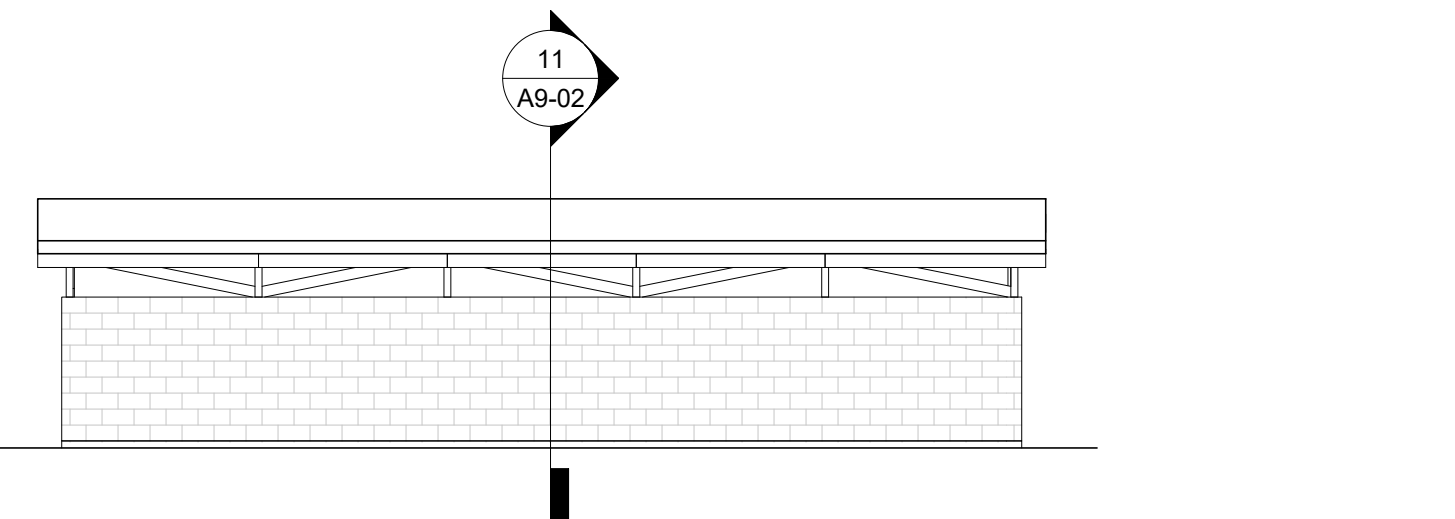


9 DUGOUT SOUTH
A9-02 1/8" = 1'-0"

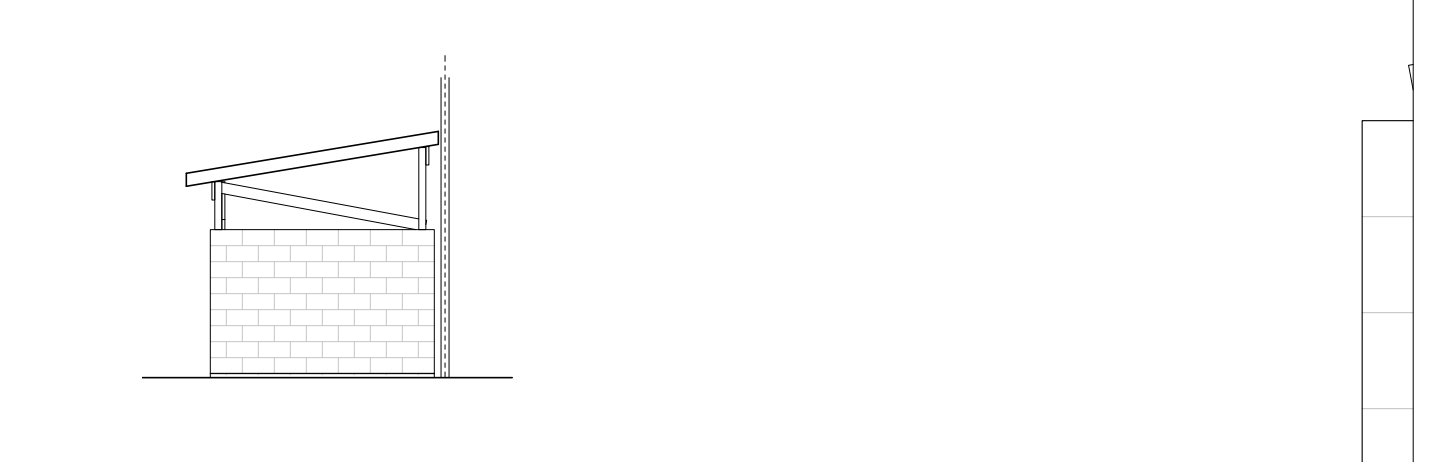


7 DUGOUT EAST
A9-02 1/8" = 1'-0"

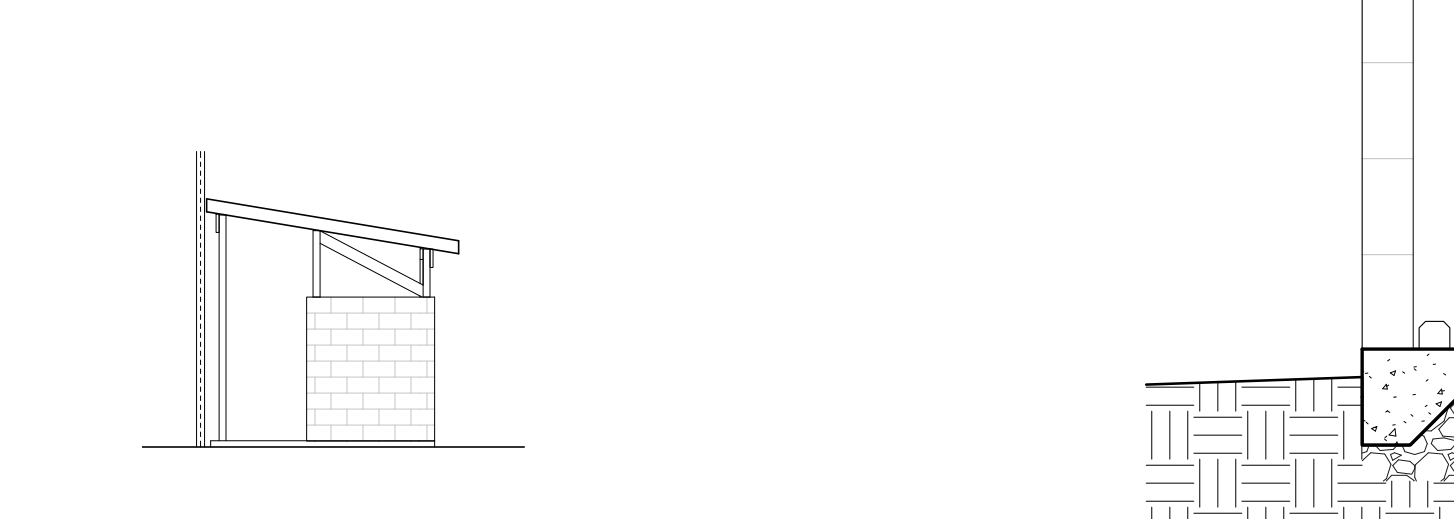


10 DUGOUT WEST
A9-02 1/8" = 1'-0"

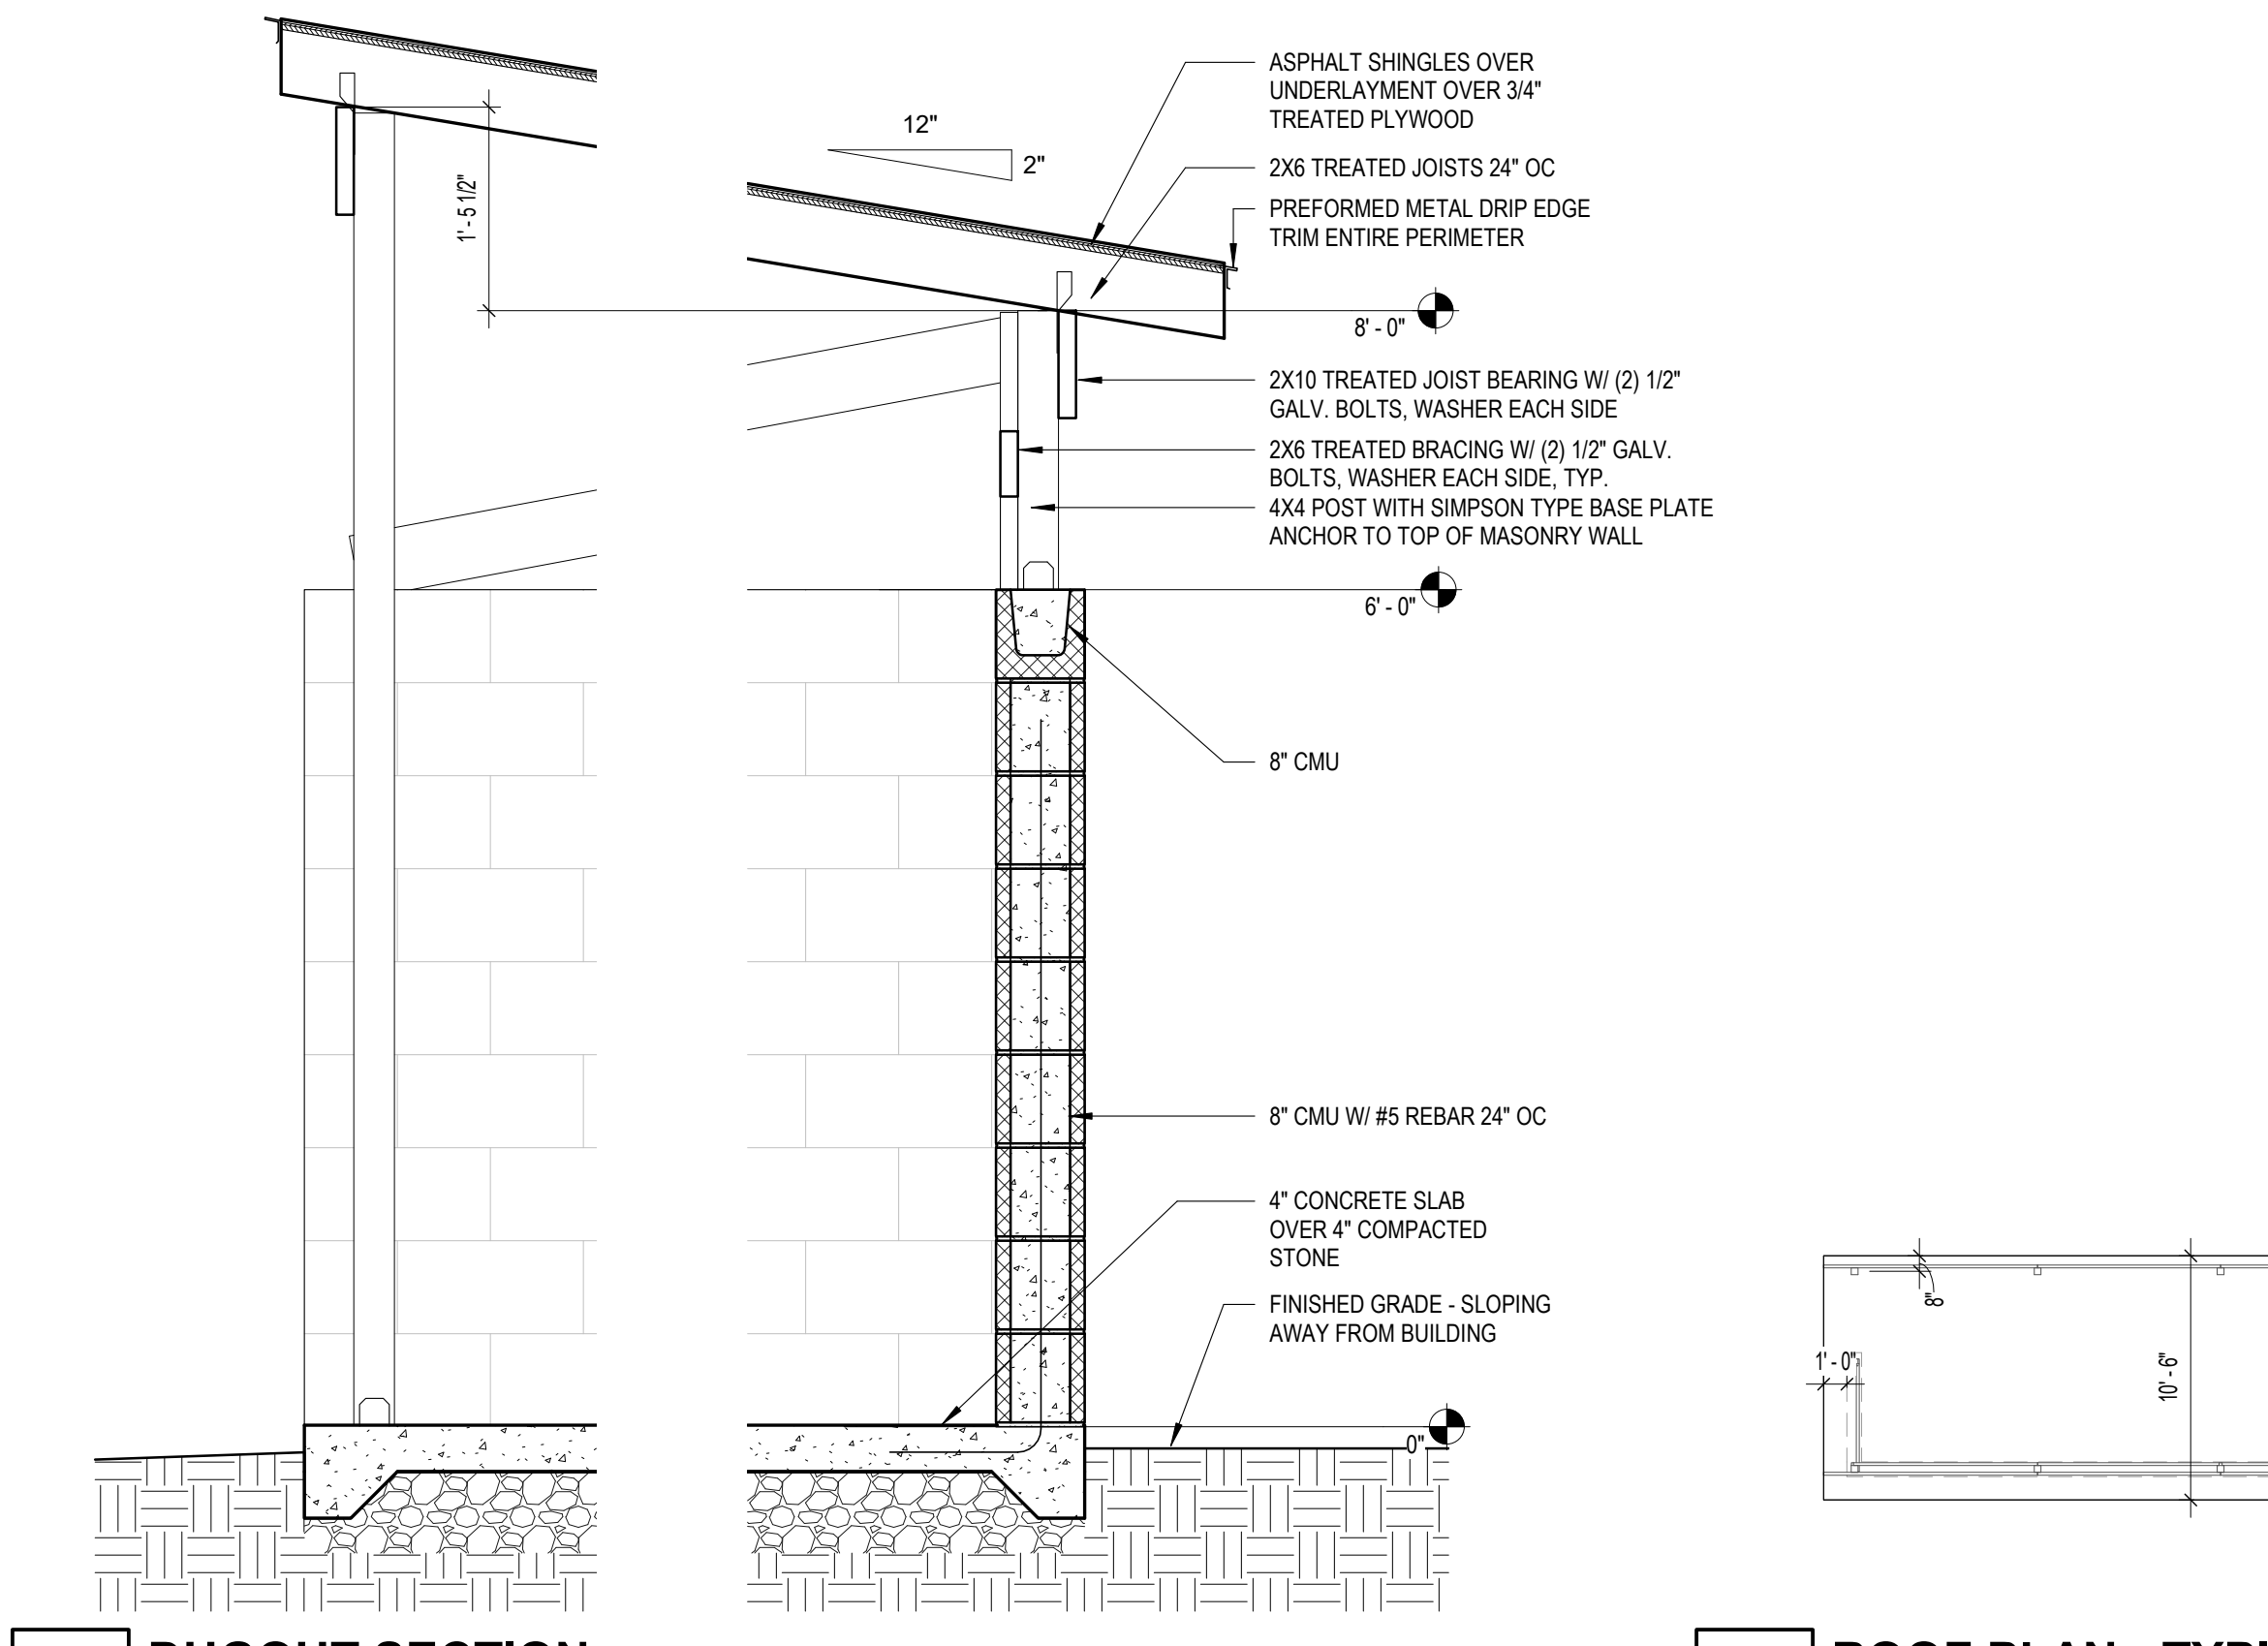


11 DUGOUT SECTION
A9-02 3/4" = 1'-0"

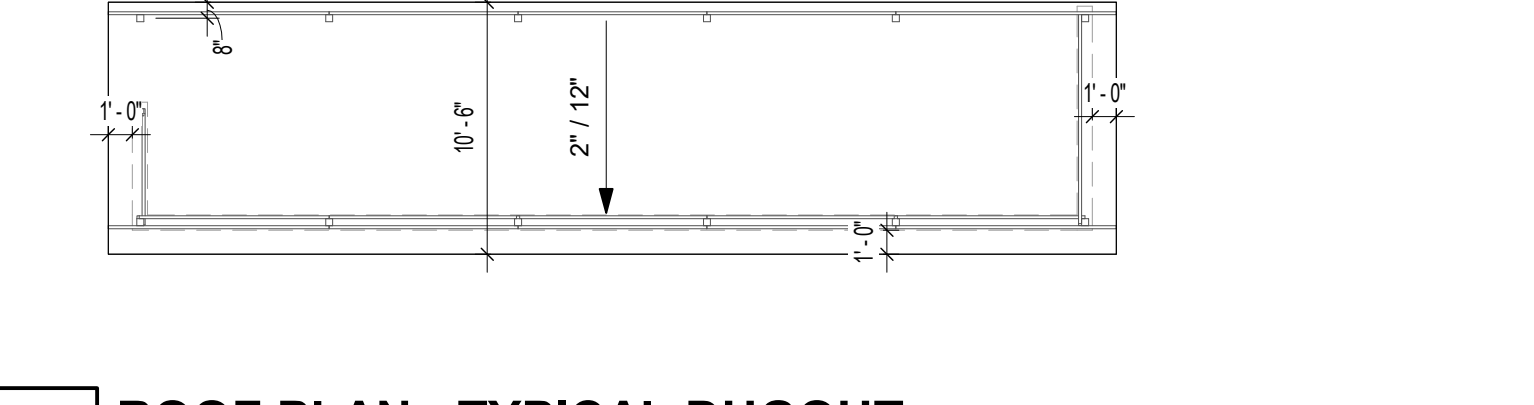


12 ROOF PLAN - TYPICAL DUGOUT
A9-02 1/8" = 1'-0"

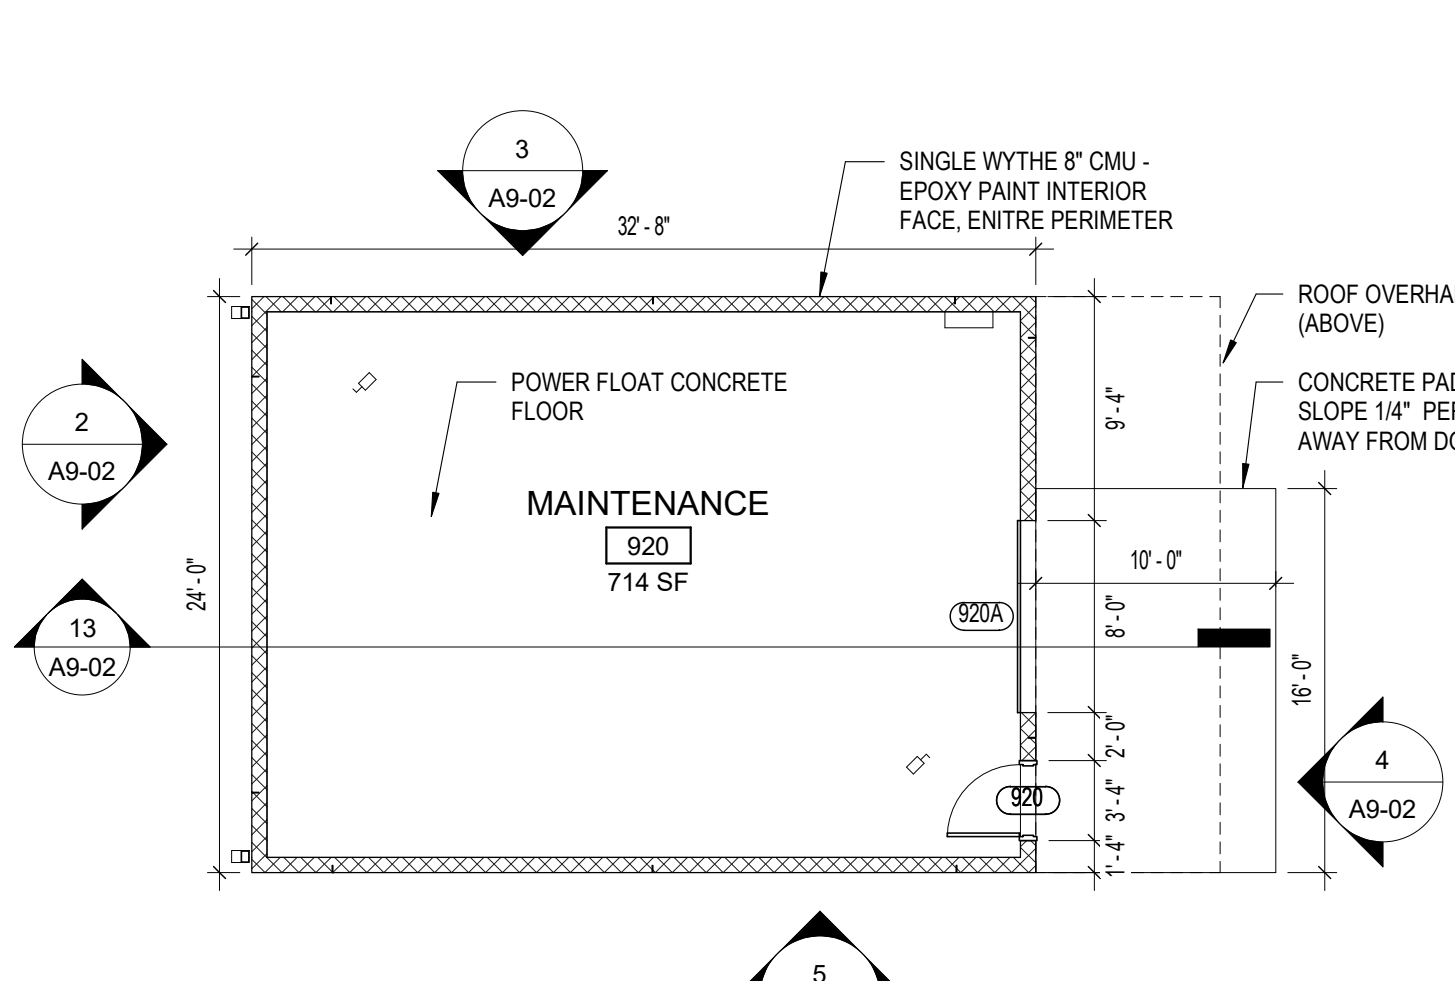


1 MAINTENANCE SHED - ALTERNATE 9
A9-02 1/8" = 1'-0"

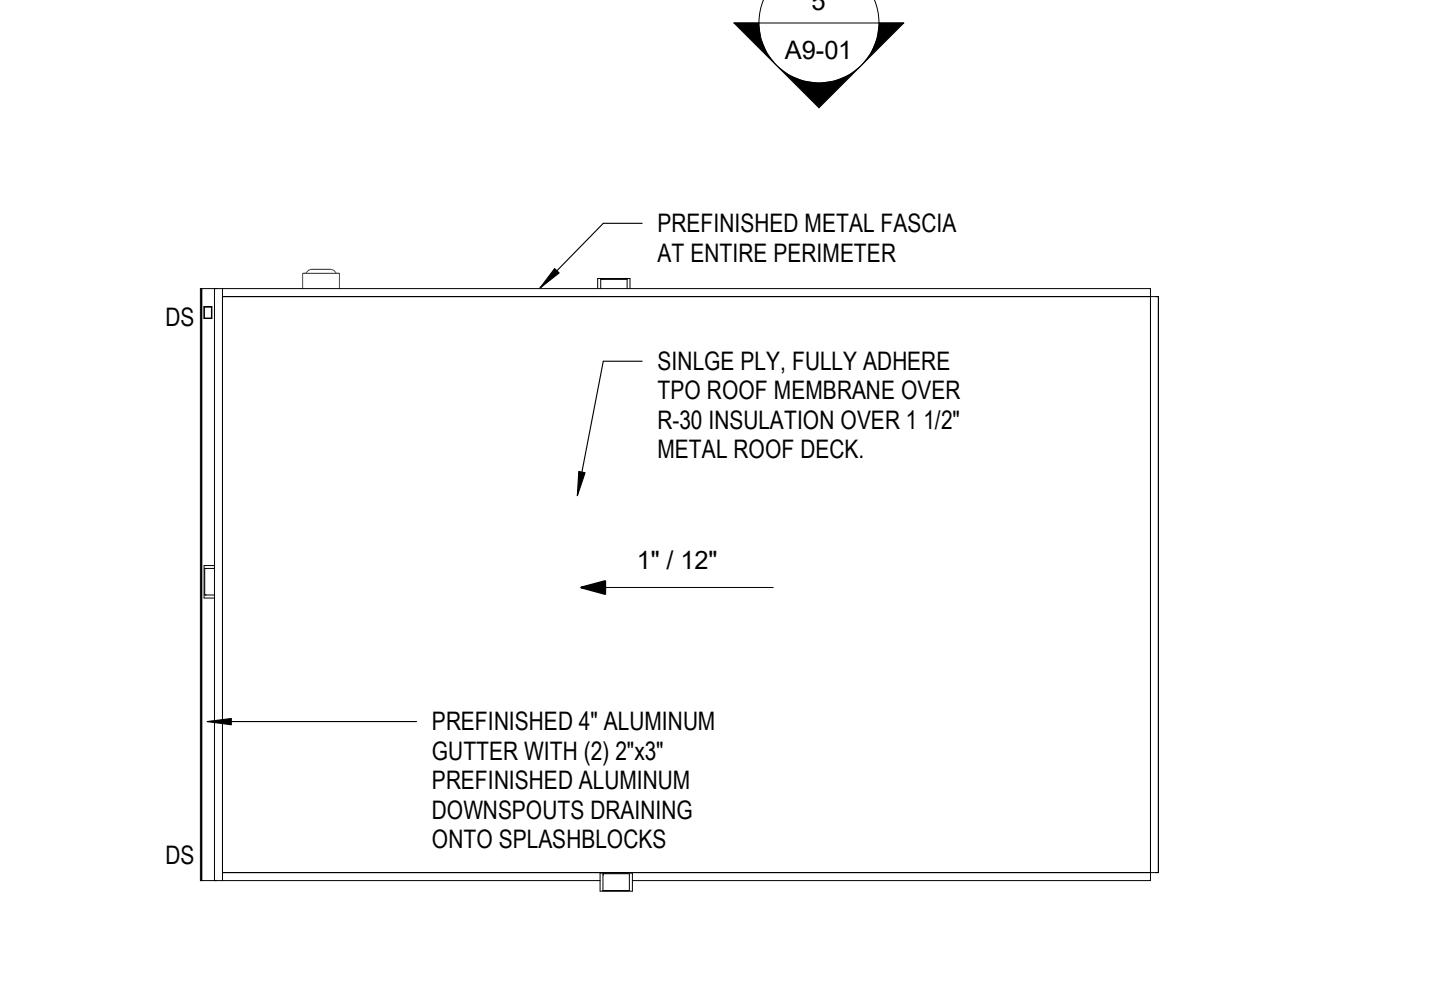


14 ROOF PLAN - MAINTENANCE SHED - ALTERNATE 9
A9-02 1/8" = 1'-0"

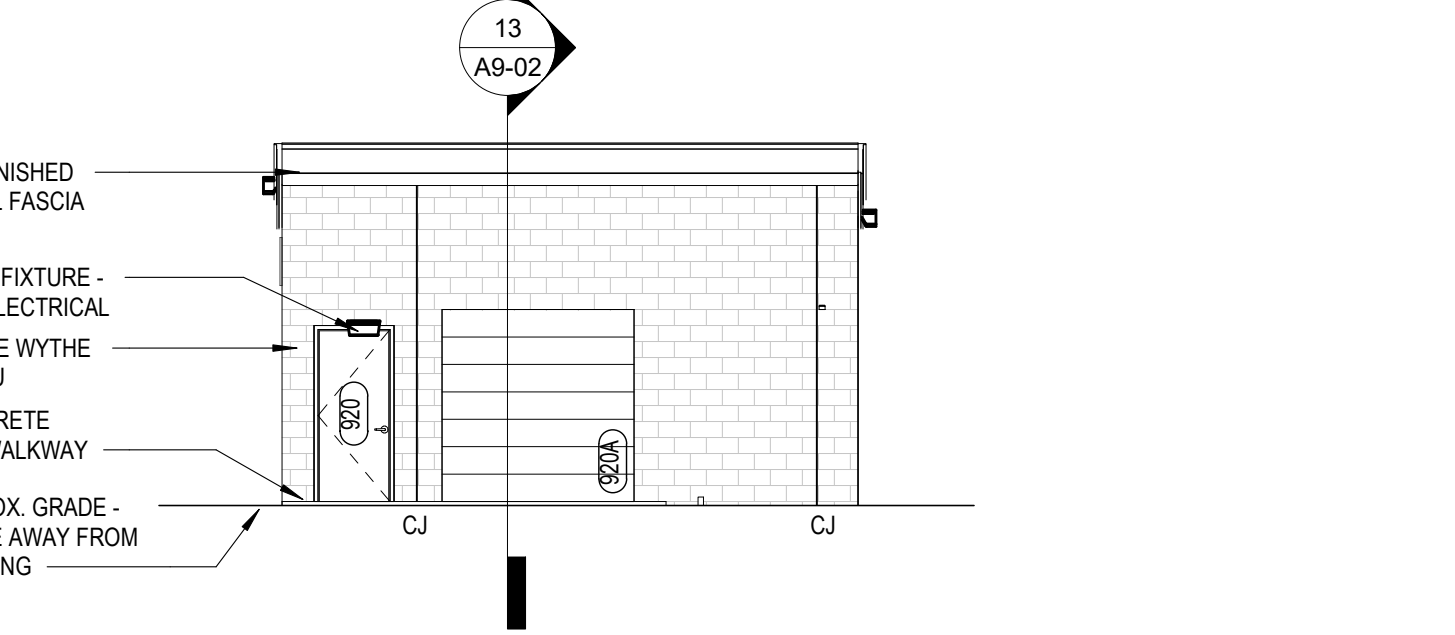


4 MAINTENANCE SHED - EAST
A9-02 1/8" = 1'-0"

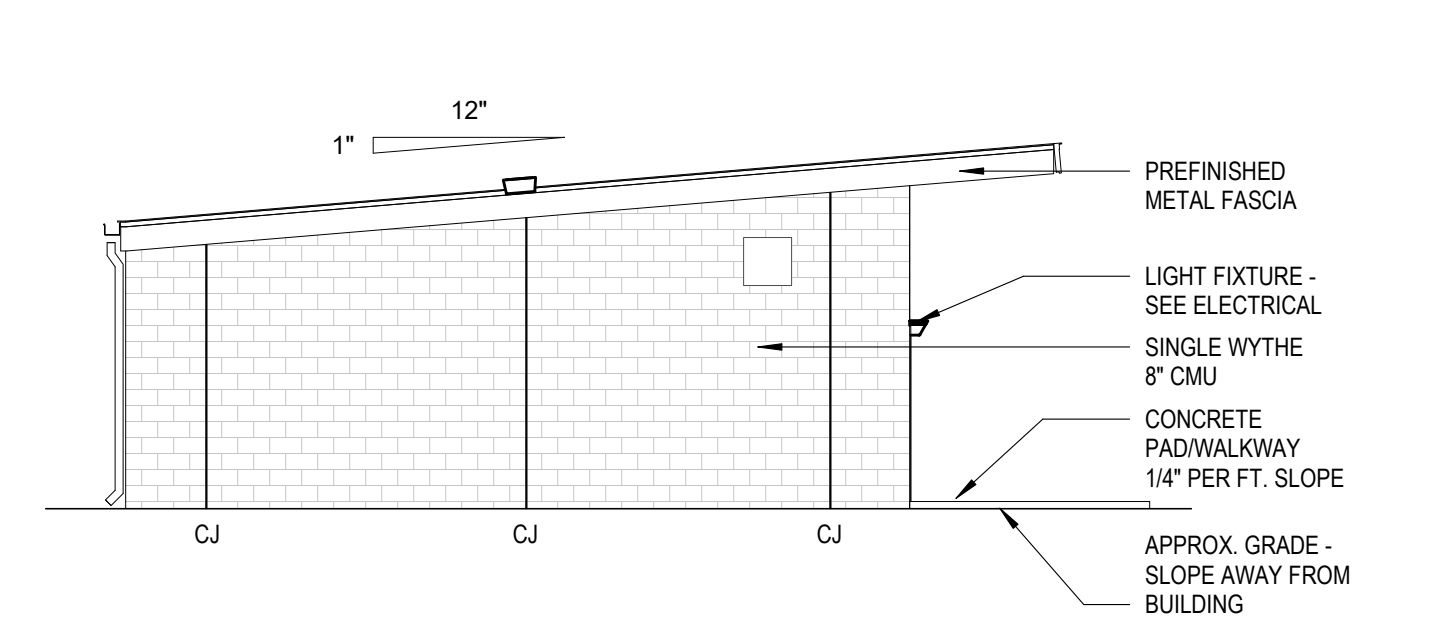


5 MAINTENANCE SHED - SOUTH
A9-02 1/8" = 1'-0"

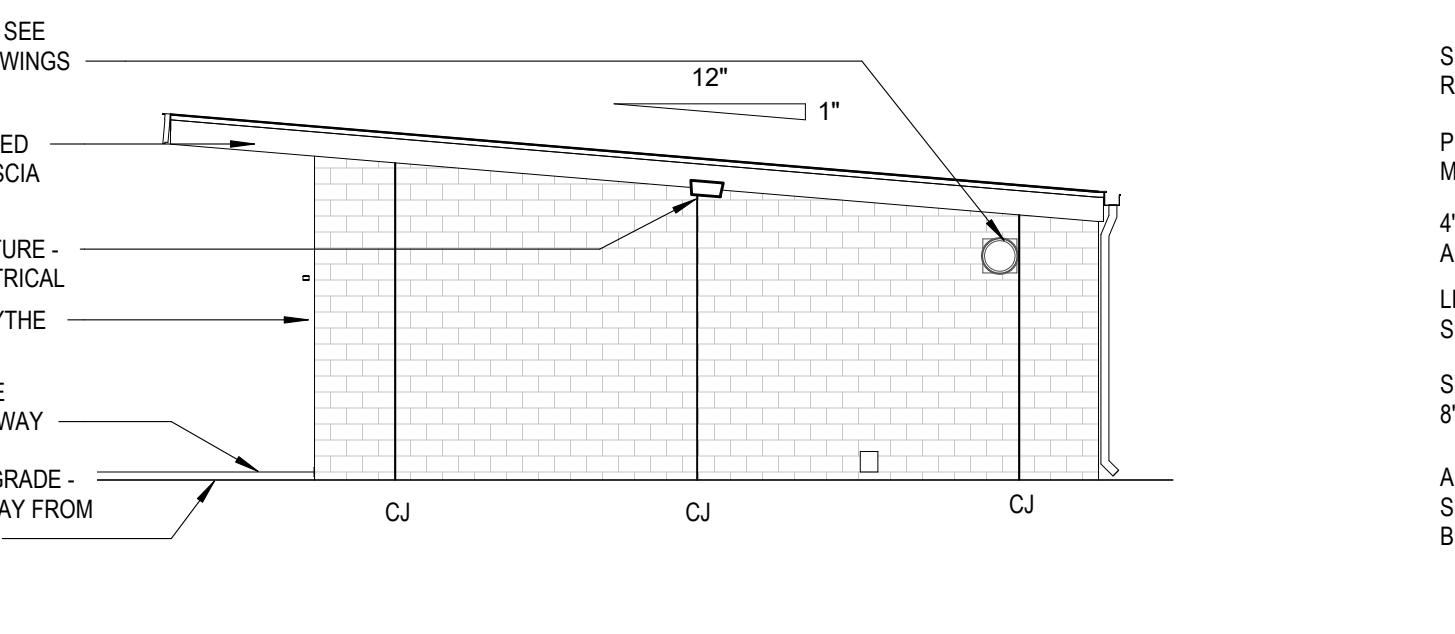


3 MAINTENANCE SHED - NORTH
A9-02 1/8" = 1'-0"

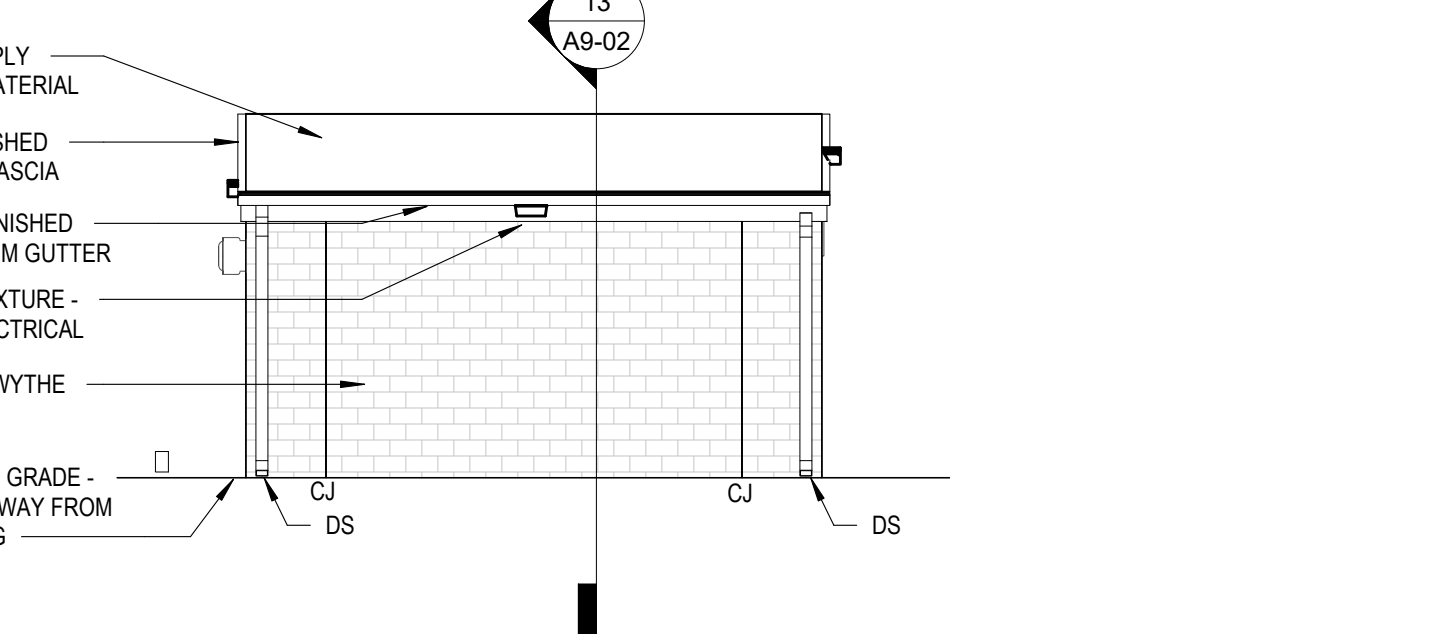

2 MAINTENANCE SHED - WEST
A9-02 1/8" = 1'-0"

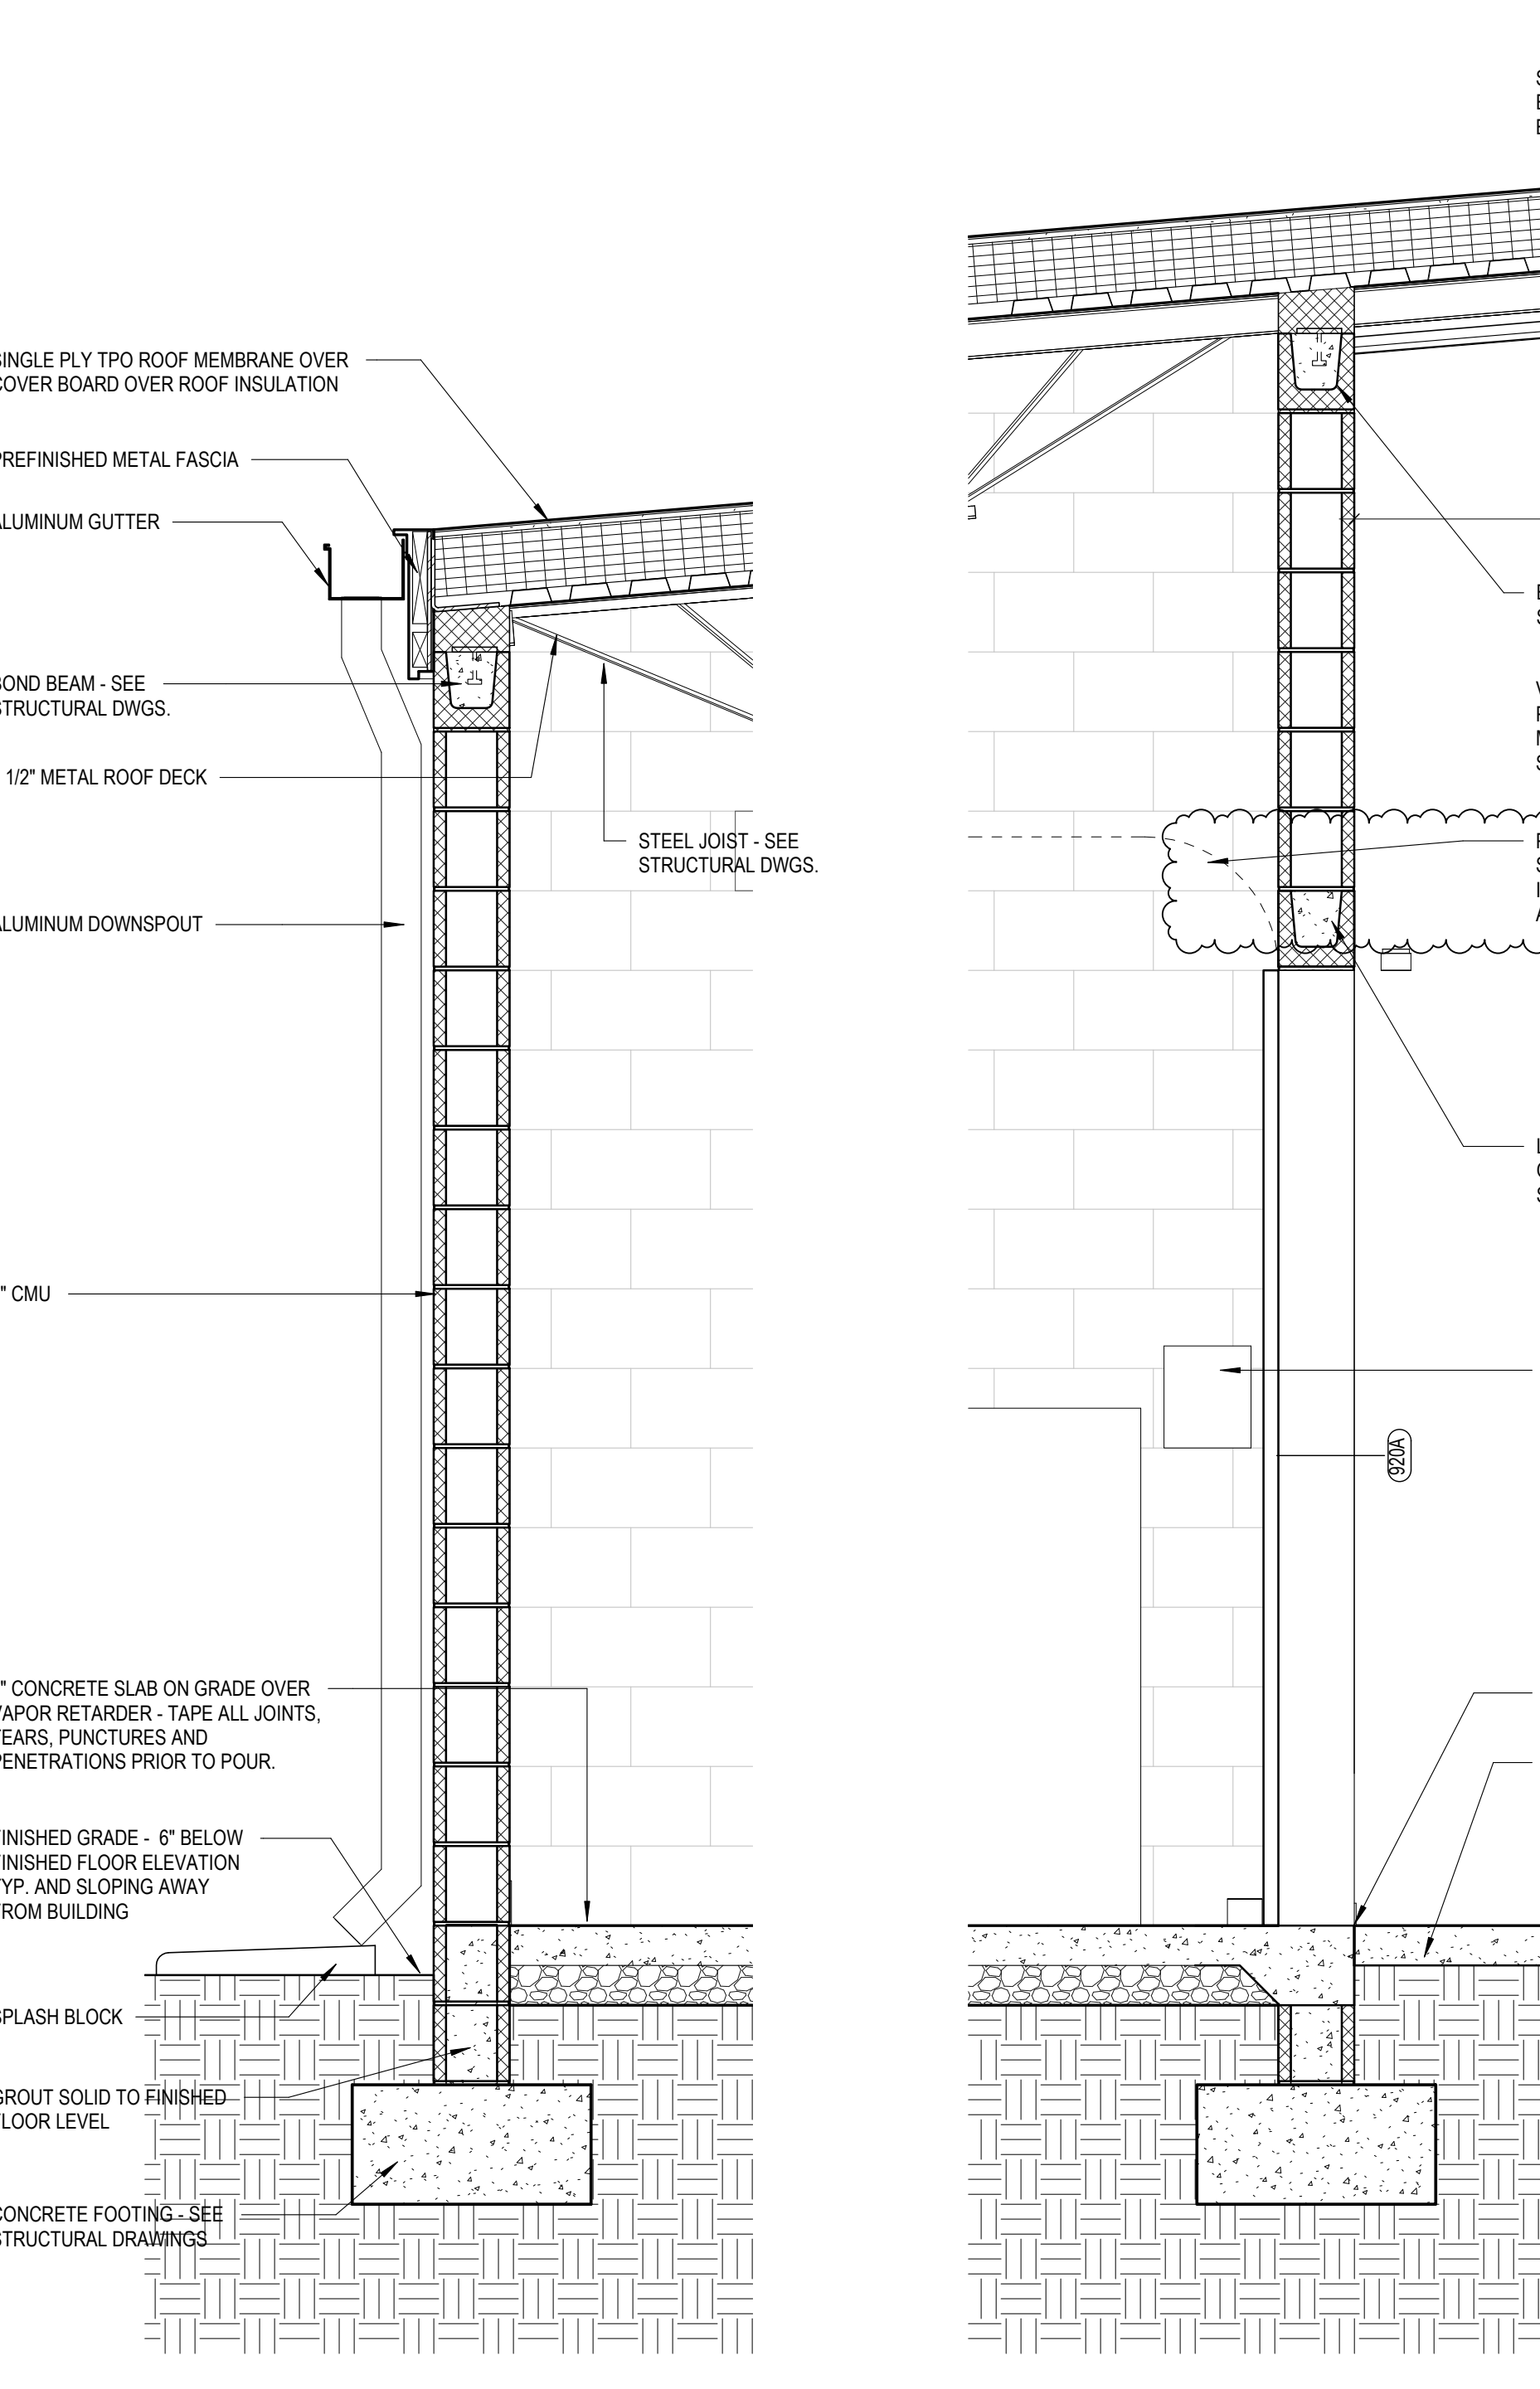

13 MAINTENANCE SECTION
A9-02 3/4" = 1'-0"

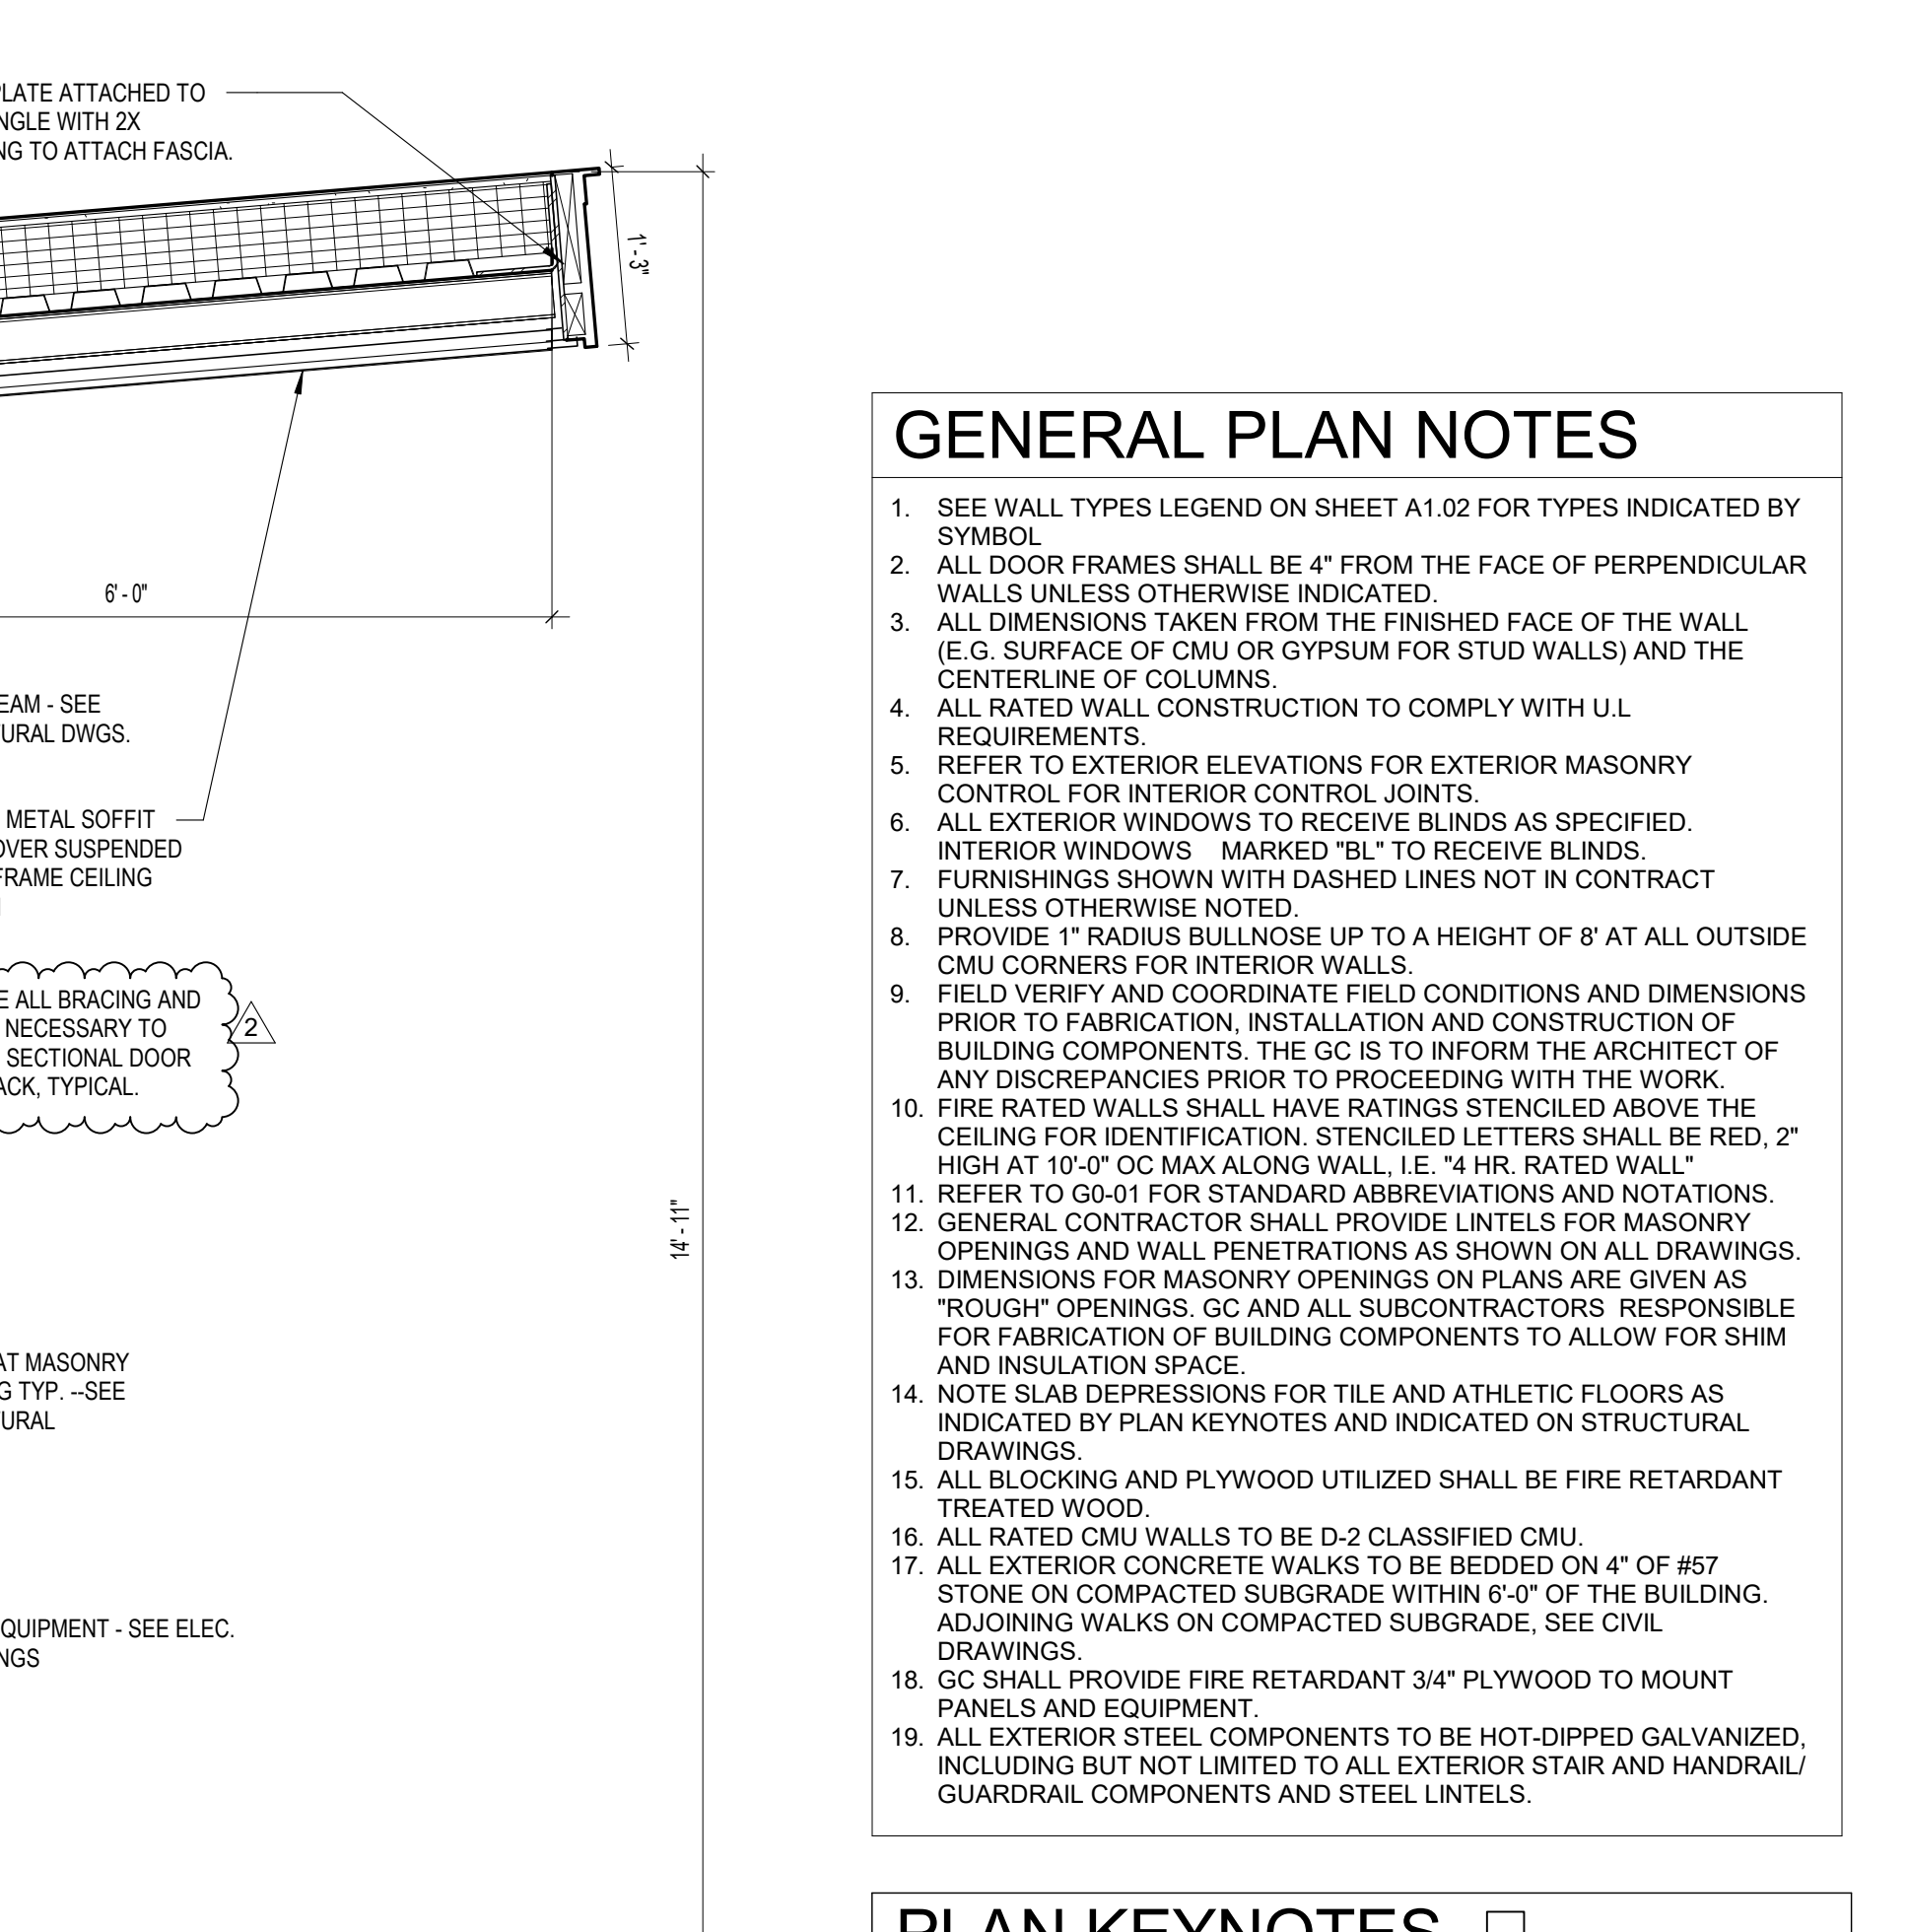

12 ROOF PLAN - TYPICAL DUGOUT
A9-02 1/8" = 1'-0"

GENERAL PLAN NOTES

1. SEE WALL TYPES LEGEND ON SHEET A1-02 FOR TYPES INDICATED BY SYMBOL
2. ALL DOOR FRAMES SHALL BE 4" FROM THE FACE OF PERPENDICULAR WALLS UNLESS OTHERWISE INDICATED.
3. ALL DIMENSIONS TAKEN FROM THE FINISHED FACE OF THE WALL (E.G. SURFACE OF CMU OR GYPSUM FOR STUD WALLS) AND THE CENTERLINE OF COLUMNS.
4. ALL RATED WALL CONSTRUCTION TO COMPLY WITH U.L. REQUIREMENTS
5. REFER TO EXTERIOR ELEVATIONS FOR EXTERIOR MASONRY CONTROL FOR INTERIOR CONTROL JOINTS
6. ALL EXTERIOR WINDOWS TO RECEIVE BLINDS AS SPECIFIED. INTERIOR WINDOWS MARKED "BL" TO RECEIVE BLINDS.
7. FURNISHINGS SHOWN WITH DASHED LINES NOT IN CONTRACT UNLESS OTHERWISE NOTED.
8. PROVIDE 1" RADIUS BULLNOSE UP TO A HEIGHT OF 8" AT ALL OUTSIDE CMU CORNERS FOR INTERIOR WALLS.
9. FIELD VERIFY AND COORDINATE FIELD CONDITIONS AND DIMENSIONS PRIOR TO FABRICATION, INSTALLATION AND CONSTRUCTION OF BUILDING COMPONENTS. THE GC IS TO INFORM THE ARCHITECT OF ANY DISCREPANCIES PRIOR TO PROCEEDING WITH THE WORK.
10. FIRE RATED WALLS SHALL HAVE RATINGS STENCILED ABOVE THE CEILING FOR IDENTIFICATION. STENCILED LETTERS SHALL BE RED, 2" HIGH AT 10" O.C. MAX ALONG WALL. I.E. "4 HR. RATED WALL"
11. REFER TO G0-01 FOR STANDARD ABBREVIATIONS AND NOTATIONS.
12. GENERAL CONTRACTOR SHALL PROVIDE LINTELS FOR MASONRY OPENINGS AND WALL PENETRATIONS AS SHOWN ON ALL DRAWINGS.
13. DIMENSIONS FOR MASONRY OPENINGS ON PLANS ARE GIVEN AS "ROUGH" OPENINGS. GC AND ALL SUBCONTRACTORS RESPONSIBLE FOR FABRICATION OF BUILDING COMPONENTS TO ALLOW FOR SHIM AND INSULATION SPACE.
14. NOTE SLAB DEPRESSIONS FOR TILE AND ATHLETIC FLOORS AS INDICATED BY PLAN KEYNOTES AND INDICATED ON STRUCTURAL DRAWINGS.
15. ALL BLOCKING AND PLYWOOD UTILIZED SHALL BE FIRE RETARDANT TREATED WOOD.
16. ALL RATED CMU WALLS TO BE D-2 CLASSIFIED CMU.
17. ALL EXTERIOR CONCRETE WALKS TO BE BEDDED ON 4" OF #57 STONES ON COMPACTED SUBGRADE WITHIN 6'-0" OF THE BUILDING. ADJOINING WALKS ON COMPACTED SUBGRADE. SEE CIVIL DRAWINGS.
18. GC SHALL PROVIDE FIRE RETARDANT 3/4" PLYWOOD TO MOUNT PANELS AND EQUIPMENT.
19. ALL EXTERIOR STEEL COMPONENTS TO BE HOT-DIPPED GALVANIZED, INCLUDING BUT NOT LIMITED TO ALL EXTERIOR STAIR AND HANDRAIL/GUARDRAIL COMPONENTS AND STEEL LINTELS.

PLAN KEYNOTES

1. SLAB RECESSED IN THIS ROOM TO ACCOMMODATE SPECIALTY FLOORING - REFER TO FINISH PLAN. GC TO CONFIRM DEPTH OF RECESS WITH FLOORING MANUFACTURER PRIOR TO POURING THE SLAB.
2. MECHANICAL LOUVER, REFER TO MECHANICAL DRAWINGS. GC TO COORDINATE OPENING SIZE AND PROVIDE LINTEL AND FLASHING
3. BUILDING EXPANSION JOINT. PROVIDE BLOCKOUTS IN SLAB FOR FLOOR TO FLOOR JOINTS. FLOOR TO FLOOR JOINTS: 2 HR. RATED 1" JOINT C/S GROUP MULTIFLEX MF-1F OR EQUAL. - - WALL TO WALL JOINTS: 2 HR. RATED 1" JOINT. C/S GROUP MULTIFLEX MF-1FW OR EQUAL. -WALL JO
4. ROLLING COUNTER DOOR. SEE SPECIFICATIONS.
5. ADA ACTUATOR. ELECTRICAL CONTRACTOR PROVIDE BACKER BOXES AND CONDUIT. COORDINATE W/ GC & HARDWARE SUPPLIER.
6. PROVIDE MAGNETIC DOOR HOLD OPENS FOR THIS DOOR ASSEMBLY. REFER TO ELECTRICAL DRAWINGS AND DOOR SCHEDULE FOR SPECIFICATIONS.
7. GC TO PROVIDE BONDBEAM LINTEL OVER THIS OPENING.
8. PROVIDE MECHANICAL DOOR HOLD OPENS FOR THIS DOOR ASSEMBLY
9. RECESS FLOOR 4 1/4" - COORDINATE WITH COOLER/FREEZER UNIT MANUFACTURER PRIOR TO POURING SLABS AND NOTIFY ARCHITECT OF DISCREPANCIES.
10. LADDER - MEANS OF ESCAPE FROM MECHANICAL PLATFORM ABOVE.
11. ROOF ACCESS LADDER - REFER TO ROOF PLAN A1-40
12. 4" WIDE SELF-CLOSING SAFETY GATE PER OSHA REQUIREMENTS
13. SLOPE SLAB TO DRAIN. SEE STRUCTURAL DRAWINGS FOR MINIMUM CONCRETE COVER AT DRAIN LOCATIONS.
14. COLUMN FEATURE. COUNTER AND WRAP. REFER TO DETAIL 15/A5-01
15. PIPE BOLLARD - SEE CIVIL DRAWINGS
16. OPERABLE PARTITION
17. NURSE EXAM CURTAIN
18. PROVIDE ELECTRONIC LOCKSET FOR SECURITY INTEGRATION THIS DOOR ASSEMBLY

Trinity Middle School

Raleigh, North Carolina

CLH Project No: 18-107

CLH design, p.a.
400 Regency Forest Drive, Suite 120
Cary, NC 27518



Addendum #2

2019-06-14

Where any article, division or subparagraph of the original contract documents or other addenda is supplemented herein, the provisions of the original documents shall remain in effect. All the supplemental provisions shall be considered as added thereto. Where any such article, division or subparagraphs are amended, voided or superseded thereby, the provisions of such article, division or subparagraph not so specifically amended, voided or superseded shall remain in effect.

The attention of the Contractor is called to the following clarifications, additions to and changes in the plans and specifications dated **May 20, 2019** on the above job. It will be the responsibility of each Contractor to call such clarifications, additions to and changes in the plans and specifications to the attention of subcontractors concerned. The Engineer in no way assumes any responsibility for notifying any subcontractor, material dealers or others not having received the original contract documents.

ITEM 1. GENERAL CONTRACT

Refer to Plan Sheet C05.03: Site Utility Plan – Area 3

REPLACE sheet C05.03 in its entirety with revised drawing C05.03 Addendum No. 3 dated June 14, 2019, attached hereto.

Revisions:

1. Note has been revised for off-site waterline.

ITEM 2. GENERAL CONTRACT

Refer to Plan Sheet C05.01: Site Utility Plan – Area 1

REPLACE sheets C05.01 in its entirety with revised drawings C05.01 Addendum No. 3 dated June 14, 2019, attached hereto.

Revisions:

1. Increase the length of the bore and jack from 230-lf to 250-lf.

ITEM 3. GENERAL CONTRACT

Refer to Plan Sheet C05.05: Sanitary Sewer Plan and Profile

REPLACE sheets C05.05 in its entirety with revised drawings C05.05 Addendum No. 3 dated June 14, 2019, attached hereto.

Revisions:

1. Increase the length of the bore and jack from 230-lf to 250-lf.

ITEM 4. GENERAL CONTRACT

Refer to Plan Sheet C02.01: Existing Conditions and Demolition Plan – Area 1

REPLACE sheets C02.01 in its entirety with revised drawings C02.01 Addendum No. 3 dated June 14, 2019, attached hereto.

Revisions:

1. Construction limits and tree protection fencing revised at bore and jack location.

ITEM 5. GENERAL CONTRACT

Refer to Plan Sheet C03.01: Site Grading Plan – Area 1

REPLACE sheets C03.01 in its entirety with revised drawings C03.01 Addendum No. 3 dated June 14, 2019, attached hereto.

Revisions:

1. Construction limits and tree protection fencing revised at bore and jack location.

ITEM 6. GENERAL CONTRACT

Refer to Plan Sheet C04.05: Site Erosion Control Plan - Area 1- Late Phase

REPLACE sheets C04.05 in its entirety with revised drawings C04.05 Addendum No. 3 dated June 14, 2019, attached hereto.

Revisions:

2. Construction limits, tree protection fencing and silt fencing revised at bore and jack location.



ITEM 7. GENERAL CONTRACT

Refer to Specification Section 32 50 01- Exterior General Athletic Equipment.

REVISE section 2.5 Portable Player Benches to read as follow:

- A. Portable Player Benches: 2-in x 10-in heavy duty, anodized, extruded aluminum seat and back planks mounted on 2-3/8" O.D. galv. steel frame, PW Athletic Equipment model #1102 (800-687-5768) or approved equal. Unless noted otherwise, provide a total of four (4) 15-ft long benches at football/soccer field.

END OF SITE/CIVIL ITEMS FOR THIS ADDENDUM

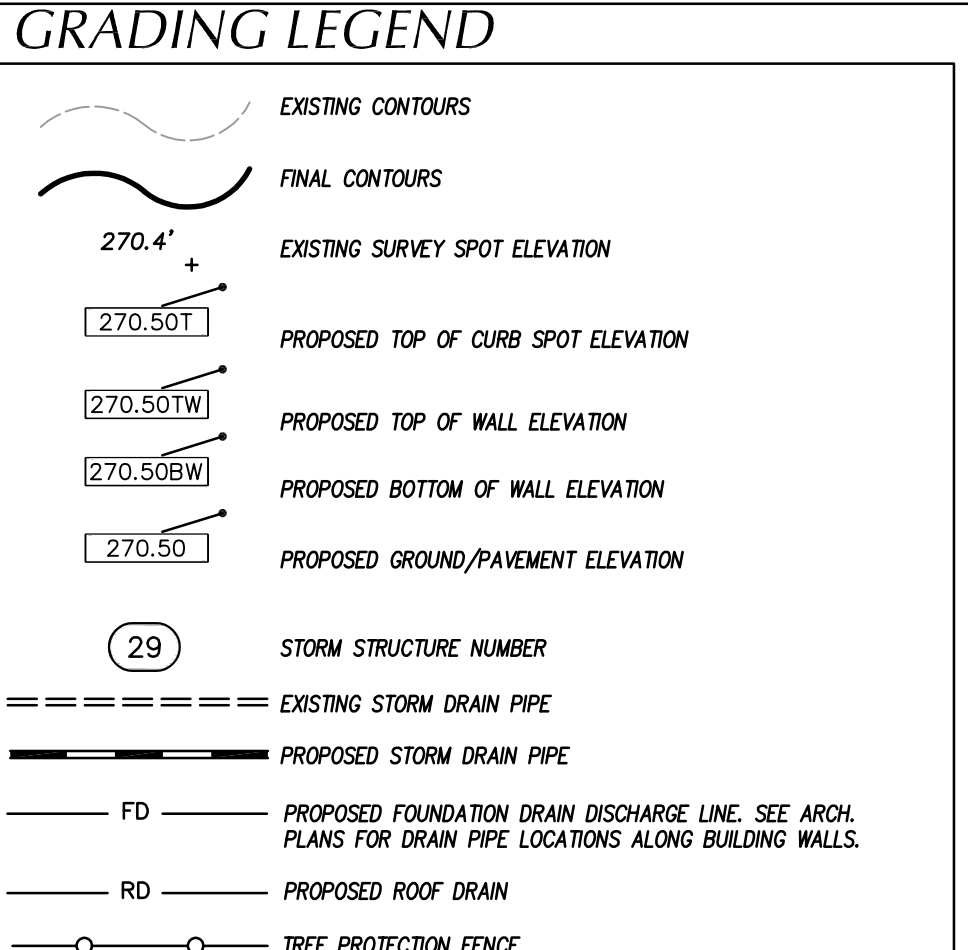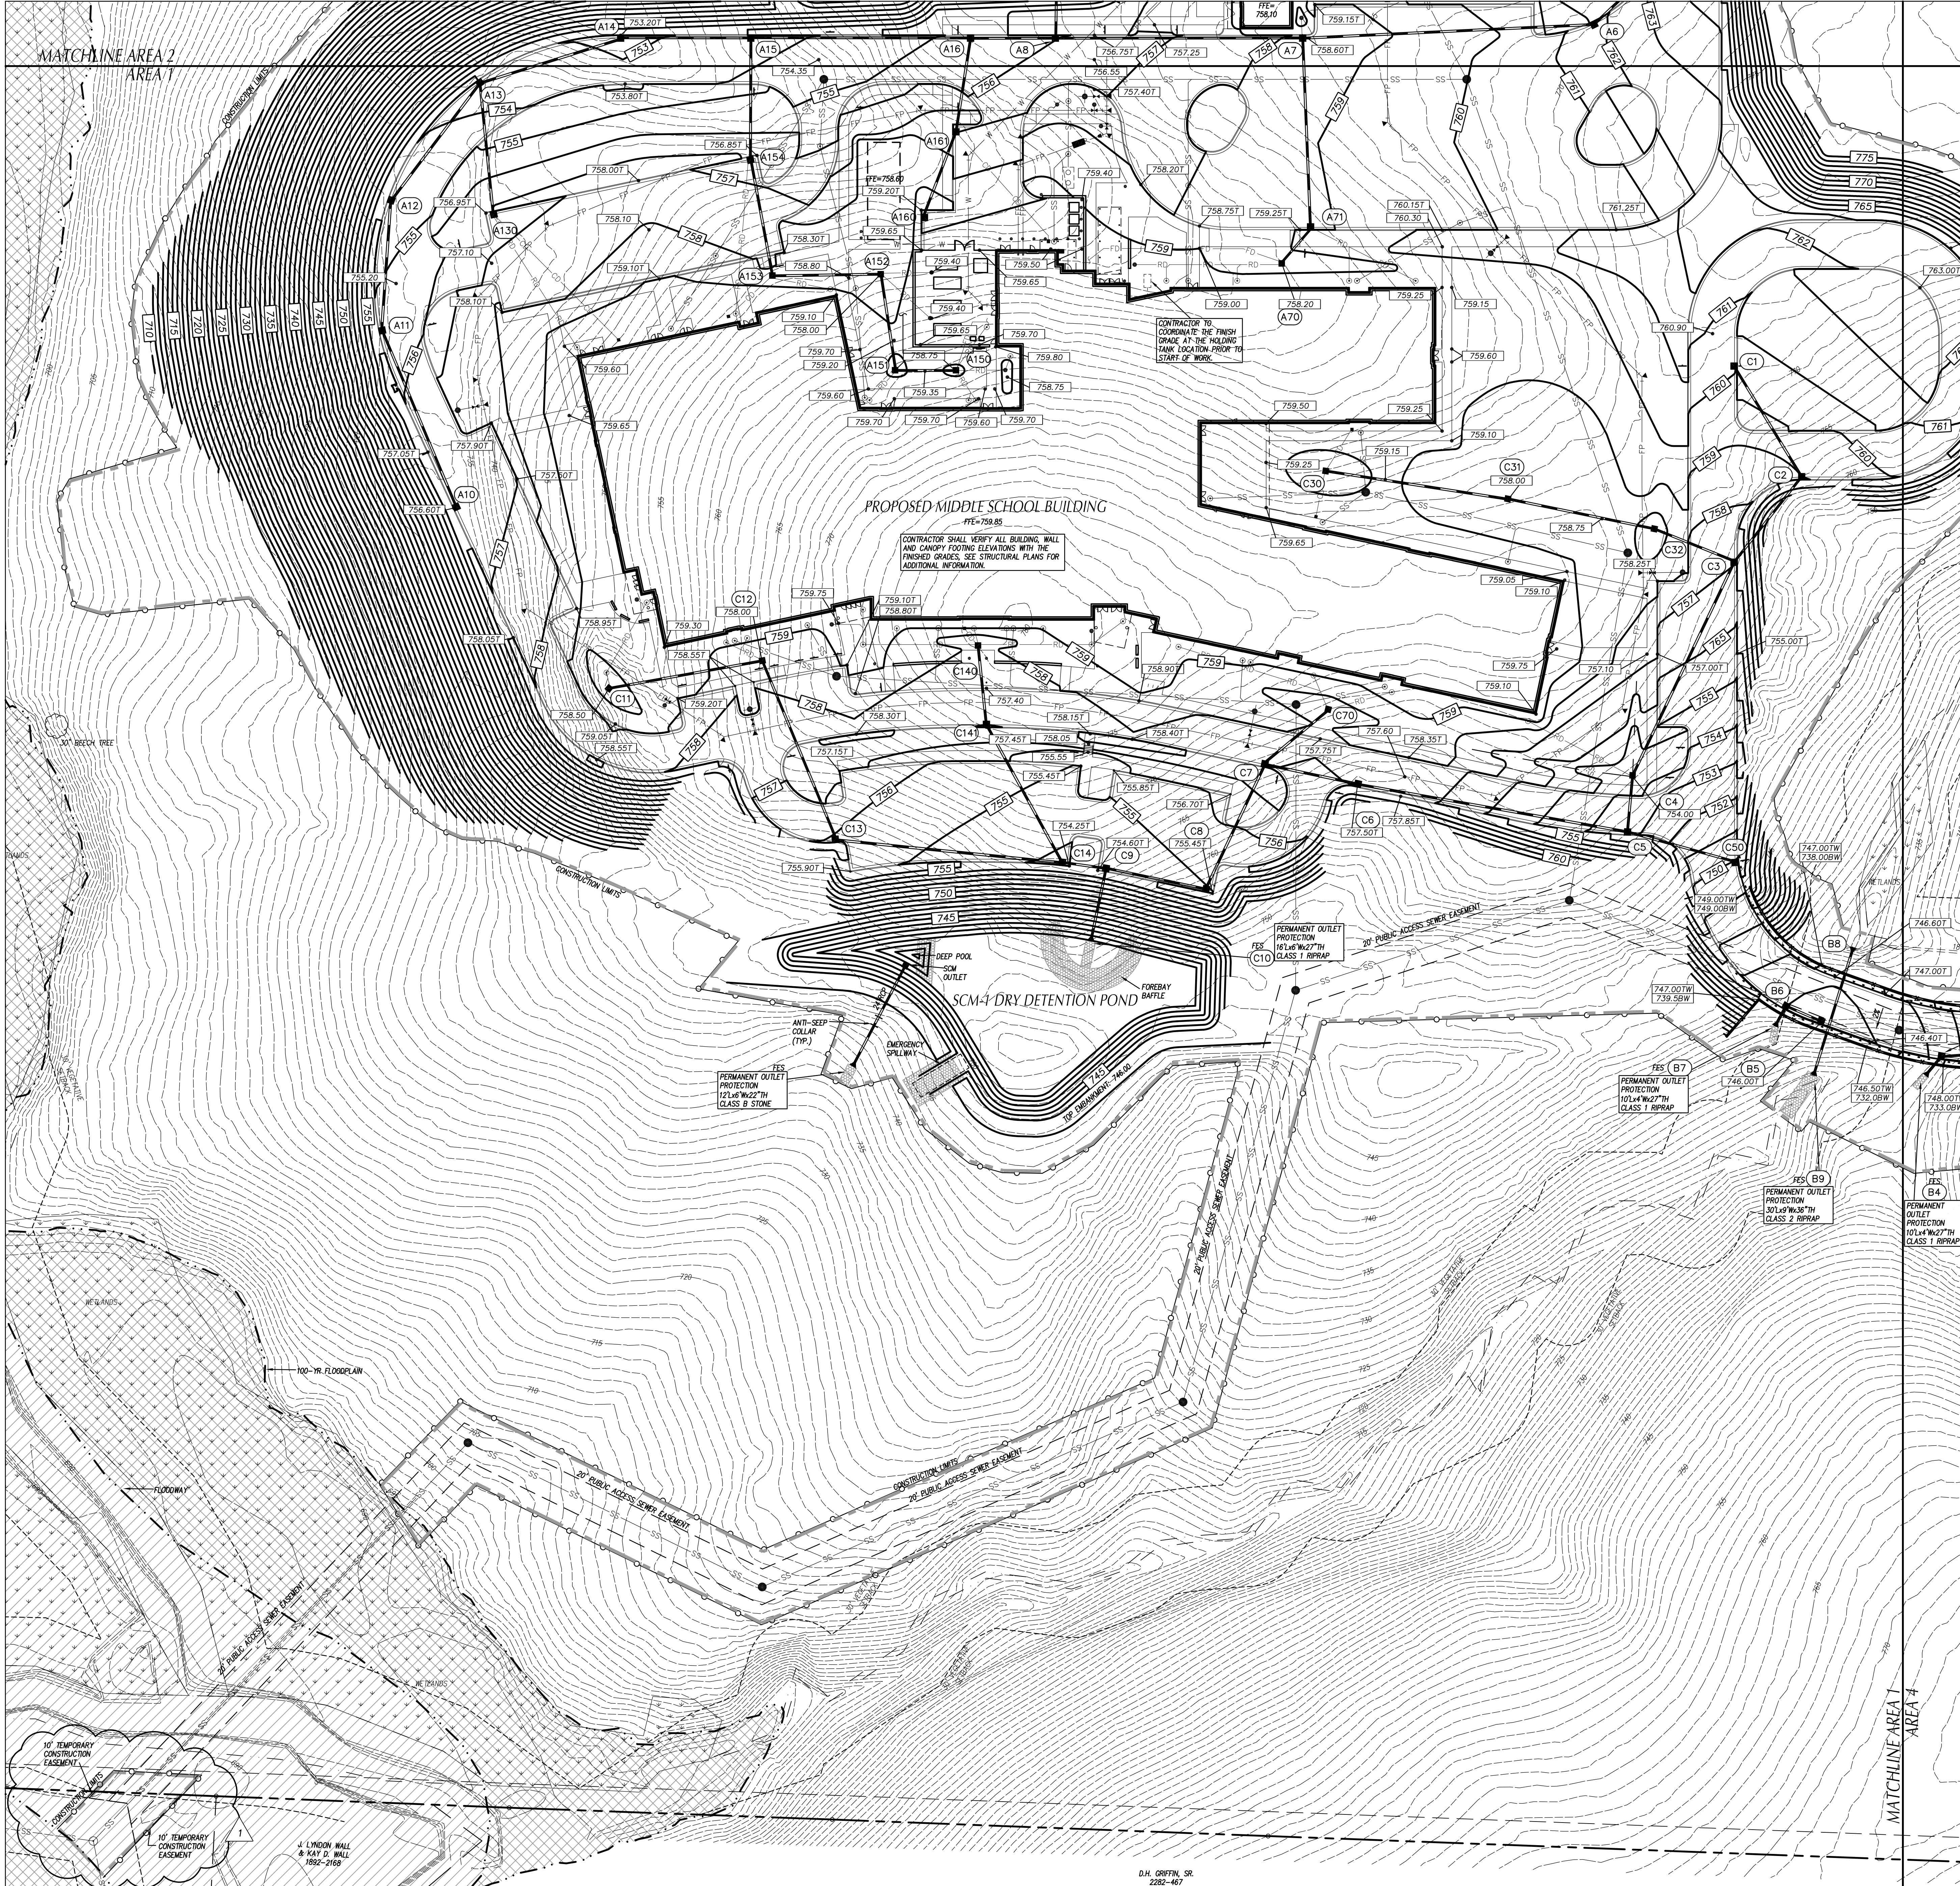

- ### GENERAL NOTES
1. ALL CONSTRUCTION SHALL BE IN ACCORDANCE WITH ALL CITY OF TRINITY AND NCDOT STANDARDS AND SPECIFICATIONS.
 2. ALL SPOT ELEVATIONS INDICATED AT CURB AND GUTTER AND ARE DENOTED TO TOP OF CURB, UNLESS OTHERWISE SHOWN.
 3. TOTAL DEMONDED AREA = 29 AC
 4. CONTRACTOR SHALL ADJUST ALL EXISTING VAULTS, MANHOLES, STORM DRAIN STRUCTURES, CLEANOUTS, ETC. AS NEEDED TO MATCH FINISH GRADE.
 5. ALL BACKFILL, COMPACTION, SOILS TESTING, ETC. SHALL BE PERFORMED BY THE OWNER'S INDEPENDENT TESTING LABORATORY. (SEE SPECIFICATIONS FOR ADDITIONAL INFORMATION)
 6. ALL STORM DRAIN PIPES SHALL BE PROTECTED WITH STONE FILTER PROTECTION AFTER STOPPAGE OF WORK EACH DAY. SEE DETAIL ON SHEET C027.04.
 7. EXISTING VEGETATION WITHIN TREE PROTECTION AREAS SHALL REMAIN UNDISTURBED, UNLESS NOTED OTHERWISE.
 8. ANY AND ALL LANDSCAPING AND EXISTING TREES & SHRUBS TO REMAIN WHICH ARE DAMAGED DURING DEMOLITION OR CONSTRUCTION SHALL BE REPLACED BY THE CONTRACTOR UTILIZING A LICENSED LANDSCAPE CONTRACTOR AT NO ADDITIONAL COST TO THE OWNER.
 9. THE GRADING CONTRACTOR SHALL COMPLY WITH ALL STATE CODES IN OBSERVING EROSION CONTROL MEASURES BOTH ON AND OFF-SITE.
 10. THE GRADING CONTRACTOR SHALL MAINTAIN ALL EROSION CONTROL DEVICES AFTER EACH RAINFALL EVENT OR AS DIRECTED BY STATE AUTHORITIES OR THE ARCHITECT.
 11. THE GRADING CONTRACTOR SHALL BE RESPONSIBLE FOR OFF-SITE DISPOSAL OF ALL CLEARING AND GRADING WASTE MATERIALS GENERATED DURING CONSTRUCTION AND FOR OBTAINING ALL APPLICABLE PERMITS FOR OFF-SITE STOCKPILES AND/OR MATERIALS AREAS.
 12. THE CROSS-SLOPE ON ALL SIDEWALKS SHALL BE A MAXIMUM OF 2.0%.
 13. CONTRACTOR SHALL VERIFY ALL EXISTING ELEVATIONS WHERE NEW CONSTRUCTION JOIN OR CONNECT TO EXISTING PAVEMENT, CURB AND OTHER ROAD STRUCTURES. NOTIFY ARCHITECT IF DISCREPANCIES OCCUR.

DRAINAGE STRUCTURE SCHEDULE

STRUCTURE NO.	PIPE	PIPE	PIPE	PIPE	UPPER	LOWER	TOP ELEV.	UPSTREAM STRUCTURE DATA		
UP STRM	DN STRM	DIAM.	LENGTH	MATERIAL	INV.	INV.	(FT.)	DEPTH		
A1	A2	1.02%	15	200	RCP	781.80	779.75	786.25	4.45	CB
A2	A3	0.88%	15	300	RCP	778.65	778.70	784.70	5.05	CB
A3	A4	3.90%	15	100	RCP	776.60	772.70	781.30	4.70	CB
A4	A5	4.70%	15	100	RCP	772.60	767.90	777.05	4.45	CB
A5	A6	5.00%	15	200	RCP	767.80	757.80	772.15	4.35	CB
A6	A7	3.00%	15	180	RCP	757.70	752.30	762.10	4.40	CB
A7	A8	4.31%	18	150	RCP	752.20	746.60	758.60	6.40	CB
A8	A9	1.00%	30	50	RCP	745.50	748.00	756.50	11.00	CB
A10	A11	0.93%	15	118	RCP	752.20	751.10	756.60	4.40	CB
A11	A12	0.93%	15	81	RCP	751.00	750.25	755.85	4.85	CB
A12	A13	1.11%	15	90	RCP	751.15	748.90	754.95	4.80	CB
A13	A14	0.93%	15	91	RCP	749.20	748.35	754.05	4.85	CB
A14	A15	0.93%	18	81	RCP	748.25	747.50	753.20	4.95	CB
A15	A16	0.93%	24	138	RCP	747.40	746.15	754.05	6.65	CB
A16	A8	0.88%	24	52.2	RCP	746.05	745.60	755.70	9.65	CB
A160	A161	3.18%	15	57	RCP	754.90	753.00	759.20	4.40	CB
A161	A16	1.02%	15	59	RCP	752.90	752.30	757.50	4.60	CB
A150	A151	1.08%	15	37	RCP	754.30	753.60	758.75	4.45	DI
A151	A152	1.02%	15	59	RCP	753.80	753.20	758.75	4.95	DI
A152	A153	1.00%	15	66	RCP	753.10	752.40	758.00	4.90	DI
A153	A154	1.11%	15	71	RCP	752.30	751.50	758.50	4.20	DI
A154	A15	1.07%	15	75	RCP	751.40	750.60	756.85	5.45	CB
A130	A13	1.11%	15	61	RCP	752.50	751.60	758.95	4.45	CB
B1	B2	7.49%	15	319	RCP	768.10	744.20	772.50	4.40	CB
B2	B3	7.63%	15	136	RCP	744.10	733.60	736.30	12.40	CB
B3	B4	7.00%	15	16	RCP	733.70	732.50	747.90	14.20	CB
B5	B6	1.30%	15	23	RCP	741.60	741.30	746.00	4.40	CB
B6	B7	1.07%	15	14	RCP	738.15	738.60	746.50	10.35	CB
B8	B9	4.87%	30	80	RCP	728.90	728.00	746.00	17.10	FES Class IV
C1	C2	2.00%	15	80	RCP	756.30	754.70	760.65	4.35	CB
C2	C3	2.01%	15	67	RCP	754.60	753.25	759.50	4.90	CB
C3	C4	1.00%	15	148	RCP	751.25	748.75	752.50	6.25	CB
C4	C5	1.00%	18	35	RCP	749.65	749.30	754.00	4.35	DI
C5	C6	0.91%	24	170	RCP	745.30	743.75	753.90	8.60	CB
C6	C7	0.91%	24	59	RCP	743.65	742.10	752.50	14.35	CB
C7	C8	0.93%	24	86	RCP	743.00	742.20	757.90	14.50	CB
C8	C9	0.94%	24	64	RCP	742.10	741.50	755.45	13.35	CB
C9	C10	0.87%	30	46	RCP	741.40	741.00	754.60	13.20	CB
C11	C12	3.18%	15	96	RCP	754.10	751.05	758.50	4.40	DI
C12	C13	3.09%	15	118	RCP	750.95	747.30	756.00	7.95	DI
C13	C14	3.09%	15	141	RCP	747.20	742.85	746.35	9.15	DI
C14	C9	4.11%	15	28	RCP	742.75	741.60	754.25	11.50	CB
C30	C31	1.01%	15	114	RCP	754.10	752.95	758.50	4.40	DI
C31	C32	1.02%	15	93	RCP	752.85	751.90	758.00	5.15	DI
C32	C3	1.02%	15	54	RCP	751.80	751.25	757.50	5.70	DI
C70	C7	8.51%	15	51	RCP	753.10	748.25	757.50	4.40	DI
C140	C141	1.02%	15	49	RCP	753.10	752.60	757.50	4.40	DI
C141	C14	1.02%	15	98	RCP	752.50	751.50	757.50	5.00	CB
C50	C0	1.01%	15	69	RCP	746.10	745.40	750.50	4.40	CB
D1	D2	10.20%	15	98	RCP	748.00	738.00	754.00	6.00	FES
E1	E2	1.08%	15	93	RCP	748.10	747.10	752.50	4.40	DI
E2	E3	1.00%	15	94	RCP	747.00	746.00	752.50	5.50	DI
E3	E4	1.00%	15	95	RCP	745.90	744.90	752.50	6.60	DI
E4	E5	1.04%	15	96	RCP	744.80	743.80	752.50	7.70	DI
E5	E6	1.02%	15	216	RCP	743.70	741.50	752.50	8.80	DI
E6	E7	1.04%	15	115	RCP	741.40	740.20	753.70	12.30	DI
E7	E8	3.00%	18	95	RCP	739.90	737.00	752.80	13.90	DI
E8	E9	2.00%	18	265	RCP	736.90	731.60	752.80	15.90	DI
E9	E10	9.85%	18	132	RCP	731.50	718.50	750.10	16.60	DI
E11	E12	1.28%	15	86	RCP	745.60	744.50	750.00	4.40	DI
E12	E9	1.10%	15	100	RCP	744.40	743.30	750.00	5.60	DI
E70	E71	1.02%	15	284	RCP	745.00	742.10	749.00	4.00	DI
E71	E7	1.82%	15	110	RCP	742.00	740.00	752.00	10.00	DI
F1	F2	0.30%	18	118	RCP	784.00	783.65	787.00	3.00	FES
G1	G2	3.28%	15	86	RCP	772.00	769.20	774.65	2.65	FES
G2	G3	1.73%	18	58	EX RCP	769.20	768.17	772.90	3.70	DI

NOTES

CB CATCH BASIN. SEE DETAIL SHEET C027.04
 DI DROP INLET. SEE DETAIL SHEET C027.04
 (2) STRUCTURE I.D. NUMBER

TOP ELEVATION IS TOP OF B/W FOR MANHOLES, TOP OF GRATE FOR VARD INLETS, AND FINISH GRADE FOR CLEANOUTS.

ALL FES INLETS & OUTLETS SHALL BE RCP.

GRAPHIC SCALE
 0 20 40 80 160
 (IN FEET)
 1 inch = 40 ft.

smith sinnett ARCHITECTURE
 19191 BLOC
 4000 Lake Boone Trail
 Raleigh, NC 27607
 info@smithsinnett.com

SMITH SINNETT ARCHITECTURE
 23953
 5/20/19

GENERAL NOTES

VOLUME I

CIH DESIGN, P.A.
 400 Regency Forest Drive
 Suite 150
 Cary, North Carolina 27510
 Phone: (919) 319-6716
 Fax: (919) 318-7614

**TRINITY MIDDLE SCHOOL
 RANDOLPH COUNTY SCHOOL SYSTEM**

Parcel PIN: 7708118367
 Surrent Drive
 Trinity, NC 27370


001419 ADDENDUM #3 REVISIONS

ID	DATE	DESCRIPTION
DRAWN BY:		KL, HB
CHECKED BY:		RP

SITE GRADING PLAN - AREA 1

2017032 20 MAY 2019


C03.01

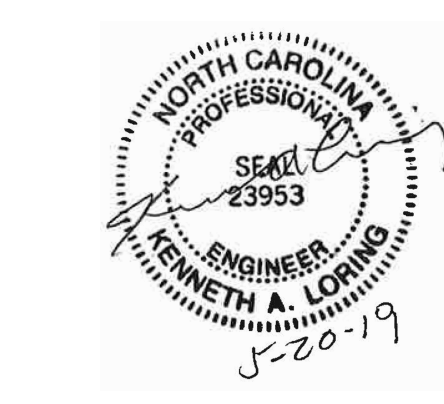

BID DOCUMENTS

VOLUME I

The Smith Sinnett Architecture, P.A., is the reproduction of this drawing without the written consent of Smith Sinnett Architecture, P.A. Any infringement of the copyright herein will be subject to legal action. All copies of this drawing are to be made from the original drawing. Smith Sinnett Architecture, P.A. 2019
THIS DRAWING IS CONSIDERED TO BE PRINTED ON A 30" X 42" SHEET

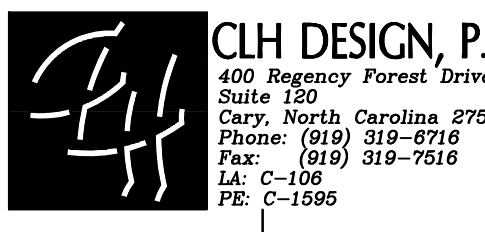

TRINITY MIDDLE SCHOOL
RANDOLPH COUNTY SCHOOL SYSTEM





Parcel PIN: 7708118367
Surrett Drive
Trinity, NC 27370

ID	DATE	DESCRIPTION
DRAWN BY:		KL, HB
CHECKED BY:		RP

SANITARY SEWER PLAN AND PROFILE

2017032 20 MAY 2019

C05.05

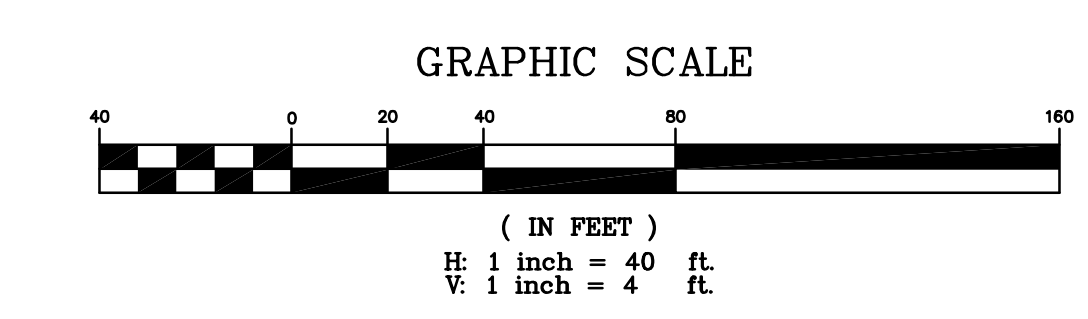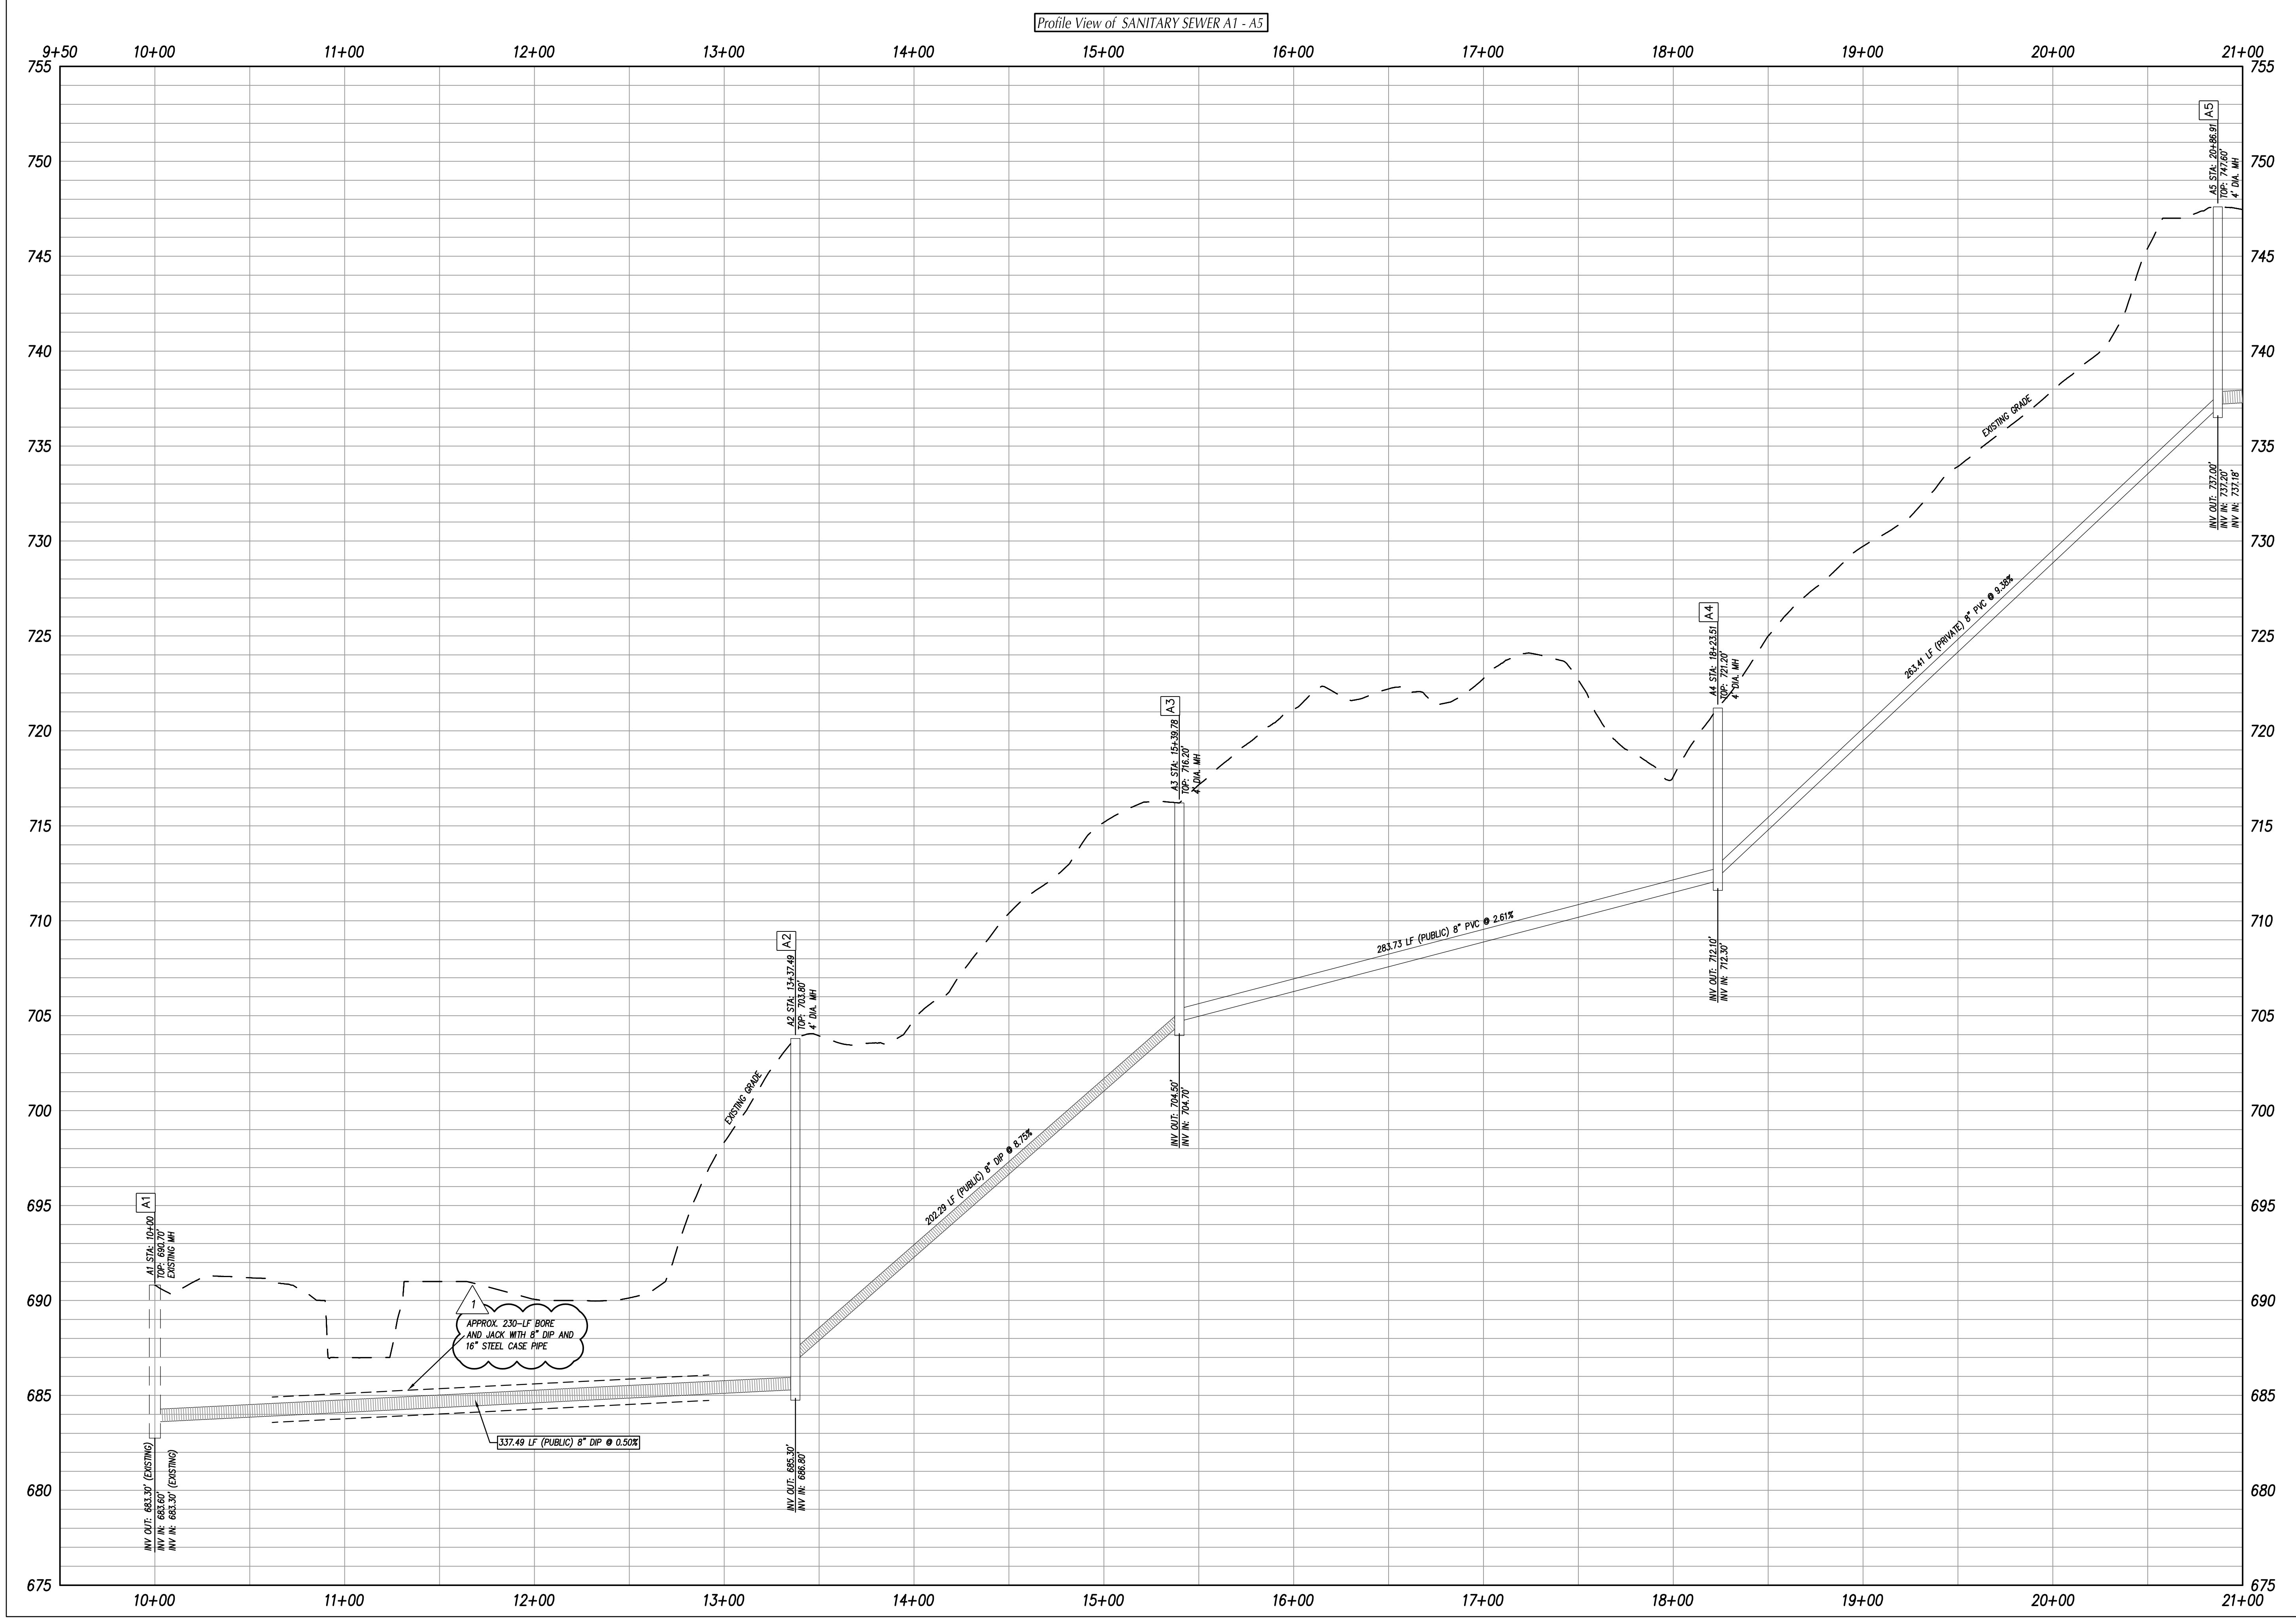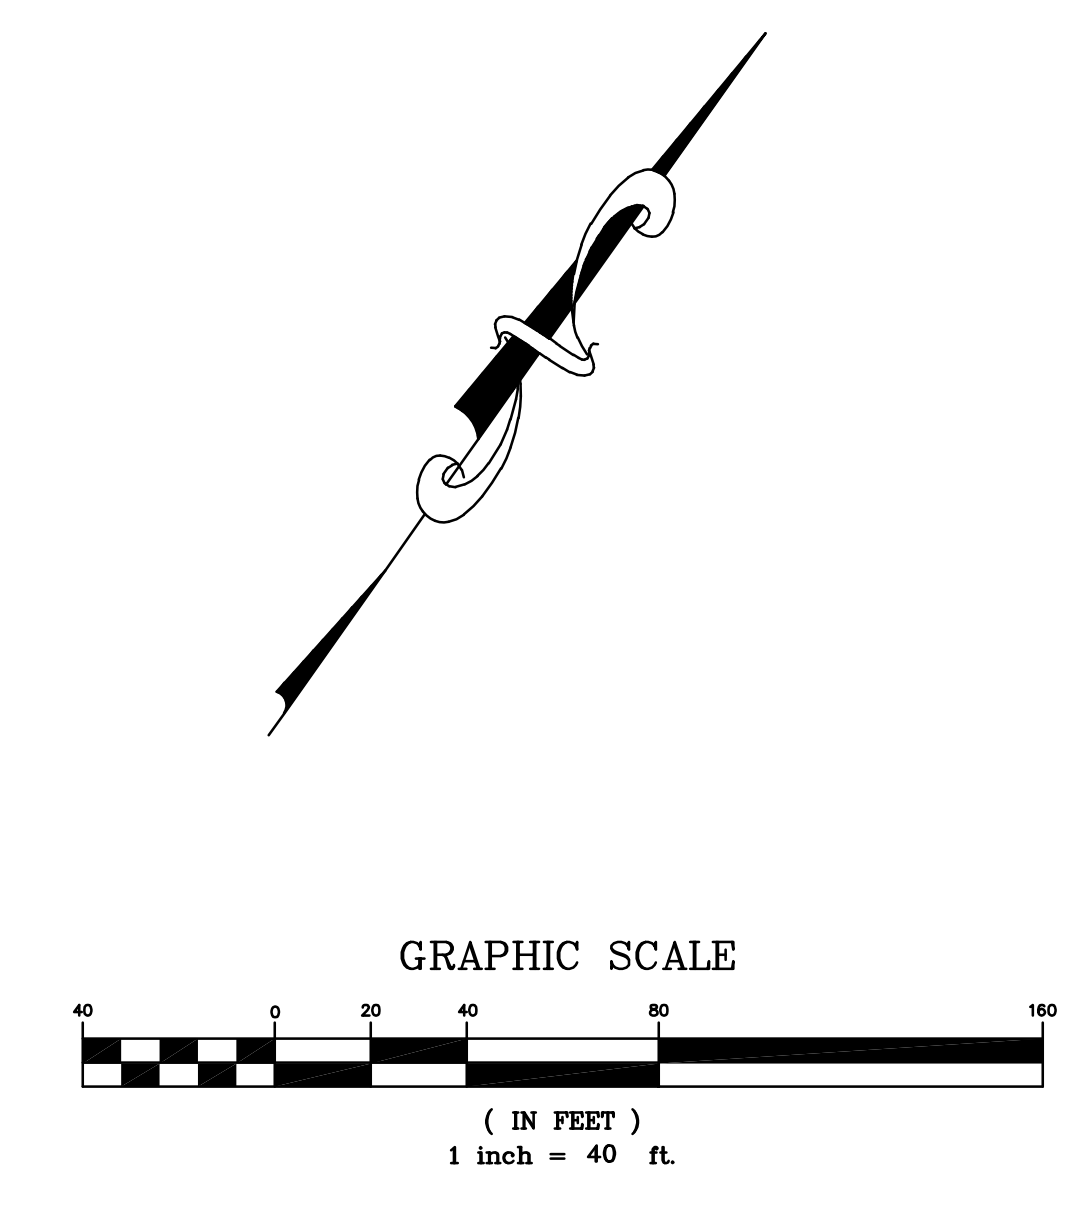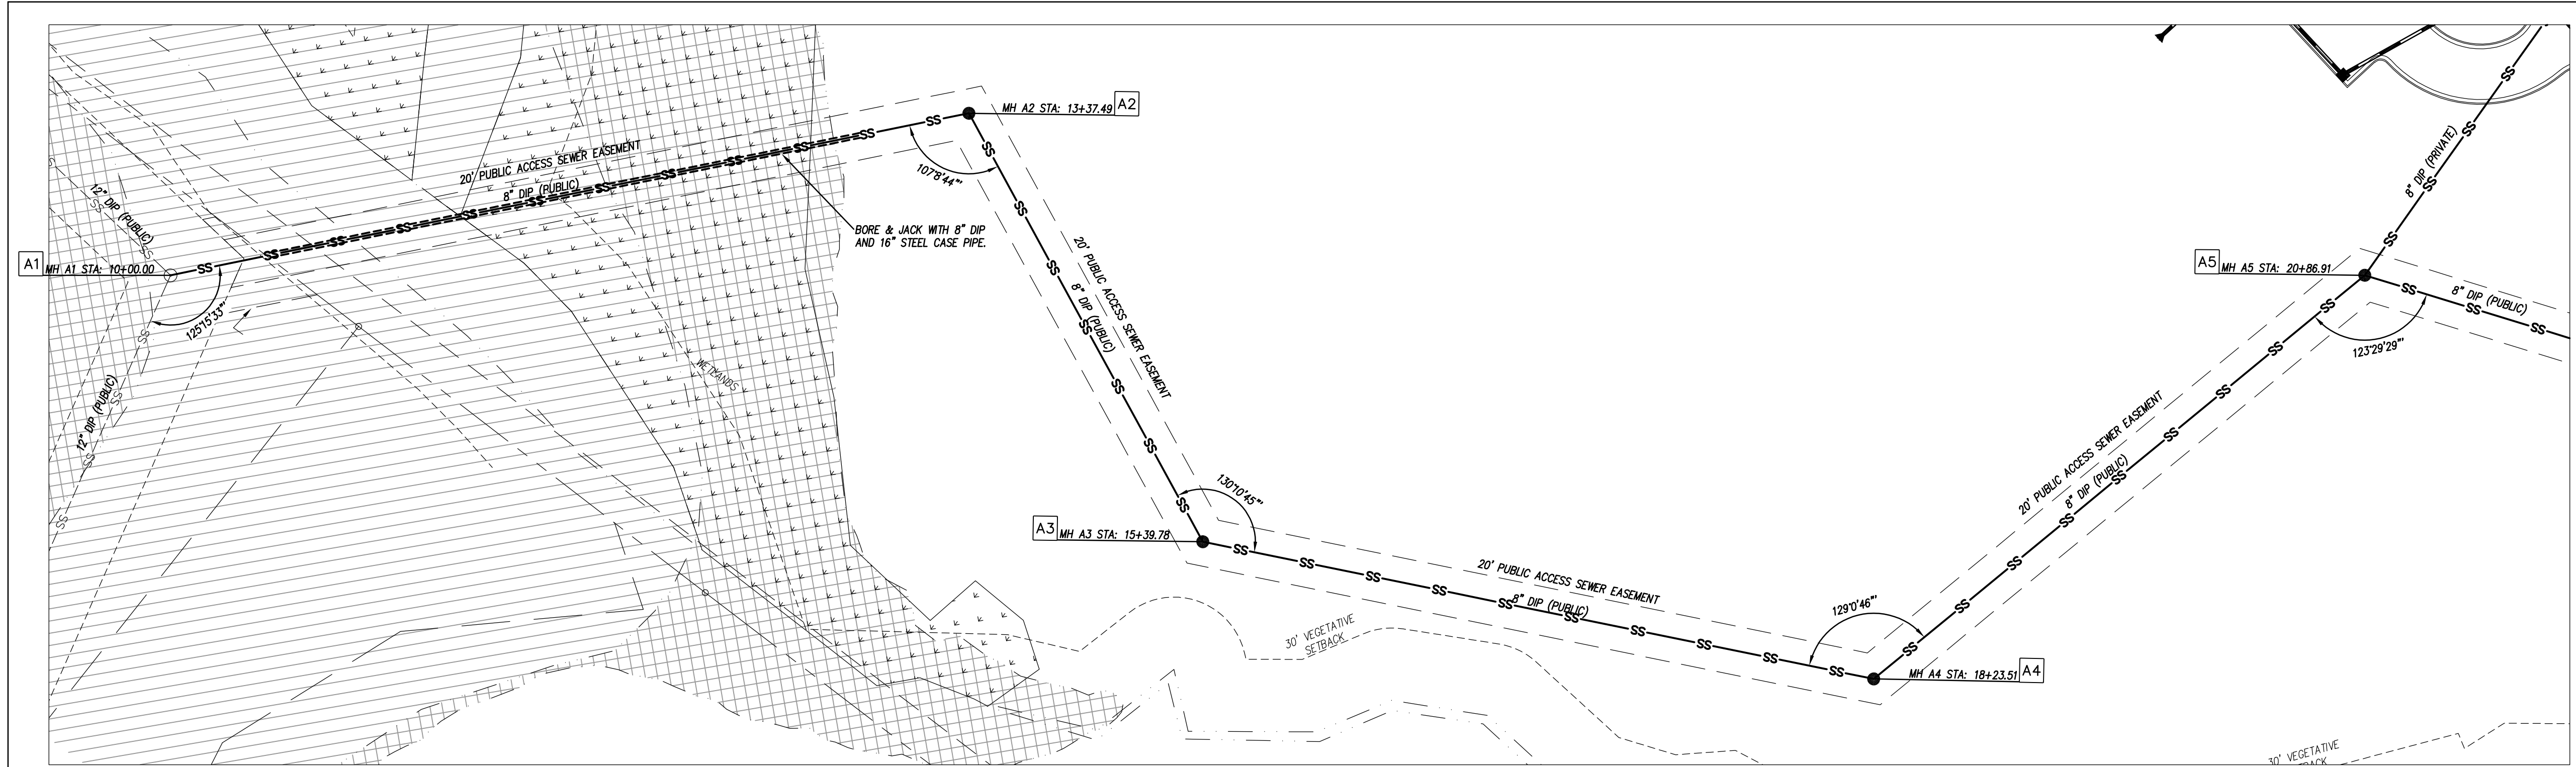


Addendum #1

Project: Trinity Middle School

Smith Sinnett Architects Project #: 2017027

Issue Date: May 14, 2019

Issued By: Sean A. Dolle, Grounded Engineering

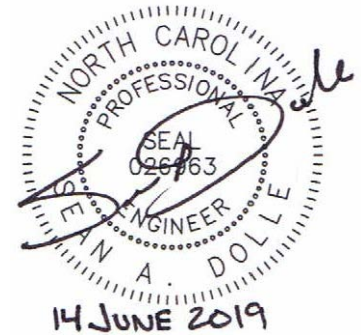

The following is a list of changes that have been made to the plans since the issuance of bid documents. These changes are as a result of Town review comments.

Changes to Plans:

1. The NPDES notes have been removed from sheet C0-01. New NPDES notes have been provided on new sheets C4-10 and C4-11.
2. General Note #15 on sheet C0-01 has been added.
3. Site Demolition Plan Note #5 has been revised on sheet C0-01.
4. A general note has been added at the beginning of the Construction Sequence on sheet C0-01.
5. The proposed Disturbed Area has been revised on sheet C0-01.
6. The limits of disturbance have been adjusted on sheet C4-00.
7. Some temporary silt fence has been added to sheet C4-00.
8. Sheets C4-10 and C4-11 have been added to the set.
9. The proposed waterline location has been shifted the west. The waterline connection to existing waterline has been revised. The blow off design at the end of the proposed waterline has been revised. (sheets C8-00 and C8-01)
10. The water meter reconnections and new meters have been adjusted on sheets C8-00 and C8-01.
11. Clarification notes have been added for the existing utility poles along the proposed waterline routes on sheets C8-00 and C8-01.
12. The waterline profile has been adjusted on sheets C8-00 and C8-01. An approximate elevation of the existing edge of pavement has also been shown on these sheets in the profile.
13. A new fire hydrant has been added near STA 108+80.
14. The fire hydrant previously shown at the driveway entrance to the school (approx. STA 114+75) has been relocated to be off of the fire line running into the project site. Refer to plans by CLH Design for more information.
15. Sheet C9-11 has been added to the set to provide a temporary silt fence detail and erosion control maintenance requirements.



P.O. Box 37132
Raleigh, NC 27627

www.grounded-engineering.com
919.438.3694

grounded
ENGINEERING

Attachments:

- C0-01 (dated 06.14.2019)
- C0-02 (dated 06.14.2019)
- C1-00 (dated 06.14.2019)
- C4-00 (dated 06.14.2019)
- C4-10 (dated 06.14.2019)
- C4-11 (dated 06.14.2019)
- C8-00 (dated 06.14.2019)
- C8-01 (dated 06.14.2019)
- C9-10 (dated 06.14.2019)
- C9-11 (dated 06.14.2019)
- C9-30 (dated 06.14.2019)

End of Document



P.O. Box 37132
Raleigh, NC 27627

www.grounded-engineering.com
919.438.3694

grounded
ENGINEERING

CONSTRUCTION SEQUENCE

THE CONTRACTOR SHALL NOT BEGIN ANY CONSTRUCTION WORK ASSOCIATED WITH THE OFF-SITE WATERLINE EXTENSION UNTIL ALL REQUIRED PERMITS ARE IN HAND AND ALL REQUIRED EASEMENTS HAVE BEEN SECURED.

- OBTAIN A SEDIMENTATION & EROSION CONTROL PERMIT FROM NCDEQ.
- PRIOR TO BEGINNING CONSTRUCTION (INCLUDING DEMOLITION), THE CONTRACTOR SHALL SCHEDULE A PRE-CONSTRUCTION MEETING ON-SITE WITH NCDEQ INSPECTOR AND OWNER'S REPRESENTATIVES. THE CONTRACTOR SHALL PROVIDE EVERYONE WITH A MINIMUM OF 72 HOURS NOTICE FOR ALL ON-SITE MEETINGS.
- FOLLOWING THE MEETING, IF APPROVED BY NCDEQ, THE CONTRACTOR SHALL PROCEED WITH INSTALLATION OF EROSION CONTROL MEASURES. CONTRACTOR SHALL ONLY DEMOLISH SITE IMPROVEMENTS AS NECESSARY TO INSTALL PROPOSED EROSION CONTROL MEASURES.
- THE CONTRACTOR SHALL SCHEDULE AN EROSION CONTROL MEASURE INSPECTION WITH NCDEQ INSPECTOR.
- UPON APPROVAL OF EROSION CONTROL MEASURES, THE CONTRACTOR SHALL BEGIN WITH THE INSTALLATION OF THE PROPOSED OFF-SITE WATERLINE. THE CONTRACTOR SHALL INSTALL CHECK DAMS WITHIN ALL AREAS OF DISTURBANCE AS THE AREAS ARE DISTURBED.
- ONCE GRADING IS COMPLETE, ALL IMPROVEMENTS HAVE BEEN INSTALLED AND THE SITE IS STABILIZED, THE CONTRACTOR SHALL CALL THE NCDEQ INSPECTOR TO REQUEST AN INSPECTION AND OBTAIN APPROVAL TO REMOVE TEMPORARY MEASURES. DO NOT REMOVE ANY TEMPORARY MEASURES WITHOUT PRIOR NCDEQ INSPECTOR APPROVAL.
- ONCE ALL WATERLINE CONSTRUCTION IS COMPLETED, THE CONTRACTOR SHALL PROVIDE PERMANENT SEEDING WHERE TEMPORARY MEASURES HAVE BEEN REMOVED AND GROUND COVER IS NOT ADEQUATE.
- ONCE THE WATERLINE CONSTRUCTION IS COMPLETE, TEMPORARY MEASURES ARE REMOVED, THE SITE IS STABILIZED, THE CONTRACTOR SHALL CALL NCDEQ INSPECTOR TO SCHEDULE A FINAL INSPECTION. FULL STABILIZATION ON THE ENTIRE SITE IS REQUIRED IN ORDER TO OBTAIN A CERTIFICATE OF OCCUPANCY.
- ONCE THE FINAL INSPECTION IS APPROVED, CLOSE THE SEDIMENTATION & EROSION CONTROL PERMIT AND OBTAIN A CERTIFICATE OF COMPLETION FROM NCDEQ.

THE NCDEQ INSPECTOR ASSIGNED TO THIS PROJECT IS:
 NAME: TBD
 EMAIL ADDRESS: TBD
 PHONE #: 919.791.4200

EROSION CONTROL NOTES

- REFER TO GENERAL NOTES.
- THE CONTRACTOR SHALL INSTALL EROSION CONTROL MEASURES AS SHOWN ON THE APPROVED CONSTRUCTION DOCUMENTS, BUT MAY ADJUST AS NECESSARY BASED ON FIELD CONDITIONS. HOWEVER, ANY DEVIATIONS FROM THE APPROVED EROSION CONTROL PLAN SHALL BE APPROVED BY NCDEQ.
- THE CONTRACTOR SHALL MAINTAIN EROSION CONTROL MEASURES FOR THE LIFE OF THE PROJECT AND SHALL ENSURE THEY ARE CONTINUALLY IN GOOD WORKING CONDITION.
- THE CONTRACTOR SHALL ENSURE GRADING OPERATIONS ARE PERFORMED IN A MANNER THAT DO NOT ALLOW ANY SEDIMENT OUTSIDE OF THE PROJECT LIMITS OR OFF-SITE. THE CONTRACTOR SHALL BE RESPONSIBLE FOR THE PROMPT REMOVAL OF ANY MUD, SOILS AND CONSTRUCTION RELATED MATERIALS DEPOSITED UPON THE SURFACES OF THE PUBLIC RIGHT-OF-WAY.
- THE CONTRACTOR SHALL BE RESPONSIBLE FOR PERFORMING ALL SELF-INSPECTIONS AND SELF-MONITORING IN ACCORDANCE WITH CONDITIONS OF NPDES PERMIT NO. NCG010000 AND NORTH CAROLINA GENERAL STATE 113A-54.1(e) AND 15A NCAC 04B .0131 AND SHALL COMPLETE THE REQUIRED SELF-INSPECTION FORM FOUND ON THE DEMLR WEBSITE (<http://deq.nc.gov/about/divisions/energy-mineral-and-resources/erosion-sediment-control/forms>)
- SELF-INSPECTIONS FOR EROSION AND SEDIMENTATION CONTROL MEASURES ARE TO BE PERFORMED AT LEAST ONCE EVERY SEVEN CALENDAR DAYS AND WITHIN 24 HOURS OR EVERY RAIN EVENT GREATER THAN 0.5 INCH. ANY NECESSARY REPAIRS SHALL BE MADE IMMEDIATELY TO MAINTAIN MEASURES AS DESIGNED. ALL ESC MEASURES SHALL BE MAINTAINED AS SPECIFIED IN THE CONSTRUCTION DETAILS ON THIS PLAN. A RAIN GAUGE SHALL BE INSTALLED AT THE PROJECT SITE FOR MONITORING.
- THE CONTRACTOR SHALL BE RESPONSIBLE FOR OBTAINING ANY AND ALL NECESSARY PERMITS ASSOCIATED WITH OFF-SITE BORROW SOURCES, IF NEEDED.
- THE FOLLOWING MUST BE KEPT ON SITE UNTIL THE E&S PLAN HAS BEEN CLOSED OUT BY LAND QUALITY: PREVIOUS 30 DAYS OF SELF INSPECTION REPORTS, RAIN GAUGE, APPROVAL CERTIFICATE/LETTER, APPROVED PLAN, AND NPDES PERMIT. THESE ITEMS SHOULD BE LOCATED IN AN ACCESSIBLE PERMIT BOX NEAR THE MAIN CONSTRUCTION ENTRANCE. FAILURE TO MAINTAIN THESE ON SITE VIOLATES THE NPDES PERMIT.
- THE CONTRACTOR SHALL BE RESPONSIBLE FOR CONTROLLING DUST POLLUTION FROM LEAVING THE PROJECT LIMITS.
- CONCRETE DUST/WASTE/WASTEWATER MUST BE CLEANED OFF THE ROADWAY BY DRY SWEEPING METHODS ONLY. WATER MUST NOT BE USED TO WASH SEDIMENT OFF OF ROADS, DRIVEWAYS, OR PARKING LOTS.
- THE CONTRACTOR SHALL NOT REMOVE ANY EROSION CONTROL MEASURES IN ANY PHASE OF CONSTRUCTION PRIOR TO APPROVAL BY THE NCDEQ INSPECTOR.
- NO ON-SITE FUEL STORAGE SHALL BE LOCATED WITHIN 50' OF ANY EXISTING OR PROPOSED STORM DRAINAGE INLET. THE CONTRACTOR SHALL BE RESPONSIBLE FOR ALL PERMITTING, SAFETY MEASURES AND APPROVALS NEEDED FOR ON-SITE FUEL STORAGE.
- THE CONTRACTOR SHALL BE RESPONSIBLE FOR APPLYING ALL GROUND COVER PER CONDITIONS OF THE NPDES PERMIT OR IN CRITICAL AREAS, AT THE END OF THE DAY.

PROPOSED DISTURBED AREA = 1.2 AC

NARRATIVE

THIS PROPOSED PROJECT IS THE CONSTRUCTION OF A PUBLIC WATERLINE ALONG SURRETT DRIVE TO SERVE THE PROPOSED TRINITY MIDDLE SCHOOL PROJECT.

EROSION CONTROL MEASURES INCLUDE GRAVEL CHECK DAMS AND WATTLE CHECK DAMS.

THE CONTRACTOR SHALL FAITHFULLY MAINTAIN ALL SEDIMENTATION AND EROSION CONTROL MEASURES THROUGHOUT THE PROJECT. ADDITIONAL MEASURES MAY BE REQUIRED BY NCDEQ LAND QUALITY SECTION, IF WARRANTED.

GRADING & DRAINAGE NOTES

- REFER TO GENERAL NOTES.
- COMPACTION OF SOILS SHALL BE PERFORMED IN ACCORDANCE WITH NCDOT STANDARDS AND SPECIFICATIONS AND/OR RECOMMENDATIONS OF A LICENSED GEOTECHNICAL ENGINEER.
- THE CONTRACTOR SHALL BE RESPONSIBLE FOR CONSTRUCTING AND GRADING ALL PROPOSED IMPROVEMENTS IN A MANNER THAT ALLOWS FOR POSITIVE DRAINAGE AWAY FROM THE BUILDING. PONDING WATER ANYWHERE ON SITE IS PROHIBITED.
- ALL NEW GRADING SHALL MEET EXISTING GRADES WITH SMOOTH TRANSITIONS.
- EXISTING STORM DRAINAGE AND EXISTING UTILITIES ARE APPROXIMATE. THE CONTRACTOR SHALL FIELD LOCATE ALL UTILITIES AND STORM DRAINAGE PRIOR TO MOBILIZATION AND REPORT THE RESULTS TO THE OWNER'S REPRESENTATIVE.
- NO STATEMENT IS MADE OR IMPLIED THAT THE ON-SITE GRADING AND EARTHWORK INDICATED ON THESE DRAWINGS IS BALANCED.
- THE CONTRACTOR SHALL BE RESPONSIBLE FOR ADJUSTING ALL EXISTING STRUCTURES WITHIN THE PROJECT LIMITS TO MATCH THE ADJACENT GRADE.

EROSION CONTROL MAINTENANCE CONTACT INFORMATION

RANDOLPH COUNTY SCHOOL SYSTEM
 2222-C SOUTH FAYETTEVILLE STREET
 ASHEBORO, NC 27205
 ATTN: MARY TROTTER, ASSISTANCE SUPERINTENDENT
 OPERATIONS DIVISION
 EMAIL: MTROTTER@RANDOLPH.K12.NC.US
 PHONE: 336.633.5183
 FAX: 336.663.5155

GENERAL NOTES

- ALL MATERIALS AND METHODS OF CONSTRUCTION SHALL CONFORM WITH DAVIDSON WATER, INC AND NCDOT STANDARDS AND SPECIFICATIONS.
- EXISTING BOUNDARY, TOPOGRAPHY, AND EXISTING CONDITIONS TAKEN FROM SURVEY PROVIDED BY NCDOT.
- THE CONTRACTOR SHALL BE RESPONSIBLE FOR CONTACTING, COORDINATING, AND PAYMENT FOR ALL NECESSARY LOCATING SERVICES INCLUDING INDEPENDENT LOCATING SERVICES. THE CONTRACTOR SHALL HAVE ALL EXISTING UTILITIES LOCATED AT LEAST 48 HOURS PRIOR TO BEGINNING DEMOLITION, EXCAVATION, OR ANY OTHER FORM OF CONSTRUCTION. THE CONTRACTOR SHALL IMMEDIATELY NOTIFY THE OWNERS REPRESENTATIVES OF ANY DISCREPANCIES OR CONFLICTS.
- ALL SUB-SURFACE UTILITIES IDENTIFIED ON THESE CONSTRUCTION DOCUMENTS ARE SHOWN IN THEIR APPROXIMATE LOCATION BASED ON SURVEY INFORMATION, FIELD OBSERVATIONS, AND OTHER RECORD DRAWINGS WHICH MAY BE AVAILABLE. THESE DRAWINGS DO NOT NECESSARILY SHOW ALL EXISTING UTILITIES. THE CONTRACTOR SHALL BE RESPONSIBLE FOR FIELD VERIFYING ALL UTILITIES.
- EXISTING IMPROVEMENTS DAMAGED OR DESTROYED BY THE CONTRACTOR DURING CONSTRUCTION SHALL BE RESTORED OR REPLACED TO ORIGINAL CONDITION AND TO THE SATISFACTION OF THE OWNER'S REPRESENTATIVE AT THE CONTRACTOR'S EXPENSE.
- THE CONTRACTOR SHALL BE RESPONSIBLE FOR OBTAINING AND COORDINATING INSPECTIONS, CERTIFICATIONS, AND OTHER REQUIREMENTS WHICH MUST BE MET UNDER THIS CONTRACT.
- THE CONTRACTOR SHALL MAINTAIN AS-BUILT DRAWINGS TO RECORD THE ACTUAL LOCATION OF ALL PIPING PRIOR TO CONCEALMENT. DRAWINGS WILL BE PROVIDED TO THE OWNER'S REPRESENTATIVE AT REGULAR INTERVALS THROUGHOUT THE PROJECT FOR RECORD KEEPING AND AT THE CONCLUSION OF CONSTRUCTION.
- IF DEPARTURES FROM THE PROJECT DRAWINGS OR SPECIFICATIONS ARE DEEMED NECESSARY BY THE CONTRACTOR, DETAILS OF SUCH DEPARTURES AND REASONS THERE FOR SHALL BE SUBMITTED TO THE OWNER'S REPRESENTATIVE FOR REVIEW. NO DEPARTURES FROM THE CONTRACT DOCUMENTS SHALL BE MADE WITHOUT THE EXPRESS WRITTEN PERMISSION OF THE OWNER'S REPRESENTATIVE.
- THE CONTRACTOR SHALL BE RESPONSIBLE FOR THE RELOCATION OF ANY EXISTING UTILITY INFRASTRUCTURE REQUIRED TO COMPLETE ANY PORTION OF CONSTRUCTION. THE CONTRACTOR SHALL ALSO BE RESPONSIBLE FOR THE COORDINATION AND COSTS OF ASSOCIATED WORK.
- THE CONTRACTOR SHALL BE RESPONSIBLE FOR KEEPING THE PREMISES FREE FROM ACCUMULATION OF WASTE MATERIALS AND RUBBISH CAUSED BY THE CONTRACTOR. ALL DEBRIS SHALL BE REMOVED FROM THE PROJECT SITE ON A DAILY BASIS.
- THE CONTRACTOR SHALL BE RESPONSIBLE FOR PROVIDING ALL REQUIRED TRAFFIC CONTROL MEASURES IN COMPLIANCE WITH NCDOT STANDARDS AND SPECIFICATIONS.
- THE CONTRACTOR SHALL NOT INTERRUPT UTILITY SERVICES TO ANY OF THE ADJACENT PROPERTIES WITHOUT PRIOR NOTICE, COORDINATION, AND APPROVAL BY THE APPROPRIATE AUTHORITY HAVING JURISDICTION.
- THE CONTRACTOR SHALL NOT INTERRUPT ACCESS TO PROPERTIES WITHOUT PRIOR NOTICE AND COORDINATION.
- THE CONTRACTOR SHALL NOT STORE VEHICLES, EQUIPMENT, AND/OR CONSTRUCTION RELATED MATERIALS WITHIN THE PUBLIC RIGHT-OF-WAY.
- THE CONTRACTOR SHALL NOT BEGIN ANY CONSTRUCTION WORK ASSOCIATED WITH THE OFF-SITE WATERLINE EXTENSION UNTIL ALL REQUIRED PERMITS ARE IN HAND AND ALL REQUIRED EASEMENTS HAVE BEEN SECURED.
- THE ENGINEER AND/OR OWNER DISCLAIM ANY ROLE IN THE CONSTRUCTION MEANS AND/OR METHODS ASSOCIATED WITH THE PROJECT AS SET FORTH IN THESE PLANS.

SITE DEMOLITION PLAN NOTES

- REFER TO GENERAL NOTES.
- THE CONTRACTOR SHALL BE RESPONSIBLE FOR PROVIDING APPROPRIATE SIGNAGE AND MEASURES TO SECURE THE CONSTRUCTION SITE AND MAINTAIN SAFETY FOR ALL PARTIES.
- THE CONTRACTOR SHALL REMOVE CONCRETE (WHERE REQUIRED) TO THE FIRST COLD JOINT OR SAW CUT TO OBTAIN A CLEAN EDGE.
- THE CONTRACTOR SHALL SAW CUT ASPHALT (WHERE REQUIRED) TO OBTAIN A CLEAN EDGE.
- THE CONTRACTOR SHALL BE RESPONSIBLE FOR REMOVING EVERYTHING WITHIN THE CLEARING LIMITS INCLUDING TREES, STUMPS, TRASH, ETC. THE CONTRACTOR SHALL BE RESPONSIBLE FOR THE REMOVAL AND REPLACEMENT OF ALL PERMANENT FEATURES IN CONFLICT WITH THE PROPOSED IMPROVEMENTS INCLUDING BUT NOT LIMITED TO SIGNS, FENCES, AND MAILBOXES.
- CLEANOUTS AND WATER VALVES LOCATED IN AREAS OF DEMOLITION OR SUBSEQUENT CONSTRUCTION SHALL BE PROTECTED FROM DAMAGE AND ADJUSTED TO BE FLUSH WITH NEW GRADE.
- CLEAN SOILS SHALL BE UTILIZED FOR BACKFILL. COMPACTION OF THESE SOILS SHALL BE PERFORMED IN ACCORDANCE WITH THE RECOMMENDATIONS OF A GEOTECHNICAL ENGINEER.
- ALL ITEMS DESIGNATED TO BE REMOVED SHALL BE REMOVED COMPLETELY, INCLUDING ALL SUBGRADE MATERIALS DIRECTLY ASSOCIATED WITH ITEMS TO BE REMOVED.
- ANY MATERIALS REMOVED AS PART OF DEMOLITION FOR THIS PROJECT SHALL BE PROPERLY DISPOSED OF OFF-SITE IN ACCORDANCE WITH ALL FEDERAL, STATE, AND LOCAL LAWS.
- THE CONTRACTOR SHALL BE RESPONSIBLE FOR PROVIDING ALL NECESSARY TEMPORARY SHORING AND STRUCTURAL STABILIZATION. THESE PLANS DO NOT PROVIDE ANY STRUCTURAL ENGINEERING RECOMMENDATIONS.
- THE CONTRACTOR SHALL BE RESPONSIBLE FOR PROVIDING APPROPRIATE TRAFFIC CONTROL MEASURES TO CONTROL CONSTRUCTION TRAFFIC IN AND OUT OF THE PROJECT SITE INCLUDING FLAGGERS.
- THE CONTRACTOR SHALL BE RESPONSIBLE FOR THE DISCONNECTION AND REMOVAL OF ALL INACTIVE INFRASTRUCTURE WITHIN THE AREA OF DEMOLITION.
- IF CONSTRUCTION MEANS AND METHODS REQUIRE ANY TEMPORARY PUBLIC LANE OR SIDEWALK CLOSURES, THE CONTRACTOR SHALL BE RESPONSIBLE FOR OBTAINING ALL NECESSARY PERMITS FROM NCDOT.

UTILITY NOTES

- REFER TO GENERAL NOTES.
- EXISTING UTILITIES IN CONFLICT WITH PROPOSED IMPROVEMENTS SHALL BE REMOVED OR RELOCATED.
- THIS PLAN IS DIAGRAMMATIC AND REPRESENTS THE APPROXIMATE LOCATION OF UTILITIES UNLESS SPECIFICALLY DIMENSIONED. THE CONTRACTOR SHALL COORDINATE THE ACTUAL AND PROPOSED LOCATION OF UTILITIES TO AVOID CONFLICTS.
- THE CONTRACTOR SHALL BE RESPONSIBLE FOR ADJUSTING ALL EXISTING UTILITY STRUCTURES (MANHOLES, VALVES, METER BOXES, ETC.) WITHIN THE PROJECT LIMITS TO MATCH THE ADJACENT GRADE.
- ALL UTILITY RELOCATIONS SHOWN ARE SCHEMATICALLY DRAWN. THE CONTRACTOR SHALL BE RESPONSIBLE FOR THE COORDINATION AND RELOCATION OF THE LINES IN A MANNER THAT CONFORMS WITH ALL APPLICABLE LOCATION, SEPARATION AND DEPTH REQUIREMENTS.

ALL WATERLINE CONSTRUCTION SHALL CONFORM WITH DAVIDSON WATER, INC. STANDARDS AND SPECIFICATIONS. ALL CONSTRUCTION INSIDE OF THE PUBLIC RIGHT-OF-WAY SHALL COMPLY WITH NCDOT STANDARDS AND SPECIFICATIONS.

REFER TO SHEET C-001 FOR PROJECT AND SHEET RELATED NOTES. REFER TO SHEET C-002 FOR DAVIDSON WATER NOTES.

**smith
sinnett**
ARCHITECTURE

T 919 781 8882

4600 Lake Boone Trail
Suite 205
Raleigh, NC 27607

info@smithsinnett.com

grounded
ENGINEERING

4909 Liles Road
Raleigh, NC 27606
919.438.3694 (o)

Firm License C-3898



BID SET

This drawing and the design shown is the property of Smith Sinnett Architecture, P.A. The reproduction or use of this property without the written consent of the Architect is prohibited. Any arrangement for the reproduction of this drawing must be returned to the Architect at the completion of the contract.
 Smith Sinnett Architecture, P.A. 2019

THIS DRAWING IS FORMATTED TO BE PRINTED ON A 24" X 36" SHEET

NEW TRINITY MIDDLE SCHOOL
 RANDOLPH COUNTY SCHOOL SYSTEM

PARCEL PIN 7708118367
 SURRETT DRIVE
 TRINITY, NC 27370

KEY PLAN
 NO SCALE



ID	DATE	DESCRIPTION
1	06.14.19	REV. PER REVIEW

DRAWN BY: SAD
 CHECKED BY: SAD

SITE NOTES



Know what's below.
 Call before you dig.

2017027

20 MAY 2019

C0-01

GENERAL MATERIAL SPECIFICATIONS

ALL MATERIALS MUST MEET OR EXCEED AWWA STANDARDS

All the parts/components that come in contact with water must meet NSF 61/NSF 372 (new lead free requirements).

- 1. Pipe; SDR 17 Lengths 20' Max. 2", 3". Pipe must have NSF/PW seal stamped on it.
2. Pipe; SDR 21 Lengths 20' Max. 2", 3", 4". Pipe must have NSF/PW seal stamped on it.
3. Pipe; Ductile Iron P.C. 350 6", 8", 10", 12", 16".
4. Valves; AWWA Standard specifications. Valves shall open left, non-rising stem. 200 PSI working pressure iron body, resilient seat gate valve 2", 3", 4", 6", 8", Mueller, M & H, American Darling, Kennedy.
5. Fire Hydrants; AWWA Type Dry Top National Standard, Traffic type. 4 1/2" valve opening, 1 1/2" pent., two 2 1/2" openings, one 4 1/2" opening, bronze to bronze seat, yellow barrel, red bonnet caps, not less than 3' 6" bury, open left. Mueller, Super Centurion 200, M & H #129, American Darling, MARK 73-1, Kennedy, K81A. AWWA C502
6. Fittings; Ductile Iron Push on, M.J. All fire hydrants shall branch off with hydrant tee and and most stub outs.
7. All MIPX Bell Adapters 2" and 3" shall be Harco.
8. All threaded pipe (nipples etc.) shall be brass 2" and 3".
9. Valve boxes 5 1/4" cast iron with WATER written on the lid, screw type.
10. Meter box plastic 12" deep Brooks #1419-12, Jones, Meter box lid, solid cast iron 15 lb. min.
11. Linesetter; Ford LSVBHH41-233W, Mueller B-2418F-2A with H-14222 and H-14227 end pieces.
12. Tubing; Type K Copper ASTM B-88.
13. Corporation stops; Ford F-1000, Mueller H-15008.
14. Service saddles; Muller H-134, Ford S70, CC Threads.
15. Tapping sleeves Stainless Steel, full rubber back, JCM, Romac-SST, Ford, Smith-Blair.

03/7/16

6

ENGINEER'S NOTES

- 1. Minimum 3 feet cover on water lines, a maximum of 4 feet. (SEE TRENCH SECTION AND LINESSETTER INSTALLATION TYPICAL)
2. Water line shall be placed at least 3 feet from edge of pavement but no greater than 5 feet from edge of pavement. (SEE TRENCH SECTION AND LINESSETTER INSTALLATION TYPICAL)
3. Special care should be take at cul-de-sacs to keep the water line the proper distance from the pavement. (SEE CUL-DE-SAC TYPICAL)
4. Water lines 6" and over shall be Ductile Iron.
5. The developer is responsible for the installation of taps or encasements on the long side when the subsurface of the roadway cannot be bored. (SEE SERVICE ENCASEMENT TYPICALS)
6. The maximum distance for a 2" line is 500'. The maximum number of taps on a 2" line is 6. (SEE CUL-DE-SAC TYPICAL)
7. Minimum fire flow shall be 500 gallons per minute at 30 P.S.I.
8. Water mains running under the pavement are to be Ductile Iron.
9. Fire Hydrants shall be spaced no more than 900 feet apart (SOME TYPES OF DEVELOPMENTS MAY REQUIRE CLOSER SPACING).
10. At all creek crossings where the water line is run through or under the creek, there shall be 5 foot cover and steel encasement pipe, D.I. used as a carrier.
11. All lines, smaller than 6", with a pressure of 100 psi (static or dynamic) or greater, shall be constructed of ductile iron. (TYPE OF MATERIAL SHALL BE DETERMINED BY DAVIDSON WATER, INC.)
12. Provide Davidson Water, Inc. with a digital copy of the street/water line layout.
13. Before Engineer writes letter for verification of construction, Davidson Water, Inc. Waterline Representative, Engineer or agent and contractor, shall perform a final inspection.

03/07/16

7

INSTALLATION SPECIFICATIONS

- 1. Work to be performed shall consist of furnishing and installing complete and ready for service all water main and appurtenances in accordance with the contract plans and specifications. Prior to commencing work, the Contractor will provide 2 working days notice to Davidson Water Inc., NCDOT, and all other appropriate utility companies.
2. Trench excavation in rock shall be a minimum of 2 feet wider than the nominal pipe diameter. Excavation shall be 6" below the proposed invert of the PVC pipe and backfilled(cushioned) with clean soil or sand.
3. Backfill along sides and immediately over pipe by hand. Backfill material around pipe shall be free of rocks and other debris. Trench backfill under existing or proposed paving and road shoulders shall be compacted to a density of 95 percent of maximum dry density.
4. Encasement pipe shall be installed by dry boring and jacking. Casing diameter, length, and wall thickness shall be as shown on plans. Materials and workmanship in the existing or proposed NCDOT right of way shall conform to NCDOT standards and specifications. The contractor making the bored crossing shall notify NCDOT prior to the start of work with enough notice for NCDOT to provide inspectors.
5. Water mains shall be laid at least 10 feet laterally from existing or proposed sanitary sewers. Water mains shall have a minimum of 18" vertical separation over sewer mains. Where this separation is not possible or the water main is laid under the sewer main, both the water and sewer pipe shall be ductile iron pipe. Center pipe spans at point of intersection in order to have 10 feet from water line joint to point of intersection.
6. Minimum cover for water mains shall be 36 inches. Maximum cover shall be 48 inches. Minimum trench width shall be pipe diameter plus 18 inches. (SEE TRENCH SECTION AND LINESSETTER TYPICAL)
7. All pipe shall be thoroughly cleaned of all earth material and rubbish before being placed in the trench. Bell holes will be dug at each joint. Pipe shall be placed on firm, smooth foundation to prevent subsequent settlement.
8. Concrete thrust blocking shall be constructed at all bends, tees, reducers, and dead ends and where conditions warrant. All fittings and accessories to be wrapped with polyethylene film prior to placing blocking. (SEE BLOCKING TYPICALS)
9. Hydrants shall be set plumb as indicated on the drawings with the pumper connection 18 inches above grade. The back of the hydrant, opposite the pipe connection, shall be firmly blocked against the vertical face of the trench with poured-in-place concrete to prevent the hydrant from blowing off the line. In fill areas or soils that are not solid hydrants shall be rodded or restrained by mega-lug using Ductile Iron pipe not PVC. Clean crushed stone or gravel shall be placed around the base of each hydrant above the supporting foundation and to within 12 inches of the ground line. Stone or gravel shall extend at least 10 inches away from the hydrant barrel in all directions. Hydrants shall be opened and flushed prior to pressure testing of the lines. SEE HYDRANT INSTALLATION TYPICAL)

03/7/16

8

- 10. Valve box assembly shall be set plumb, true and to grade. (SEE VALVE INSTALLATION TYPICAL)
11. All water mains shall be pressure tested with a test pressure at the high point of the main twice the working pressure or 200 PSI, whichever is greater. Test pressure shall be maintained for a minimum of 3 hours. Make up water shall not exceed the following amounts in gallons per 1000 feet of main: 2" line - .50, 3" line - 0.74, 4" line - 1.11, 6" line - 1.65, 8" line 2.22, 12" line-3.3, 16" line - 3.96 and 24" line - 5.97.
12. All water mains shall be flushed and disinfected prior to being put in service. Flushing shall be accomplished with sufficient water velocity (Minimum of 2.5 fps) to thoroughly clean the main. The mains shall be disinfected using a chlorine equal to or greater than 50 milligrams per liter (50 ppm). The chlorine solution shall remain in the mains for a minimum of 24 hours. Bacteriological test samples shall be taken by Davidson Water Inc. for evaluation and line disinfectant approval. After disinfection is complete, the new lines shall be flushed sufficiently so that the chlorine concentration level in the new lines do not exceed existing line concentration.
13. Water lines shall be placed at least 3 feet minimum from the edge of the pavement but no greater than 5 feet from the edge of the pavement. (SEE TRENCH SECTION AND LINESSETTER INSTALLATION TYPICAL)
14. Special care should be taken at cul-de-sacs to ensure water line is kept proper distance from the edge of the pavement. (SEE CUL-DE-SAC TYPICAL)
15. All tapping sleeves and valves shall be air tested at 150 P.S.I. for a minimum of 15 minutes. Testing is to take place before taps are made.

9

ALL WATERLINE CONSTRUCTION SHALL CONFORM WITH DAVIDSON WATER, INC. STANDARDS AND SPECIFICATIONS. ALL CONSTRUCTION INSIDE OF THE PUBLIC RIGHT-OF-WAY SHALL COMPLY WITH NCDOT STANDARDS AND SPECIFICATIONS.

REFER TO SHEET C-001 FOR PROJECT AND SHEET RELATED NOTES. REFER TO SHEET C-002 FOR DAVIDSON WATER NOTES.

smith sinnett ARCHITECTURE

T 919 781 8582


4600 Lake Boone Trail Suite 205 Raleigh, NC 27607

info@smithsinnett.com

grounded ENGINEERING

4909 Liles Road Raleigh, NC 27606 919.438.3694 (o)

Firm License C-3898

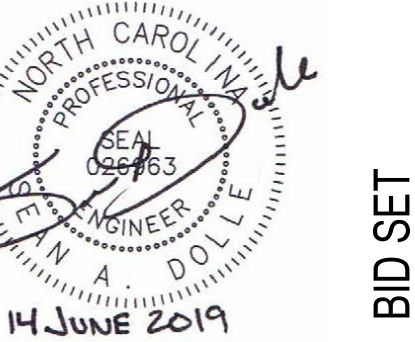

BID SET

This drawing and the design shown is the property of Smith Sinnett Architecture, P.A. the reproduction or use of this drawing without the written consent of the Architect is prohibited. Any arrangement for the reproduction of this drawing must be returned to the Architect at the completion of the contract. Smith Sinnett Architecture, P.A. 2019 THIS DRAWING IS FORMATTED TO BE PRINTED ON A 24" X 36" SHEET

NEW TRINITY MIDDLE SCHOOL RANDOLPH COUNTY SCHOOL SYSTEM

PARCEL PIN 7708118367 SURRETT DRIVE TRINITY, NC 27370

KEY PLAN NO SCALE



Table with 3 columns: ID, DATE, DESCRIPTION. Row 1: 1, 06.14.19, REV. PER REVIEW. Row 2: DRAWN BY: SAD. Row 3: CHECKED BY: SAD.

SITE NOTES

2017027 20 MAY 2019

C0-02



Know what's below. Call before you dig.

ALL WATERLINE CONSTRUCTION SHALL CONFORM WITH DAVIDSON WATER, INC. STANDARDS AND SPECIFICATIONS. ALL CONSTRUCTION INSIDE OF THE PUBLIC RIGHT-OF-WAY SHALL COMPLY WITH NCDOT STANDARDS AND SPECIFICATIONS.

REFER TO SHEET C-001 FOR PROJECT AND SHEET RELATED NOTES. REFER TO SHEET C-002 FOR DAVIDSON WATER NOTES.




T 919 781 882

4600 Lake Boone Trail
Suite 205
Raleigh, NC 27607

info@smithsinnett.com



4909 Liles Road
Raleigh, NC 27606
919.438.3694 (o)
Firm License C-3898


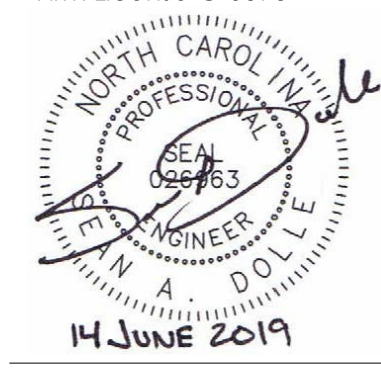


BID SET

This drawing and the design shown is the property of Smith Sinnett Architecture, P.A. The reproduction or use of this project without the written consent of the Architect is prohibited. Any arrangement to reproduce this drawing in any form or for any purpose other than that intended by the Architect must be returned to the Architect at the completion of the contract.

Smith Sinnett Architecture, P.A. 2019

THIS DRAWING IS FORMATTED TO BE PRINTED ON A 24" X 36" SHEET

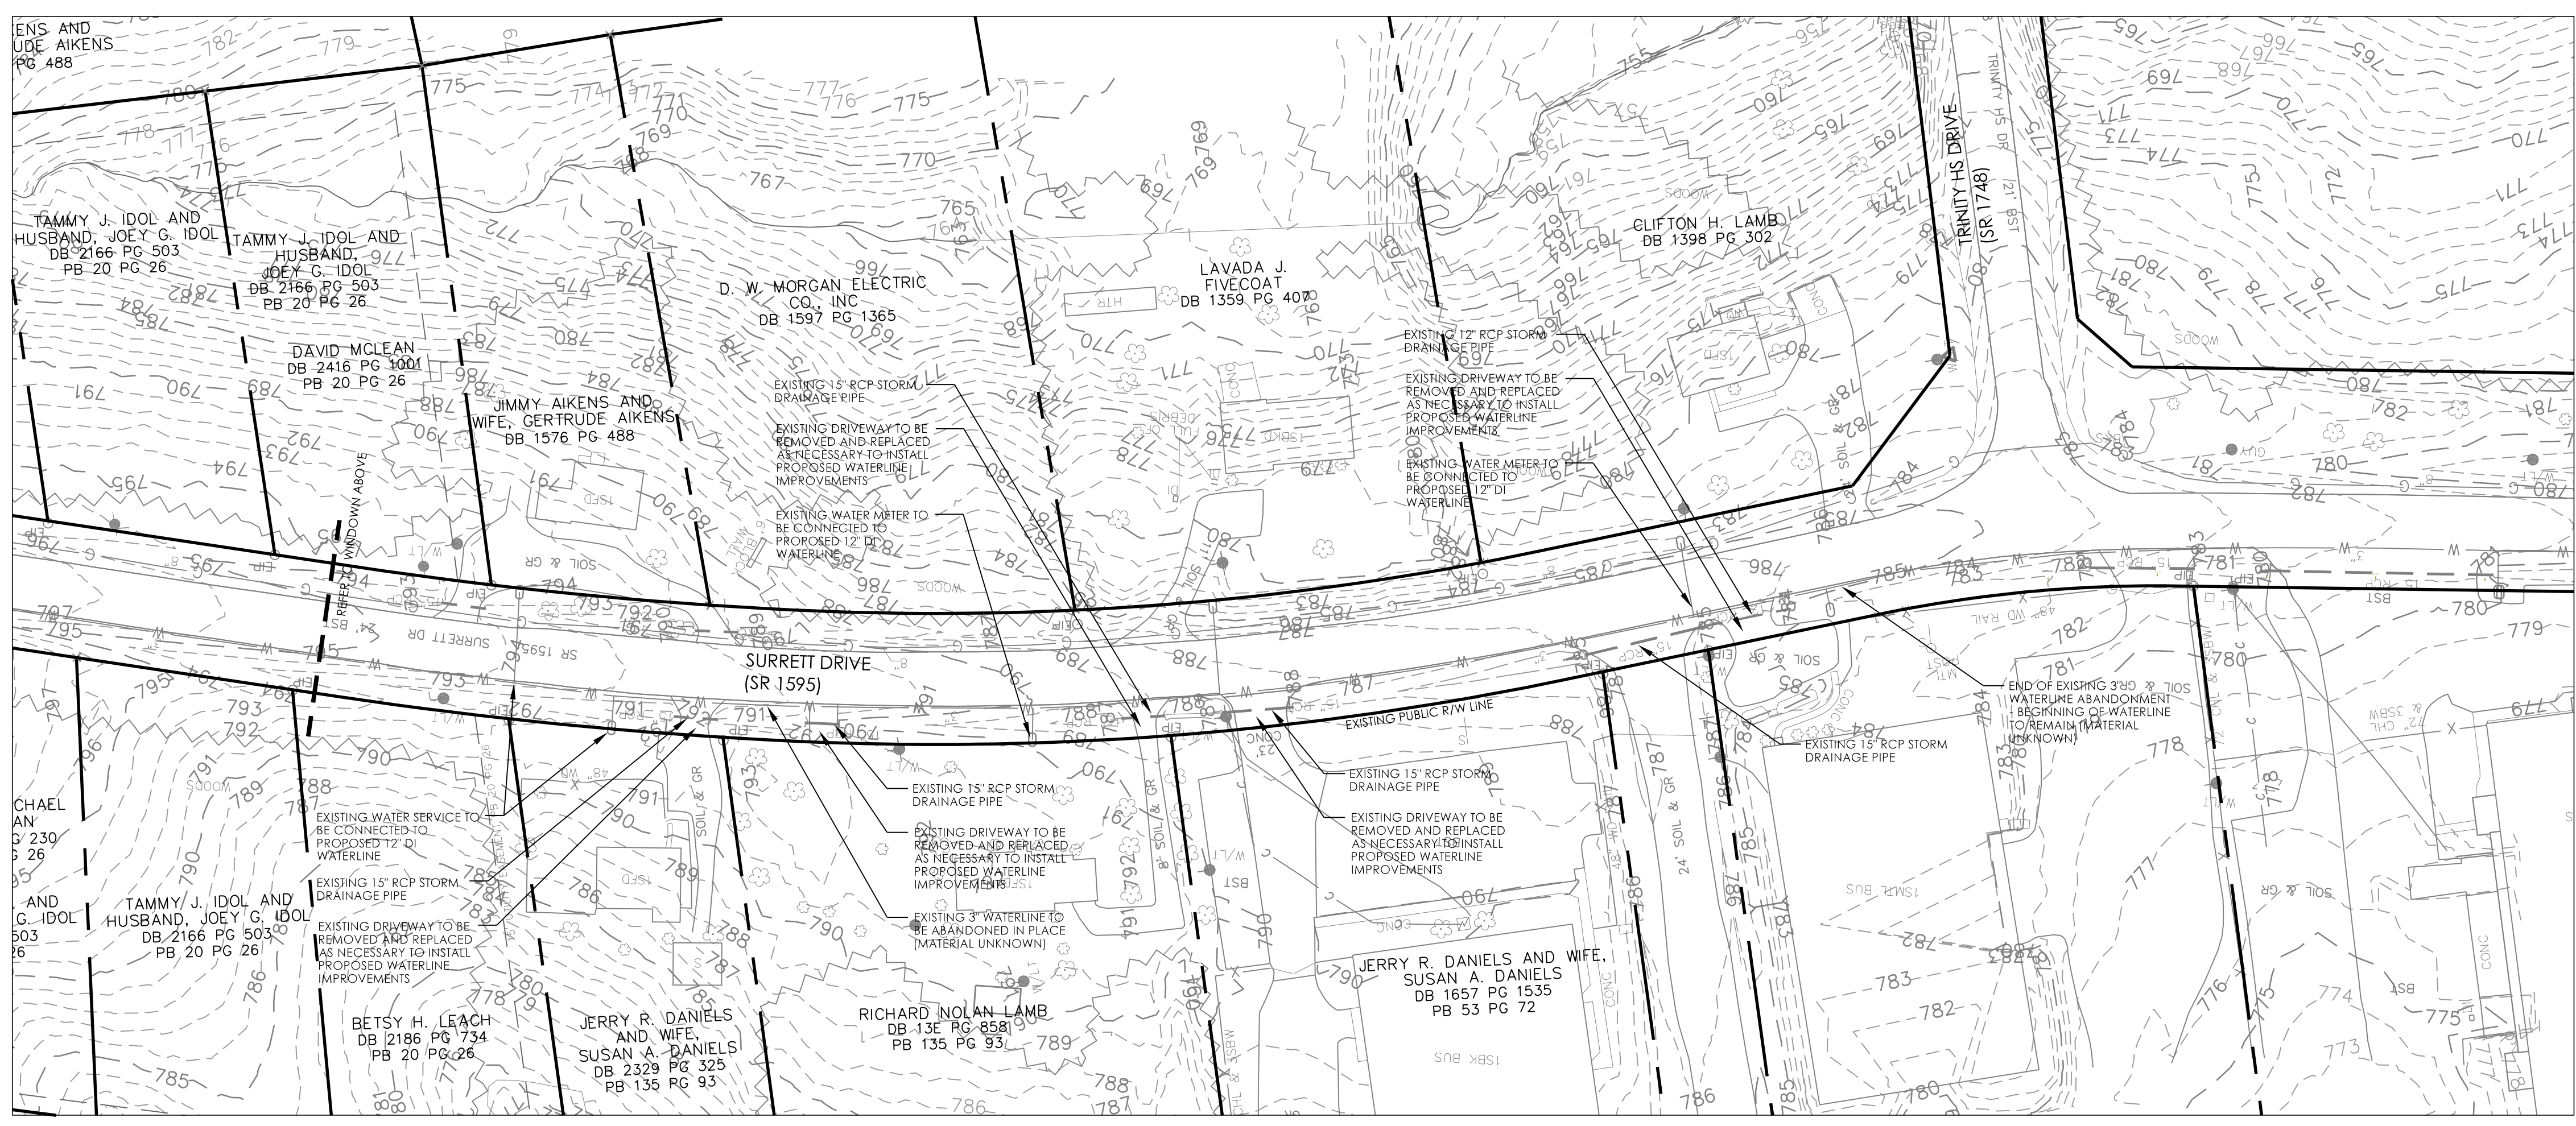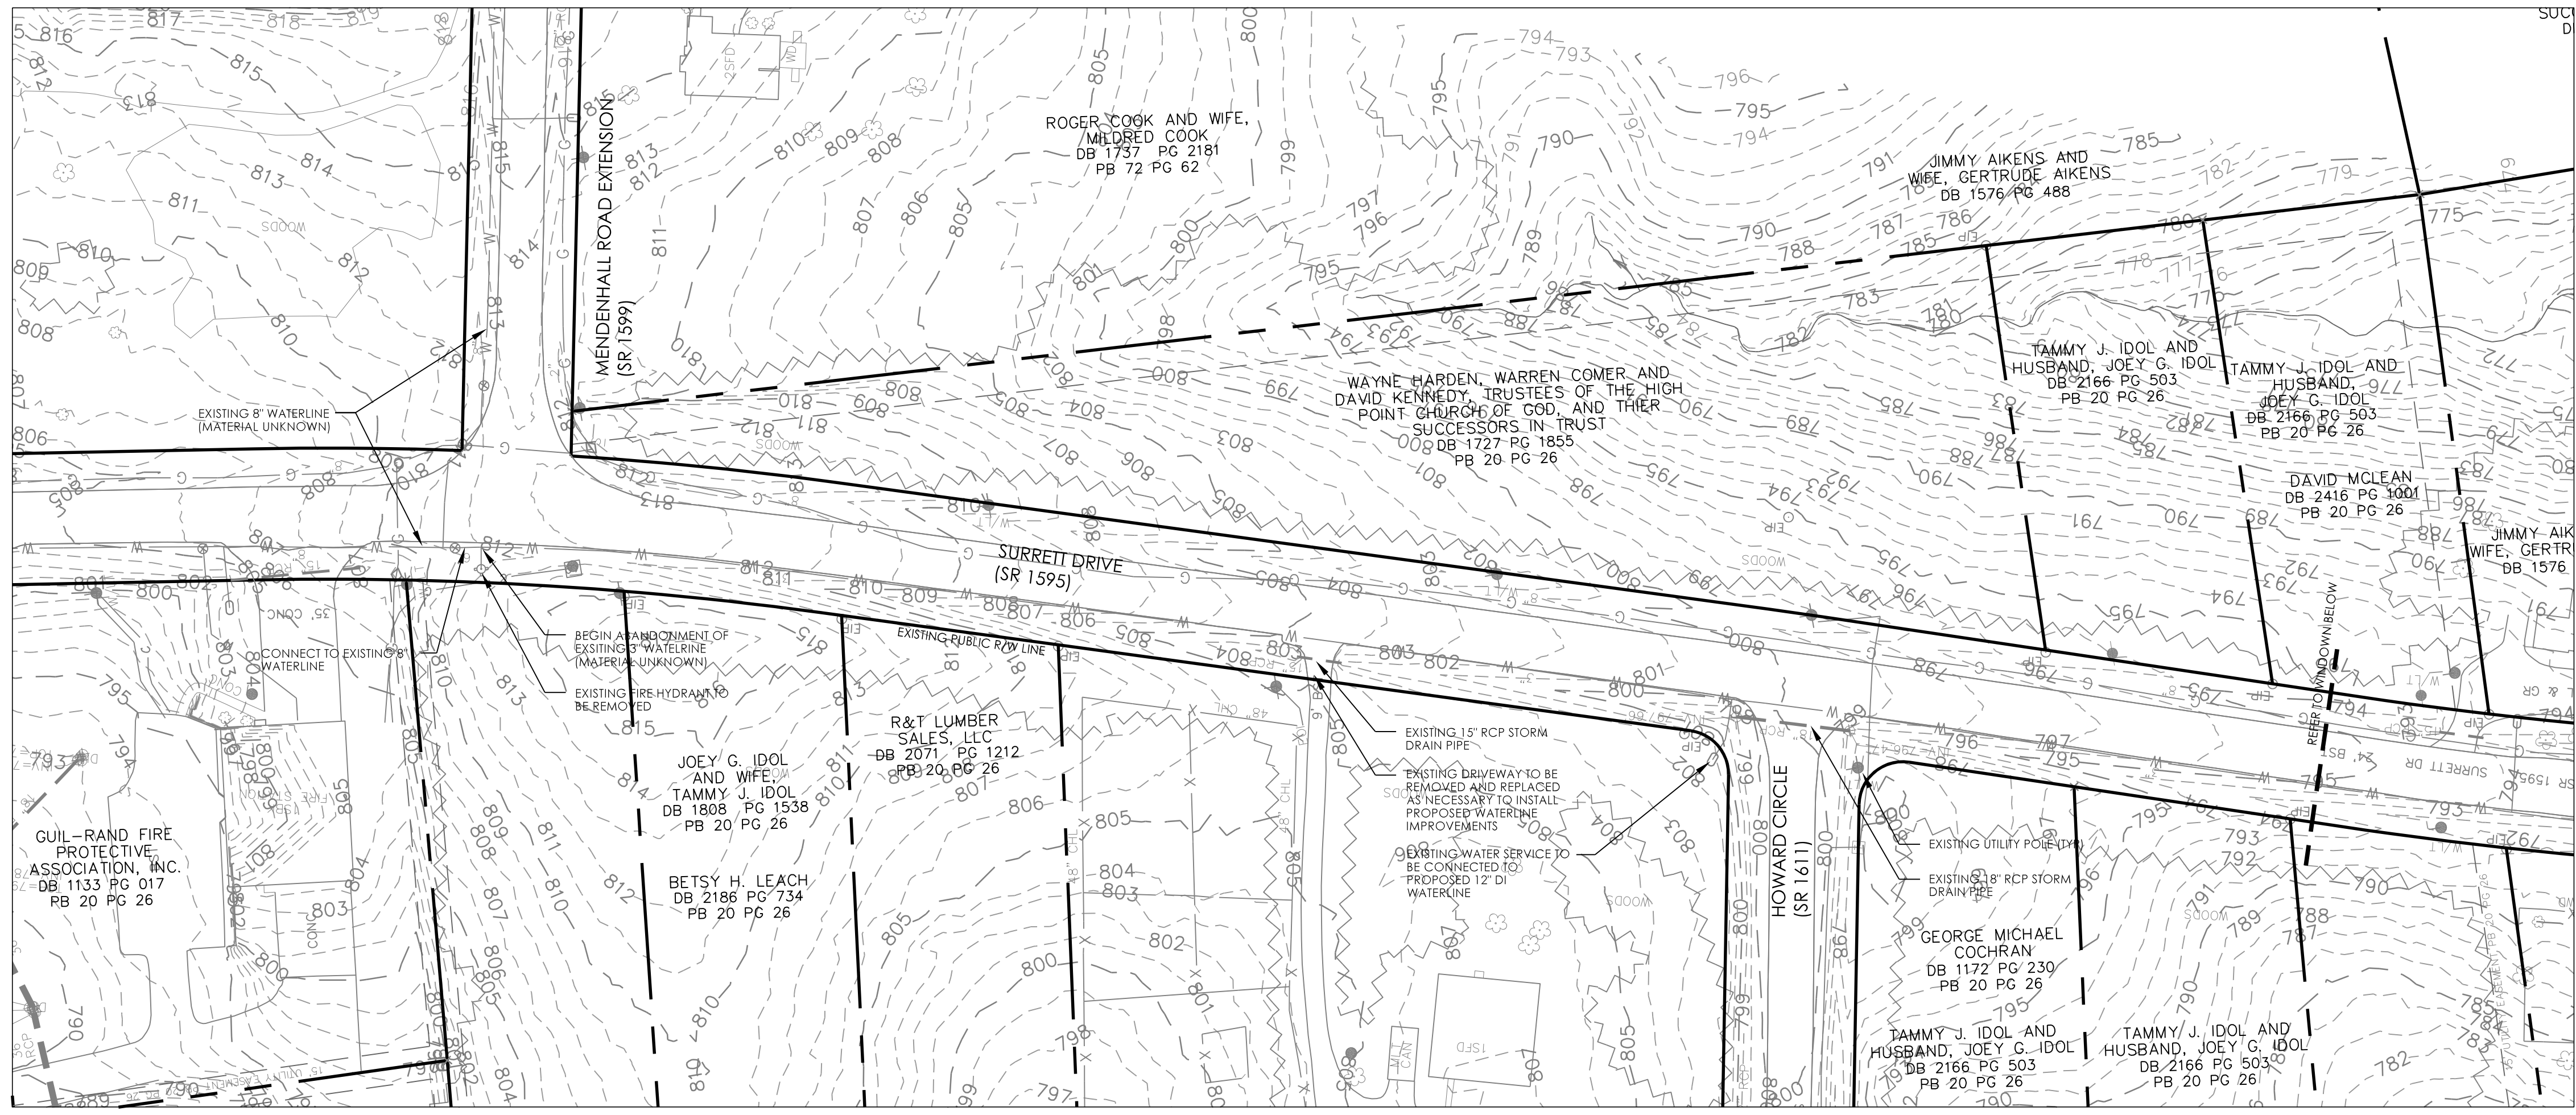

NEW TRINITY MIDDLE SCHOOL
RANDOLPH COUNTY SCHOOL SYSTEM

PARCEL PIN 7708118367
SURRETT DRIVE
TRINITY, NC 27370

KEY PLAN
NO SCALE

1	06.14.19	REV. PER REVIEW
ID	DATE	DESCRIPTION
DRAWN BY:		SAD
CHECKED BY:		SAD

OFFSITE
WATERLINE EX.
COND. & DEMO
PLAN



2017027 20 MAY 2019



Know what's below.
Call before you dig.



C1-00

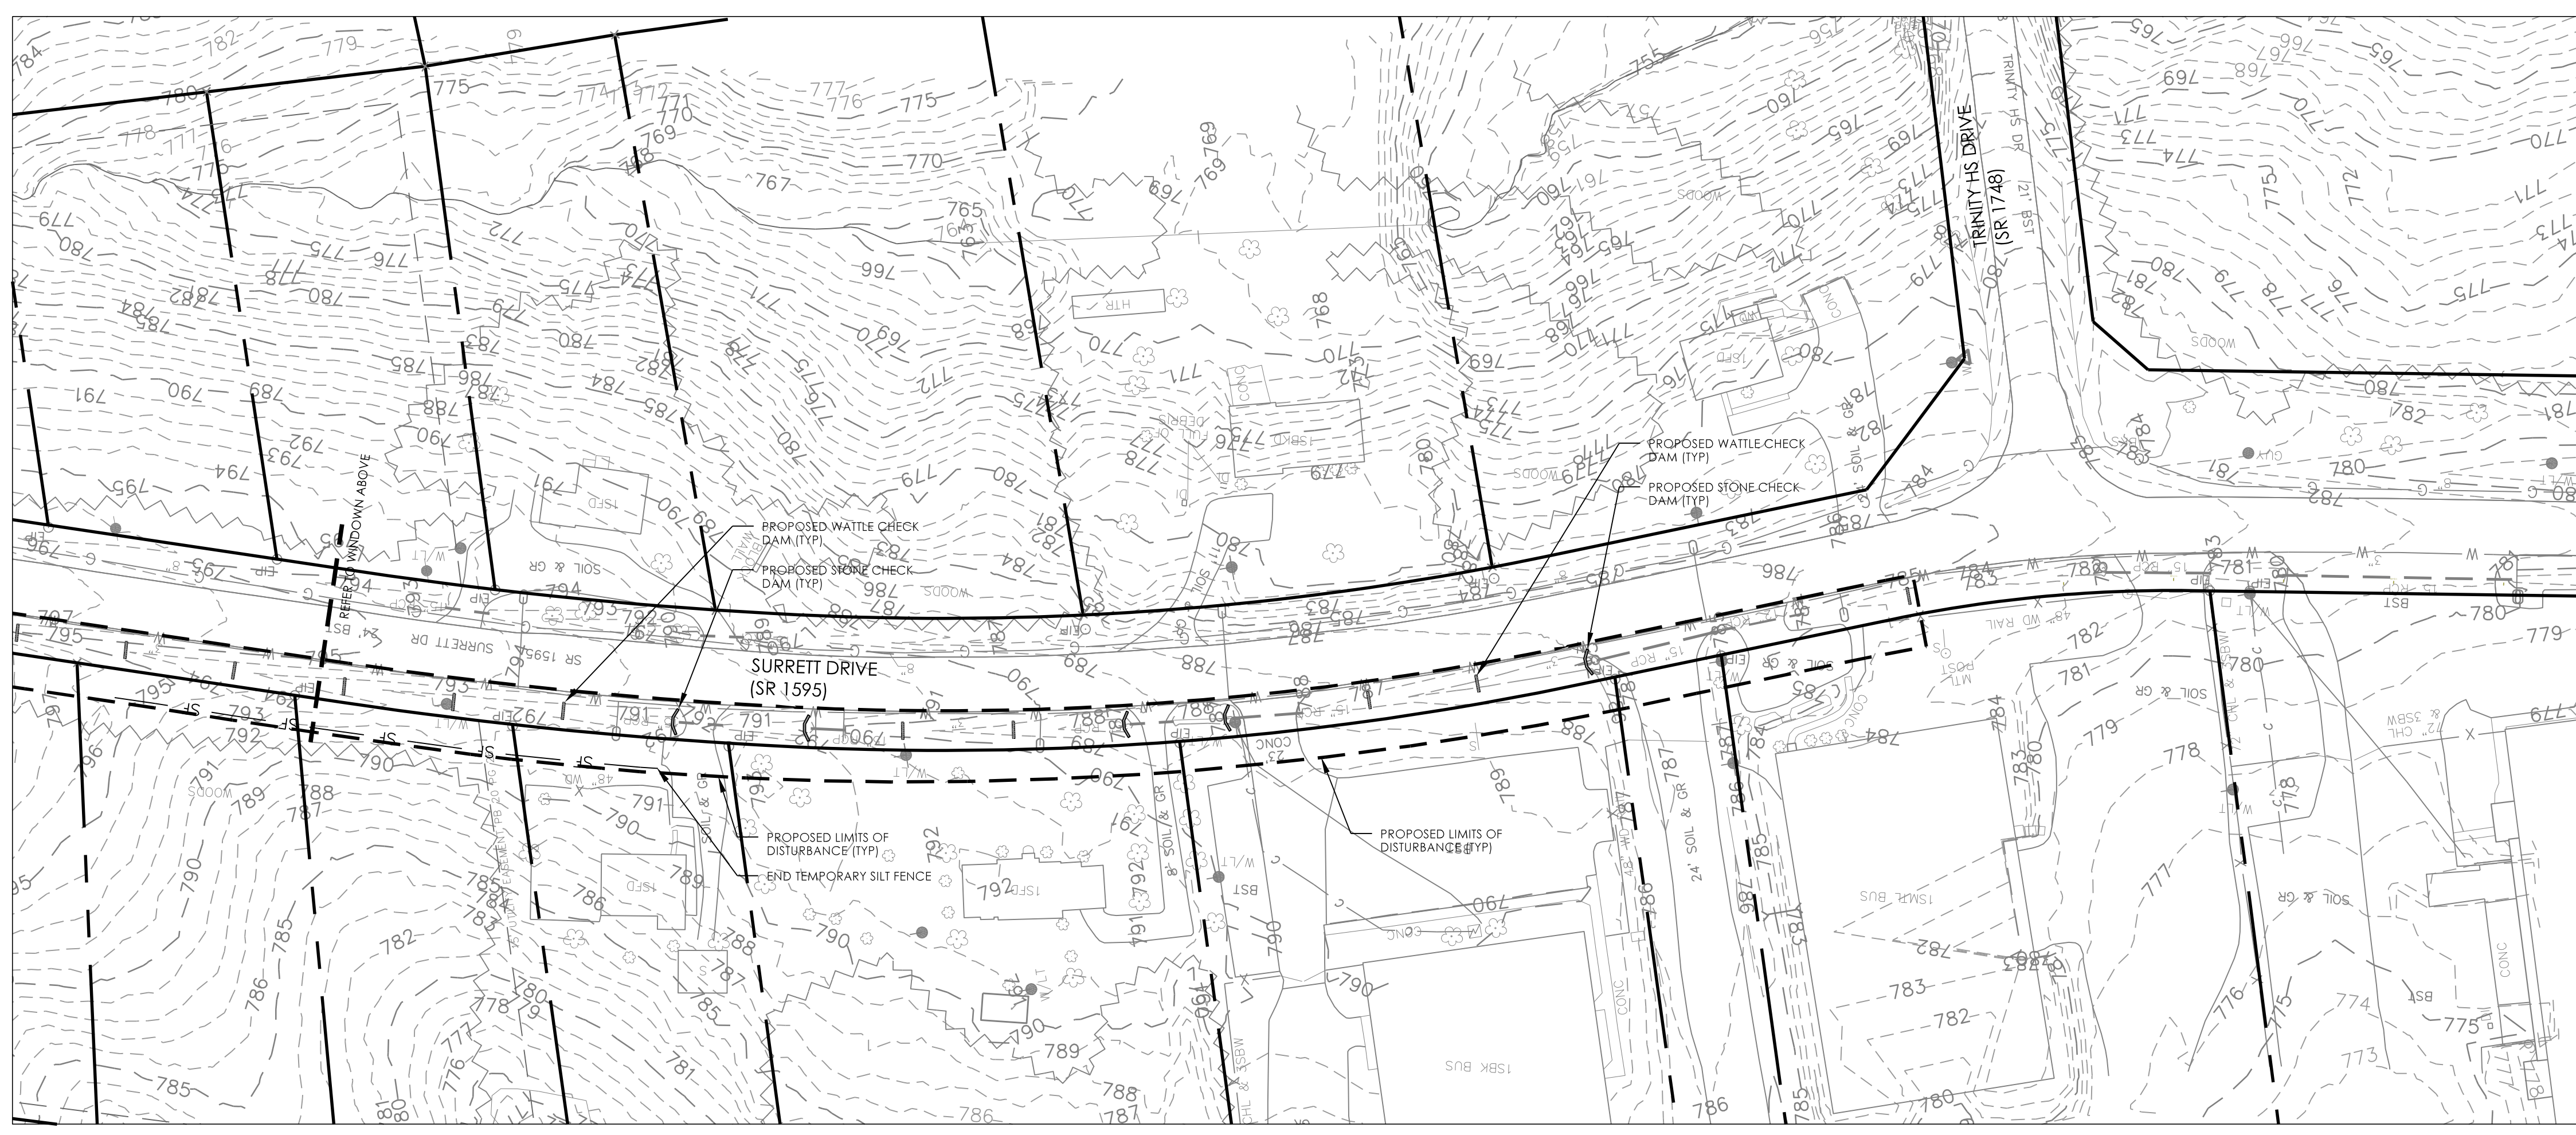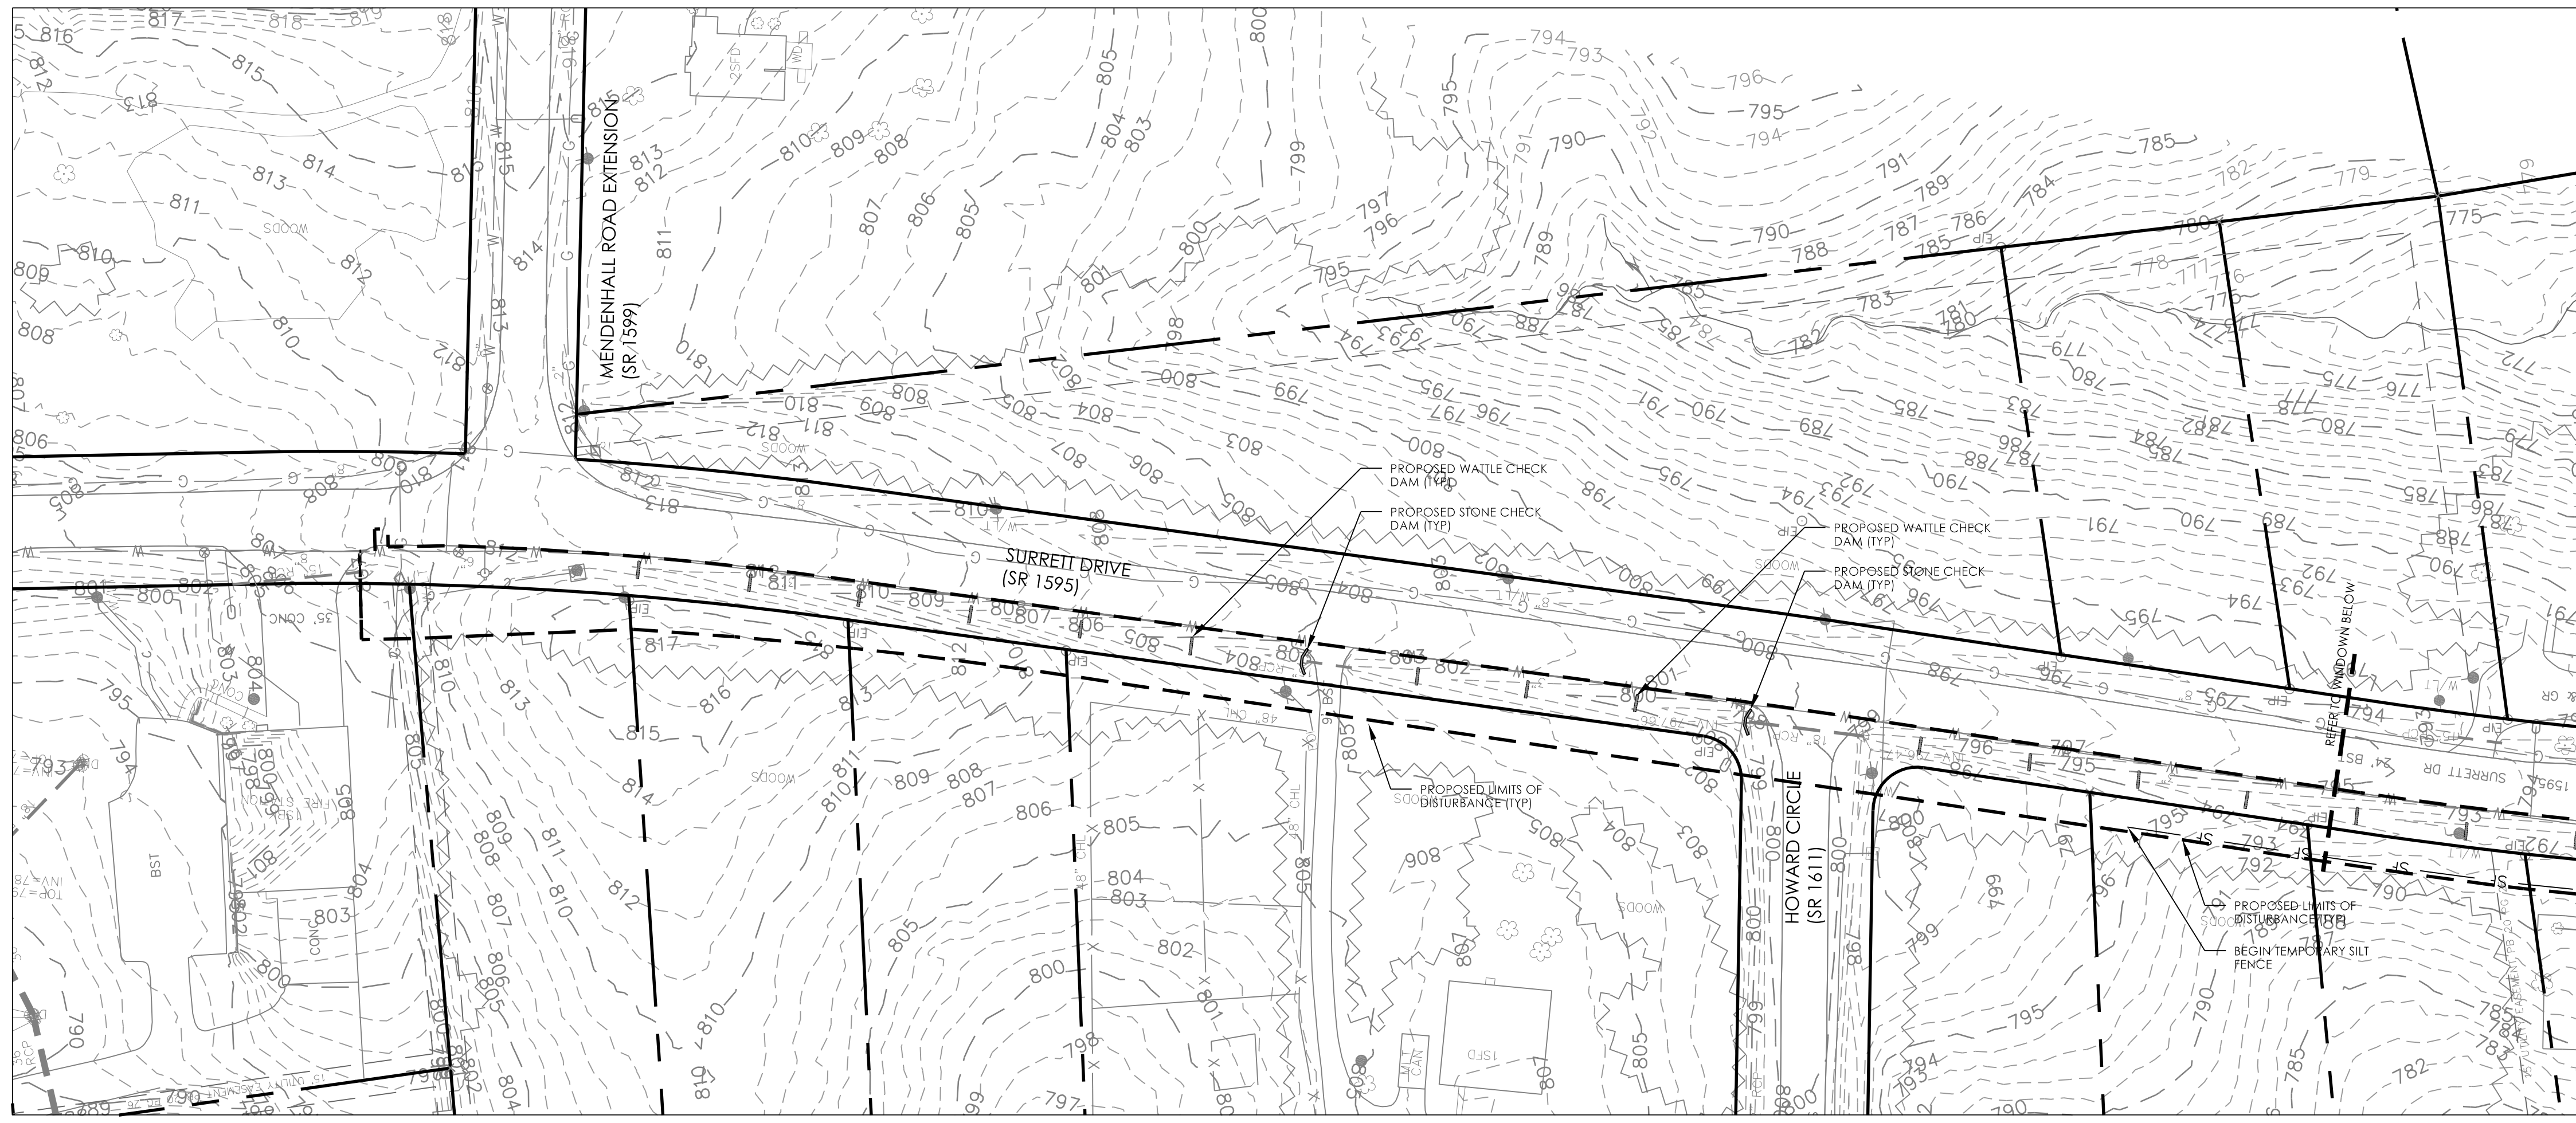

ALL WATERLINE CONSTRUCTION SHALL CONFORM WITH DAVIDSON WATER, INC. STANDARDS AND SPECIFICATIONS. ALL CONSTRUCTION INSIDE OF THE PUBLIC RIGHT-OF-WAY SHALL COMPLY WITH NCDOT STANDARDS AND SPECIFICATIONS.

REFER TO SHEET C-001 FOR PROJECT AND SHEET RELATED NOTES. REFER TO SHEET C-002 FOR DAVIDSON WATER NOTES.

T 919 781 8882

4600 Lake Boone Trail
Suite 205
Raleigh, NC 27607

info@smithsinnett.com

4909 Liles Road
Raleigh, NC 27606
919.438.3694 (o)
Firm License C-3898



BID SET

This drawing and the design shown is the property of Smith Sinnett Architecture, P.A. The reproduction or use of this drawing without the written consent of the Architect is prohibited. Any violation of this prohibition is a violation of the legal action. All copies of this drawing must be returned to the Architect at the completion of the contract.
Smith Sinnett Architecture, P.A. 2019

THIS DRAWING IS FORMATTED TO BE PRINTED ON A 24" X 36" SHEET

NEW TRINITY MIDDLE SCHOOL
RANDOLPH COUNTY SCHOOL SYSTEM

PARCEL PIN 7708118367
SURRETT DRIVE
TRINITY, NC 27370

KEY PLAN
NO SCALE

ID	DATE	DESCRIPTION
1	06.14.19	REV. PER REVIEW
DRAWN BY: SAD		
CHECKED BY: SAD		

OFFSITE
WATERLINE
EROSION
CONTROL PLAN

2017027 20 MAY 2019

C4-00



Know what's below.
Call before you dig.




NORTH



ALL WATERLINE CONSTRUCTION SHALL CONFORM WITH DAVIDSON WATER, INC. STANDARDS AND SPECIFICATIONS. ALL CONSTRUCTION INSIDE OF THE PUBLIC RIGHT-OF-WAY SHALL COMPLY WITH NCDOT STANDARDS AND SPECIFICATIONS.

REFER TO SHEET C-001 FOR PROJECT AND SHEET RELATED NOTES. REFER TO SHEET C-002 FOR DAVIDSON WATER NOTES.

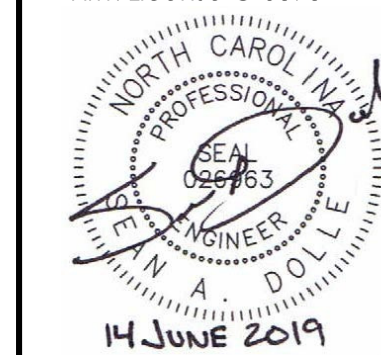

GROUND STABILIZATION AND MATERIALS HANDLING PRACTICES FOR COMPLIANCE WITH THE NCG01 CONSTRUCTION GENERAL PERMIT

Implementing the details and specifications on this plan sheet will result in the construction activity being considered compliant with the Ground Stabilization and Materials Handling sections of the NCG01 Construction General Permit (Sections E and F, respectively). The permittee shall comply with the Erosion and Sediment Control plan approved by the delegated authority having jurisdiction. All details and specifications shown on this sheet may not apply depending on site conditions and the delegated authority having jurisdiction.

Temporary and Permanent Groundcover*

STABILIZATION TIMEFRAMES (Effective Aug. 3, 2011)		
SITE AREA DESCRIPTION	STABILIZATION	TIMEFRAME EXCEPTIONS
Perimeter dikes, swales, ditches, slopes	7 days	None
High Quality Water (HQW) Zones	7 days	None
Slopes steeper than 3:1	7 days	If slopes are 10' or less in length and are not steeper than 2:1, 14 days are allowed.
Slopes 3:1 or flatter	14 days	7 days for slopes greater than 50' in length.
All other areas with slopes flatter than 4:1	14 days	None, except for perimeters and HQW Zones.

*-For Falls Lake watershed, in disturbed areas where grading activities are incomplete, provide temporary groundcover no later than seven (7) days for slopes steeper than 3:1; ten (10) days for slopes equal to or flatter than 3:1; fourteen (14) days for areas with no slope.

GROUND STABILIZATION SPECIFICATION

Stabilize the ground sufficiently so that rain will not dislodge the soil. Use one of the techniques in the table below:

Temporary Stabilization	Permanent Stabilization
<ul style="list-style-type: none"> Temporary grass seed covered with straw or other mulches and tackifiers Hydroseeding Rolled erosion control products with or without temporary grass seed Appropriately applied straw or other mulch Plastic sheeting 	<ul style="list-style-type: none"> Permanent grass seed covered with straw or other mulches and tackifiers Geotextile fabrics such as permanent soil reinforcement matting Hydroseeding Shrubs or other permanent plantings covered with mulch Uniform and evenly distributed ground cover sufficient to restrain erosion Structural methods such as concrete, asphalt or retaining walls

POLYACRYLAMIDES (PAMS) AND FLOCCULANTS

- Select flocculants that are appropriate for the soils being exposed during construction, selecting from the *NC DWR List of Approved PAMS/Flocculants*.
- Apply flocculants at or before the inlets to Erosion and Sediment Control Measures.
- Apply flocculants at the concentrations specified in the *NC DWR List of Approved PAMS/Flocculants* and in accordance with the manufacturer's instructions.
- Provide ponding area for containment of treated Stormwater before discharging offsite.
- Store flocculants in leak-proof containers that are kept under storm-resistant cover or surrounded by secondary containment structures.



EQUIPMENT AND VEHICLE MAINTENANCE

- Maintain vehicles and equipment to prevent discharge of fluids.
- Provide drip pans under any stored equipment.
- Identify leaks and repair as soon as feasible, or remove leaking equipment from the project.
- Collect all spent fluids, store in separate containers and properly dispose as hazardous waste (recycle when possible).
- Remove leaking vehicles and construction equipment from service until the problem has been corrected.
- Bring used fuels, lubricants, coolants, hydraulic fluids and other petroleum products to a recycling or disposal center that handles these materials.

LITTER, BUILDING MATERIAL AND LAND CLEARING WASTE

- Never bury or burn waste. Place litter and debris in approved waste containers.
- Provide a sufficient number of waste containers on site to manage the quantity of waste produced.
- Locate waste containers at least 50 feet away from storm drain inlets and surface waters unless no other alternatives are reasonably available.
- Locate waste containers on areas that do not receive substantial amounts of runoff from upland areas and does not drain directly to a storm drain, stream or wetland.
- Cover waste containers at the end of each workday and before storm events. Repair or replace damaged waste containers.
- Anchor all lightweight items in waste containers during times of high winds.
- Empty waste containers as needed to prevent overflow.
- Dispose waste off-site at an approved disposal facility.

PAINT AND OTHER LIQUID WASTE


- Do not dump paint and other liquid waste into storm drains, streams or wetlands.
- Locate paint washouts at least 50 feet away from storm drain inlets and surface waters unless no other alternatives are reasonably available.
- Contain liquid wastes in a controlled area.
- Containment must be labeled, sized and placed appropriately for the needs of site.
- Prevent the discharge of soaps, solvents, detergents and other liquid wastes from construction sites.

PORTABLE TOILETS

- Install portable toilets on level ground, at least 50 feet away from storm drains, streams or wetlands unless there is no alternative reasonably available. If 50 foot offset is not attainable, provide relocation of portable toilet behind silt fence or place on a gravel pad and surround with sand bags.
- Provide staking or anchoring of portable toilets during periods of high winds or in high foot traffic areas.
- Monitor portable toilets for leaking and properly dispose of any leaked material. Utilize a licensed sanitary waste hauler to remove leaking portable toilets and replace with properly operating unit.

EARTHEN STOCKPILE MANAGEMENT

- Show stockpile locations on plans. Locate earthen-material stockpile areas at least 50 feet away from storm drain inlets, sediment basins, perimeter sediment controls and surface waters unless it can be shown no other alternatives are reasonably available.
- Protect stockpile with silt fence installed along toe of slope with a minimum offset of five feet from the toe of stockpile.
- Provide stable stone access point when feasible.
- Stabilize stockpile within the timeframes provided on this sheet and in accordance with the approved plan and any additional requirements. Soil stabilization is defined as vegetative, physical or chemical coverage techniques that will restrain accelerated erosion on disturbed soils for temporary or permanent control needs.

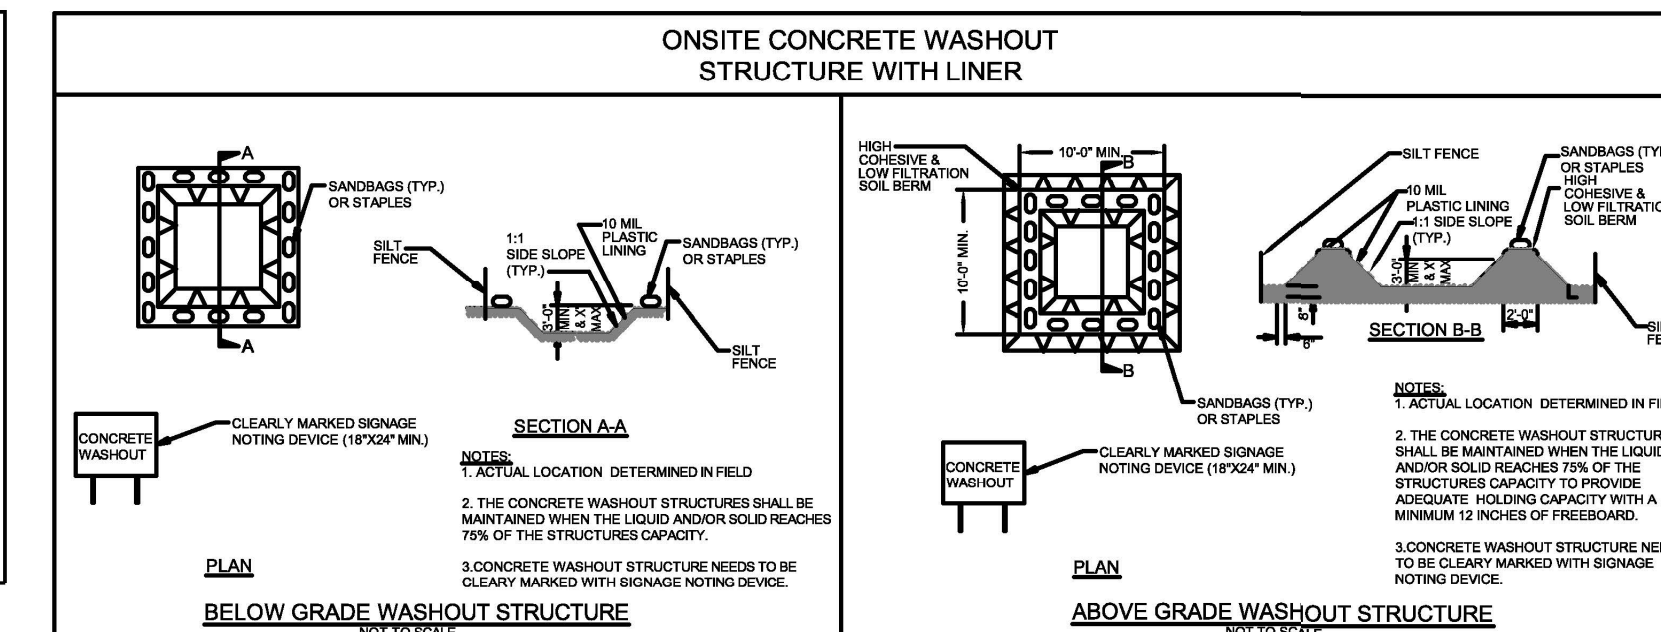

CONCRETE WASHOUTS

- Do not discharge concrete or cement slurry from the site.
- Dispose of, or recycle settled, hardened concrete residue in accordance with local and state solid waste regulations and at an approved facility.
- Manage washout from mortar mixers in accordance with the above item and in addition place the mixer and associated materials on impervious barrier and within lot perimeter silt fence.
- Install temporary concrete washouts per local requirements, where applicable. If an alternate method or product is to be used, contact your approval authority for review and approval. If local standard details are not available, use one of the two types of temporary concrete washouts provided on this detail.
- Do not use concrete washouts for dewatering or storing defective curb or sidewalk sections. Stormwater accumulated within the washout may not be pumped into or discharged to the storm drain system or receiving surface waters. Liquid waste must be pumped out and removed from project.
- Locate washouts at least 50 feet from storm drain inlets and surface waters unless it can be shown that no other alternatives are reasonably available. At a minimum, install protection of storm drain inlet(s) closest to the washout which could receive spills or overflow.
- Locate washouts in an easily accessible area, on level ground and install a stone entrance pad in front of the washout. Additional controls may be required by the approving authority.
- Install at least one sign directing concrete trucks to the washout within the project limits. Post signage on the washout itself to identify this location.
- Remove leavings from the washout when at approximately 75% capacity to limit overflow events. Replace the tarp, sand bags or other temporary structural components when no longer functional. When utilizing alternative or proprietary products, follow manufacturer's instructions.
- At the completion of the concrete work, remove remaining leavings and dispose of in an approved disposal facility. Fill pit, if applicable, and stabilize any disturbance caused by removal of washout.

HERBICIDES, PESTICIDES AND RODENTICIDES

- Store and apply herbicides, pesticides and rodenticides in accordance with label restrictions.
- Store herbicides, pesticides and rodenticides in their original containers with the label, which lists directions for use, ingredients and first aid steps in case of accidental poisoning.
- Do not store herbicides, pesticides and rodenticides in areas where flooding is possible or where they may spill or leak into wells, stormwater drains, ground water or surface water. If a spill occurs, clean area immediately.
- Do not stockpile these materials onsite.

HAZARDOUS AND TOXIC WASTE

- Create designated hazardous waste collection areas on-site.
- Place hazardous waste containers under cover or in secondary containment.
- Do not store hazardous chemicals, drums or bagged materials directly on the ground.

This drawing and the design shown is the property of Smith Sinnett Architecture, P.A. The reproduction or use of this drawing without the written consent of the Architect is prohibited. Any arrangement for the use of this drawing for any other project must be returned to the Architect at the completion of the contract.
Smith Sinnett Architecture, P.A. 2019
THIS DRAWING IS FORMATTED TO BE PRINTED ON A 24" X 36" SHEET

NEW TRINITY MIDDLE SCHOOL
RANDOLPH COUNTY SCHOOL SYSTEM

PARCEL PIN 7708118367
SURRETT DRIVE
TRINITY, NC 27370

KEY PLAN
NO SCALE

1	06.14.19	REV. PER REVIEW
ID	DATE	DESCRIPTION


DRAWN BY: SAD
CHECKED BY: SAD

NPDES NOTES



ALL WATERLINE CONSTRUCTION SHALL CONFORM WITH DAVIDSON WATER, INC. STANDARDS AND SPECIFICATIONS. ALL CONSTRUCTION INSIDE OF THE PUBLIC RIGHT-OF-WAY SHALL COMPLY WITH NCDOT STANDARDS AND SPECIFICATIONS.

REFER TO SHEET C-001 FOR PROJECT AND SHEET RELATED NOTES. REFER TO SHEET C-002 FOR DAVIDSON WATER NOTES.

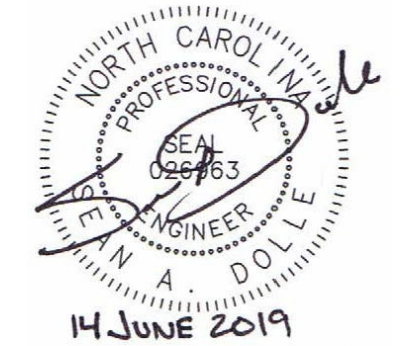

This drawing and the design shown is the property of Smith Sinnett Architecture, P.A. The reproduction or use of this drawing without the written consent of the Architect is prohibited. Any infringement of the copyright in this drawing shall be a legal action. All copies of this drawing must be returned to the Architect at the completion of the contract.
Smith Sinnett Architecture, P.A., 2019
THIS DRAWING IS FORMATTED TO BE PRINTED ON A 24" X 36" SHEET

NEW TRINITY MIDDLE SCHOOL
RANDOLPH COUNTY SCHOOL SYSTEM

PARCEL PIN 7708118367
SURRETT DRIVE
TRINITY, NC 27370

KEY PLAN
NO SCALE



1 06.14.19 REV. PER REVIEW
ID DATE DESCRIPTION
DRAWN BY: SAD
CHECKED BY: SAD

NPDES NOTES

**PART III
SELF-INSPECTION, RECORDKEEPING AND REPORTING**

SECTION A: SELF-INSPECTION

Self-inspections are required during normal business hours in accordance with the table below. When adverse weather or site conditions would cause the safety of the inspection personnel to be in jeopardy, the inspection may be delayed until the next business day on which it is safe to perform the inspection. In addition, when a storm event of greater than 1.0 inch occurs outside of normal business hours, the self-inspection shall be performed upon the commencement of the next business day. Any time when inspections were delayed shall be noted in the Inspection Record.

Inspect	Frequency (during normal business hours)	Inspection records must include [40 CFR 122.41]:
(1) Rain gauge maintained in good working order	Daily	Daily rainfall amounts. If no daily rain gauge observations are made during weekend or holiday periods, and no individual-day rainfall information is available, record the cumulative rain measurement for those un-attended days (and this will determine if a site inspection is needed). Days on which no rainfall occurred shall be recorded as "zero." The permittee may use another rain-monitoring device approved by the Division.
(2) E&SC Measures	At least once per 7 calendar days and within 24 hours of a rain event > 1.0 inch in 24 hours	1. Identification of the measures inspected, 2. Date and time of the inspection, 3. Name of the person performing the inspection, 4. Indication of whether the measures were operating properly, 5. Description of maintenance needs for the measure, 6. Corrective actions taken, and 7. Date of actions taken.
(3) Stormwater discharge outfalls (SDOs)	At least once per 7 calendar days and within 24 hours of a rain event > 1.0 inch in 24 hours	1. Identification of the discharge outfalls inspected, 2. Date and time of the inspection, 3. Name of the person performing the inspection, 4. Evidence of indicators of stormwater pollution such as oil sheen, floating or suspended solids or discoloration, 5. Indication of visible sediment leaving the site, 6. Actions taken to correct/prevent sedimentation, and 7. Date of actions taken.
(4) Perimeter of site	At least once per 7 calendar days and within 24 hours of a rain event > 1.0 inch in 24 hours	If visible sedimentation is found outside site limits, then a record of the following shall be made: 1. Actions taken to clean up or stabilize the sediment that has left the site limits, 2. Date of actions taken, and 3. An explanation as to the actions taken to control future releases.
(5) Streams or wetlands onsite or offsite (where accessible)	At least once per 7 calendar days and within 24 hours of a rain event > 1.0 inch in 24 hours	If the stream or wetland has increased visible sedimentation or a stream has visible increased turbidity from the construction activity, then a record of the following shall be made: 1. Evidence and actions taken to reduce sediment contributions, and 2. Records of the required reports to the appropriate Division Regional Office per Part III, Section C, Item (2)(a) of this permit of this permit.

NOTE: The rain inspection resets the required 7 calendar day inspection requirement.

**PART III
SELF-INSPECTION, RECORDKEEPING AND REPORTING**

SECTION B: RECORDKEEPING

1. E&SC Plan Documentation

The approved E&SC plan as well as any approved deviation shall be kept on the site. The approved E&SC plan must be kept up-to-date throughout the coverage under this permit. The following items pertaining to the E&SC plan shall be documented in the manner described:

Item to Document	Documentation Requirements
(a) Each E&SC Measure has been installed and does not significantly deviate from the locations, dimensions and relative elevations shown on the approved E&SC Plan.	Initial and date each E&SC Measure on a copy of the approved E&SC Plan or complete, date and sign an inspection report that lists each E&SC Measure shown on the approved E&SC Plan. This documentation is required upon the initial installation of the E&SC Measures or if the E&SC Measures are modified after initial installation.
(b) A phase of grading has been completed.	Initial and date a copy of the approved E&SC Plan or complete, date and sign an inspection report to indicate completion of the construction phase.
(c) Ground cover is located and installed in accordance with the approved E&SC Plan.	Initial and date a copy of the approved E&SC Plan or complete, date and sign an inspection report to indicate compliance with approved ground cover specifications.
(d) The maintenance and repair requirements for all E&SC Measures have been performed.	Complete, date and sign an inspection report.
(e) Corrective actions have been taken to E&SC Measures.	Initial and date a copy of the approved E&SC Plan or complete, date and sign an inspection report to indicate the completion of the corrective action.

2. Additional Documentation

In addition to the E&SC Plan documents above, the following items shall be kept on the site and available for agency inspectors at all times during normal business hours, unless the Division provides a site-specific exemption based on unique site conditions that make this requirement not practical:

- (a) This general permit as well as the certificate of coverage, after it is received.
- (b) Records of inspections made during the previous 30 days. The permittee shall record the required observations on the Inspection Record Form provided by the Division or a similar inspection form that includes all the required elements. Use of electronically-available records in lieu of the required paper copies will be allowed if shown to provide equal access and utility as the hard-copy records.
- (c) All data used to complete the Notice of Intent and older inspection records shall be maintained for a period of three years after project completion and made available upon request. [40 CFR 122.41]

**PART III
SELF-INSPECTION, RECORDKEEPING AND REPORTING**

SECTION C: REPORTING

1. Occurrences that must be reported

Permittees shall report the following occurrences:

- (a) Visible sediment deposition in a stream or wetland.
- (b) Oil spills if:
 - They are 25 gallons or more,
 - They are less than 25 gallons but cannot be cleaned up within 24 hours,
 - They cause sheen on surface waters (regardless of volume), or
 - They are within 100 feet of surface waters (regardless of volume).

- (a) Releases of hazardous substances in excess of reportable quantities under Section 311 of the Clean Water Act (Ref: 40 CFR 110.3 and 40 CFR 117.3) or Section 102 of CERCLA (Ref: 40 CFR 302.4) or G.S. 143-215.85.

- (b) Anticipated bypasses and unanticipated bypasses.

- (c) Noncompliance with the conditions of this permit that may endanger health or the environment.

2. Reporting Timeframes and Other Requirements

After a permittee becomes aware of an occurrence that must be reported, he shall contact the appropriate Division regional office within the timeframes and in accordance with the other requirements listed below. Occurrences outside normal business hours may also be reported to the Division's Emergency Response personnel at (800) 662-7956, (800) 858-0368 or (919) 733-3300.

Occurrence	Reporting Timeframes (After Discovery) and Other Requirements
(a) Visible sediment deposition in a stream or wetland	<ul style="list-style-type: none"> • Within 24 hours, an oral or electronic notification. • Within 7 calendar days, a report that contains a description of the sediment and actions taken to address the cause of the deposition. Division staff may waive the requirement for a written report on a case-by-case basis. • If the stream is named on the NC 303(d) list as impaired for sediment-related causes, the permittee may be required to perform additional monitoring, inspections or apply more stringent practices if staff determine that additional requirements are needed to assure compliance with the federal or state impaired-waters conditions.
(b) Oil spills and release of hazardous substances per Item 1(b)-(c) above	<ul style="list-style-type: none"> • Within 24 hours, an oral or electronic notification. The notification shall include information about the date, time, nature, volume and location of the spill or release.
(c) Anticipated bypasses [40 CFR 122.41(m)(3)]	<ul style="list-style-type: none"> • A report at least ten days before the date of the bypass, if possible. The report shall include an evaluation of the anticipated quality and effect of the bypass.
(d) Unanticipated bypasses [40 CFR 122.41(m)(3)]	<ul style="list-style-type: none"> • Within 24 hours, an oral or electronic notification. • Within 7 calendar days, a report that includes an evaluation of the quality and effect of the bypass.
(e) Noncompliance with the conditions of this permit that may endanger health or the environment [40 CFR 122.41(l)(7)]	<ul style="list-style-type: none"> • Within 24 hours, an oral or electronic notification. • Within 7 calendar days, a report that contains a description of the noncompliance, and its causes; the period of noncompliance, including exact dates and times, and if the noncompliance has not been corrected, the anticipated time noncompliance is expected to continue; and steps taken or planned to reduce, eliminate, and prevent reoccurrence of the noncompliance. [40 CFR 122.41(l)(6). • Division staff may waive the requirement for a written report on a case-by-case basis.



Know what's below.
Call before you dig.



ALL WATERLINE CONSTRUCTION SHALL CONFORM WITH DAVIDSON WATER, INC. STANDARDS AND SPECIFICATIONS. ALL CONSTRUCTION INSIDE OF THE PUBLIC RIGHT-OF-WAY SHALL COMPLY WITH NCDOT STANDARDS AND SPECIFICATIONS.

REFER TO SHEET C-001 FOR PROJECT AND SHEET RELATED NOTES. REFER TO SHEET C-002 FOR DAVIDSON WATER NOTES.

T 919 781 8582
4600 Lake Boone Trail
Suite 205
Raleigh, NC 27607
info@smithsinnett.com


grounded
ENGINEERING
4909 Liles Road
Raleigh, NC 27606
919.438.3694 (o)
Firm License C-3898




BID SET



1" = 50' (HORIZONTAL)
1" = 5' (VERTICAL)

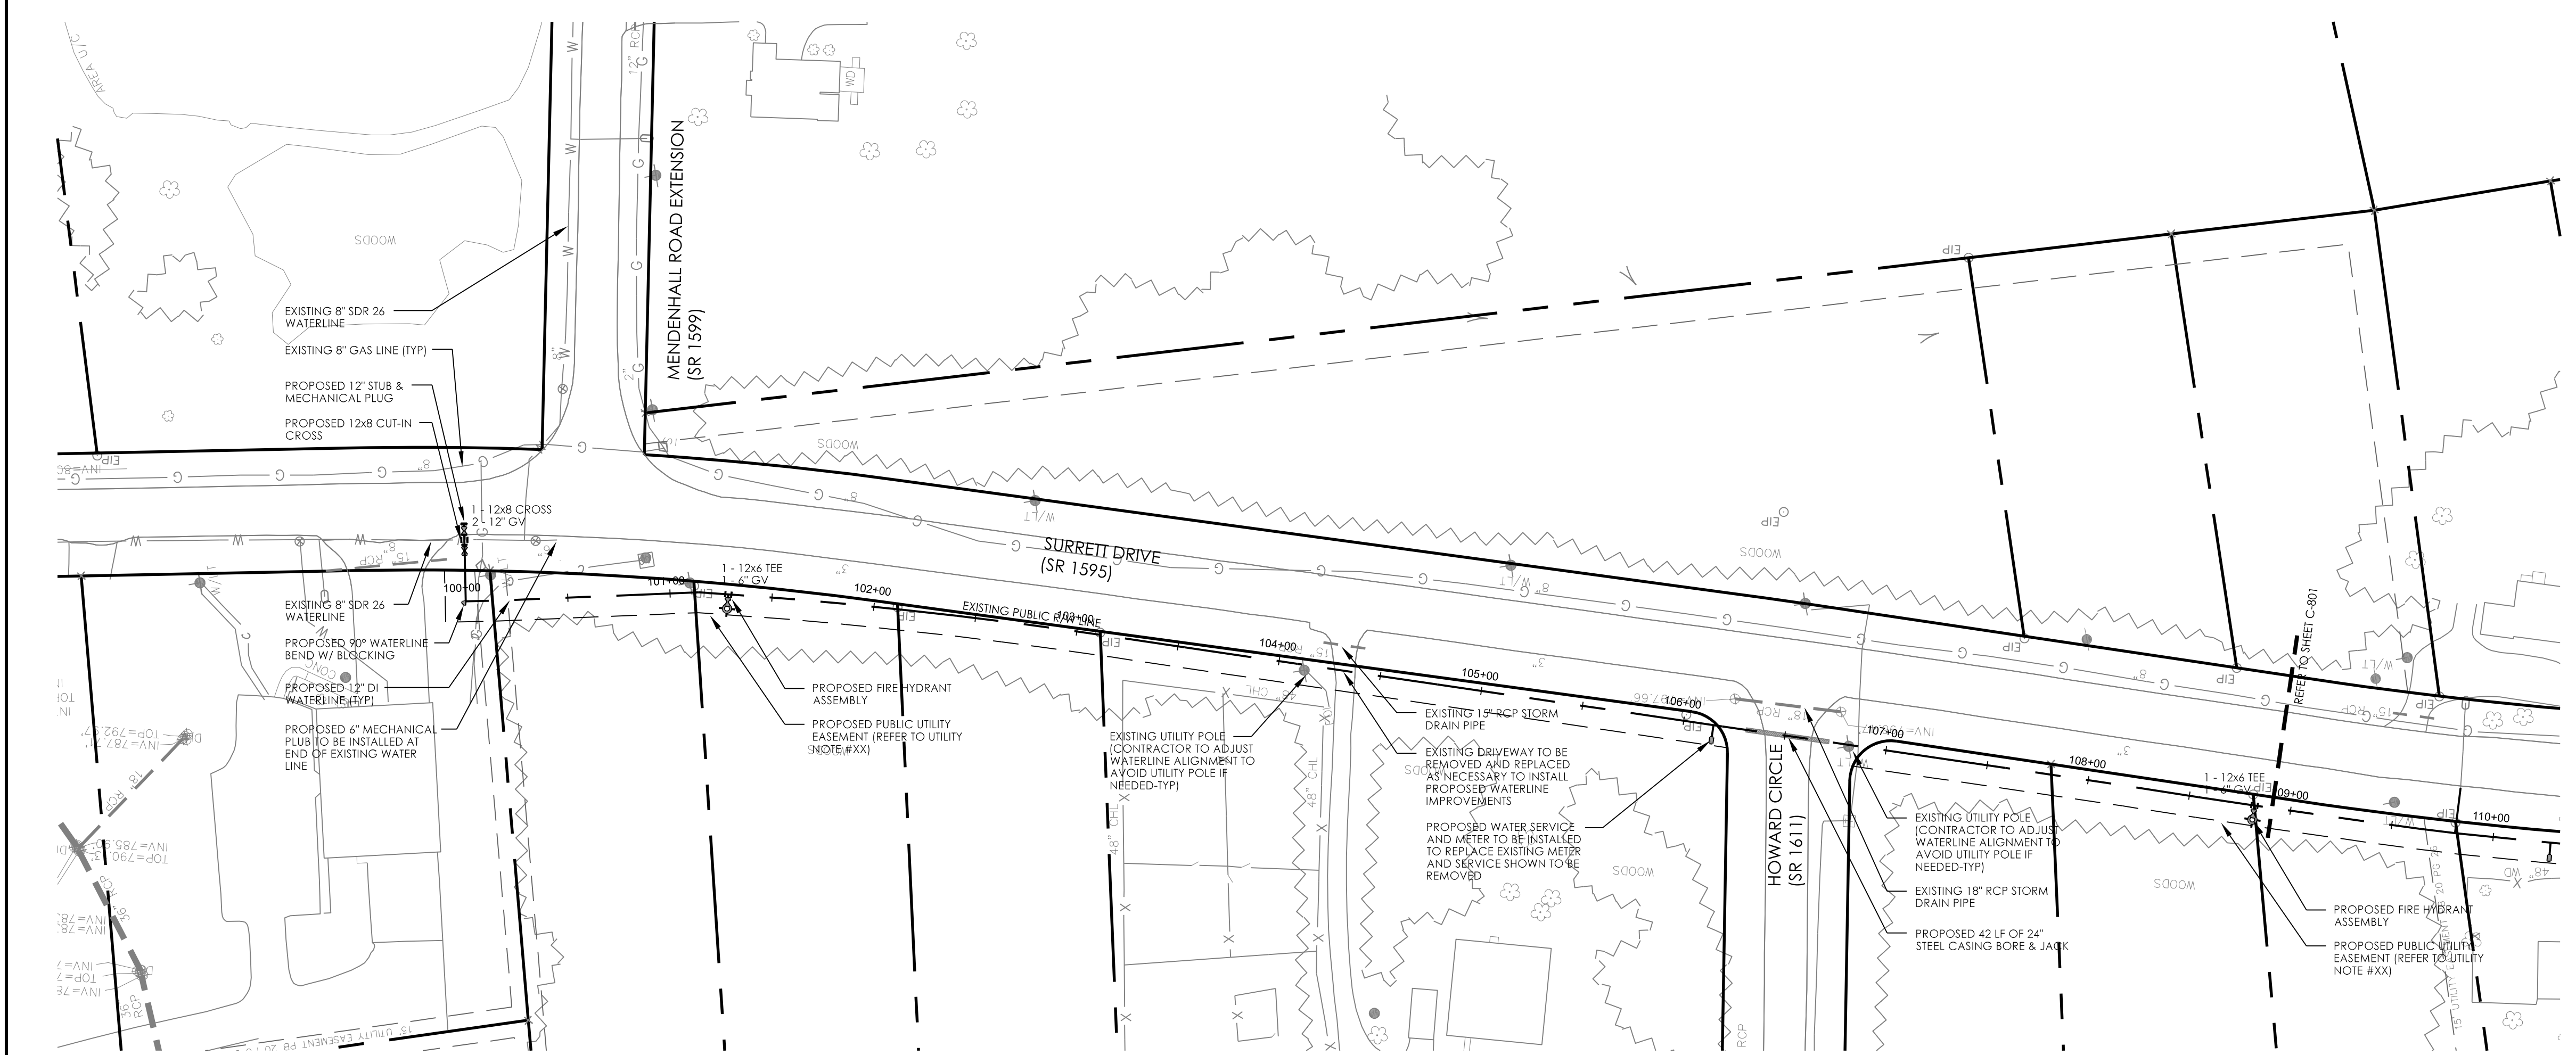

PUBLIC WATERLINE EXTENSION

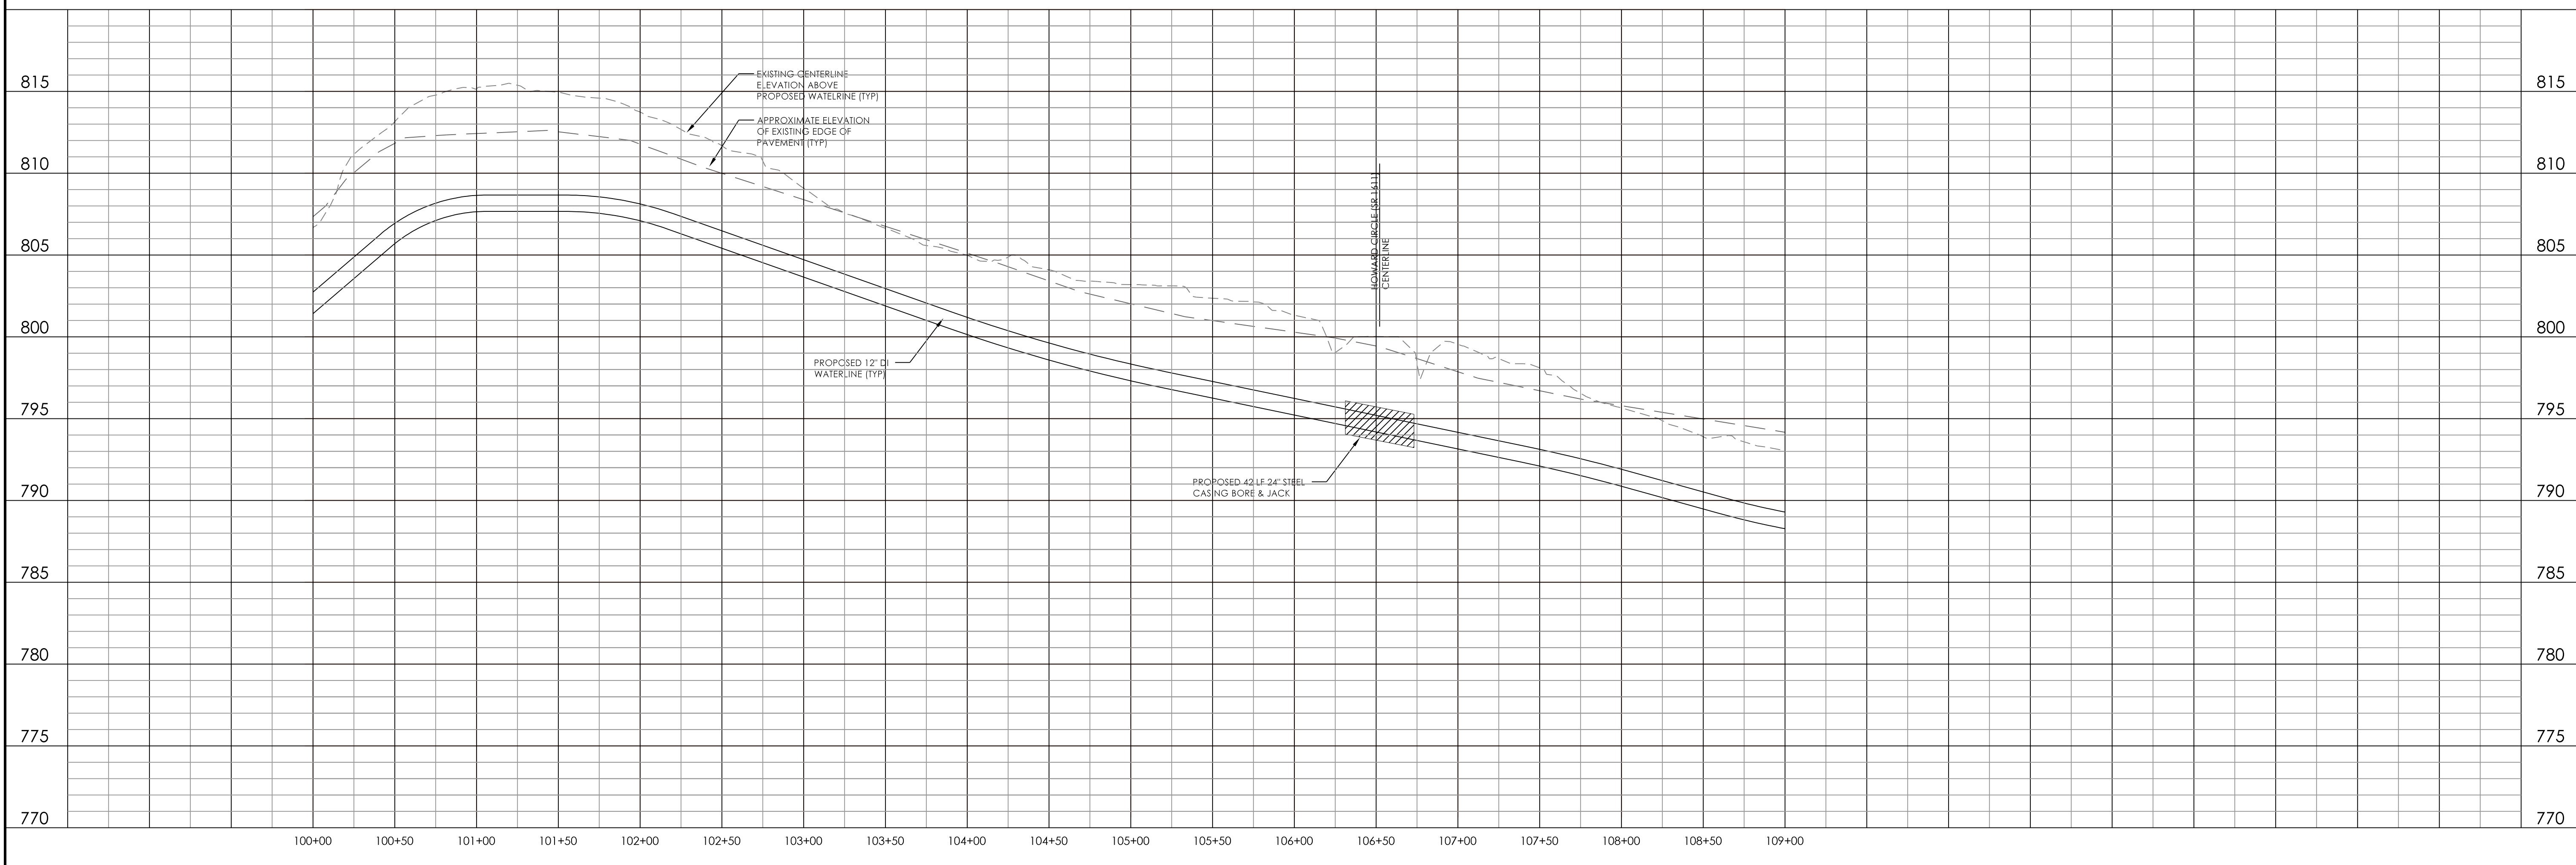

NEW TRINITY MIDDLE SCHOOL
RANDOLPH COUNTY SCHOOL SYSTEM
PARCEL PIN 7708118367
SURRETT DRIVE
TRINITY, NC 27370


KEY PLAN
NO SCALE

ID	DATE	REV.	PER REVIEW	DESCRIPTION
1	06.14.19			REV. PER REVIEW

DRAWN BY: SAD
CHECKED BY: SAD

OFFSITE
WATERLINE
PLAN & PROFILE

2017027 20 MAY 2019

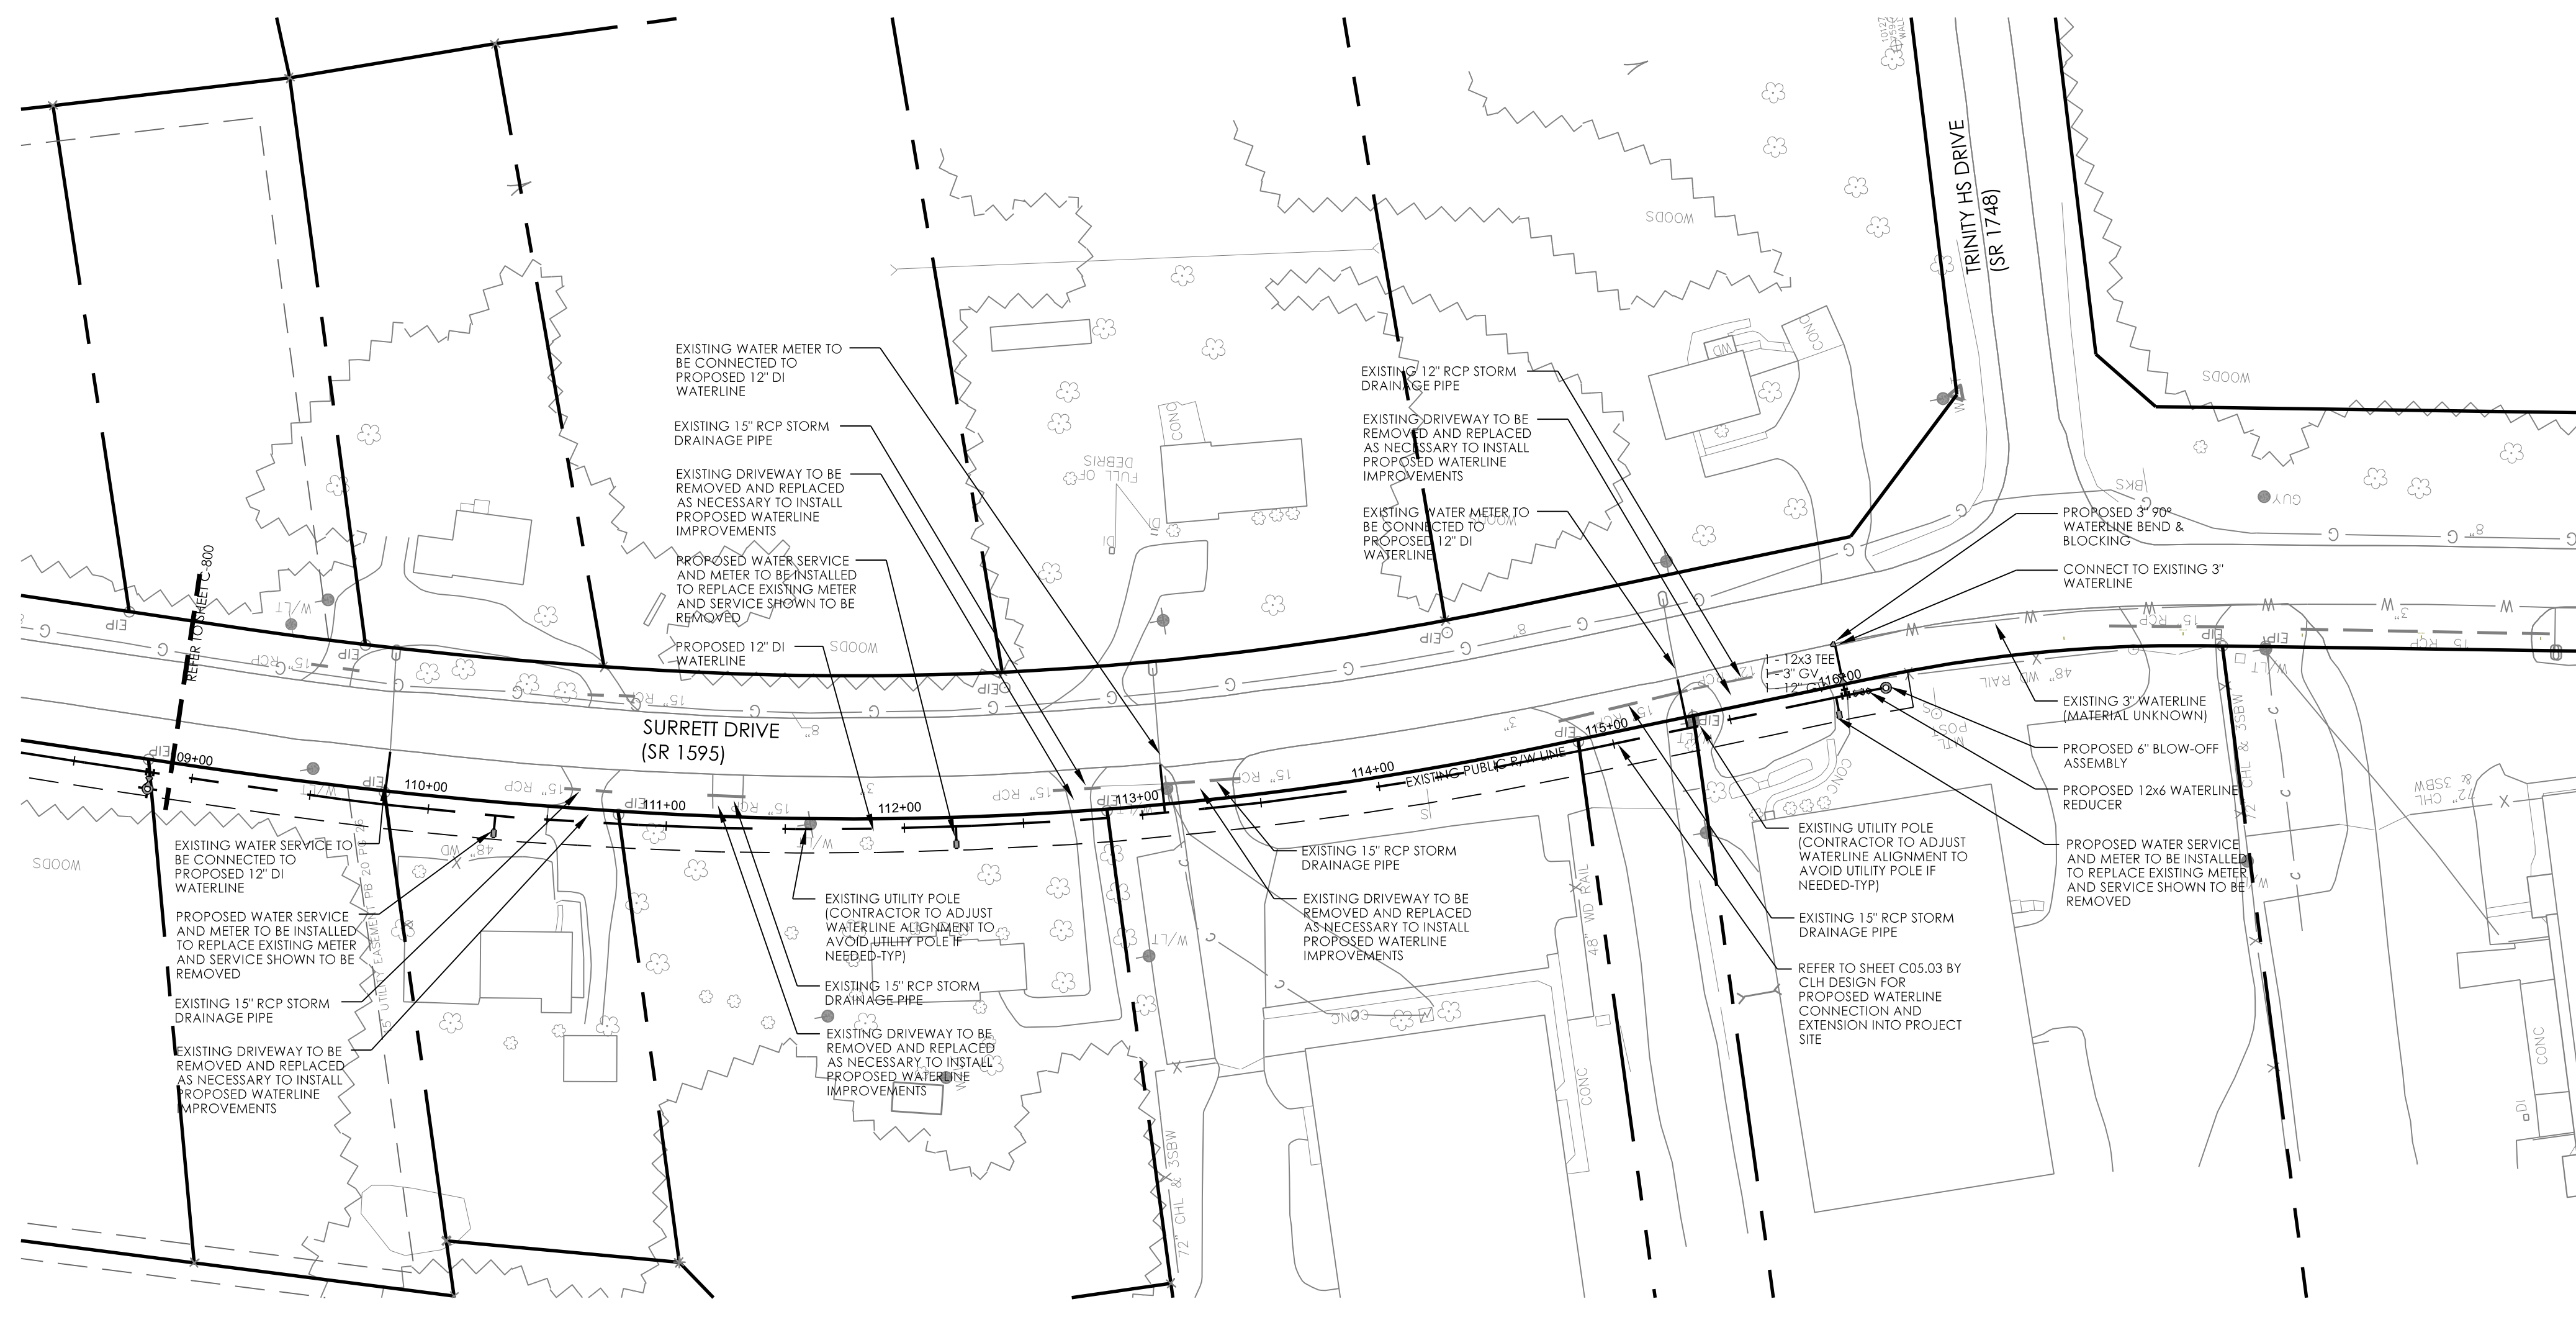


PUBLIC WATERLINE EXTENSION

ALL WATERLINE CONSTRUCTION SHALL CONFORM WITH DAVIDSON WATER, INC. STANDARDS AND SPECIFICATIONS. ALL CONSTRUCTION INSIDE OF THE PUBLIC RIGHT-OF-WAY SHALL COMPLY WITH NCDOT STANDARDS AND SPECIFICATIONS.

REFER TO SHEET C-001 FOR PROJECT AND SHEET RELATED NOTES. REFER TO SHEET C-002 FOR DAVIDSON WATER NOTES.



1" = 50' (HORIZONTAL)
1" = 5' (VERTICAL)

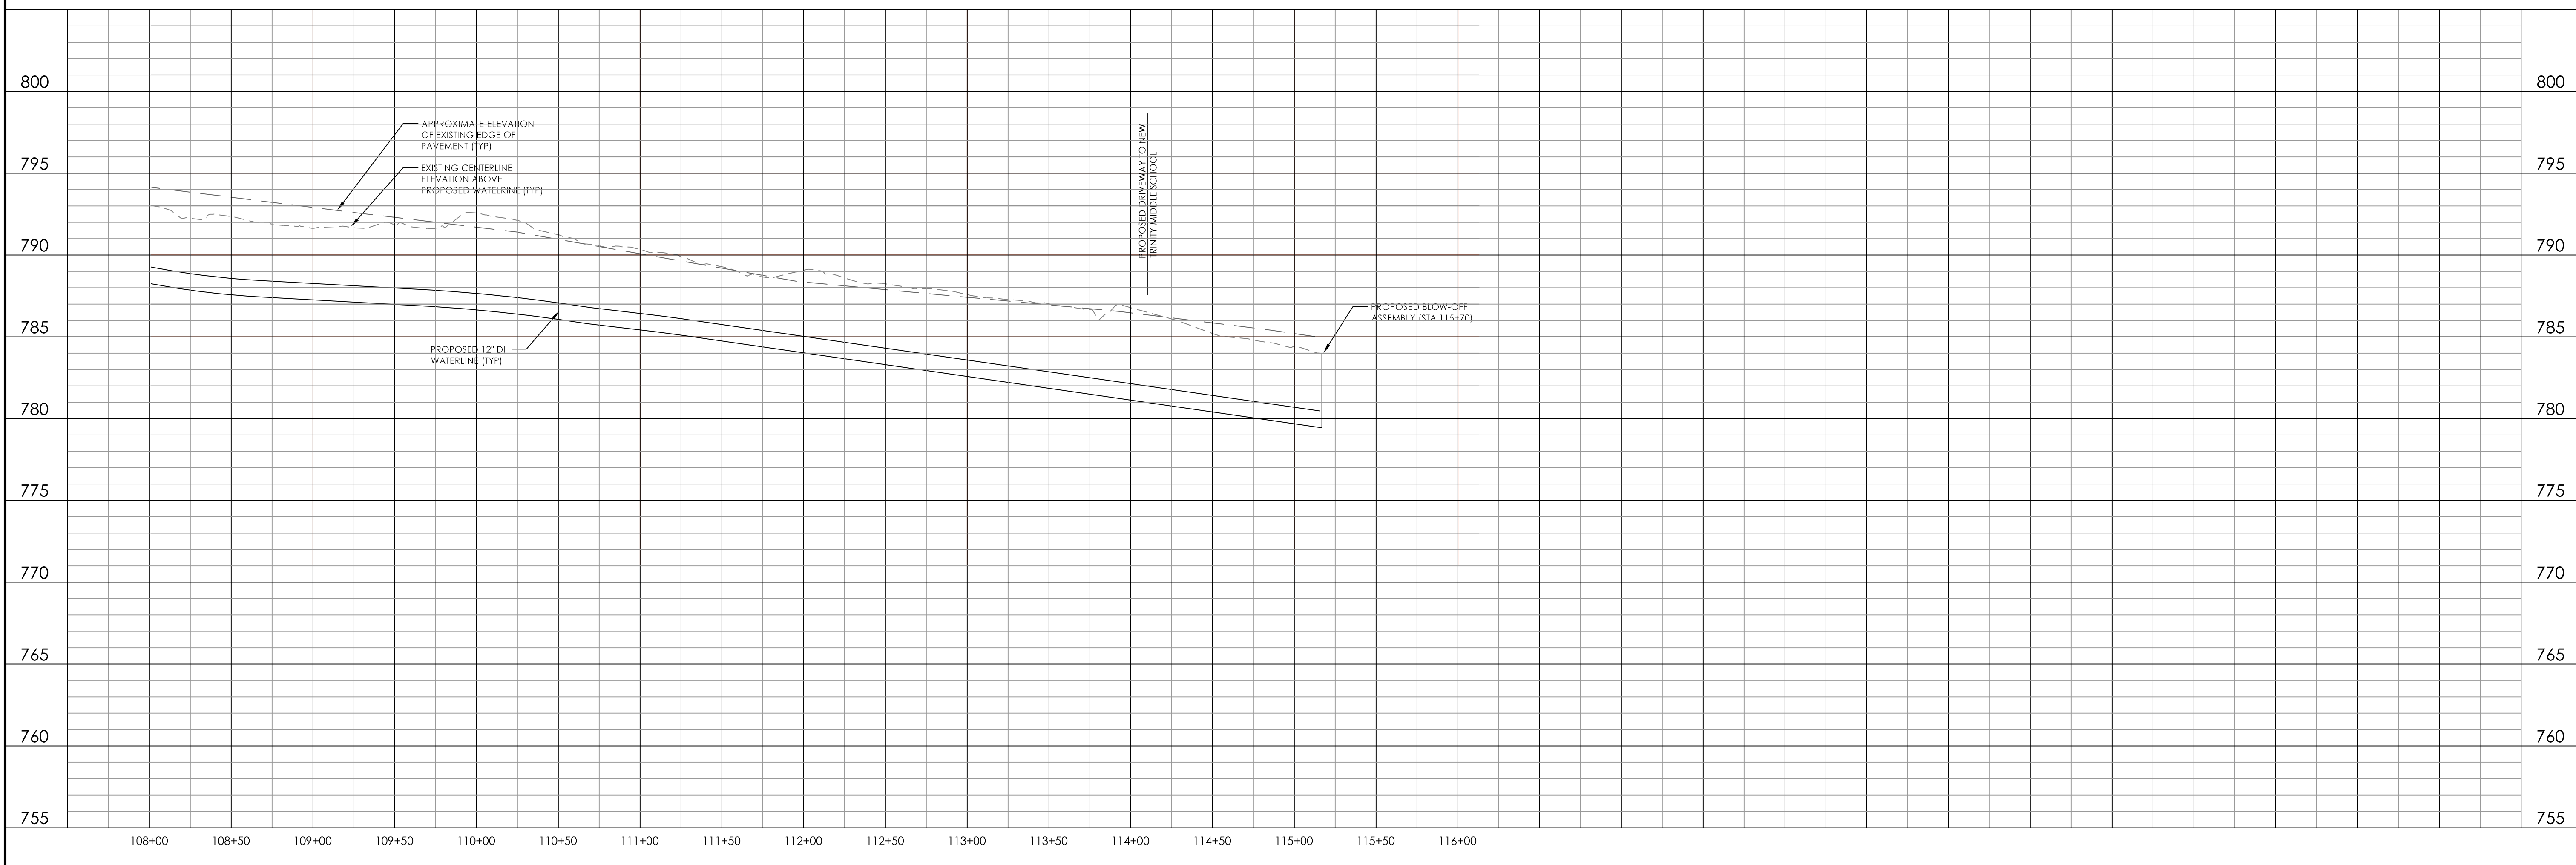


T 919 781 882

4600 Lake Boone Trail
Suite 205
Raleigh, NC 27607

info@smithsinnett.com

4909 Liles Road
Raleigh, NC 27606
919.438.3694 (o)
Firm License C-3898

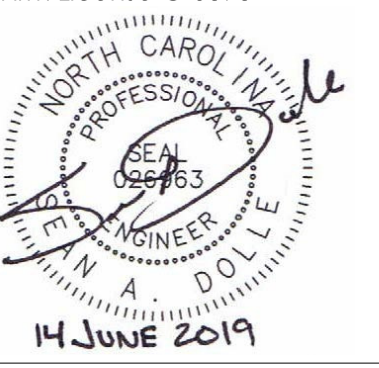

BID SET

This drawing and the design shown is the property of Smith Sinnett Architecture, P.A. The reproduction or use of this drawing without the written consent of the Architect is prohibited. Any arrangement to reproduce this drawing without the written consent of the Architect must be returned to the Architect at the completion of the contract.

Smith Sinnett Architecture, P.A. 2019

THIS DRAWING IS FORMATTED TO BE PRINTED ON A 24" X 36" SHEET

NEW TRINITY MIDDLE SCHOOL
RANDOLPH COUNTY SCHOOL SYSTEM

PARCEL PIN 7708118367
SURRETT DRIVE
TRINITY, NC 27370





KEY PLAN
NO SCALE

ID	DATE	DESCRIPTION
1	06.14.19	REV. PER REVIEW

DRAWN BY: SAD
CHECKED BY: SAD

OFFSITE
WATERLINE
PLAN & PROFILE

2017027 20 MAY 2019

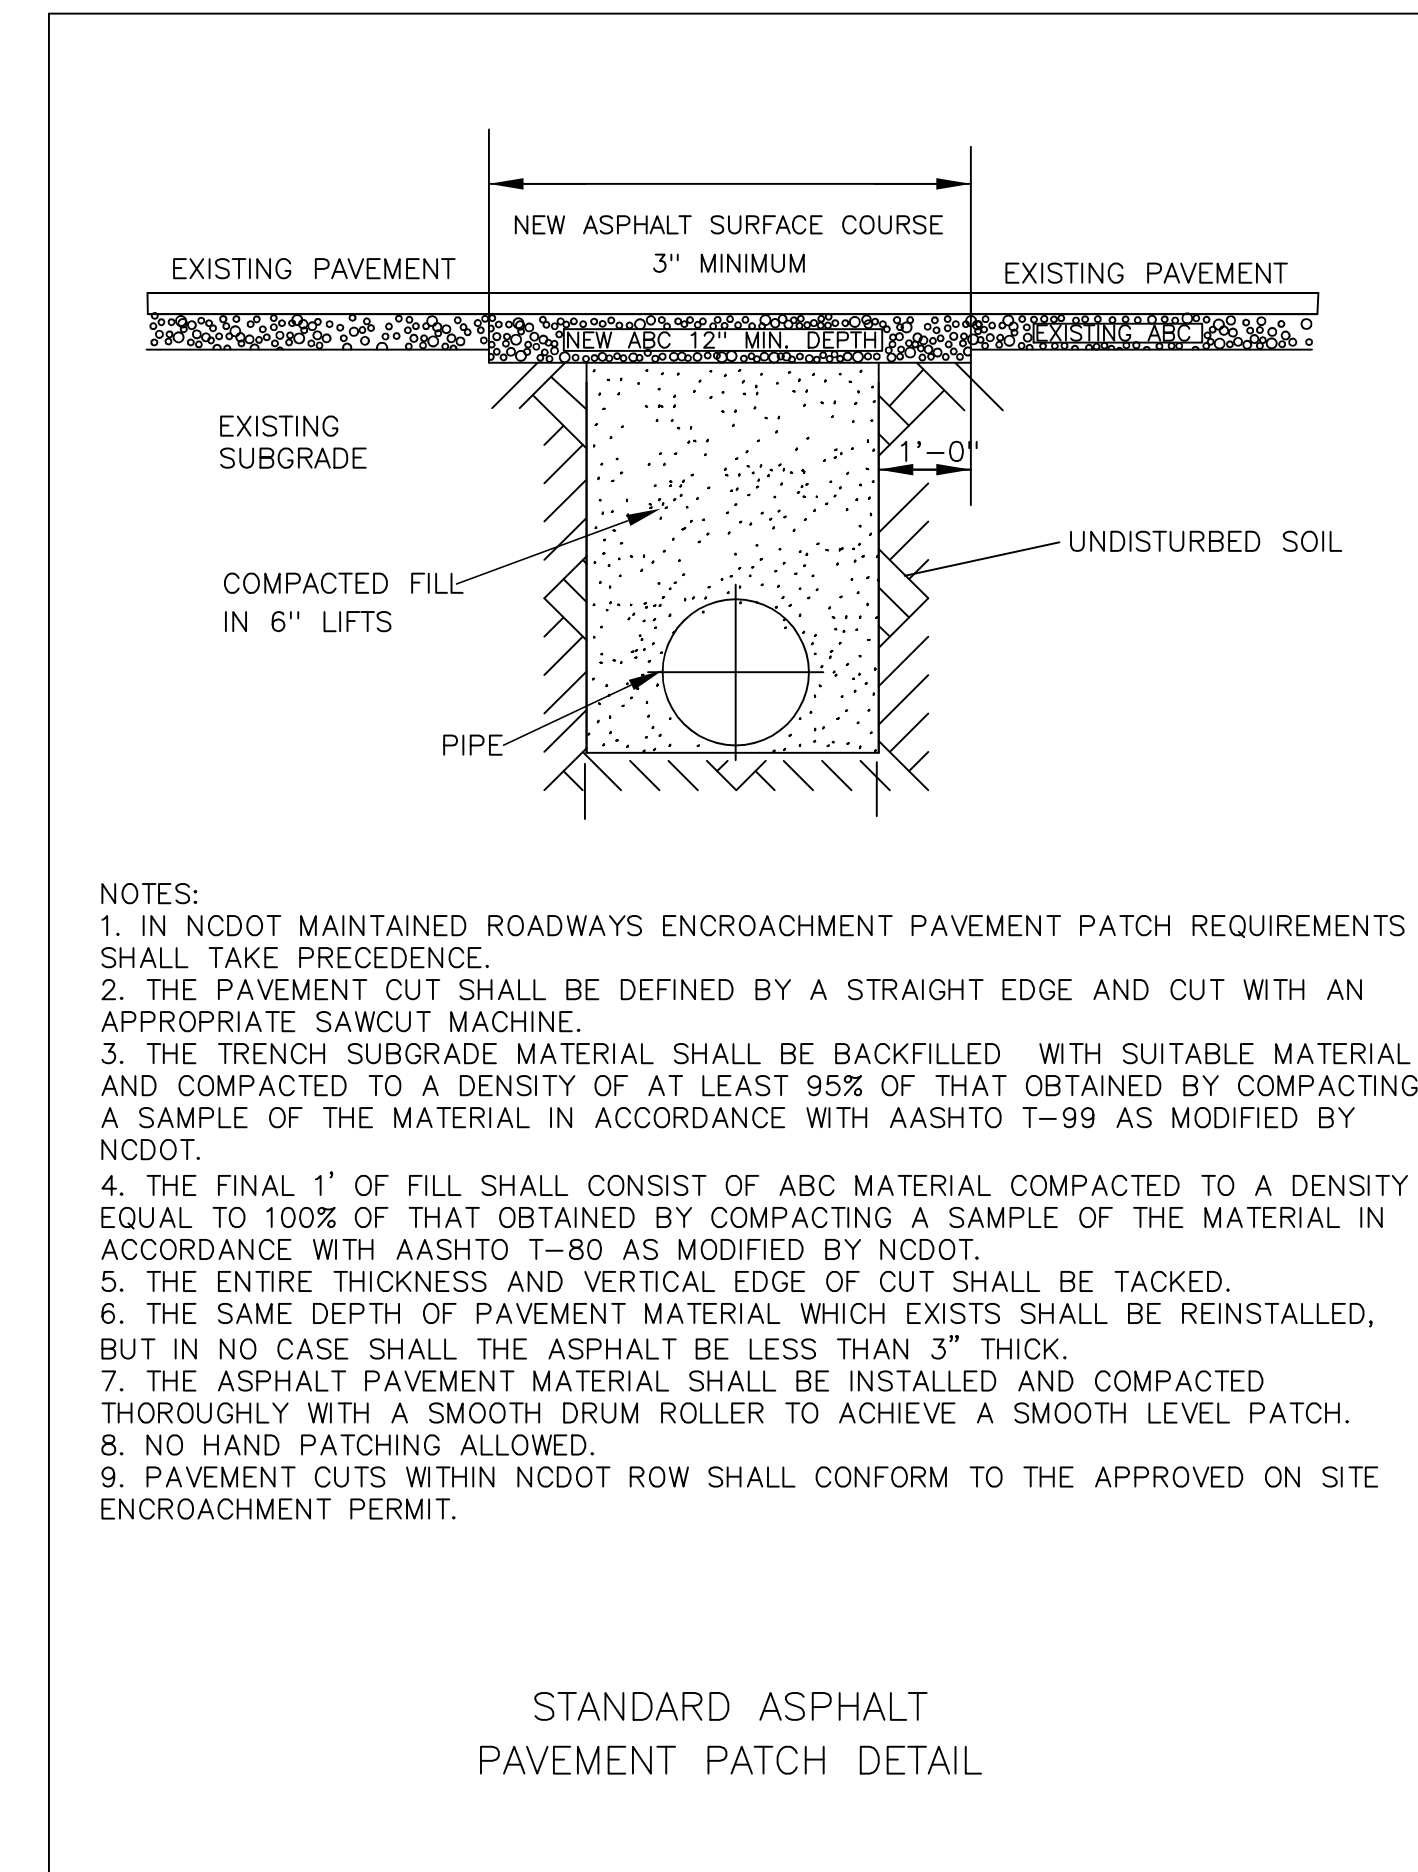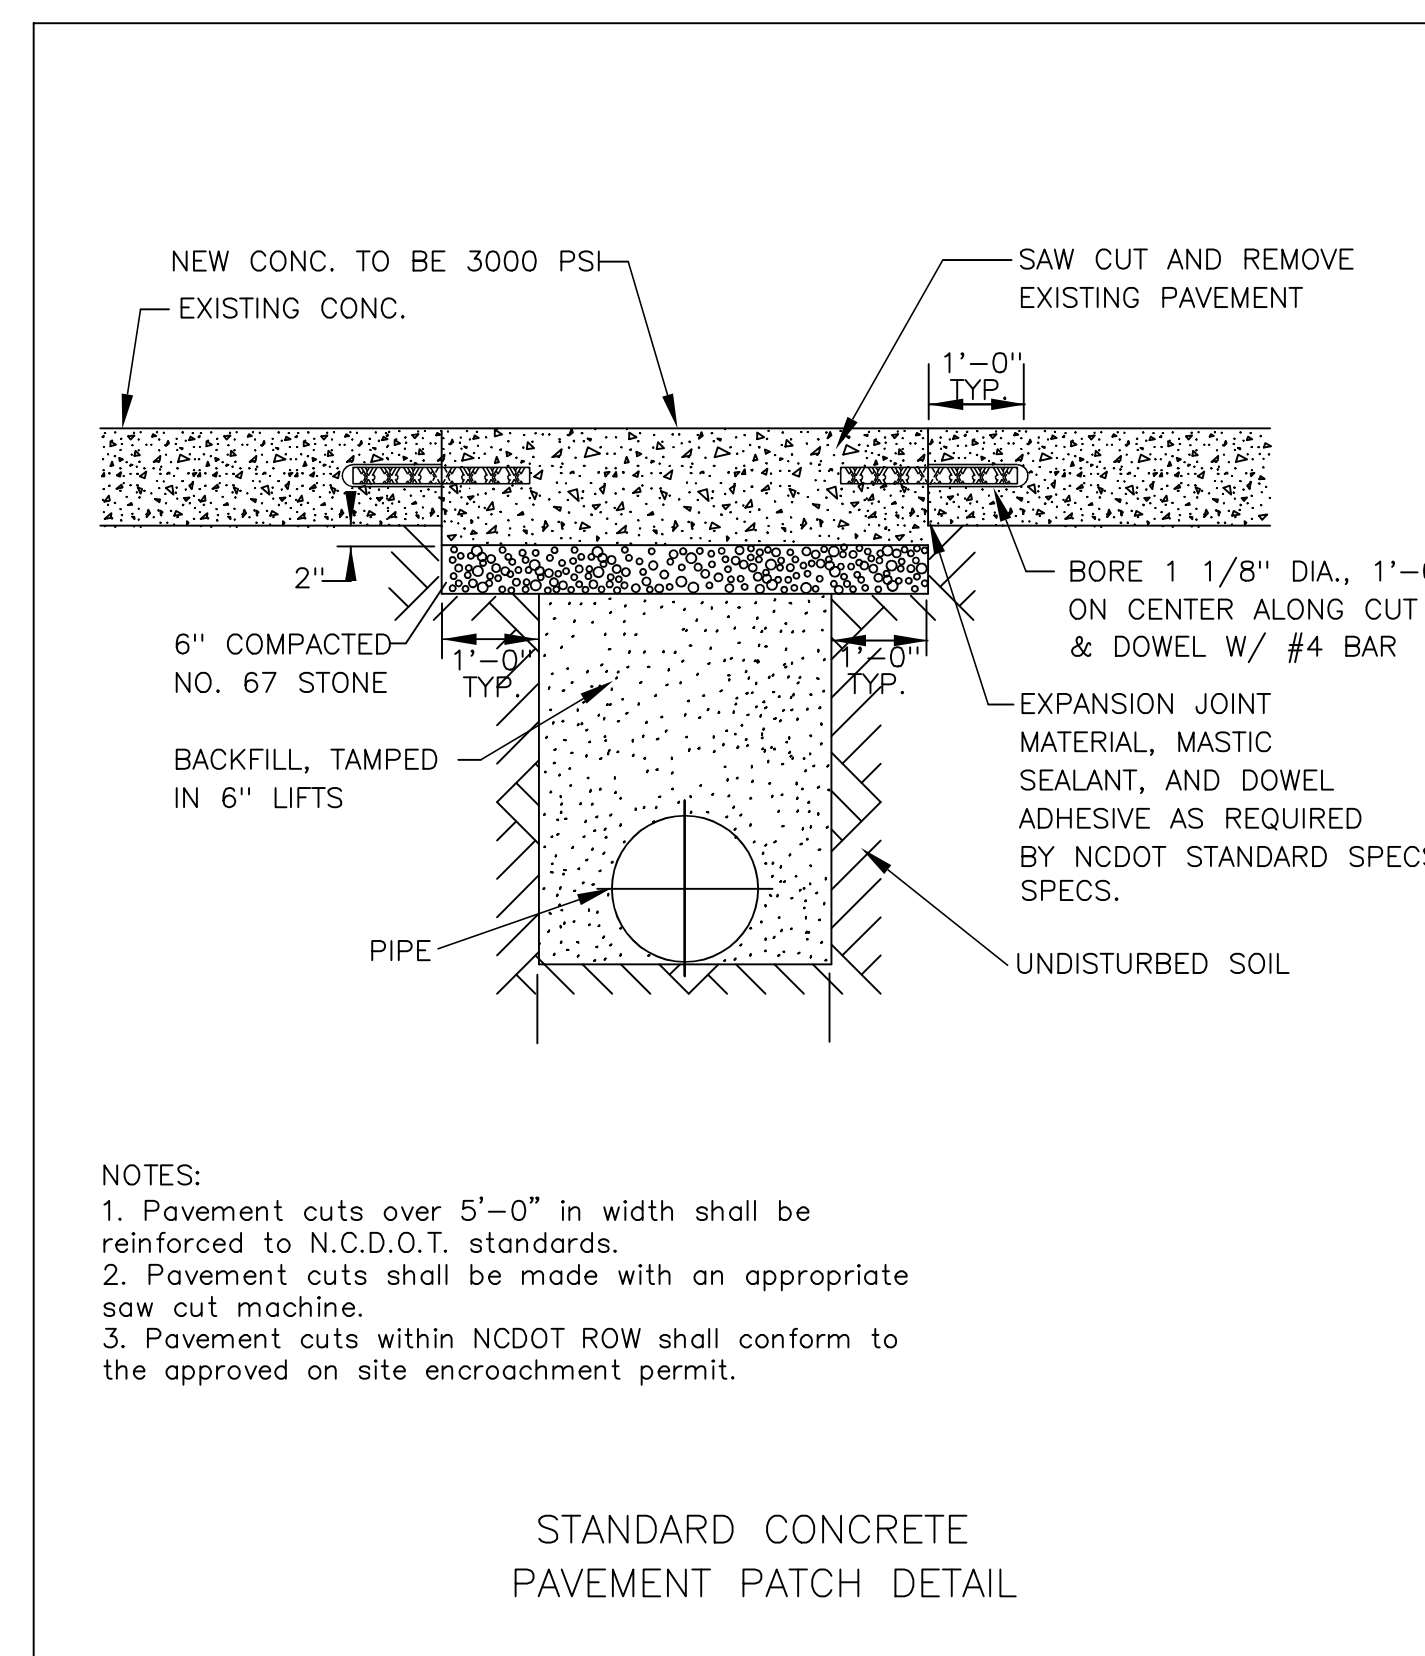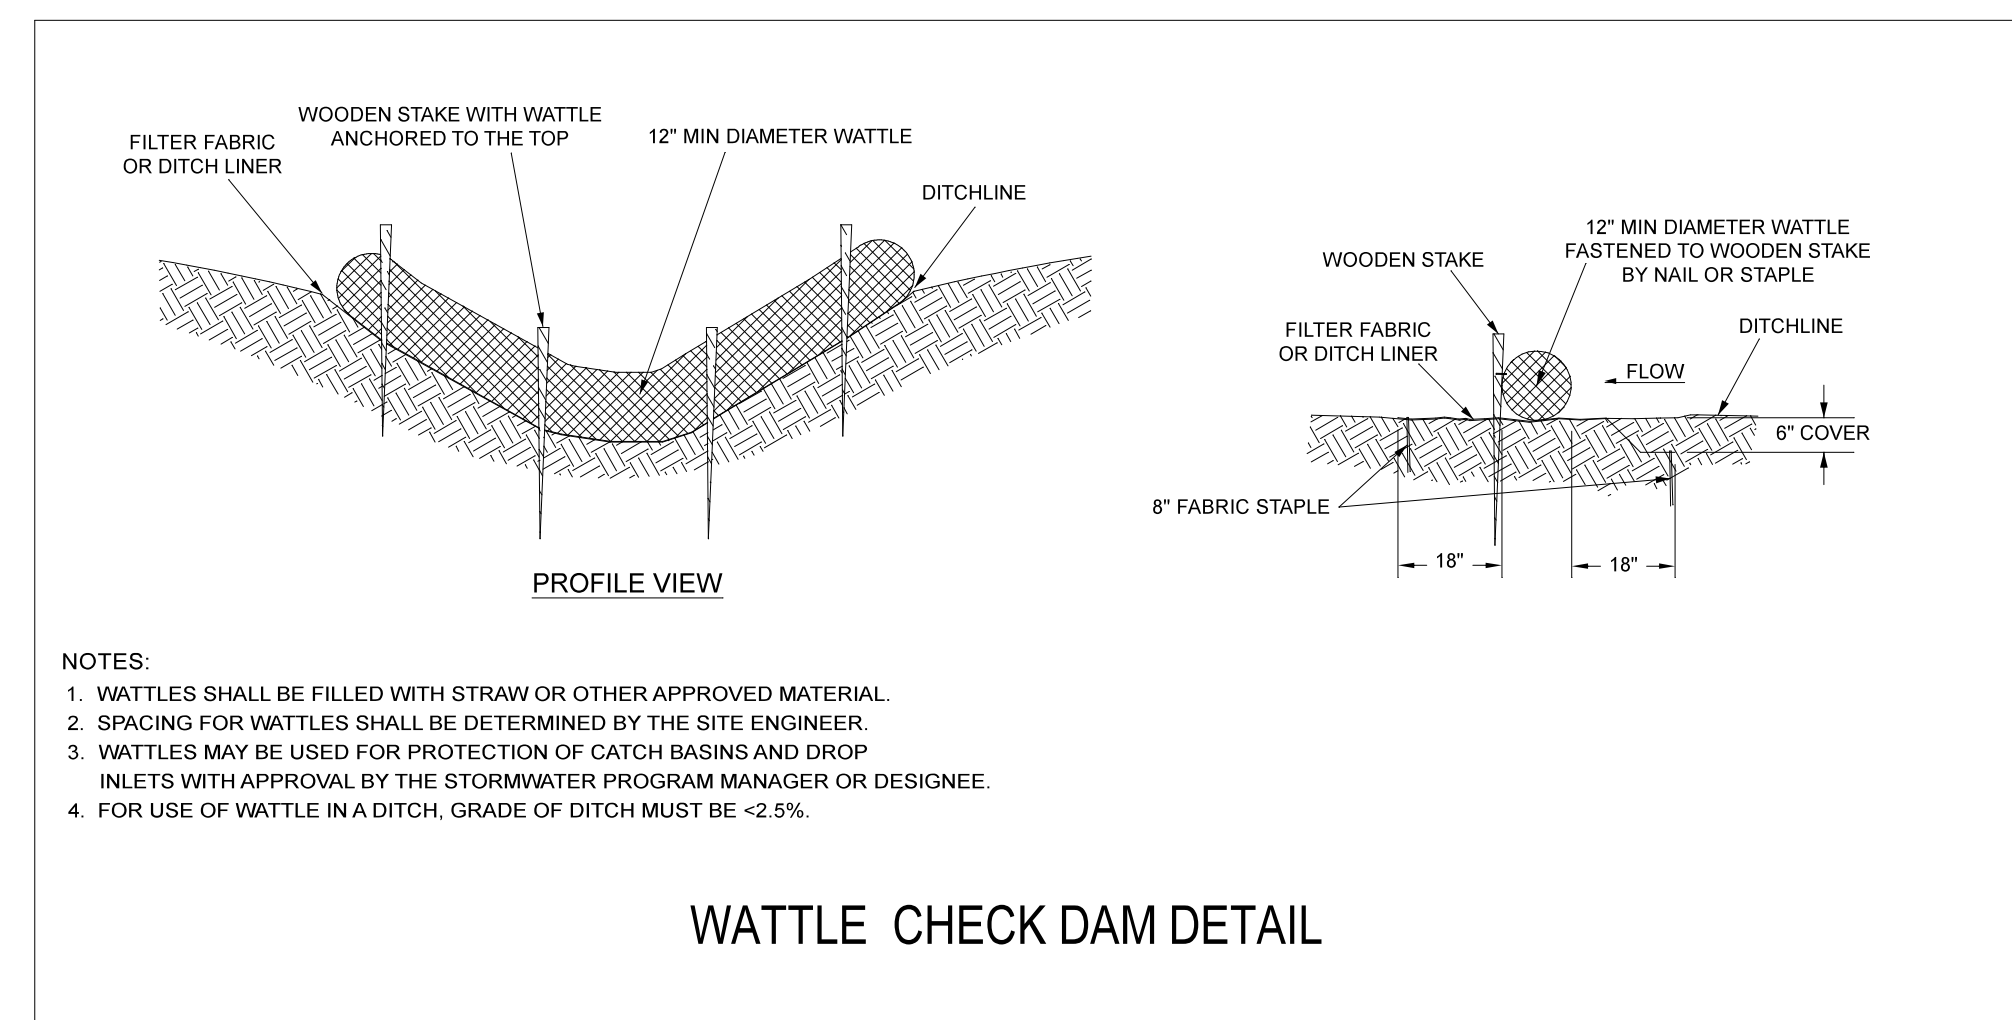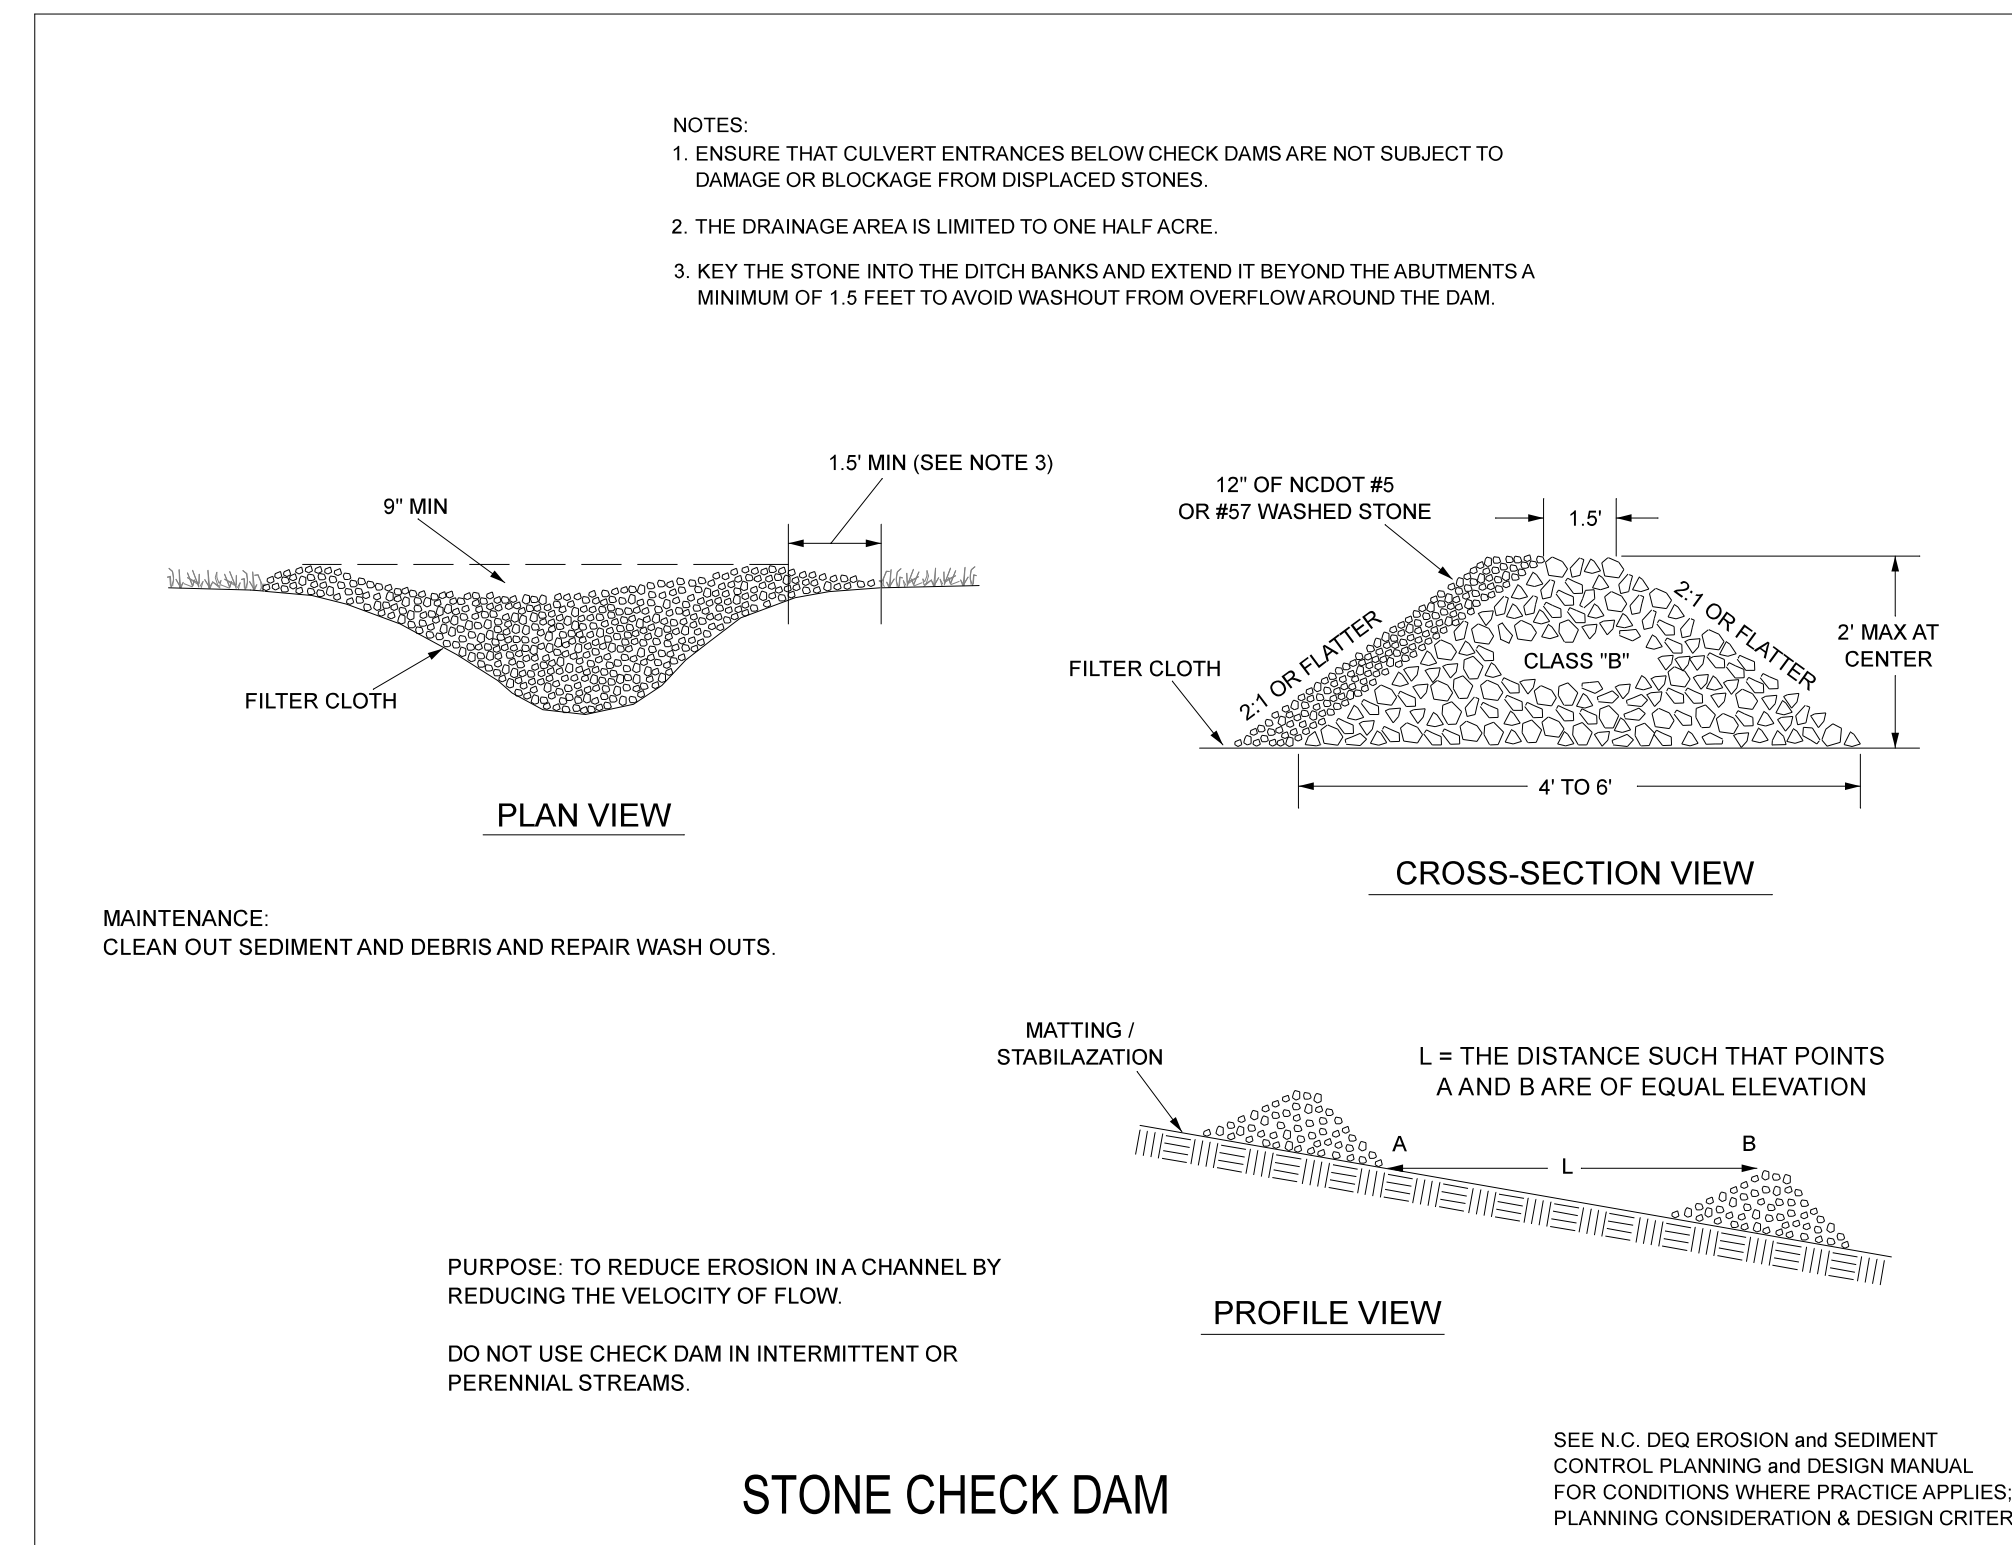

TEMPORARY SEEDING SPECIFICATIONS

Complete grading before preparing seedbeds, and install all necessary erosion control practices such as, dikes, waterways, and basins. Minimize steep slopes because they make seedbed preparation difficult and increase the erosion hazard. If soils become compacted during grading, loosen them to a depth of 6-8 inches using a ripper, harrow, or chisel plow.

SEEDBED PREPARATION

Good seedbed preparation is essential to successful plant establishment. A good seedbed is well-pulverized, loose, and uniform. Where hydrosowing methods are used, the surface may be left with a more irregular surface of large clods and stones.

Liming—Apply lime according to soil test recommendations. If the pH (acidity) of the soil is not known, an application of ground agricultural limestone at the rate of 1 to 1 1/2 tons/acre on coarse-textured soils and 2-3 tons/acre on fine-textured soils is usually sufficient. Apply limestone uniformly and incorporate into the top 4-6 inches of soil. Soils with a pH of 6 or higher need not be limed.

Fertilizer—Base application rates on soil tests. When these are not possible, apply a 10-10-10 grade fertilizer at 700-1,000 lb/acre. Both fertilizer and lime should be incorporated into the top 4-6 inches of soil. If a hydraulic seeder is used, do not mix seed and fertilizer more than 30 minutes before application.

Surface roughening—If recent tillage operations have resulted in a loose surface, additional roughening may not be required, except to break up large clods. If rainfall causes the surface to become sealed or crusted, loosen it just prior to seeding by disking, raking, harrowing, or other suitable methods. Groove or furrow slopes steeper than 3:1 on the contour before seeding (Refer to the NCDOT Erosion and Sediment Control Planning and Design Manual, Practice 6.03, Surface Roughening).

PLANT SELECTION

Select an appropriate species or species mixture from Table 6.10a for seeding in late winter and early spring, Table 6.10b for summer, and Table 6.10c for fall.

In the Mountains, December and January seedings have poor chances of success. When it is necessary to plant at these times, use recommendations for fall and a securely tacked mulch.

SEEDING

Evenly apply seed using a cyclone seeder (broadcast), drill, cultipacker seeder, or hydroseder. Use seeding rates given in Tables 6.10a-6.10c. Broadcast seeding and hydrosowing are appropriate for steep slopes where equipment cannot be driven. Hand broadcasting is not recommended because of the difficulty in achieving a uniform distribution.

Small grains should be planted no more than 1 inch deep, and grasses and legumes no more than 1/2 inch. Broadcast seed must be covered by raking or chain dragging, and then lightly firmed with a roller or cultipacker. Hydrosowed mixtures should include a wood fiber (cellulose) mulch.

MULCHING

The use of an appropriate mulch will help ensure establishment under normal conditions, and is essential to seeding success under harsh site conditions (Refer to the NCDOT Erosion and Sediment Control Planning and Design Manual, Practice 6.14, Mulching). Harsh site conditions include: • seeding in fall for winter cover (wood fiber mulches are not considered adequate for this use).

- slopes steeper than 3:1.
- excessively hot or dry weather.
- adverse soils (shallow, rocky, or high in clay or sand), and
- areas receiving concentrated flow.

If the area to be mulched is subject to concentrated water flow, as in channels, anchor mulch with netting (Refer to the NCDOT Erosion and Sediment Control Planning and Design Manual, Practice 6.14, Mulching).

TEMPORARY SEEDING MAINTENANCE

Re-seed and mulch areas where seeding emergence is poor, or where erosion occurs, as soon as possible. Do not mow. Protect from traffic as much as possible.

ALL WATERLINE CONSTRUCTION SHALL CONFORM WITH DAVIDSON WATER, INC. STANDARDS AND SPECIFICATIONS. ALL CONSTRUCTION INSIDE OF THE PUBLIC RIGHT-OF-WAY SHALL COMPLY WITH NCDOT STANDARDS AND SPECIFICATIONS.

REFER TO SHEET C-001 FOR PROJECT AND SHEET RELATED NOTES. REFER TO SHEET C-002 FOR DAVIDSON WATER NOTES.

TABLE 6.10a - TEMPORARY SEEDING RECOMMENDATIONS FOR LATE WINTER AND EARLY SPRING

SEEDING MIXTURE SPECIES	RATE (LBS/ACRE)
RYE (GRAIN)	120
ANNUAL LESPEDEZA (KOBE IN PIEDMONT AND COASTAL PLAIN, KOREAN IN MOUNTAINS)	50

OMIT ANNUAL LESPEDEZA WHEN DURATION OF TEMPORARY COVER IS NOT TO EXTEND BEYOND JUNE.

SEEDING DATES:
MOUNTAINS - ABOVE 2500 FEET: FEB. 15 - MAY 15
PIEDMONT - BELOW 2500 FEET: FEB. 1 - MAY 1
COASTAL PLAIN - JAN. 1 - MAY 1
DEC. 1 - APR. 15

SOIL AMENDMENTS:
FOLLOW RECOMMENDATIONS OF SOIL TESTS OR APPLY 2,000 LB/ACRE GROUND AGRICULTURAL LIMESTONE AND 750 LB/ACRE 10-10-10 FERTILIZER.

MULCH:
APPLY 4,000 LB/ACRE STRAW. ANCHOR STRAW BY TACKING WITH ASPHALT, NETTING, OR A MULCH ANCHORING TOOL. A DISK WITH BLADES SET NEARLY STRAIGHT CAN BE USED AS A MULCH ANCHORING TOOL.

MAINTENANCE:
REFERTILIZE IF GROWTH IS NOT FULLY ADEQUATE. RESEED, REFERTILIZE AND MULCH IMMEDIATELY FOLLOWING EROSION OR OTHER DAMAGE.

TABLE 6.10b - TEMPORARY SEEDING RECOMMENDATIONS FOR SUMMER

SEEDING MIXTURE SPECIES	RATE (LBS/ACRE)
GERMAN MILLET	40

IN THE PIEDMONT AND MOUNTAINS, A SMALL-STEMMED SUDANGRASS MAY BE SUBSTITUTED AT A RATE OF 50 LB/ACRE.

SEEDING DATES:
MOUNTAINS - MAY 15 - AUG. 15
PIEDMONT - MAY 1 - AUG. 15
COASTAL PLAIN - APR. 15 - AUG. 15

SOIL AMENDMENTS:
FOLLOW RECOMMENDATIONS OF SOIL TESTS OR APPLY 2,000 LB/ACRE GROUND AGRICULTURAL LIMESTONE AND 750 LB/ACRE 10-10-10 FERTILIZER.

MULCH:
APPLY 4,000 LB/ACRE STRAW. ANCHOR STRAW BY TACKING WITH ASPHALT, NETTING, OR A MULCH ANCHORING TOOL. A DISK WITH BLADES SET NEARLY STRAIGHT CAN BE USED AS A MULCH ANCHORING TOOL.

MAINTENANCE:
REFERTILIZE IF GROWTH IS NOT FULLY ADEQUATE. RESEED, REFERTILIZE AND MULCH IMMEDIATELY FOLLOWING EROSION OR OTHER DAMAGE.

TABLE 6.10c - TEMPORARY SEEDING RECOMMENDATIONS FOR FALL

SEEDING MIXTURE SPECIES	RATE (LBS/ACRE)
RYE (GRAIN)	120

SEEDING DATES:
MOUNTAINS - AUG. 15 - DEC. 15
PIEDMONT - AUG. 15 - DEC. 30
COASTAL PLAIN - AUG. 15 - DEC. 30

SOIL AMENDMENTS:
FOLLOW RECOMMENDATIONS OF SOIL TESTS OR APPLY 2,000 LB/ACRE GROUND AGRICULTURAL LIMESTONE AND 1,000 LB/ACRE 10-10-10 FERTILIZER.

MULCH:
APPLY 4,000 LB/ACRE STRAW. ANCHOR STRAW BY TACKING WITH ASPHALT, NETTING, OR A MULCH ANCHORING TOOL. A DISK WITH BLADES SET NEARLY STRAIGHT CAN BE USED AS A MULCH ANCHORING TOOL.


MAINTENANCE:
REPAIR AND REFERTILIZE DAMAGED AREAS IMMEDIATELY. TOPDRESS WITH 50 LB/ACRE OF NITROGEN IN MARCH. IF IT IS NECESSARY TO EXTEND TEMPORARY COVER BEYOND JUNE 15, OVERSEED WITH 50 LB/ACRE KOBE (PIEDMONT AND COASTAL PLAIN) OR KOREAN (MOUNTAINS) LESPEDEZA IN LATE FEBRUARY OR EARLY MARCH.

T 919 781 8882

4600 Lake Boone Trail
Suite 205
Raleigh, NC 27607

info@smithsinnett.com

4909 Liles Road
Raleigh, NC 27606
919.438.3694 (o)
Firm License C-3898

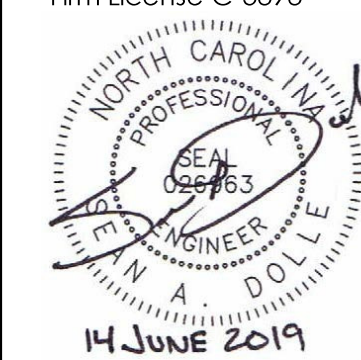

BID SET

This drawing and the design shown is the property of Smith Sinnett Architecture, P.A. The reproduction or use of this drawing without the written consent of the Architect is prohibited. Any management of this drawing must be returned to the Architect at the completion of the contract.
Smith Sinnett Architecture, P.A. 2019
THIS DRAWING IS FORMATTED TO BE PRINTED ON A 24" X 36" SHEET

NEW TRINITY MIDDLE SCHOOL
RANDOLPH COUNTY SCHOOL SYSTEM

PARCEL PIN 7708118367
SURRETT DRIVE
TRINITY, NC 27370

KEY PLAN
NO SCALE

ID	DATE	DESCRIPTION
1	06.14.19	REV. PER REVIEW

DRAWN BY: SAD

CHECKED BY: SAD

OFFSITE
WATERLINE
EROSION
CONTROL DETAILS
2017027 20 MAY 2019



Know what's below.
Call before you dig.

ALL WATERLINE CONSTRUCTION SHALL CONFORM WITH DAVIDSON WATER, INC. STANDARDS AND SPECIFICATIONS. ALL CONSTRUCTION INSIDE OF THE PUBLIC RIGHT-OF-WAY SHALL COMPLY WITH NCDOT STANDARDS AND SPECIFICATIONS.

REFER TO SHEET C-001 FOR PROJECT AND SHEET RELATED NOTES. REFER TO SHEET C-002 FOR DAVIDSON WATER NOTES.

CHECK DAM MAINTENANCE

INSPECT CHECK DAMS AND CHANNELS AT LEAST WEEKLY AND AFTER EACH SIGNIFICANT (1/2 INCH OR GREATER) RAINFALL EVENT AND REPAIR IMMEDIATELY. CLEAN OUT SEDIMENT, STRAW, LIMBS, OR OTHER DEBRIS THAT COULD CLOG THE CHANNEL WHEN NEEDED.

ANTICIPATE SUBMERGENCE AND DEPOSITION ABOVE THE CHECK DAM AND EROSION FROM HIGH FLOWS AROUND THE EDGES OF THE DAM. CORRECT ALL DAMAGE IMMEDIATELY. IF SIGNIFICANT EROSION OCCURS BETWEEN DAMS, ADDITIONAL MEASURE CAN BE TAKEN SUCH AS INSTALLING A PROTECTIVE RIPRAP LINER IN THAT PORTION OF THE CHANNEL.

REMOVE SEDIMENT ACCUMULATED BEHIND THE DAMS AS NEEDED TO PREVENT DAMAGE TO CHANNEL VEGETATION. ALLOW THE CHANNEL TO DRAIN THROUGH THE STONE CHECK DAM, AND PREVENT LARGE FLOWS FROM CARRYING SEDIMENT OVER THE DAM. ADD STONES TO DAMS AS NEEDED TO MAINTAIN DESIGN HEIGHT AND CROSS SECTION.


SILT FENCE MAINTENANCE

INSPECT SEDIMENT FENCES AT LEAST ONCE A WEEK AND AFTER EACH RAINFALL. MAKE ANY REQUIRED REPAIRS IMMEDIATELY.

SHOULD THE FABRIC FOR A SEDIMENT FENCE COLLAPSE, TEAR, DECOMPOSE, OR BECOME INEFFECTIVE, REPLACE IT PROMPTLY.

REMOVE SEDIMENT DEPOSITS AS NECESSARY TO PROVIDE ADEQUATE STORAGE VOLUME FOR THE NEXT RAIN AND TO REDUCE PRESSURE ON THE FENCE. TAKE CARE TO AVOID UNDERMINING THE FENCE DURING CLEANOUT.

REMOVE ALL FENCING MATERIALS AND UNSTABLE SEDIMENT DEPOSITS AND BRING THE AREA TO GRADE AND STABILIZE IT AFTER THE CONTRIBUTING DRAINAGE AREA HAS BEEN PROPERLY STABILIZED.

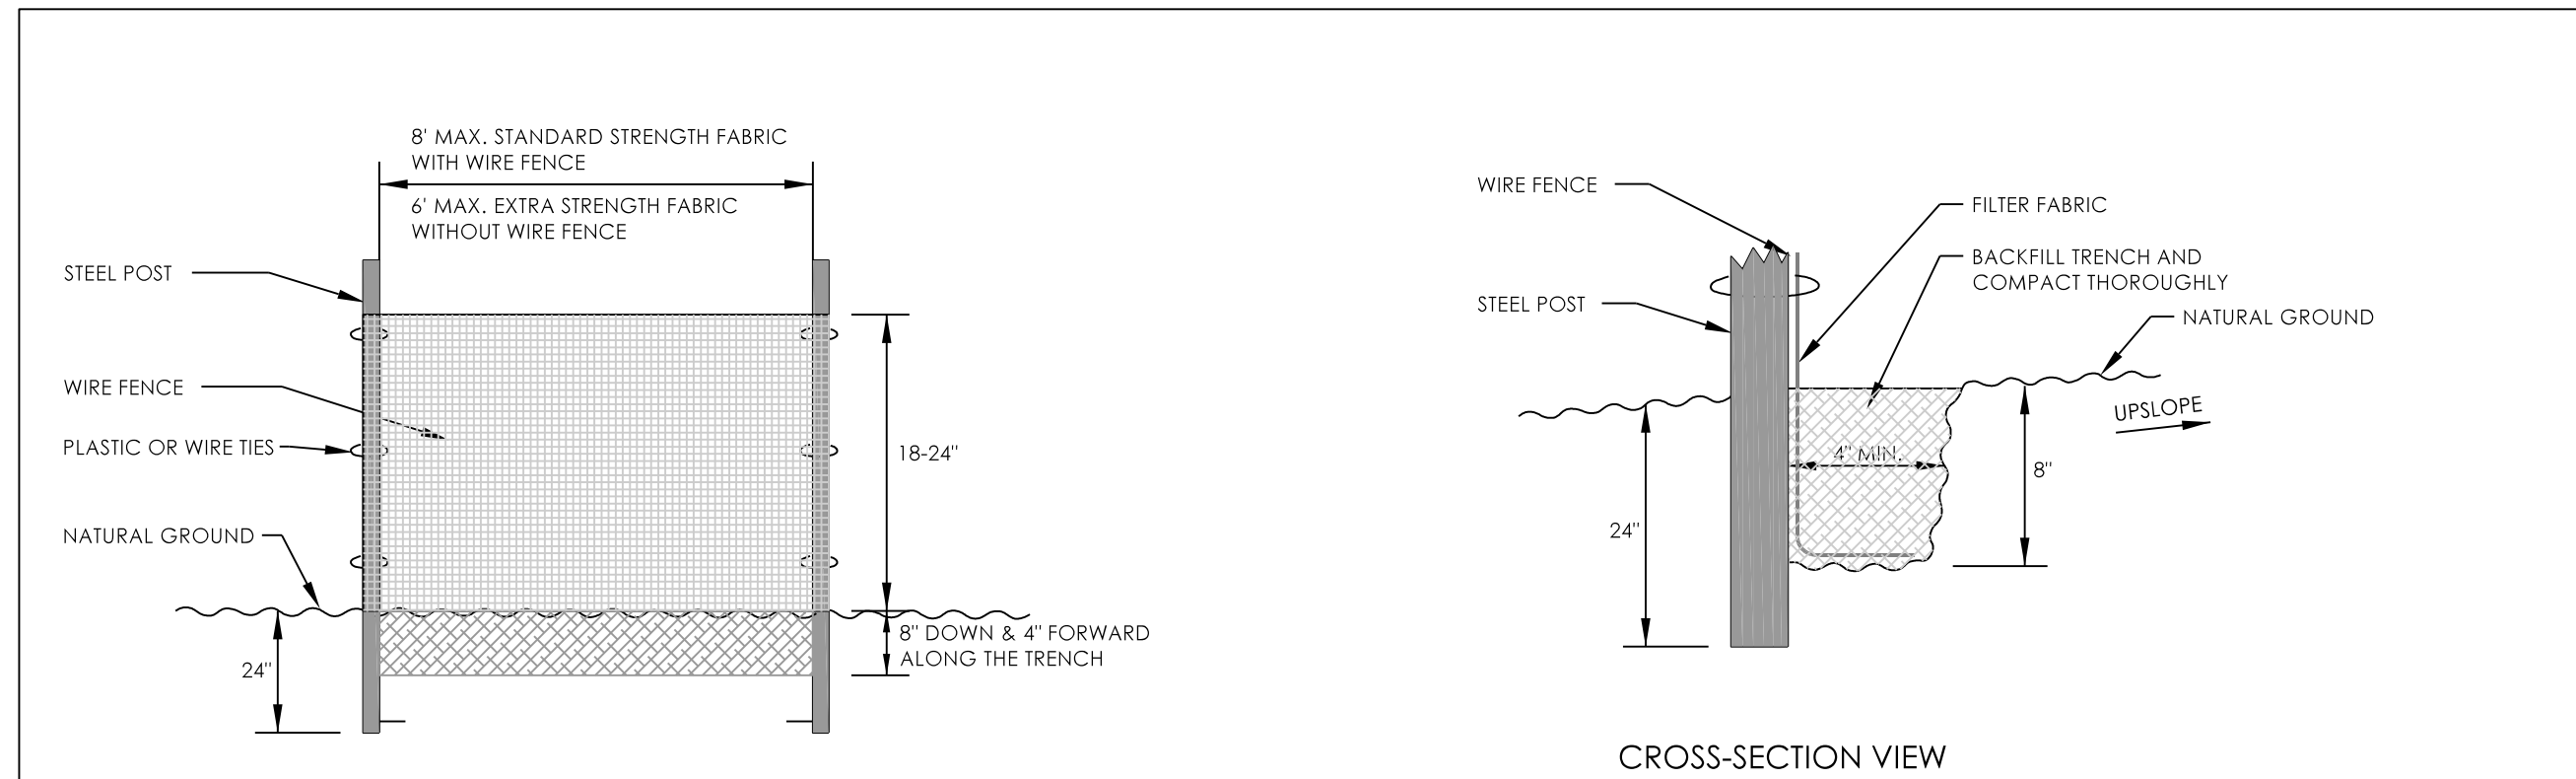

MATERIAL SPECIFICATIONS

1. USE A SYNTHETIC FILTER FABRIC OF AT LEAST 95% BY WEIGHT OF POLYOLEFINS OR POLYESTER, WHICH IS CERTIFIED BY THE MANUFACTURER OR SUPPLIER AS CONFORMING TO THE REQUIREMENTS OF ASTM D 6461, WHICH IS SHOWN IN PART IN TABLE 6-62b IN THE NCDOT EROSION AND SEDIMENT CONTROL PLANNING AND DESIGN MANUAL. SYNTHETIC FILTER FABRIC SHOULD CONTAIN ULTRAVIOLET RAY INHIBITORS AND STABILIZERS TO PROVIDE A MINIMUM OF 6 MONTHS OF EXPECTED USABLE CONSTRUCTION LIFE AT A TEMPERATURE RANGE OF 0 DEGREES TO 120 DEGREES FARENHEIT.
2. ENSURE THAT POSTS FOR SEDIMENT FENCES ARE 1.25 LB/LINEAR FOOT MINIMUM STEEL WITH A MINIMUM LENGTH OF 5 FEET. MAKE SURE THAT STEEL POSTS HAVE PROJECTIONS TO FACILITATE FASTENING THE FABRIC.
3. FOR REINFORCEMENT OF STANDARD STRENGTH FILTER FABRIC, USE WIRE FENCE WITH A MINIMUM 14 GAUGE AND A MAXIMUM MESH SPACING OF 6 INCHES.

CONSTRUCTION SPECIFICATIONS

1. CONSTRUCT THE SEDIMENT BARRIER OF STANDARD STRENGTH OR EXTRA STRENGTH SYNTHETIC FILTER FABRICS.
2. ENSURE THAT THE HEIGHT OF THE SEDIMENT FENCE DOES NOT EXCEED 24 INCHES ABOVE THE GROUND SURFACE. (HIGHER FENCES MAY IMPOUND VOLUMES OF WATER SUFFICIENT TO CAUSE FAILURE OF THE STRUCTURE.)
3. CONSTRUCT THE FILTER FABRIC FROM A CONTINUOUS ROLL CUT TO THE LENGTH OF THE BARRIER TO AVOID JOINTS. WHEN JOINTS ARE NECESSARY, SECURELY FASTEN THE FILTER CLOTH ONLY AT A SUPPORT POST WITH 4 FEET MINIMUM OVERLAP TO THE NEXT POST.
4. SUPPORT STANDARD LENGTH FILTER FABRIC BY WIRE MESH FASTENED SECURELY TO THE UPSLOPE SIDE OF THE POSTS. EXTEND THE WIRE MESH SUPPORT TO THE BOTTOM OF THE TRENCH. FASTEN THE WIRE REINFORCEMENT, THEN FABRIC ON THE UPSLOPE SIDE OF THE FENCE POST. WIRE OR PLASTIC ZIP TIES SHOULD HAVE MINIMUM 50 POUND TENSILE STRENGTH.
5. WHEN A WIRE MESH SUPPORT FENCE IS USED, SPACE POSTS A MAXIMUM OF 8 FEET APART. SUPPORT POSTS SHOULD BE DRIVEN SECURELY INTO THE GROUND A MINIMUM OF 24 INCHES.
6. EXTRA STRENGTH FILTER FABRIC WITH 6 FEET POST SPACING DOES NOT REQUIRE WIRE MESH SUPPORT FENCE. SECURELY FASTEN THE FILTER FABRIC DIRECTLY TO POSTS. WIRE OR PLASTIC ZIP TIES SHOULD HAVE MINIMUM 50 POUND TENSILE STRENGTH.
7. EXCAVATE A TRENCH APPROXIMATELY 4 INCHES WIDE AND 8 INCHES DEEP ALONG THE PROPOSED LINE OF POSTS AND UPSLOPE FROM THE BARRIER.
8. PLACE 12 INCHES OF THE FABRIC ALONG THE BOTTOM AND SIDE OF THE TRENCH.
9. BACKFILL THE TRENCH WITH SOIL PLACED OVER THE FILTER FABRIC AND COMPACT. THOROUGH COMPACTION OF THE BACKFILL IS CRITICAL TO SILT FENCE PERFORMANCE.
10. DO NOT ATTACH FILTER FABRIC TO EXISTING TREES.

INSTALLATION SPECIFICATIONS

1. THE BASE OF BOTH END POSTS SHOULD BE AT LEAST ONE FOOT HIGHER THAN THE MIDDLE OF THE FENCE. CHECK WITH LEVEL IF NECESSARY.
2. INSTALL POSTS 4 FEET APART IN CRITICAL AREAS AND 6 FEET APART ON STANDARD APPLICATIONS.
3. INSTALL POSTS 2 FEET DEEP ON DOWNSTREAM SIDE OF THE SILT FENCE, AND AS CLOSE AS POSSIBLE TO THE FABRIC, ENABLING POSTS TO SUPPORT THE FABRIC FROM UPSTREAM WATER PRESSURE.
4. INSTALL POSTS WITH TEN NIPPLES FACING AWAY FROM THE FILTER FABRIC.
5. ATTACH THE FABRIC TO EACH POST WITH THREE TIES, ALL SPACED WITH THE TOP 9 INCHES OF THE FABRIC. ATTACH EACH TIE DIAGONALLY 45-DEGREES THROUGH THE FABRIC, WITH EACH PUNCTURE AT LEAST 1 INCH VERTICALLY APART. ALSO, EACH TIE SHOULD BE POSITIONED TO HANG ON A POST NIPPLE WHEN TIGHTENING TO PREVENT SAGGING.
6. WRAP APPROXIMATELY 6 INCHES OF FABRIC AROUND THE END POSTS AND SECURE WITH 3 TIES.
7. NO MORE THAN 24 INCHES OF A 36 INCH FABRIC IS ALLOWED ABOVE GROUND LEVEL.
8. THE INSTALLATION SHOULD BE CHECKED AND CORRECTED FOR ANY DEVIATIONS BEFORE COMPACTION.
9. COMPACTION IS VITALLY IMPORTANT FOR EFFECTIVE RESULTS. COMPACT THE SOIL IMMEDIATELY NEXT TO THE SILT FENCE FABRIC WITH THE FRONT WHEEL OF THE TRACTOR, SKID STEER, OR ROLLER EXERTING AT LEAST 60 POUNDS PER SQUARE INCH. COMPACT THE UPSLOPE SIDE FIRST, AND THEN EACH SIDE TWICE FOR A TOTAL OF 4 TRIPS.

MAINTENANCE REQUIREMENTS

INSPECT SEDIMENT FENCES AT LEAST ONCE A WEEK AND AFTER EACH RAINFALL. MAKE ANY REQUIRED REPAIRS IMMEDIATELY.


SHOULD THE FABRIC OF A SEDIMENT FENCE COLLAPSE, TEAR, DECOMPOSE OR BECOME INEFFECTIVE, REPLACE IT PROMPTLY.

REMOVE SEDIMENT DEPOSITS AS NECESSARY TO PROVIDE ADEQUATE STORAGE VOLUME FOR THE NEXT RAIN AND TO REDUCE PRESSURE ON THE FENCE. TAKE CARE TO AVOID UNDERMINING THE FENCE DURING CLEANOUT.

REMOVE ALL FENCING MATERIALS AND UNSTABLE SEDIMENT DEPOSITS AND BRING THE AREA TO GRADE AND STABILIZE IT AFTER THE CONTRIBUTING DRAINAGE AREA HAS BEEN PROPERLY STABILIZED.

TEMPORARY SILT FENCE (SEDIMENT FENCE)

NOT TO SCALE

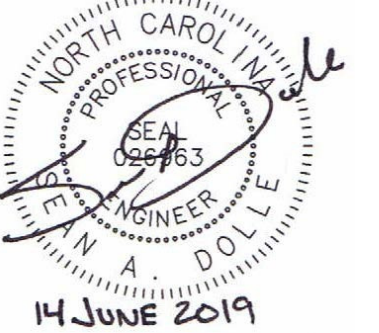

BID SET

This drawing and the design shown is the property of Smith Sinnett Architecture, P.A. The reproduction or use of this drawing without the written consent of the Architect is prohibited. Any arrangement for the reproduction of this drawing must be returned to the Architect at the completion of the contract.
Smith Sinnett Architecture, P.A. 2019

THIS DRAWING IS FORMATTED TO BE PRINTED ON A 24" X 36" SHEET

NEW TRINITY MIDDLE SCHOOL
RANDOLPH COUNTY SCHOOL SYSTEM

PARCEL PIN 7708118367
SURRETT DRIVE
TRINITY, NC 27370

KEY PLAN
NO SCALE




ID	DATE	REV.	PER	DESCRIPTION
1	06.14.19			REV. PER REVIEW

DRAWN BY: SAD
CHECKED BY: SAD


OFFSITE
WATERLINE
EROSION
CONTROL DETAILS
2017027 20 MAY 2019




Know what's below.
Call before you dig.

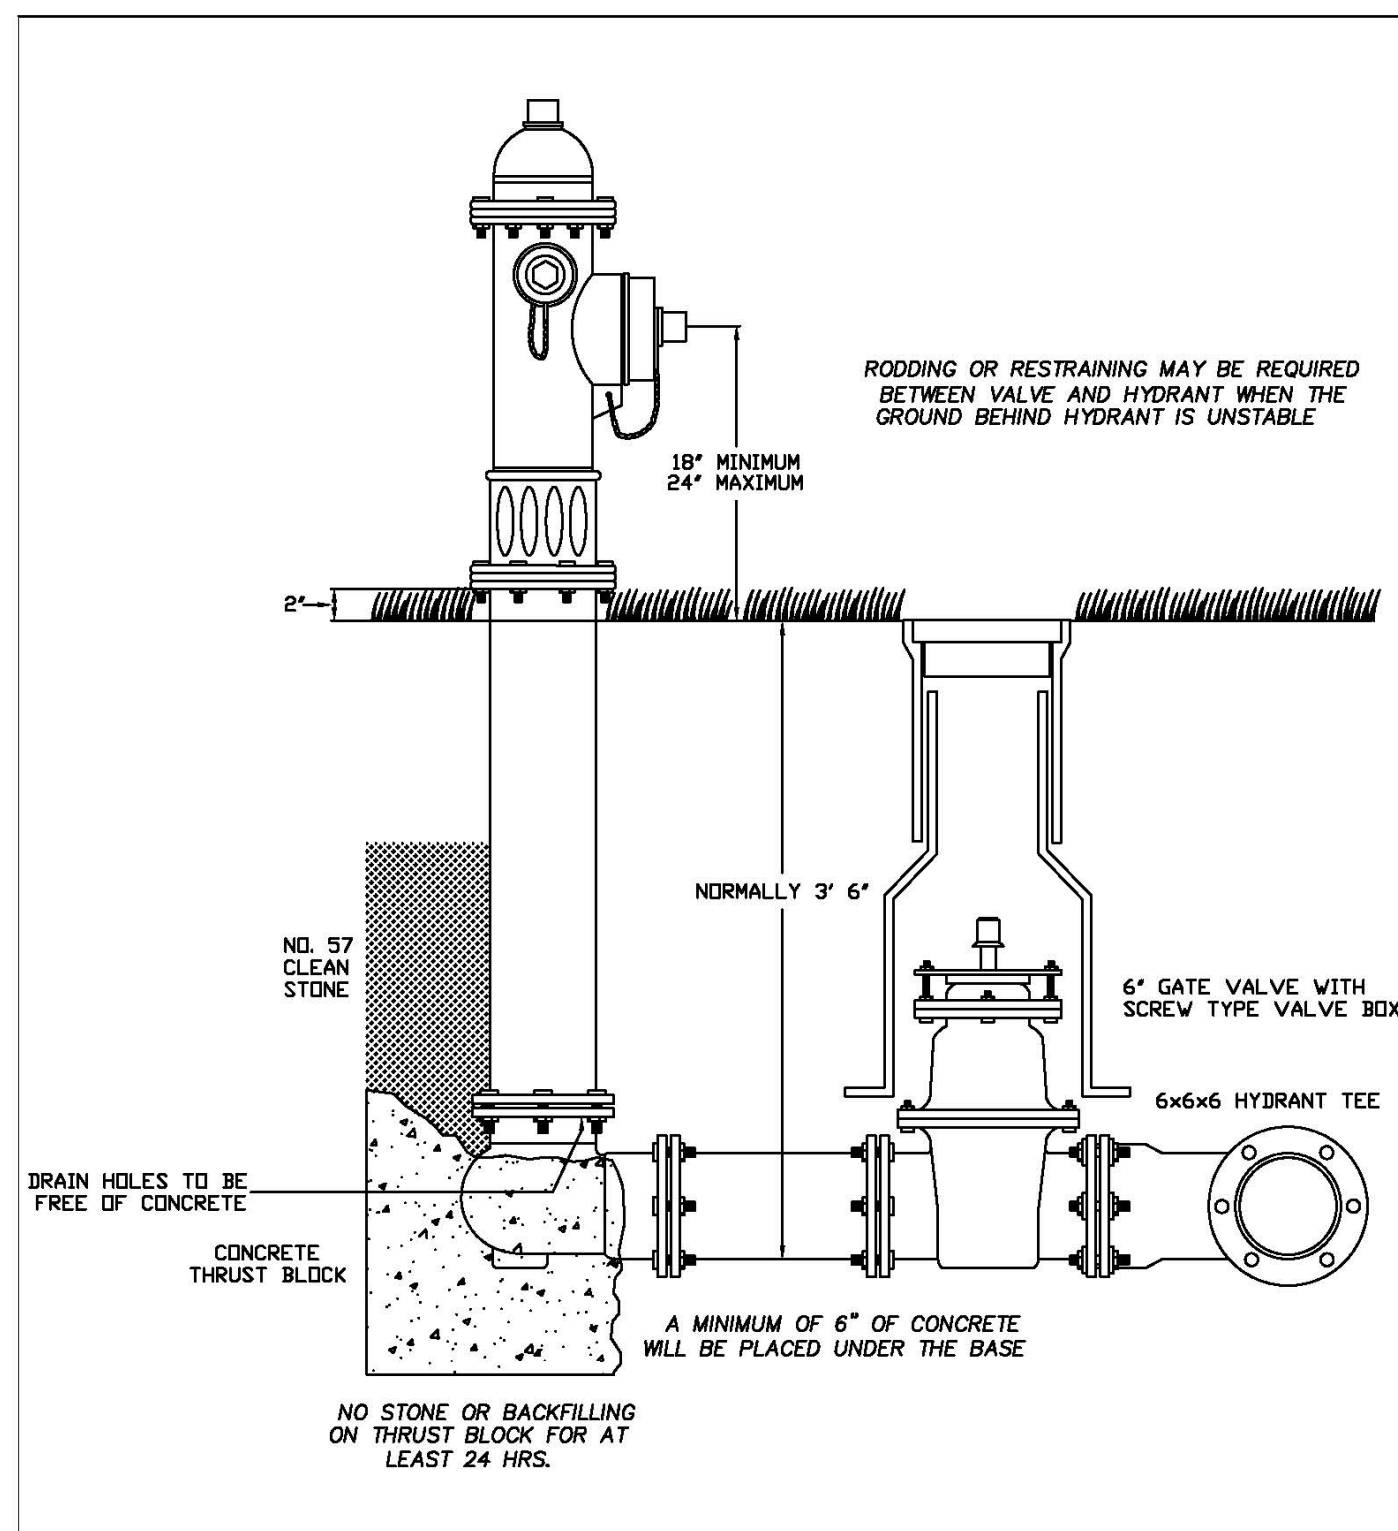

TYPICAL FIRE HYDRANT INSTALLATION

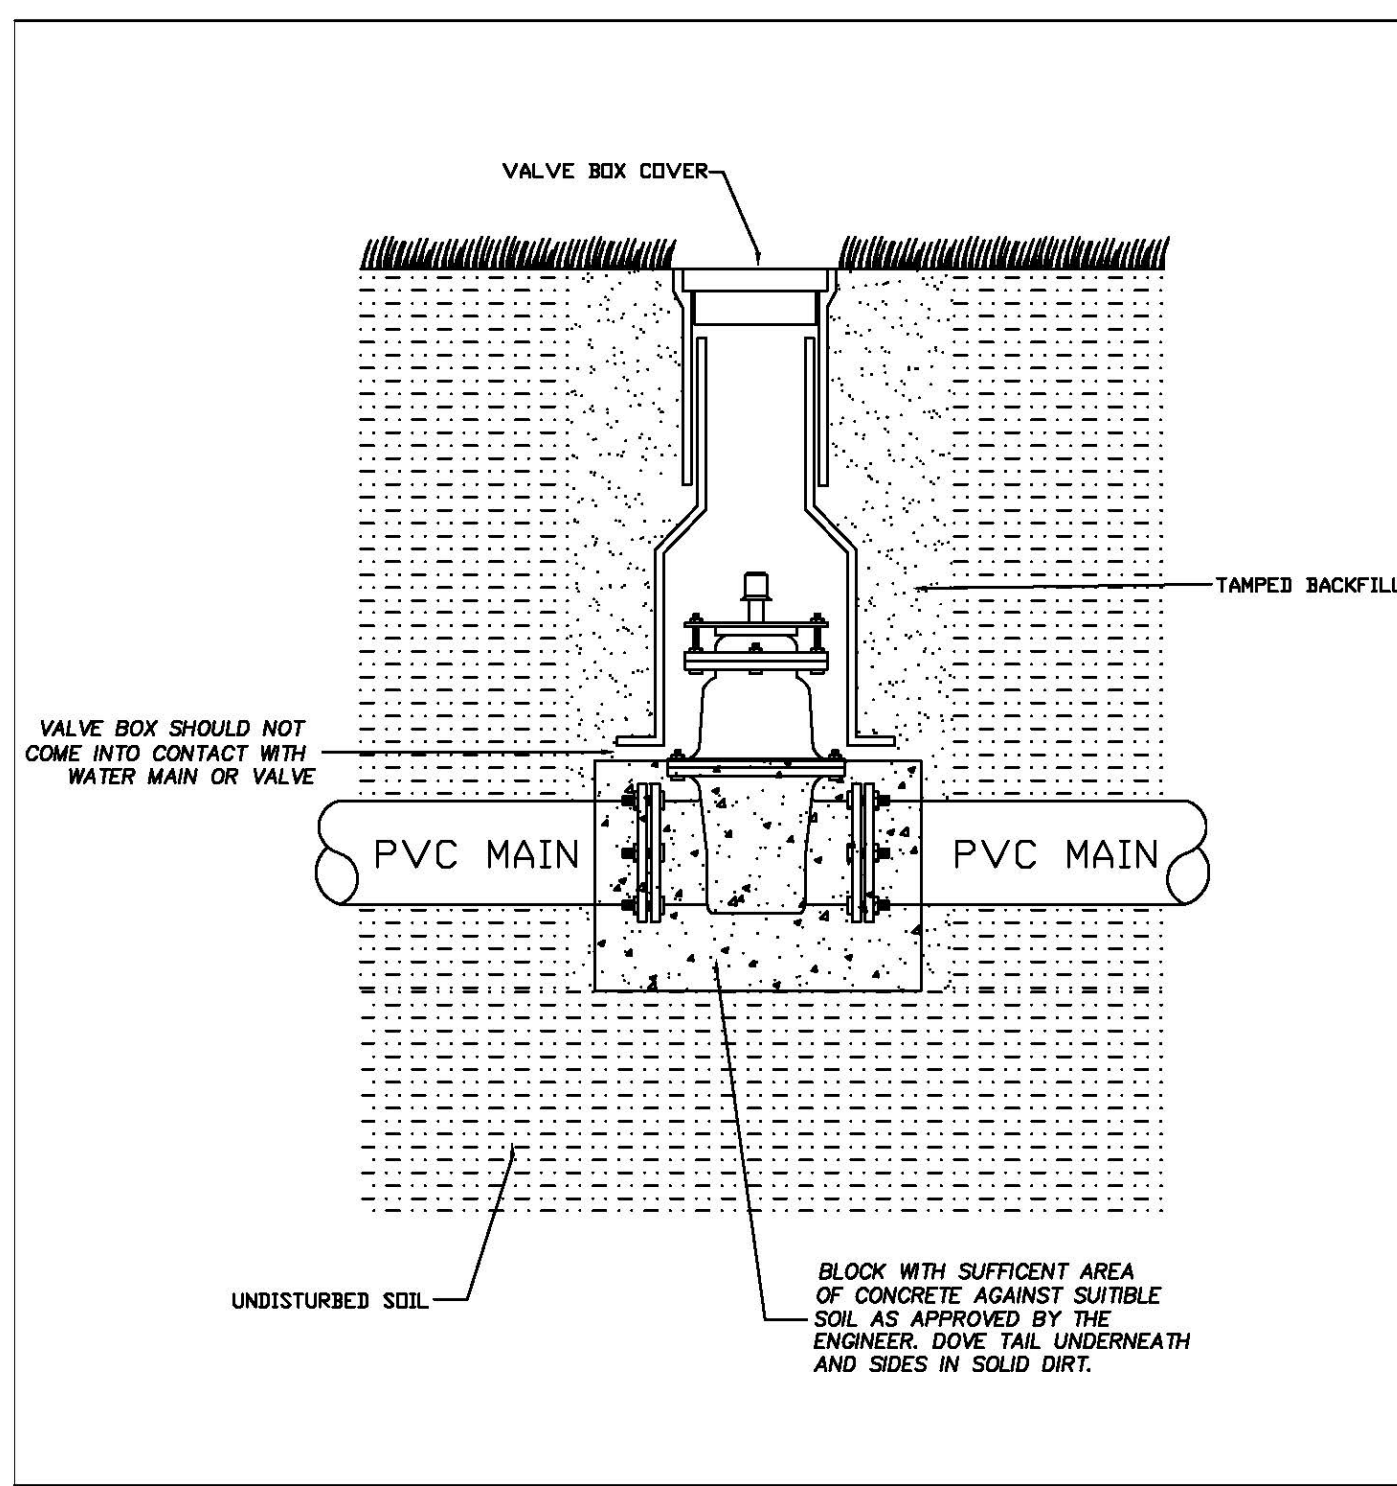


TYPICAL IN LINE WATER VALVE INSTALLATION

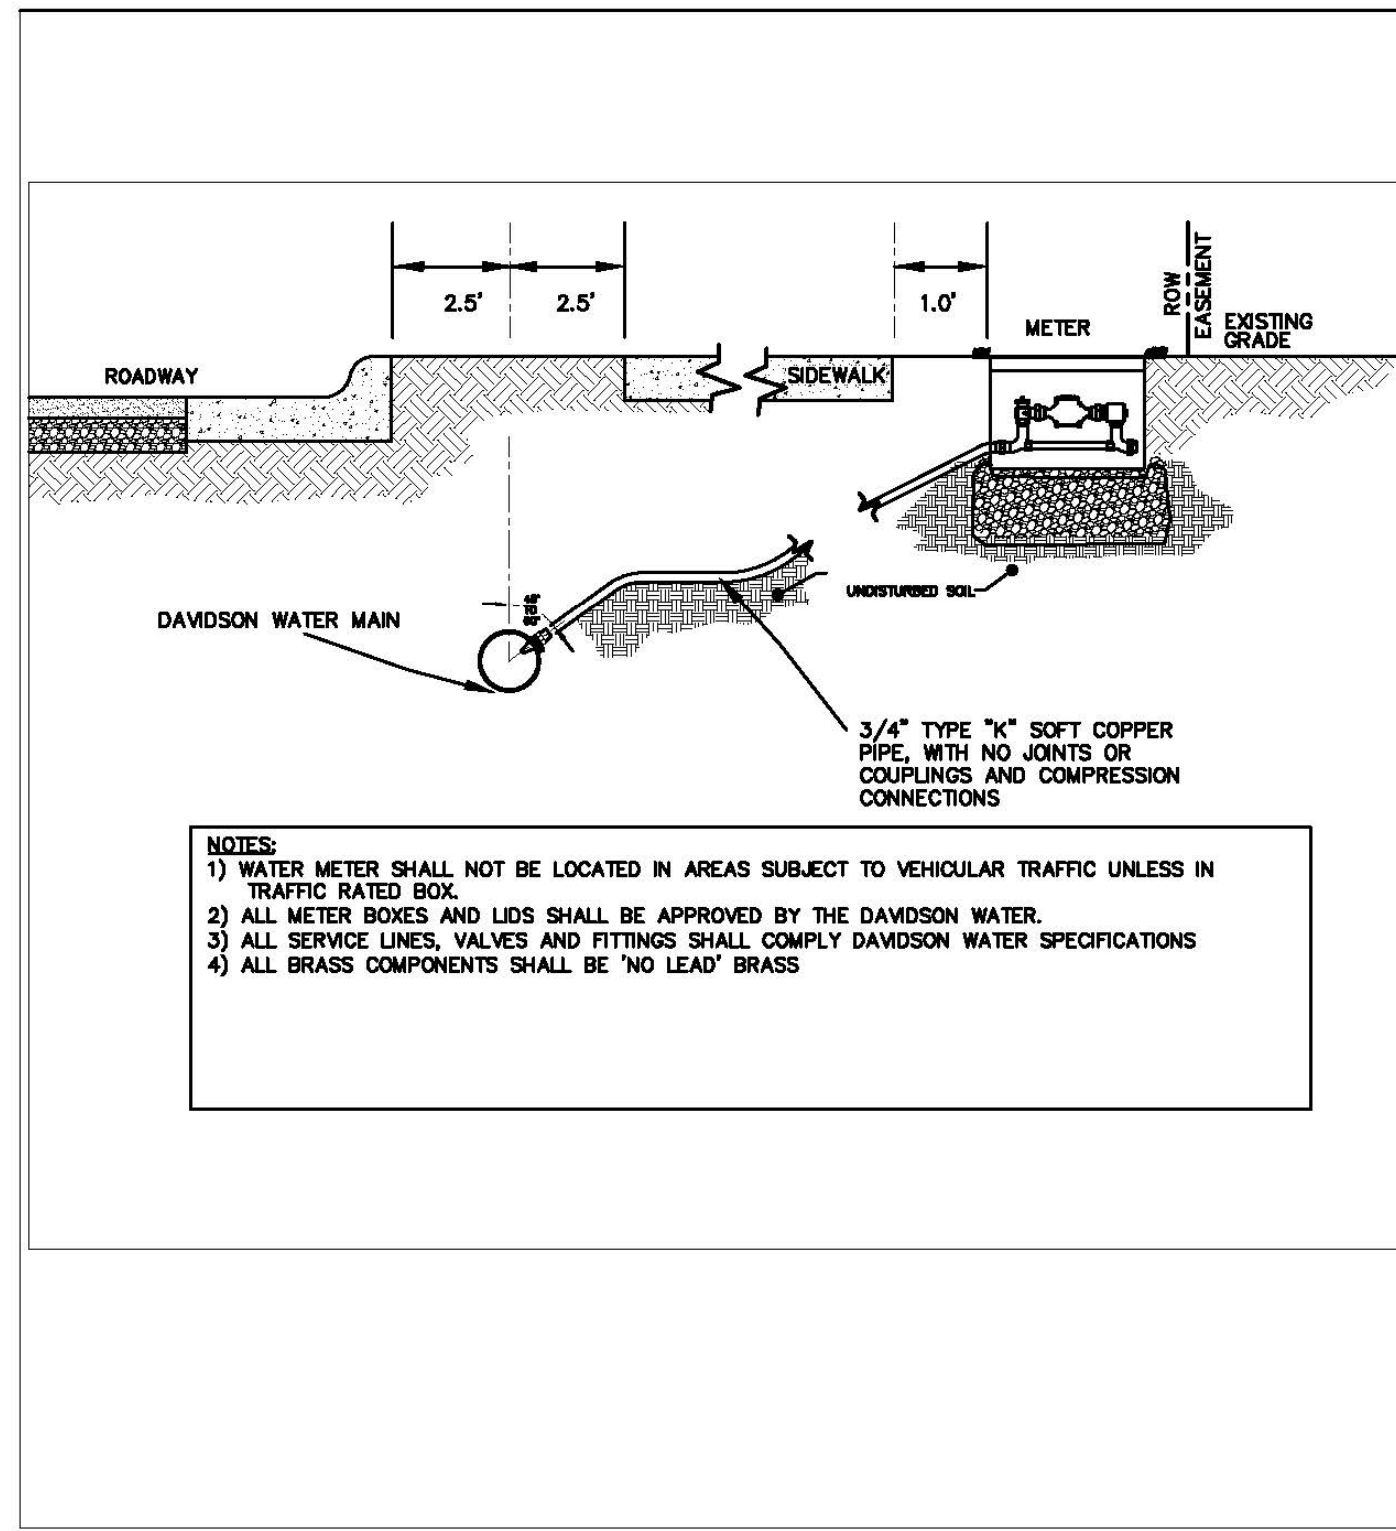

STANDARD WATER MAIN, SERVICE & METER BOX INSTALLATION WITH SIDEWALK


ALL WATERLINE CONSTRUCTION SHALL CONFORM WITH DAVIDSON WATER, INC. STANDARDS AND SPECIFICATIONS. ALL CONSTRUCTION INSIDE OF THE PUBLIC RIGHT-OF-WAY SHALL COMPLY WITH NCDOT STANDARDS AND SPECIFICATIONS.

REFER TO SHEET C-001 FOR PROJECT AND SHEET RELATED NOTES. REFER TO SHEET C-002 FOR DAVIDSON WATER NOTES.

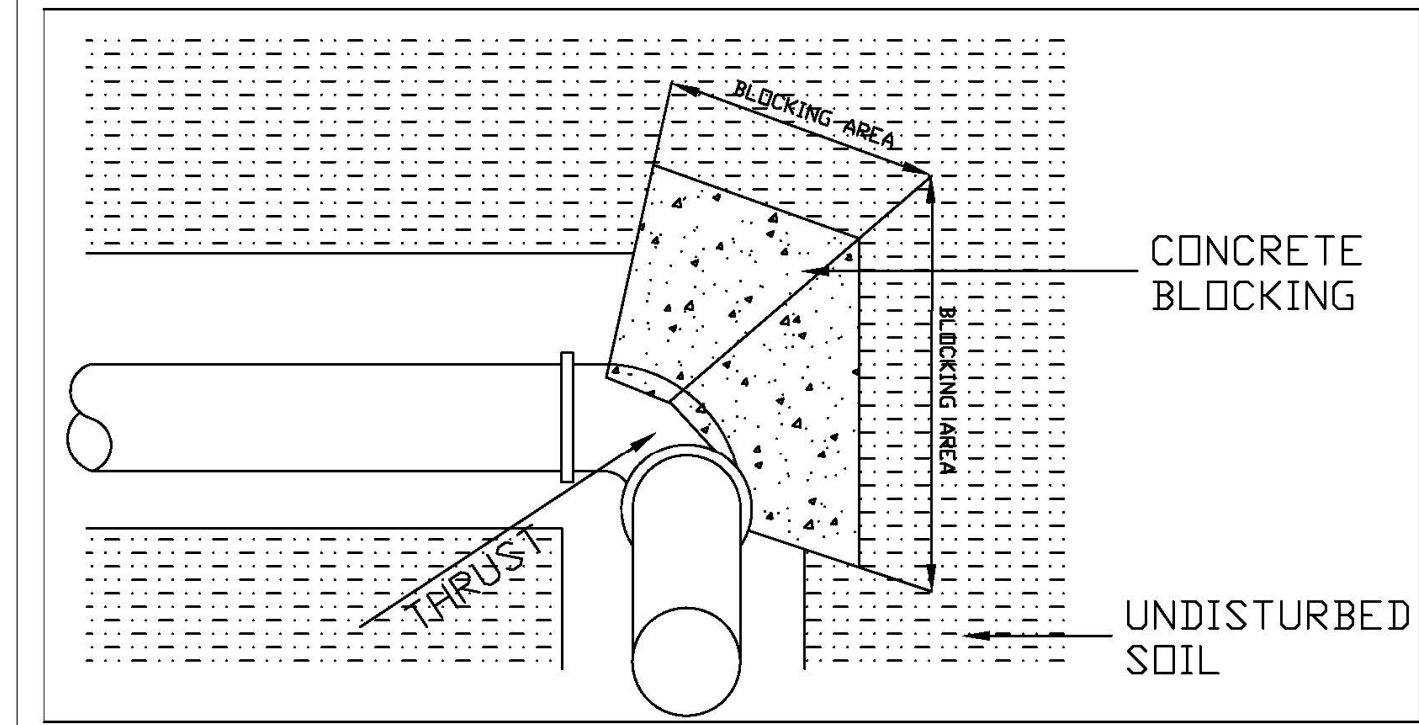


BLOCKING AREA


Keep concrete away from joints. Place concrete fairly dry and form if required for maximum area against undisturbed soil. All fittings to be wrapped with 10 mil. polyethylene prior to pouring blocking. Use 3000 PSI concrete.

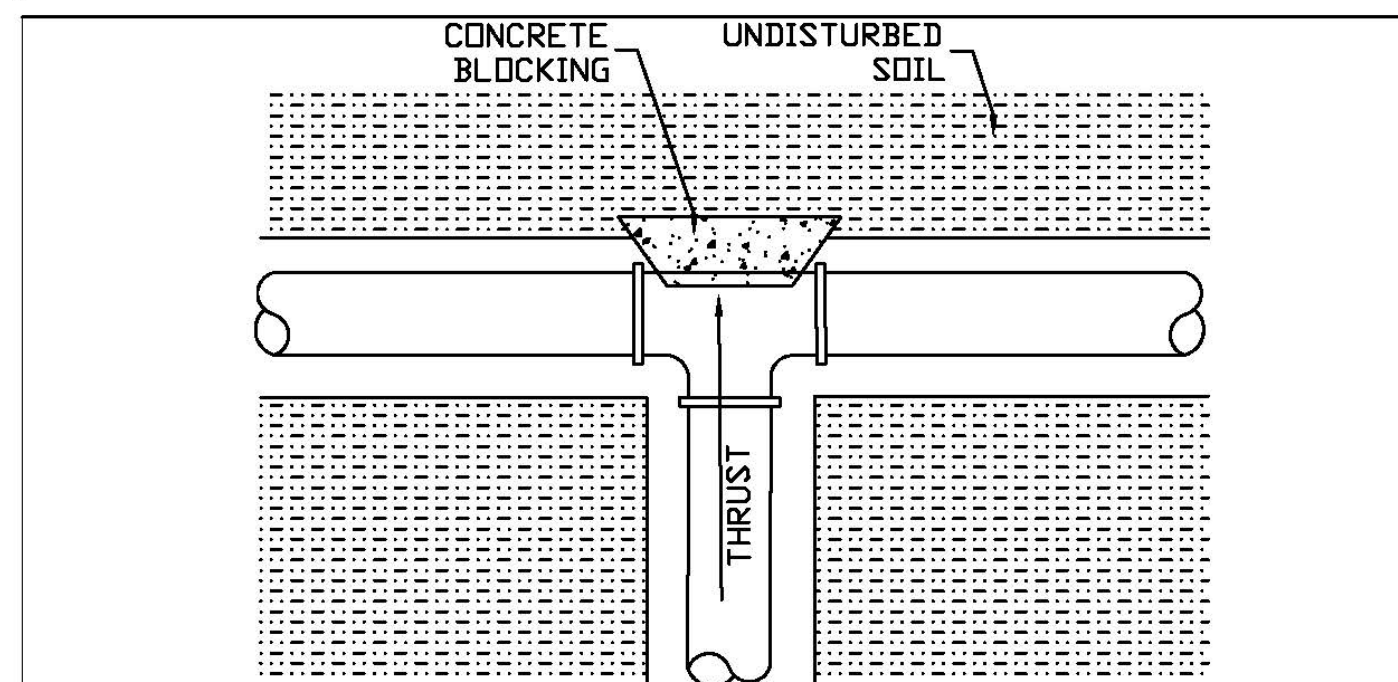


TYPICAL TEE BLOCKING

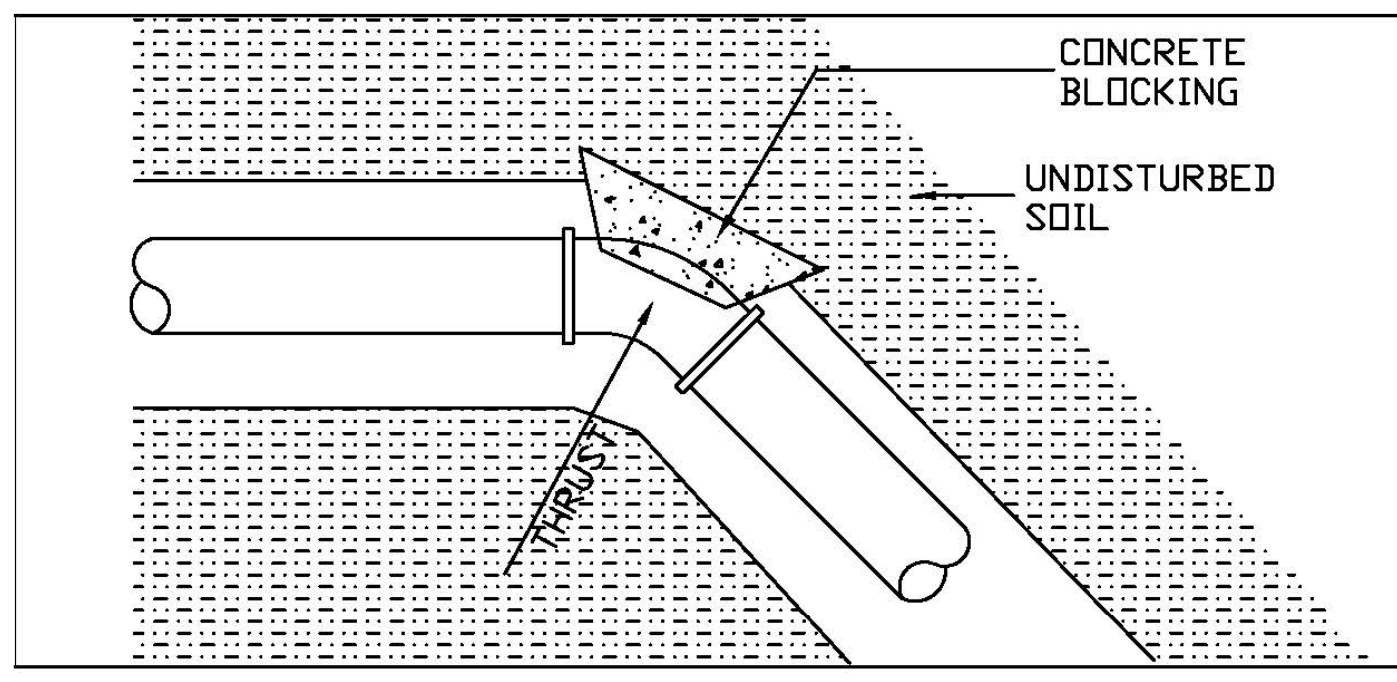


TYPICAL 45° BEND BLOCKING

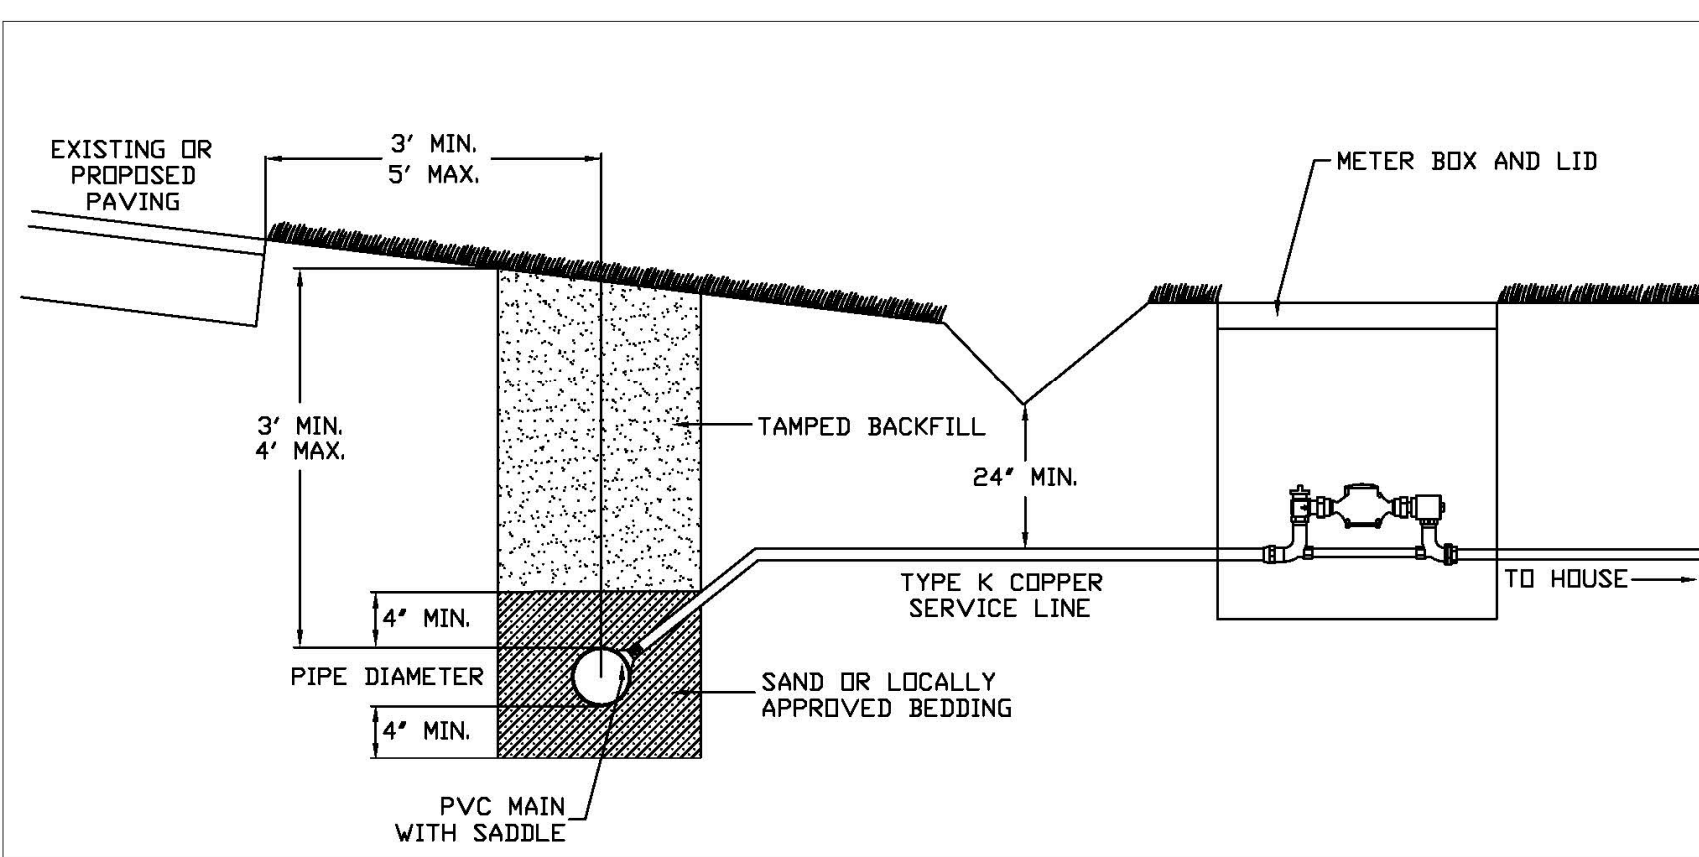


TYPICAL TRENCH SECTION AND LINESSETTER INSTALLATION

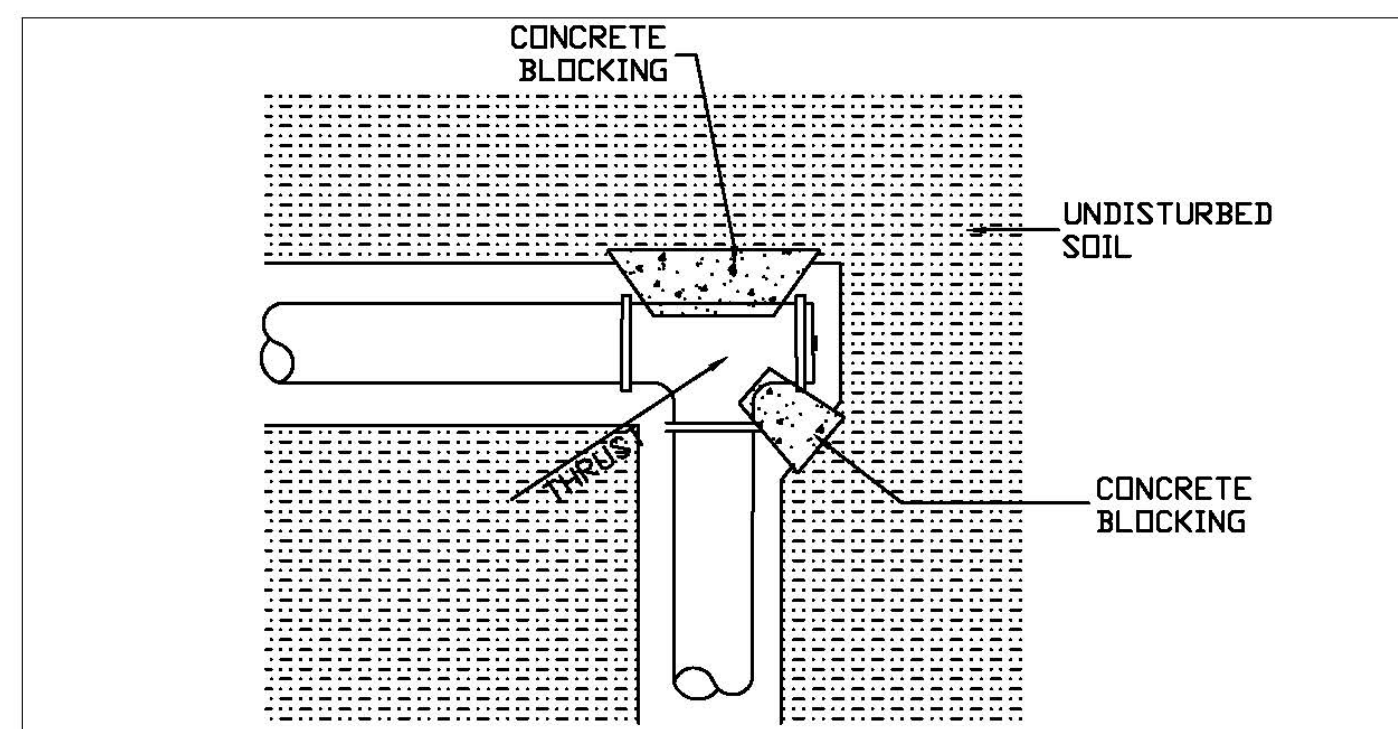

TYPICAL TEE WITH PLUG BLOCKING

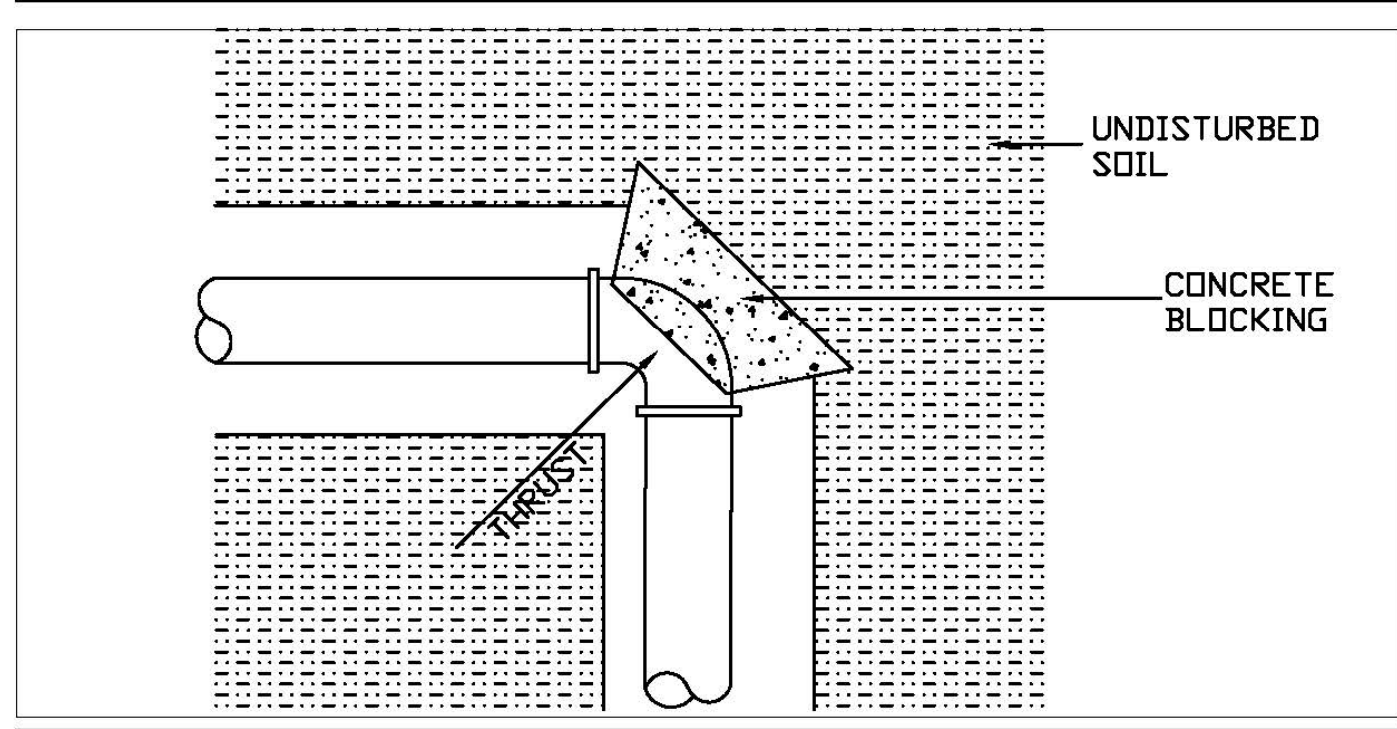

TYPICAL 90° BEND BLOCKING

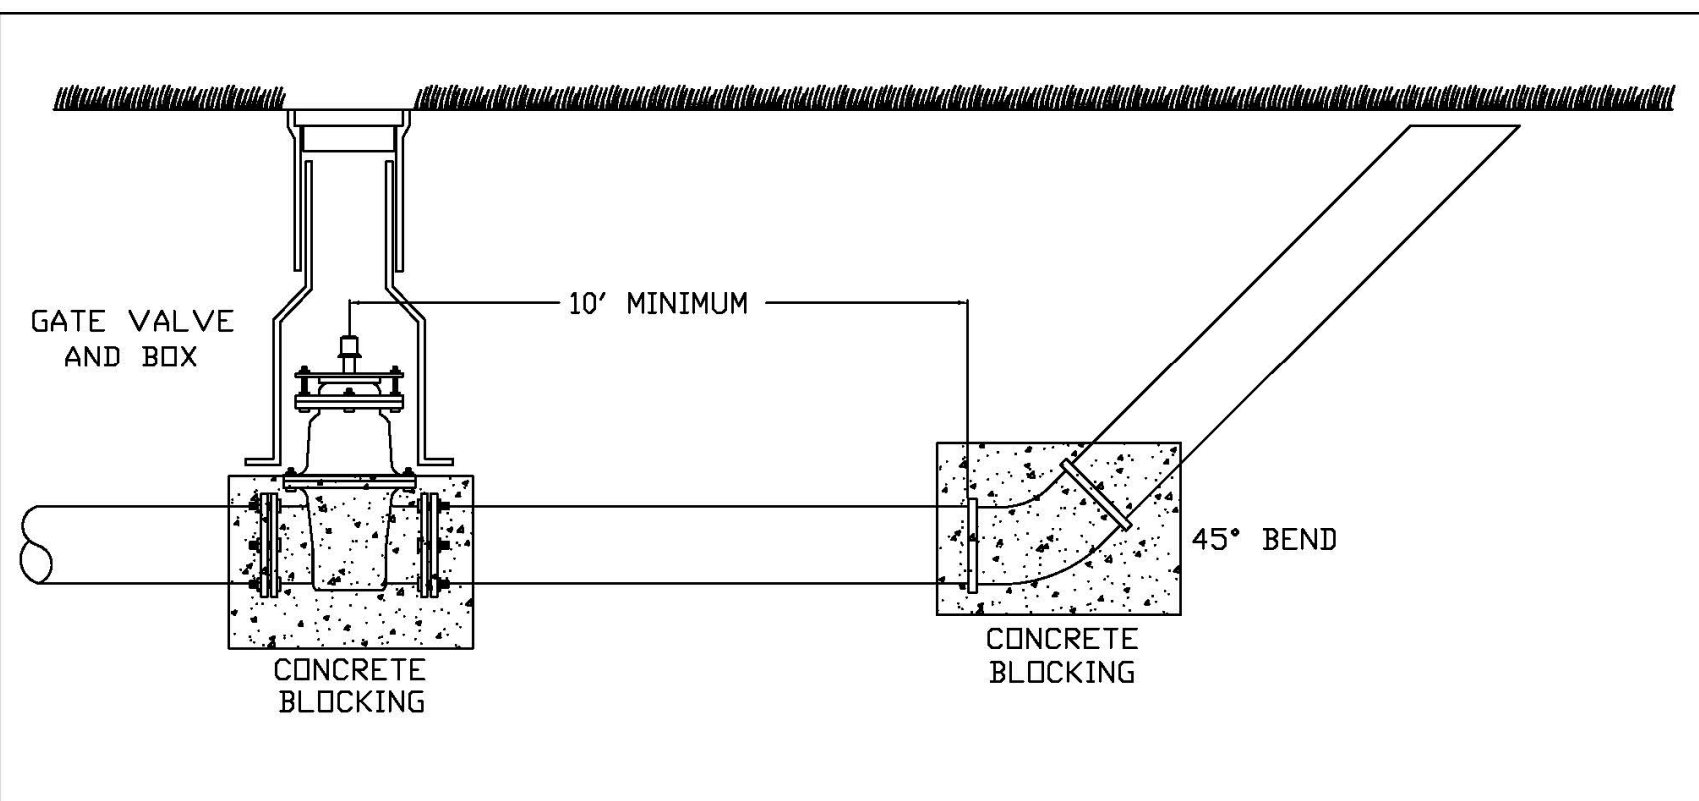

TYPICAL 2,3,4,6, AND 8 in. BLOW OFF INSTALLATION

This drawing and the design shown is the property of Smith Sinnett Architecture, P.A. The reproduction or use of this drawing without the written consent of the Architect is prohibited. Any engineering or design work shown on this drawing must be returned to the Architect at the completion of the contract.
Smith Sinnett Architecture, P.A. 2019
THIS DRAWING IS FORMATTED TO BE PRINTED ON A 24" X 36" SHEET

NEW TRINITY MIDDLE SCHOOL
RANDOLPH COUNTY SCHOOL SYSTEM

PARCEL PIN 7708118367
SURRETT DRIVE
TRINITY, NC 27370

KEY PLAN
NO SCALE

ID	DATE	REV.	PER	DESCRIPTION
1	06.14.19			REV. PER REVIEW

DRAWN BY: SAD
CHECKED BY: SAD

OFFSITE WATERLINE UTILITY DETAILS

2017027 20 MAY 2019



Know what's below.
Call before you dig.



June 14, 2019

Drew Wilgus, AIA, LEED AP
Smith Sinnett Architecture
4600 Lake Boone Trail
Raleigh, NC 27607

Re: Trinity Middle School
LM Project No: R18.165

Dear Drew:

Please refer to summary below of structural drawing revisions issued in Addendum #3 dated June 14, 2019.

Drawing S1-01

Revised section cut 5/S3-01 to section cut 5A/S3-01 to properly denote 16" CMU at this location.

Drawing S3-01

Revised section 5/S3-01 to Section 5 & 5A/S3-01 to denote both 12" CMU and 16" CMU.

Clarifications

- Note that Slab Type S7 as denoted on S0-02 is NOT USED.
- "BOD - Field House" reference elevation in Section 1/S3-24 is not applicable and is an extraneous reference.
- Section 1/S3-24 applies at the 1/S4-13 (2 frame locations), 2/S4-13 (1 frame location), 4/S4-13 (1 frame location).

Raleigh HQ
415 Hillsborough Street
Suite 101
Raleigh, NC
27603

P: 919.782.1833

Virginia Beach
5032 Rouse Drive
Suite 200
Virginia Beach, VA
23462

P: 757.671.8626


Richmond
1503 Santa Rosa Road
Suite 210
Richmond, VA
23229

P: 804.346.3935

Sincerely,
LYNCH MYKINS STRUCTURAL ENGINEERS, PC

Jeffrey R. Morrison, PE
Sr. Project Engineer



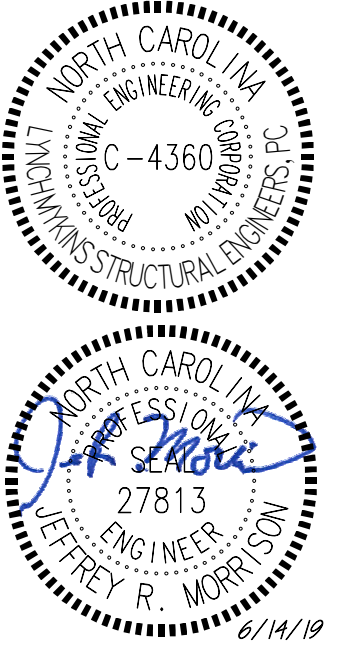


Structural Engineers
415 Hillsborough St., Ste 101
Raleigh, NC 27603
919.782.1833 - lynchmykins.com

VOLUME I


This drawing shall be used only for the project and site shown in the title block. It is not to be used for any other project or site without the written consent of Smith Sinnett Architecture, P.A. The reproduction or use of this drawing without the written consent of Smith Sinnett Architecture, P.A. is prohibited. Any infringement of the copyright rights in this drawing shall be subject to legal action. All copies of this drawing shall be the property of Smith Sinnett Architecture, P.A. and shall be returned to the Architect at the completion of the project.

Smith Sinnett Architecture, P.A. 2018
THIS DRAWING IS COMMITTED TO BE PRINTED ON A 36" X 48" SHEET

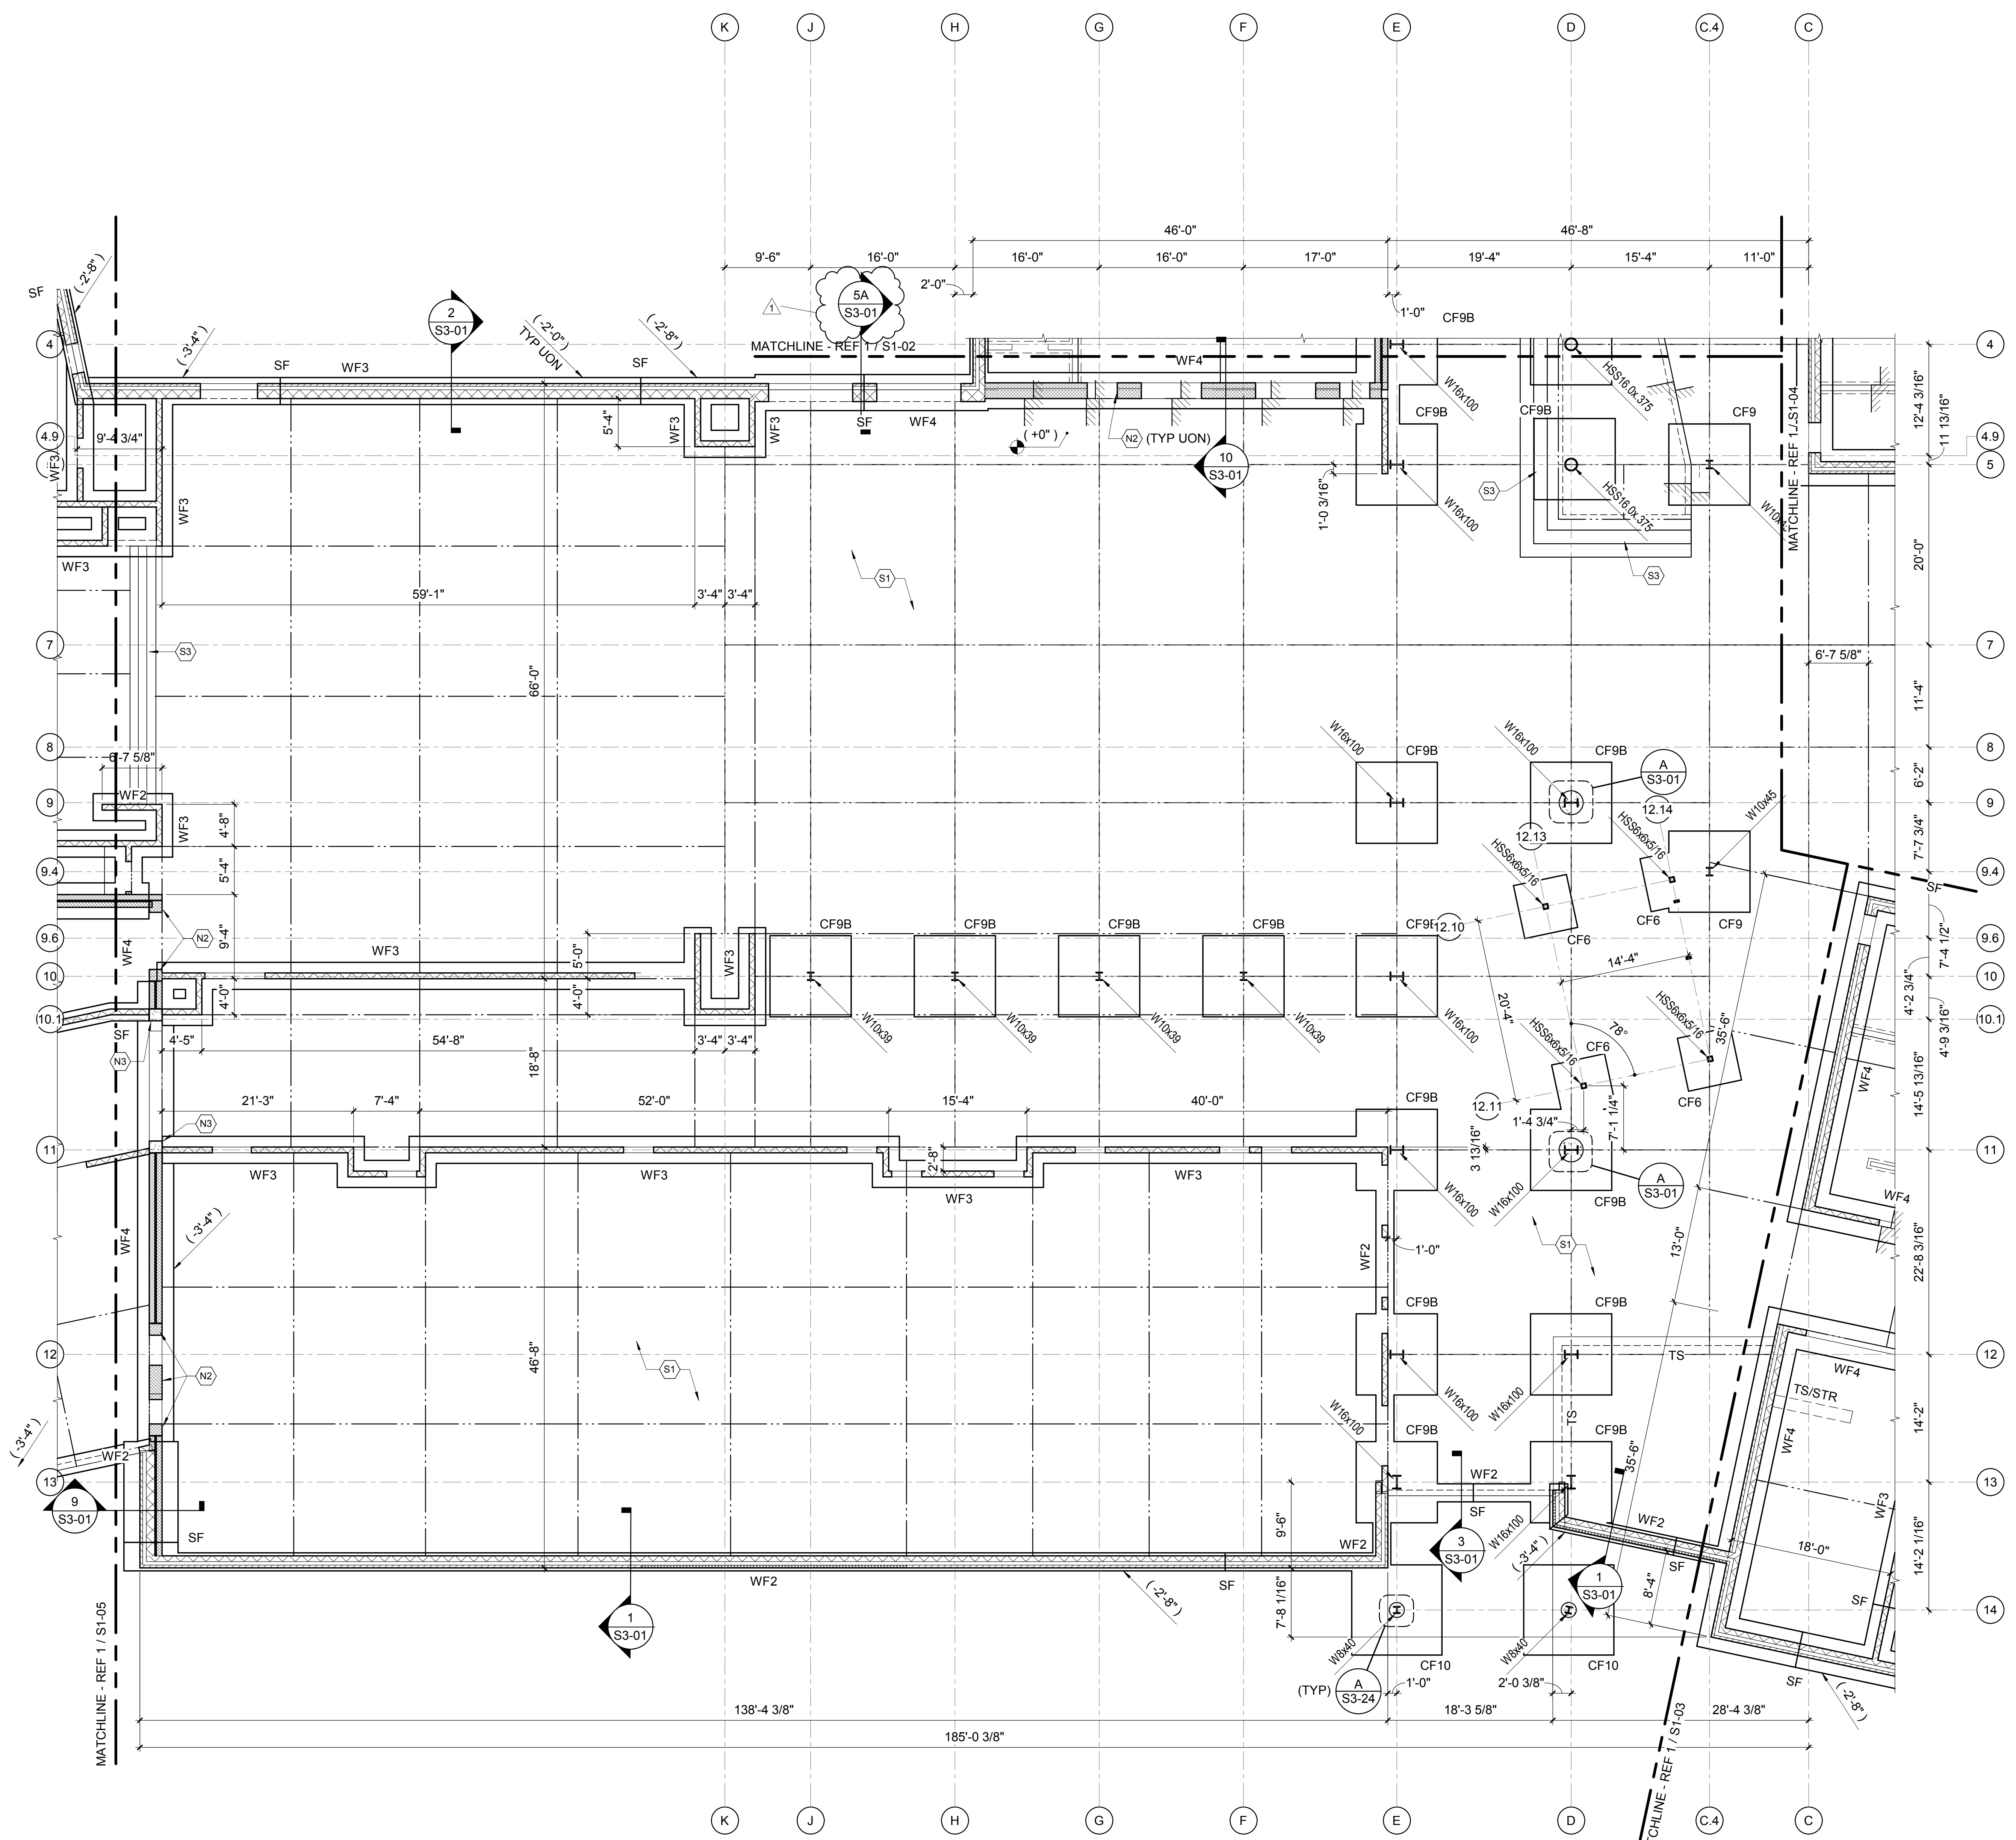

1 FOUNDATION PLAN - 100A WING
S1-01 1/8" = 1'-0"


**NEW TRINITY MIDDLE SCHOOL
RANDOLPH COUNTY SCHOOL SYSTEM**
Parcel PIN 7708118367
Surrett Drive
Trinity, NC 27370

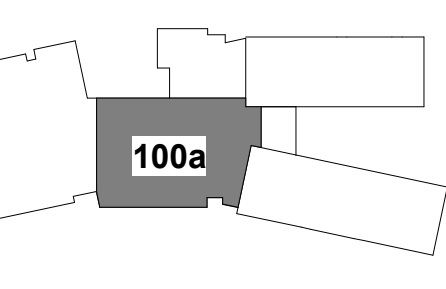

KEY PLAN
NO SCALE

06/14/19 ADDENDUM 3
ID DATE DESCRIPTION
DRAWN BY: MBG
CHECKED BY: JRM


FOUNDATION PLAN
100A WING

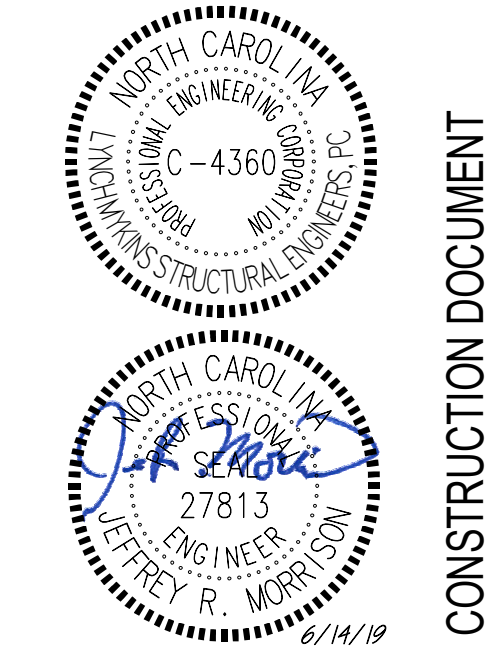

VOLUME I

This drawing shall be taken as the true and correct drawing of the work shown. It is the responsibility of the contractor to verify all dimensions and conditions in the field. The contractor shall be responsible for any errors or omissions in this drawing. This drawing is submitted to the client for their review and approval. The contractor shall be responsible for any errors or omissions in this drawing. This drawing is submitted to the client for their review and approval.


**NEW TRINITY MIDDLE SCHOOL
RANDOLPH COUNTY SCHOOL SYSTEM**
Parcel PIN 7708118367
Surrett Drive
Trinity, NC 27370

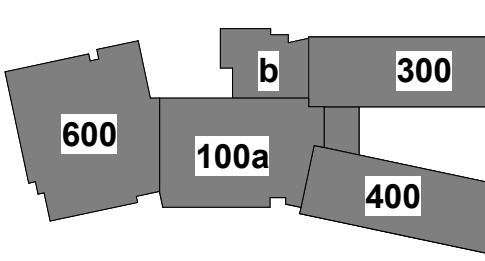


KEY PLAN
NO SCALE

06/14/19 ADDENDUM 3
ID DATE DESCRIPTION
DRAWN BY: MBG
CHECKED BY: JRM


**SECTIONS -
FOUNDATION**

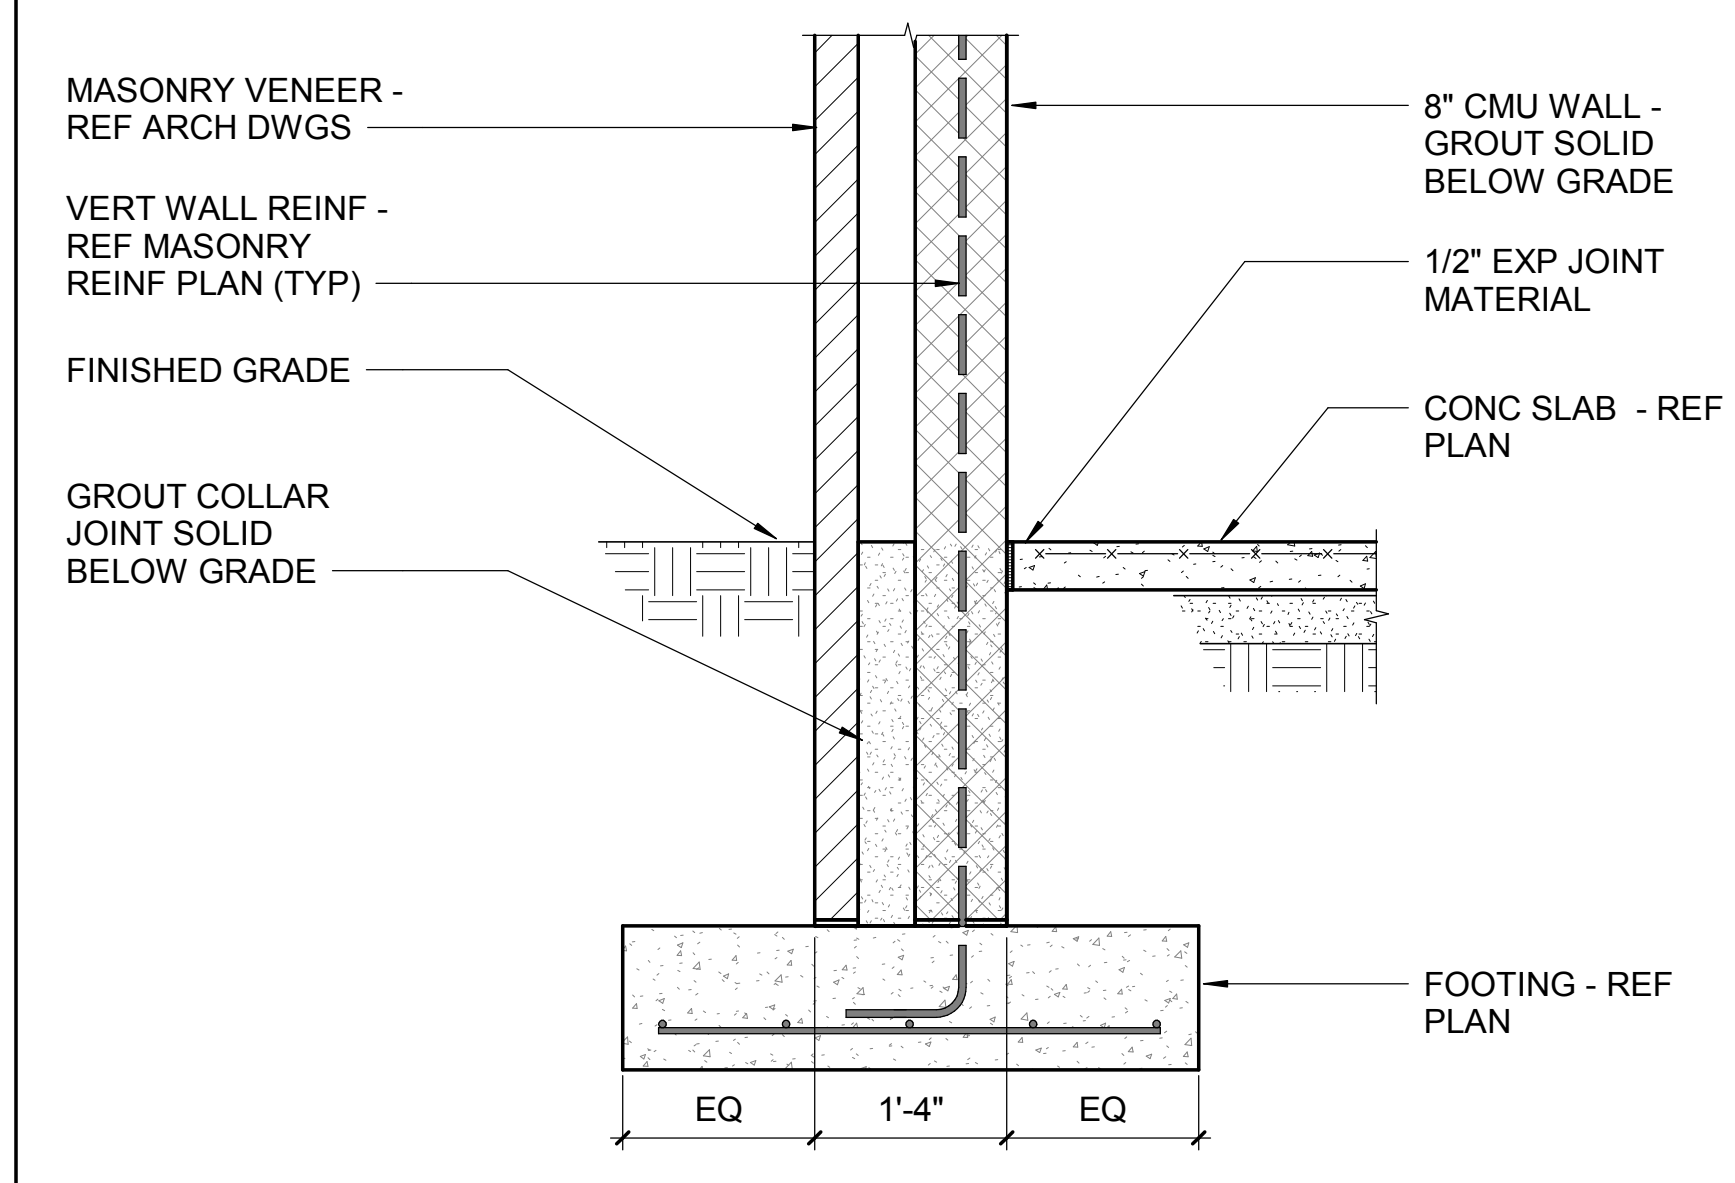


1 SECTION
S3-01 3/4" = 1'-0"

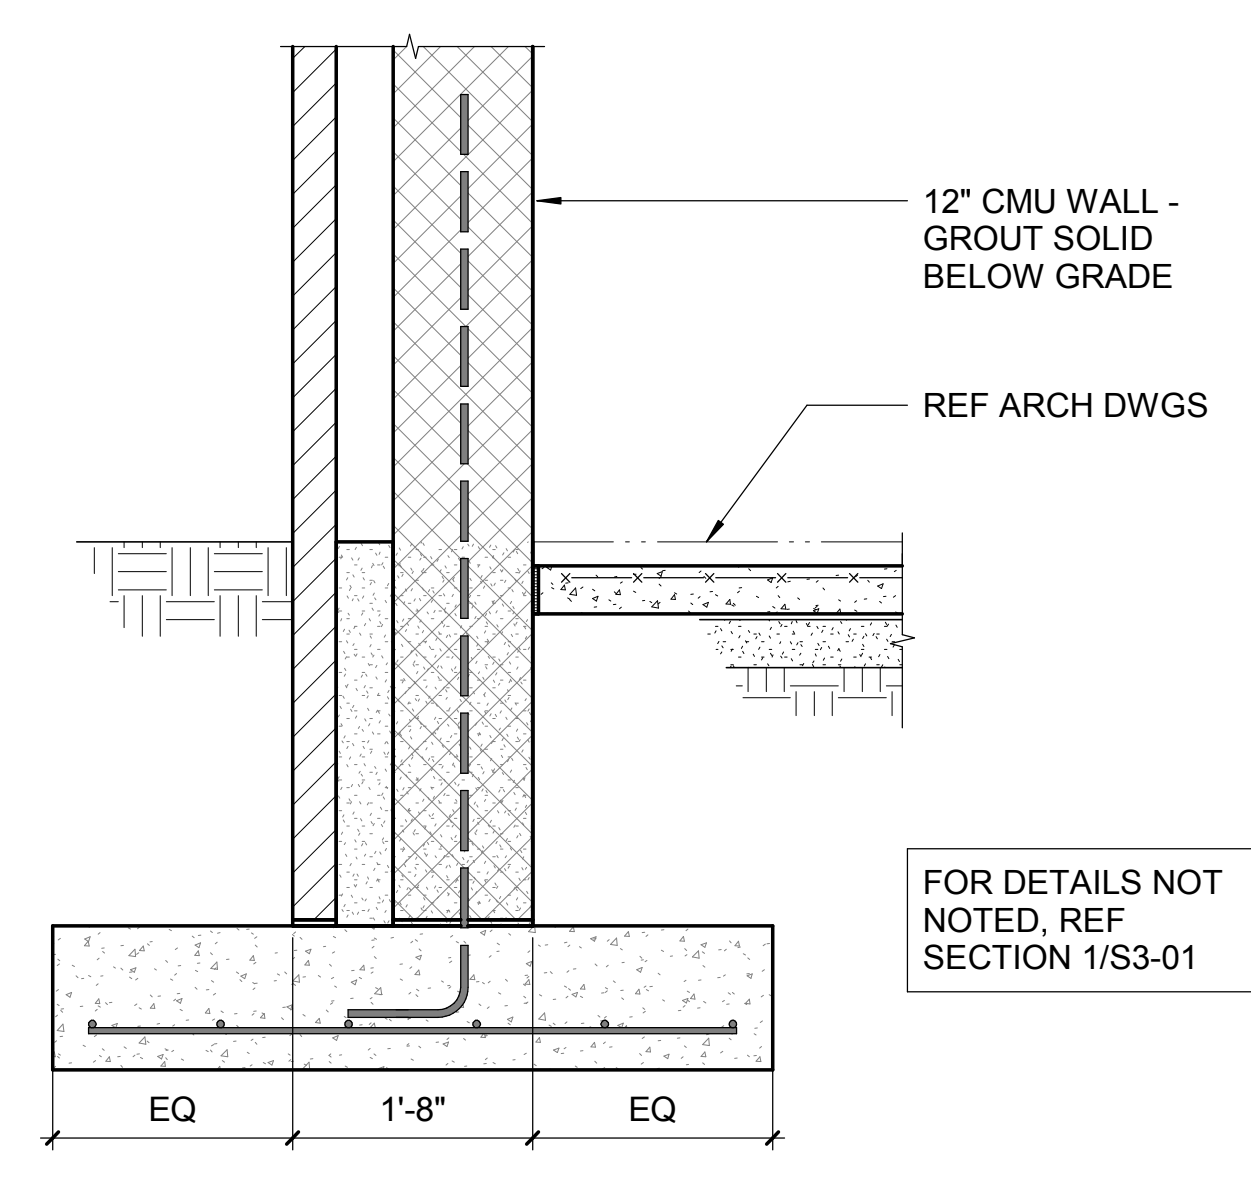


2 SECTION
S3-01 3/4" = 1'-0"

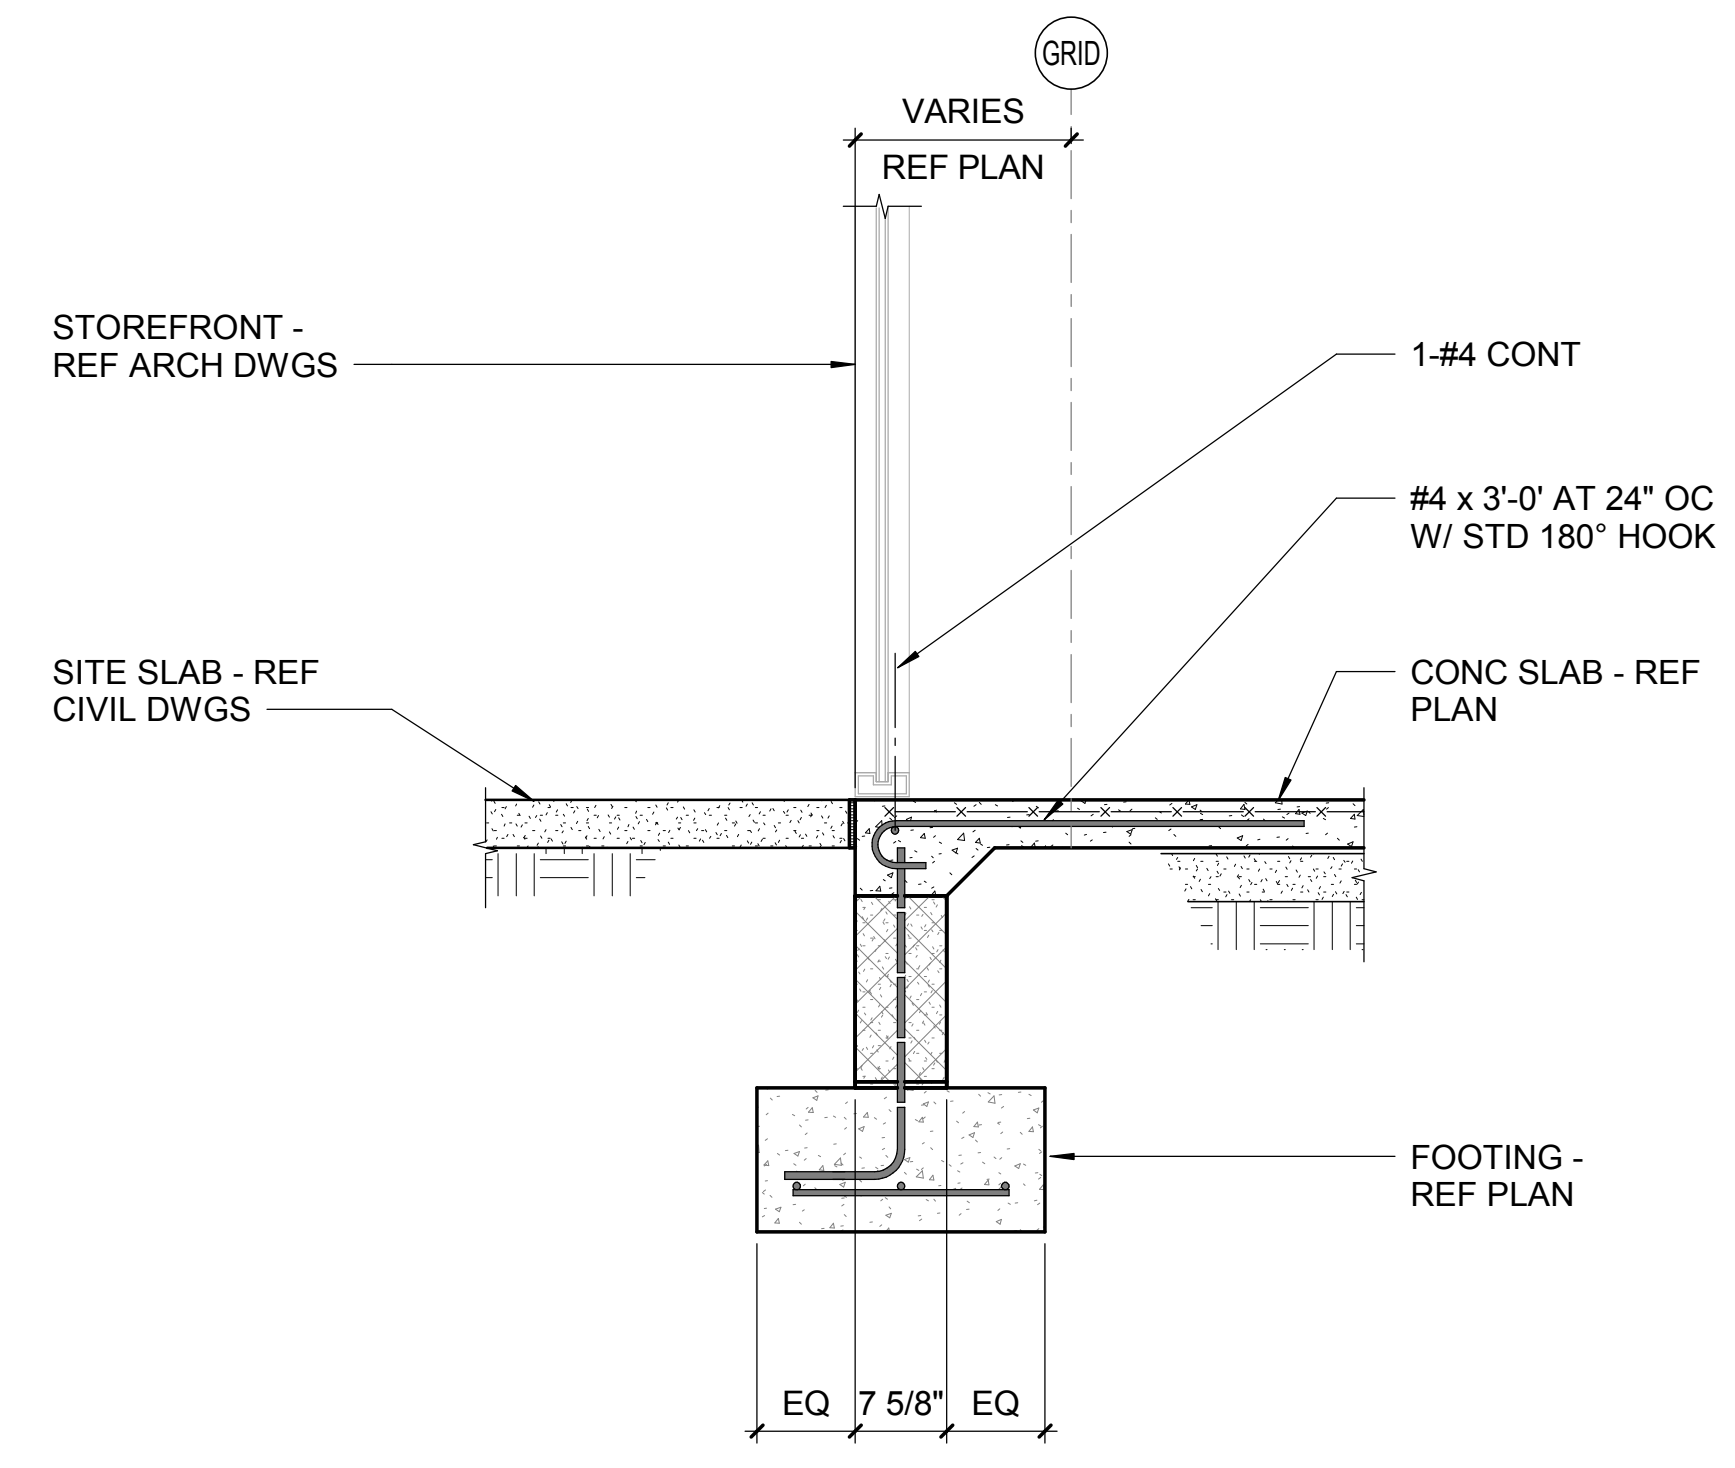


3 SECTION
S3-01 3/4" = 1'-0"

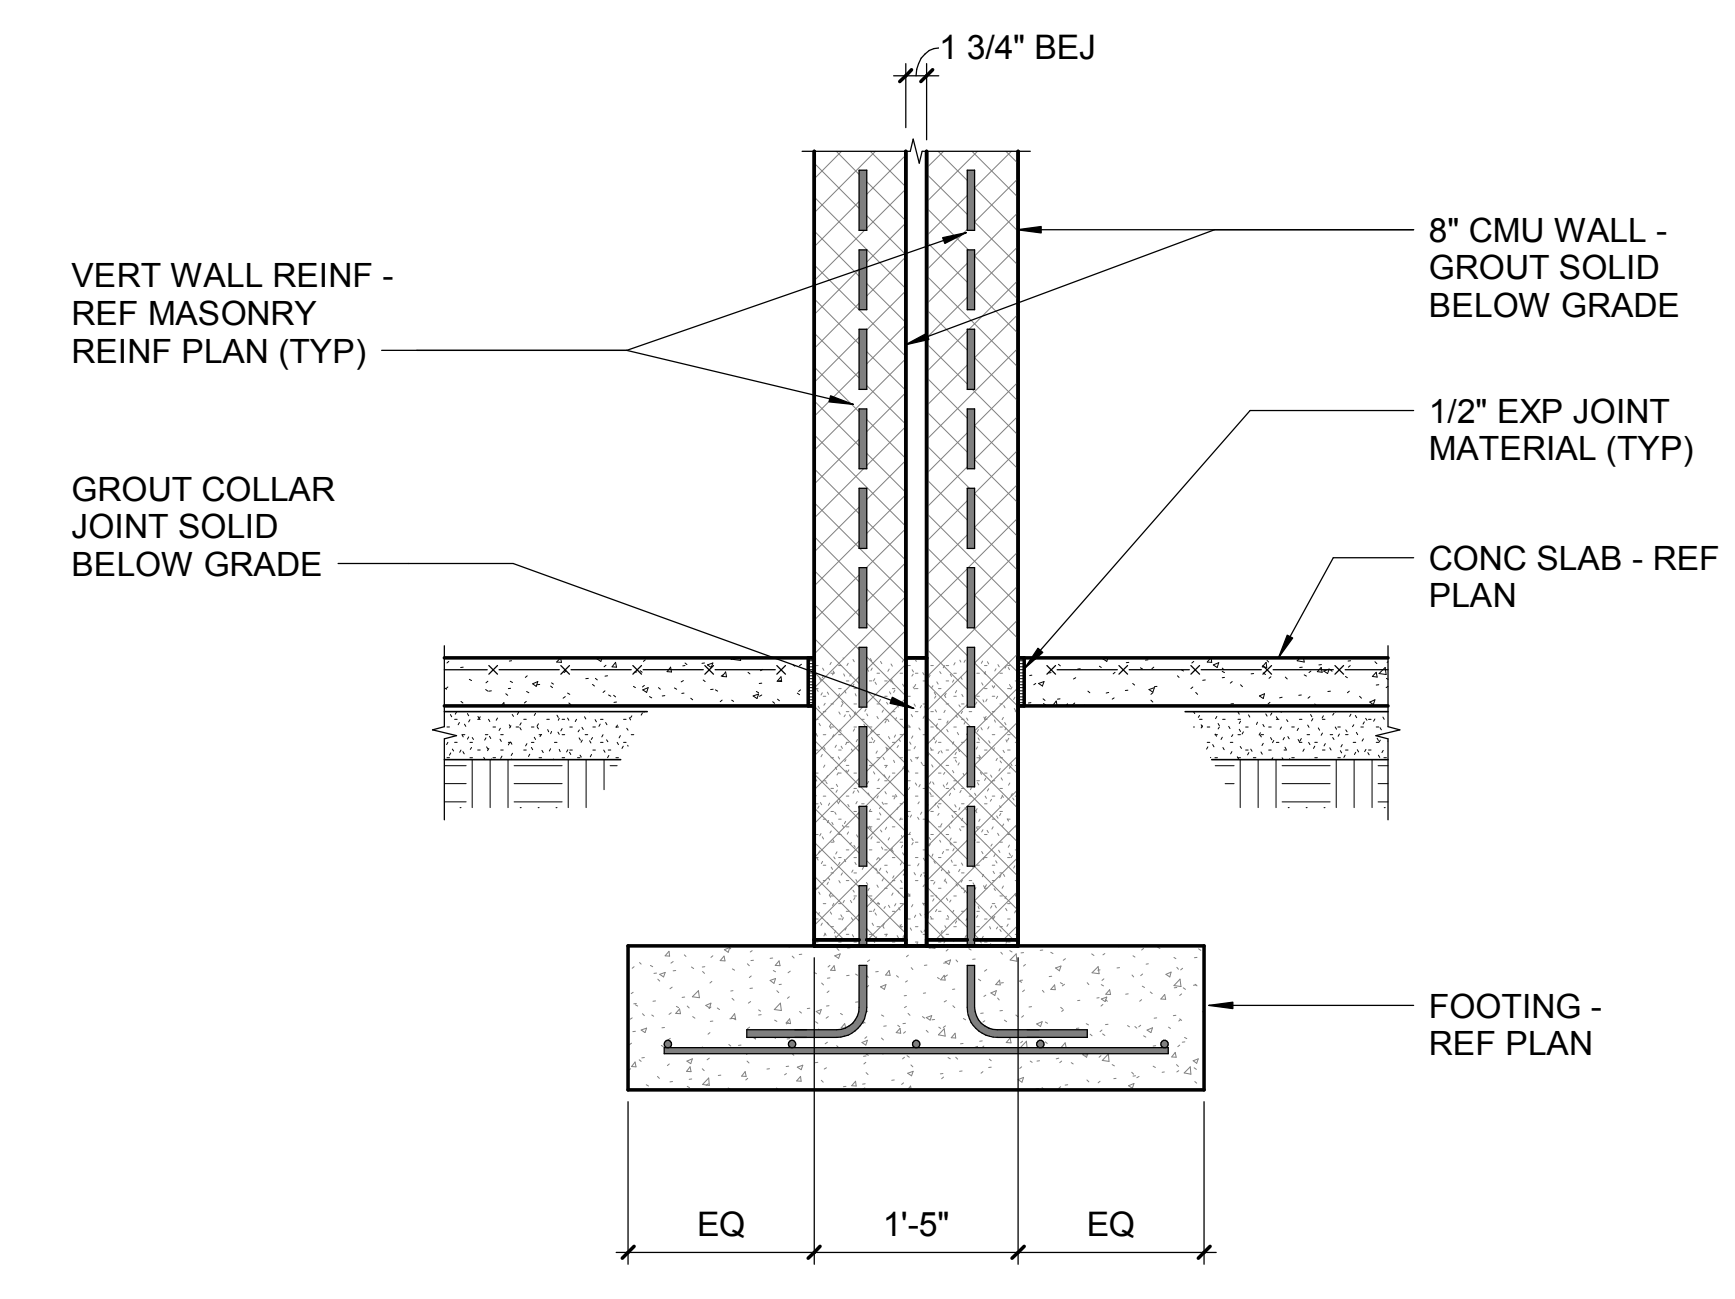


4 SECTION
S3-01 3/4" = 1'-0"

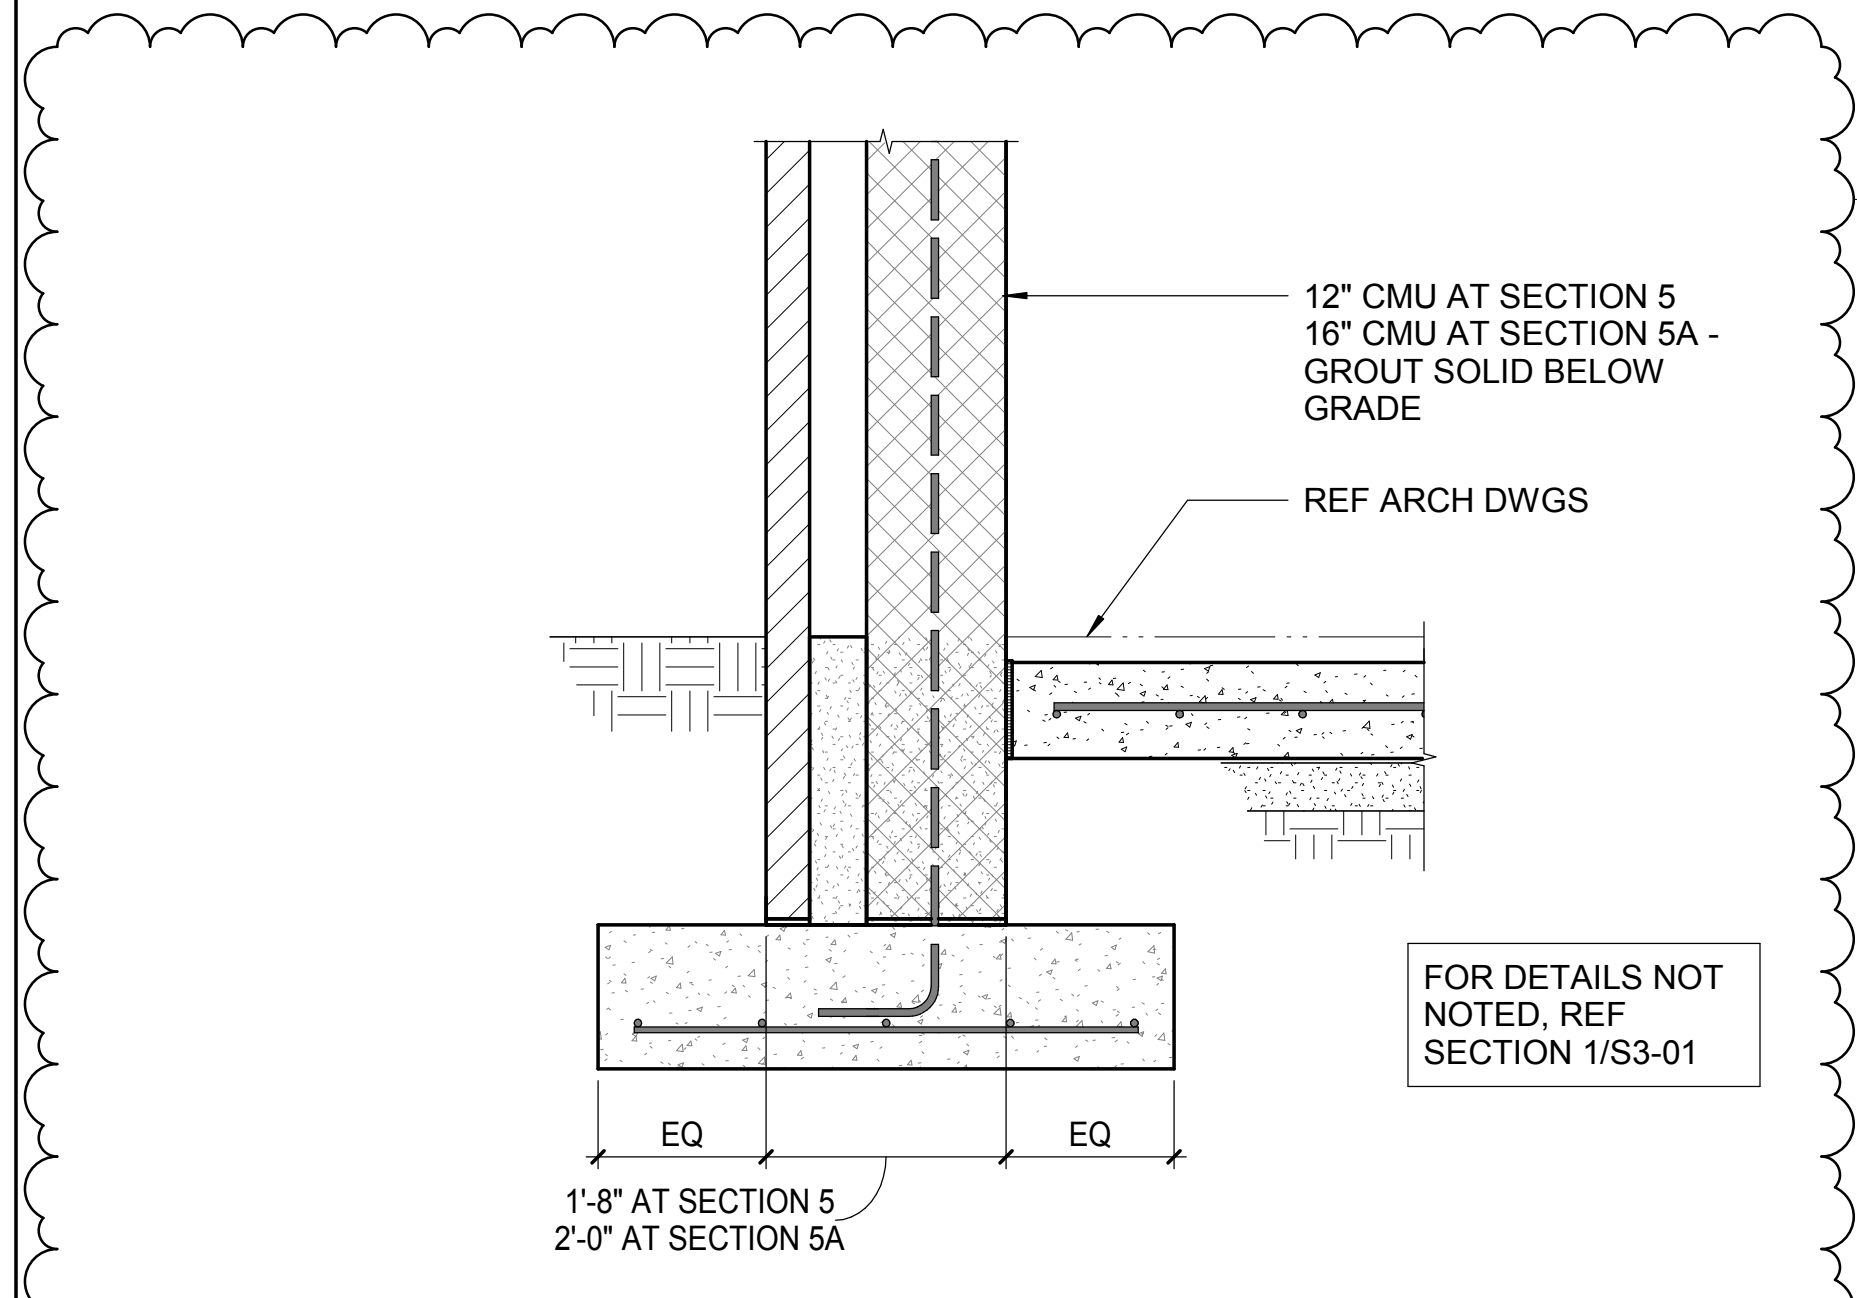


5/5A SECTION
S3-01 3/4" = 1'-0"

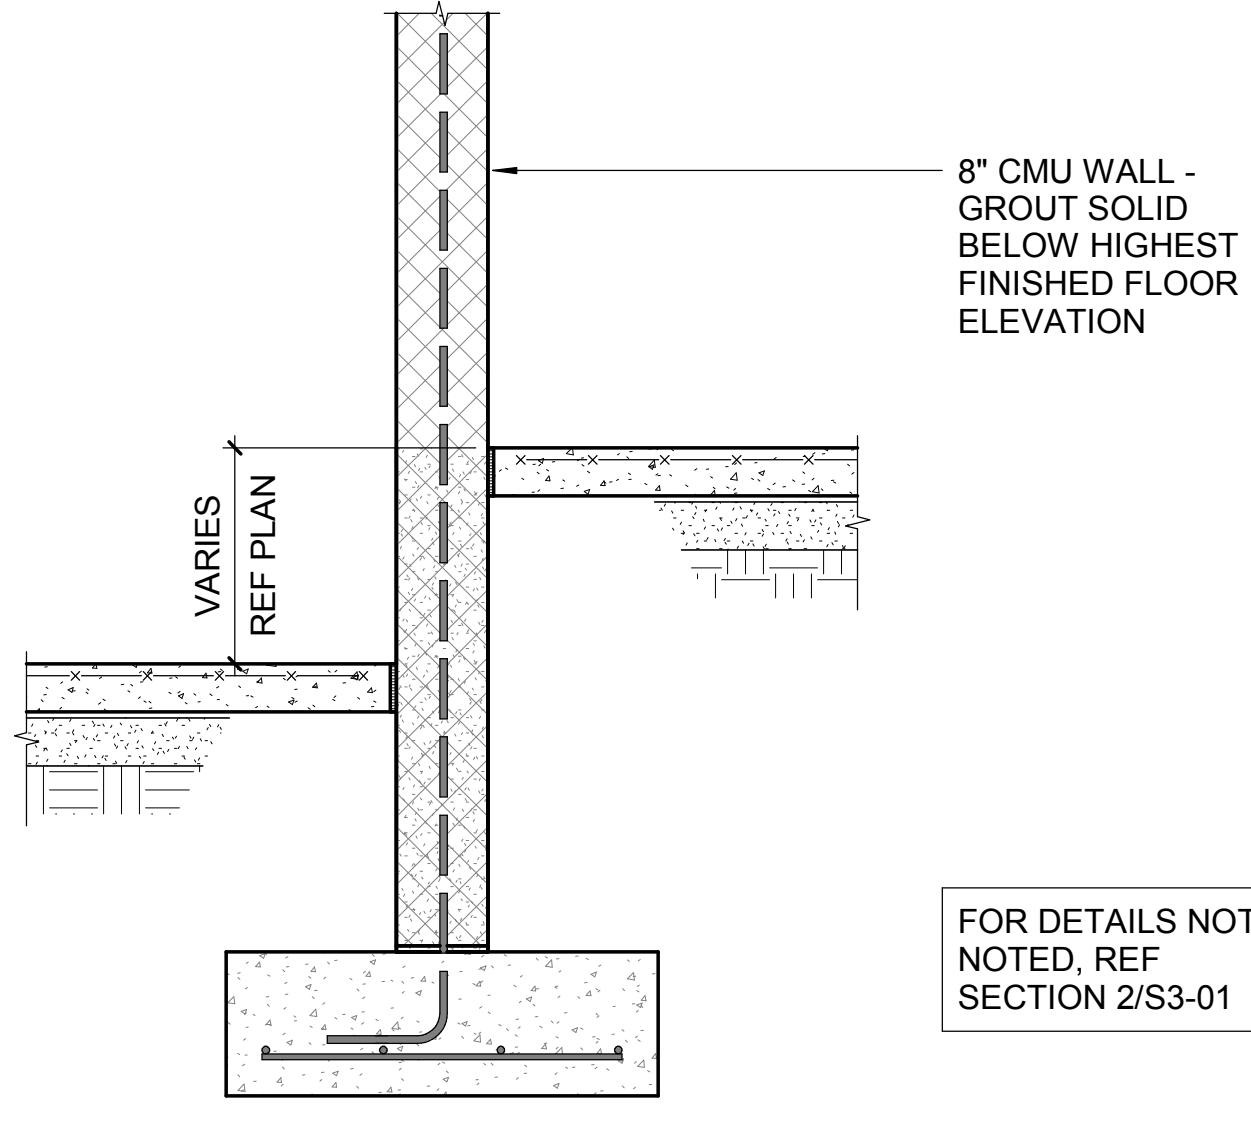


6 SECTION
S3-01 3/4" = 1'-0"

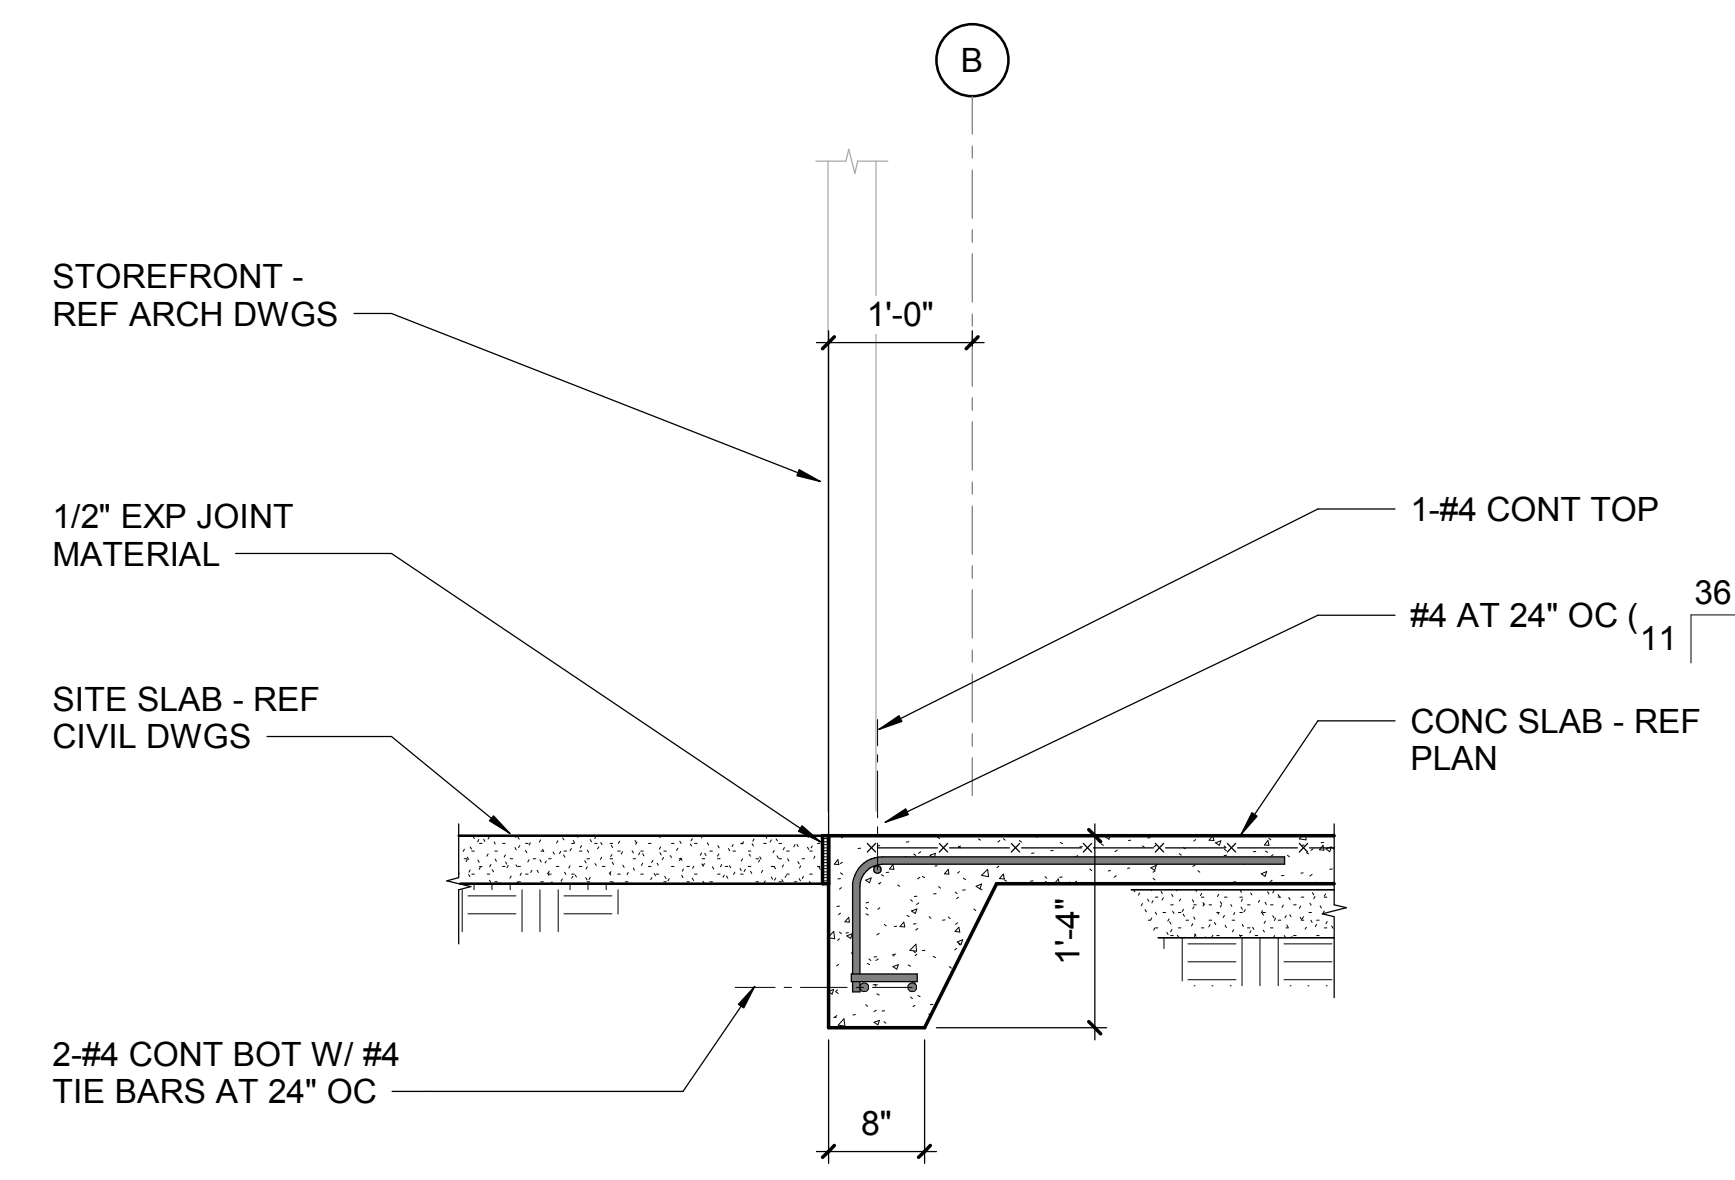


7 SECTION
S3-01 3/4" = 1'-0"

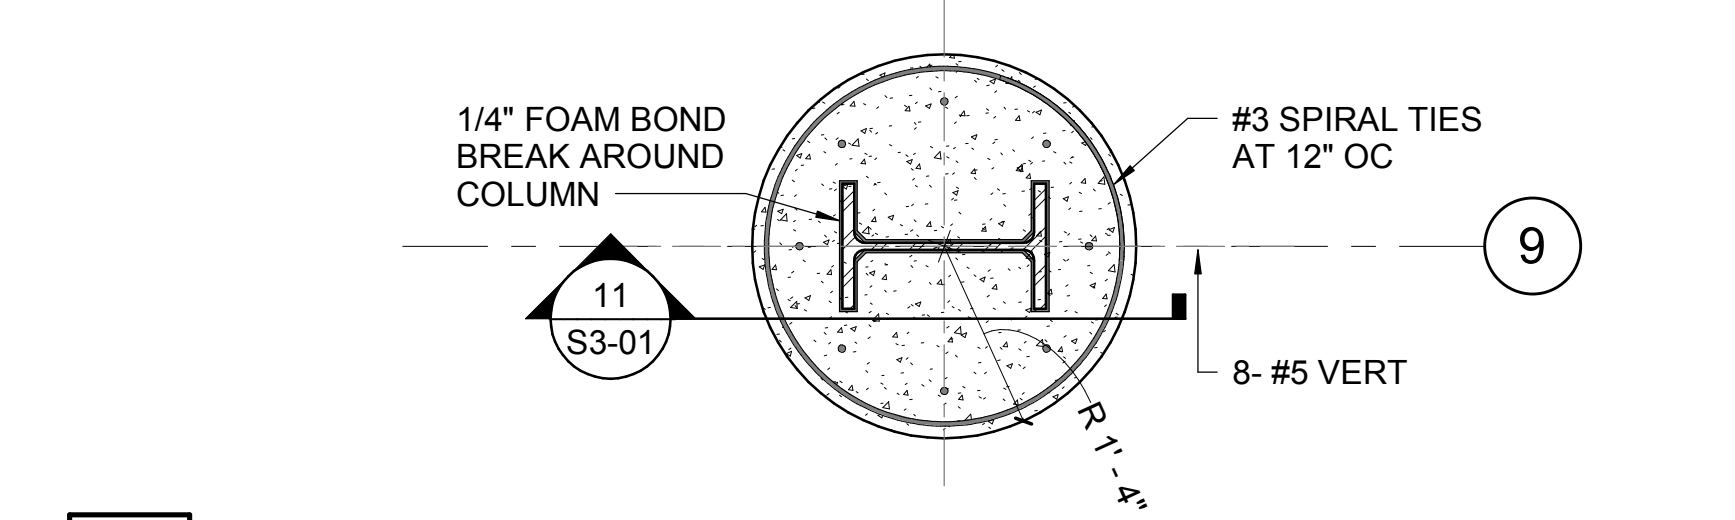


A PLAN DETAIL
S3-01 3/4" = 1'-0"

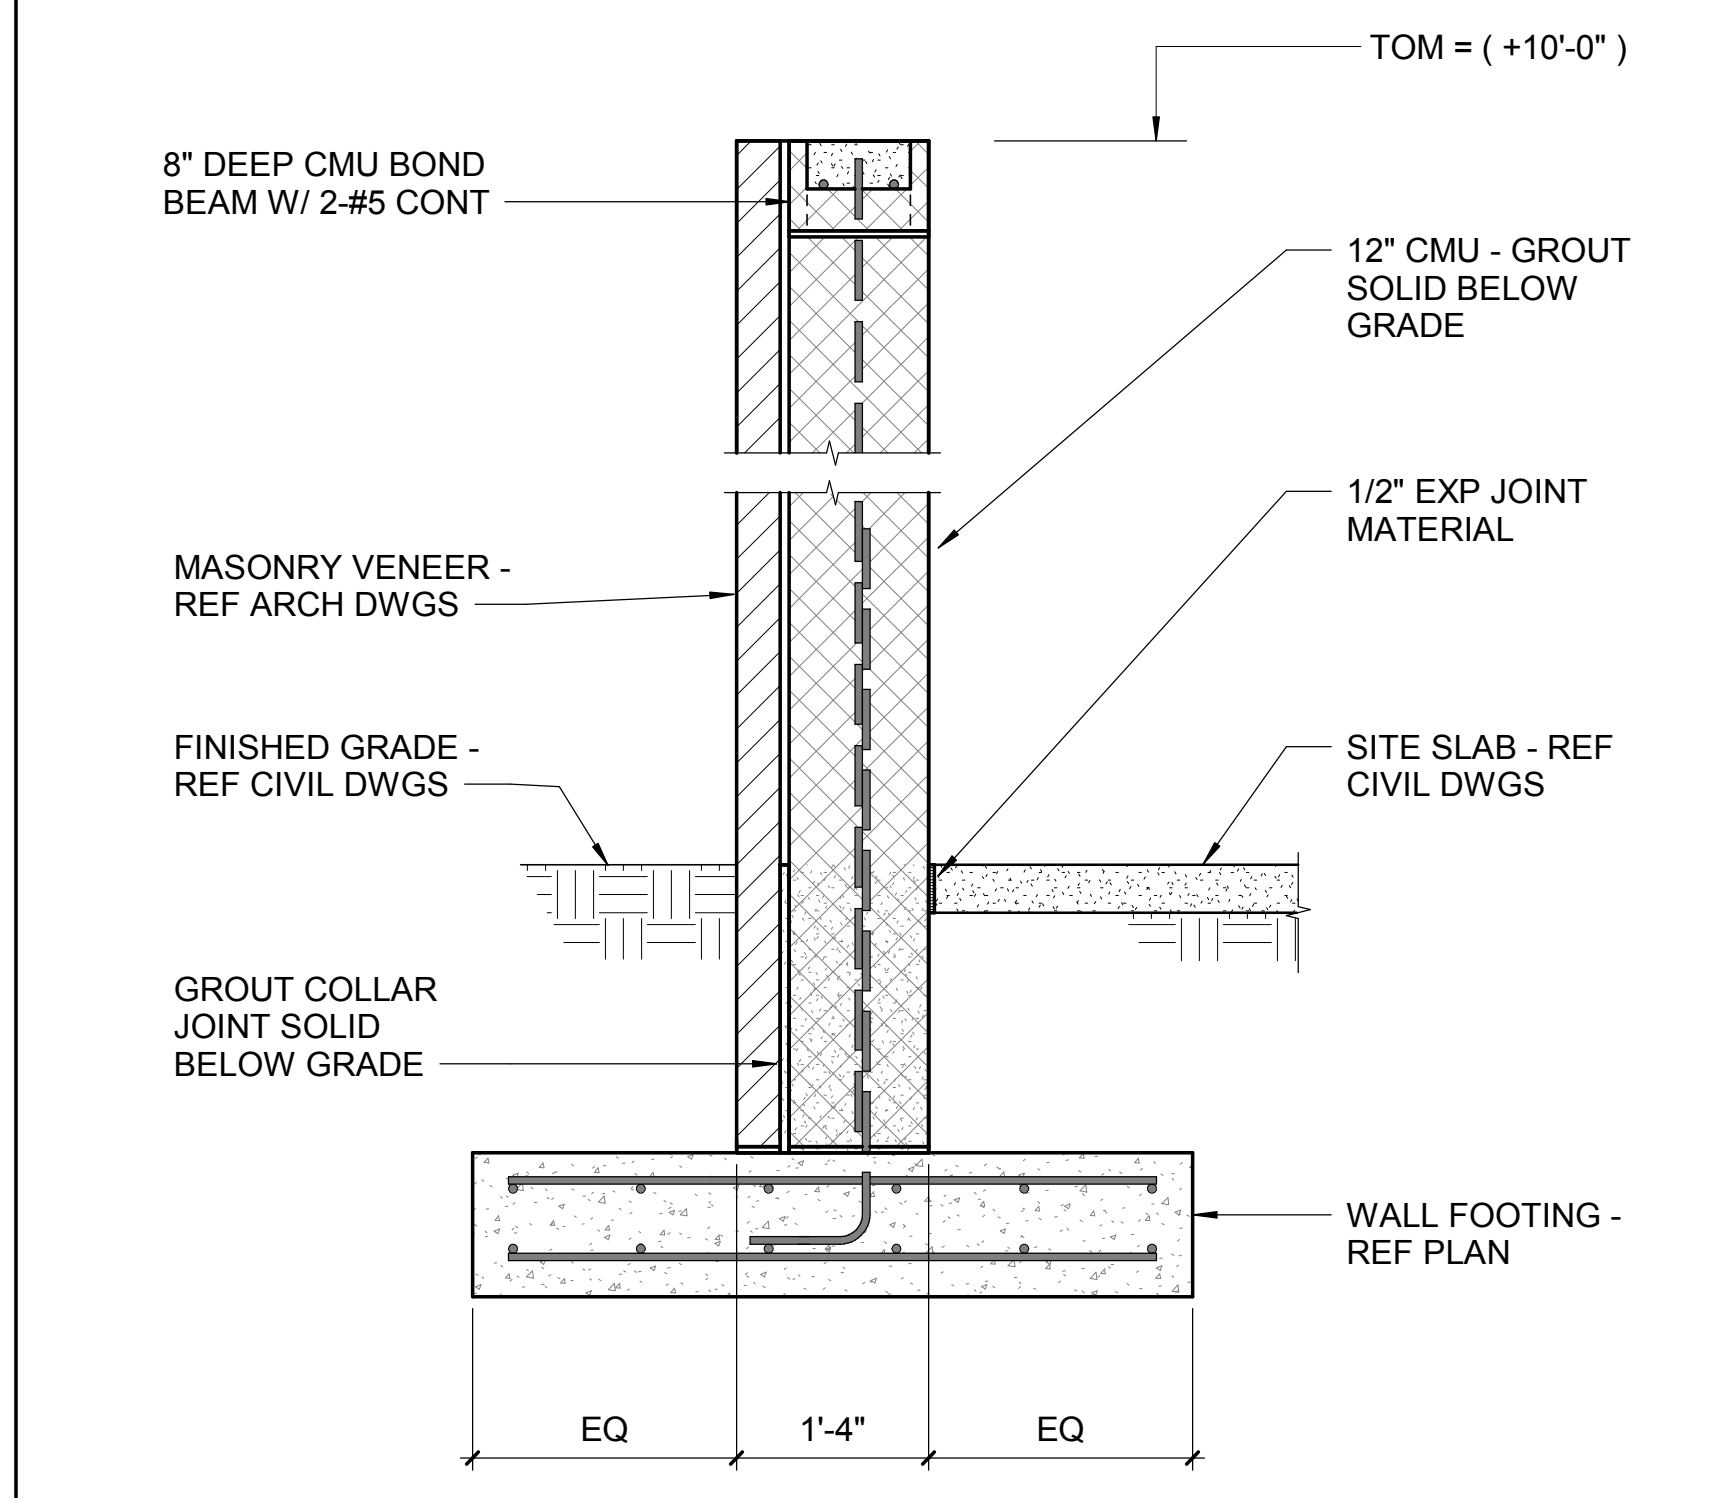


8 SECTION
S3-01 3/4" = 1'-0"

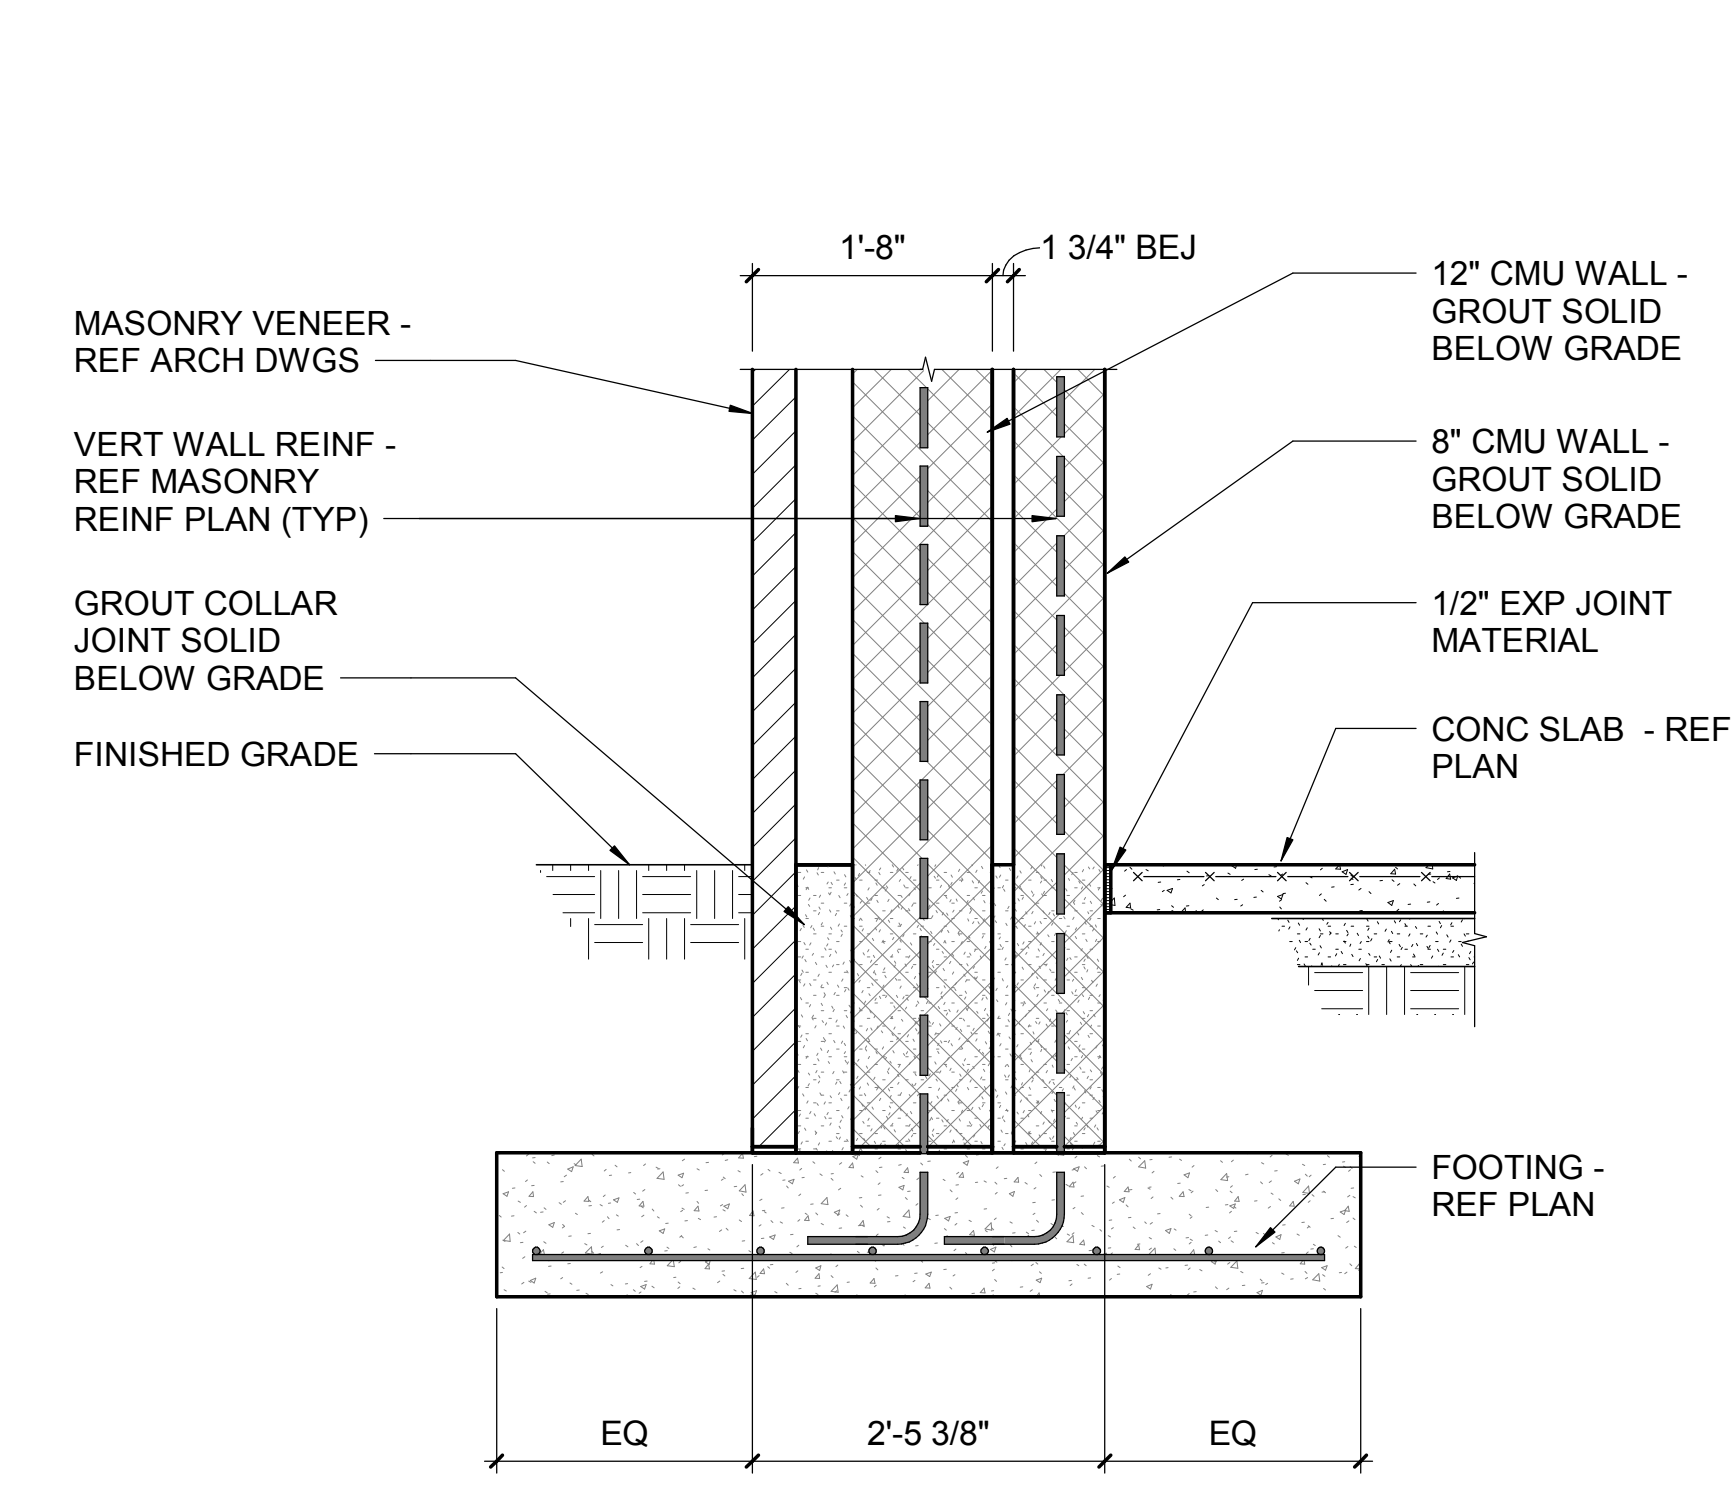

9 SECTION
S3-01 3/4" = 1'-0"

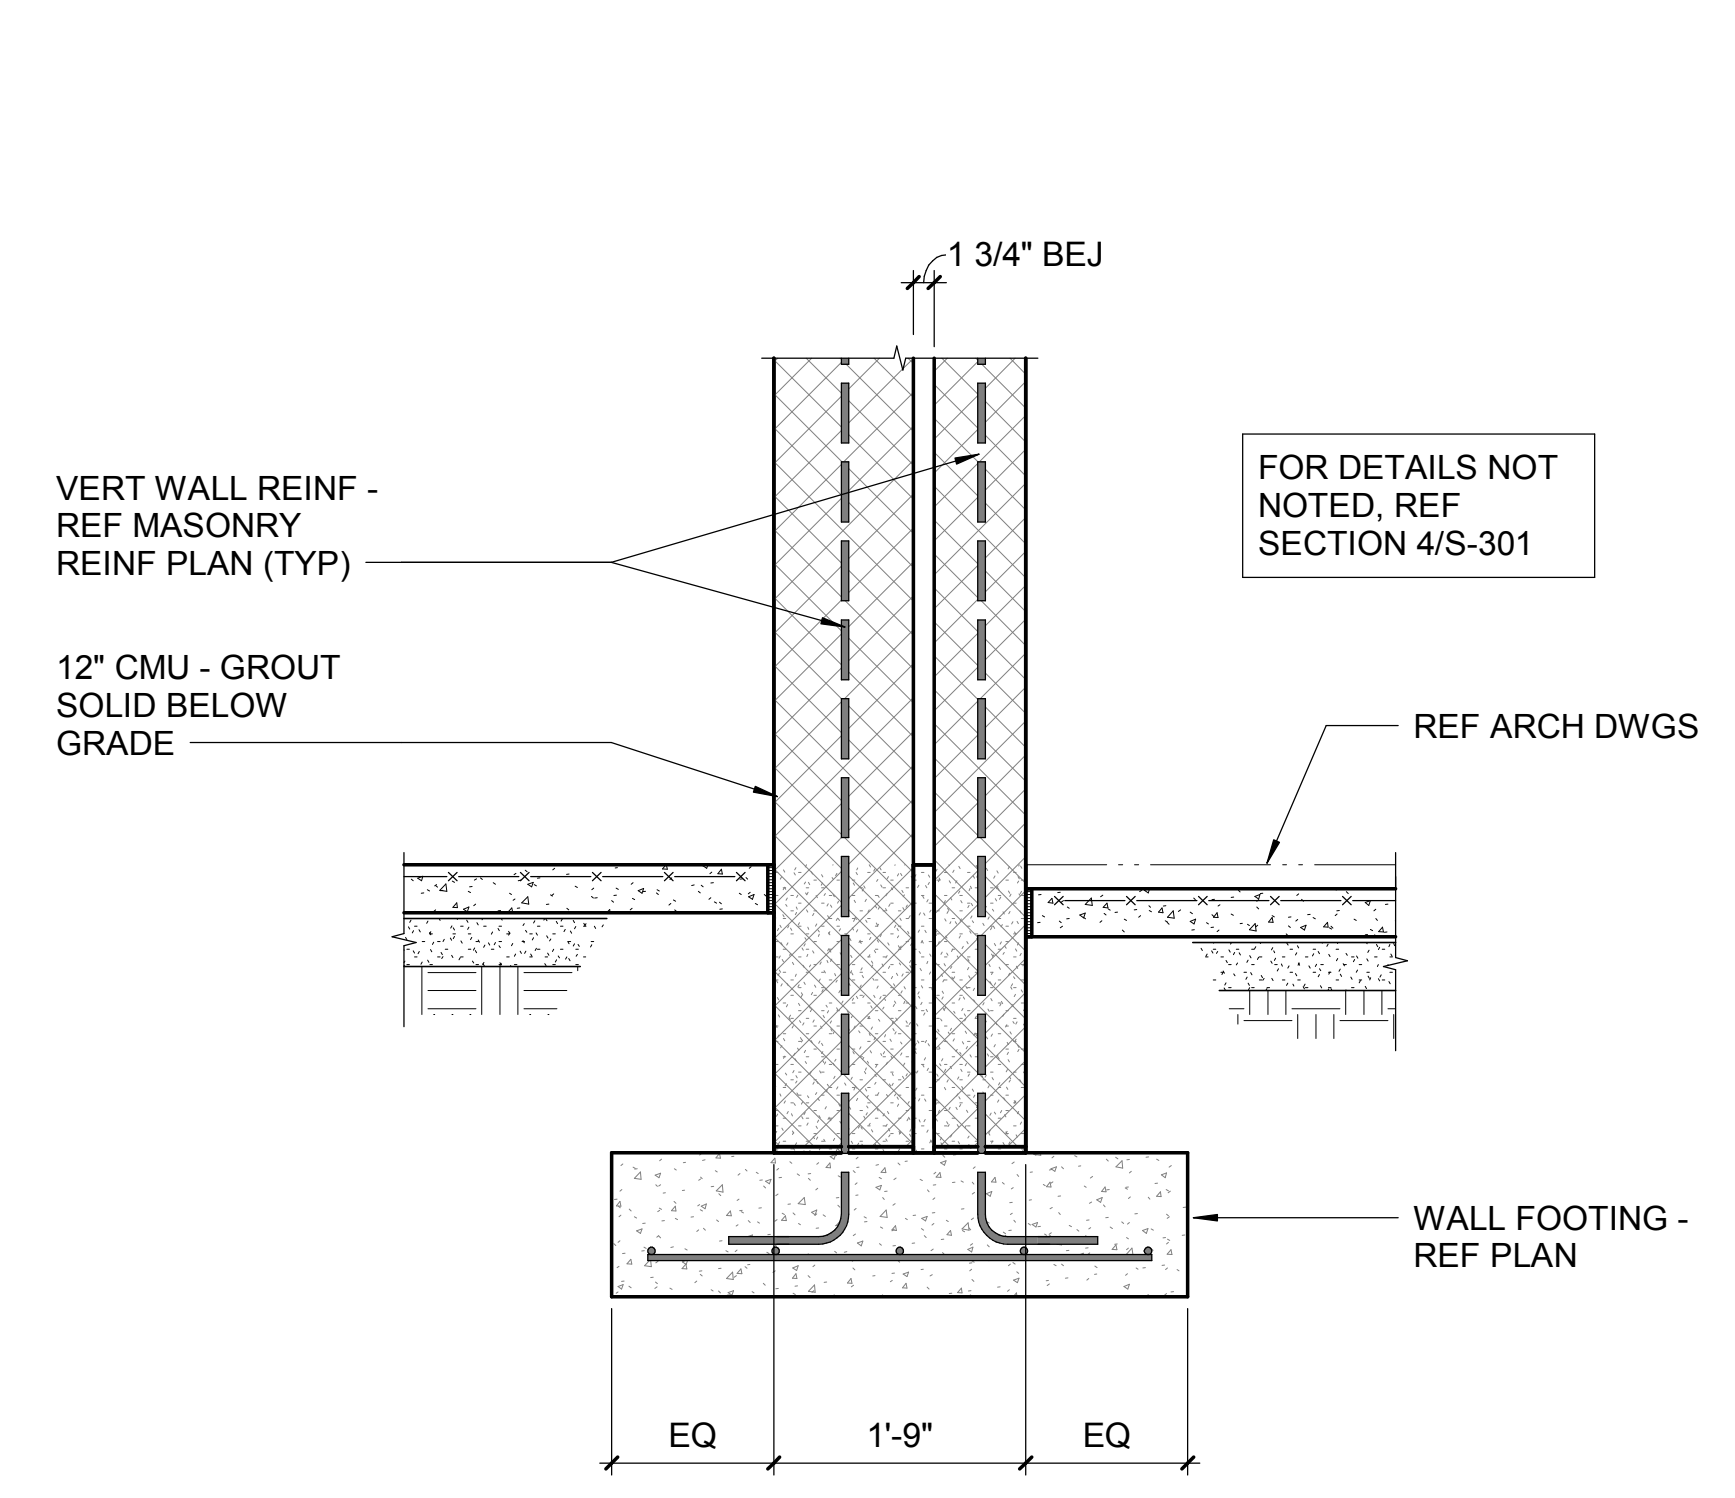

10 SECTION
S3-01 3/4" = 1'-0"

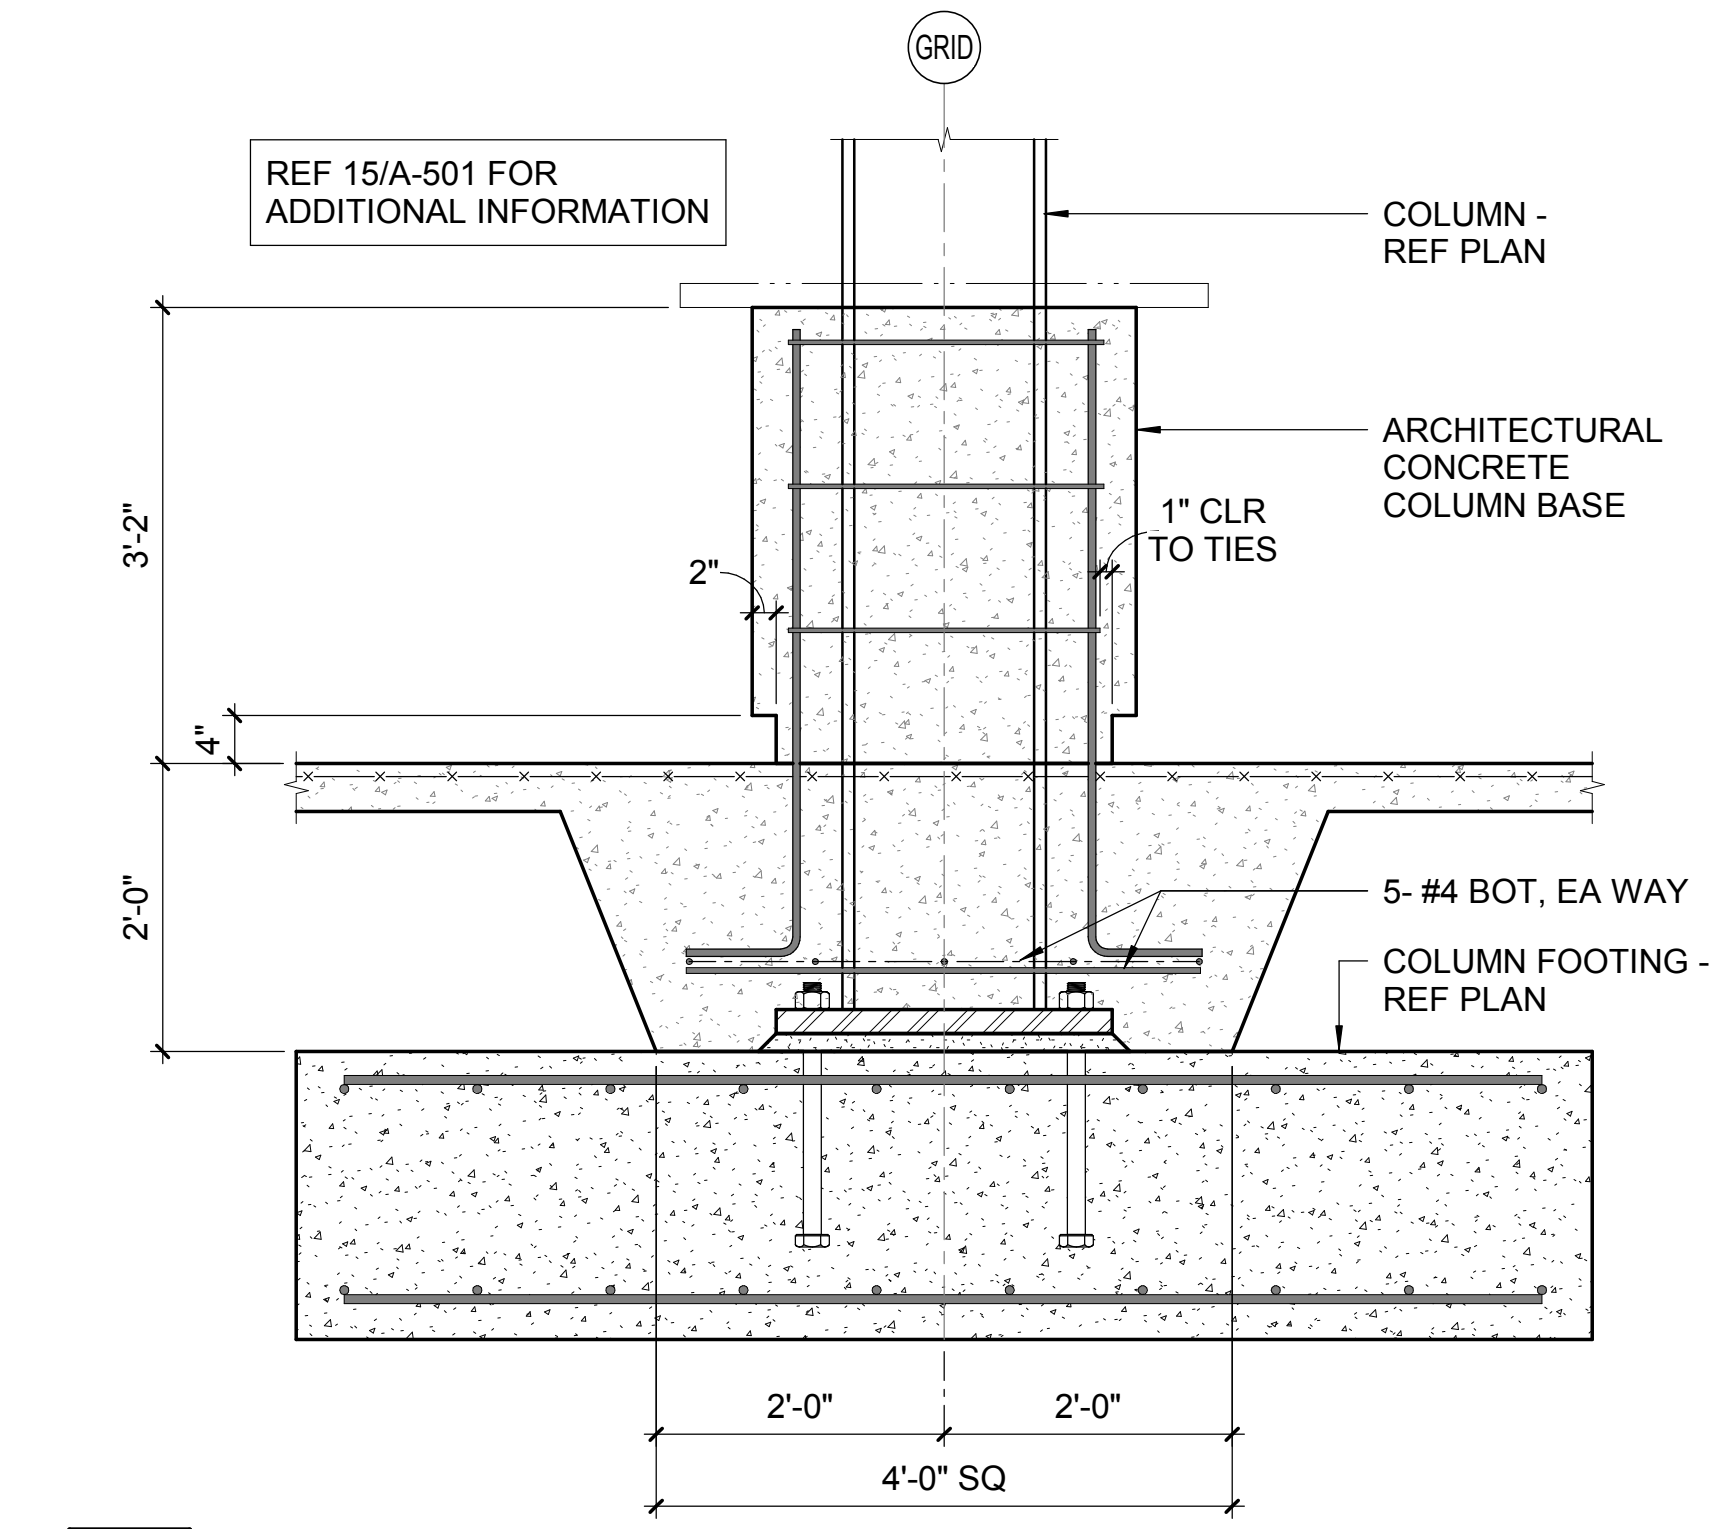

11 SECTION
S3-01 3/4" = 1'-0"

C:\01_Revit\Temp\Floor\18185_Trimly MS_SITRC_R18_618mm.rvt 6/20/19 2:53:57 PM



Progressive Design Collaborative, Ltd

3101 Poplarwood Court, Suite 320

Raleigh, North Carolina 27604

919-790-9989

ADDENDUM 03 – PLUMBING

DATE: June 14, 2019

PROJECT: Trinity Middle School
PDC Project # 17104



This Addendum, applicable to the work designed below, shall be understood to be and is a change to the bid documents and shall be part of and included in the contract for the above referenced project. All General, Supplementary and Special Conditions, etc., as originally specified or as modified below shall apply to these items.

Changes to Plumbing Drawings:

1. Drawing P0-01
 - a. Changed Urinal Model Number - Note that U-1 / U-2 Urinals are to be Model No. 6590.001 by American Standard, or approved equal from listed equals in specifications
 - b. Removed Fixture L-4 Kitchen Hand-Wash Lavatory - Plumbing contractor still required to provide final connections to Kitchen Area Hand-Wash Lavatories provided as part of Kitchen Equipment / Food Service Contract
 - c. Revised Shower Fixtures SH-1, SH-2 Model Numbers to be Hydapipe Metered type with exterior mounted Stainless Steel Shroud, and Added Shower SH-4 Fixture for Coaches Office Hydapipe Non-Metered Type with exterior mounted Stainless Steel Shroud
2. Drawing P1-02
 - a. Revised location of Shower Controls at Roll-In/Transfer Showers SH-3 in Rooms Toilet 114 and Toilet 111
3. Drawing P1-07
 - a. Revised location of Shower Controls at Roll-In/Transfer Showers SH-1 in Rooms Locker 636 and Locker 645
 - b. Revised Fixture Callout to new Shower SH-4 Fixture and moved controls at Room Toilet 637




pdcengineers.com

4. Drawing P2-01
 - a. Revised Keynote 2 to include verbiage regarding Valved Piping Bypass added for possible future Pressure Reducing Station
 - b. Revised Keynote 4
 - c. Revised Piping configuration at Domestic Water Riser to include regarding Valved Piping Bypass added for possible future Pressure Reducing Station
 - d. Added Detail for Valved Piping Bypass added for possible future Pressure Reducing Station
 - e. Removed Fixture Tags (L-4) from Kitchen Hand-Wash Lavatories (Lavatories provided under Food Service Contract) and added Kitchen Equipment Symbol corresponding to Kitchen Equipment Schedule for reference.
 - f. Revised portions of the Domestic Water Service Piping sizes.
5. Drawing P3-02
 - a. Riser Diagram updated to match changes to Shower Control Locations at Rooms Toilet 114 and Toilet 111
6. Drawing P3-03
 - a. Riser Diagrams updated to match changes to Kitchen / Boiler Rooms including removal of Kitchen Lavatory callouts, some Domestic Water Piping Sizes, and addition of Valved Piping Bypass at Domestic Water Riser
7. Drawing P3-13
 - a. Riser Diagram updated to match changes to Shower Control Locations at Locker Rooms

END OF ADDENDUM 03 – PLUMBING

Attachments: Drawing Sheets (4)

WALL RATINGS LEGEND	
	1 HR RATED WALL
	2 HR RATED WALL

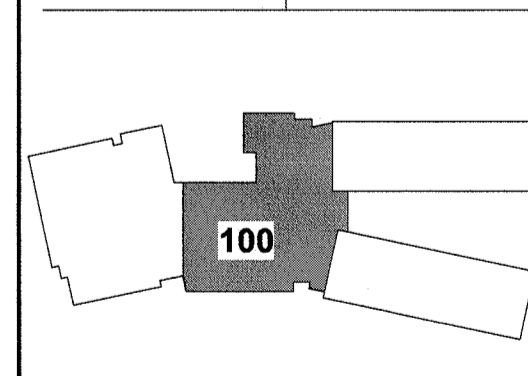


**KEY PLAN
NO SCALE**

ID	DATE	DESCRIPTION
1	06/14/19	ADDENDUM 03

DRAWN BY: _____
CHECKED BY: _____

100A WING - FIRST FLOOR PLUMBING PLAN


2017032 20 MAY 2019

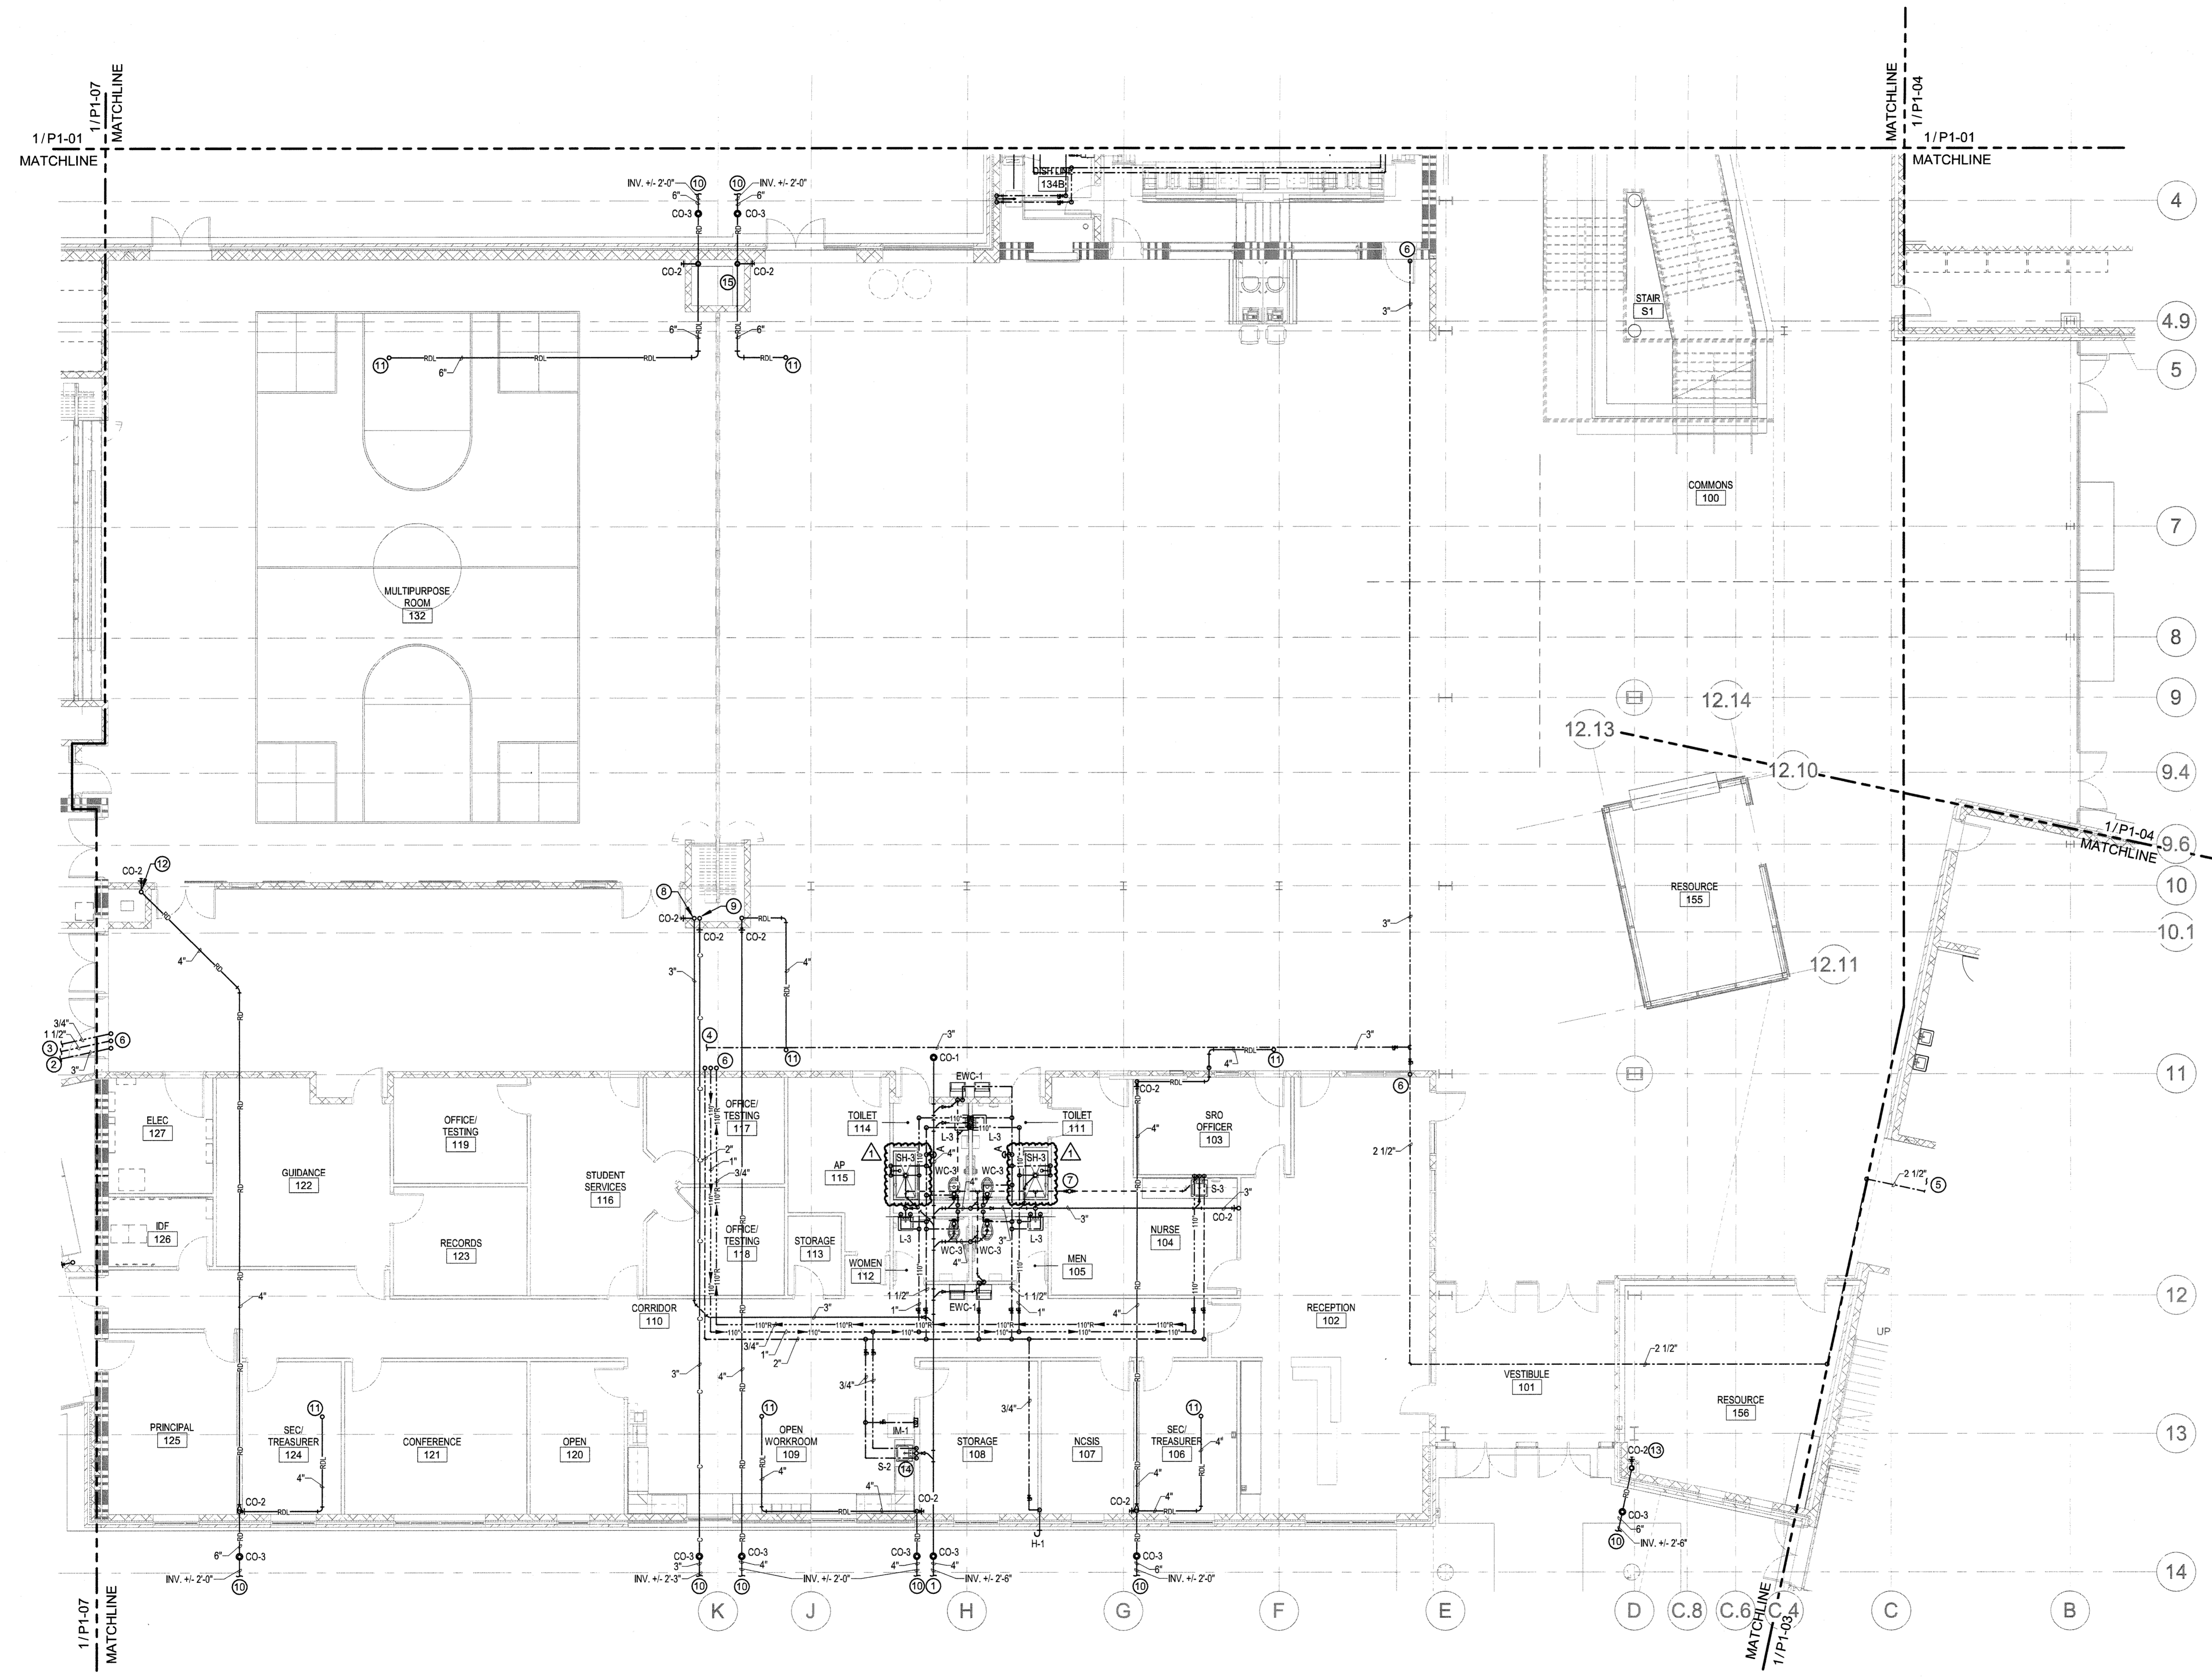


GENERAL NOTES:
1. ALL VENT PIPING SHALL BE 2" UNLESS OTHERWISE NOTED.

- NOTES:** (AS INDICATED ON THIS PLAN BY A NUMBER IN A ○)
- 1 PROVIDE MATERIALS AND MAKE CONNECTION TO SANITARY SEWER PIPING PROVIDED BY SITE UTILITIES CONTRACTOR.
 - 2 DOMESTIC COLD WATER PIPING. REFER TO SHEET P1-07 FOR CONTINUATION.
 - 3 DOMESTIC HOT WATER PIPING. REFER TO SHEET P1-07 FOR CONTINUATION.
 - 4 DOMESTIC COLD WATER PIPING. REFER TO SHEET P1-01/3 FOR CONTINUATION.
 - 5 DOMESTIC COLD WATER PIPING. REFER TO SHEET P1-03 FOR CONTINUATION.
 - 6 PLUMBING CONTRACTOR TO COORDINATE PIPING RISE AND DROP AS NEEDED TO STAY ABOVE CEILINGS OR AT UNDERSIDE OF ROOF DECKING IN AREAS WITH NO CEILING. REFER TO SHEET P1-01 & P2-01 FOR CONTINUATION.
 - 7 3" VTR.
 - 8 2" SANITARY WASTE PIPING DOWN FROM ABOVE. REFER TO SHEET P1-01/3 FOR CONTINUATION. TRANSITION TO 3" PIPING BELOW SLAB.
 - 9 2" CONDENSATE PIPING DOWN FROM ABOVE. REFER TO SHEET P1-01/3 FOR CONTINUATION. TRANSITION TO 3" PIPING BELOW SLAB.
 - 10 PROVIDE MATERIALS AND MAKE CONNECTION TO STORM SEWER PIPING PROVIDED BY SITE UTILITIES CONTRACTOR.
 - 11 ROOF DRAIN LEADER. REFER TO SHEET P1-08 FOR CONTINUATION.
 - 12 ROOF DRAIN LEADER. REFER TO SHEET P1-01/3 FOR CONTINUATION.
 - 13 ROOF DRAIN LEADER. REFER TO SHEET P1-05 FOR CONTINUATION.
 - 14 2" VENT UP TO 2" VTR. REFER TO SHEET P1-08 FOR CONTINUATION.
 - 15 COORDINATE CLOSELY ROOF DRAIN LEADERS THIS AREA WITH MECHANICAL PIPING AND DUCTING ALSO IN THIS AREA. ROOF DRAIN LEADERS MAY BE REQUIRED TO BE INSTALLED ABOVE MECHANICAL DUCTING/PIPING FOR SYSTEMS TO DROP AS NEEDED.

100A WING - FIRST FLOOR PLUMBING PLAN
1/8" = 1'-0"

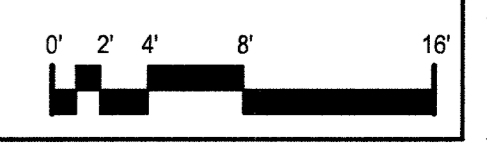

WALL RATINGS LEGEND

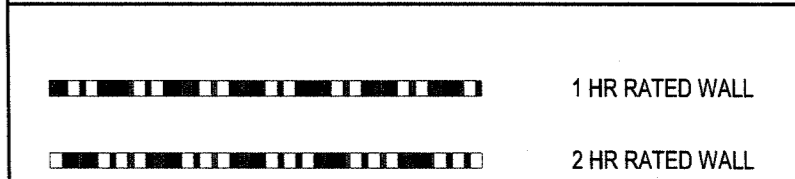


**smith
sinnett**
ARCHITECTURE

1101 7th St
1101 7th St
600 Lake Boone Hall
Suite 205
Cary, NC 27513
info@smithsinnett.com

pdc

Progressive Design Collaborative, Inc.

5101 Rutherford Court, Suite 100
Raleigh, North Carolina 27606
919.700.0900
PROJECT #17104
Issue #1 C-01-03
pdcrae.com

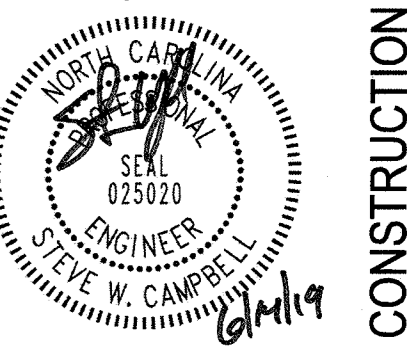

VOLUME II

This drawing and the design shown is the property of Smith Sinnett Architecture, P.A. The user may not reproduce or transmit this drawing or any part of it without the written consent of the architect. The user agrees to hold the architect harmless from any claims or damages that may be asserted against the architect or the architect's firm, its officers, directors, employees, agents, or representatives in connection with the use of this drawing. The user agrees to indemnify and hold the architect and its firm, its officers, directors, employees, agents, or representatives harmless from any claims or damages that may be asserted against the architect or the architect's firm, its officers, directors, employees, agents, or representatives in connection with the use of this drawing.

Smith Sinnett Architecture, P.A. 2019
THIS DRAWING IS FORWARDED TO BE PRINTED ON A 36" X 48" SHEET

**NEW TRINITY MIDDLE SCHOOL
RANDOLPH COUNTY SCHOOL SYSTEM**

Parcel PIN 7708118367
Surrett Drive
Trinity, NC 27370

**KEY PLAN
NO SCALE**


ID	DATE	DESCRIPTION
1	06/14/19	ADDENDUM 03

DRAWN BY: Author
CHECKED BY: RA

600 WING - FIRST FLOOR PLUMBING PLAN

2017032 20 MAY 2019

P1-07

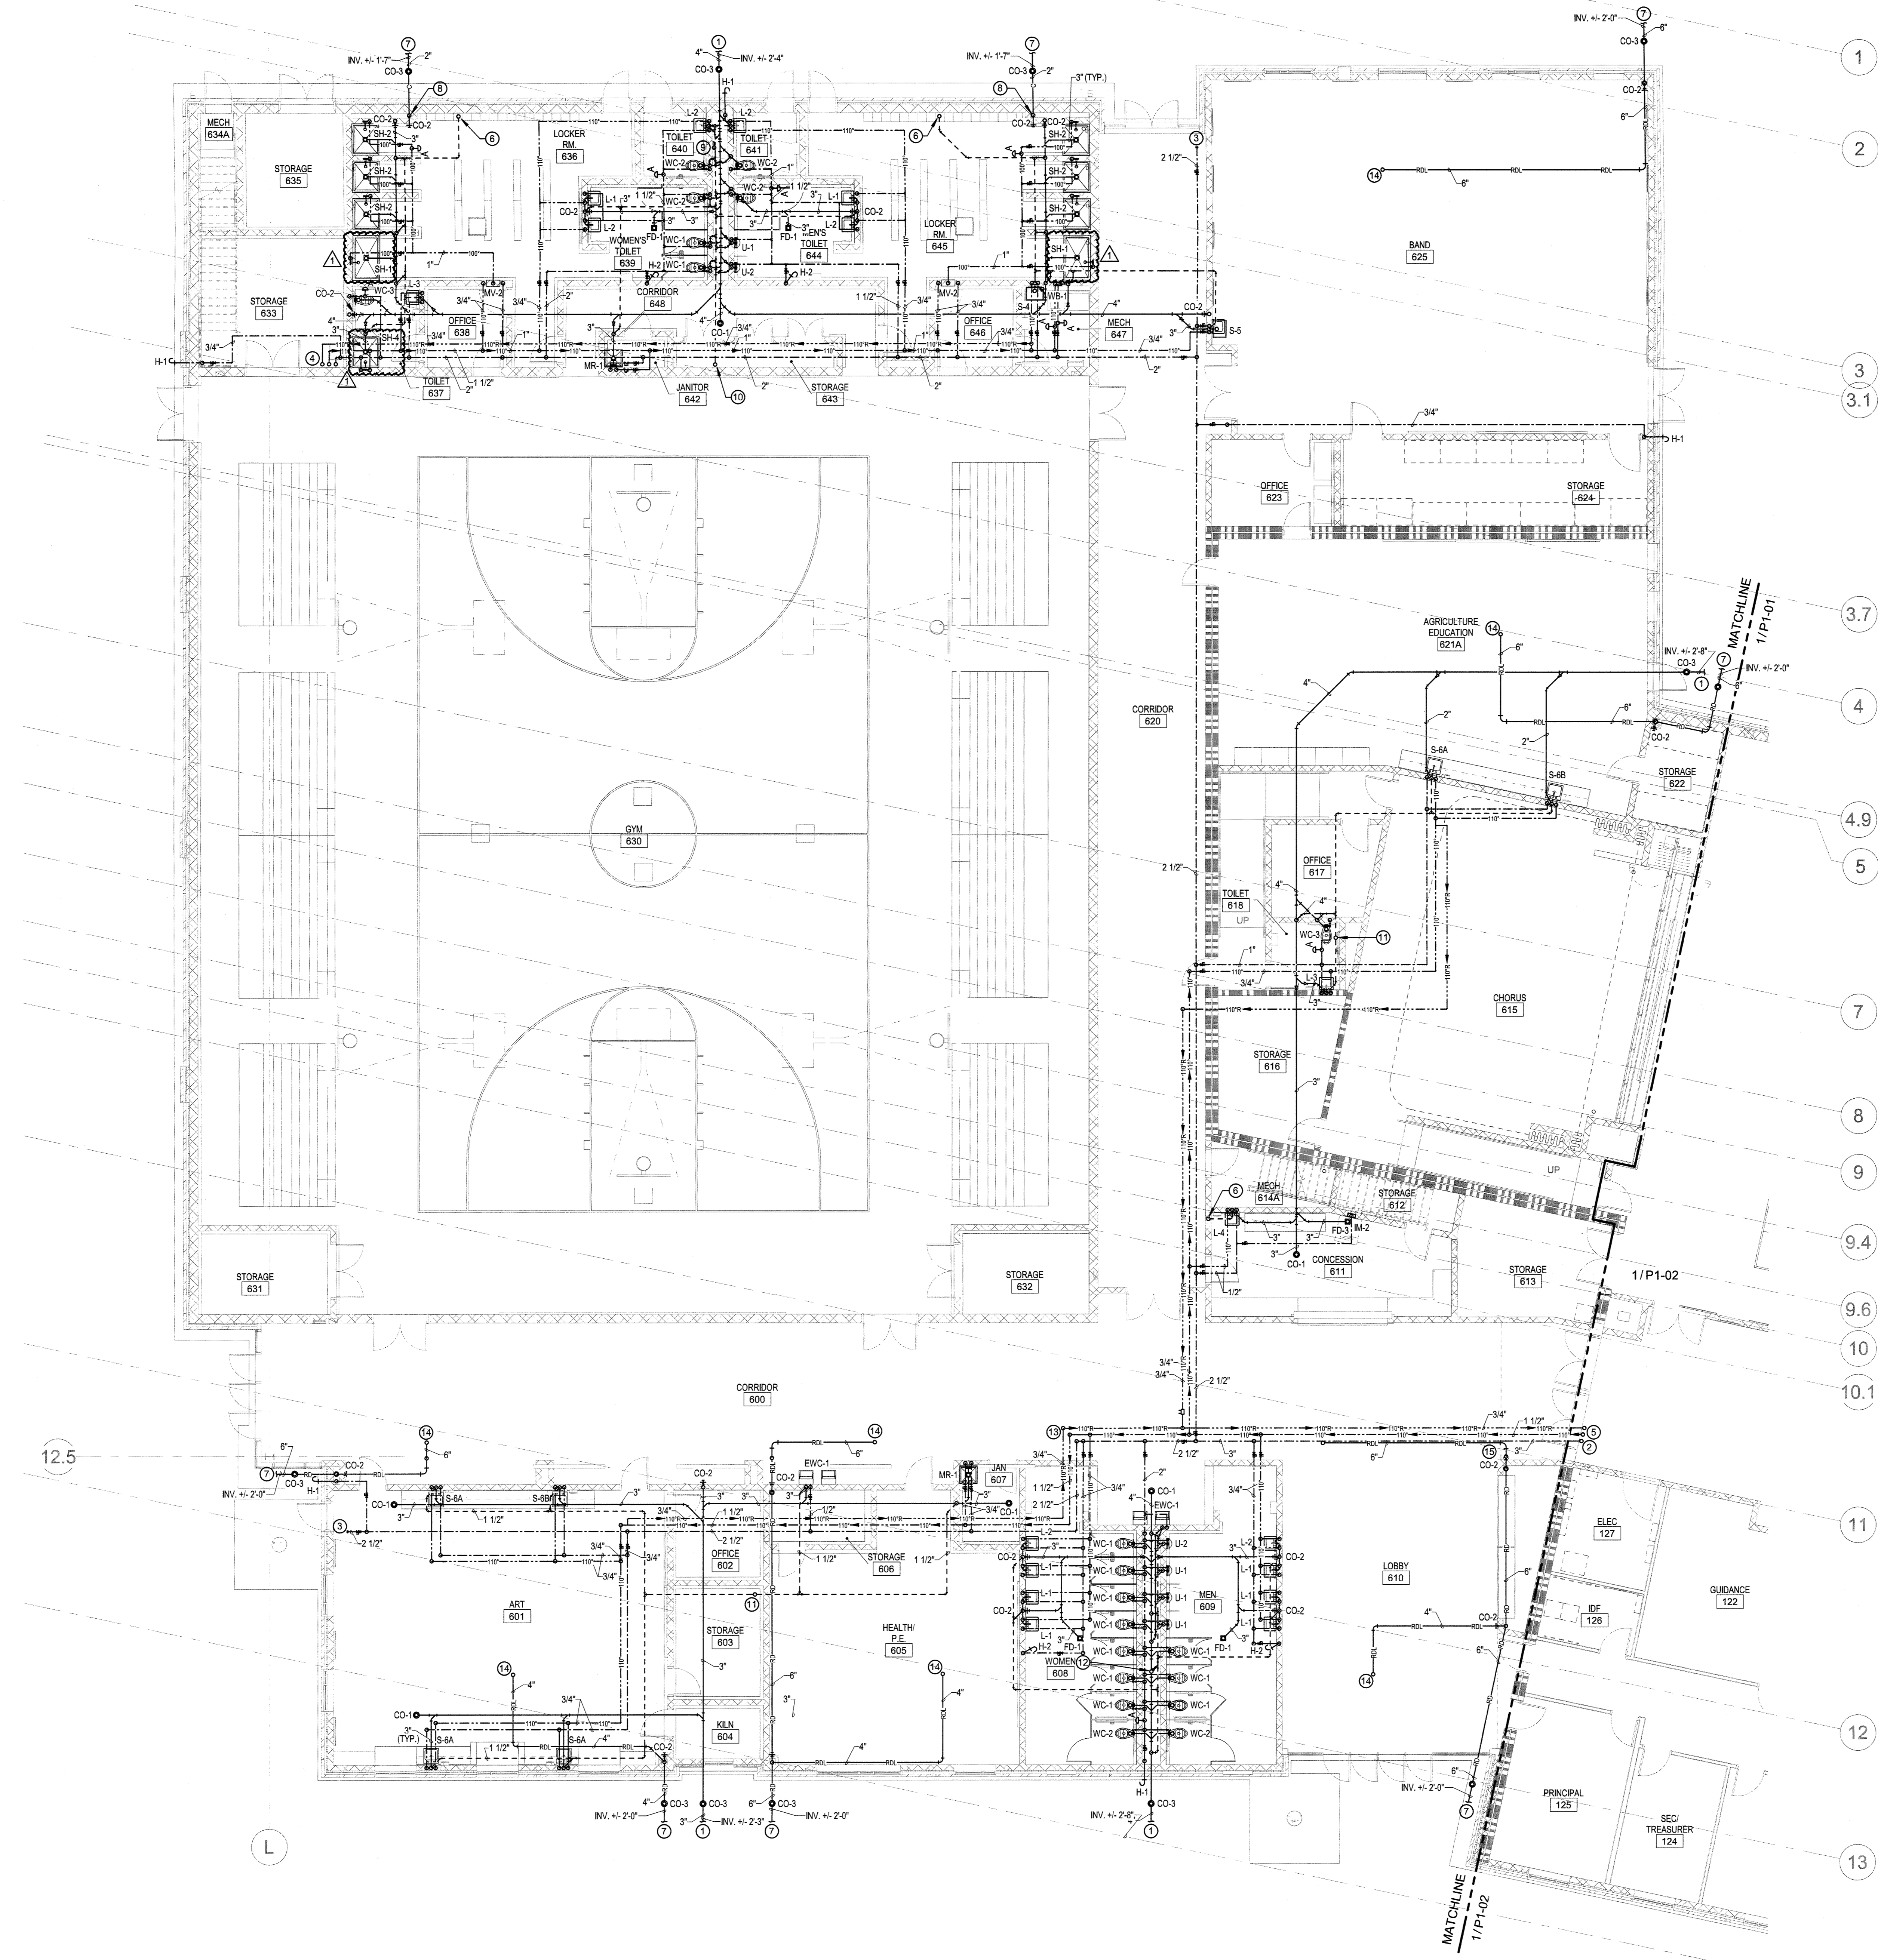



GENERAL NOTES:

1. ALL VENT PIPING SHALL BE 2" UNLESS OTHERWISE NOTED.


NOTES (AS INDICATED ON THIS PLAN BY A NUMBER IN A CIRCLE)

- 1 PROVIDE MATERIALS AND MAKE CONNECTION TO SANITARY SEWER PIPING PROVIDED BY SITE UTILITIES CONTRACTOR.
- 2 DOMESTIC COLD WATER PIPING. REFER TO SHEET P1-01/1 FOR CONTINUATION.
- 3 CAPPED FOR POSSIBLE FUTURE EXPANSION. PLACE ADJACENT VALVE IN THE CLOSED POSITION.
- 4 1 1/2" COLD WATER, 1 1/2" HOT WATER, 3/4" HOT WATER RETURN FROM MECHANICAL PLATFORM ABOVE. REFER TO SHEET P1-01/4 FOR CONTINUATION.
- 5 DOMESTIC HOT WATER PIPING. REFER TO SHEET P1-01/1 FOR CONTINUATION.
- 6 2" VENT PIPING UP. REFER TO P1-01/3 & P1-01/4 FOR CONTINUATION.
- 7 PROVIDE MATERIALS AND MAKE CONNECTION TO STORM SEWER PIPING PROVIDED BY SITE UTILITIES CONTRACTOR.
- 8 2" CONDENSATE PIPING DOWN FROM ABOVE. REFER TO P1-01/4 FOR CONTINUATION.
- 9 2" SANITARY WASTE PIPING DOWN FROM ABOVE. REFER TO P1-01/4 FOR CONTINUATION.
- 10 3" VENT PIPING UP. REFER TO P1-01/4 FOR CONTINUATION.
- 11 2" VENT PIPING UP TO 2" VTR.
- 12 3" VENT PIPING UP TO 3" VTR.
- 13 PLUMBING CONTRACTOR TO COORDINATE PIPE DROPS AND ENTRANCE INTO SOFFIT AND/OR CEILING AT THIS LOCATION SO THAT PIPING IS NOT EXPOSED. REFER TO ARCHITECTURE DRAWINGS AND COORDINATE WITH GENERAL CONTRACTOR.
- 14 ROOF DRAIN PIPING FROM ROOF DRAIN ABOVE. REFER TO P1-08 FOR CONTINUATION.
- 15 ROOF DRAIN PIPING FROM ROOF DRAIN ABOVE. REFER TO P1-01/3 FOR CONTINUATION.

1 600 WING - FIRST FLOOR PLUMBING PLAN

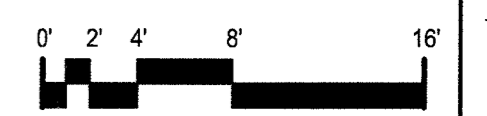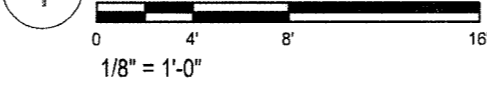


C:\Users\jshelton\Documents\17104_TRINITYMS_PDC_Central_0419\sheet\600 Wing - First Floor Plumbing Plan.dwg 6/13/2019 11:57:59 AM

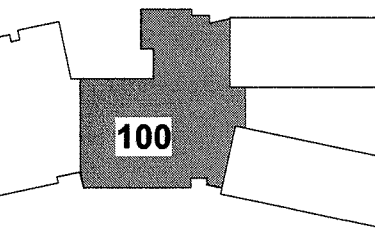


KEY PLAN
NO SCALE

ID	DATE	DESCRIPTION
1	06/14/19	ADDENDUM 03


DRAWN BY: Author
CHECKED BY: RA
100A WING - HOT & COLD WATER RISER

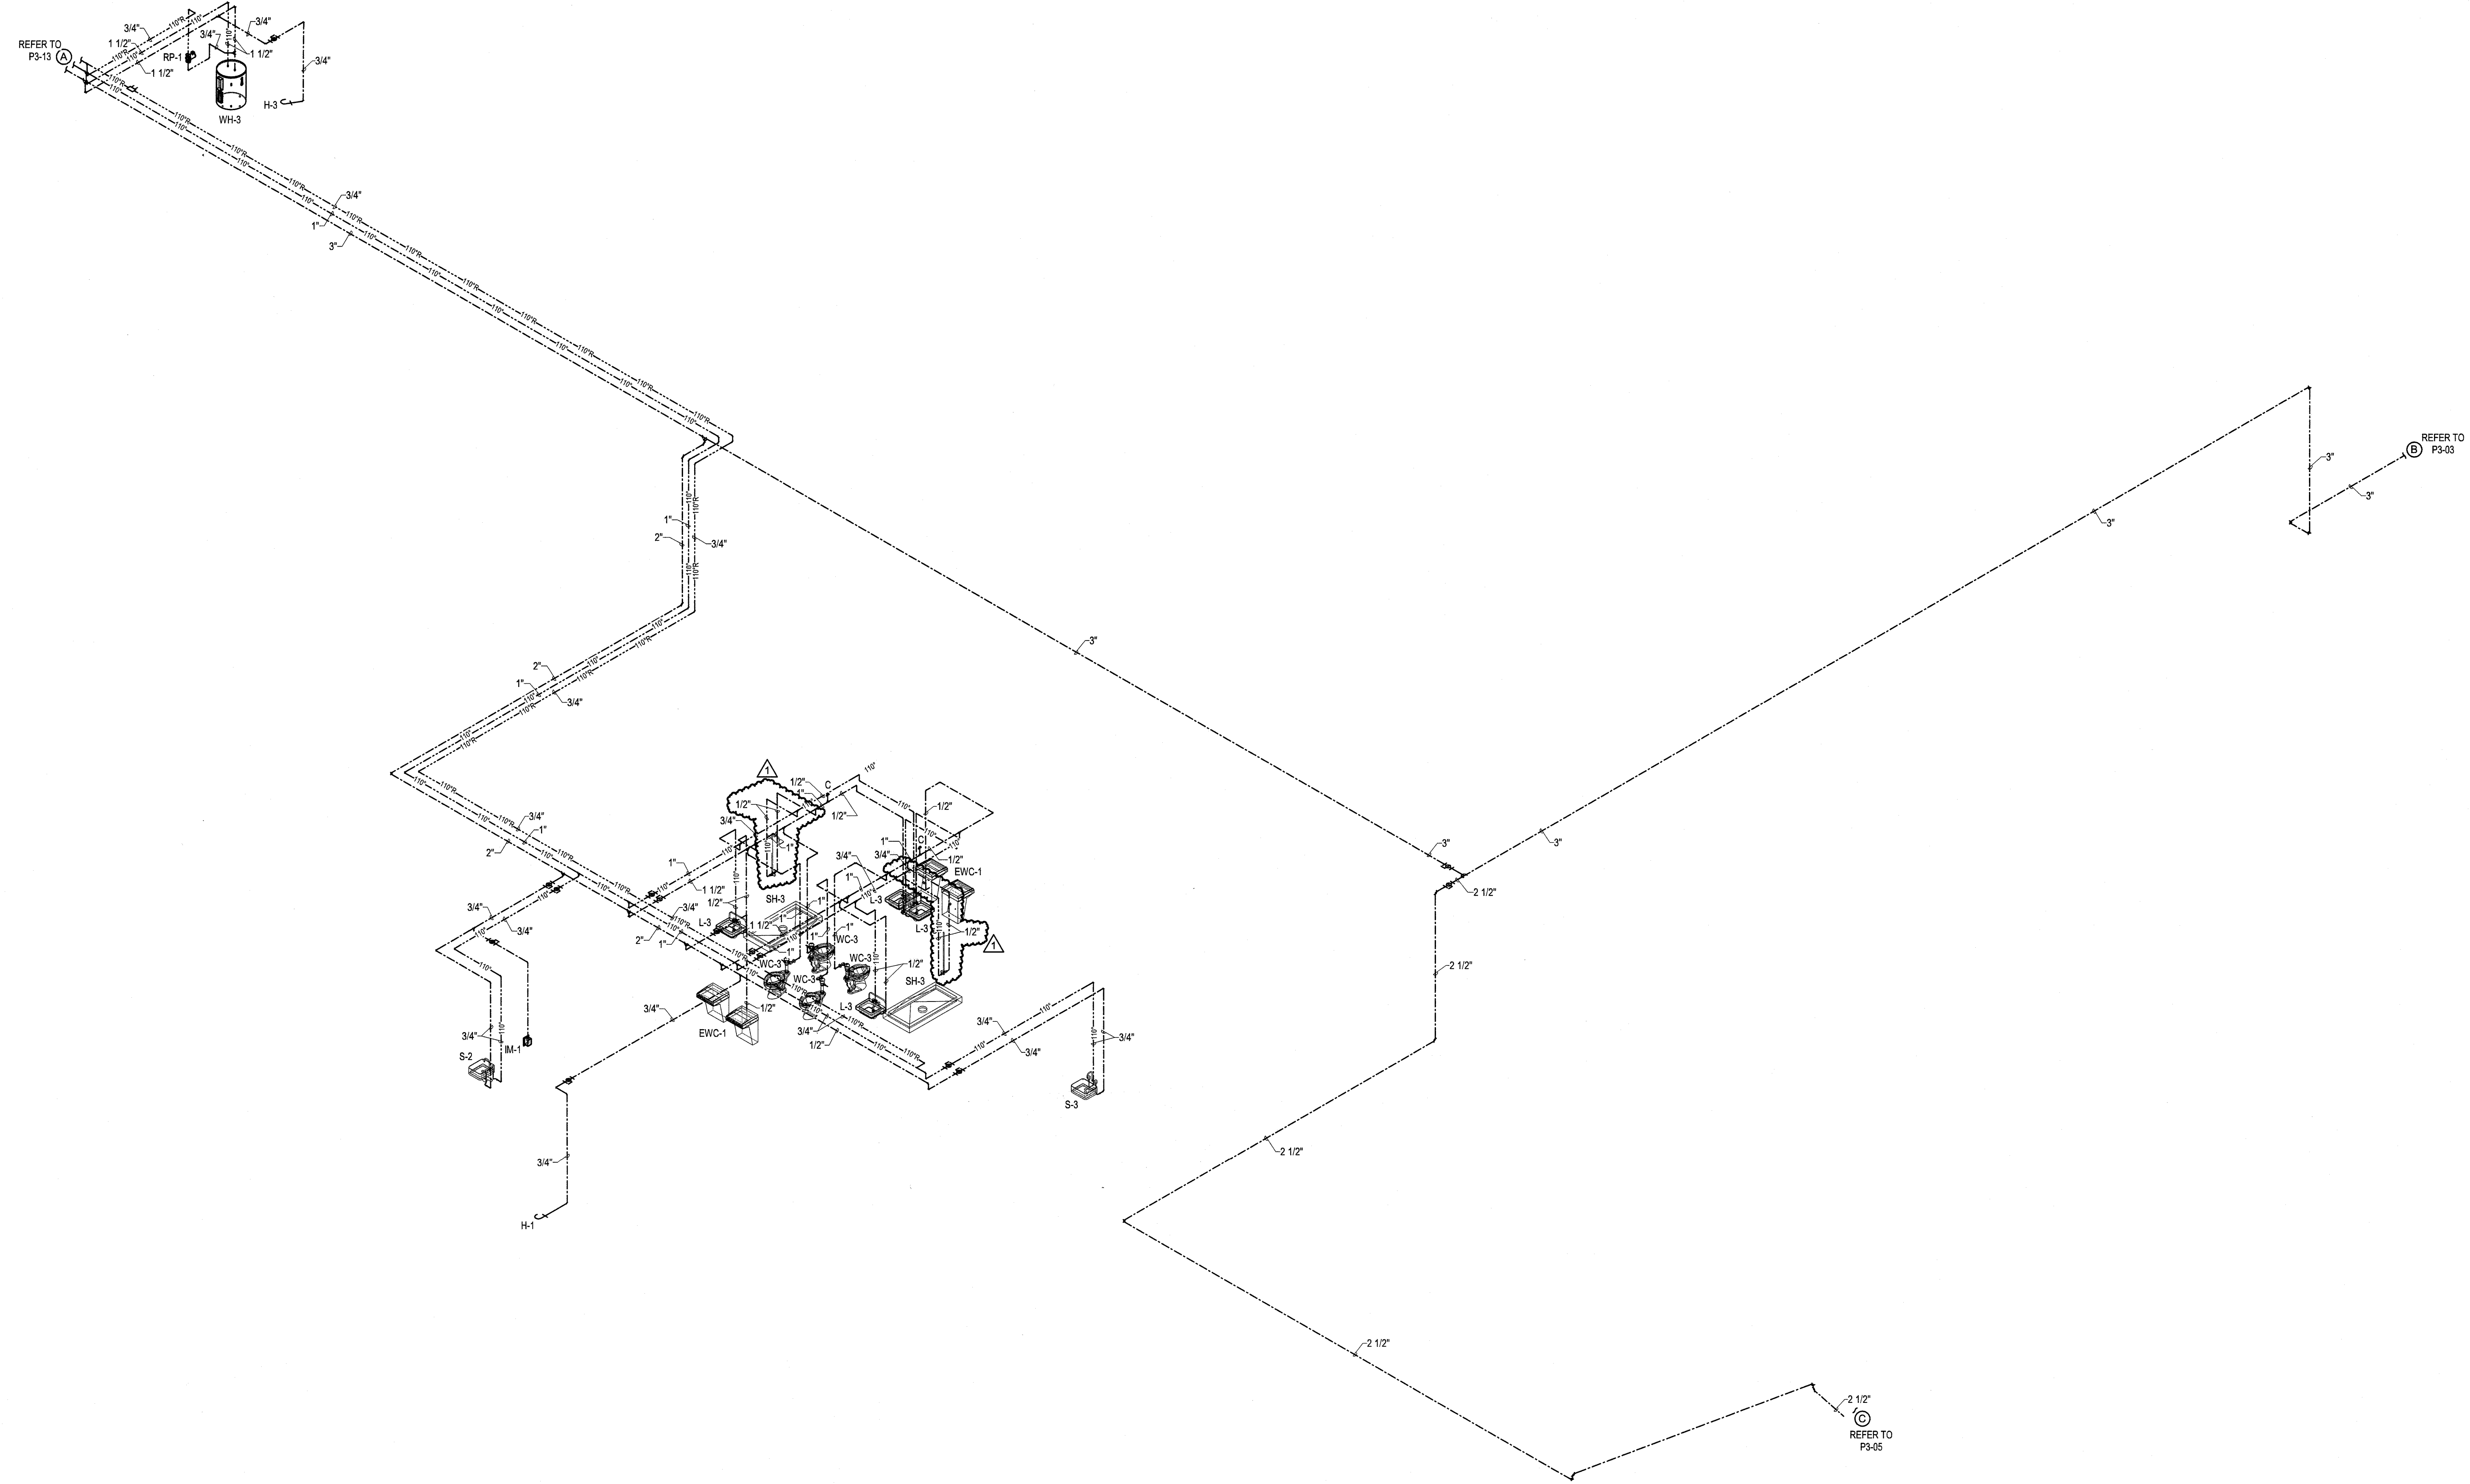

1 100A WING - HOT & COLD WATER RISER
NOT TO SCALE


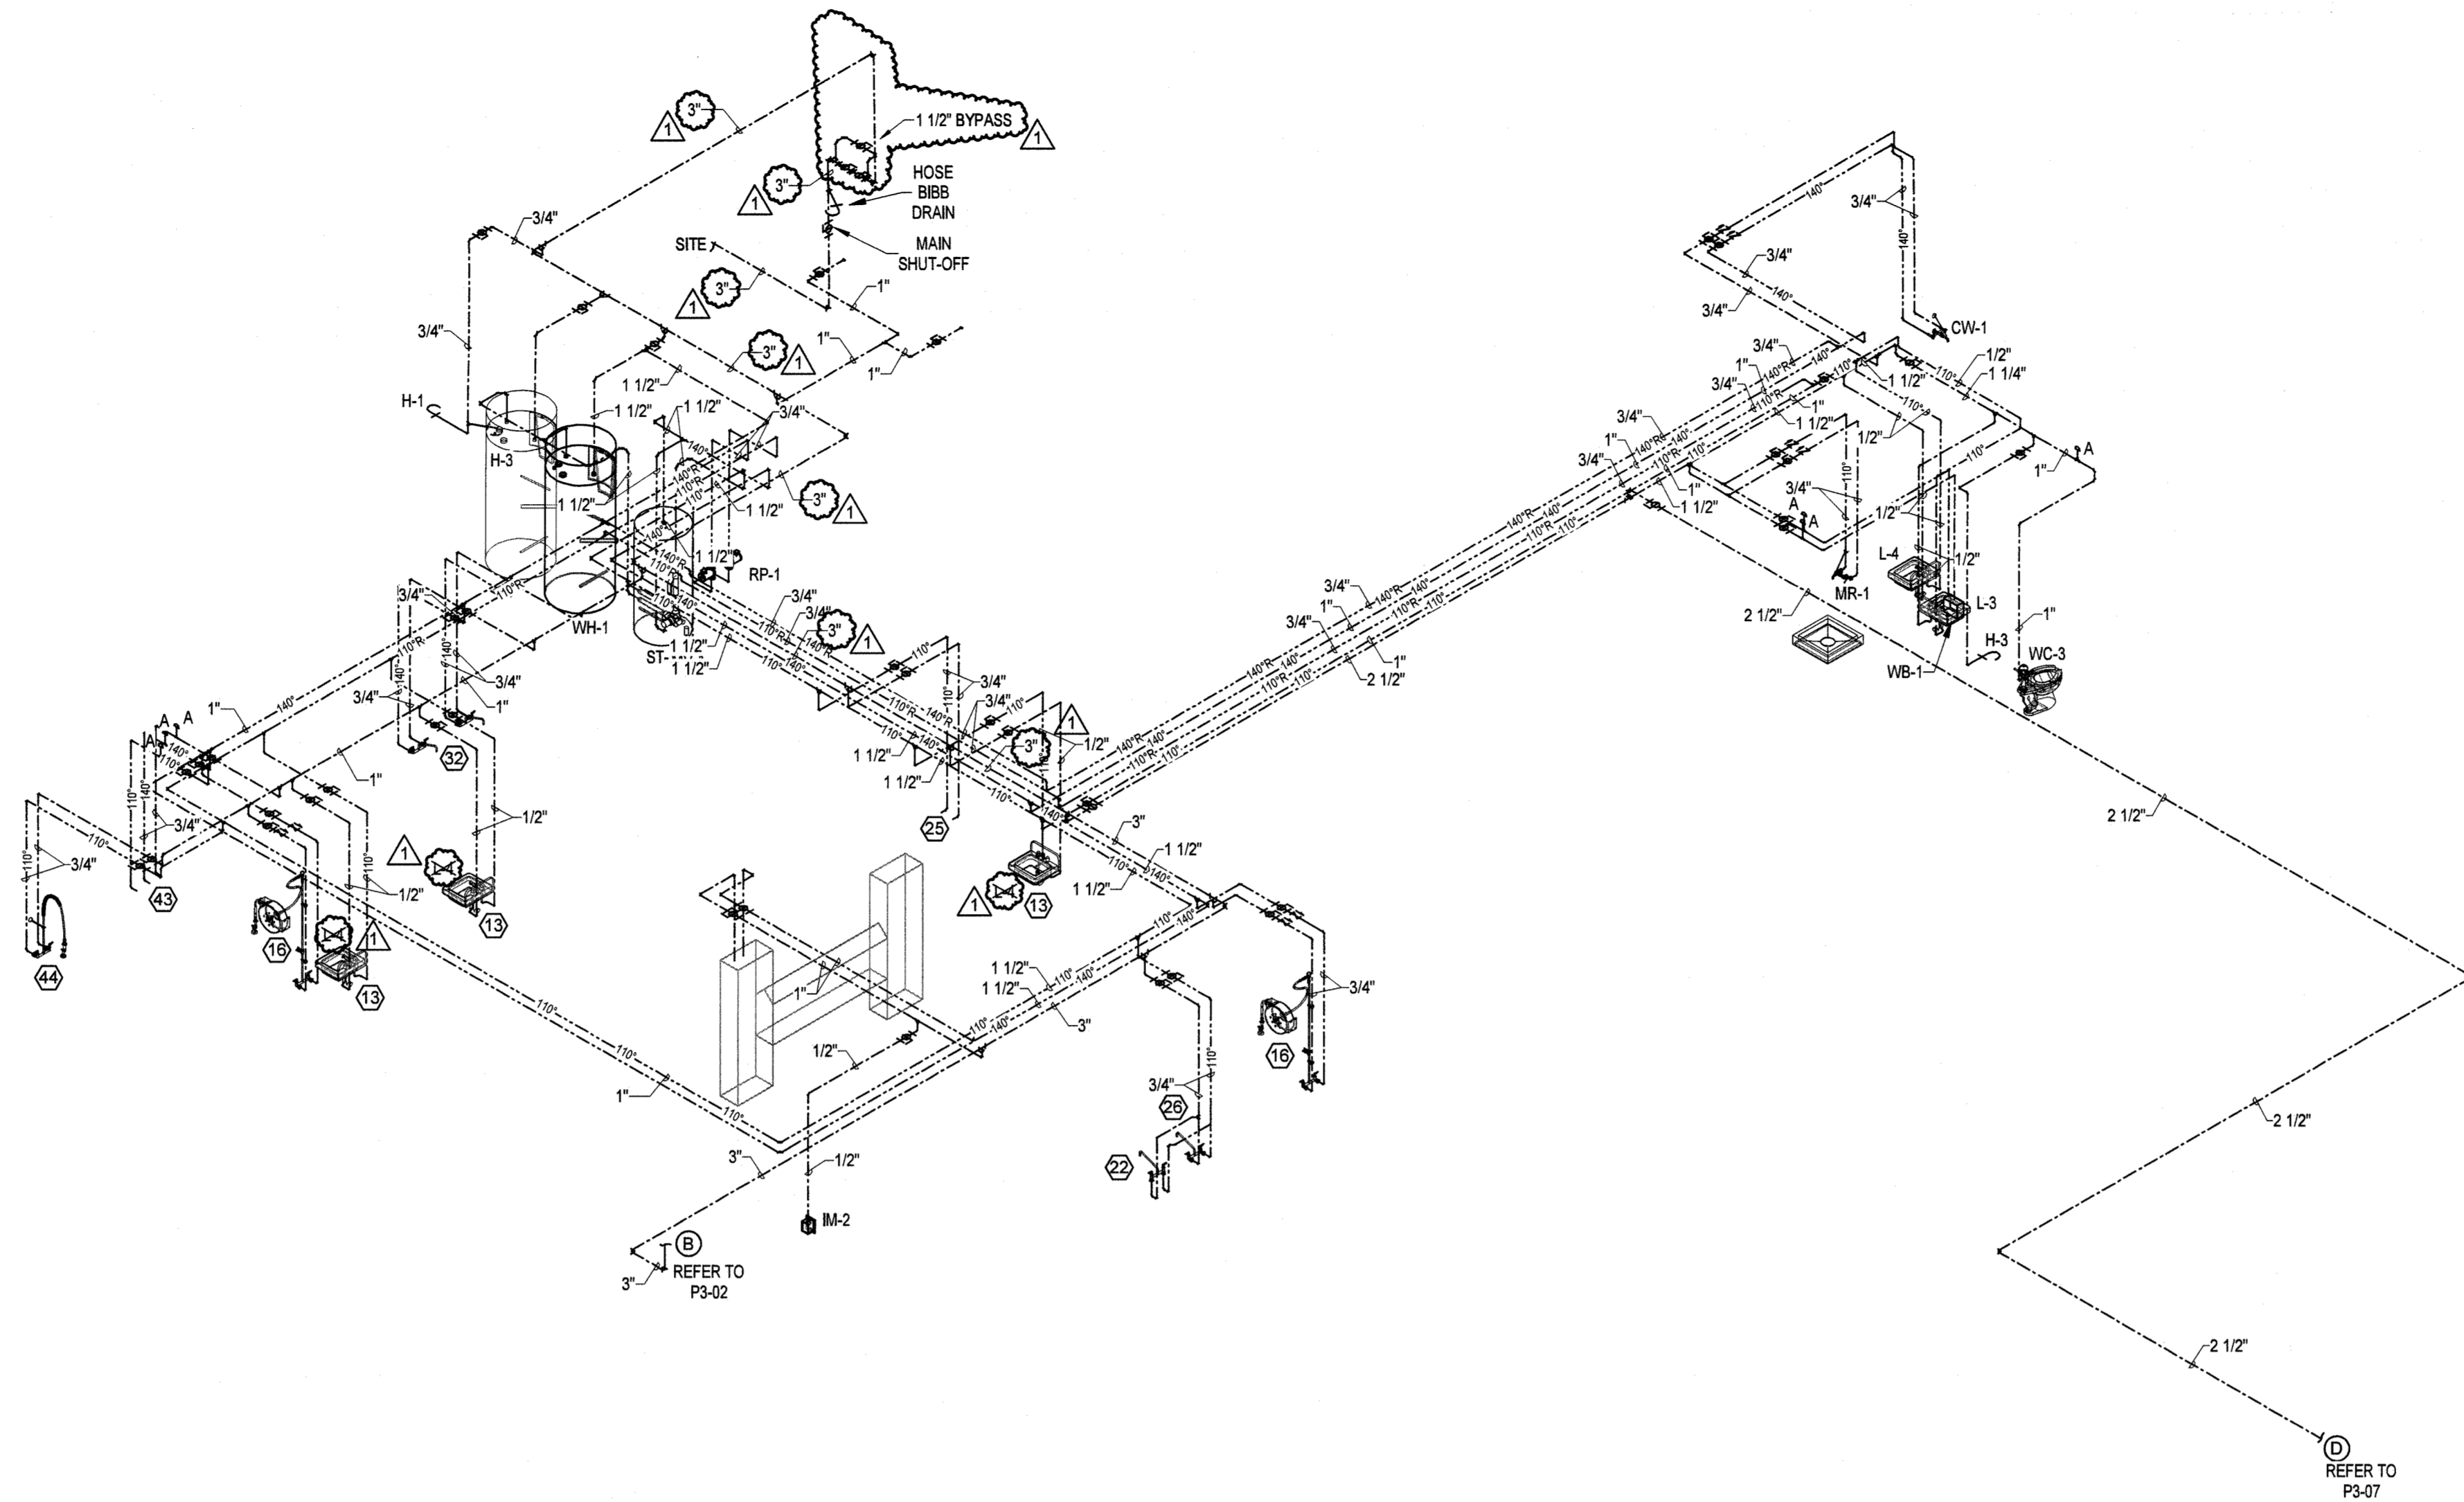


2 100B WING - HOT & COLD WATER RISER
NOT TO SCALE

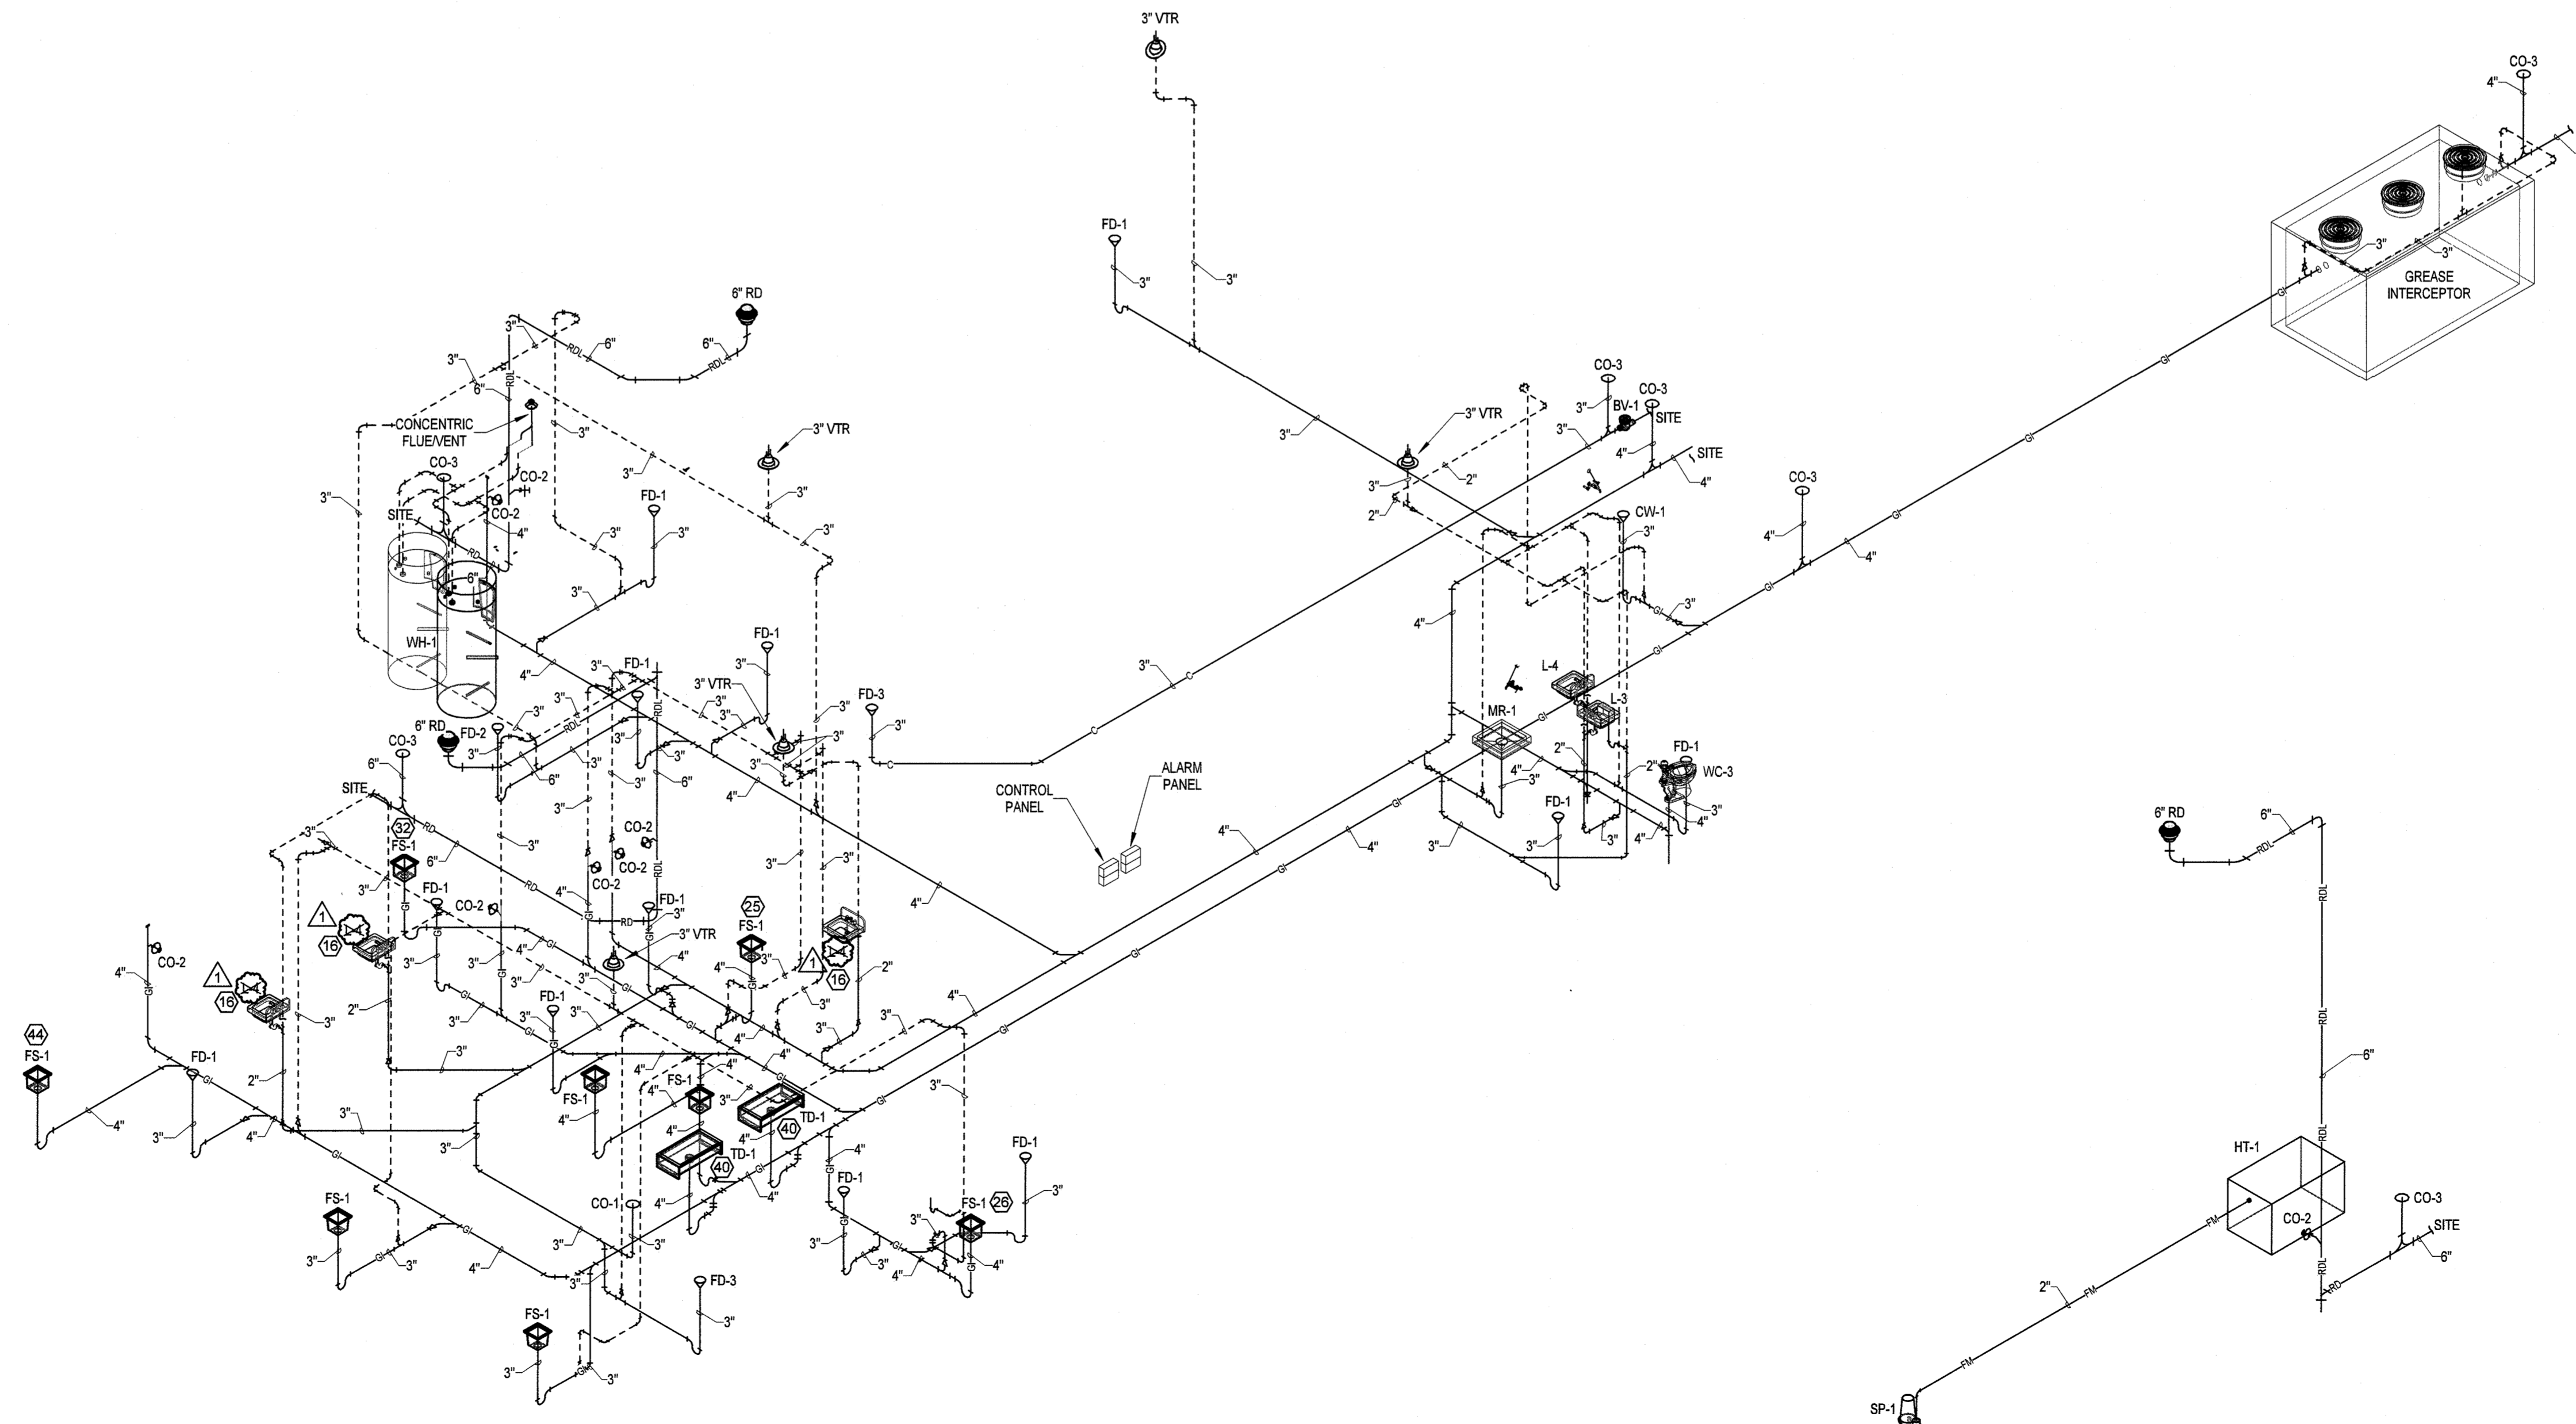

1 100B WING - WASTE & VENT, & ROOF DRAIN RISER
NOT TO SCALE

C:\Users\p3\Documents\Revit\2018\Projects\17104_Trinity MS\17104_TRINITY MS_MBP_Local.rvt 5/14/2019 8:52:32 AM

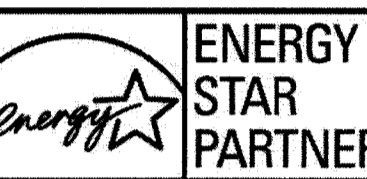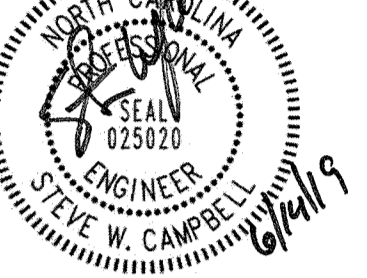


VOLUME II

This drawing and the design shown is the property of Smith Sinnett Architecture, Inc. and shall not be used for any other project without the written consent of the Architect. No part of this drawing shall be reproduced, stored in a retrieval system, or transmitted in any form or by any means, electronic, mechanical, photocopying, recording, or by any information storage and retrieval system, without the prior written permission of the Architect. All rights reserved. Smith Sinnett Architecture, P.A. 2019

THIS DRAWING IS FORMATTED TO BE PRINTED ON A 36" X 48" SHEET

NEW TRINITY MIDDLE SCHOOL
RANDOLPH COUNTY SCHOOL SYSTEM
Parcel PIN 7708118367
Surrett Drive
Trinity, NC 27370

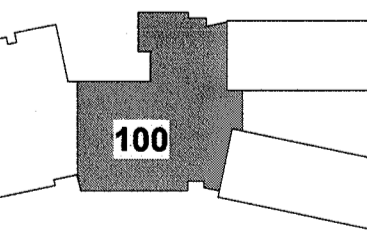

KEY PLAN
NO SCALE


ID	DATE	DESCRIPTION
1	06/14/19	ADDENDUM 03

DRAWN BY: Author

CHECKED BY: RA

100B WING -
WASTE, VENT,
ROOF DRAIN, HOT
& COLD WTR.

RAISERS 20 MAY 2019

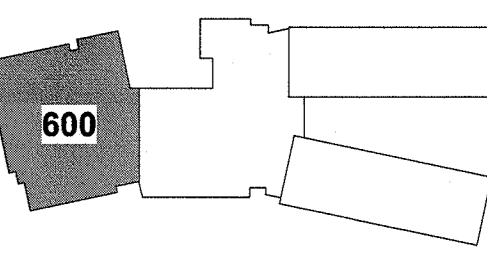


KEY PLAN
NO SCALE

ID	DATE	DESCRIPTION
1	06/14/19	ADDENDUM 03

DRAWN BY: Author
CHECKED BY: RA

600 WING - HOT & COLD WATER RISER

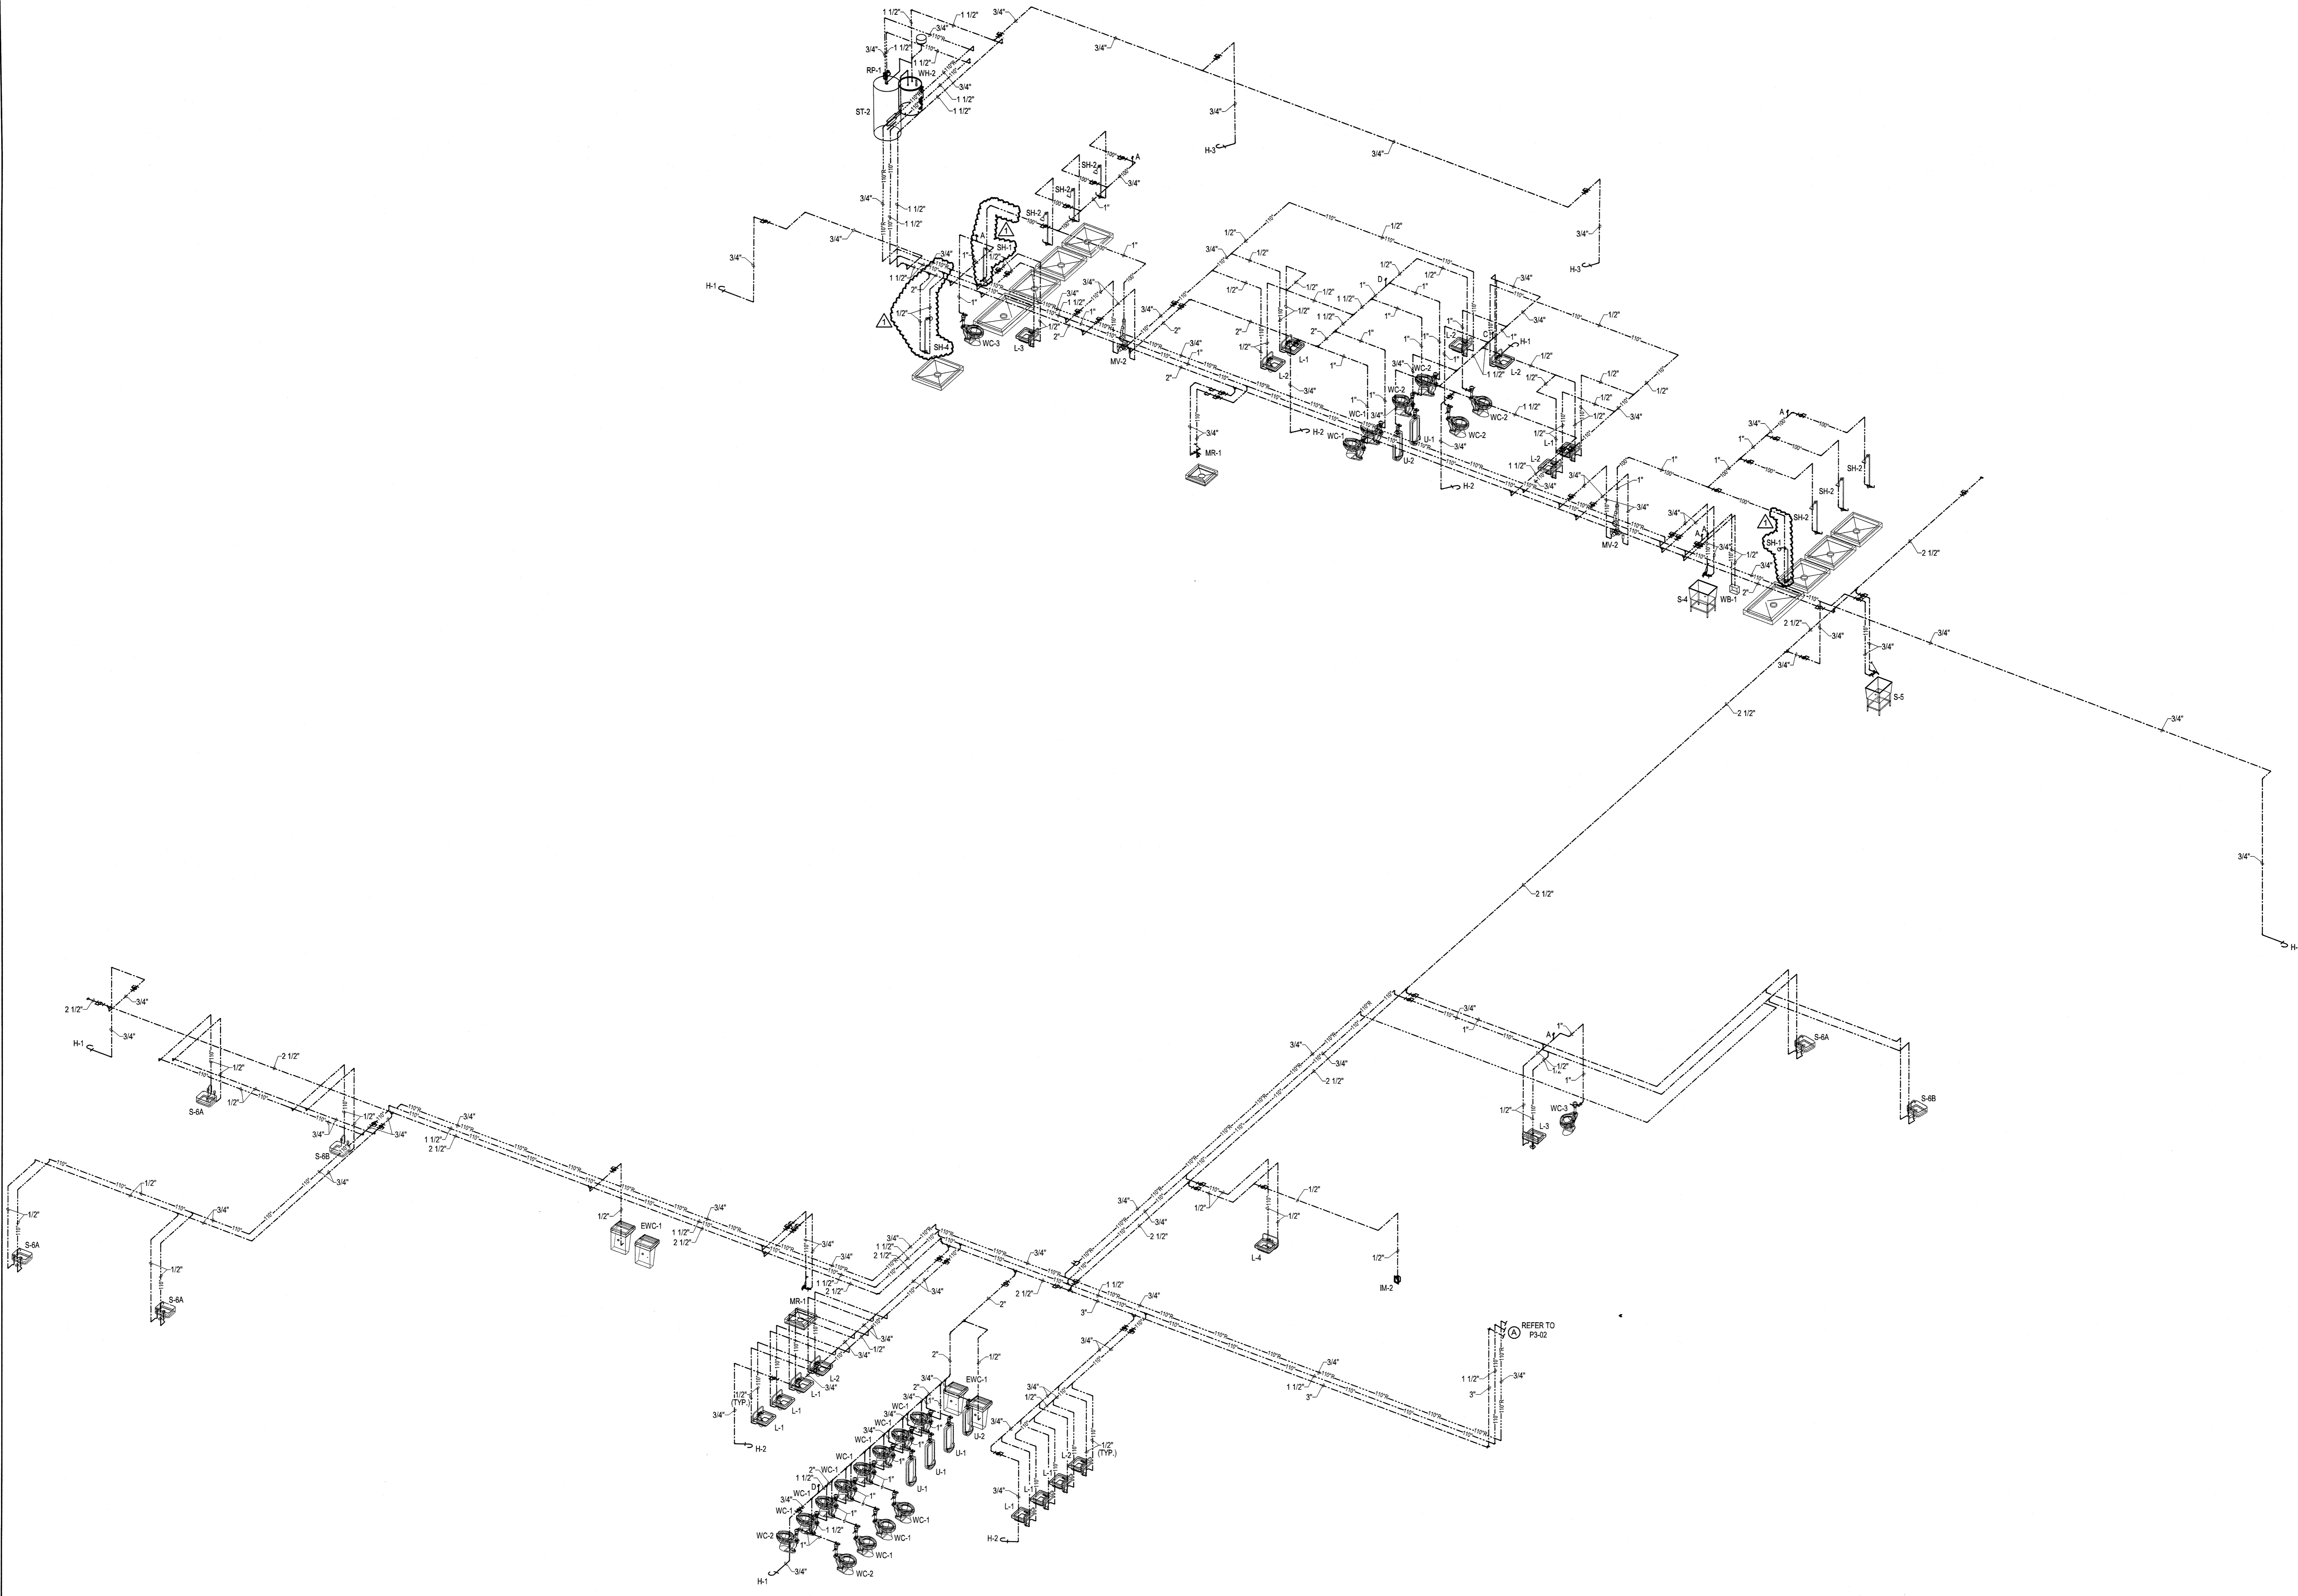

1 600 WING - HOT & COLD WATER RISER
NOT TO SCALE

C:\Users\jch\Documents\17104_TRINITY\M3_PDC_Central_chrisliao.rvt
6/20/2019 11:57:38 AM



Progressive Design Collaborative, Ltd

3101 Poplarwood Court, Suite 320


Raleigh, North Carolina 27604

919-790-9989

ADDENDUM 03 – MECHANICAL

DATE: June 13, 2019

PROJECT: Trinity Middle School
PDC Project # 17104

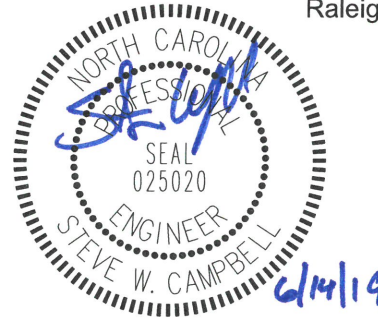

This Addendum, applicable to the work designed below, shall be understood to be and is a change to the bid documents and shall be part of and included in the contract for the above referenced project. All General, Supplementary and Special Conditions, etc., as originally specified or as modified below shall apply to these items.

Changes to Mechanical Drawings:

Drawing M0-01

- Revised language in chiller schedule regarding sound requirements.

Drawing M6-05

- Added hood integration points list

Changes to Mechanical Specifications:

Section 23 09 23

- 1.01(B)(1) – Revised specification to require any approved bidder who does not have an existing server established with Randolph County to provide a Niagara 4 server as part of the work.
- 1.03(B)(7) – Added Trane as acceptable manufacturer.
- 1.04(A)(6) – Revised language to include office with 125 miles of project site.
- 2.02 – Section added to provide requirements if vendor is providing a new server.
- 2.03 – Section added to provide requirements if vendor is providing a new server.
- 2.04 – Section added to provide requirements if vendor is providing a new server.
- Subsequent Sections have been renumbered accordingly.
- Added Veris as an acceptable humidity sensor manufacturer.

Section 23 52 23

- 2.01(C) – Weil McLain and Webster burners as preferred alternate
- 2.01(D) and (E) – Added Burnham and Peerless as acceptable manufacturers

Section 23 05 70

- 3.01 (F) – Added reference to Fire Protection Contractor

Section 23 09 33

- 2.01(H) – Added SquareD as an acceptable manufacturer
- 2.10(C) – Revised language to allow either fused disconnect or circuit breaker
- 2.07(A)(1) – Added BACnet MS/TP as acceptable protocol

END OF ADDENDUM 03 – MECHANICAL

Attachments: Drawings (M0-01) Specifications (23 05 70, 23 09 23, 23 09 33, 23 52 23)



pdcengineers.com

SECTION 23 05 70
MECHANICAL COORDINATION DRAWINGS

PART 1 GENERAL

1.01 SECTION INCLUDES

- A. The Mechanical Contractor shall be responsible for providing 1/4 scale coordination drawings for the entire project.
- B. The drawings shall cover above ceiling space, mechanical rooms, electrical rooms and service yards.

PART 2 PRODUCTS - NOT USED

PART 3 EXECUTION

3.01 COORDINATION

- A. The Mechanical Contractor shall obtain the architectural, structural, and MEP REVIT models from the Architect. The models will be in REVIT 2018.
- B. The Mechanical Contractor shall produce drawings that indicate all piping, equipment and ductwork on 1/4 scale drawings. All items shall be drawn to scale, dimensioned and be easily identified. Actual equipment dimensions from the submittals shall be used. The drawings shall indicate a bottom of duct or bottom of pipe. All manufacturers' recommended clearances and code required clearances shall be clearly indicated.
- C. The Mechanical Contractor shall import a 3D file compatible with Navisworks from the Plumbing Contractor that indicates all piping, fixtures, and plumbing equipment. This includes underground piping. The drawings shall be to scale, dimensioned, and clearly identified. The drawings shall indicate bottom of pipe (or centerline) for all equipment or pipes.
- D. The Mechanical Contractor shall import a 3D file compatible with Navisworks from the Fire Protection Contractor that indicates all piping, heads, and equipment. The drawings shall be to scale, dimensioned and clearly identified. The drawings shall indicate bottom of pipe (or centerline) for all equipment or pipes.
- E. The Mechanical Contractor shall import a 3D file compatible with Navisworks from the Electrical Contractor that indicate all conduits over 2", lights, cable tray, underground duct banks and electrical equipment. The drawings shall be to scale, dimensioned and clearly identified. The drawings shall indicate mounting heights of all equipment.
- F. The Mechanical Contractor shall incorporate the Plumbing Contractor's, **Fire Protection Contractor's**, and the Electrical Contractor's model and drawings with his own model to produce one overall set of coordination drawings for each area. The Mechanical Contractor shall adjust layers, colors, etc., to make the drawing readable. (**Addendum 03**)
- G. Navisworks shall be used for clash detection. The Mechanical Contractor shall review the overall coordination model for conflicts. If a conflict is found, the Mechanical Contractor shall coordinate revisions to the model and drawings with each sub contractor. There shall be as many iterations as required to produce a clash-free model
- H. If any problems cannot be worked out between the Contractors, the Mechanical Contractor shall contact the Engineer. At that time, a meeting with the Engineer and the Architect will be arranged. The Mechanical Contractor shall make the overall coordination model available for the meeting.
- I. Once all conflicts have been resolved, the Mechanical Contractor shall provide the Architect and Engineer with a complete set of Coordination Drawings.
- J. In addition, the Mechanical Contractor shall send the completed overall coordination drawings to a printer so that the Plumbing, Fire Protection, and Electrical Contractors can order as many copies as they desire (at their expense). The Mechanical Contractor is responsible for providing the Engineer's set, the Architect's set, and the Mechanical Contractor's set(s).

- K. The Mechanical Contractor and the General Contractor/Construction Manager are responsible for setting the schedule for this process. The Plumbing Contractor, Fire Protection Contractor, Electrical Contractor and the Architect should approve the schedule.
- L. The Coordination Drawings shall be used as the basis for the As-built Drawings. These shall be made available to the Design Team for this purpose.
- M. The overall coordination drawings shall be completed prior to any plumbing, mechanical and electrical work beginning. Start of work, including underground work, without completed Coordination Drawings is at the Contractor's risk.

END OF SECTION 23 05 70

SECTION 23 09 23
DIRECT DIGITAL CONTROL SYSTEM FOR HVAC

PART 1: GENERAL

1.01 WORK INCLUDED

- A. Furnish a totally native BACnet-based system. All building controllers, application controllers, and all input/output devices shall communicate using the protocols and network standards as defined by ANSI/ASHRAE Standard 135-2008, BACnet. In other words, all workstations and controllers, including unitary controllers, shall be native BACnet devices. No gateways shall be used for communication to controllers installed under this section. Gateways may be used for communication to systems installed under other sections.
- B. This system shall be directly interfaced with ~~the~~ **an** existing Randolph County ~~Alert~~ BACnet Server and shall be incorporated seamlessly into the existing graphics package and shall match all **existing** graphics standards. All building automation functions for the installed system shall be integrated into the existing Server. This includes the ability to view, schedule, trend, and alarm all control points through the existing software.
 - 1. ***If approved bidder does not currently maintain an existing BAS Server for Randolph county, a new Niagara 4 BAS Server with the latest software vesion shall be provided. New BAS Server shall at a minimum be certified as a BACnet Advanced Operator Workstation (B-AWS) per standards of BACnet Testing Laboratories. New controls shall be incorporated seamlessly into the new or existing graphics package and shall match all graphics standards for Randolph County. All building automation functions for the installed system shall be integrated into the new Server. This includes the ability to view, schedule, trend, and alarm all control points through the new or existing software. (Addendum 03)***
 - 2. ***If an existing Randolph County schools server is being connected to by the Controls vendor, all software shall be upgraded to the latest stable version. (Addendum 03)***
- C. The Controls Contractor shall include any software, expansion, and licensing upgrades necessary to accommodate the scope of work for this project.
- D. Provide all necessary BACnet-compliant hardware and software to meet the system's functional specifications. Provide Protocol Implementation Conformance Statement (PICS) for Windows-based control software and every controller in system, including unitary controllers.
- E. Prepare individual hardware layouts, interconnection drawings, and software configuration from project design data.
- F. Implement the detailed design for all analog and binary objects, system databases, graphic displays, logs, and management reports based on control descriptions, logic drawings, configuration data, and bid documents.
- G. Design, provide, and install all equipment cabinets, panels, data communication network cables needed, and all associated hardware.
- H. Provide and install all interconnecting cables between supplied cabinets, application controllers, and input/output devices.
- I. Provide and install all interconnecting cables between all operator's terminals and peripheral devices (such as printers, etc.) supplied under this section.
- J. Provide complete manufacturer's specifications for all items that are supplied. Include vendor name of every item supplied.
- K. Provide supervisory specialists and technicians at the job site to assist in all phases of system installation, startup, and commissioning.
- L. Provide a comprehensive operator and technician training program as described herein.

- M. Provide as-built documentation, operator's terminal software, diagrams, and all other associated project operational documentation (such as technical manuals) on approved media, the sum total of which accurately represents the final system.
- N. Provide new sensors, dampers, valves, and install only new electronic actuators. No existing or previously used components shall be installed as any part or piece of the system.

1.02 SYSTEM DESCRIPTION

- A. A distributed logic control system complete with all software and hardware functions shall be provided and installed. System shall be completely based on ANSI/ASHRAE Standard 135-2008. This system is to control all mechanical equipment, including all unitary equipment such as VAV boxes, etc., and all air handlers, boilers, chillers, and any other listed equipment using native BACnet-compliant components. Non-BACnet-compliant or proprietary equipment or systems (including gateways) shall not be acceptable and are specifically prohibited.
- B. Operator's workstation software (EXISTING) shall use Windows 10 as the computer operating system. The Energy Management and Control System (EMCS) application program shall be written to communicate specifically utilizing BACnet protocols. Software functions delivered on this project shall include password protection, scheduling (including optimum start), alarming, logging of historical data, full graphics including animation, after-hours billing program, demand limiting, and a full suite of field engineering tools including graphical programming and applications. Systems using operating systems other than that described above are strictly prohibited. All software required to program application specific controllers and all field level devices and controllers will be left with the owner. All software passwords required to program and make future changes to the system will also become the property of the owner. All software required to make any program changes anywhere in the system, along with scheduling and trending applications, will be left with the owner. All software passwords required to program and make future changes to schedules, trends and related program changes will also become the property of the owner. All software required for all field engineering tools including graphical programming and applications will be left with the owner. All software passwords required to program and make future changes to field engineering tools, including graphical programming and applications will be left with the owner.
- C. Building controllers shall include complete energy management software, including scheduling building control strategies with optimum start and logging routines. All energy management software and firmware shall be resident in field hardware and shall not be dependent on the operator's terminal. Operator's terminal software is to be used for access to field-based energy management functions only. Provide zone-by-zone direct digital logic control of space temperature, scheduling, runtime accumulation, equipment alarm reporting, and override timers for after-hours usage.
- D. Room sensors shall be provided with digital readout that allows the user to view room temperature, view outside air temperature, adjust the room setpoint within preset limits and set desired override time. User shall also be able to start and stop unit from the digital sensor. Include all necessary wiring and firmware such that room sensor includes field service mode. Field service mode shall allow a technician to balance VAV zones and access any parameter in zone controller directly from the room sensor. Field service mode shall have the ability to be locked out.
- E. All application controllers for every terminal unit (VAV, HP, UV, etc.) air handler, all central plant equipment, and any other piece of controlled equipment shall be fully programmable. Application controllers shall be mounted next to controlled equipment and communicate with building controller through BACnet LAN.

1.03 APPROVED MANUFACTURERS

- A. The basis of design shall be the Compass system from Alerton. The Owner's existing server is an Alerton BACnet Server.
- B. Approved Control Manufacturers
 - 1. Alerton (Preferred Alternate)

2. Johnson
3. Automated Logic
4. Honeywell
5. Schneider
6. Siemens
7. **Trane (Addendum 03)**

1.04 QUALITY ASSURANCE

- A. The Building Automation System (BAS) system shall be designed, installed, commissioned, and serviced by manufacturer authorized and trained personnel. System provider shall have an in-place support facility within 2 hours response time of the site with technical staff, spare parts inventory, and necessary test and diagnostic equipment.
1. The contractor shall provide full-time, on-site, experienced project manager for this work, responsible for direct supervision of the design, installation, start-up and commissioning of the BAS system.
 2. The Bidder shall be regularly engaged in the design, installation and maintenance of BAS systems and shall have demonstrated technical expertise and experience in the design, installation and maintenance of BAS systems similar in size and complexity to this project.
 3. Materials and equipment shall be manufacturer's latest standard design that complies with the specification requirements.
 4. All BAS peer-to-peer network controllers, central system controllers and local user displays shall be UL Listed under Standard UL 916, category PAZX.
 5. All electronic equipment shall conform to the requirements of FCC Regulation, Part 15, Governing Radio Frequency Electromagnetic Interference and be so labeled.
 6. Control system shall be engineered, programmed and supported completely by representative's local office that must be within **125** miles of project site. **(Addendum 03)**

1.05 REFERENCE STANDARDS

- A. The latest edition of the following standards and codes in effect and amended as of supplier's proposal date, and any applicable subsections thereof, shall govern design and selection of equipment and material supplied:
1. American Society of Heating, Refrigerating and Air Conditioning Engineers (ASHRAE).
 2. ANSI/ASHRAE Standard 135-2008, BACnet.
 3. Uniform Building Code (UBC), including local amendments.
 4. UL 916 Underwriters Laboratories Standard for Energy Management Equipment. Canada and the US.
 5. National Electrical Code (NEC).
 6. FCC Part 15, Subpart J, Class A.
 7. EMC Directive 89/336/EEC (European CE Mark).
 8. UL-864 UUKL listing for Smoke Controls for any equipment used in smoke control sequences.
 9. City, county, state, and federal regulations and codes in effect as of contract date.
 10. Except as otherwise indicated, the system supplier shall secure and pay for all permits, inspections, and certifications required for his work, and arrange for necessary approvals by the governing authorities.

1.06 SUBMITTALS

- A. Drawings
1. The system supplier shall submit engineered drawings, control sequence, and bill of materials for approval.
 2. Drawings shall be submitted in the following standard sizes: 8" x 11 1/2" (ANSI B) or 11" x 17".
 3. Eight complete sets (copies) of submittal drawings shall be provided.
 4. System Documentation
 - a. Include the following in submittal package:
 - b. System configuration diagrams in simplified block format.

- c. All input/output object listings and an alarm point summary listing.
 - d. Electrical drawings that show all system internal and external connection points, terminal block layouts, and terminal identification.
 - e. Complete bill of materials, valve schedule and damper schedule.
 - f. Manufacturer's instructions and drawings for installation, maintenance, and operation of all purchased items.
 - g. Overall system operation and maintenance instructions-including preventive maintenance and troubleshooting instructions.
 - h. For all system elements-operator's workstation(s), building controller(s), application controllers, routers, and repeaters-provide BACnet Protocol Implementation Conformance Statements (PICS) as per ANSI/ASHRAE Standard 135-2001.
 - i. Provide complete description and documentation of any proprietary (non-BACnet) services and/or objects used in the system.
 - j. A list of all functions available and a sample of function block programming that shall be part of delivered system.
5. Project Management
- a. The vendor shall provide a detailed project design and installation schedule with time markings and details for hardware items and software development phases. Schedule shall show all the target dates for transmission of project information and documents, and shall indicate timing and dates for system installation, debugging, and commissioning.

1.07 WARRANTY

- A. Warranty shall cover all costs for parts, labor, associated travel, and expenses for a period of one year from completion of system acceptance.
- B. Hardware and software personnel supporting this warranty agreement shall provide on-site or off-site service in a timely manner after failure notification to the vendor. The maximum acceptable response time to provide this service at the site shall be 24 hours, Monday through Friday and 48 hours on Saturday and Sunday.
- C. This warranty shall apply equally to both hardware and software.

1.08 RELATED WORK IN OTHER SECTIONS

- A. Refer to Division 0 and Division 1 for related contractual requirements.
- B. Refer to Section 23 01 00 for General Mechanical Provisions.

PART 2: PRODUCTS

2.01 ADVANCED WORKSTATION (AWS) - EXISTING

- A. General structure of workstation interaction shall be a standard client/server relationship with web server embedded in the server for browser only access. Server shall be used to archive data and store system database. The AWS shall support operation in a virtualized server environment. Thick and web clients shall access server for all archived data.
 1. A single server license shall:
 - a. Allow a minimum of 50 thick client seats/installations.
 - b. Allow a minimum of 200 web client users.
 - c. Not restrict system size based on point count (BACnet or Integration).
 2. Data Displays
 - a. Data displays shall render all data associated with project as called out on drawings and/or object type list supplied. Graphic files shall be created using digital, full color photographs of system installation, AutoCAD or Visio drawing files of field installation drawings, and wiring diagrams from as-built drawings.
 - b. Data displays shall render data using iconic graphic representations of all mechanical equipment. System shall be capable of displaying graphic file, text, trendlog, and dynamic object data together on each display and shall include animation. Information shall be labeled with descriptors and shall be shown with the appropriate engineering

- units. All information on any display shall be dynamically updated without any action by the user.
- c. Data display frame shall allow user to change all field-resident AWS functions associated with the project, such as setpoints, weekly schedules, exception schedules, etc., from any screen, no matter if that screen shows all text or a complete graphic display. This shall be done without any reference to object addresses or other numeric/mnemonic indications.
 - d. Analog objects shall be displayed with operator modifiable units. Analog input objects may also be displayed as individual graphic items on the display screen as an overlay to the system graphic.
 - e. All displays and programming shall be generated and customized by the local use energy management and control system (EMCS) supplier and installer. Systems requiring factory development of graphics or programming of DDC logic are specifically prohibited.
 - f. AWS shall be supplied with a library of standard graphics, which may be used unaltered or modified by the operator. AWS shall include a library of equipment graphic components to assemble custom graphics. Systems that do not allow customization or creation of new graphic objects by the operator (or with third-party software) shall not be allowed.
 - g. A navigation tree for building, equipment and system diagnostic centric display organization shall be available from data display view. The tree navigation contents shall be customizable on a per-user and per-group basis.
 - h. Each display may be protected from viewing unless operator credentials have the appropriate access level. An access level may be assigned to each display and system object. The menu label shall not appear on the graphic if the operator does not have the appropriate security level.
 - i. Data displays shall have the ability to link to content outside of the EMCS system. Such content shall include, but is not limited to launching external files in their native applications (for example, a Microsoft Word document).
 - j. A single system software license can support a minimum of 200 user accounts and web access.
 - k. Data displays shall support:
 - 1) Graphic items with custom geometry that offer both color gradient shading and variable opacity in scale to system variables, both analog and digital, and color range settings. For example, rooms on a floor plan graphic can be made to indicate the space temperature by varying the color of that room.
 - 2) Clear and custom geometry navigation buttons to provide intuitive navigation to system display or external URLs.
 - 3) Graphic files in JPG, PNG, and GIF file types.
 - 4) Viewing of up to 1,024 system data points (Analog, Binary, and/or Multi-state) in a single screen.
 - 5) Customizable mouse-over tooltip information of graphic items or data points can be displayed. The tooltips can be turned on and off. The default setting is off.
 - 6) Right click capability to directly access system functionality, such as Schedule, Trendlogs, and Alarms associated with a display object selected.
 - 7) Automatic zooming to the screen size detected to maximize the size of the display to match screen display area available. The zoom capability can be enabled or disabled, default is enabled. The background color, if solid, will be used to flood fill the remaining screen background.
 - 8) Supports user configurable embedded Data Viewer for a persistent trend log data view to accompany system data and graphic information on a single display.
3. Password Protection

- a. Provide security system that prevents unauthorized use unless operator is logged on. Access shall be limited to operator's assigned functions when user is logged on. This includes displays as outlined above.
 - b. AWS shall provide security for a minimum of 200 users. Each user shall have an individual User ID, User Name, and Password. Entries are alphanumeric characters only and are case sensitive (except for User ID). User ID, User Name, and Password shall be shall support a minimum of 40 characters. All user information and passwords shall be stored in an encrypted form.
 - c. Each user shall be allowed individual assignment of only those control functions, menu items, navigation tree, and user-specific system start display, as well as restricted access to discrete BACnet devices to which that user requires access.
 - d. All passwords, user names, and access assignments shall be adjustable via Server and Thick client. Password shall be adjustable via the web client.
 - e. Users shall also have a set access level, which defines access to displays and individual objects the user may control. System shall include 10 separate and distinct access levels for assignment to users.
 - f. The AWS and Thick Client shall include an Auto Logout feature that shall automatically logout user when there has been no keyboard or mouse activity for a set period of time. Time period shall be adjustable by system administrator. Auto Logout may be enabled and disabled by system administrator. Operator terminal shall display message on screen that user is logged out after Auto Logout occurs.
 - g. The system shall permit the assignment of an effective date range, as well as an effective time of day, that the User IDs are permitted to authenticate.
4. Operator Activity Log
- a. An Operator Activity Log that tracks all operator changes and activities shall be included with AWS. System shall track what is changed in the system, who performed this change, date and time of system activity, and value of the change before and after operator activity. Operator shall be able to display all activity, sort the changes by user and also by operation. Operator shall be able to print the Operator Activity Log display.
 - b. Log shall be gathered and archived to a hard drive on AWS as needed. Operator shall be able to export data for display and sorting in a spreadsheet.
 - c. System shall have the option to require user comment recording in the Operator Activity Log upon any system point change.
 - d. Operator Activity log shall be accessible via the Web Client for viewing, sorting, filtering, and Printing.
5. Scheduling
- a. AWS, Thick Client and Web Client shall show all information in easy-to-read daily format including calendar of this month and next. All schedules shall show actual ON/OFF times for day based on scheduling priority. Priority for scheduling shall be events, holidays and daily, with events being the highest.
 - b. Holiday and special event schedules shall display data in calendar format. Operator shall be able to schedule holidays and special events directly from these calendars.
 - c. Operator shall be able to change all information for a given weekly or exception schedule if logged on with the appropriate access privileges.
 - d. AWS and Thick Client shall include a Schedule Wizard for set up of schedules. Wizard shall walk user through all steps necessary for schedule generation. Wizard shall have its own pull-down selection for startup or may be started by right-clicking on value displayed on graphic and then selecting Schedule.
 - e. Scheduling shall include optimum start based on outside air temperature, current heating/cooling setpoints, indoor temperature and history of previous starts. Each and every individual zone shall have optimum start time independently calculated based on all parameters listed. User shall input schedules to set time that occupied setpoint is to be attained. Optimum start feature shall calculate the startup time needed to

- match zone temperature to setpoint. User shall be able to set a limit for the maximum startup time allowed.
- f. Schedule list shall show all schedules currently defined. This list shall include all standard, holiday and event schedules. In addition, user shall be able to select a list that shows all scheduled points and zones.
 - g. Any displayed data that is changeable by the operator may be selected using the right mouse button and the schedule shall then be selectable on the screen. Selection of the schedule using this method shall allow the viewing of the assigned schedule allow the point to be scheduled.
 - h. Schedule editor shall support drag-n-drop events and holidays onto the schedule calendar.
 - i. Schedule editor shall support drag-n-drop events default to a two-hour period, which can then be adjusted by the user.
 - j. Schedule editor shall support drag-n-drop holidays default for OFF all day and can be edited for multiple-day holidays.
 - k. Schedule editor shall support the view of affected zones when adding or editing timed events of a schedule.
 - l. The web client shall have the ability to search a list of all scheduled points and zones to access the schedule calendar.
 - m. Schedule time blocks shall present schedule detail via mouse-over information.
6. Alarm Indication and Handling
- a. AWS shall provide visual, printed, and email means of alarm indication. Printout of alarms shall be sent to the assigned terminal and port. Alarm notification can be filtered based on the User ID's authorization level.
 - b. Web client shall display a persistent alarm state for the system regardless of the data view including points in alarm but not acknowledged, and points that have gone into alarm and returned to normal without being acknowledged.
 - c. Alarm History shall provide log of alarm messages. Alarm log shall be archived to the hard disk of the AWS. Each entry shall include a description of the event-initiating object generating the alarm. Description shall be an alarm message of at least 256 characters in length. Entry shall include time and date of alarm occurrence, time and date of object state return to normal, time and date of alarm acknowledgment, and identification of operator acknowledging alarm.
 - d. Alarm messages shall be in user-definable text (English or other specified language) and shall be delivered either to the operator's terminal, client or through remote communication using email (Authenticated SMTP supported).
 - e. AWS, Thick Client, and Web Client shall allow for set up of alarms. UI shall walk user through all steps necessary for alarm generation. Alarm creation may be started by right-clicking on value displayed on graphic and then selecting Alarm setup.
 - f. Web client shall support color-coded indication of current alarms as follows:
 - 1) Red indicator shows number of active alarms that have not been acknowledged.
 - 2) Yellow indicator shows number of alarms that are still active but have been acknowledged.
 - 3) Blue indicator shows number of alarms that have returned to normal but have not been acknowledged.
 - 4) Color-coded indicators, when selected by the user, navigate to a pre-filtered view of alarm history.
 - 5) Alarm history can be filtered by color-coded indicator states.
 - 6) Alarm annunciation includes navigation link to a user-selected display or URL.
 - 7) Any displayed data that is changeable by the operator may be selected using the right mouse button and the alarm shall then be selectable on the screen. Selection of the alarm using this method shall allow the viewing of the alarm history or allow the creation of a new alarm.
7. Trendlog Information

- a. AWS shall periodically gather historically recorded data stored in the building controllers and store the information in the system database. Stored records shall be appended with new sample data, allowing records to be accumulated. Systems that write over stored records shall not be allowed unless limited file size is specified. System database shall be capable of storing up to 50 million records before needing to archive data. Samples may be viewed at the web client. All trendlog records shall be displayed in standard engineering units.
 - b. AWS shall be capable of trending on an interval determined by a polling rate, or change-of-value.
 - c. AWS, Thick client, or Web Client shall be able to add and edit trendlogs and the setup information. This includes the information to be logged as well as the interval at which it is to be logged. All operations shall be password protected. Viewing may be accessed directly from any and all graphics on which a trended object is displayed.
 - d. AWS and Thick Client shall include a Trendlog Wizard for setup of multiple trend logs simultaneously. Wizard shall walk user through all necessary steps. Wizard shall have its own pull-down selection for startup, or may be started by right-clicking on value displayed on graphic, and then selecting Trendlogs from the displayed menu.
 - e. AWS shall be capable of using Microsoft SQL as the system database.
 - f. Any displayed data that is changeable by the operator may be selected using the right mouse button and the trendlog shall then be selectable from a menu on the screen. Selection of the trendlog using this method shall allow the viewing of the trendlog data in the DataViewer.
 - g. DataViewer shall provide:
 - 1) Software that is capable of graphing the trend-logged object data shall be included.
 - 2) Access and ability to create, edit and view are restricted to users by user account credentials
 - 3) Specific and repeatable URL defines the trendlog(s) views for browser bookmarking and email compatibility.
 - 4) Call out of trendlog value at intersection of trend line and mouse-over vertical axis.
 - 5) Trendlog or Energy log and companion logs can be configured to display on one of two independent vertical scales embedded in the display.
 - 6) Click zoom for control of data set viewed along either graph axis.
 - 7) User-specifiable start and end dates as well as a fast scroll features that supports click zoom of macro scale view of the data for quickly finding data set based on visual signature.
 - 8) User export of the viewed data set to MS Excel.
 - 9) Web browser-based help.
 - 10) Optional min/max ranges (Upper Control Limits, Lower Control Limits) for each value.
8. Energy Log Information
- a. AWS shall be capable of periodically gathering energy log data stored in the field equipment and archive the information. Archive files shall be appended with new data, allowing data to be accumulated. Systems that write over archived data shall not be allowed unless limited file size is specified. Display all energy log information in standard engineering units.
 - b. All data shall be stored in database file format for direct use by third-party programs. Operation of system shall stay completely online during all graphing operations.
 - c. AWS operator shall be able to change the energy log setup information as well. This includes the meters to be logged, meter pulse value, and the type of energy units to be logged. All meters monitored by the system may be logged. System shall support using flow and temperature sensors for BTU monitoring.

- d. AWS shall display data in tabular format form for both consumption and peak values. Data shall be shown in hourly, daily, weekly, monthly and yearly formats. In each format, the user shall be able to select a specific period of data to view.
 - e. Web client shall display data in tabular format and graphical format. Data shall be shown in hourly, daily, weekly, monthly and yearly formats. In each format, the user shall be able to select a specific period of data to view.
9. Demand Limiting
- a. AWS shall include demand limiting program that includes two types of load shedding. One type of load shedding shall shed/restore equipment in binary fashion based on energy usage when compared to shed and restore settings. The other type of shedding shall adjust operator-selected control setpoints in an analog fashion based on energy usage when compared to shed and restore settings. Shedding may be implemented independently on each and every zone or piece of equipment connected to system.
 - b. Binary shedding shall include minimum of five (5) priority levels of equipment shedding. All loads in a given priority level shall be shed before any loads in a higher priority level are shed. Load shedding within a given priority level shall include two methods. In one, the loads shall be shed/restored in a "first off-first on" mode, and in the other the loads are just shed/restored in a "first off-last on" (linear) fashion.
 - c. Analog shed program shall generate a ramp that is independently used by each individual zone or individual control algorithm to raise the appropriate cooling setting and lower appropriate heating setting to reduce energy usage.
 - d. AWS shall be able to display the status of each and every load shed program. Status of each load assigned to an individual shed program shall be displayed along with English description of each load.
10. Reports
- a. AWS shall be capable of periodically producing reports of trendlogs, alarm history, tenant activities, device summary, energy logs, and override points. The frequency, content, and delivery are to be user adjustable.
 - b. All reports shall be capable of being delivered in multiple formats including text- and comma-separated value (CSV) files. The files can be printed, emailed, or saved to a folder, either on the server hard drive or on any network drive location.
11. Configuration/Setup
- a. Provide means for operator to display and change system configuration. This shall include, but not be limited to system time, day of the week, date of daylight savings set forward/set back, printer termination, port addresses, modem port and speed, etc. Items shall be modified using understandable terminology with simple mouse/cursor key movements.
 - b. The building management system (BMS) shall operate the user interface in any region and support varying languages and locale settings, without the addition of special software. Localization tools shall be commonly available open sourced or purchased products, No BMS manufacturer specific software will be acceptable.
 - 1) The following localization capabilities shall be supported:
 - (a) Locale settings related to date, time and number formats
 - (b) Multiple left-to-right languages supported including Cyrillic languages
 - (c) On the fly locale change using browser language settings (multiple language and locale setting change)
 - (d) Default character encoding shall be UTF-8
 - (e) Each localized BMS element can be localized independently and operate autonomously
12. Field Engineering Tools
- a. AWS shall include field engineering tools for programming all controllers supplied. All controllers shall be programmed using graphical tools that allow the user to connect function blocks on screen that provide sequencing of all control logic. Function blocks shall be represented by graphical displays that are easily identified and distinct from

- other types of blocks. Graphical programming that uses simple rectangles and squares is not acceptable.
- b. User shall be able to select a graphical function block from menu and place on screen. Provide zoom in and zoom out capabilities. Function blocks shall be downloaded to controller without any reentry of data.
 - c. Programming tools shall include a real-time operation mode. Function blocks shall display real-time data and be animated to show status of data inputs and outputs when in real-time operation. Animation shall show change of status on logic devices and countdown of timer devices in graphical format.
 - d. Field engineering tools shall also include a database manager of applications that include logic files for controllers and associated graphics. Operator shall be able to select unit type, input/output configuration and other items that define unit to be controlled. Supply minimum of 250 applications as part of workstation software.
 - e. Field engineering tool shall include Device Manager for detection of devices connected anywhere on the BACnet network by scanning the entire network. This function shall display device instance, network identification, model number, and description of connected devices. It shall record and display software file loaded into each controller. A copy of each file shall be stored on the computer's hard drive. If needed, this file shall be downloaded to the appropriate controller using the mouse.
 - f. AWS shall automatically notify the user when a device that is not in the database is added to the network.
 - g. AWS shall include backup/restore function that will back up entire system to selected medium and then restore system from that medium. The system shall be capable of creating a backup for the purpose of instantiating a new client PC.
 - h. The system shall provide a means to scan, detect, interrogate, and edit third-party BACnet devices and BACnet objects within those devices.
13. Software
- a. At the conclusion of the project, contractor shall leave with owner a electronic copy that includes the complete software operation system and project graphics, setpoints, system parameters, etc. This backup shall allow the owner to completely restore the system in the case of a computer malfunction.
14. Web Client
- a. EMCS supplier shall provide an HTML5-based browser access to the AWS as part of standard installation. User must be able to access all displays of real-time data that are part of the AWS using a standard web browser. Web browser shall tie into the network through owner-supplied Ethernet network connection. The web client shall support a minimum of 200 users with a single license.
 - b. Browser shall be standard version of Microsoft Internet Explorer v10.0 or later, Firefox v19.0 or later, Chrome v24.0 or later, and Safari v7.1.1 or later. No special vendor-supplied software shall be needed on computers running browser. Data shall be displayed in real-time and update automatically without user interaction.
 - c. Web pages shall be automatically generated using HTML5 from the data display files that reside on the AWS. Any system that requires use of an HTML editor for generation of web pages shall not be considered.
 - d. Access through web client or thick client shall utilize the same hierarchical security scheme as the AWS. User shall be asked to log on once the client makes connection to the AWS. Once the user logs on, any and all changes that are made shall be tracked by the AWS. The user shall be able to change only those items he or she has authority to change. A user activity report shall show any and all activity of the users who have logged on to the system, regardless of whether those changes were made using a web client, thick client or through the AWS.
 - e. Shall provide User Session Management including the ability to view all connected user sessions to the web client, see how long they have been active/inactive for each unique session, and force log-out for any or all sessions.

- f. Shall provide menu-style navigation access to primary features, i.e. alarm history, DataViewer, Search scheduled points and Zones, System Activity, User Session Management, and Top Display
- g. Web client shall, at a minimum, support the following tablets:
 - 1) Android platform:
 - (a) Google Nexus
 - (b) Samsung Galaxy Note
 - 2) Apple platform
 - (a) Ipad
 - (b) Apple Ipad Mini

2.02 NIAGARA BASED SERVER (BASE BID)

- A. ***The contractor shall be responsible for the hardware and software for the enterprise framework and system integration required for the complete Building Automation System.***
- B. ***Provide a JACE 8000 controller to provide integrated control, supervision, data logging, alarming, scheduling and network management.***
- C. ***Provide license for 1000 analytic points for Embedded Controller.***
- D. ***The BAS shall be comprised of Network Control Units (NCU) connected to the Building Automation System local area network (BAS LAN).***
 - 1. ***Access to the BAS, either through a Workstation on the BAS LAN, within the building or through a Wireless Application Protocol device, or remotely through the Internet, shall be accomplished through a standard Web browser.***
 - 2. ***Each NCU shall communicate to BTL Listed BACnet controllers provided under the Programmable Controllers section.***
- E. ***The system includes software and programming of the JACE, NCU(s), Operator Workstation(s) (OWS) software and hardware, development of all graphical screens, setup of schedules, trends, logs and alarms, network management and connection of the NCU(s) to the local area network. (Addendum 03)***

2.03 SERVER REQUIREMENTS (BASE BID)

- A. ***The Server shall be a PC with minimum Intel Core i5 Quad core 3.4 GHz processor with 8 GB RAM and a 1TB SATA hard drive with 6 GB/s transfer rate. It shall include a minimum 32X CD-ROM drive and 4-USB ports. A minimum 21", HDMI, DVI-D video interfaces, minimum 1024 x 768 resolution, 4x3 Widescreen, LED color monitor with a minimum 60 Hz refresh rate shall also be included.***
- B. ***The server operating system shall be:***
 - 1. ***Windows 10 64bit***
 - 2. ***With VM support***
 - 3. ***With the most recent service packs and system updates.***
 - 4. ***Selected based on availability and project requirements.***
- C. ***Acceptable Manufacturers are:***
 - 1. ***Dell***
 - 2. ***Lenovo***
 - 3. ***HP (Hewlett Packard)***
- D. ***Connection to the BAS LAN network shall be via an Ethernet network interface card, 100 Mbps.***
- E. ***The server shall support all Network Control Units (NCU), OWSs, and 3rd party mechanical / electrical systems connected to the Facility Management Control / Building Automation System Local Area Network. (Addendum 03)***

2.04 NETWORK (BASE BID)

- A. ***The BAS network(s) must be based on Open Systems.***

- B. **Niagara N4 shall be used at the network levels as the manager(s).**
- C. **High-speed data transfer rates for alarm reporting, quick report generation from multiple controllers and upload/download efficiency between network devices.**
- D. **Support of any combination of controllers and operator workstations directly connected to the local area network. A minimum of 50 devices shall be supported on a single local area network.**
- E. **Detection and accommodation of single or multiple failures of workstations, controller panels and the network media. The network shall include provisions for automatically reconfiguring itself to allow all operational equipment to perform their designated functions as effectively as possible in the event of single or multiple failures.**
- F. **Message and alarm buffering to prevent information from being lost.**
- G. **Error detection, correction, and retransmission to guarantee data integrity.**
- H. **Default device definition to prevent loss of alarms or data, and ensure alarms are reported as quickly as possible in the event an operator device does not respond.**
- I. **Commonly available, multiple sourced, networking components shall be used to allow the system to coexist with other networking applications such as office automation. Ethernet to IEEE 802.3 standard is the only acceptable technology.**
- J. **Synchronization of the real-time clocks in all NCU panels shall be provided.**
- K. **The BAS LAN shall be a 100 Megabits/sec Ethernet network supporting BACnet, Java, XML, HTTP, SOAP, OBIX, SNMP and SMTP Protocols for maximum flexibility for integration of building data with enterprise information systems and providing support for multiple Network Control Units (NCUs), user workstations and where specified, a local server. Local area network minimum physical and media access requirements:**
 - 1. **Ethernet; IEEE standard 802.3**
 - 2. **Cable; 100 Base-T, UTP-8 wire, category 5**
 - 3. **Minimum throughput; 100 Mbps**
 - 4. **Provide access to the BAS LAN via a Wireless Application Protocol (WAP) device. Through this connection the BAS LAN will provide authorized staff with the ability to monitor and control the BAS from any location within the through a web browser, or web enabled devices.**
 - 5. **Provide access to the BAS LAN from a remote location, via the Intranet or Internet. The owner shall provide (in future) a connection to the Internet to enable access via high-speed cable modem, asynchronous digital subscriber line (ADSL) modem, ISDN line, T1 Line or access to an Internet Service Provider (ISP). If required, the owner will provide a switch/firewall between the building LAN and the BAS LAN. Through this connection the BAS LAN will provide authorized staff with the ability to monitor and control the BAS from a remote location through a web browser, or web enabled devices.**
- L. **Controller Local Area Network (BAS sub LAN)**
 - 1. **Provide a network of stand-alone, distributed direct digital controllers that operate on the following protocol using the specified physical layers:**
 - a. **The BAS sub LAN shall employ the BACnet protocol for communication between controllers. BACnet protocol implementation shall adhere to the ANSI/ASHRAE Standard 135. Communications between BACnet devices shall be 76.8 kbps over approved twisted shielded pair cabling utilizing Master/Slave Token Passing BACnet protocol. BACnet defines a comprehensive set of object types and application services for communication requirements among all levels of control in a distributed, hierarchical Building Automation System. BACnet is intended to provide a single, uniform standard for the BAS to provide the required interoperability.**

2. ***Strict adherence to industry standards including ANSI/ASHRAE Standard 135, BACnet, certified by BACnet Testing Laboratory (BTL listed) to assure interoperability between all system components. Controllers that are not BTL listed are unacceptable.***
 3. ***Provide BAS Controllers that conform to ANSI/ASHRAE Standard. 135, BACnet***
 4. ***The design of the BAS sub LAN shall network Local Control Unit (LCU) and Terminal Control Unit (TCU) to a Network Control Unit (NCU).***
 5. ***This level of communication shall support a family of application specific controllers and shall communicate bi-directionally with the network through DDC Controllers for transmission of global data.***
 6. ***Terminal Control Unit (TCU) shall be arranged on the BAS sub LAN's in a functional relationship manner with Local Control Unit (LCU). Ensure that a Variable Air Volume (VAV) Terminal Control Unit (TCU) is logically on the same LAN or segment as the Local Control Unit (LCU) that is controlling its corresponding Air Handling Unit (AHU).***
- M. ***The system shall consist of a network of Network Control Units (NCUs), interoperable Local Control Units (LCUs) and Terminal Control Units (TCUs) (VAV Box Controllers, Fan Coil Unit Controllers, etc.). All controllers for terminal units, air handling units (AHU) and controllers shall communicate and share data, utilizing BACnet communications protocols only.***
- N. ***The intent of this specification is to provide a distributed and networked open Building Automation System, the capability to integrate ANSI/ASHRAE Standard 135, BACnet and ISO/IEC 14908-1: Open Data Communication in Building Automation, Controls and Building Management – Control Network Protocol into a unified system in order to provide flexibility for expansion, maintenance, and service of the system.***
- O. ***The proposed system must maintain strict adherence to industry standards including ANSI/ASHRAE Standard 135, Annex L, and Device Profile to assure interoperability between all system components. BACnet system must be tested and listed on BACnet Testing Laboratory (BTL) web site. Systems based on vendor specific proprietary hardware or software will not be considered for this project.***
- P. ***Systems utilizing gateways to proprietary communication systems will not be considered for this project. A gateway is considered to be a device or controller where the sole function is mapping of data points from one protocol to another. A gateway device cannot perform higher-level energy management functions such as Outdoor Air Optimization, Electrical Demand Limiting and the like.***
- Q. ***The supplied system software shall employ object-oriented technology (OOT) for representation of all data and control devices within the system. In addition, adherence to industry standards including ANSI/ASHRAE™ Standard 135, BACnet to assure interoperability between all system components is required.***
- R. ***A hierarchical topology is required to assure reasonable system response times and to manage the flow and sharing of data without unduly burdening the customer's internal Intranet network. Systems employing a flat single tiered architecture shall not be acceptable. Maximum acceptable response time from any alarm occurrence (at the point of origin) to the point of annunciation shall not exceed 10 seconds for network connected user interfaces. Maximum acceptable response time from any alarm occurrence (at the point of origin) to the point of annunciation shall not exceed 60 seconds for remote or dial-up connected user interfaces.***
- S. ***User Access***
1. ***The supplied system must incorporate the ability to access all data using standard Web browsers without requiring proprietary operator interface and configuration programs.***

- T. ***An Open Database Connectivity (ODBC) or Structured Query Language (SQL) compliant server database is required for all system databases, all controller program graphics and network databases which shall be provided in a NiagaraN4 Framework format.***
 - 1. ***This data shall reside on a supplier-installed server for all database access.***
 - 2. ***Systems requiring proprietary database and user interface programs shall not be acceptable.***

- U. ***Software Tools***
 - 1. ***All software tools needed for full functional use, including programming of controllers, NiagaraN4 Framework network management and expansion, and graphical user interface use and development, of the BAS described within these specifications shall be provided to the owner or his designated agent.***
 - a. ***Any licensing required by the manufacturer now and to the completion of the warranty period, including changes to the licensee of the software tools and the addition of hardware corresponding to the licenses, to allow for a complete and operational system for both normal day to day operation and servicing shall be provided.***
 - b. ***Any such changes to the designated license holders shall be made by the manufacturer upon written request by the owner or his agent.***
 - c. ***Any cost associated with the license changes shall be identified within the BAS submittals.***

- V. ***Software License Agreement***
 - 1. ***The Owner shall sign a copy of the manufacturer's standard software and firmware licensing agreement as a condition of this contract.***
 - 2. ***Such license shall grant use of all programs and application software to Owner as defined by the manufacturer's license agreement, but shall protect manufacturer's rights to disclosure of trade secrets contained within such software.***
 - a. ***The Owner shall be the named license holder of all software associated with any and all incremental work on the project(s).***
 - b. ***In addition, the Owner shall receive ownership of all job specific configuration documentation, data files, and application-level software developed for the project.***
 - c. ***This shall include all custom, job specific software code, databases and documentation for all configuration and programming that is generated for a given project and/or configured for use with the NCU, Server, OWS and any related LAN/WAN/Intranet and Internet connected routers and devices.***
 - d. ***Any and all required User IDs and passwords for access to any component or software program shall be provided to the owner. (Addendum 03)***

2.05 BUILDING CONTROLLER

- A. ***General Requirements***
 - 1. ***BACnet Conformance***
 - a. ***Building Controller shall be approved by the BTL as meeting the BACnet Building Controller requirements.***
 - b. ***Please refer to section 22.2, BACnet Functional Groups, in the BACnet standard, for a complete list of the services that must be directly supported to provide each of the functional groups listed above. All proprietary services, if used in the system, shall be thoroughly documented and provided as part of the submittal data. All necessary tools shall be supplied for working with proprietary information.***
 - 2. ***Building controller shall be of scalable design such that the number of trunks and protocols may be selected to fit the specific requirements of a given project.***
 - 3. ***The controller shall be capable of panel-mounted on DIN rail and/or mounting screws.***
 - 4. ***The controller shall be capable of providing global control strategies for the system based on information from any objects in the system, regardless if the object is directly monitored by the building controller module or by another controller.***

5. The controller shall be capable of running up to six (6) independent control strategies simultaneously. The modification of one control strategy does not interrupt the function or runtime others.
6. The software program implementing the DDC strategies shall be completely flexible and user-definable. All software tools necessary for programming shall be provided as part of project software. Any systems utilizing factory pre-programmed global strategies that cannot be modified by field personnel on-site, using a wide area network (WAN) or downloaded through remote communications are not acceptable. Changing global strategies using firmware changes is also unacceptable.
7. Programming shall be object-oriented using control function blocks and support DDC functions. All flowcharts shall be generated and automatically downloaded to controller. Programming tool shall be supplied and be resident on workstation. The same tool shall be used for all controllers.
8. The programming tool shall provide means to graphically view inputs and outputs to each program block in real-time as program is executing. This function may be performed using the operator's workstation or field computer.
9. Controller shall have 6,000 Analog Values and 6,000 Binary Values.
10. Controller IP configuration can be done via a direct USB connect with an operator's workstation or field computer.
11. Controller shall have at a minimum a Quad Core 996Ghz processor to ensure fast processing speeds.
12. Global control algorithms and automated control functions shall execute using a 64-bit processor.
13. Controller shall have a minimum of 1 GB of DDR3 SDRAM on a 533Mhz bus to ensure high speed data recording, large data storage capacity and reliability.
14. Controller shall support two (2) on-board EIA-485 ports capable of supporting various EIA-485 protocols including, but not limited to BACnet MS/TP and Modbus.
 - a. Ports are capable of supporting various EIA-485 protocols including, but not limited to BACnet MS/TP and Modbus.
15. Controller shall support two (2) ports-each of gigabit speed-Ethernet (10/100/1000) ports.
 - a. Ports are capable of supporting various Ethernet protocols including, but not limited to BACnet IP, FOX, and Modbus.
16. All ports shall be capable of having protocol(s) assigned to utilize the port's physical connection.
17. The controller shall have at a minimum four (4) onboard inputs, two (2) universal inputs and two (2) binary inputs.
18. Schedules
 - a. Building controller modules shall provide normal seven-day scheduling, holiday scheduling and event scheduling.
 - b. Each building controller shall support a minimum of 380 BACnet Schedule Objects and 380 BACnet Calendar Objects.
19. Logging Capabilities
 - a. Each building controller shall log as minimum 2,000 objects at 15-minute intervals. Any object in the system (real or calculated) may be logged. Sample time interval shall be adjustable at the operator's workstation.
 - b. Logs may be viewed both on-site or off-site using WAN or remote communication.
 - c. Building controller shall periodically upload trended data to networked operator's workstation for long-term archiving if desired.
 - d. Archived data stored in database format shall be available for use in third-party spreadsheet or database programs.
20. Alarm Generation
 - a. Alarms may be generated within the system for any object change of value or state (either real or calculated). This includes things such as analog object value changes, binary object state changes, and various controller communication failures.
 - b. Each alarm may be dialed out as noted elsewhere.

- c. Alarm log shall be provided for alarm viewing. Log may be viewed on-site at the operator's terminal or off-site using remote communications.
- d. Controller must be able to handle up to 2,000 alarm setups stored as BACnet event enrollment objects, with system destination and actions individually configurable.
- 21. Demand Limiting
 - a. Demand limiting of energy shall be a built-in, user-configurable function. Each controller module shall support shedding of up to 1,200 loads using a minimum of two types of shed programs.
 - b. Load shedding programs in building controller modules shall operate as defined in section 2.1.J of this specification.
- B. BACnet MS/TP
 - 1. BACnet MS/TP LAN must be software-configurable from 9.6 to 115.4Kbps
 - a. Each BACnet MS/TP LAN shall support 64 BACnet devices at a minimum.
 - b. All proprietary object types, if used in the system, shall be thoroughly documented and provided as part of the submittal data. All necessary tools shall be supplied for working with proprietary information.
- C. BACnet IP
 - 1. The building controller shall comply with Annex J of the BACnet specification for IP connections. This device shall use Ethernet to connect to the IP internetwork, while using the same Ethernet LAN for non-IP communications to other BACnet devices on the local area network (LAN).
 - 2. Must support interoperability on WANs and campus area networks (CANs), and function as a BACnet Broadcast Management Device (BBMD).
 - 3. Each controller shall support at a minimum 128 BBMD entries.
 - 4. BBMD management architecture shall support 3,000 subnets at a minimum.
 - 5. Shall support BACnet Network Address Translation.
 - 6. All proprietary object types, if used in the system, shall be thoroughly documented and provided as part of the submittal data. All necessary tools shall be supplied for working with proprietary information.
- D. Expansion Ports
 - 1. Controller shall support two (2) expansion ports.
 - a. Combining the two on-board EIA-458 ports with fully loaded expansion ports, the controller shall support six (6) EIA-485 trunks simultaneously.
 - 2. Expansion cards that mate to the expansion ports shall include:
 - a. Dual port EIA-485 card.
 - b. LON network card.
- E. Niagara Framework
 - 1. Controller shall utilize the Tridium Niagara Framework.
 - a. Niagara Framework shall be version 4.7.
 - b. All Niagara licensing shall be stored on a removable MicroSD card for fast in-field replacement of controller.
 - c. The Niagara License for the controllers shall be an open license.
 - 1) The controller shall be programmable via Niagara Workplace programming tool.
 - 2) The controller shall be programmable via an Niagara embedded Workplace programming tool.
- F. Power Supply
 - 1. Input for power shall accept between 17 and 30VAC, 47 and 63Hz.
 - 2. Optional rechargeable battery for shutdown of controller including storage of all data in flash memory.
 - 3. On-board capacitor will ensure continuous operation of real-time clocks for minimum of 14 days.
- G. Controller shall be in compliance with the following:
 - 1. UL 916 for open energy management

2. FCC Class B
 3. ROHS
 4. IEC 60703
 5. C-Tick Listed
- H. Controller shall operate in the following environmental conditions:
1. -4 to 149 °F (-20 to 65 °C) without optional battery, or 32 to 122 °F (0 to 50 °C) with optional battery.
 2. 0 to 95% relative humidity (RH), non-condensing.

2.06 TERMINAL UNIT APPLICATION CONTROLLERS (HEAT PUMPS, AC UNITS, FAN-COILS)

- A. Provide one native BACnet application controller for each piece of unitary mechanical equipment that adequately covers all objects listed in object list for unit. All controllers shall interface to building controller through MS/TP LAN using BACnet protocol. No gateways shall be used. Controllers shall include input, output and self-contained logic program as needed for complete control of unit.
- B. BACnet Conformance
1. Application controllers shall, as a minimum, support MS/TP BACnet LAN types. They shall communicate directly using this BACnet LAN at 9.6, 19.2, 38.4 and 76.8 Kbps, as a native BACnet device. Application controllers shall be approved by the BTL as meeting the BACnet Application Specific Controller requirements and support all BACnet services necessary to provide the following BACnet functional groups:
 - a. Files Functional Group
 - b. Reinitialize Functional Group
 - c. Device Communications Functional Group
 2. Please refer to Section 22.2, BACnet Functional Groups in the BACnet standard, for a complete list of the services that must be directly supported to provide each of the functional groups listed above. All proprietary services, if used in the system, shall be thoroughly documented and provided as part of the submittal data. All necessary tools shall be supplied for working with proprietary information.
 3. Standard BACnet object types supported shall include, as a minimum, Analog Input, Analog Output, Analog Value, Binary Input, Binary Output, Binary Value, Device, File, and Program Object Types. All proprietary object types, if used in the system, shall be thoroughly documented and provided as part of the submittal data. All necessary tools shall be supplied for working with proprietary information.
- C. Application controllers shall include universal inputs with 10-bit resolution that can accept 3K and 10K thermistors, 0-5VDC, 4-20mA, dry contact signals and a minimum of 3 pulse inputs. Any input on controller may be either analog or digital. Controller shall also include support and modifiable programming for interface to intelligent room sensor. Controller shall include binary outputs on board with analog outputs as needed.
- D. All program sequences shall be stored on board controller in EEPROM. No batteries shall be needed to retain logic program. All program sequences shall be executed by controller 10 times per second and shall be capable of multiple PID loops for control of multiple devices. Programming of application controller shall be completely modifiable in the field over installed BACnet LANs or remotely through modem interface. Operator shall program logic sequences by graphically moving function blocks on screen and tying blocks together on screen. Application controller shall be programmed using same programming tools as building controller and as described in operator workstation section. All programming tools shall be provided and installed as part of system.
- E. Application controller shall include support for intelligent room sensor (see Section 2.10.B.) Display on room sensor shall be programmable at controller and include an operating mode and a field service mode. All button functions and display data shall be programmable to show specific controller data in each mode based on which button is pressed on the sensor. See sequence of operation for specific display requirements at intelligent room sensor.

2.07 VAV BOX CONTROLLERS-SINGLE DUCT

- A. Provide one native BACnet application controller for each VAV box that adequately covers all objects listed in object list for unit. All controllers shall interface to building controller through MS/TP LAN using BACnet protocol. No gateways shall be used. Controllers shall include on board CFM flow sensor, inputs, outputs and programmable, self-contained logic program as needed for control of units.
- B. BACnet Conformance
 - 1. Application controllers shall, at a minimum, support MS/TP BACnet LAN types. They shall communicate directly through this BACnet LAN at 9.6, 19.2, 38.4 and 76.8 Kbps, as a native BACnet device. Application controllers shall be approved by the BTL as meeting the BACnet Application Specific Controller requirements.
 - 2. Please refer to Section 22.2, BACnet Functional Groups, in the BACnet standard, for a complete list of the services that must be directly supported to provide each of the functional groups listed above. All proprietary services, if used in the system, shall be thoroughly documented and provided as part of the submittal data. All necessary tools shall be supplied for working with proprietary information.
 - 3. Standard BACnet object types supported shall include, as a minimum, Analog Input, Analog Output, Analog Value, Binary Input, Binary Output, Binary Value, Device, File, and Program Object Types. All proprietary object types, if used in the system, shall be thoroughly documented and provided as part of the submittal data. All necessary tools shall be supplied for working with proprietary information.
- C. Application controllers shall include universal inputs with 10-bit resolution that can accept 3K and 10K thermistors, 0-5 VDC, and dry contact signals. Inputs on controller may be either analog or digital. Controller shall also include support and modifiable programming for interface to intelligent room sensor with digital display. Controller shall also include binary outputs on board. For applications using variable speed parallel fans, provide a single analog output selectable for 0-10 V or 0-20 mA control signals. Application controller shall include microprocessor driven flow sensor for use in pressure independent control logic. All boxes shall be controlled using pressure-independent control algorithms and all flow readings shall be in CFM (LPS if metric).
- D. All program sequences shall be stored on board application controller in EEPROM. No batteries shall be needed to retain logic program. All program sequences shall be executed by controller 10 times per second and shall be capable of multiple PID loops for control of multiple devices. Programming of application controller shall be completely modifiable in the field over installed BACnet LANs or remotely using modem interface. Operator shall program logic sequences by graphically moving function blocks on screen and tying blocks together on screen. Application controller shall be programmed using the same programming tool as Building Controller and as described in operator's workstation section. All programming tools shall be provided as part of system.
- E. Application controller shall include support for intelligent room sensor (see Section 2.10.B.) Display on room sensor shall be programmable at application controller and include an operating mode and a field service mode. All button functions and display data shall be programmable to show specific controller data in each mode based on which button is pressed on the sensor. See sequence of operations for specific display requirements for intelligent room sensor.
- F. On board flow sensor shall be microprocessor-driven and pre-calibrated at the factory. Pre-calibration shall be at 16 flow points as a minimum. All factory calibration data shall be stored in non-volatile memory. Calibration data shall be field adjustable to compensate for variations in VAV box type and installation. All calibration parameters shall be adjustable through intelligent room sensor. Operator's workstation, portable computers, and special hand-held field tools shall not be needed for field calibration.
- G. Provide duct temperature sensor at discharge of each VAV box that is connected to controller for reporting back to operator's workstation.

2.08 AUXILIARY CONTROL DEVICES

A. Temperature Sensors

1. Provide the following instrumentation as required by the monitoring, control and optimization functions. All temperature sensors shall use Thermistor or platinum RTD elements. All temperature sensors to be solid-state electronic, interchangeable with housing appropriate for application. Wall sensors to be installed as indicated on drawings. Duct sensors to be installed such that the sensing element is in the main air stream. Immersion sensors to be installed in wells provided by control contractor, but installed by mechanical contractor. Immersion wells shall be filled with thermal compound before installation of immersion sensors. Outside air sensors shall be installed away from exhaust or relief vents, not in an outside air intake, and in a location, that is in the shade most of the day. All Temperature Sensors shall be Alerton, ACI or Veris.
 - a. Room Temperature:
 - 1) Sensor Output: 10K @ 77°F
 - 2) Sensor Accuracy: $\pm 0.36^\circ\text{F}$ from 32 to 158°F
 - 3) Operating Temperature Range: -40 to 212°F
 - 4) Operating Humidity Range: 0 to 90% RH non-condensing
 - b. Liquid Immersion Temperature:
 - 1) Sensor Output: 10K @ 77°F
 - 2) Sensor Accuracy: $\pm 0.36^\circ\text{F}$ from 32 to 158°F
 - 3) Operating Temperature Range: -40 to 302°F
 - 4) Operating Humidity Range: 10 to 95% RH non-condensing
 - c. Duct (Single Point & Averaging) Temperature
 - 1) Sensor Output: 10K @ 77°F
 - 2) Sensor Accuracy: $\pm 0.36^\circ\text{F}$ from 32 to 158°F
 - 3) Operating Temperature Range: -40 to 302°F
 - 4) Operating Humidity Range: 10 to 95% RH non-condensing
 - d. Outside Air Temperature
 - 1) Sensor Output: 10K @ 77°F
 - 2) Sensor Accuracy: $\pm 0.36^\circ\text{F}$ from 32 to 158°F
 - 3) Operating Temperature Range: -40 to 302°F
 - 4) Operating Humidity Range: 10 to 95% RH non-condensing

B. Humidity Sensor

1. Provide the following instrumentation as required by the monitoring, control and optimization functions. All humidity sensors shall be transmitters. Sensor output shall be 0-10V or 4-20mA signal. Sensor shall operate from 24 VDC or 24 VAC power source. The sensors shall be wall or duct mounted type as indicated on plans and in the sequence of operation. Wall sensors to be installed as indicated on drawings. Duct sensors to be installed such that the sensing element is in the main air stream. Outside air sensors shall be installed away from exhaust or relief vents, not in an outside air intake, and in a location, that is in the shade most of the day. All humidity sensors shall be Alerton, ACI, **or Veris. (Addendum 03)**
 - a. Outdoor/Duct Humidity Sensor
 - 1) Sensor Output: 4-20mA or 0-10 VDC
 - 2) Sensor Accuracy: $\pm 2\%$ from 10 to 95% RH
 - 3) Operating Temperature Range: -40 to 140°F
 - 4) Operating Humidity Range: 0 to 100% RH
 - 5) Long Term Stability: 2% drift/5 years
 - b. Room Humidity Sensor
 - 1) Sensor Output: 4-20mA or 0-10 VDC
 - 2) Sensor Accuracy: $\pm 2\%$ from 10 to 95% RH
 - 3) Operating Temperature Range: -40 to 140°F
 - 4) Operating Humidity Range: 0 to 100% RH

- 5) Long Term Stability: 2% drift/5 years
- C. Indoor Air Quality (CO₂) sensor
1. Provide the following instrumentation as required by the monitoring, control and optimization functions. The sensor shall be compliant with ASHRAE 62.1 standard. The sensors shall be a non-dispersive infrared (NDIR) operation. Sensor shall have field selectable outputs of 0-10V or 4-20mA. Sensor shall operate from 24 VDC or 24 VAC power source. The sensors shall be wall or duct mounted type as indicated on plans and in the sequence of operation. Wall sensors to be installed as indicated on drawings. Mount 48 inches above finished floor. Duct sensors to be installed such that the sensing element is in the main air stream. All CO₂ sensors shall be Alerton, ACI or Veris.
 - a. Wall Mounted
 - 1) Sensor Range: 0-2000ppm
 - 2) Sensor Accuracy: $\pm 30\text{ppm} \pm 5\%$ of measured value
 - 3) Sensor Repeatability: $\pm 20\text{ppm} \pm 1\%$ of measured value
 - 4) Operating Temperature Range: 32 to 122°F
 - 5) Operating Humidity Range: 0 to 95% RH
 - 6) 5-year calibration interval
 - b. Duct Mounted
 - 1) Sensor Range: 0-2000ppm or 0-5000ppm
 - 2) Sensor Accuracy: $\pm 30\text{ppm} \pm 5\%$ of measured value
 - 3) Sensor Repeatability: $\pm 20\text{ppm} \pm 1\%$ of measured value
 - 4) Operating Temperature Range: 32 to 122°F
 - 5) Operating Humidity Range: 0 to 95% RH
 - 6) 5-year calibration interval
- D. Differential Pressure Transmitters
1. Provide the following instrumentation as required by the monitoring, control and optimization functions. Pressure range to suit application. Sensor shall have provision for zeroing by pushbutton or digital input. Sensor shall have field selectable outputs of 0-5V, 0-10V, and 4-20mA. Sensor shall operate from 24 VDC or 24 VAC power source. Sensor shall be switch or jumper selectable for pressure ranges and for flow direction (uni-directional or bi-directional). All pressure sensors shall be Alerton, ACI or Veris.
 - a. Fluid Pressure Transmitter
 - 1) Sensor Pressure Range: 0-100 PSI, as needed
 - 2) Sensor Accuracy: $\pm 2.0\%$ FSO (includes linearity, hysteresis and repeatability.)
 - 3) Operating Temperature Range: -22 to 248°F
 - 4) Operating Humidity Range: 10 to 90% RH
 - 5) Enclosure rating: NEMA 4
 - (a) Dry Media Pressure Transmitter
 - (b) Sensor Pressure Range: -5.0" W.C. to 5.0" W.C., as needed
 - (c) Sensor Accuracy: $\pm 2.0\%$ FSO (includes linearity, hysteresis and repeatability.)
 - (d) Operating Temperature Range: 32 to 140°F
 - (e) Operating Humidity Range: 0 to 95% RH
- E. Control Relays
1. Control relays shall be UL listed plug-in type with dust cover and LED "energized" indicator. Contact rating, configuration, and coil voltage shall be suitable for application.
 2. Acceptable Manufacturers are IDEC, Functional Devices or Veris.
- F. Current Sensors
1. Current sensor shall be self-powered and solid state. The switches shall be selected to match the current of the application and output requirements of the DDC system. The current shall provide visual indication (LED) for output status and sensor. Current sensor shall be Alerton, ACI or Veris.

2.09 ENCLOSURES

- A. All controllers, power supplies and relays shall be mounted in enclosures.
- B. Enclosures may be NEMA 1 when located in a clean, dry, indoor environment. Indoor enclosures shall be NEMA 12 when installed in other than a clean environment. Outdoor enclosures shall be NEMA 3R.
- C. Enclosures shall have hinged, locking doors.
- D. Provide laminated plastic nameplates for all enclosures in any mechanical room or electrical room. Include location and unit served on nameplate. Laminated plastic shall be 0.125 inches thick and appropriately sized to make label easy to read.

2.10 AIR FLOW MEASURING STATIONS (THERMAL DISPERSION TYPE)

- A. Acceptable Manufacturers
 - 1. EBTRON, Inc.
- B. Types of Mounting Application
 - 1. Fan-Inlet
 - 2. Duct Mounted Probe
- C. Specifications:
 - 1. Transmitter Powered by 24VAC or VDC power supply
 - 2. Airflow Range:
 - a. 0 to 10,000 FPM (fan inlet)
 - b. 0 to 4,000 FPM (duct mounted)
 - 3. Transmitter Signal Range: 0-10 VDC or 4-20mA
 - 4. Airflow Measuring Accuracy: $\pm 3\%$ of measured flow
 - 5. Temperature Reading Range -20 to 140°F
 - 6. Temperature Reading Accuracy: $\pm 0.15^\circ\text{F}$
 - 7. Operating Temperature Range: -20 to 120°F
 - 8. Operating Humidity Range: 5-95% R.H., non-condensing

2.11 LIQUID FLOW METERS

- A. Insertional Turbine Flow Meters
 - 1. Approved Manufacturers
 - a. ONICON
 - b. Provide an ONICON Model F-1210 Dual Turbine Flow Meter complete with all installation hardware necessary to enable insertion and removal of the meter without system shutdown. For bi-directional flow applications, provide ONICON Model FB-1210. The flow meter shall be hand-insertable up to 400 psi. The flow meter shall have two contra-rotating axial turbines, with electronic impedance-based sensing and an averaging circuit to reduce measurement errors due to swirl and flow profile distortion. Wetted metal components shall be nickel-plated brass (unless optional 316L SS is otherwise specified). Optional 316L SS construction is required for HW applications operating over 250 degrees F, and for any application in non-metallic pipe. The maximum operating temperature shall be 280 degrees F, 300 F peak. Each flow meter shall be individually wet-calibrated against a primary volumetric standard that is accurate to within 0.1% and traceable to NIST*. The manufacturer's certificate of calibration shall be provided with each flow meter. Accuracy shall be within $\pm 0.5\%$ of rate at the calibrated velocity, within $\pm 1\%$ of rate over a 10:1 turndown (3.0 to 30 ft/s) and within $\pm 2\%$ of rate over a 50:1 turndown (from 0.4 to 20 ft/s). The flow meter shall include integral analog output(s), 4-20 mA, 0-10V, or 0-5V. Bi-directional meters shall include an isolated contact closure output for direction. The flow meter shall be covered by the manufacturer's two-year warranty.
- B. Inline Magnetic Flow Meters
 - 1. Approved Manufacturers
 - a. ONICON

- b. Provide an ONICON F-3200 Series Electromagnetic Flow Meter complete with integral or remote electronics module. The electronics module shall include a backlit graphic display and keypad. Connections to the piping shall be ANSI class 150 flanges (ANSI class 300 available where required). The installing contractor is responsible for providing suitable mating flanges. The flow tube shall be epoxy coated steel; the sensing electrodes shall be 316SS; the liner shall be polypropylene or ebonite for low temperature service, PTFE for hot water service. Each flow meter shall be individually wet-calibrated and accurate to within $\pm 0.2\%$ of reading from 1.6 to 33 feet per second velocity. A certificate of calibration shall be provided with each flow meter. Output signals shall be 4-20 mA and programmable pulse. The flow meter shall be capable of measuring bi-directional flow. For installations in non-metallic pipe, install grounding rings between flanges. Each flow meter shall be factory programmed for its specific application, and shall be re-programmable using the integral keypad on the converter (no special interface device or computer required). Each flow meter shall be covered by the manufacturer's two-year warranty.

PART 3: EXECUTION

3.01 EXAMINATION

- A. Prior to starting work, carefully inspect installed work of other trades and verify that such work is complete to the point where work of this Section may properly commence.
- B. Notify the owner's representative in writing of conditions detrimental to the proper and timely completion of the work.
- C. Do not begin work until all unsatisfactory conditions are resolved.

3.02 INSTALLATION (GENERAL)

- A. Install in accordance with manufacturer's instructions.
- B. The Controls Contractor shall provide their own independent ethernet network for startup, functional testing, and Commissioning and shall not rely on the Owner's network for commencement of this work.
- C. Provide all miscellaneous devices, hardware, software, interconnections, installation, and programming required to ensure a complete operating system in accordance with the sequences of operation and point schedules.

3.03 LOCATION AND INSTALLATION OF COMPONENTS

- A. Locate and install components for easy accessibility; in general, mount 48 inches above floor with minimum 3 feet of clear access space in front of units. Obtain approval on locations from owner's representative prior to installation.
- B. All instruments, switches, transmitters, etc., shall be suitably wired and mounted to protect them from vibration, moisture, and high or low temperatures.
- C. Identify all equipment and panels. Provide permanently mounted tags for all panels.
- D. Provide stainless steel or brass thermowells suitable for respective application and for installation under other sections, and sized to suit pipe diameter without restricting flow.

3.04 INTERLOCKING AND CONTROL WIRING

- A. Provide all interlock and control wiring. All wiring shall be installed neatly and professionally, in accordance with Specification Division 26 and all national, state and local electrical codes.
- B. Provide wiring as required by functions as specified and as recommended by equipment manufacturers, to serve specified control functions. Provide shielded low capacitance wire for all communications trunks.
- C. Control wiring shall not be installed in power circuit raceways. Magnetic starters and disconnect switches shall not be used as junction boxes. Provide auxiliary junction boxes as required. Coordinate location and arrangement of all control equipment with the owner's representative prior to rough-in.

- D. Provide auxiliary pilot duty relays on motor starters as required for control function.
- E. Provide power for all control components from nearest electrical control panel or as indicated on the electrical drawings; coordinate with electrical contractor.
- F. All control wiring in the mechanical, electrical, telephone and boiler rooms to be installed in raceways.
- G. Control wiring above accessible ceiling spaces shall be run in raceway. Wiring exposed above the ceiling that terminates at VAV box controllers, etc., shall be listed for plenum use.

3.05 DDC OBJECT TYPE SUMMARY

- A. Provide all database generation.
- B. Displays
 - 1. System displays shall show all analog and binary object types within the system. They shall be logically laid out for easy use by the owner. Provide outside air temperature indication on all system displays associated with economizer cycles.
- C. Run Time Totalization
 - 1. At a minimum, run time totalization shall be incorporated for each monitored supply fan, return fan, exhaust fan, hot water and chilled water pumps. Warning limits for each point shall be entered for alarm and or maintenance purposes.
- D. Trendlog
 - 1. All binary and analog object types (including zones) shall have the capability to be automatically trended.
- E. Alarm
 - 1. All analog inputs (High/Low Limits) and selected binary input alarm points shall be prioritized and routed (locally or remotely) with alarm message per owner's requirements.
- F. Database Save
 - 1. Provide backup database for all standalone application controllers on disk.

3.06 FIELD SERVICES

- A. Prepare and start logic control system under provisions of this section.
- B. Start up and commission systems. Allow sufficient time for startup and commissioning prior to placing control systems in permanent operation.
- C. Provide the capability for off-site monitoring at control contractor's local or main office. At a minimum, off-site facility shall be capable of system diagnostics and software download. Owner shall provide phone line for this service for one year or as specified.
- D. Provide owner's representative with spare parts list. Identify equipment critical to maintaining the integrity of the operating system.

3.07 TRAINING

- A. Provide application engineer to instruct owner in operation of systems and equipment.
- B. Provide system operator's training to include (but not be limited to) such items as the following: modification of data displays, alarm and status descriptors, requesting data, execution of commands and request of logs. Provide this training to a minimum of three persons.
- C. Provide on-site training above as required, up to 8 hours as part of this contract.

3.08 DEMONSTRATION

- A. Demonstrate complete operating system to owner's representative.
- B. Provide certificate stating that control system has been tested and adjusted for proper operation.

END OF SECTION 23 09 23

SECTION 23 09 33
VARIABLE FREQUENCY DRIVE

PART 1 GENERAL

1.01 DESCRIPTION

- A. This specification covers variable frequency drives (VFDs) designated on the drawing schedules to be variable speed. All standard and optional features shall be included within the VFD panel.
- B. The VFD shall be UL Type 1 or UL Type 12 as required on the schedule.
- C. The VFD shall have been evaluated by UL and found acceptable for mounting in a plenum or other air handling compartment.
 - 1. Manufacturer shall supply a copy of the UL plenum evaluation upon request.
- D. The VFD shall be tested to UL 508C.
 - 1. The appropriate UL label shall be applied.
- E. VFD shall be manufactured in ISO 9001, 2000 certified facilities.
- F. The VFD shall be CE marked and conform to the European Union ElectroMagnetic Compatibility directive.
- G. The VFD shall be UL listed for a short circuit current rating of 65 kAIC and labeled with this rating.
- H. To ensure adequate technical and factory support, VFDs manufactured by others and brand labeled shall not be acceptable.
- I. The VFD manufacturer shall supply the VFD and all necessary controls as herein specified.
- J. The manufacturer shall have been engaged in the production of this type of equipment for a minimum of twenty years.

PART 2 PRODUCTS

2.01 MANUFACTURERS

- A. ABB
- B. Danfoss
- C. Eaton
- D. Johnson
- E. Schneider
- F. Siemens
- G. Yasakawa
- H. **Square D (Addendum 03)**

2.02 DESCRIPTION

- A. The VFD shall convert incoming fixed frequency three-phase AC power into an adjustable frequency and voltage for controlling the speed of three-phase AC motors.
- B. The motor current shall closely approximate a sine wave.
- C. Motor voltage shall be varied with frequency to maintain desired motor magnetization current suitable for the driven load and to eliminate the need for motor derating.
- D. When properly sized, the VFD shall allow the motor to produce full rated power at rated motor voltage, current, and speed without using the motor's service factor.
- E. VFDs utilizing sine weighted/coded modulation (with or without 3rd harmonic injection) must provide data verifying that the motors will not draw more than full load current during full load and full speed operation.
- F. The VFD shall include an input full-wave bridge rectifier and maintain a fundamental (displacement) power factor near unity regardless of speed or load.

- G. The VFD shall have a dual 5% impedance DC link reactor on the positive and negative rails of the DC bus to minimize power line harmonics and protect the VFD from power line transients. The chokes shall be non-saturating.
 - 1. Swinging chokes that do not provide full harmonic filtering throughout the entire load range are not acceptable.
- H. VFDs with saturating (non-linear) DC link reactors shall require an additional 3% AC line reactor to provide acceptable harmonic performance at full load, where harmonic performance is most critical.
- I. The VFD's full load output current rating shall meet or exceed NEC Table 430-150.
- J. The VFD shall be able to provide full rated output current continuously, 110% of rated current for 60 seconds and 135% of rated torque for up to 0.5 second while starting.
- K. The VFD shall provide full motor torque at any selected frequency from 20 Hz to base speed while providing a variable torque V/Hz output at reduced speed.
 - 1. This is to allow driving direct drive fans without high speed derating or low speed excessive magnetization, as would occur if a constant torque V/Hz curve was used at reduced speeds.
- L. A programmable automatic energy optimization selection feature shall be provided standard in the VFD. This feature shall automatically and continuously monitor the motor's speed and load to adjust the applied voltage to maximize energy savings.
- M. The VFD must be able to produce full torque at low speed to operate direct drive fans.
- N. The VFD must be capable of connection and disconnection to motor while the VFD is under load.
 - 1. This switching shall be accomplished without interlocks or damage to the VFD.
- O. An automatic motor adaptation algorithm shall measure motor stator resistance and reactance to optimize performance and efficiency.
 - 1. It shall not be necessary to run the motor or de-couple the motor from the load to perform the test.
- P. Galvanic isolation shall be provided between the VFD's power circuitry and control circuitry to ensure operator safety and to protect connected electronic control equipment from damage caused by voltage spikes, current surges, and ground loop currents.
 - 1. VFDs not including either galvanic or optical isolation on both analog I/O and discrete digital I/O shall include additional isolation modules.
- Q. VFD shall minimize audible motor noise through the use of an adjustable carrier frequency.
 - 1. The carrier frequency shall be automatically adjusted to optimize motor and VFD operation while reducing motor noise.
 - 2. VFDs with fixed carrier frequency are not acceptable.
- R. All VFDs shall contain integral EMI filters to attenuate radio frequency interference conducted to the AC power line.

2.03 PROTECTIVE FEATURES

- A. A minimum of Class 20 I²t electronic motor overload protection for single motor applications shall be provided.
 - 1. Overload protection shall automatically compensate for changes in motor speed.
- B. Protection against input transients, loss of AC line or load phase, output short circuit, output ground fault, over voltage, under voltage, VFD over temperature and motor over temperature.
 - 1. The VFD shall display all faults in plain language. Codes are not acceptable.
- C. Protect VFD from input phase loss.
 - 1. The VFD should be able to protect itself from damage and indicate the phase loss condition. During an input phase loss condition,

2. the VFD shall be able to be programmed to either trip off while displaying an alarm, issue a warning while running at reduced output capacity, or issue a warning while running at full commanded speed.
 3. This function is independent of which input power phase is lost.
- D. Protect from under voltage.
1. The VFD shall provide full rated output with an input voltage as low as 90% of the nominal.
 2. The VFD will continue to operate with reduced output, without faulting, with an input voltage as low as 70% of the nominal voltage.
- E. Protect from over voltage.
1. The VFD shall continue to operate without faulting with a momentary input voltage as high as 130% of the nominal voltage.
- F. The VFD shall incorporate a programmable motor preheat feature to keep the motor warm and prevent condensation build up in the motor when it is stopped in a damp environment by providing the motor stator with a controlled level of current.
- G. VFD shall include a "signal loss detection" algorithm with adjustable time delay to sense the loss of an analog input signal.
1. It shall also include a programmable time delay to eliminate nuisance signal loss indications.
 2. The functions after detection shall be programmable.
- H. VFD shall function normally when the keypad is removed while the VFD is running.
1. No warnings or alarms shall be issued as a result of removing the keypad.
- I. VFD shall catch a rotating motor operating forward or reverse up to full speed without VFD fault or component damage.
- J. Selectable over-voltage control shall be provided to protect the drive from power regenerated by the motor while maintaining control of the driven load.
- K. VFD shall include current sensors on all three output phases to accurately measure motor current, protect the VFD from output short circuits, output ground faults, and act as a motor overload.
1. If an output phase loss is detected, the VFD will trip off and identify which of the output phases is low or lost.
- L. If the temperature of the VFD's heat sink rises to a critical level, the VFD shall automatically reduce its carrier frequency to reduce the heat sink temperature.
1. It shall also be possible to program the VFD so that it reduces its output current limit value if the VFD's temperature becomes too high.
- M. In order to ensure operation during periods of overload, it must be possible to program the VFD to automatically reduce its output current to a programmed value during periods of excessive load. This allows the VFD to continue to run the load without tripping.
- N. The VFD shall have temperature controlled cooling fan(s) for quiet operation, minimized losses, and increased fan life.
1. The drive fan speed can be preprogrammed at preset speeds or run in Auto mode.
 2. At low loads or low ambient temperatures, the VFD may even turn the fan(s) off even when the VFD is running.
- O. The VFD shall store in memory the last 10 alarms.
1. A description of the alarm, and the date and time of the alarm shall be recorded.
 2. The VFD shall include graphing capability for the last 2 alarms to provide additional diagnostic analysis.
- P. When used with a pumping system, the VFD shall be able to detect no-flow situations, dry pump conditions, and operation off the end of the pump curve.
1. It shall be programmable to take appropriate protective action when one of the above situations is detected.

2.04 INTERFACE FEATURES

- A. Hand, Off and Auto keys shall be provided to start and stop the VFD and determine the source of the speed reference.
 - 1. It shall be possible to either disable these keys or password protect them from undesired operation.
- B. There shall be an "Info" key on the keypad.
 - 1. The Info key shall include "on-line" context sensitive assistance for programming and troubleshooting.
- C. The VFD shall be programmable to provide a digital output signal to indicate whether the VFD is in Hand or Auto mode.
 - 1. This is to alert the Building Automation System whether the VFD is being controlled locally or by the Building Automation System.
- D. Password protected keypad with alphanumeric, graphical, backlit display can be remotely mounted.
 - 1. Two levels of password protection shall be provided to guard against unauthorized parameter changes.
- E. All VFDs shall have the same customer interface.
 - 1. The keypad and display shall be identical and interchangeable for all sizes of VFDs.
- F. To set up multiple VFDs, it shall be possible to upload all setup parameters to the VFD's keypad, place that keypad on all other VFDs in turn and download the setup parameters to each VFD.
 - 1. To facilitate setting up VFDs of various sizes, it shall be possible to download from the keypad only size independent parameters.
 - 2. Keypad shall provide visual indication of copy status.
- G. A red FAULT light, a yellow WARNING light and a green POWER-ON light shall be provided.
 - 1. These indications shall be visible both on the keypad and on the VFD when the keypad is removed.
- H. A quick setup menu with factory preset typical HVAC parameters shall be provided on the VFD.
 - 1. The VFD shall also have individual Fan, Pump, and Compressor menus specifically designed to facilitate start-up of these applications.
- I. A three-feedback PID controller to control the speed of the VFD shall be standard.
- J. This controller shall accept up to three feedback signals.
 - 1. It shall be programmable to compare the feedback signals to a common setpoint or to individual setpoints and to automatically select either the maximum or the feedback signal as the controlling signal.
 - 2. It shall also be possible to calculate the controlling feedback signal as the average of all feedback signals or the difference between a pair of feedback signals.
- K. The VFD shall be able to apply individual scaling to each feedback signal.
- L. For fan flow tracking applications, the VFD shall be able to calculate the square root of any or all individual feedback signals so that a pressure sensor can be used to measure air flow.
- M. The VFD's PID controller shall be able to actively adjust its setpoint based on flow.
 - 1. This allows the VFD to compensate for a pressure feedback sensor which is located near the output of the pump rather than out in the controlled system.
- N. The VFD shall have three additional PID controllers which can be used to control damper and valve positioners in the system and to provide setpoint reset.
- O. Floating point control interface shall be provided to increase/decrease speed in response to contact closures.
- P. Five simultaneous meter displays shall be available.
 - 1. They shall include at a minimum, frequency, motor current, motor voltage, VFD output power, VFD output energy, VFD temperature in degrees, among others.

- Q. Programmable Sleep Mode shall be able to stop the VFD.
 - 1. When its output frequency drops below set "sleep" level for a specified time, when an external contact commands that the VFD go into Sleep Mode, or when the VFD detects a no-flow situation, the VFD may be programmed to stop.
 - 2. When the VFD's speed is being controlled by its PID controller, it shall be possible to program a "wake-up" feedback value that will cause the VFD to start.
 - 3. To avoid excessive starting and stopping of the driven equipment, it shall be possible to program a minimum run time before sleep mode can be initiated and a minimum sleep time for the VFD.
- R. A run permissive circuit shall be provided to accept a "system ready" signal to ensure that the VFD does not start until dampers or other auxiliary equipment are in the proper state for VFD operation.
 - 1. The run permissive circuit shall also be capable of initiating an output "run request" signal to indicate to the external equipment that the VFD has received a request to run.
- S. VFD shall be programmable to display feedback signals in appropriate units, such as inches of water column (in-wg), pressure per square inch (psi) or temperature (°F).
- T. VFD shall be programmable to sense the loss of load.
 - 1. The VFD shall be programmable to signal this condition via a keypad warning, relay output and/or over the serial communications bus.
 - 2. To ensure against nuisance indications, this feature must be based on motor torque, not current, and must include a proof timer to keep brief periods of no load from falsely triggering this indication.

2.05 STANDARD CONTROL AND MONITORING INPUTS AND OUTPUTS

- A. Four dedicated, programmable digital inputs shall be provided for interfacing with the systems control and safety interlock circuitry.
- B. Two terminals shall be programmable to act as either as digital outputs or additional digital inputs.
- C. Two programmable relay outputs, Form C 240 V AC, 2 A, shall be provided for remote indication of VFD status.
- D. Each relay shall have an adjustable on delay / off delay time.
- E. Two programmable analog inputs shall be provided that can be either direct-or-reverse acting.
- F. Each shall be independently selectable to be used with either an analog voltage or current signal.
- G. The maximum and minimum range of each shall be able to be independently scalable from 0 to 10 V dc and 0 to 20 mA.
- H. A programmable low-pass filter for either or both of the analog inputs must be included to compensate for noise.
- I. The VFD shall provide front panel meter displays programmable to show the value of each analog input signal for system set-up and troubleshooting,
- J. One programmable analog current output (0/4 to 20 mA) shall be provided for indication of VFD status.
 - 1. This output shall be programmable to show the reference or feedback signal supplied to the VFD and for VFD output frequency, current and power.
 - 2. It shall be possible to scale the minimum and maximum values of this output.
- K. It shall be possible through serial bus communications to read the status of all analog and digital inputs of the VFD.
- L. It shall be possible to command all digital and analog output through the serial communication bus.

2.06 OPTIONAL CONTROL AND MONITORING INPUTS AND OUTPUTS

- A. It shall be possible to add optional modules to the VFD in the field to expand its analog and digital inputs and outputs.
- B. These modules shall use rigid connectors to plug into the VFD's control card.
- C. The VFD shall automatically recognize the option module after it is powered up. There shall be no need to manually configure the module.
- D. Modules may include such items as:
 - 1. Additional digital outputs, including relay outputs
 - 2. Additional digital inputs
 - 3. Additional analog outputs
 - 4. Additional analog inputs, including Ni or Pt temperature sensor inputs
- E. It shall be possible through serial bus communications to control the status of all analog and digital outputs of the VFD.
 - 1. Standard programmable firefighter's override mode allows a digital input to control the VFD and override all other local or remote commands.
 - 2. It shall be possible to program the VFD so that it will ignore most normal VFD safety circuits including motor overload.
 - 3. The VFD shall display FIREMODE whenever in firefighter's override mode.
 - 4. Fire-mode shall allow selection of forward or reverse operation and the selection of a speed source or preset speed, as required to accommodate local fire codes, standards and conditions.
- F. A real-time clock shall be an integral part of the VFD.
 - 1. It shall be possible to use this to display the current date and time on the VFD's display.
 - 2. Ten programmable time periods, with individually selectable ON and OFF functions shall be available.
 - 3. The clock shall also be programmable to control start/stop functions, constant speeds, PID parameter setpoints and output relays. It shall be possible to program unique events that occur only during normal work days, others that occur only on non-work days, and others that occur on specific days or dates.
 - 4. The manufacturer shall provide free PC-based software to set up the calendar for this schedule.
- G. All VFD faults shall be time stamped to aid troubleshooting.
- H. It shall be possible to program maintenance reminders based on date and time, VFD running hours, or VFD operating hours.
- I. The real-time clock shall be able to time and date stamp all faults recorded in the VFD fault log.
- J. The VFD shall be able to store load profile data to assist in analyzing the system demand and energy consumption over time.
- K. The VFD shall include a sequential logic controller to provide advanced control interface capabilities. This shall include:
 - 1. Comparators for comparing VFD analog values to programmed trigger values
 - 2. Logic operators to combine up to three logic expressions using Boolean algebra
 - 3. Delay timers
 - 4. A 20-step programmable structure
 - 5. The VFD shall include a Cascade Controller which allows the VFD to operate in closed loop set point (PID) control mode one motor at a controlled speed and control the operation of additional constant speed motor starters.

2.07 SERIAL COMMUNICATIONS

- A. The VFD shall include a standard EIA-485 communications port and capabilities to be connected to the following serial communication protocols at no additional cost and without a need to install any additional hardware or software in the VFD:

1. BACnet IP *or* BACnet MS/TP (Addendum 03)
 2. Option board only
- B. Option boards for the following protocols shall be available:
1. BACnet Expanded
 2. Ethernet
 3. LonWorks Free Topology (FTP) certified to LonMark standard 3.3
- C. VFD shall have standard USB port for direct connection of Personal Computer (PC) to the VFD.
1. The manufacturer shall provide no-charge PC software to allow complete setup and access of the VFD and logs of VFD operation through the USB port.
 2. It shall be possible to communicate to the VFD through this USB port without interrupting VFD communications to the building management system.
- D. The VFD shall have provisions for an optional 24 V DC back-up power interface to power the VFD's control card. This is to allow the VFD to continue to communicate to the building automation system even if power to the VFD is lost.

2.08 ADJUSTMENTS

- A. The VFD shall have a manually adjustable carrier frequency to allow the user to select the desired operating characteristics. The VFD shall also be programmable to automatically reduce its carrier frequency to avoid tripping due to thermal loading.
- B. Four independent setups shall be provided.
- C. Four preset speeds per setup shall be provided for a total of 16.
- D. Each setup shall have two programmable ramp up and ramp down times. Acceleration and deceleration ramp times shall be adjustable over the range from 1 to 3,600 seconds.
- E. Each setup shall be programmable for a unique current limit value.
1. If the output current from the VFD reaches this value, any further attempt to increase the current produced by the VFD will cause the VFD to reduce its output frequency to reduce the load on the VFD.
 2. If desired, it shall be possible to program a timer which will cause the VFD to trip off after a programmed time period.
- F. If the VFD trips on one of the following conditions, the VFD shall be programmable for automatic or manual reset: external interlock, under-voltage, over-voltage, current limit, over temperature, and VFD overload.
- G. The number of restart attempts shall be selectable from 0 through 20 or infinitely and the time between attempts shall be adjustable from 0 through 600 seconds.
- H. An automatic "start delay" may be selected from 0 to 120 seconds. During this delay time, the VFD shall be programmable to either apply no voltage to the motor or apply a DC braking current if desired.
- I. Four programmable critical frequency lockout ranges to prevent the VFD from operating the load at a speed that causes vibration in the driven equipment shall be provided. Semi-automatic setting of lockout ranges shall simplify the set-up.

2.09 OPTIONAL FEATURES

- A. All optional features shall be built, mounted and tested by the VFD manufacturer.
1. The VFD manufacturer's warranty shall apply to the entire assembly as shipped.
 2. Packages built by third parties and do not carry the VFD manufacturer's warranty shall not be allowed.
 3. All options shall carry a UL / C-UL Enclosed Industrial Control Panel label.
 4. All panels shall be marked for 100,000 amp short circuit current rating.
- B. The enclosure rating of the VFD w/ options shall be consistent with the VFD rating of either NEMA/UL type 1 or NEMA/UL type 12, as required for the installation location and/or as called for on the schedule.

1. The package shall include ALL optional devices and shipped as a complete factory tested assembly.
- C. Three Contactor bypass shall be provided that allows operation of the motor via line power in the event of a failure of the VFD.
 1. Motor control selection shall be through either a VFD output contactor or a bypass contactor that is electrically interlocked to ensure that both contactors are not energized simultaneously.
 2. A third contactor, the drive input contactor, shall be supplied as standard.
 3. This allows the powering of the VFD with the motor off or operating in bypass mode for testing, programming and troubleshooting purposes.
- D. The Three Contactor bypass shall include the following interface and control features:
 1. Mode selection via a four position DRIVE/OFF/BYPASS/TEST switch.
 2. DRIVE Mode: Both the drive input and output contactors are closed and the motor is operated via VFD power
 3. OFF mode: DRIVE input, drive output and bypass contactors are all open.
 4. Bypass mode: Bypass contactor is closed and motor is operating from line power. Both the drive input and drive output contactors are open for servicing of the VFD without power.
 5. Test mode: Bypass contactor is closed and the motor is operated from line power. The drive input contactor is closed but the drive output contactor is open. This allows for the testing and programming of the VFD while the motor is operated via line power.
- E. Contactors shall operate from a 24vdc power supply that shall function off of any two legs of the AC line and shall maintain power on the loss of any one of the AC lines.
- F. A Bypass pilot light is supplied to indicate that the motor is operating from line power.
- G. Common start/stop command when operating in either Bypass or VFD mode.
- H. Selectable Run Permissive logic shall operate in either VFD or bypass operation.
 1. When activated, any command to start the motor, in either Hand Bypass, Remote Bypass, Hand VFD or Remote VFD shall not start the motor, but instead close a relay contact that is used to initiate operation of another device, such as an outside air damper.
 2. A contact closure from this device shall confirm that it is appropriately actuated and the motor shall then start.
- I. Bypass package shall include an External Safety interlock that will disable motor operation in either bypass or VFD when open.
- J. Fire-mode bypass operation shall be standard.
 1. When activated via a contact closure, the motor shall transfer to bypass (line power) regardless of the mode selected.
 2. All calls to stop the motor shall be ignored.
 3. These include the opening of the start command, an external safety trip or the tripping of the motor overload.
 4. Fire-mode operation will take precedence over all other commands.
- K. The bypass must include a selectable time delay of 0 to 60 seconds before the initiation of bypass operation.
 1. When transferring from VFD to bypass modes, the time delay starts after the motor has decelerated to zero speed.
 2. This delay allows the BAS to prepare for bypass operation.
 3. Bypass packages that do not include a time delay, or do not include a selectable delay period, will not be acceptable.
- L. Automatic bypass shall be selectable.
 1. When active, the motor shall be transferred to line power on a VFD fault condition.
 2. The bypass time delay shall be activate prior to this transfer to line power to allow the VFD time to attempt to recover from the fault condition prior to running in bypass.

2.10 PROTECTIVE FEATURES

- A. Main input disconnect shall be provided that removes power from both the bypass and VFD.
- B. Main input motor rated fuses that protect the entire package.
- C. ~~VFD only fast acting input fuses shall be provided. Packages that include only main input motor rated fusing or circuit breaker are not acceptable.~~ **Disconnecting means shall be either a fused disconnect and a circuit breaker rated for SCCR listed herein. (Addendum 03)**
- D. Overload protection shall be supplied in bypass mode.
- E. This overload shall supply minimum class 20 protection as well as wide adjustable current setting for complete motor protection when operating on line power.
 - 1. Those overloads that are not class 20 or current selectable will not be acceptable.
- F. Overload protection shall include phase loss and phase imbalance protection.
- G. For 460V/600V units 75 Hp and below and 208V/230V units 40 Hp and below, low voltage contactor operation shall be maintained down to 70% of the unit's nominally rated voltage, to ensure VFD operation.
- H. For 460V/600V units 75 Hp and below and 208V/230V units 40 Hp and below, the VFD shall be able to operate the motor at a reduced load with the loss of any one of the three phases of power.
 - 1. Contactors shall remain closed regardless of which phase is lost to ensure VFD operation.

2.11 LINE/LOAD CONDITIONERS

- A. VFDs that do not include 5% DC link impedance shall include 5% AC line reactors in the options enclosure. Lower levels of impedance will not be acceptable.

2.12 SERVICE CONDITIONS

- A. Ambient temperature, continuous, full speed, full load operation:
 - 1. 14 to 113°F on Non-Bypass units
 - 2. 14 to 104°F on Bypass units
 - 3. 5 to 95% relative humidity, non-condensing.
 - 4. Elevation to 3,300 feet without derating.
 - 5. AC line voltage variation, -10 to +10% of nominal with full output.
 - 6. All power and control wiring shall be from the bottom.
 - 7. All VFDs shall be plenum rated.

2.13 QUALITY ASSURANCE

- A. To ensure quality, the complete VFD shall be tested by the manufacturer. The VFD shall drive a motor connected to a dynamometer at full load and speed and shall be cycled during the automated test procedure.
- B. All optional features shall be functionally tested at the factory for proper operation.

PART 3 EXECUTION

3.01 START-UP SERVICE

- A. The manufacturer shall provide start-up commissioning of the VFD and its optional circuits by a factory certified service technician who is experienced in start-up and repair services.
- B. Sales personnel and other agents who are not factory certified shall not be acceptable as commissioning agents.
- C. Start-up services shall include checking for verification of proper operation and installation for the VFD, its options and its interface wiring to the building automation system.
- D. Harmonic filtering.
 - 1. The VFD supplier shall, with the aid of the buyer's detailed electrical power single line diagram showing all impedances in the power path to the VFDs, perform an analysis to initially demonstrate the supplied equipment will meet the IEEE recommendations after installation.

2. If, as a result of the analysis, it is determined that additional filter equipment is required to meet the IEEE recommendations, then the cost of such equipment shall be included in the drive supplier quotation.

3.02 WARRANTY

- A. The complete VFD shall be warranted by the manufacturer for a period of 36 months from date of shipment.
 1. The warranty shall include parts, labor, travel costs and living expenses incurred by the manufacturer to provide factory authorized on-site service.
 2. The warranty shall be provided by the VFD manufacturer and not a third party.
 3. A written warranty statement shall be provided with the submittals.

END OF SECTION 23 09 33

SECTION 23 52 23
CAST-IRON BOILERS

PART 1 GENERAL

1.01 SECTION INCLUDES

- A. Boilers.
- B. Controls and boiler trim.
- C. Hot water connections.
- D. Fuel connection.
- E. Collector, draft hood, and chimney connection.

1.02 REFERENCE STANDARDS

- A. AHRI 1500 - Performance Rating of Commercial Space Heating Boilers; 2015.
- B. ASME BPVC-IV - Boiler and Pressure Vessel Code, Section IV - Rules for Construction of Heating Boilers; 2017.
- C. ASME BPVC-VIII-1 - Boiler and Pressure Vessel Code, Section VIII, Division 1 - Rules for Construction of Pressure Vessels; 2017.
- D. NEMA 250 - Enclosures for Electrical Equipment (1000 Volts Maximum); 2014.
- E. NFPA 54 - National Fuel Gas Code; 2018.
- F. UL (DIR) - Online Certifications Directory; Current Edition.

1.03 SUBMITTALS

- A. Product Data: Provide data indicating general layout, dimensions, and size and location of water, gas, and vent connections, and electrical characteristics and connection requirements.
- B. Manufacturer's Instructions: Submit manufacturer's complete installation instructions.

1.04 QUALITY ASSURANCE

- A. Manufacturer Qualifications: Company specializing in manufacturing the type of products specified in this section, with minimum three years of documented experience.

1.05 REGULATORY REQUIREMENTS

- A. Conform to applicable code code for internal wiring of factory wired equipment.
- B. Conform to ASME BPVC-IV and ASME BPVC-VIII-1 for boiler construction.
- C. Units: UL (DIR) listed and labeled.
- D. Products Requiring Electrical Connection: Listed and classified by UL (DIR) as suitable for the purpose specified and indicated.

1.06 DELIVERY, STORAGE, AND HANDLING

- A. Protect units before, during, and after installation from damage to casing by leaving factory shipping packaging in place until immediately prior to final acceptance.

PART 2 PRODUCTS

2.01 MANUFACTURERS

- A. Smith Cast Iron Boilers/Mestek, Inc: www.smithboiler.com/#sle.
- B. Viessmann
- C. Weil-McLain/SPX Corporation: www.weil-mclain.com/#sle. **Preferred Alternate (Addendum 03)**
- D. **Burnham (Addendum 03)**
- E. **Peerless (Addendum 03)**

2.02 PERFORMANCE REQUIREMENTS

- A. Performance rating shall be in accordance with AHRI 1500.
- B. Rating:
 - 1. Refer to Schedules on Drawings.

2.03 MANUFACTURED UNITS

- A. Hot Water Boilers: Suitable for forced draft with insulated jacket, sectional cast iron heat exchanger, natural gas burning system, refractory, controls, and boiler trim including circulator.
- B. Provide water wall design consisting of water backed combustion area with water circulating around firebox. Refractory chamber or separate base not required.
- C. Efficiency:
 - 1. Annual Fuel Utilization Efficiency: 0.80.

2.04 FABRICATION

- A. Assembly: Cast iron sections with 80 psig water ASME Boilers and Pressure Vessels Code rating, assembled with push nipples or gaskets and draw rods.
- B. Access: To flue passages for cleaning and flame observation ports.
- C. Jacket: Glass fiber insulated steel jacket, finished with factory applied baked enamel.

2.05 HOT WATER BOILER TRIM

- A. ASME rated pressure relief valve, 80 psig.
- B. Combination water pressure and temperature gauge.
- C. Low water cut-off to prevent burner operation when boiler water falls below safe level.
- D. Operating temperature controller with outdoor reset to maintain boiler water temperature.
- E. Electronic operating temperature controller:
 - 1. NEMA 250 Type 1 enclosure with full cover for wall mounting.
 - 2. Ambient temperature range -30 to 150 degrees F.
 - 3. Adjustable reset ratio of outside air temperature change to discharge control point change 1:2 to 100:1.
 - 4. Integral set point adjustment 80 to 230 degrees F.
 - 5. Electronic primary and outdoor sensors.
- F. High limit temperature controller with manual reset for burner to prevent boiler water temperature from exceeding safe system temperature.
- G. Boiler air vent.

2.06 FUEL BURNING SYSTEM

- A. Manufacturers:
 - 1. Webster *Preferred Alternate (Addendum 03)*
 - 2. Riello
 - 3. Weishaupt
- B. Burner Operation: Low-High-Low-Off with low fire position for ignition.
- C. Gas Burner: Atmospheric type for natural gas adjustable combustion air supply, pressure regulator, gas valves, manual shut-off, intermittent spark or glow coil ignition, flame sensing device, and automatic 100 percent shut-off.
- D. Gas Burner Safety Controls: Energize ignition, limit time for establishment of flame, prevent opening of gas valve until pilot flame is proven, stop gas flow on ignition failure, energize blower motor, and after air flow proven and slight delay, allow gas valve to open.
- E. Collector and Draft Hood: Stainless steel vent pipe and air intake.
- F. Controls: Pre-wired, factory assembled electronic controls in control cabinet with flame scanner or detector, programming control, relays, and switches. Provide pre-purge and post-purge

ignition and shut-down of burner in event of ignition pilot and main flame failure with manual reset.

PART 3 EXECUTION

3.01 INSTALLATION

- A. Install in accordance with manufacturer's instructions.
- B. Install boiler on concrete housekeeping base, sized minimum 4 inches larger than boiler base.
- C. Provide connection of natural gas service in accordance with requirements of NFPA 54 and applicable codes.
- D. Pipe relief valves to nearest floor drain.

3.02 SYSTEM STARTUP

- A. Provide the services of manufacturer's field representative for starting and testing unit.

3.03 CLOSEOUT ACTIVITIES

- A. Train operating personnel in operation and maintenance of units.

END OF SECTION 23 52 23

Trinity Middle School
Trinity, NC

Smith Sinnett / 2017032
Randolph County School System

FAN SCHEDULE

	MODEL	AIRFLOW (CFM)	ESP	HP	BHP/WATTS	FAN SPEED	MAX RPM	SCONES	VOLT	REMARKS
EF-01	CSP-A710-VG	450	0.60	n/a	236w	1,365	1,400	6.5	115	1,3,4,5
EF-02	G-095-VG	300	0.40	0.17	0.05	1,214	1,300	5.9	115	2,3,4,10,13
EF-03	G-095-VG	300	0.40	0.17	0.05	1,214	1,300	5.9	115	2,3,4,10,13
EF-04	G-095-VG	245	0.50	0.17	0.06	1,328	1,400	7.1	115	1,2,3,4
EF-05	CSP-A290	140	0.50	n/a	50w	913	1,000	3.5	115	1,3,4,5
EF-06	CSP-A700	560	0.50	n/a	198w	942	1,000	0.9	115	1,3,4,5
EF-07	CSP-A1410	1260	0.50	n/a	550w	1,345	1,450	2.5	115	3,4,5,7,13
EF-08	CSP-A290	250	0.50	n/a	75w	987	1,100	3.0	115	3,4,5,9
EF-09	CSP-A290	190	0.50	n/a	70w	964	1,100	3.0	115	1,3,4,5
EF-10	CSP-A700	610	0.50	n/a	237w	990	1,100	1.1	115	1,3,4,5
EF-11	G-099-VG	860	0.50	0.25	0.09	1,221	1,300	7.6	115	1,2,3,4
EF-12	CUE-141-VG	1260	0.50	0.25	0.24	1,020	1,100	8.7	115	2,3,4,7,13
EF-13	G-097-VG	70	0.50	0.25	0.18	996	1,100	8.2	115	1,3,4,5
EF-14	CUE-090-VG	300	0.50	0.1	0.06	1,393	1,450	6.5	115	2,3,4,9
EF-15	G-143-VG	1170	0.60	0.5	0.22	1,044	1,150	7.5	115	1,2,3,4
EF-16	G-103-VG	610	0.50	0.25	0.09	1,192	1,300	5.0	115	1,2,3,4
EF-17	CUE-141-VG	1180	0.50	0.25	0.18	996	1,100	8.2	115	2,3,4,7,13
EF-18	G-097-VG	140	0.50	0.25	0.18	1,219	1,300	6.5	115	1,2,3,4
EF-19	CUE-090-VG	300	0.50	0.1	0.06	1,393	1,450	6.5	115	2,3,4,9
EF-20	CSP-A1410	1170	0.50	n/a	457w	1,275	1,350	2.0	115	3,4,5,7,13
EF-21	CSP-A510	300	0.50	n/a	170w	1,059	1,150	3.5	115	3,4,5,9
EF-22	CSP-A290	140	0.50	n/a	50w	913	1,000	3.5	115	1,3,4,5
EF-23	CSP-A1410	1170	0.50	n/a	457w	1,275	1,350	2.0	115	3,4,5,7,13
EF-24	CSP-A1410	890	0.50	n/a	239w	1,068	1,150	1.2	115	1,3,4,5
EF-25	G-099-VG	610	0.50	0.25	0.10	1,260	1,300	7.9	115	1,2,3,4
EF-26	CUE-095-VG	360	0.50	0.17	0.07	1,373	1,450	6.8	115	2,3,4,10
EF-27	CSP-A290	180	0.50	n/a	32w	1,069	1,150	2.9	115	1,3,4,5
EF-28	CSP-A1410	850	0.60	n/a	239w	1,088	1,150	1.5	115	1,3,4,5
EF-29	G-097-VG	70	0.50	0.25	0.18	1,019	1,300	6.5	115	1,2,3,4
EF-30	SPA250	180	0.50	n/a	50w	900	1,050	3.0	115	3,4,5,10
EF-31	CUE-101HP-VG	600	1.00	0.5	0.25	2,033	2,100	12.1	115	2,3,4,12,13
EF-32	CUE-141-VG	1180	0.50	0.25	0.18	996	1,100	8.2	115	2,3,4,7,13
EF-33	SPA250	180	0.50	n/a	50w	900	1,050	3.0	115	3,4,5,10
EF-34	CUE-141-VG	1180	0.50	0.25	0.18	996	1,100	8.2	115	2,3,4,7,13
EF-35	G-123-VG	610	0.60	0.25	0.13	1,124	1,200	7.7	115	1,2,3,4
EF-36	REFER TO KITCHEN HOOD DRAWINGS									0
EF-37	CUE-141-VG	1260	0.50	0.5	0.20	1,020	1,100	8.7	115	2,3,4,7,13
EF-38	CW-099-VG	750	0.30	0.25	0.1	1,276	1,350	7.3	115	3,4,14
EF-39	CSP-A290	210	0.50	n/a	81w	1,011	1,050	2.5	115	3,4,5
EF-40	G-090-VG	250	0.40	0.17	0.05	1,214	1,300	5.9	115	2,3,4,10,13
EF-41	REFER TO KITCHEN HOOD DRAWINGS									0

GENERAL NOTES:

- PROVIDE DUCT TRANSITIONS FOR ALL FANS.
- FOR EXTERIOR FANS, THE UNIT HOUSING SHALL BE CONSTRUCTED OF ALUMINUM.
- ALL FANS SHALL BE UL LISTED AND AMCA CERTIFIED.
- PROVIDE WITH UNIT MOUNTED DISCONNECT SWITCH OR INTEGRAL PLUG DISCONNECT (FOR IN-LINE FANS).
- EXTERNALLY OR INTERNALLY MOUNTED DISCONNECT SWITCH FURNISHED BY HVAC CONTRACTOR TO BE INSTALLED BY ELECTRICAL CONTRACTOR.
- EXTERNALLY MOUNTED STARTER FURNISHED BY CONTROLS CONTRACTOR INSTALLED BY THE ELECTRICAL CONTRACTOR.
- PROVIDE OVERLOAD PROTECTION FOR ALL FANS, COORDINATE WITH ELECTRICAL CONTRACTOR.
- PROVIDE SPEED CONTROLLERS FOR ALL DIRECT DRIVE FANS.
- FOR ALL ROOF MOUNTED FANS, BOTH THE FAN AND CURB SHALL BE RATED FOR THE PROJECT WIND ZONE.
- BASES OF DESIGN IS GREENHECK, EQUIVALENTS BY LOREN COOK, PENN. TWIN CITY, OR EQUIVALENT.

REMARKS:

- CONTROL FAN WITH DDC SYSTEM, CONSULT OWNER FOR SCHEDULING.
- PROVIDE WITH 4" HIGH RIBBED CURB, CURBS SHALL BE COMPATIBLE WITH THE ROOFING SYSTEM, ALL ROOF CURBS AND ATTACHMENT METHODS TO FANS SHALL BE RATED FOR THE PROJECT WIND ZONE.
- FACTORY WIND TESTED, 1/2" TOGGLE, MOUNTED AND WIRED.
- PROVIDE GRAVITY OPERATED DAMPER.
- PROVIDE HANGING VIBRATION ISOLATION KIT.
- CONTROL FAN WITH KITCHEN HOOD SYSTEM, FAN STATUS SHALL BE MONITORED BY DDC SYSTEM.
- FAN CONTROLLED BY MANUAL TWIST TIMER.
- PROVIDE WITH INTEGRAL PRESSURE SENSING SWITCH AND WALL MOUNTED INDICATOR TO START FAN ON INDICATION OF DRYER RUNNING.
- FAN SHALL BE CONTROLLABLE BY DDC SYSTEM, BUT SHALL BE SCHEDULED TO RUN CONTINUOUSLY.
- FAN REFERRED BY LINE VOLTAGE THERMOSTAT.
- REFER TO KITCHEN HOOD DRAWINGS, FAN IS KEF-1.
- INTERLOCK FAN WITH DISHWASHER OPERATION.
- MONITOR FAN STATUS WITH DDC SYSTEM.
- PROVIDE SIDEWALL MOUNTING KIT.

MECHANICAL SUMMARY

MECHANICAL SYSTEMS, SERVICE SYSTEMS AND EQUIPMENT

CODE	2018 NC ENERGY CODE:	ASHRAE 90.1-2013:	PRESCRIPTIVE:	PERFORMANCE:
			<input checked="" type="checkbox"/>	

ADDITIONAL PRESCRIPTIVE COMPLIANCE:

- 506.2.1 MORE EFFICIENT MECHANICAL EQUIPMENT
- 506.2.2 REDUCED LIGHTING POWER DENSITY
- 506.2.3 ENERGY RECOVERY VENTILATION SYSTEMS
- 506.2.4 HIGHER EFFICIENCY SERVICE WATER HEATING
- 506.2.5 ON-SITE SUPPLY OF RENEWABLE ENERGY
- 506.2.6 AUTOMATIC DAYLIGHTING CONTROLS

THERMAL ZONE: 4A

WINTER DRY BULB:	20.0 DEGREES F
SUMMER DRY BULB:	84.0 DEGREES F
SUMMER WET BULB:	74.3 DEGREES F
SUMMER HRM/CDB:	129.5 / 81.2 DEGREES F

INTERIOR DESIGN CONDITIONS

WINTER DRY BULB:	70 DEGREES F
SUMMER DRY BULB:	75 DEGREES F
RELATIVE HUMIDITY:	55 %

BUILDING HEATING LOAD:

3,426 MBH

BUILDING COOLING LOAD:

373 TONS

MECHANICAL SPACING CONDITIONING SYSTEM


UNITARY

DESCRIPTION OF UNIT:	REFER TO SCHEDULES ON DRAWINGS
HEATING EFFICIENCY:	
COOLING EFFICIENCY:	
SIZE CATEGORY OF UNIT:	

BOILER:	TOTAL BOILER OUTPUT, IF OVERSIZED, STATE REASON.	4,454 MBH
CHILLER:	TOTAL CHILLER CAPACITY, IF OVERSIZED, STATE REASON.	390 TONS

REFER TO EQUIPMENT SCHEDULES FOR UNIT EFFICIENCIES:

DESIGNER STATEMENT:
TO THE BEST OF MY KNOWLEDGE AND BELIEF, THE DESIGN OF THIS BUILDING COMPLIES WITH THE MECHANICAL SYSTEMS, SERVICE SYSTEMS AND EQUIPMENT REQUIREMENTS OF THE NORTH CAROLINA STATE ENERGY CODE.

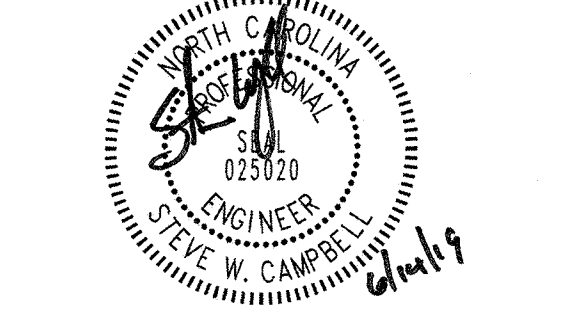

NAME: STEVE W. CAMPBELL, P.E.

BOILER SCHEDULE

BOILERS B-01 & B-02

WELL-MCLAIN WATER BOILER, 88 SERIES 1088, 3,082 GAS INPUT, 2,227 MBH WATER OUTPUT, 88.1% THERMAL EFFICIENCY, 115 GPM WITH MAXIMUM 1.0 PSI PRESSURE DROP. BURNERS SHALL HAVE LOW OIL-FLOW-OFF, PROTECT START, AND ELECTRONIC DIRECT SPARK IGNITION. PROVIDE 50 PSI ASME RELIEF AND LOW WATER CUTOFF. GAS FRED, BUILT IN AIR ELIMINATOR. WEBSTER 1.5 HP BUFFER OPERATION. PROVIDE SUCTION AND DISCHARGE SERVICE VALVE FOR EACH COMPRESSOR. PROVIDE SINGLE POINT 480 VOLT POWER CONNECTION THAT FEEDS CHILLER AND PRIMARY PUMP AND PROVIDE AN ADDITIONAL 120 VOLT POWER CONNECTION FOR THE EVAPORATOR HEAT TAP. TEAD CONDENSER FAN MOTORS. PROVIDE FACTORY MOUNTED AND WIRED CONTROL TRANSFORMER. FACTORY MOUNT AND WIRE EVAPORATOR HEAT FOR FREEZE PROTECTION TO 20°F. PROVIDE CONTROL PANEL THAT PROVIDES CHILLED WATER SETPOINT ADJUSTMENT AND DEMAND LIMITING VIA A 4-20MA INPUT. PROVIDE HIGH SHORT CIRCUIT CURRENT RATED CONTROL PANEL. CONTROL PANEL SCR RATING SHALL BE MINIMUM 50A. PROVIDE LOWVOLTAGE BACNET CONTROL INTERFACE. 460/380, MCA = 285, MOP = 300, GPM = 253 AT 16 FT PRESSURE DROP AT 45°F EVT AND 57°F LWT. WEIGHT = 780 LBS. MINIMUM EVAPORATOR FLOW = 147 GPM. EQUALS BY YORK, CARRIER AND DAIKIN, OR AS LISTED IN SPECIFICATIONS. PROVIDE EPOXY COATING ON ALL COLS FOR SEACAST CORROSION PROTECTION. CORROSION DURABILITY SHALL BE CONFIRMED THROUGH TESTING TO NO LESS THAN 5,000 HOURS SALT SPRAY PER ASTM B11740 USING SCRIBED ALUMINUM TEST COUPONS. PROVIDE FACTORY PUMP PACKAGE WITH TWO PUMPS, VFD, DRAINAGE VALVES, SHUT-OFF VALVES, AND LEAVING CONNECTIONS. PUMP PACKAGE SHALL BE SINGLE POINT INTEGRATED INTO THE CHILLER PACKAGE WITH A SEPARATE FACTORY WIRED CONTROL PANEL. THE CONTROL OF THE PUMPS SHALL BE INTEGRATED INTO THE CHILLER CONTROLLER. FREEZE PROTECTION DOWN TO AN AMBIENT OF -20°F SHALL BE PROVIDED. THE PUMP PACKAGE SHALL BE INSULATED. ONE REDUNDANT PUMP - THE CHILLER CONTROLS BOTH PUMPS THROUGH A LEADLAG AND FAILURE RECOVERY FUNCTIONALITY.

BOILER STACKS

14" DIAMETER METAL-BESSETT INSULATED DOUBLE WALL 304 STAINLESS STEEL METAL STACK SUITABLE FOR FORCED DRAFT BOILER. STACK SHALL INCLUDE ALL DUCTS, ELBOWS, FLANGES, TRIM RINGS FOR CEILING PENETRATION AND A ROOF CAP. COMPLYING WITH UL 103 AND NFPA 211. EQUIVALENTS BY AMPCO OR VAN PACKER.

ROOF VENT SCHEDULE

MARK	MODEL	AIRFLOW (CFM)	ESP	SERVICE	THROAT AREA (SF)	SIZE	THROAT FPM	WEIGH T	REMARKS
RV-A1	FGI	14550	0.12	INTAKE	18.0	48x54	951	280	
RV-A2	FGI	14550	0.12	INTAKE	18.0	48x54	951	280	
RV-B1	FGI	12650	0.09	INTAKE	18.0	48x54	828	280	
RV-B2	FGI	12650	0.09	INTAKE	18.0	48x54	828	280	
RV-C	FGI	4000	0.08	INTAKE	7.5	20x24	793	120	
RV-F	FGI	9500	0.12	INTAKE	19.5	48x48	981	280	

GENERAL NOTES:

- PROVIDE 18 INCH ROOF CURB
- PROVIDE ALUMINUM BIRDSCREEN
- PROVIDE ALL TRANSITIONS FROM ROOF VENT INLET. MOTORIZED ALUMINUM DAMPERS SHALL BE PROVIDED BY THE CONTROLS CONTRACTOR
- PROVIDE BACKED ENAMEL FINISH. COLOR SHALL BE SELECTED BY ARCHITECT
- BASES OF DESIGN IS GREENHECK, EQUIVALENTS BY TWIN CITY, LOREN COOKE, OR EQUIVALENT.

CHILLER SCHEDULE

CHILLERS CH-01 & CH-02 & CH-03

TRANE AIR COOLED SCROLL CHILLER, MODEL 46CA100, REFRIGERANT R-410A, 126 FULL LOAD TONS, 147 KW, AND 1500 CFM AIR FLOW. PROVIDE WITH MAXIMUM 1.0 PSI PRESSURE DROP. BURNERS PANELS AROUND COMPLETE UNIT WITH LOW SOUND FANS. THE OVERALL A WEIGHTED SOUND POWER LEVEL SHALL NOT EXCEED 88 DB AFTER ATTENUATION, AS MEASURED PER ARI STANDARD 370. PROVIDE HIGH AMBIENT OPTION REQUIRED FOR 20-125°F OPERATION. PROVIDE SUCTION AND DISCHARGE SERVICE VALVE FOR EACH COMPRESSOR. PROVIDE SINGLE POINT 480 VOLT POWER CONNECTION THAT FEEDS CHILLER AND PRIMARY PUMP AND PROVIDE AN ADDITIONAL 120 VOLT POWER CONNECTION FOR THE EVAPORATOR HEAT TAP. TEAD CONDENSER FAN MOTORS. PROVIDE FACTORY MOUNTED AND WIRED CONTROL TRANSFORMER. FACTORY MOUNT AND WIRE EVAPORATOR HEAT FOR FREEZE PROTECTION TO 20°F. PROVIDE CONTROL PANEL THAT PROVIDES CHILLED WATER SETPOINT ADJUSTMENT AND DEMAND LIMITING VIA A 4-20MA INPUT. PROVIDE HIGH SHORT CIRCUIT CURRENT RATED CONTROL PANEL. CONTROL PANEL SCR RATING SHALL BE MINIMUM 50A. PROVIDE LOWVOLTAGE BACNET CONTROL INTERFACE. 460/380, MCA = 285, MOP = 300, GPM = 253 AT 16 FT PRESSURE DROP AT 45°F EVT AND 57°F LWT. WEIGHT = 780 LBS. MINIMUM EVAPORATOR FLOW = 147 GPM. EQUALS BY YORK, CARRIER AND DAIKIN, OR AS LISTED IN SPECIFICATIONS. PROVIDE EPOXY COATING ON ALL COLS FOR SEACAST CORROSION PROTECTION. CORROSION DURABILITY SHALL BE CONFIRMED THROUGH TESTING TO NO LESS THAN 5,000 HOURS SALT SPRAY PER ASTM B11740 USING SCRIBED ALUMINUM TEST COUPONS. PROVIDE FACTORY PUMP PACKAGE WITH TWO PUMPS, VFD, DRAINAGE VALVES, SHUT-OFF VALVES, AND LEAVING CONNECTIONS. PUMP PACKAGE SHALL BE SINGLE POINT INTEGRATED INTO THE CHILLER PACKAGE WITH A SEPARATE FACTORY WIRED CONTROL PANEL. THE CONTROL OF THE PUMPS SHALL BE INTEGRATED INTO THE CHILLER CONTROLLER. FREEZE PROTECTION DOWN TO AN AMBIENT OF -20°F SHALL BE PROVIDED. THE PUMP PACKAGE SHALL BE INSULATED. ONE REDUNDANT PUMP - THE CHILLER CONTROLS BOTH PUMPS THROUGH A LEADLAG AND FAILURE RECOVERY FUNCTIONALITY.

THE CHILLER MANUFACTURER SHALL PROVIDE A NOISE REDUCTION SYSTEM TO LIMIT THE CHILLER NOISE AND MEET OR BE LESS THAN AN NC LEVEL OF 26 WITHIN THE BAND AND ORCHESTRA ROOMS ADJACENT TO THE CHILLER YARD WITH ALL THREE CHILLERS RUNNING SIMULTANEOUSLY. REFER TO ARCHITECT DRAWINGS FOR CHILLER YARD WITH ALL THREE CHILLERS RUNNING SIMULTANEOUSLY. PROVIDE A NOISE REDUCTION SYSTEM NOT LIMITED TO HUSH COVER™ REMOVABLE INSULATION COVERS FOR THE CHILLER COMPRESSORS. DISCHARGE SUCTION LINE AND OIL SEPARATORS, OUTDOOR GRAVE HIGH CURE™ ACUSTICAL INSULATION BLANKETS MANUFACTURED WITH TANERA GORE™ THREAD AND VINYL COATED POLYESTER MATERIALS RATED FOR 20+ YEAR OUTDOOR LIFE WHEN PROPERLY ANCHORED TO A SOLID CONCRETE ARCHITECTURAL BARRIER (SUCH AS BRICK BARRIER WALL BY OTHERS), HUSH DUCT™ ACUSTICAL LOUVERS ATTACHED TO THE COMPRESSOR AND CONDENSER SECTION, HUSH GUARD™ ACUSTICAL METAL PANELS SURROUNDING THE CHILLER CONDENSER FANS AND/OR THE ENTIRE CHILLER. THE NOISE REDUCTION SYSTEM SHALL BE MANUFACTURED BY A COMPANY SPECIALIZING IN THE MANUFACTURE OF SUCH PRODUCTS AND RELATED ACCESSORIES WITH NOT LESS THAN 20 YEARS DOCUMENTED SUCCESSFUL EXPERIENCE WITH WORK COMPARABLE TO WORK OF THIS PROJECT. ALL NOISE CONTROL MATERIALS MANUFACTURERS SHALL DELIVER A COMPLETE SUBMITTAL INCLUDING A COPY OF AN ACUSTICAL REPORT IN COMPLIANCE WITH THE ACUSTICAL PERFORMANCE AS PER THIS SPECIFICATION AND THE COMPLETED SYSTEM SHALL RESULT IN A CHILLER DEGRADATION OF NO MORE THAN 25%. THE COMPLETE NOISE REDUCTION SYSTEM SHALL BE INSTALLED BY THE NOISE MATERIALS MANUFACTURER TO ENSURE GUARANTEED AND MEET THE ACUSTICAL PERFORMANCE AS PER THIS SPECIFICATION. CHILLER MANUFACTURERS FACTORY ATTENUATION PACKAGES ARE NOT ACCEPTABLE. CHILLER MANUFACTURERS LOW NOISE FANS ARE ACCEPTABLE. BPO NOISE AND VIBRATION CONTROL, INC., LOTS 4 AND 10/NETS ARE INTERESTED IN PROVIDING AN ACCEPTABLE SUPPLIER OF THESE PRODUCTS AND SERVICES. THE OWNER WILL RETAIN THE SERVICES OF A THIRD PARTY TO PERFORM SOUND MEASUREMENTS ON THE COMPLETE SYSTEM TO VERIFY COMPLIANCE WITH REQUIREMENTS OF THIS SPECIFICATION. IF OVERALL SOUND PRESSURE LEVEL (SPL) RESULTS DO NOT MEET THE REQUIREMENTS OF THIS SPECIFICATION, THEN THE CHILLER MANUFACTURER/VENDOR SHALL SUPPLY ADDITIONAL SOUND ATTENUATION AND FACTORY MODIFICATIONS TO MEET THIS REQUIREMENT AT NO ADDITIONAL COST TO THE OWNER.

AIR DISTRIBUTION SCHEDULE

MARK	PURPOSE	MIN FLOW (CFM)	MAX FLOW (CFM)	DUCT SIZE	MAKE	MODEL	REMARKS
A	SUPPLY	40	100	24x24	6"	PRICE	ASPD 1,2,3
B	SUPPLY	105	230	24x24	8"	PRICE	ASPD 1,2,3
C	SUPPLY	235	375	24x24	10"	PRICE	ASPD 1,2,3
D	SUPPLY	380	550	24x24	12"	PRICE	ASPD 1,2,3
E	SUPPLY	50	180	8x6	8x6	PRICE	620 1,6
F	SUPPLY	185	250	10x8	10x8	PRICE	620 1,6
G	SUPPLY	300	350	14x8	14x8	PRICE	620 1,6
H	SUPPLY	405	525	16x8	16x8	PRICE	620 1,6
J	SUPPLY	305	400	4 SLOT	10"	PRICE	SDS 100 1,7
K	SUPPLY	555	700	24x24	14"	PRICE	ASPD 1,2,3
R	RETURN/EXHAUST	40	100	24x24	6"	PRICE	APDOR 1,2,3,4
RR	RETURN/EXHAUST	100	1212	6"	PRICE	APDOR 1,2,3,4	
S	RETURN/EXHAUST	0	225	24x24	8"	PRICE	APDOR 1,2,3,4
T	RETURN/EXHAUST	230	375	24x24	10"	PRICE	APDOR 1,2,3,4
U	RETURN/EXHAUST	380	555	24x24	12"	PRICE	APDOR 1,2,3,4
V	RETURN/EXHAUST	500	850	24x24	14"	PRICE	APDOR 1,2,3,4
W							

MISCELLANEOUS POINTS AND SEQUENCES

EXHAUST FAN CONTROL

EXHAUST FANS SHALL BE CONTROLLED BY THE BAS, VIA PRE-PROGRAMMED SCHEDULE, EXCEPT WHERE INDICATED ON THE FAN SCHEDULE.

OCCUPIED PERIOD:
FANS SHALL OPERATE VIA METHOD AS LISTED IN THE FAN SCHEDULE (BAS, T-STAT, ETC.) FANS CONTROLLED BY INDIVIDUAL THERMOSTAT DO NOT REQUIRE BAS CONNECTION

UN-OCCUPIED PERIOD:
FANS ARE OFF, EXCEPT WHERE INDICATED ON THE SCHEDULE

PREPARATORY PERIOD:
FANS ARE OFF, EXCEPT WHERE INDICATED ON THE SCHEDULE

EXHAUST FANS SHALL BE INTERLOCKED TO OPERATE WITH THEIR RESPECTIVE AIR HANDLING UNIT. EXHAUST FANS IN MECHANICAL ROOMS SHALL BE CONTROLLED BY LOCAL THERMOSTAT. FANS SHALL TURN ON WHEN TEMPERATURE RISES ABOVE SETPOINT. ON A DROP BELOW SETPOINT, FAN SHALL TURN OFF.

THE BAS SHALL GENERATE AN ALARM WHENEVER THE STATUS OF A FAN DOES NOT MATCH THE COMMAND.

LIGHTING CONTROL

THE BAS CONTRACTOR SHALL PROVIDE WIRING TO LIGHTING CONTACTORS SPECIFIED AND INDICATED ON THE ELECTRICAL DRAWINGS.

THE BAS CONTRACTOR SHALL PROVIDE OUTPUTS TO CONTROL LIGHTING RELAYS AND CONTACTORS. LIGHTING CIRCUITS SHALL BE CONTROLLED VIA USER ADJUSTABLE SCHEDULES WITHIN THE BAS BASED ON TIME OF DAY AND 365-DAY CALENDAR SCHEDULE.

REFER TO ELECTRICAL DRAWINGS AND SPECIFICATIONS FOR LIGHTING CONTROL REQUIREMENTS.

REFER TO SPECIFICATIONS SECTION 26 09 23 FOR PROGRAMMING REQUIREMENTS.

REFER TO LIGHTING DRAWINGS FOR OVERRIDE SWITCHES. REFER TO ELECTRICAL DRAWINGS FOR LOCATIONS, CONTROLS CONTRACTOR IS RESPONSIBLE FOR PROVIDING THE OVERRIDE SWITCHES, FACE PLATES, LOW VOLTAGE RACEWAY, AND PROGRAMMING. FACE PLATES SHALL MATCH DIVISION 26 SPECIFICATIONS, MATERIAL, AND COLOR. RACEWAY AND BOXES ASSOCIATED WITH OVERRIDE SWITCHES BY DIVISION 26.

DUCTLESS SPLIT SYSTEMS

DUCTLESS SPLIT SYSTEMS SHALL HAVE WALL MOUNTED CONTROLS IN THEIR RESPECTIVE ROOMS. UNITS ARE COOLING ONLY AND SHALL OPERATE AS REQUIRED TO KEEP ROOMS AT SETPOINT.

THE BAS CONTRACTOR SHALL PROVIDE A SEPARATE WALL MOUNTED TEMPERATURE SENSOR IN EACH ROOM CONTAINING A DUCTLESS SPLIT SYSTEM TO MONITOR THE TEMPERATURE ONLY. PROVIDE A HIGH LIMIT TEMPERATURE ALARM (85°F, ADJ)

TREND LOGS

PROVIDE TREND LOGS FOR BOILER OPERATION, CHILLER OPERATION, COOLING TOWER OPERATION, HOT AND CHILLED WATER PUMP OPERATION, AND AIR HANDLING UNIT OPERATION.

PROVIDE TREND LOGS FOR ALL VAV BOX OPERATION.

PROVIDE TREND LOGS FOR ALL RESET REQUESTS.

TREND ALL TEMPERATURE, PRESSURE, AND EQUIPMENT CHANGES OF STATE.

MAINTENANCE MANAGEMENT

THE DDC SYSTEM SHALL MEASURE AND RECORD RUN TIME FOR ALL START/STOP POINTS IN THE SYSTEM. BASED UPON THE ACCUMULATED RUN TIME, PROVIDE MAINTENANCE MESSAGES ON THE INTERVAL RECOMMENDED BY THE EQUIPMENT MANUFACTURERS. ANY DIGITAL INPUT POINT THAT IS USED FOR MAINTENANCE PURPOSES (I.E. DIRTY FILTER) SHALL ALSO GENERATE A MAINTENANCE MESSAGE. ALL MAINTENANCE MESSAGES ARE TO BE SENT VIA EMAIL TO COUNTY'S FACILITY MAINTENANCE DIRECTOR OR SOMEONE ELSE OF HIS CHOOSING.

TROUBLE ALARMS

THE CONTROL SUBCONTRACTOR SHALL ESTABLISH A TROUBLE HIGH AND TROUBLE LOW ALARM LIMIT FOR EACH ANALOG INPUT, EQUIPMENT STATUS AND ANNUNCIATE A CORRESPONDING ALARM MESSAGE AT THE CONTROLS FRONT END.

MODIFICATION

ALL SOFTWARE SETPOINTS, LIMITS, ALARMS, MESSAGES, SCHEDULES, SEQUENCES, ETC., AS SPECIFIED HEREIN ARE TO PROVIDE AN INITIAL SETUP OF THE CONTROLS SYSTEM. THE CONTROLS SUBCONTRACTOR SHALL PROVIDE SOFTWARE CUSTOMIZATIONS REQUIRED TO "TUNE" THE DDC SYSTEM TO ACCURATELY RESPOND TO ACTUAL BUILDING PARAMETERS. FURTHER, THESE SOFTWARE FUNCTIONS SHALL BE READILY MODIFIABLE BY THE OWNER'S PERSONNEL AS CHANGES IN BUILDING OPERATION DICTATE.

UNIT HEATERS

UNIT HEATER: BUILT-IN THERMOSTAT SHALL MAINTAIN ITS SETPOINT OF 55°F (ADJ.) BY STARTING THE UNIT HEATER. ONCE THE UNIT HEATER IS ENERGIZED, IT WILL RUN FOR AT LEAST FIVE (5) MINUTES TO AVOID SHORT CYCLING. NO BAS MONITORING OR CONTROL IS REQUIRED FOR UNIT HEATERS.

MISCELLANEOUS POINTS

BAS SHALL MONITOR ELEVATOR SUMP PUMP OPERATION AND ALARMS.

RELIEF AIR DAMPERS IN MECHANICAL ROOMS SHALL HAVE MULTIPLE DAMPER SECTIONS. EACH SECTION SHALL BE OPENED (STAGED) TO MAINTAIN A SLIGHT POSITIVE PRESSURE IN THE ROOM.











WATER HEATER AND RECIRCULATION PUMP CONTROL

BAS SHALL ENABLE AND DISABLE RECIRCULATION PUMPS FOR OCCUPIED AND UNOCCUPIED TIMES. REFER TO PLUMBING DRAWINGS FOR NUMBER AND LOCATION OF PUMPS.

THE BAS WILL GENERATE AN ALARM IF THE PUMP FAILS TO RUN.

WALK-IN COOLER AND FREEZER

BAS SHALL MONITOR THE TEMPERATURES IN THE KITCHEN WALK-IN COOLER AND FREEZER. A HIGH LIMIT ALARM (ADJ) SHALL BE ESTABLISHED FOR EACH. WHEN THE TEMPERATURE EXCEEDS THE HIGH LIMIT, AN ALARM SHALL BE DISPLAYED AT THE FRONT END GRAPHIC.

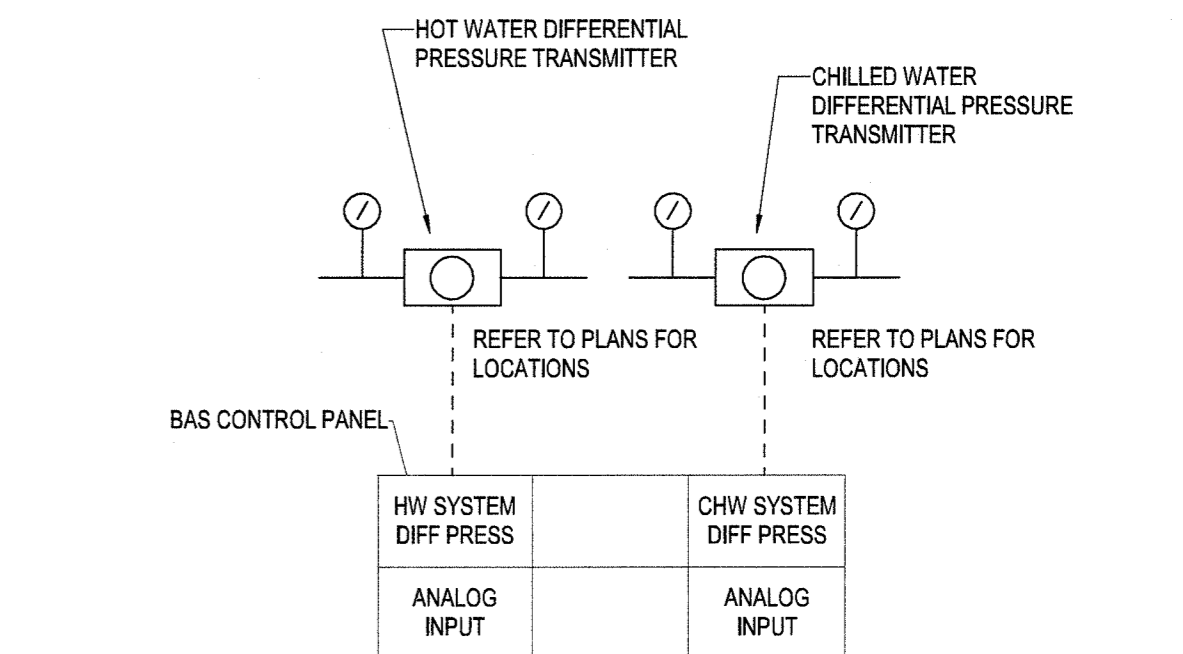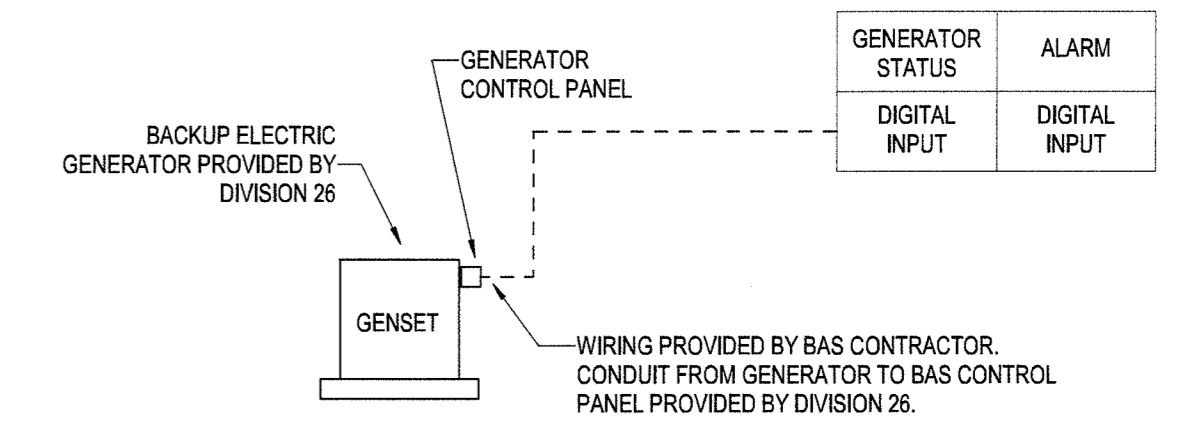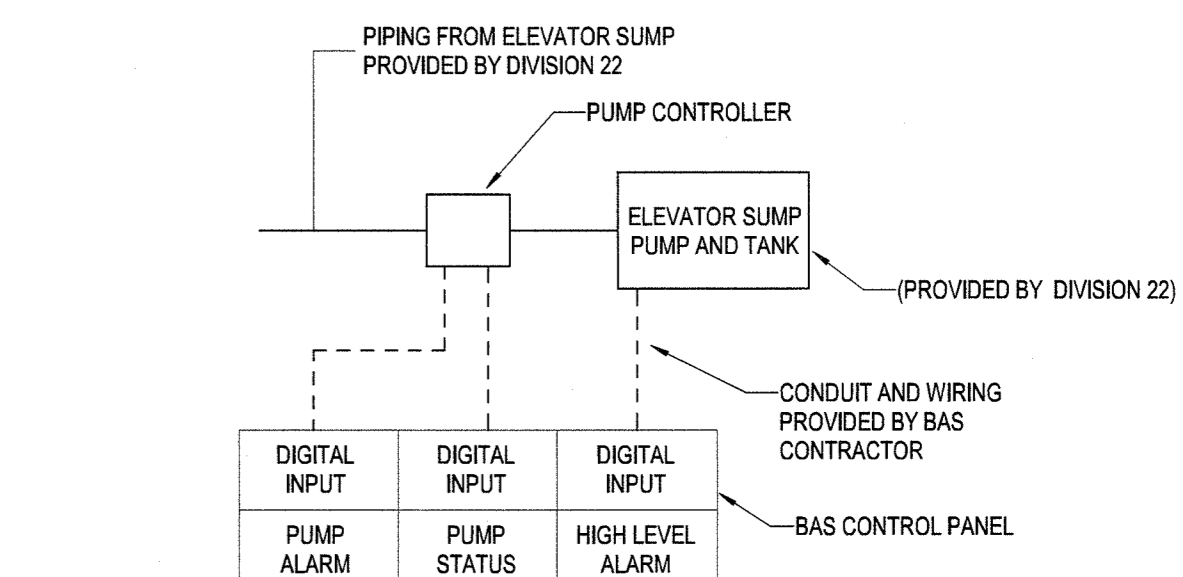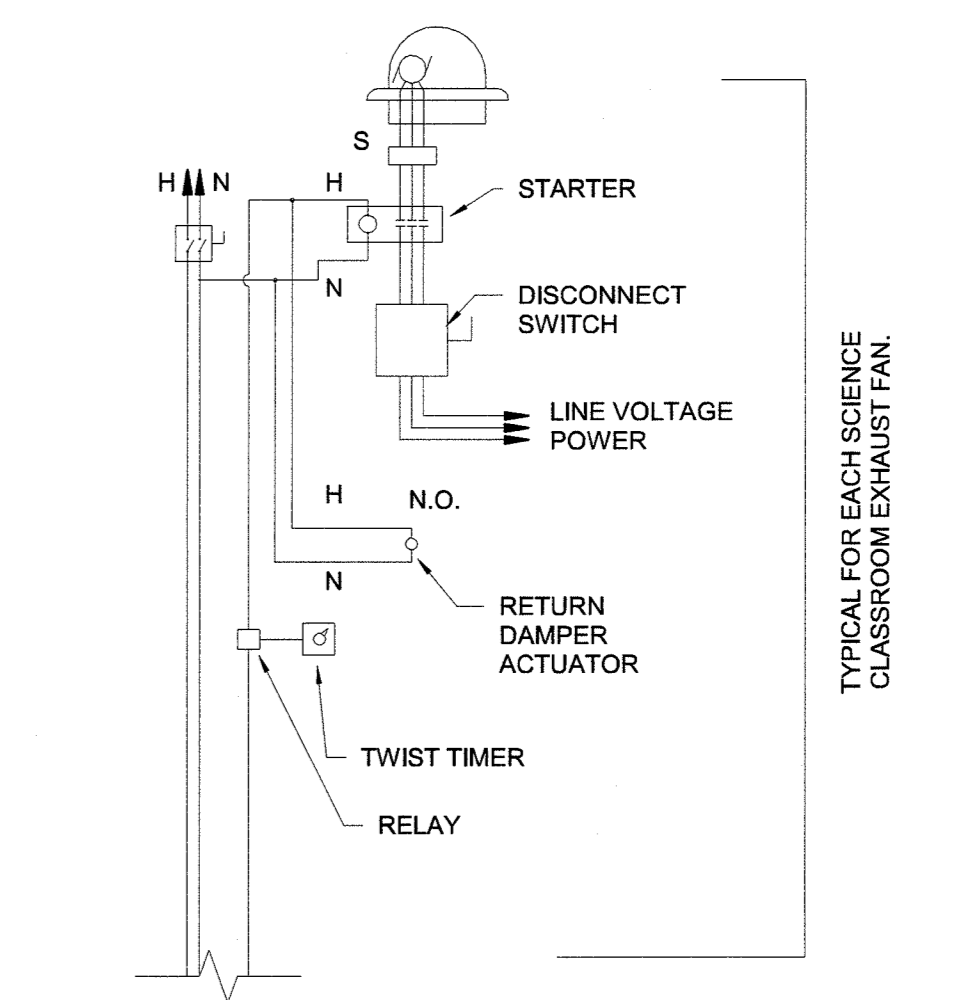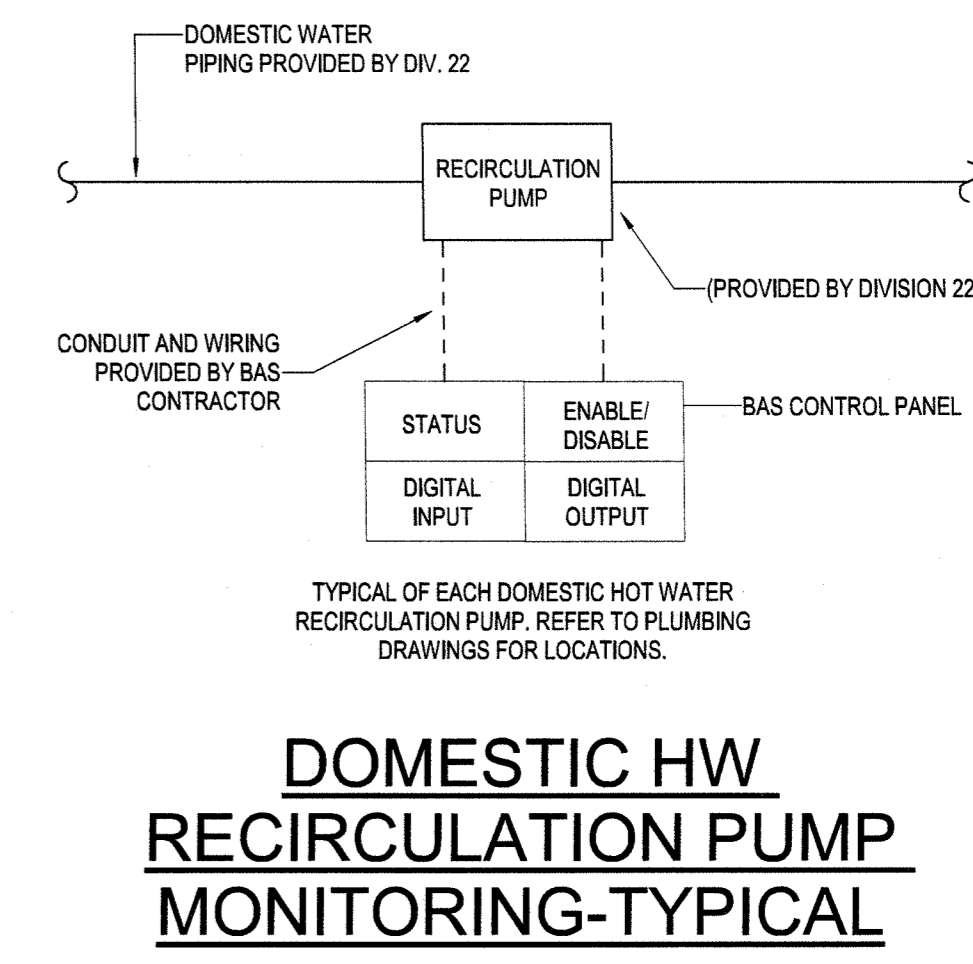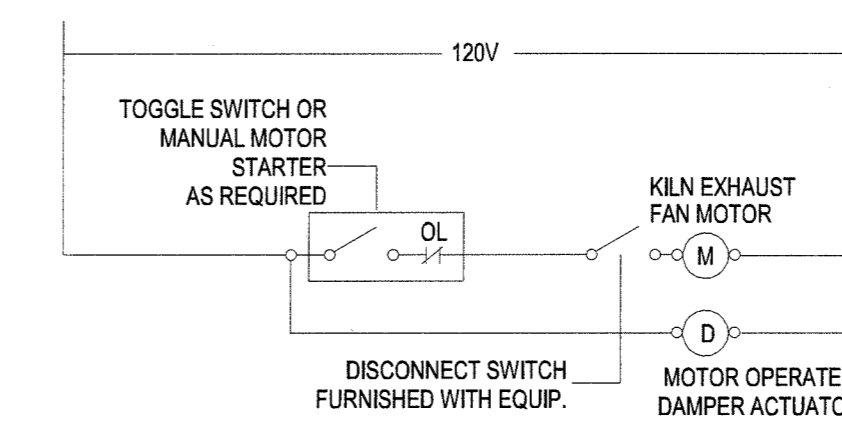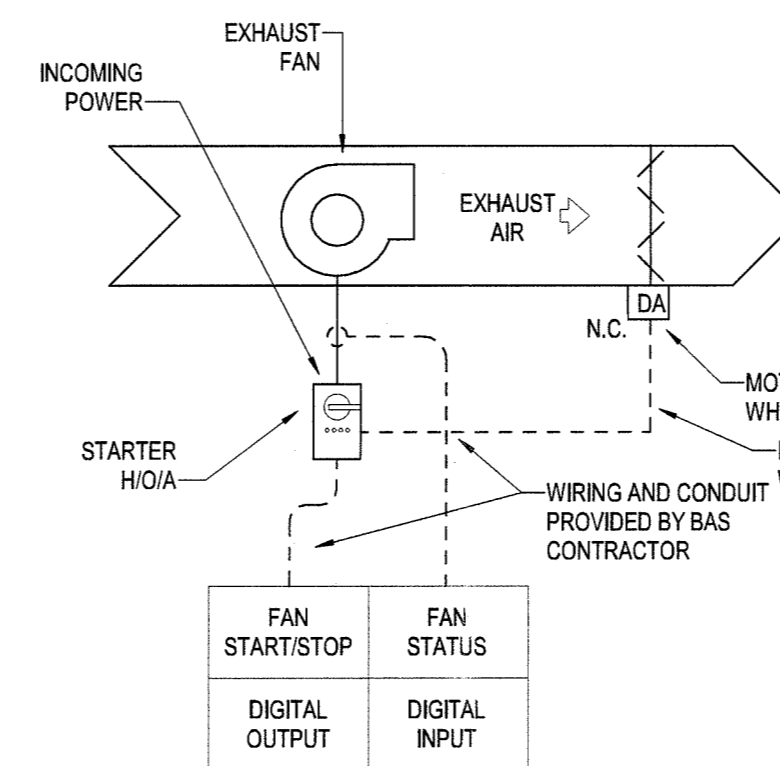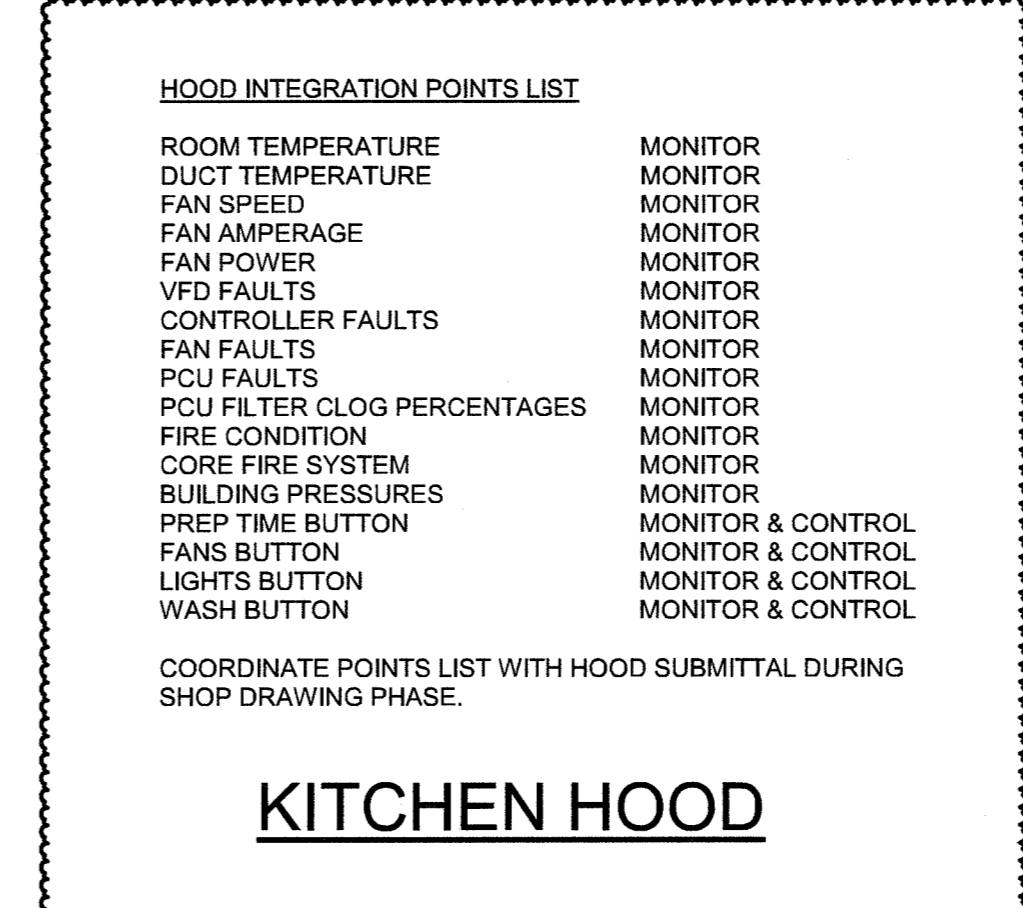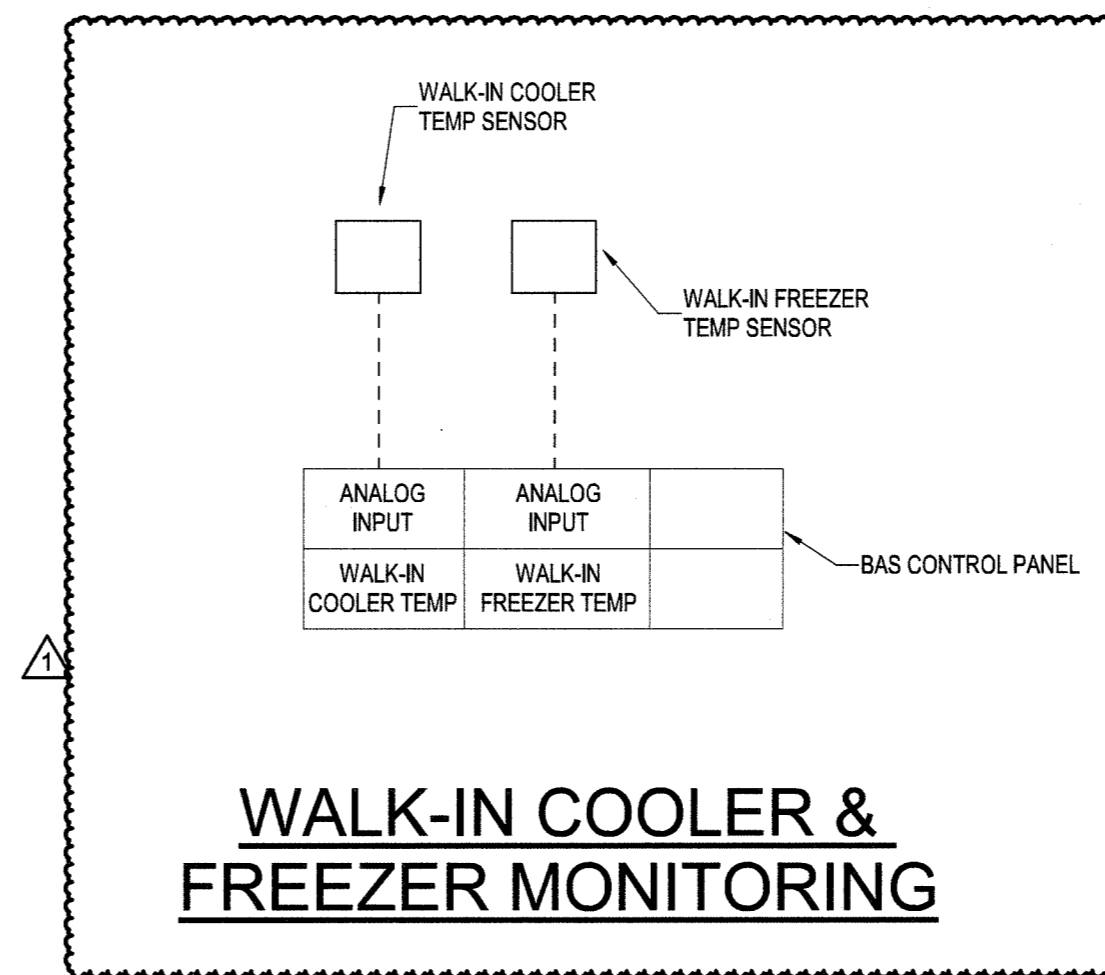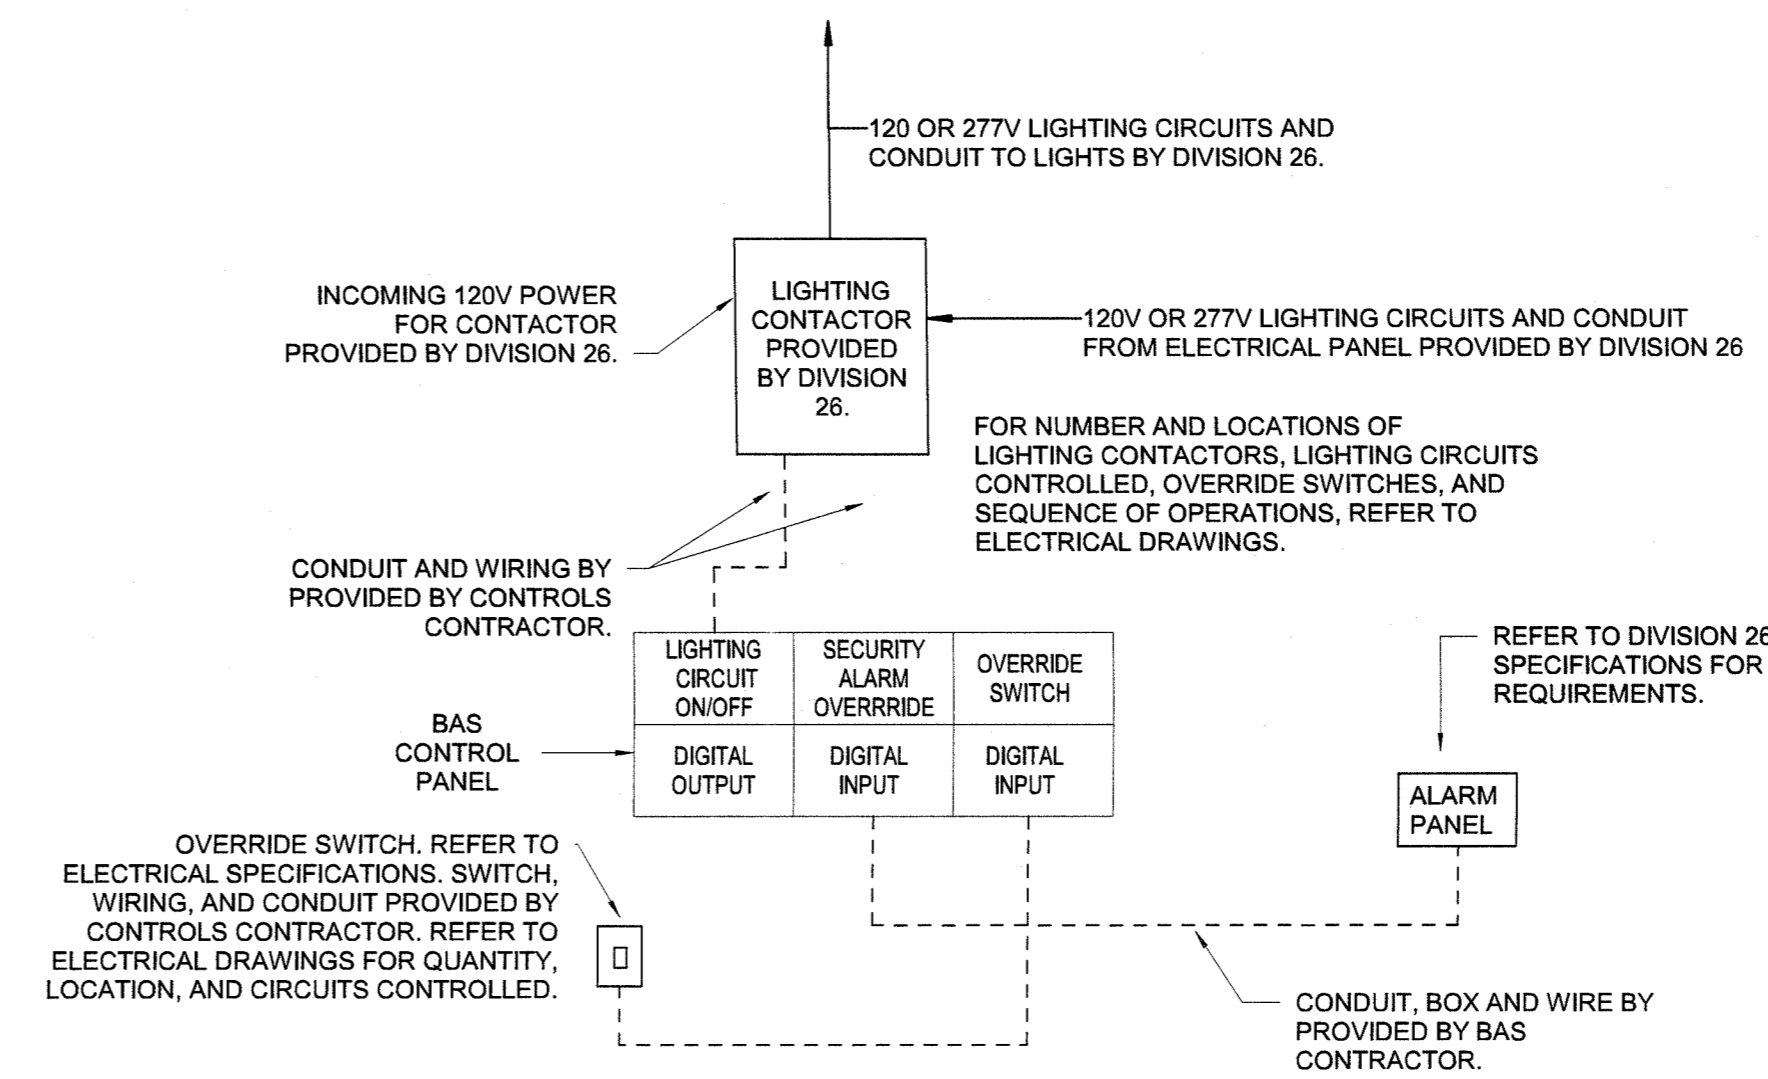




Progressive Design Collaborative, Ltd
3101 Poplarwood Court, Suite 320
Raleigh, North Carolina 27604
919-790-9989

ADDENDUM 03 – ELECTRICAL

DATE: June 14, 2019
PROJECT: Trinity Middle School
PDC Project # 17104

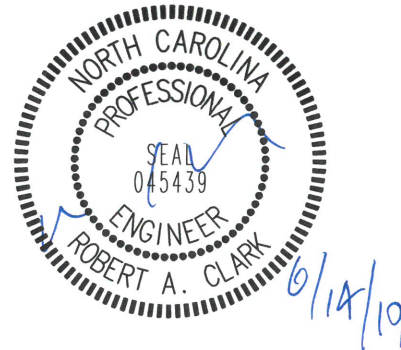

This Addendum, applicable to the work designed below, shall be understood to be and is a change to the bid documents and shall be part of and included in the contract for the above referenced project. All General, Supplementary and Special Conditions, etc., as originally specified or as modified below shall apply to these items.

Changes to Electrical Specifications:

Specification 26 43 00, Page 2, Part 2, 2.01

- Added: Manufacturer SSI (An ILSCO Company)

Specification 26 77 62, Page 1

- Clarified Sound System shall be provided under the Base Bid and be 100% complete and operational upon project completion.

Changes to Electrical Drawings:

Drawing E0-07

- Revised: Dimming Riser Detail 06 to clarify 11 fixtures, Room Reference and Control Console model.

Drawing E1-01

- Revised: Switch locations in Vestibule 150 and Commons 100. Clarified Panels in Electrical 127.

Drawing E1-03

- Revised: Light fixtures in Media /Storage 306 to accommodate ceiling change.

Drawing E1-05

- Added: General Note A.

Drawing E1-06

- Revised: Note 11 and Added: Dimming Preset station.

Drawing E2-01

- Clarified Panel BL4 location in Electrical 127.

Drawing E2-10

- Revised: General Note 3 and Deleted: Key Note 29 on plan.

Drawing E3-03

- Revised: Ceiling device in Media/Storage 306 to accommodate ceiling change.

Drawing E4-01

- Added: Panel SBL5 to Power Riser.

END OF ADDENDUM 03 – ELECTRICAL

Attachments: Specification Sections (26 43 00, 26 77 62), Drawings (9)



pdcengineers.com

SECTION 26 43 00
SURGE PROTECTIVE DEVICES

PART 1 GENERAL

1.01 SECTION INCLUDES

- A. Surge protective devices for service entrance locations.
- B. Surge protective devices for distribution locations.

1.02 RELATED REQUIREMENTS

- A. Section 26 05 26 - Grounding and Bonding for Electrical Systems.
- B. Section 26 24 13 - Switchboards.
- C. Section 26 24 16 - Panelboards.

1.03 REFERENCE STANDARDS

- A. UL 1283 - Standard for Electromagnetic Interference Filters; Current Edition, Including All Revisions.
- B. UL 1449 - Standard for Surge Protective Devices; Current Edition, Including All Revisions.
- C. NFPA 70 - National Electrical Code; National Fire Protection Association, Including All Applicable Amendments and Supplements; 2017.

1.04 ADMINISTRATIVE REQUIREMENTS

- A. Coordination: Coordinate size and location of overcurrent device compatible with the actual surge protective device and location to be installed. Notify Architect of any conflicts or deviations from the contract documents to obtain direction prior to ordering equipment.

1.05 SUBMITTALS

- A. Product Data: Include detailed component information, voltage, surge current ratings, repetitive surge current capacity, voltage protection rating (VPR) for all protection modes, maximum continuous operating voltage (MCOV), nominal discharge current (I-n), short circuit current rating (SCCR), connection means including any required external overcurrent protection, enclosure ratings, outline and support point dimensions, weight, service condition requirements, and installed features.
 - 1. SPDs with EMI/RFI filter: Include noise attenuation performance.
- B. Shop Drawings: Include wiring diagrams showing all factory and field connections with wire and circuit breaker/fuse sizes.
- C. Certificates: Manufacturer's documentation of listing for compliance with the following standards:
 - 1. UL 1449.
 - 2. UL 1283 (for Type 2 SPDs).
- D. Field Quality Control Test Reports.
- E. Manufacturer's Installation Instructions: Include application conditions and limitations of use stipulated by product testing agency. Include instructions for storage, handling, protection, examination, preparation, and installation of product.
- F. Operation and Maintenance Data: Include information on status indicators and recommended maintenance procedures and intervals.
- G. Warranty: Submit sample of manufacturer's warranty and documentation of final executed warranty completed in Owner's name and registered with manufacturer.
- H. Project Record Documents: Record actual connections and locations of surge protective devices.

1.06 QUALITY ASSURANCE

- A. Conform to requirements of NFPA 70.

- B. Maintain at the project site a copy of each referenced document that prescribes execution requirements.
- C. Product Listing Organization Qualifications: Third party agencies shall be amongst those accredited by the NCBC (North Carolina Building Code Council) to label Electrical and Mechanical Equipment.

1.07 DELIVERY, STORAGE, AND PROTECTION

- A. Store in a clean, dry space in accordance with manufacturer's written instructions.

1.08 FIELD CONDITIONS

- A. Maintain field conditions within manufacturer's required service conditions during and after installation.

1.09 WARRANTY

- A. Manufacturer's Warranty: Provide minimum five year warranty covering repair or replacement of surge protective devices showing evidence of failure due to defective materials or workmanship.
- B. Exclude surge protective devices from any clause limiting warranty responsibility for acts of nature, including lightning, stated elsewhere.

PART 2 PRODUCTS

2.01 MANUFACTURERS

- A. Field-installed, Externally Mounted Surge Protective Devices:
 - 1. Current Technology; a brand of Thomas & Betts Power Solutions.
 - 2. Schneider Electric; Square D Brand Surgeologic Products.
 - 3. Liebert.
 - 4. SSI (An ILSCO Company)
 - 5. Approved equal.
- B. Factory-installed, Internally Mounted Surge Protective Devices:
 - 1. Same as manufacturer of equipment containing surge protective device, to provide a complete listed assembly including SPD.
- C. Source Limitations: Furnish surge protective devices produced by a single manufacturer and obtained from a single supplier.

2.02 SURGE PROTECTIVE DEVICES - GENERAL REQUIREMENTS

- A. Description: Factory-assembled surge protective devices (SPDs) for 60 Hz service; listed, classified, and labeled as suitable for the purpose intended; system voltage as indicated on the drawings.
- B. Protected Modes:
 - 1. Wye Systems: L-N, L-G, N-G, L-L.
- C. UL 1449 Voltage Protection Ratings (VPRs):
 - 1. 208Y/120V System Voltage: Not more than 700 V for L-N, L-G, and N-G modes and 1,000 V for L-L mode.
 - 2. 480Y/277V System Voltage: Not more than 1,200 V for L-N, L-G, and N-G modes and 2,000 V for L-L mode.
- D. UL 1449 Maximum Continuous Operating Voltage (MCOV): Not less than 115% of nominal system voltage.
- E. Enclosure Environment Type per NEMA 250: As indicated on the drawings.
- F. Mounting for Field-installed, Externally Mounted SPDs: Unless otherwise indicated, as specified for the following locations:
 - 1. Provide surface-mounted SPD where mounted in non-public areas or adjacent to surface-mounted equipment.

- G. Equipment Containing Factory-installed, Internally Mounted SPDs: Listed and labeled as a complete assembly including SPD.
 - 1. Switchboards: See Section 26 24 13.
 - 2. Panelboards: See Section 26 24 16.

2.03 SURGE PROTECTIVE DEVICES FOR SERVICE ENTRANCE LOCATIONS

- A. Unless otherwise indicated, provide field-installed, externally mounted or factory-installed, internally mounted SPDs.
- B. List and label as complying with UL 1449, Type 1 when connected on line side of service disconnect overcurrent device and Type 1 or 2 when connected on load side of service disconnect overcurrent device.
- C. Provide SPDs utilizing field-replaceable modular or non-modular protection circuits.
- D. Surge Current Rating: Not less than 120 kA per mode/240 kA per phase.
- E. Surge Current Rating:
 - 1. Ampacity: 2500 - 6000A 300 kA per mode 600 kA per phase.
 - 2. Ampacity: 1200 - 2000A 250 kA per mode 500 kA per phase.
 - 3. Ampacity: 600 - 1000A 200 kA per mode 400 kA per phase.
 - 4. Ampacity: 225 - 400A 150 kA per mode 300 kA per phase.
 - 5. Ampacity: 125 - 225A 100 kA per mode 200 kA per phase.
- F. UL 1449 Nominal Discharge Current (I-n): 20 kA.
- G. UL 1449 Short Circuit Current Rating (SCCR): Not less than the available fault current at the installed location as indicated on the drawings.
- H. Opening of supplementary protective devices, internal or external, shall not be permissible during UL 1449 3rd Edition Nominal Discharge testing.
- I. EMI/RFI Filtering: Provide EMI/RFI filter to attenuate electrical noise; listed as complying with UL 1283 for Type 2 SPDs (UL 1283 listing not available for Type 1 SPDs).
 - 1. Noise Attenuation: Not less than 40 dB at 100 kHz using MIL-STD-220 insertion loss test method.
- J. Diagnostics:
 - 1. Protection Status Monitoring: Provide indicator lights to report the protection for each phase.
 - 2. Alarm Notification: Provide indicator light and audible alarm to report alarm condition. Provide button to manually silence audible alarm.
 - 3. Remote Status Monitoring: Provide Form C dry type contacts (normally open and normally closed) for remote annunciation of status.
 - 4. Surge Counter: Provide surge event counter with manual reset button, surge count retention upon power loss, and six digit LCD display that indicates quantity of surge events.

2.04 SURGE PROTECTIVE DEVICES FOR DISTRIBUTION LOCATIONS

- A. Unless otherwise indicated, provide field-installed, externally mounted SPDs.
- B. List and label as complying with UL 1449, Type 1 or Type 2.
- C. Provide SPDs utilizing Non-Modular surge protection circuits.
- D. Surge Current Rating: Not less than 80 kA per mode/160 kA per phase.
- E. Surge Current Rating:
 - 1. Ampacity: 400 - 800A 150 kA per mode 300 kA per phase.
 - 2. Ampacity: 125 - 225A 100 kA per mode 200 kA per phase.
 - 3. Ampacity: 15 - 100A 50 kA per mode 100 kA per phase.
- F. UL 1449 Nominal Discharge Current (I-n): 20 kA.
- G. UL 1449 Short Circuit Current Rating (SCCR): Not less than the available fault current at the installed location as indicated on the drawings.

- H. Diagnostics:
 - 1. Protection Status Monitoring: Provide indicator lights to report the protection status for each phase.
 - 2. Alarm Notification: Provide indicator light and audible alarm to report alarm condition. Provide button to manually silence audible alarm.
 - 3. Remote Status Monitoring: Provide Form C dry type contacts (normally open and normally closed) for remote annunciation of status.

PART 3 EXECUTION

3.01 EXAMINATION

- A. Verify that field measurements are as indicated.
- B. Verify that the service voltage and configuration marked on the SPD are consistent with the service voltage and configuration at the location to be installed.
- C. Verify that electrical equipment is ready to accept connection of the SPD and that installed overcurrent device is consistent with requirements of drawings and manufacturer's instructions.
- D. Verify system grounding and bonding is in accordance with Section 26 05 26, including bonding of neutral and ground for service entrance and separately derived systems where applicable. Do not energize SPD until deficiencies have been corrected.
- E. Verify that conditions are satisfactory for installation prior to starting work.

3.02 INSTALLATION

- A. Perform work in a neat and workmanlike manner.
- B. Install products in accordance with manufacturer's instructions.
- C. Arrange equipment to provide minimum clearances in accordance with manufacturer's instructions and NFPA 70.
- D. Unless indicated otherwise, connect service entrance surge protective device on load side of service disconnect main overcurrent device.
- E. Provide conductors with minimum ampacity not less than manufacturer's recommended minimum conductor size.
- F. Install conductors between SPD and equipment terminations as short and straight as possible, not exceeding manufacturer's recommended maximum conductor length. Breaker locations may be reasonably rearranged in order to provide leads as short and straight as possible. Twist conductors together to reduce inductance.
- G. Do not energize SPD until bonding of neutral and ground for service entrance and separately derived systems is complete in accordance with Section 26 05 26 where applicable. Replace SPDs damaged by improper or missing neutral-ground bond.
- H. Disconnect SPD prior to performing any high potential testing. Replace SPDs damaged by performing high potential testing with SPD connected.

3.03 FIELD QUALITY CONTROL

- A. Inspect and test in accordance with NETA ATS, except Section 4.
- B. Perform inspections and tests listed in NETA ATS Section 7.19.1.
- C. Procure services of a qualified manufacturer's representative to observe installation and assist in inspection, testing, and adjusting. Include manufacturer's reports with field quality control submittals.

3.04 CLEANING

- A. Repair scratched or marred exterior surfaces to match original factory finish.

END OF SECTION 26 43 00

SECTION 26 77 62
SOUND SYSTEM

THIS SYSTEM SHALL BE PROVIDED UNDER THE BASE BID AND SHALL BE 100% COMPLETE AND OPERATIONAL UPON PROJECT COMPLETION.

THE SOUND SYSTEM SHALL PROVIDE FOR THE PICK-UP, PROCESSING, AMPLIFICATION AND DISTRIBUTION OF LIVE AND PRERECORDED PROGRAM MATERIAL. SOUND COVERAGE OF THE AUDIENCE AREA SHALL BE BY MAIN SPEAKERS. ONE ON EACH OUTSIDE STAGE PERIMETER AS WELL AS FILL IN SPEAKERS BEYOND WHERE THE CURTAIN CAN BE DRAWN TO SEPARATE THE ROOM.

AN ASSISTED LISTENING SYSTEM SHALL BE PROVIDED TO COMPLY WITH NCBS VOLUME 1C HANDICAP ACCESSIBILITY REQUIREMENTS.

THE SYSTEM SHALL CONSIST OF BOTH WIRELESS AND WIRED MICROPHONES. ALSO, INCLUDED THERE SHALL BE TWO MIXERS, CD/CD WRITER, DIGITAL PROCESSORS, EQUIPMENT STORAGE DRAWER, AMPLIFIERS, SPEAKERS, WALL JACKS, LOCK-ABLE WALL RACK WITH REQUIRED SPACING FOR EQUIPMENT SUPPLIED, POWER CONDITIONER, VENTED BLANKS, MIC CABLES AND ALL OTHER CABLING. ALL MISCELLANEOUS ITEMS SHALL BE INCLUDED FOR A COMPLETE OPERATIONAL SYSTEM. ALL COMPONENTS SHALL BE NEW AND OF THE LATEST DESIGN. ALL ITEMS SHALL BE PROFESSIONAL GRADE. ALL EQUIPMENT TO BE HOUSED IN ONE RACK. EACH PIECE OF RACK MOUNTED EQUIPMENT SHALL BE SEPARATED BY A 1.75" VENTED BLANK.

THE SPECIFICATIONS CALL FOR SPECIFIC PRODUCTS (BASIS OF DESIGN) TO ESTABLISH QUALITY AND PERFORMANCE CRITERIA FOR THIS PROJECT. OTHER EQUIPMENT WILL BE CONSIDERED THAT MEET THE CRITERIA. SUBMIT DETAILED CUT SHEETS 10 DAYS PRIOR TO BID DATE. APPROVAL MUST BE GIVEN BEFORE SUBMISSIONS WILL BE ALLOWED. ALONG WITH OTHER SUBMITTAL REQUIREMENTS THE CONTRACTOR MUST PROVIDE A LIST OF AT LEAST 5 PROJECTS OF SIMILAR DESIGN.

5.01 PRODUCTS

- A. Mixer - The basis of design for MIXER is BOGEN VMIX, with 8 module bays capable of accepting advanced plug-in modules, with 2 bays capable of accepting signal-processing plug-in output modules. Each channel shall have its own independent volume control, and LED signal/clip indicator. The mixer shall have a master volume control, bass and treble controls, an 11-segment LED output level switch (-50, -10, and +4dBu), circuit breaker with reset capability, one power indicator, a grounded un-switched AC convenience receptacle with a 500W maximum capacity provided for external equipment. The mixer shall be capable of being bridged and muted. The mixer shall be rack mountable (with RPK87 rack mount kit). The mixer shall come with a 3 year parts warranty, (2RU each). Approved manufacturers: Bogen, Mackle, Allen Heath.
 - 1. QUANTITY - TWO
- B. CD/CD Recorder - The basis of design for CD/CD Writer is Tascam model CDRW750. Approved manufacturers: Denon, TDK, Tascam. Features required are:
 - 1. Uses professional grade and consumer grade CDs
 - 2. CD-text reading and writing capability
 - 3. Unbalanced RCA Analog I/O
 - 4. SPDIF coax and optical digital I/O
 - 5. Wireless remote
 - 6. Repeat play
 - 7. Digital gain adjustment
 - 8. Head phone output
 - 9. QUANTITY - ONE
- C. Equalizer - The basis of design for Digital Equalizer is SHURE DFR22. Approved manufacturers: Shure, Peavey, Ashly Protea. The device shall have 2 analog inputs and 2

shall have a maximum continuous rating of 200 watts at 8 ohms. All necessary mounting hardware to be included. Main speakers to be connected to CH 1 on main amp.

1. QUANTITY - TWO
- H. Fill-In Speakers - Basis of Design for FILL-IN SPEAKERS is Bogen OCS1 (recessed) (70 Volt). Approved manufacturers: Bogen, JBL, Electro-Voice. The FILL-IN SPEAKERS shall be of surface design, consisting of a 6.5" low frequency transducer, a coaxially-mounted 3/4" high frequency transducer and frequency dividing network installed in a ported enclosure. The low frequency voice coil shall be 1" in diameter and the coil former shall be of aluminum for maximum heat dissipation. Rated power shall be at least 75 watts continuous pink noise power. The high frequency transducer shall be horn -loaded to more evenly cover a minimum 110 degree polar area. The backcan shall be constructed of formed steel and the baffle of UL94V-0 fire rated medium impact polystyrene. An enclosed terminal box shall be included providing strain relief for use with either plenum-rated wire, 1/2" conduit or flexible conduit up to 7/8" outside diameter. The external wiring shall be accomplished via a removable lockable wiring connector with screw-down terminals to provide both secure wire terminations and rewiring capability before loudspeaker installation. An attachment loop shall be provided on the back panel for cabling to building structure as a secondary point of support. The system shall include a support backing plate to reinforce the ceiling material and tile support rails for use with standard ceiling tiles. The speakers shall have a 70.7 volt transformer with selectable taps
1. QUANTITY - TWELVE
- I. Monitor Speaker - Basis of Design for MONITOR SPEAKER is APOGEE AFI - Point 5. Approved manufacturers: Apogee, Electro-Voice, Community. The monitor speaker shall have one low frequency 5.25" permanent magnet cone type driver and one .5" Mylar tweeter. Connectors shall be of the spring type. The grill shall have a highly durable, quality finish on perforated steel. Nominal impedance shall be 8 ohms with maximum power handling of 60W continuous/240W peak. Speaker shall be hung on inside of proscenium wall facing the stage. Speaker shall be connected to CH. 2 of the main amplifier. Music source only for input to this channel.
1. QUANTITY - ONE
- J. Main Amplifier - Basis of Design for MAIN AMPLIFIER is APOGEE CA-2000. The MAIN AMPLIFIER shall contain the latest in power MOSFET technology. Approved manufacturers: Apogee, Crest-Audio, Crown. All controls shall be located on the rear of the unit to avoid being tampered with. The air intake and air filter shall be located on the front panel for easy access when cleaning is required. The front end circuitry shall feature an advanced clip eliminator to reduce distortion. Speaker protection shall be provided by means of an ultra-fast crowbar unit. The amplifier shall be equipped with adjustable speed fans for quiet, efficient cooling and feature internally configurable AC mains for 120 VAC or 230 VAC. The MAIN AMPLIFIER shall have a rating of 180 watts at 8 ohms. (2RU)
1. QUANTITY - ONE
- K. Fill-In Speaker Amplifier - Basis of Design for FILL-IN AMPLIFIER is BOGEN V-250. Approved manufacturers: Bogen, Crest-Audio, QSC. The FILL-IN speaker amp shall have a power rating of 60 watts. The amplifier shall provide one low-impedance balanced microphone input, one dedicated Hi-Z auxiliary input, and one dedicated telephone line input as well as a fourth input that is switch selectable to be either a microphone or auxiliary input. The microphone inputs shall be equipped with filters to protect against RF interference, independent volume controls for each input as well as TREBLE control. The amplifier shall contain a TEL volume control to adjust the telephone paging level and a VOX volume control to adjust the TEL input signal trigger point for automatic muting of the AUX input. The amplifier shall provide output impedances of 4 - (direct), 8, 16-ohm speaker systems as well as 25V and 70V constant voltage systems. Two high-impedance outputs shall be provided to drive a tape recorder or booster amplifier and, when used with an accessory transformer, to feed a 600-ohm telephone line. The amplifier shall contain a thermostat capable of resetting the power transformer to protect against heat build-up and short-circuited or overloaded connections. Included rack mounts for standard rack mounting. (2 RU)

- 1. QUANTITY - ONE
- L. Wired Microphone - Basis of Design for HANDHELD MICS is Shure SM58s. Approved manufacturers: Shure, Audio-Technology, EV. The HANDHELD MICS shall be unidirectional with a frequency response from 50 to 15,000 HZ. Rated impedance shall be 150 ohms low impedance. The mic connection point shall be by a 3 pin XLR connector. The mic element shall be covered by a steel mesh grill.
 - 1. QUANTITY - TWO
- M. Lockable Drawer - Basis of Design for LOCKABLE DRAWER is LOWELL L18-193L. Approved manufacturers: Lowell, Atlas, Middle Atlantic. The drawer is 19"W for rack mount use. Drawer shall have panel space height of (2RU) and a maximum extension of 15.375" Construction shall be welded 16 gauge USA steel with ball bearing slides and positive stops. Load capacity shall be 50LBS. Finish shall be black powder epoxy.
 - 1. QUANTITY - ONE
- N. Power Conditioner - Basis of Design for POWER CONDITIONER shall be an AVLEX PC-08. Approved manufacturers: Avlex, Furman, Monster. The POWER CONDITIONER shall have eight switched AC outlets. Also, the conditioner shall have two light modules with dimming capability, adjustable swivel and pull out positioning. The eight circuits shall be rated at 15 amps, equivalent to 1800 watts at 120 volts.
 - 1. QUANTITY - ONE
- O. Equipment Rack - Basis of Design for EQUIPMENT RACK is LOWELL L260 SERIES. Approved manufacturers: Lowell, Atlas, Middle Atlantic. The EQUIPMENT RACK shall be fully welded 16 gauge US steel with vented side, a 14 gauge steel bottom and reinforcement at all load bearing junctures. Front and rear mounting rails shall be fixed in place. Top entry and a 6" deep rear conduit plane for knockouts shall be provided. Rack space requirements will be determined by individual contractor.
 - 1. QUANTITY - ONE
- P. Floor Rack Diagram -
- Q. FLOOR RACK (Refer to A.3 for Blank Panels)

ASSITIVE LISTENING TRANSMITTER
POWER CONDITIONER
8 CHANNEL POWER VECTOR MIXER
8 CHANNEL POWER VETOR MIXER
CD/CD WRITER
WIRELESS HANDHELD RECEIVERS
WIRELESS HANDHELD RECEIVERS
STORAGE DRAWER W/LOCK
DIGITAL EQUALIZER
ANTENNA COMBINER
AMPLIFIER 1 (MAIN)
AMPLIFIER 2 (FILL-IN SPEAKER)

- R. Microphone Stands - Basis of Design for MICROHONE STANDS is BOGEN SF4s. Approved manufacturers: Bogen, Exo, Tascam. The MICROPHONE STANDS shall be full height professional grade with a low profile base black in color. The stands shall be constructed of 5/8" and 7/8" diameter heavy-duty welded cold rolled tubing with 5/8" - 27 male thread termination to accommodate standard microphone holders. Top and bottom lock-nut rings are included for versatile and secure positioning. The one-piece low silhouette cast iron includes anti-tip stabilizers.
 - 1. QUANTITY - TWO

- S. Microphone Plates (Jacks) - Basis of Design for MICROPHONE PLATES is RAPCO SP1-DF. Approved manufacturers: Rapco, Switchcraft, Shure. The MICROPHONE PLATES shall be single gang stainless steel with one female XLR jack mounted on plate. Three on the wall below the front edge of stage evenly spaced across the width of the stage. One on the stage right wall, one on the stage -left wall, and one on the back wall of the stage. Floor pockets or floormounted jacks will NOT be allowed.
 - 1. QUANTITY - SIX
- T. Main Speaker Cable - Basis of Design for MAIN SPEAKER CABLE is BELDON 5000UE. Approved manufacturers: Beldon, Monster, Tappan or equal. The MAIN SPEAKER CABLE shall be 12 AWG copper cable with conductors. The cable must be UL listed and be made in the USA. Cables installed in a plenum environment must be plenum rated, otherwise PVC jacket will be accepted. Each speaker shall have its own individual homerun.
- U. Monitor Speaker Cable - Basis of Design for MONITOR SPEAKER CABLE is TAPPAN P40020.1. Approved manufacturers: Beldon, Monster, Tappan or equal. The MONITOR SPEAKER CABLE shall be a 18 AWG 7 - strand copper cable with two copper conductors. The cable must be UL listed and be made in USA. Cables installed in a plenum environment must be plenum rated, otherwise PVC jacket will be accepted.
- V. Fill In Speaker Cable - Basis of Design for FILL IN SPEAKER CABLE is TAPPAN P40020.1. Approved manufacturers: Tappan, Beldon, monster or equal. The FILL IN SPEAKER CABLE shall be a 18 AWG 7 - strand copper cable with two copper conductors. The cable must be UL listed and be made in USA. Cables installed in a plenum environment must be plenum rated, otherwise PVC jacket will be accepted. Fill In Speakers may be daisy chained.
- W. Microphone Field Cable - Basis of Design for Microphone Cable is TAPPAN R20008.1. Approved manufacturers: Tappan, Beldon, monster or equal. The MICROPHONE CABLE shall be a 22 AWG shielded 7 strand 1 pair copper cable. The cable must be UL listed and made in USA. Cables installed in a plenum environment shall be plenum rated, otherwise PVC will be accepted. All microphone cables to be individually homerun.
- X. Microphone Portable Cable - The MICROPHONE PORTABLE CABLE shall have 22 AWG 7 strand center conductors. The conductors shall have a 95% low loss spiral wound shield with a black ultra-flexible rubber jacket. Cables shall be terminated with a three pin female XLR connector on one end a three pin XLR male connector on the other end. 25" cables shall be included.
 - 1. QUANTITY - FOUR


5.02 EXECUTION

- A. A qualified "System Contractor" shall install the sound system complete except for the conduit/raceway. "System Contractor" shall have 5 years' experience in the specific field of sound system installations of this kind. "System Contractor" shall submit single line drawings showing equipment locations and interconnections between all equipment supplied.
- B. The system shall be installed using the latest technology and with good engineering practices. All cables shall be tested for opens, shorts and grounds prior to the hook-up of any cables to equipment. The system shall be balanced for optimum coverage for the room. Digital EQ shall be set and locked.

END OF SECTION 26 77 62

Trinity Middle School
Trinity, NC

Smith Sinnett / 2017032
Randolph County School System

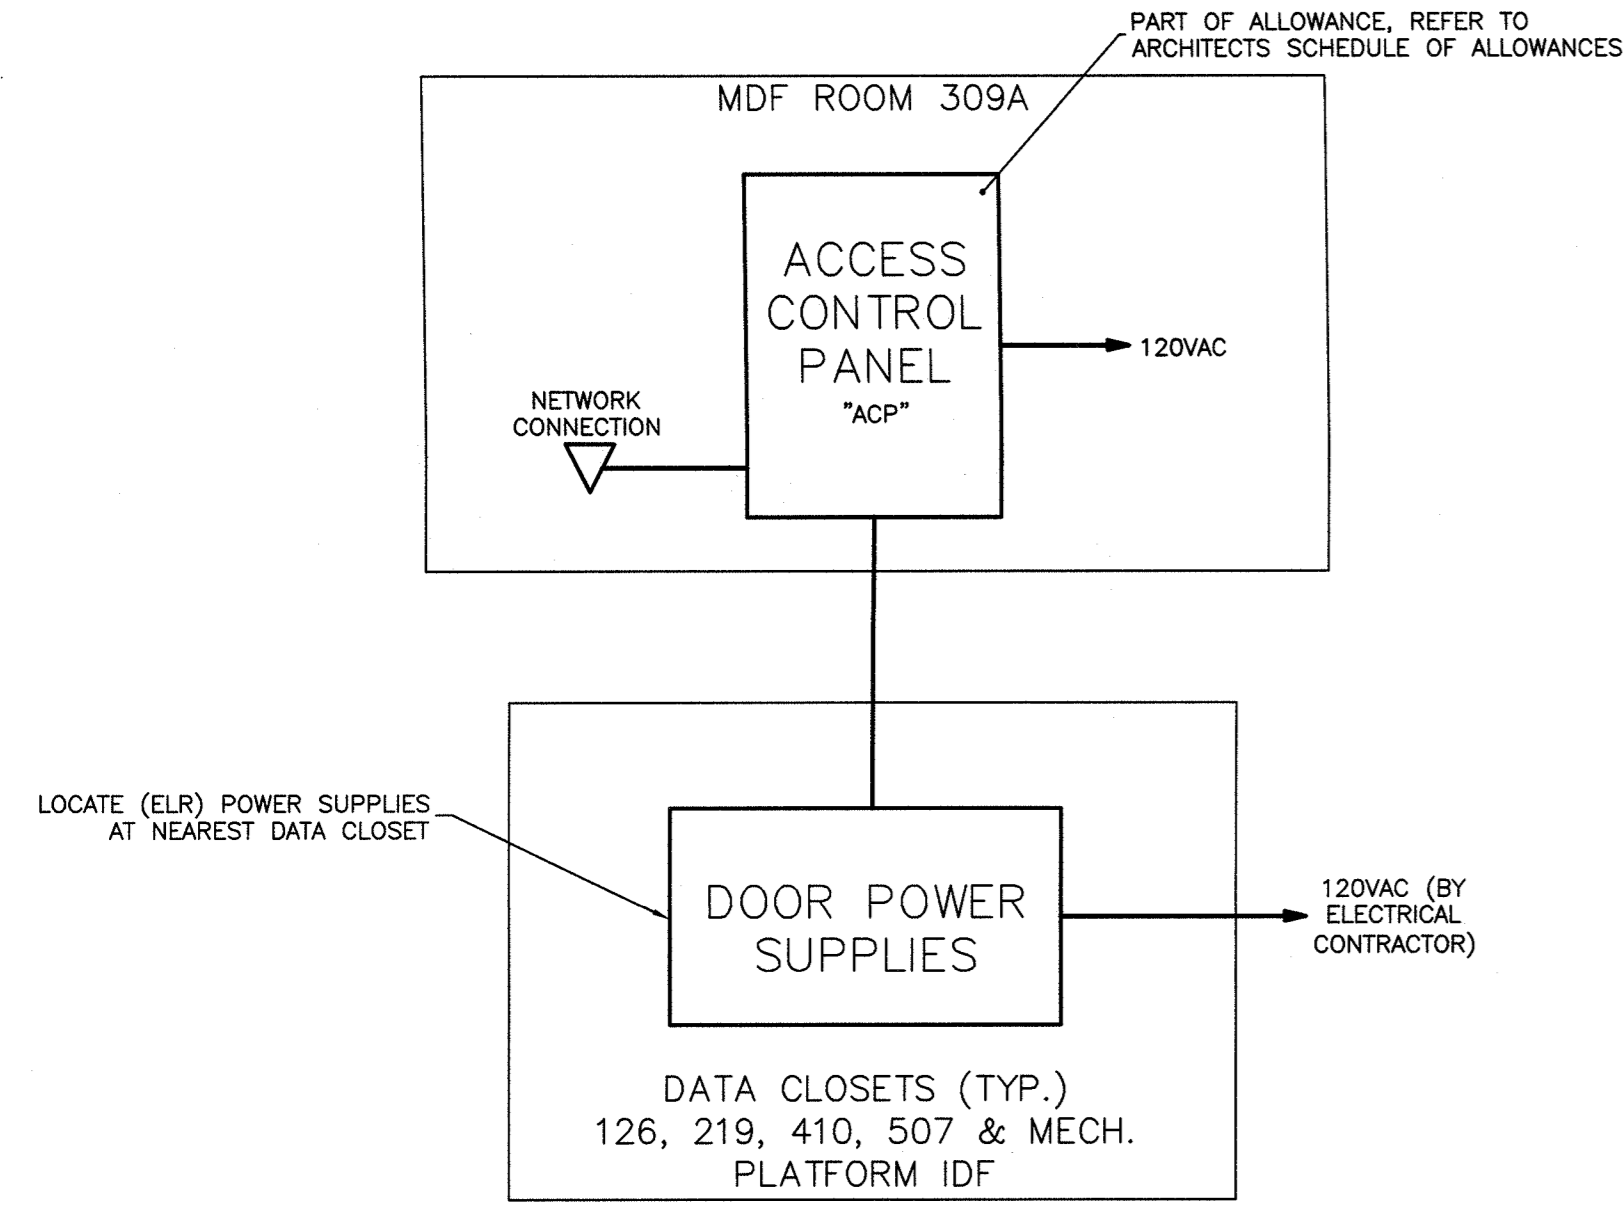







GENERAL NOTES:

1. ALL WORK SHALL BE COORDINATED BETWEEN OWNER, ARCHITECT, ELECTRICAL CONTRACTOR, OWNER'S ACCESS CONTROL CONTRACTOR AND DOOR HARDWARE CONTRACTOR PRIOR TO ROUGH-IN. A PRE-INSTALLATION MEETING SHALL OCCUR PRIOR TO INSTALLATION. AN ALLOWANCE AS IDENTIFIED IN THE ARCHITECTS SCHEDULE OF ALLOWANCES IS PROVIDED FOR THE ACCESS CONTROL SYSTEM. ALL ROUGH-INS, CONDUIT OUTLET BOXES, 120VAC SHALL BE PROVIDED AS PART OF THE CONTRACT AND NOT THE ALLOWANCE. THE ALLOWANCE WILL COVER ALL CARD READERS, HEAD-END EQUIPMENT, LOW VOLTAGE WIRING, AND ANY ACCESSORIES REQUIRED FOR A 100% COMPLETE SYSTEM. REFER TO THE DOOR HARDWARE SPECIFICATION / SCHEDULE. IF THERE ARE ANY COMPONENTS THAT ARE NOT SPECIFIED IN THE DOOR HARDWARE SPECIFICATIONS THEN IT SHALL BE INCLUDED IN THE ALLOWANCE. SEE ARCHITECTS SCHEDULE FOR ALLOWANCES.
2. REFER TO DOOR HARDWARE SPECIFICATION.
3. ALL ROUGH-INS SHALL BE COORDINATED WITH THE OWNER AND ACCESS CONTROL SYSTEM CONTRACTOR HIRED UNDER THE ALLOWANCE.
4. AS-BUILT DRAWINGS SHALL BE SUBMITTED AS PART OF O&M MANUALS.
5. POWER SUPPLIES SHALL BE LOCATED AT IDF/MDF CLOSETS AS REQUIRED FOR EASE OF MAINTENANCE BY RANDOLPH MAINTENANCE.
6. ALL 120VAC POWER THAT IS REQUIRED FOR SYSTEM SHALL BE COORDINATED AND PROVIDED BY THE ELECTRICAL CONTRACTOR.
7. DOOR DETAILS E0-07/05/07 & /09 ARE FOR REFERENCE ONLY. THE INSTALLATION REQUIREMENTS SHALL BE AS PER DOOR HARDWARE REQUIREMENTS, CARD READERS, STRIKES, POWER SUPPLIES, REX MOTIONS AND ASSOCIATED CONDUIT AND WIRING SHALL BE COORDINATED CLOSELY BETWEEN TRADES.
8. CARD READERS MOUNTED IN SINGLE GANG BOX WITH 3/4" CONDUIT TO JUNCTION BOX AND/OR CEILING VOID. COORDINATE CLOSELY.
9. ALL REX LOCATIONS, DOOR POSITION SWITCHES SHALL BE COORDINATED AND ROUGHED-IN BY THE ELECTRICAL CONTRACTOR.
10. REFER TO ARCHITECTURAL DOOR SCHEDULE AND ELECTRICAL PLANS FOR DOOR ACCESS CONTROL LOCATIONS.
11. THE ELECTRICAL CONTRACTOR SHALL COORDINATE WITH THE OWNER/OTHERS AND PROVIDE 3/4" RACEWAY FROM DOOR FRAMES TO ALLOW FOR THE DOOR CLOSER/HOLDERS TO BE WIRED INTO THE OWNER'S ACCESS CONTROL SYSTEM. APPLICABLE AREAS: (1) DOUBLE DOORS VESTIBULE 201, (2) DOUBLE DOORS VESTIBULE 302, (2) DOUBLE DOORS VESTIBULE 402, (2) DOUBLE DOORS VESTIBULE 501.

DETAIL
NOT TO SCALE

DOOR ACCESS CONTROL SYSTEM RISER

08

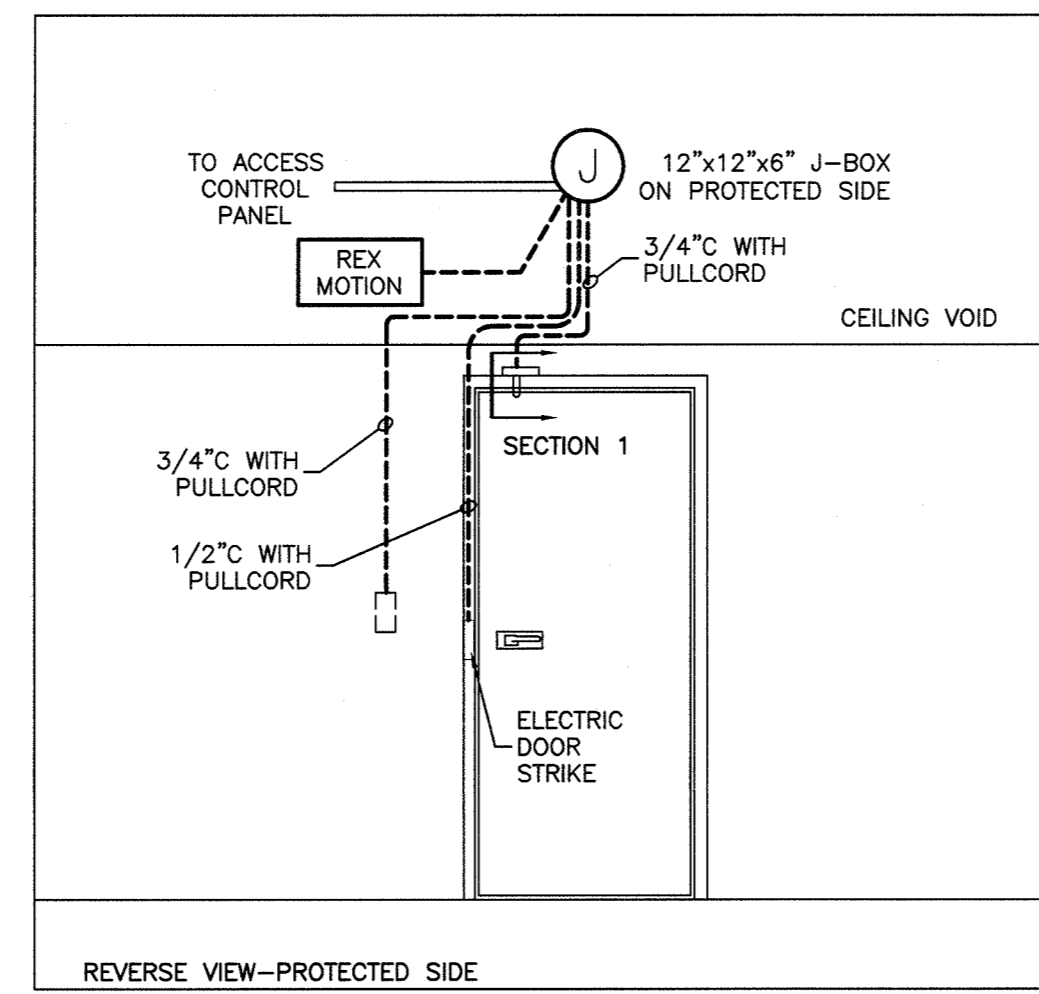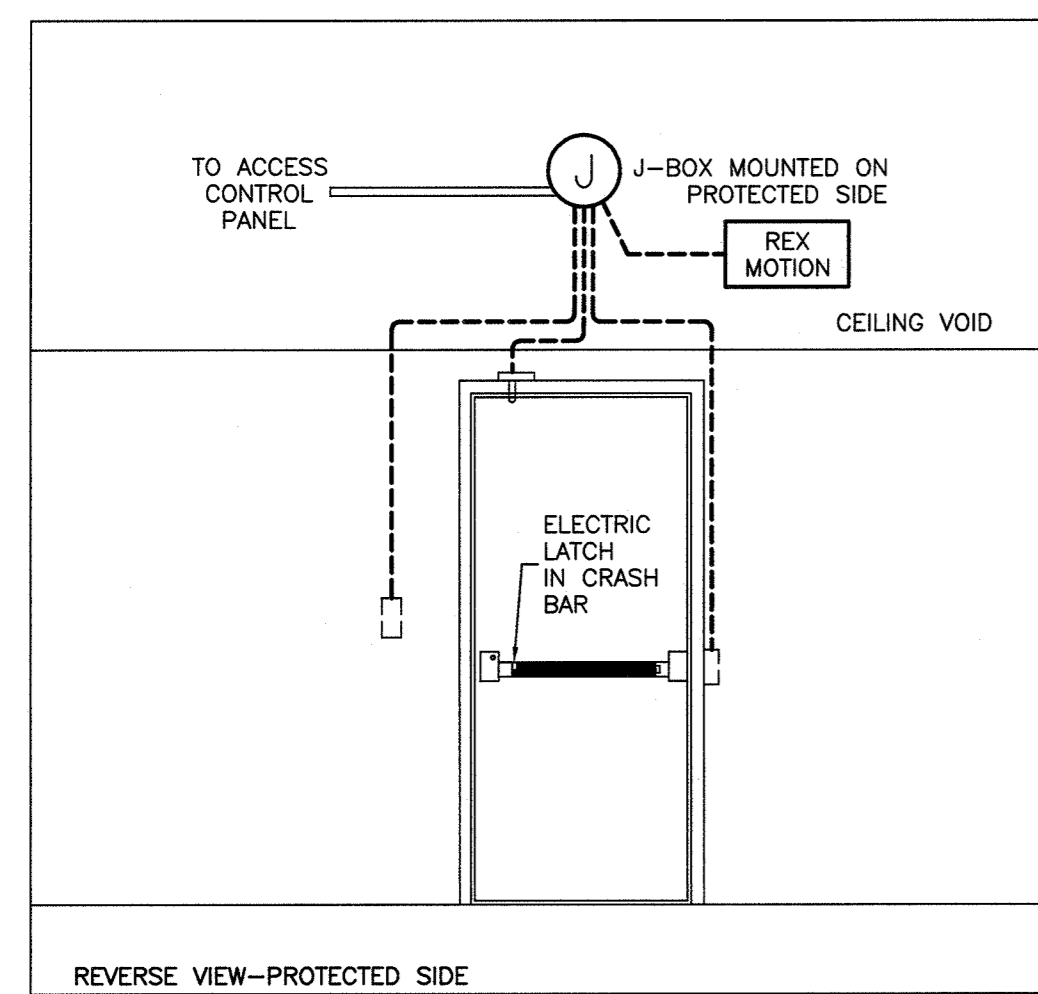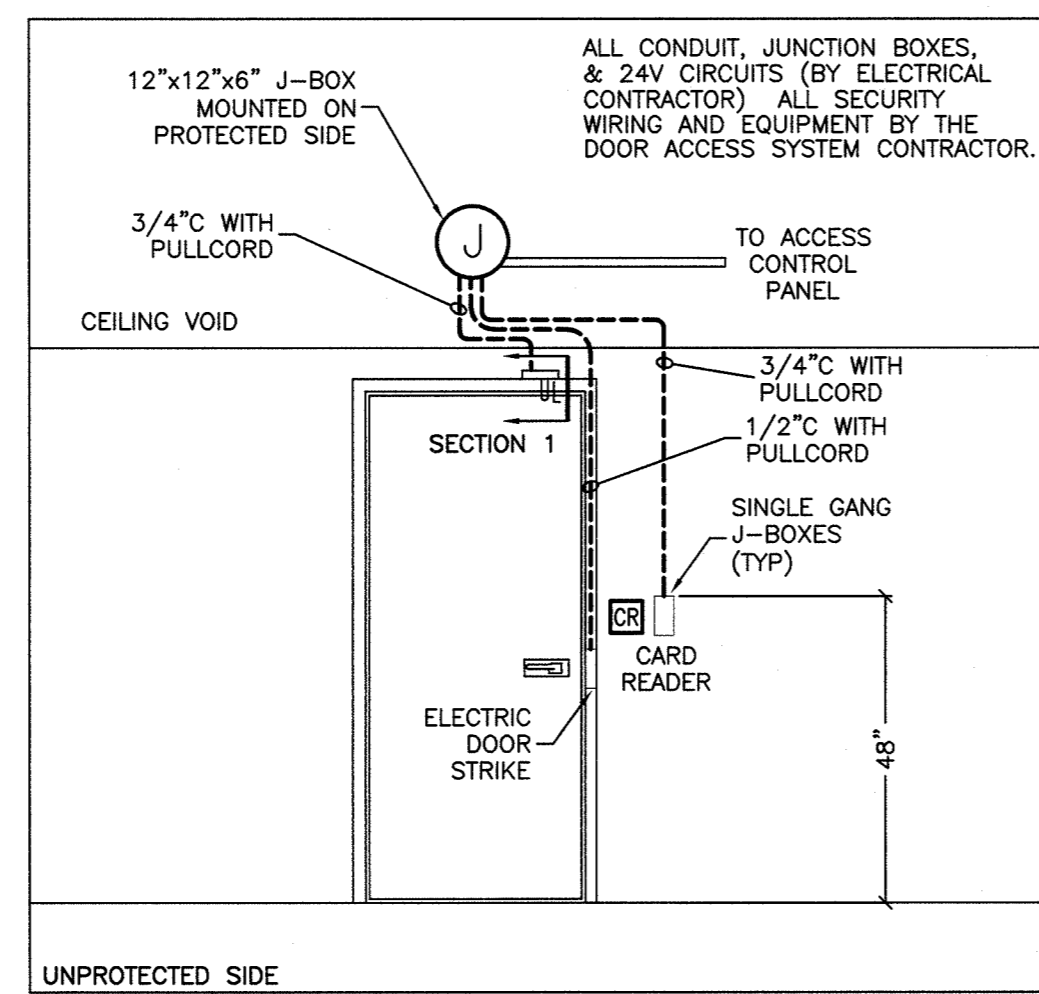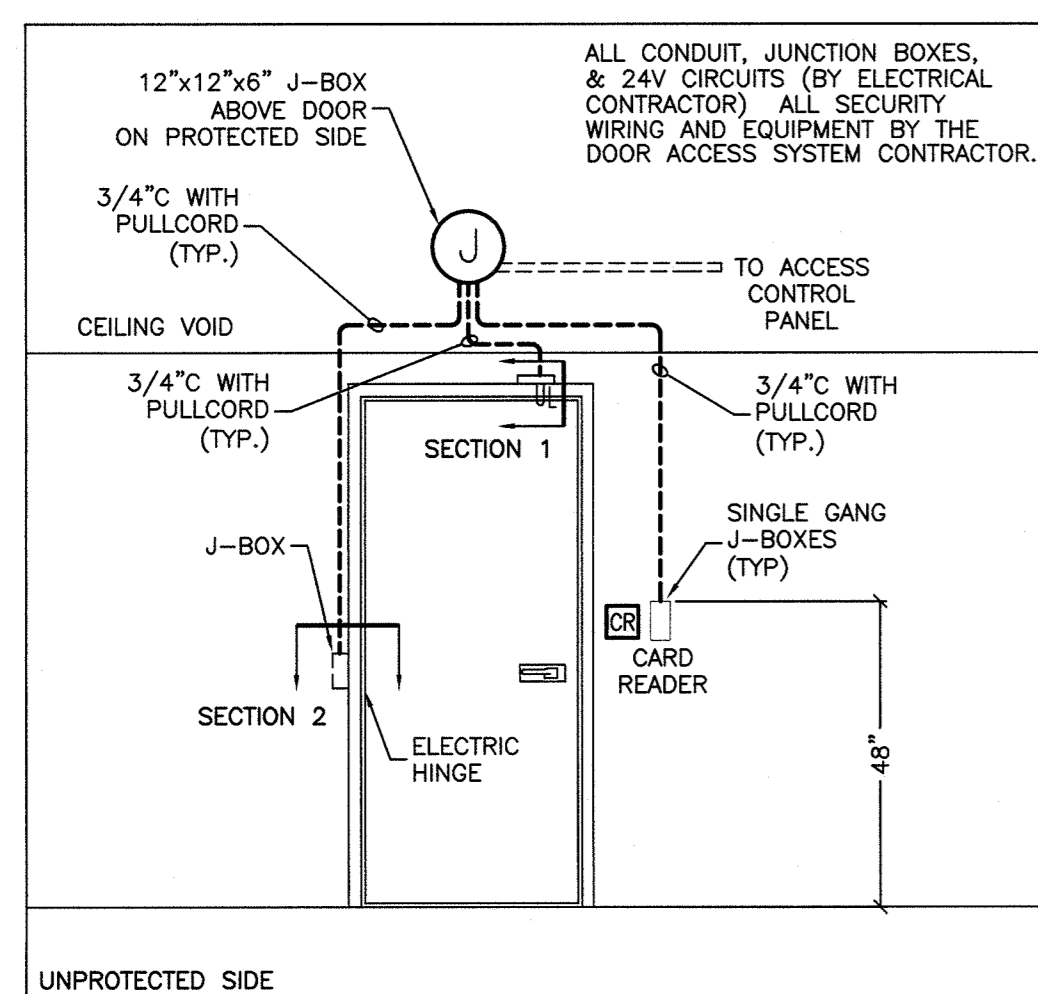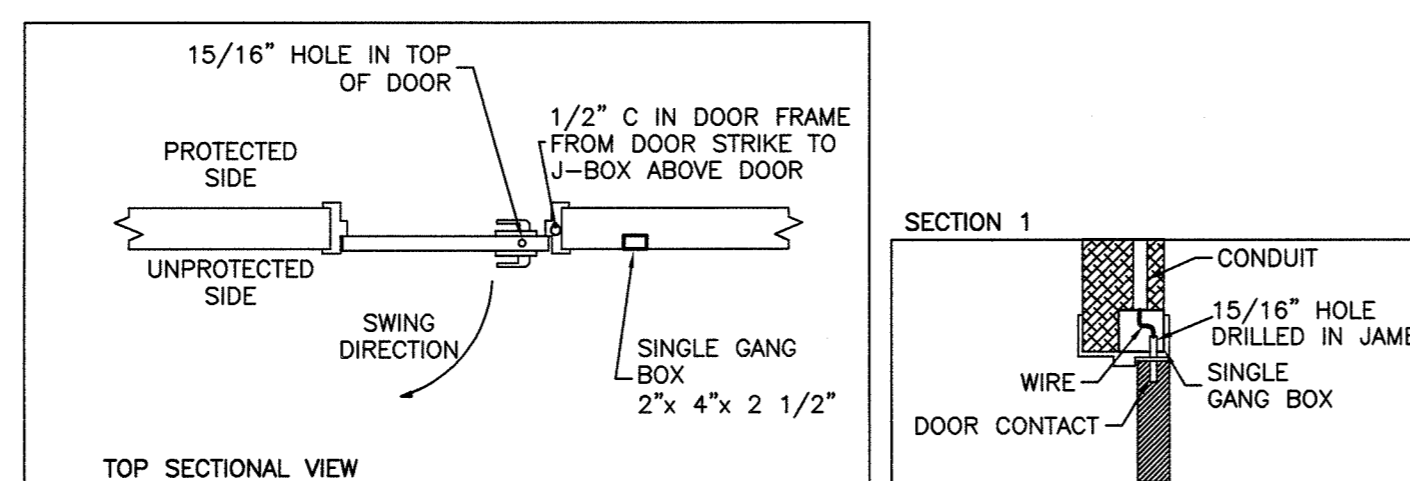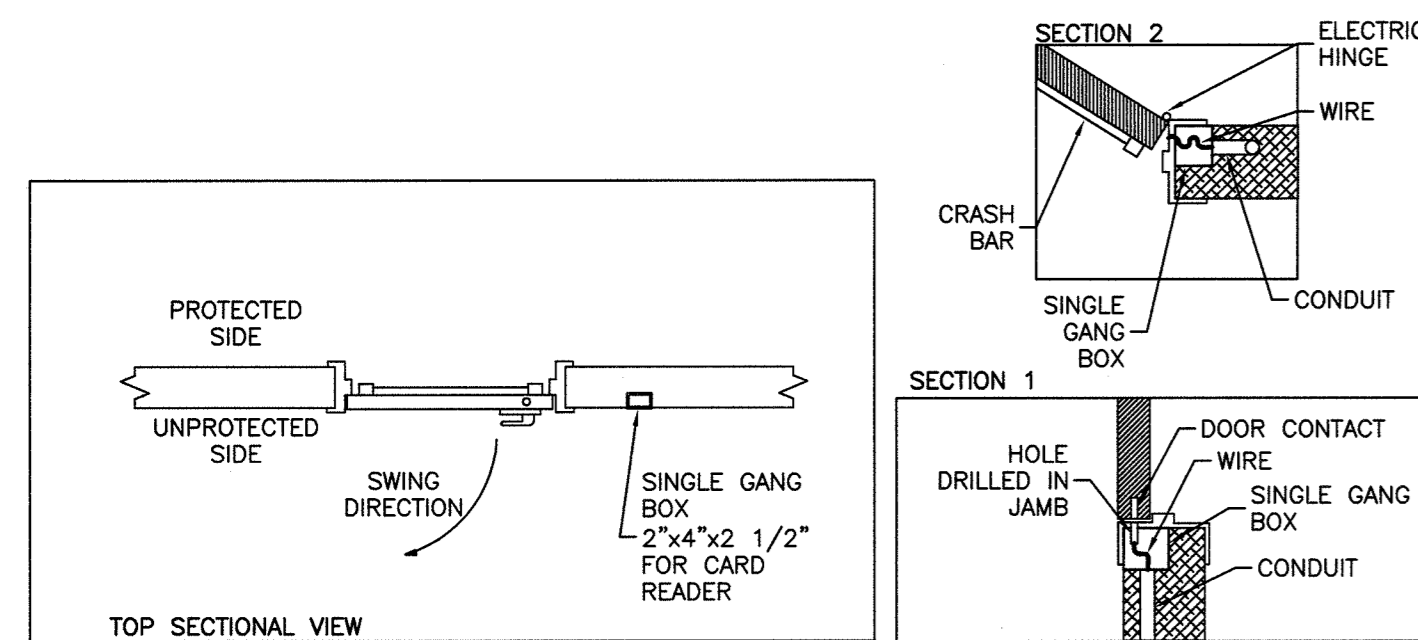

GENERAL NOTES:

1. REFER TO DOOR HARDWARE SPECIFICATION FOR DOOR HARDWARE.
2. THE INSTALLATION OF ALL CONDUIT, WIRING, JUNCTION BOXES, TERMINATIONS, CARD READERS AND IEI EQUIPMENT SHALL BE COORDINATED BETWEEN THE ELECTRICAL, SECURITY AND DOOR HARDWARE CONTRACTORS PRIOR TO INSTALLATION.
3. POWER SUPPLIES SHALL BE LOCATED IN READILY ACCESSIBLE LOCATION AT NEAREST NETWORK CLOSET, NOT ABOVE CEILINGS.
4. COORDINATE CLOSELY, PRIOR TO ROUGH-IN WITH THE SECURITY CONTRACTOR HIRED UNDER THE ALLOWANCE.

GENERAL NOTES:

1. REFER TO DOOR HARDWARE SPECIFICATION FOR DOOR HARDWARE.
2. THE INSTALLATION OF ALL CONDUIT, WIRING, JUNCTION BOXES, TERMINATIONS, CARD READERS AND ACCESS CONTROL EQUIPMENT SHALL BE COORDINATED BETWEEN THE ELECTRICAL, SECURITY AND DOOR HARDWARE CONTRACTORS PRIOR TO INSTALLATION.
3. POWER SUPPLIES SHALL BE LOCATED IN READILY ACCESSIBLE LOCATION AT NEAREST NETWORK CLOSET, NOT ABOVE CEILINGS.
4. THIS DOOR DETAIL IS A GENERAL DETAIL AND DOES NOT REFLECT THE ACTUAL DOOR PROVIDED. THE CONTRACTORS SHALL COORDINATE WITH ALL APPLICABLE TRADES AND INCORPORATE ALL REQUIRED ACCESS CONTROLS FOR A COMPLETE AND 100% OPERATIONAL DOOR.
5. COORDINATE CLOSELY, PRIOR TO ROUGH-IN WITH THE SECURITY CONTRACTOR HIRED UNDER THE ALLOWANCE.

DETAIL
NOT TO SCALE





EXTERIOR SINGLE DOORS W/CRASH BAR

09

DETAIL
NOT TO SCALE

PLATFORM LED DIMMING RISER

06

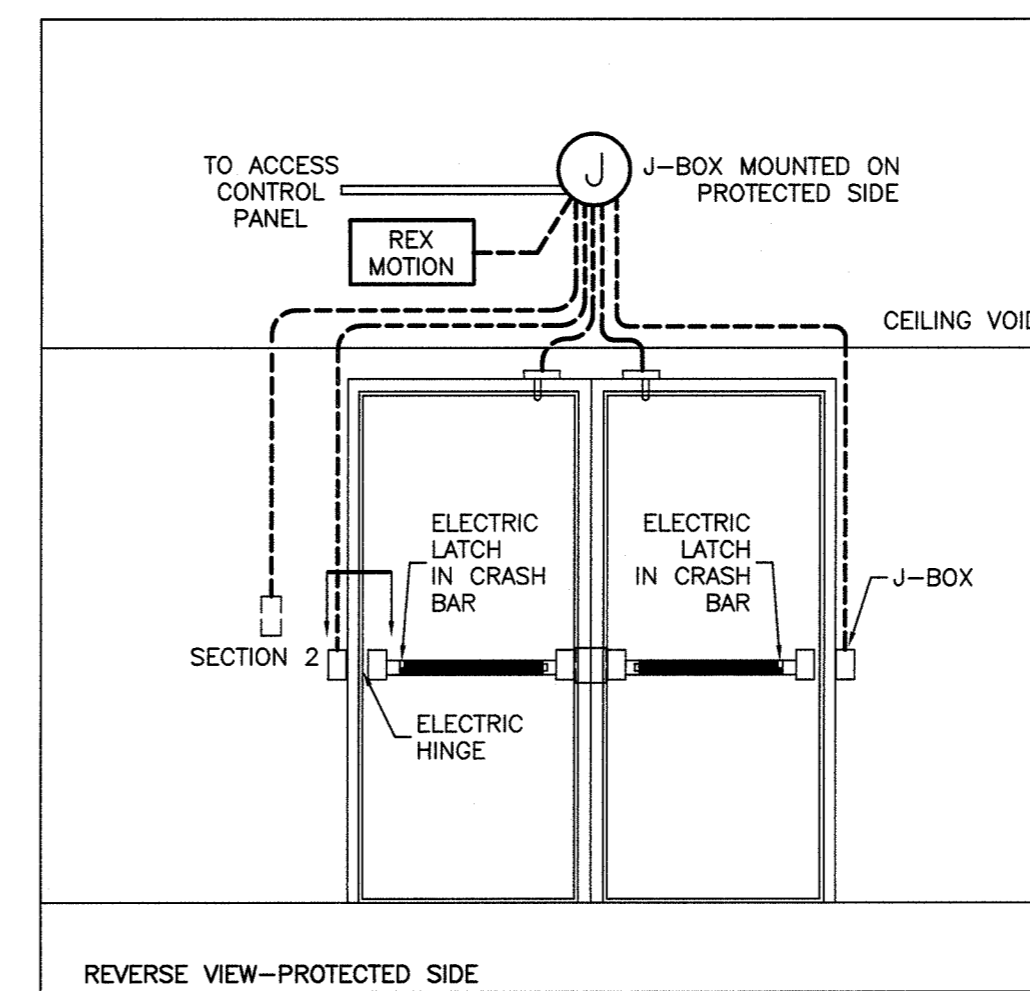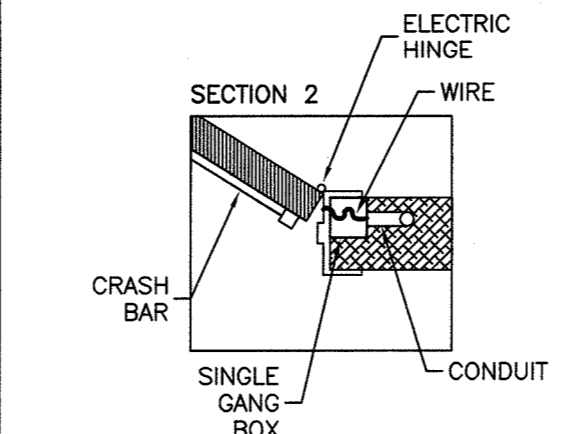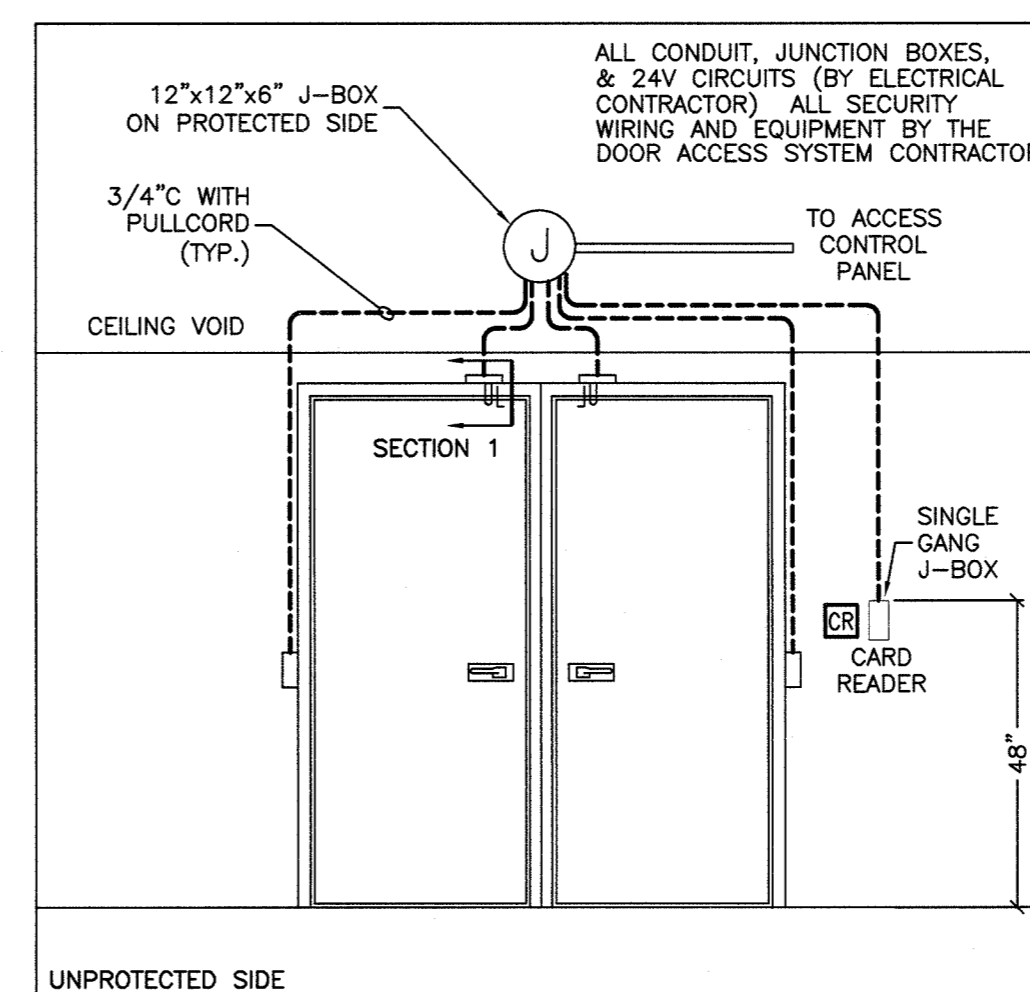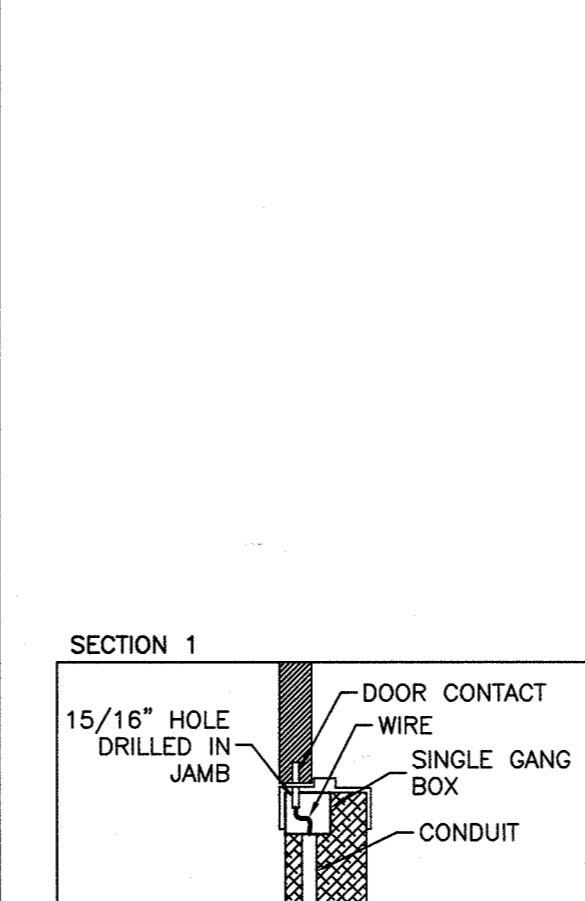


GENERAL NOTES:

1. REFER TO DOOR HARDWARE SPECIFICATION FOR DOOR HARDWARE.
2. THE INSTALLATION OF ALL CONDUIT, WIRING, JUNCTION BOXES, TERMINATIONS, CARD READERS AND ACCESS CONTROL EQUIPMENT SHALL BE COORDINATED BETWEEN THE ELECTRICAL, SECURITY AND DOOR HARDWARE CONTRACTORS PRIOR TO INSTALLATION.
3. POWER SUPPLIES SHALL BE LOCATED IN READILY ACCESSIBLE LOCATION AT NEAREST NETWORK CLOSET, NOT ABOVE CEILINGS.
4. THIS DOOR DETAIL IS A GENERAL DETAIL AND DOES NOT REFLECT THE ACTUAL DOOR PROVIDED. THE CONTRACTORS SHALL COORDINATE WITH ALL APPLICABLE TRADES AND INCORPORATE ALL REQUIRED ACCESS CONTROLS FOR A COMPLETE AND 100% OPERATIONAL DOOR.
5. COORDINATE CLOSELY, PRIOR TO ROUGH-IN WITH THE SECURITY CONTRACTOR HIRED UNDER THE ALLOWANCE.

DETAIL
NOT TO SCALE

EXTERIOR DOUBLE DOORS W/CRASH BARS

05

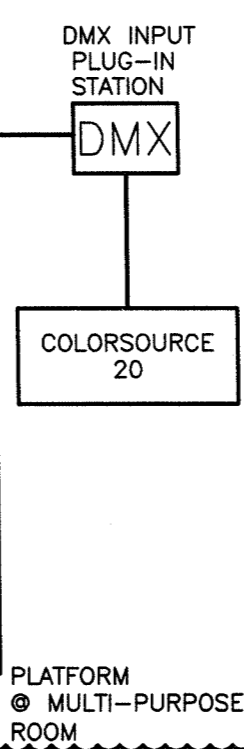

NOTES:

1. THIS PLATFORM LIGHTING SYSTEM DESIGN BASIS IS SYSTEM AS MANUFACTURED BY ELECTRONIC THEATER CONTROLS ("ETC"). OR APPROVED EQUAL. EQUAL MANUFACTURER'S SHALL BE RESPONSIBLE FOR FURNISHING ALL PARTS, PIECES AND COMPONENTS REQUIRED SO THAT THE EQUAL PRODUCT PERFORMS IN AN EQUIVALENT MANNER AS THE SYSTEM SPECIFIED. EQUIVALENT SYSTEMS SHALL BE SUBMITTED 10 DAYS PRIOR TO BID FOR CONSIDERATION AND APPROVAL.
2. THIS SYSTEM SHALL INCLUDE ALL DEVICES, CONSOLE AND EQUIPMENT FOR A 100% COMPLETE AND OPERABLE SYSTEM.
3. THE ELECTRICAL CONTRACTOR SHALL PROVIDE AND INSTALL ALL CONDUIT, POWER CABLE, LOW VOLTAGE CABLES, SWITCHES AND MOUNT AND INSTALL ALL EQUIPMENT. THE ELECTRICAL CONTRACTOR SHALL COORDINATE WITH THE EQUIPMENT SUPPLIER FOR THIS INSTALLATION SUCH THAT THE SUPPLIER (ETC) IS INVOLVED CLOSELY WITH THE INSTALLATION. THE LIGHTING SYSTEM SHALL BE PURCHASED THRU A SYSTEMS INTEGRATOR (BARBIZON, ATLAS-STAGEWORKS OR BANDIT).
4. THE SYSTEM SHALL BE 100% TESTED AND VERIFIED PRIOR TO OWNER TRAINING.
5. LOCATIONS OF DATA TRAK SHALL BE COORDINATED CLOSELY TO AVOID INTERFERENCES. INTEGRATOR EQUIPMENT PROVIDER SHALL LOCATE TRAK FOR OPTIMUM PERFORMANCE. TRACKS SHALL BE SUPPORTED SECURELY FROM STRUCTURE.
6. ALL WIRING SHALL BE IN CONDUIT.
7. THE SYSTEM SHALL BE PROVIDED WITH ALL BUTTON STATION, CONTROL CONSOLE, DMX CONNECTION, LOW VOLTAGE WIRING, LINE VOLTAGE WIRING, CONNECTORS, FEEDERS, FIXTURES, TRACKS, SUPPORT ACCESSORIES, ETC FOR A COMPLETE AND OPERATIONAL TRACK LIGHTING SYSTEM.

DETAIL
NOT TO SCALE

EXTERIOR DOUBLE DOORS W/CRASH BARS

05

DETAIL
NOT TO SCALE

GENERATOR PAD

04

DETAIL
NOT TO SCALE

GENERATOR PAD

DETAIL
NOT TO SCALE

GENERATOR PAD

DETAIL
NOT TO SCALE

H-FRAME CONSTRUCTION DETAIL



DETAIL
NOT TO SCALE

H-FRAME FOR PANEL MOUNTING

01

NOT USED

NOT USED

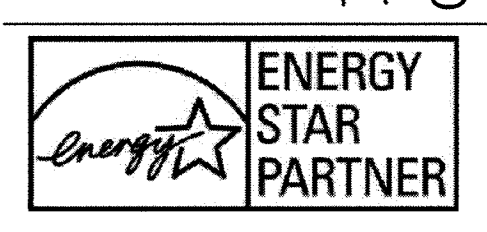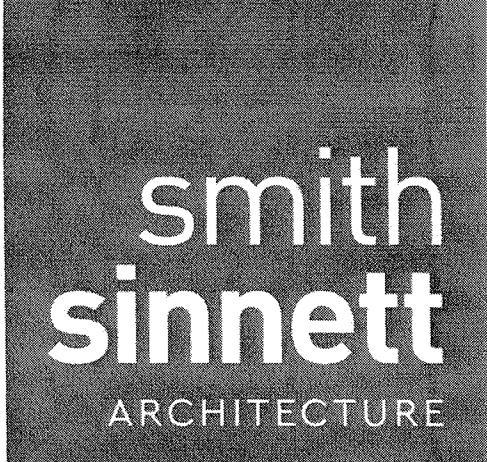

VOLUME II

This drawing and the design shown is the property of Smith Sinnett Architecture, Inc. and shall remain the property of the Architect. No part of this drawing shall be reproduced or used in any form without the written consent of the Architect. All rights are reserved. No liability shall be assumed by the Architect for the construction of the drawings after the completion of the contract. Smith Sinnett Architecture, P.A. 2019


NEW TRINITY MIDDLE SCHOOL
RANDOLPH COUNTY SCHOOL SYSTEM
Parcel PIN 7708118367
Surrett Drive
Trinity, NC 27370

KEY PLAN
NO SCALE


1	06/14/19	ADDENDUM 03
ID	DATE	DESCRIPTION
		JPT
		RAC
ELECTRICAL DETAILS		

2017032 20 MAY 2019
E0-07


Printed By: csm
Date: 05/13/2019 @ 11:55 AM
Sheet: E0-07

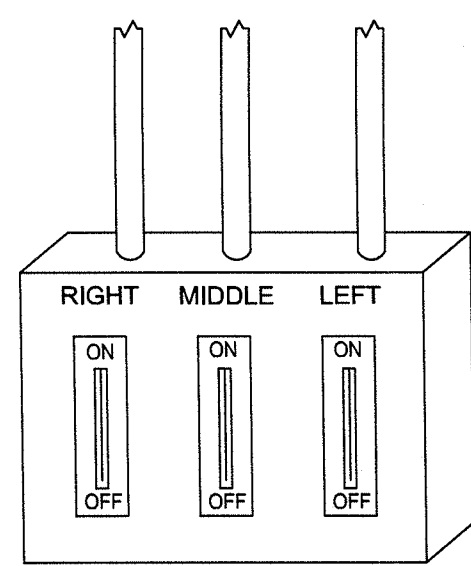

SWITCH BANK 'C'
NOTE: ALL SWITCHES SHALL BE 4-WAY KEYED SWITCHES.

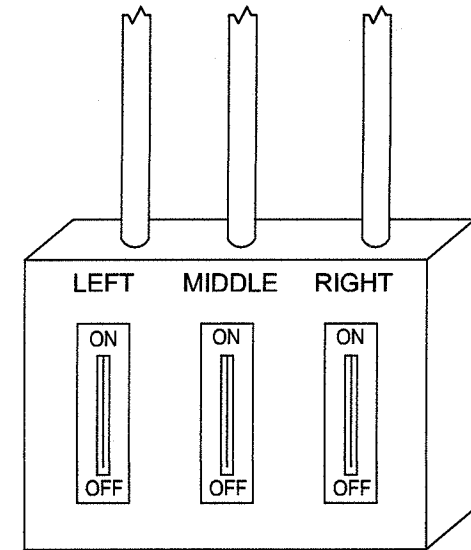


SWITCH BANK 'B'
NOTE: ALL SWITCHES SHALL BE 3-WAY KEYED SWITCHES.

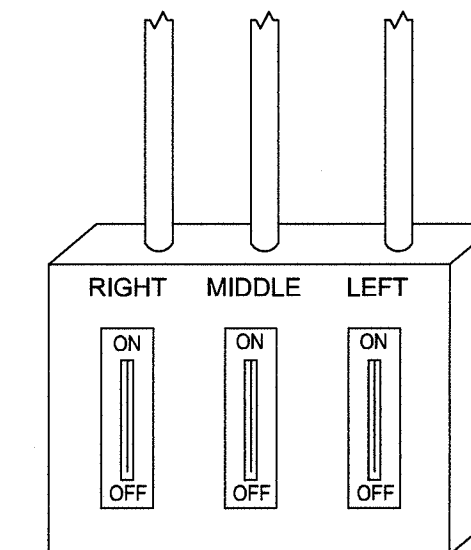


SWITCH BANK 'A'
NOTE: ALL SWITCHES SHALL BE 3-WAY KEYED SWITCHES.


4 MULTIPURPOSE ROOM SWITCH BANKS
NOT TO SCALE

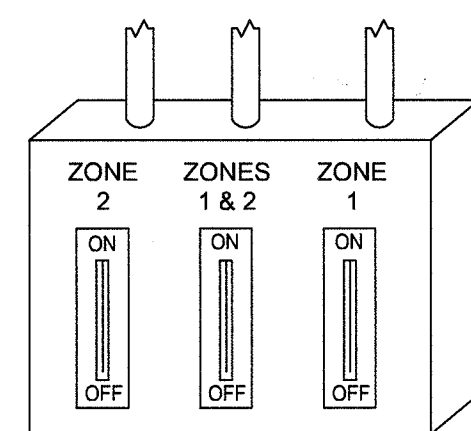

SWITCH BANK '3'
NOTE: ALL SWITCHES SHALL BE 4-WAY KEYED SWITCHES.

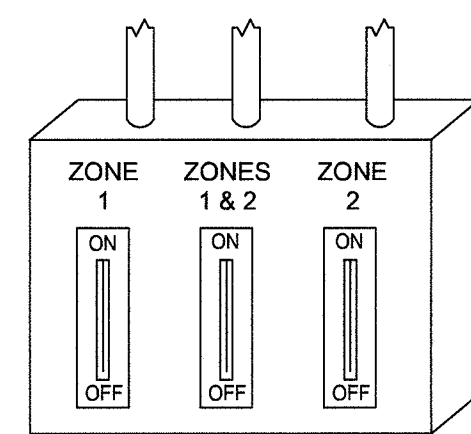

SWITCH BANK '2'
NOTE: ALL SWITCHES SHALL BE 3-WAY KEYED SWITCHES.

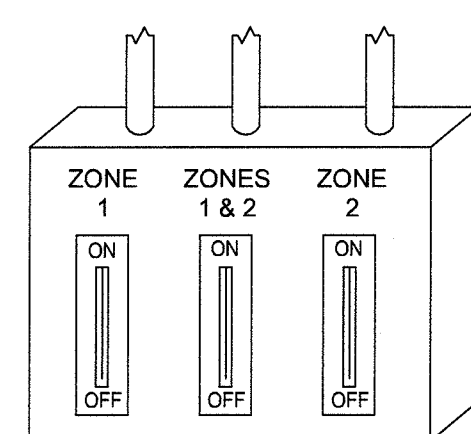


SWITCH BANK '1'
NOTE: ALL SWITCHES SHALL BE 3-WAY KEYED SWITCHES.

5 CAFETERIA SWITCH BANKS
NOT TO SCALE

WALL RATINGS LEGEND	
	1 HR RATED WALL
	2 HR RATED WALL


1 FIRST FLOOR LIGHTING PLAN - AREA 100
1/8" = 1'-0"

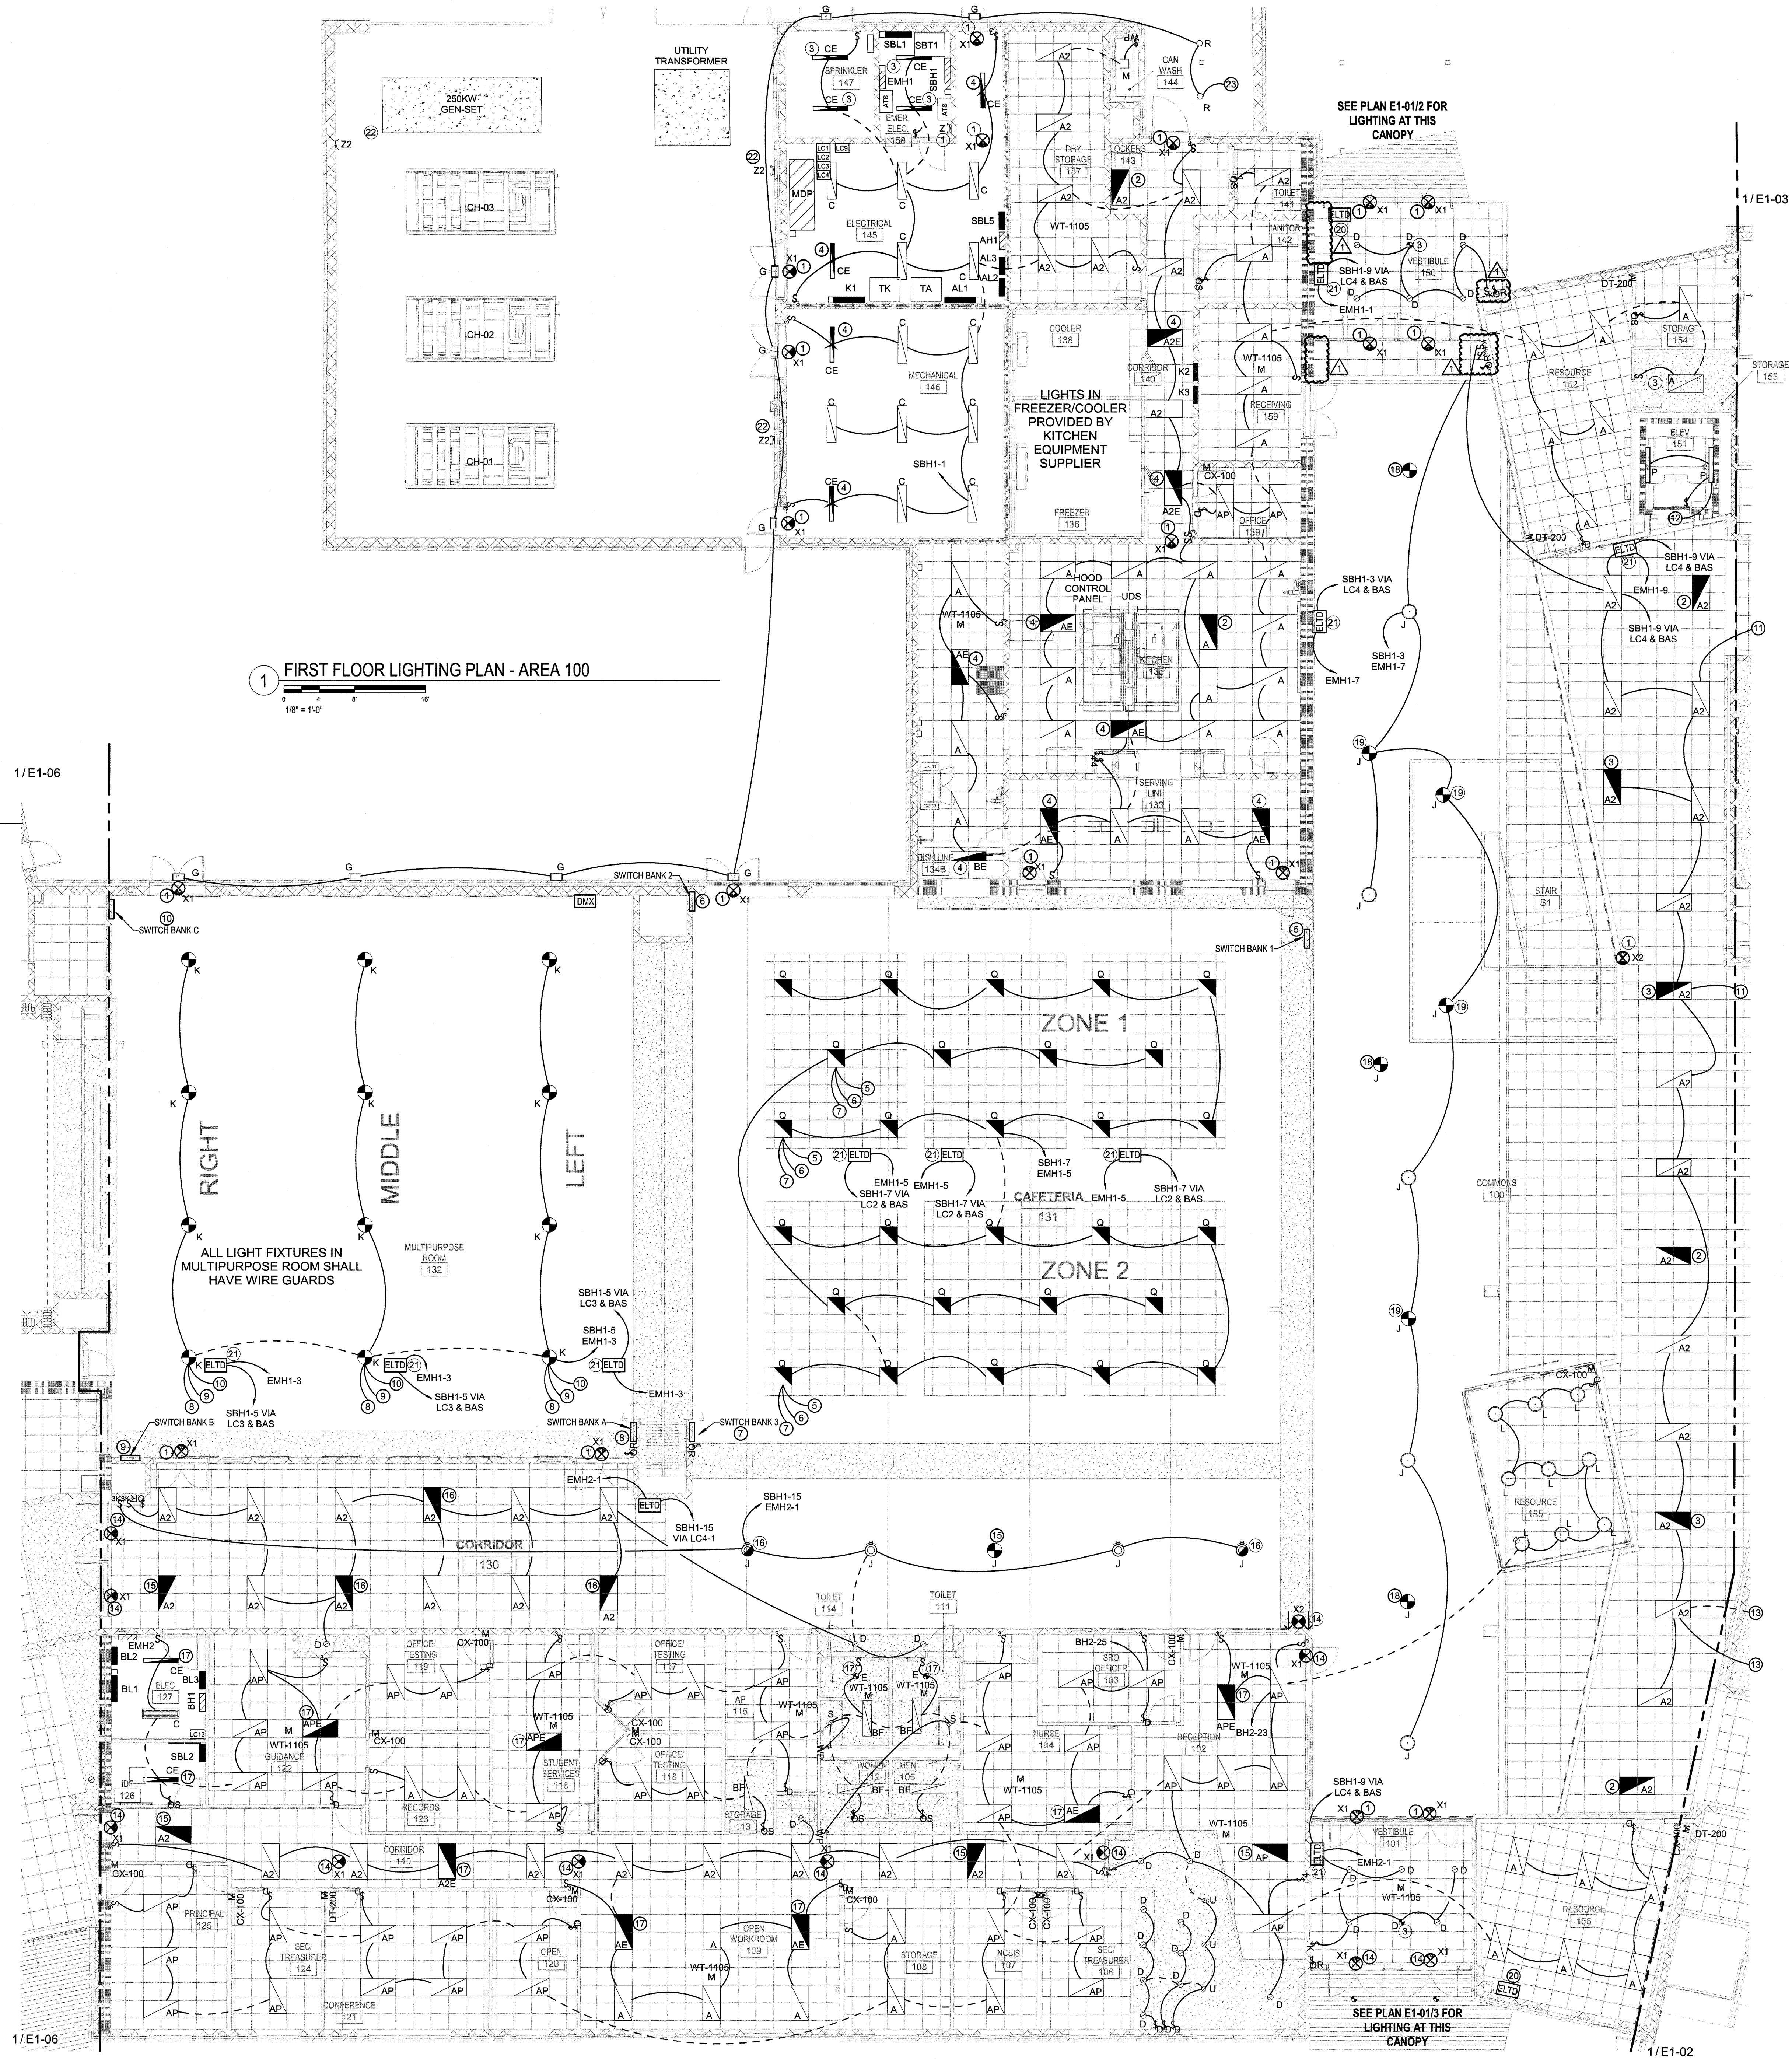

2 AREA 100 - VESTIBULE 150 CANOPY
1/8" = 1'-0"

- NOTES: (AS SHOWN ON THIS PLAN WITH A NUMBER IN A ○)
- EMERGENCY FIXTURE - WIRE AHEAD OF ALL SWITCHES AND CONNECT TO EMERGENCY CIRCUIT EMH1-1.
 - NIGHT LIGHT/EMERGENCY LIGHT - WIRE TO EMERGENCY CIRCUIT EMH1-1.
 - EMERGENCY FIXTURE IN CORRIDOR - WIRE FIXTURE VIA 20A UL924 ELTD SO THAT FIXTURE TURNS ON/OFF WITH OTHER FIXTURES BUT FIXTURE ILLUMINATES UPON LOSS OF NORMAL POWER. WIRE TO EMERGENCY CIRCUIT EMH1-1.
 - EMERGENCY FIXTURE WITH INTERNAL UL924 ELTD - WIRE SO FIXTURE TURNS ON/OFF WITH OTHER FIXTURES BUT FIXTURE ILLUMINATES UPON LOSS OF NORMAL POWER. WIRE TO NORMAL CIRCUIT AS SHOWN AND EMERGENCY CIRCUIT EMH1-1.
 - WIRE TO SWITCH BANK 1 - REFER TO DETAIL E1-01/5.
 - WIRE TO SWITCH BANK 2 - REFER TO DETAIL E1-01/5.
 - WIRE TO SWITCH BANK 3 - REFER TO DETAIL E1-01/5.
 - WIRE TO SWITCH BANK A - REFER TO DETAIL E1-01/4.
 - WIRE TO SWITCH BANK B - REFER TO DETAIL E1-01/4.
 - WIRE TO SWITCH BANK C - REFER TO DETAIL E1-01/4.
 - REFER TO DRAWING E1-03 FOR CONTINUATION.
 - CONNECT TO RECEPTACLE CIRCUIT IN ROOM AHEAD OF GFCL.
 - REFER TO DRAWING E1-02 FOR CONTINUATION.
 - EMERGENCY FIXTURE - WIRE AHEAD OF ALL SWITCHES AND CONNECT TO EMERGENCY CIRCUIT EMH2-1.
 - NIGHT LIGHT/EMERGENCY LIGHT - WIRE TO EMERGENCY CIRCUIT EMH2-1.
 - EMERGENCY FIXTURE IN CORRIDOR - WIRE FIXTURE VIA 20A UL924 ELTD SO THAT FIXTURE TURNS ON/OFF WITH OTHER FIXTURES BUT FIXTURE ILLUMINATES UPON LOSS OF NORMAL POWER. WIRE TO EMERGENCY CIRCUIT EMH2-1.
 - EMERGENCY FIXTURE WITH INTERNAL UL924 ELTD - WIRE SO FIXTURE TURNS ON/OFF WITH OTHER FIXTURES BUT FIXTURE ILLUMINATES UPON LOSS OF NORMAL POWER. WIRE TO NORMAL CIRCUIT AS SHOWN AND EMERGENCY CIRCUIT EMH2-1.
 - NIGHT LIGHT/EMERGENCY LIGHT - WIRE TO EMERGENCY CIRCUIT EMH1-7.
 - EMERGENCY FIXTURE IN CORRIDOR - WIRE FIXTURE VIA 20A UL924 ELTD SO THAT FIXTURE TURNS ON/OFF WITH OTHER FIXTURES BUT FIXTURE ILLUMINATES UPON LOSS OF NORMAL POWER. WIRE TO EMERGENCY CIRCUIT EMH1-7.
 - EXTERIOR EMERGENCY CANOPY FIXTURE - WIRE TO NORMAL AND EMERGENCY CIRCUITS VIA EMERGENCY LIGHTING TRANSFER DEVICE AS SHOWN. FIXTURE CONTROLLED ON/OFF THROUGH BAS. UPON LOSS OF NORMAL POWER FIXTURE SHALL ILLUMINATE.
 - EMERGENCY FIXTURE - WIRE TO NORMAL AND EMERGENCY CIRCUITS VIA EMERGENCY LIGHTING TRANSFER DEVICE AS SHOWN. FIXTURE CONTROLLED ON/OFF THROUGH BAS. UPON LOSS OF NORMAL POWER FIXTURE SHALL ILLUMINATE.
 - EMERGENCY FIXTURE WITH BATTERY BACK-UP - WIRE AHEAD OF SWITCHES AND/OR BAS. FIXTURE SHALL OPERATE UPON LOSS OF NORMAL POWER.
 - REFER TO CANOPY LIGHTING PLAN E1-01/2 FOR CONTINUATION.
 - REFER TO AREA 100 LIGHTING PLAN E1-01/1 FOR CONTINUATION.


3 AREA 100 - VESTIBULE 101 CANOPY
1/8" = 1'-0"

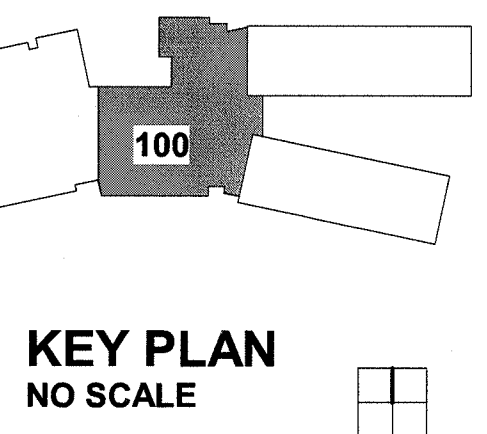

ID	DATE	DESCRIPTION
1	06/14/19	ADDENDUM 03

DRAWN BY: JPT
CHECKED BY: RA

WALL RATINGS LEGEND	
	1 HR RATED WALL
	2 HR RATED WALL

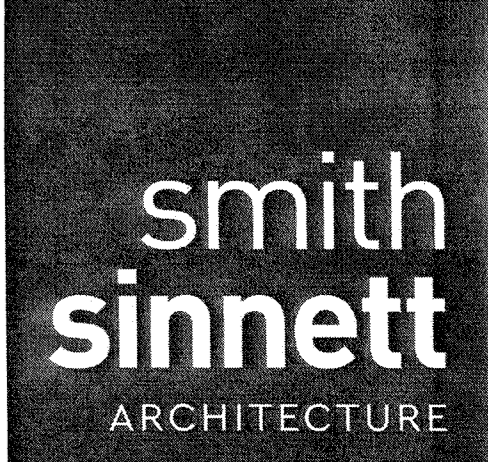

1145 101 002
 710 101 200
 4000 Lake Boone Trail
 Raleigh, NC 27607
 info@smithsinnett.com

pdc
 Progressive Design Collaborative, Inc.
 5101 Piedmont Court, Suite 350
 Raleigh, North Carolina 27604
 919-790-0992
 PROJECT #1104
 06/14/19
 pdcra.com

REGISTERED PROFESSIONAL ENGINEER
 STATE OF NORTH CAROLINA
 No. 34433
 DATE: 6/13/19

CONSTRUCTION DOCUMENT

ENERGY STAR PARTNER
VOLUME II

This drawing and the design shown is the property of Smith Sinnett & Associates, Inc. and shall remain the property of the Architect. No part of this drawing may be reproduced, stored in a retrieval system, or transmitted in any form or by any means, electronic, mechanical, photocopying, recording, or by any information storage and retrieval system, without the prior written permission of the Architect. The date of completion of the drawing is 06/13/19.


Smith Sinnett & Associates, P.A. 2019
 THIS DRAWING IS FORMATTED TO BE PRINTED ON A 36" x 48" SHEET

- NOTES: (AS SHOWN ON THIS PLAN WITH A NUMBER IN A ○)
- EMERGENCY FIXTURE - WIRE AHEAD OF ALL SWITCHES AND CONNECT TO EMERGENCY LIGHTING CIRCUIT EMH1-9.
 - NIGHT LIGHT/EMERGENCY LIGHT - WIRE TO EMERGENCY CIRCUIT EMH1-9.
 - EMERGENCY FIXTURE IN CORRIDOR - WIRE FIXTURE VIA 20A UL 924 ELTD SO THAT FIXTURE TURNS ON/OFF WITH OTHER FIXTURES BUT FIXTURE ILLUMINATES UPON LOSS OF NORMAL POWER. WIRE TO NORMAL CIRCUIT INDICATED AND EMERGENCY CIRCUIT EMH1-11.
 - EMERGENCY FIXTURE WITH INTERNAL UL924 ELTD - WIRE SO FIXTURE TURNS ON/OFF WITH OTHER FIXTURES BUT FIXTURE ILLUMINATES UPON LOSS OF NORMAL POWER. WIRE TO NORMAL CIRCUIT AS SHOWN AND EMERGENCY CIRCUIT EMH1-9.
 - CONTINUE UP TO LIGHTS IN SECOND FLOOR STAIRWELL.
 - REFER TO DRAWING FOR CONTINUATION.
 - EMERGENCY FIXTURE - WIRE AHEAD OF ALL SWITCHES AND CONNECT TO EMERGENCY LIGHTING CIRCUIT EMH1-11.
 - NIGHT LIGHT/EMERGENCY LIGHT - WIRE TO EMERGENCY CIRCUIT EMH1-11.
 - EMERGENCY FIXTURE WITH INTERNAL UL924 ELTD - WIRE SO FIXTURE TURNS ON/OFF WITH OTHER FIXTURES BUT FIXTURE ILLUMINATES UPON LOSS OF NORMAL POWER. WIRE TO NORMAL CIRCUIT AS SHOWN AND EMERGENCY CIRCUIT EMH1-11.
 - CONTINUED TO EXTERIOR LIGHTING ON DRAWING E1-02.
 - EMERGENCY FIXTURE IN OPEN AREA - WIRE FIXTURE VIA 20A UL 924 ELTD SO THAT FIXTURE TURNS ON/OFF WITH OTHER FIXTURES BUT FIXTURE ILLUMINATES UPON LOSS OF NORMAL POWER. WIRE TO NORMAL CIRCUIT INDICATED AND EMERGENCY CIRCUIT EMH1-11.



1 FIRST FLOOR LIGHTING PLAN - AREA 300
 1" = 1'-0"


**NEW TRINITY MIDDLE SCHOOL
 RANDOLPH COUNTY SCHOOL SYSTEM**
 Parcel PIN 7708118367
 Surrett Drive
 Trinity, NC 27370

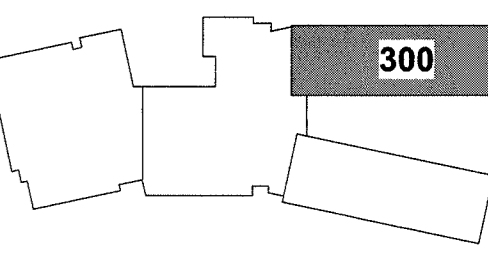

ID	DATE	DESCRIPTION
1	06/14/19	ADDENDUM 03

DRAWN BY: JPT
 CHECKED BY: RA

FIRST FLOOR LIGHTING PLAN - AREA 300

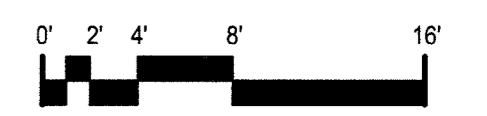


2017032 20 MAY 2019

E1-03

C:\Users\jpt\Documents\17104_TRINITY_MBS_PDC_Central_middleschool.rvt 6/13/2019 11:55:30 AM

WALL RATINGS LEGEND	
	1 HR RATED WALL
	2 HR RATED WALL

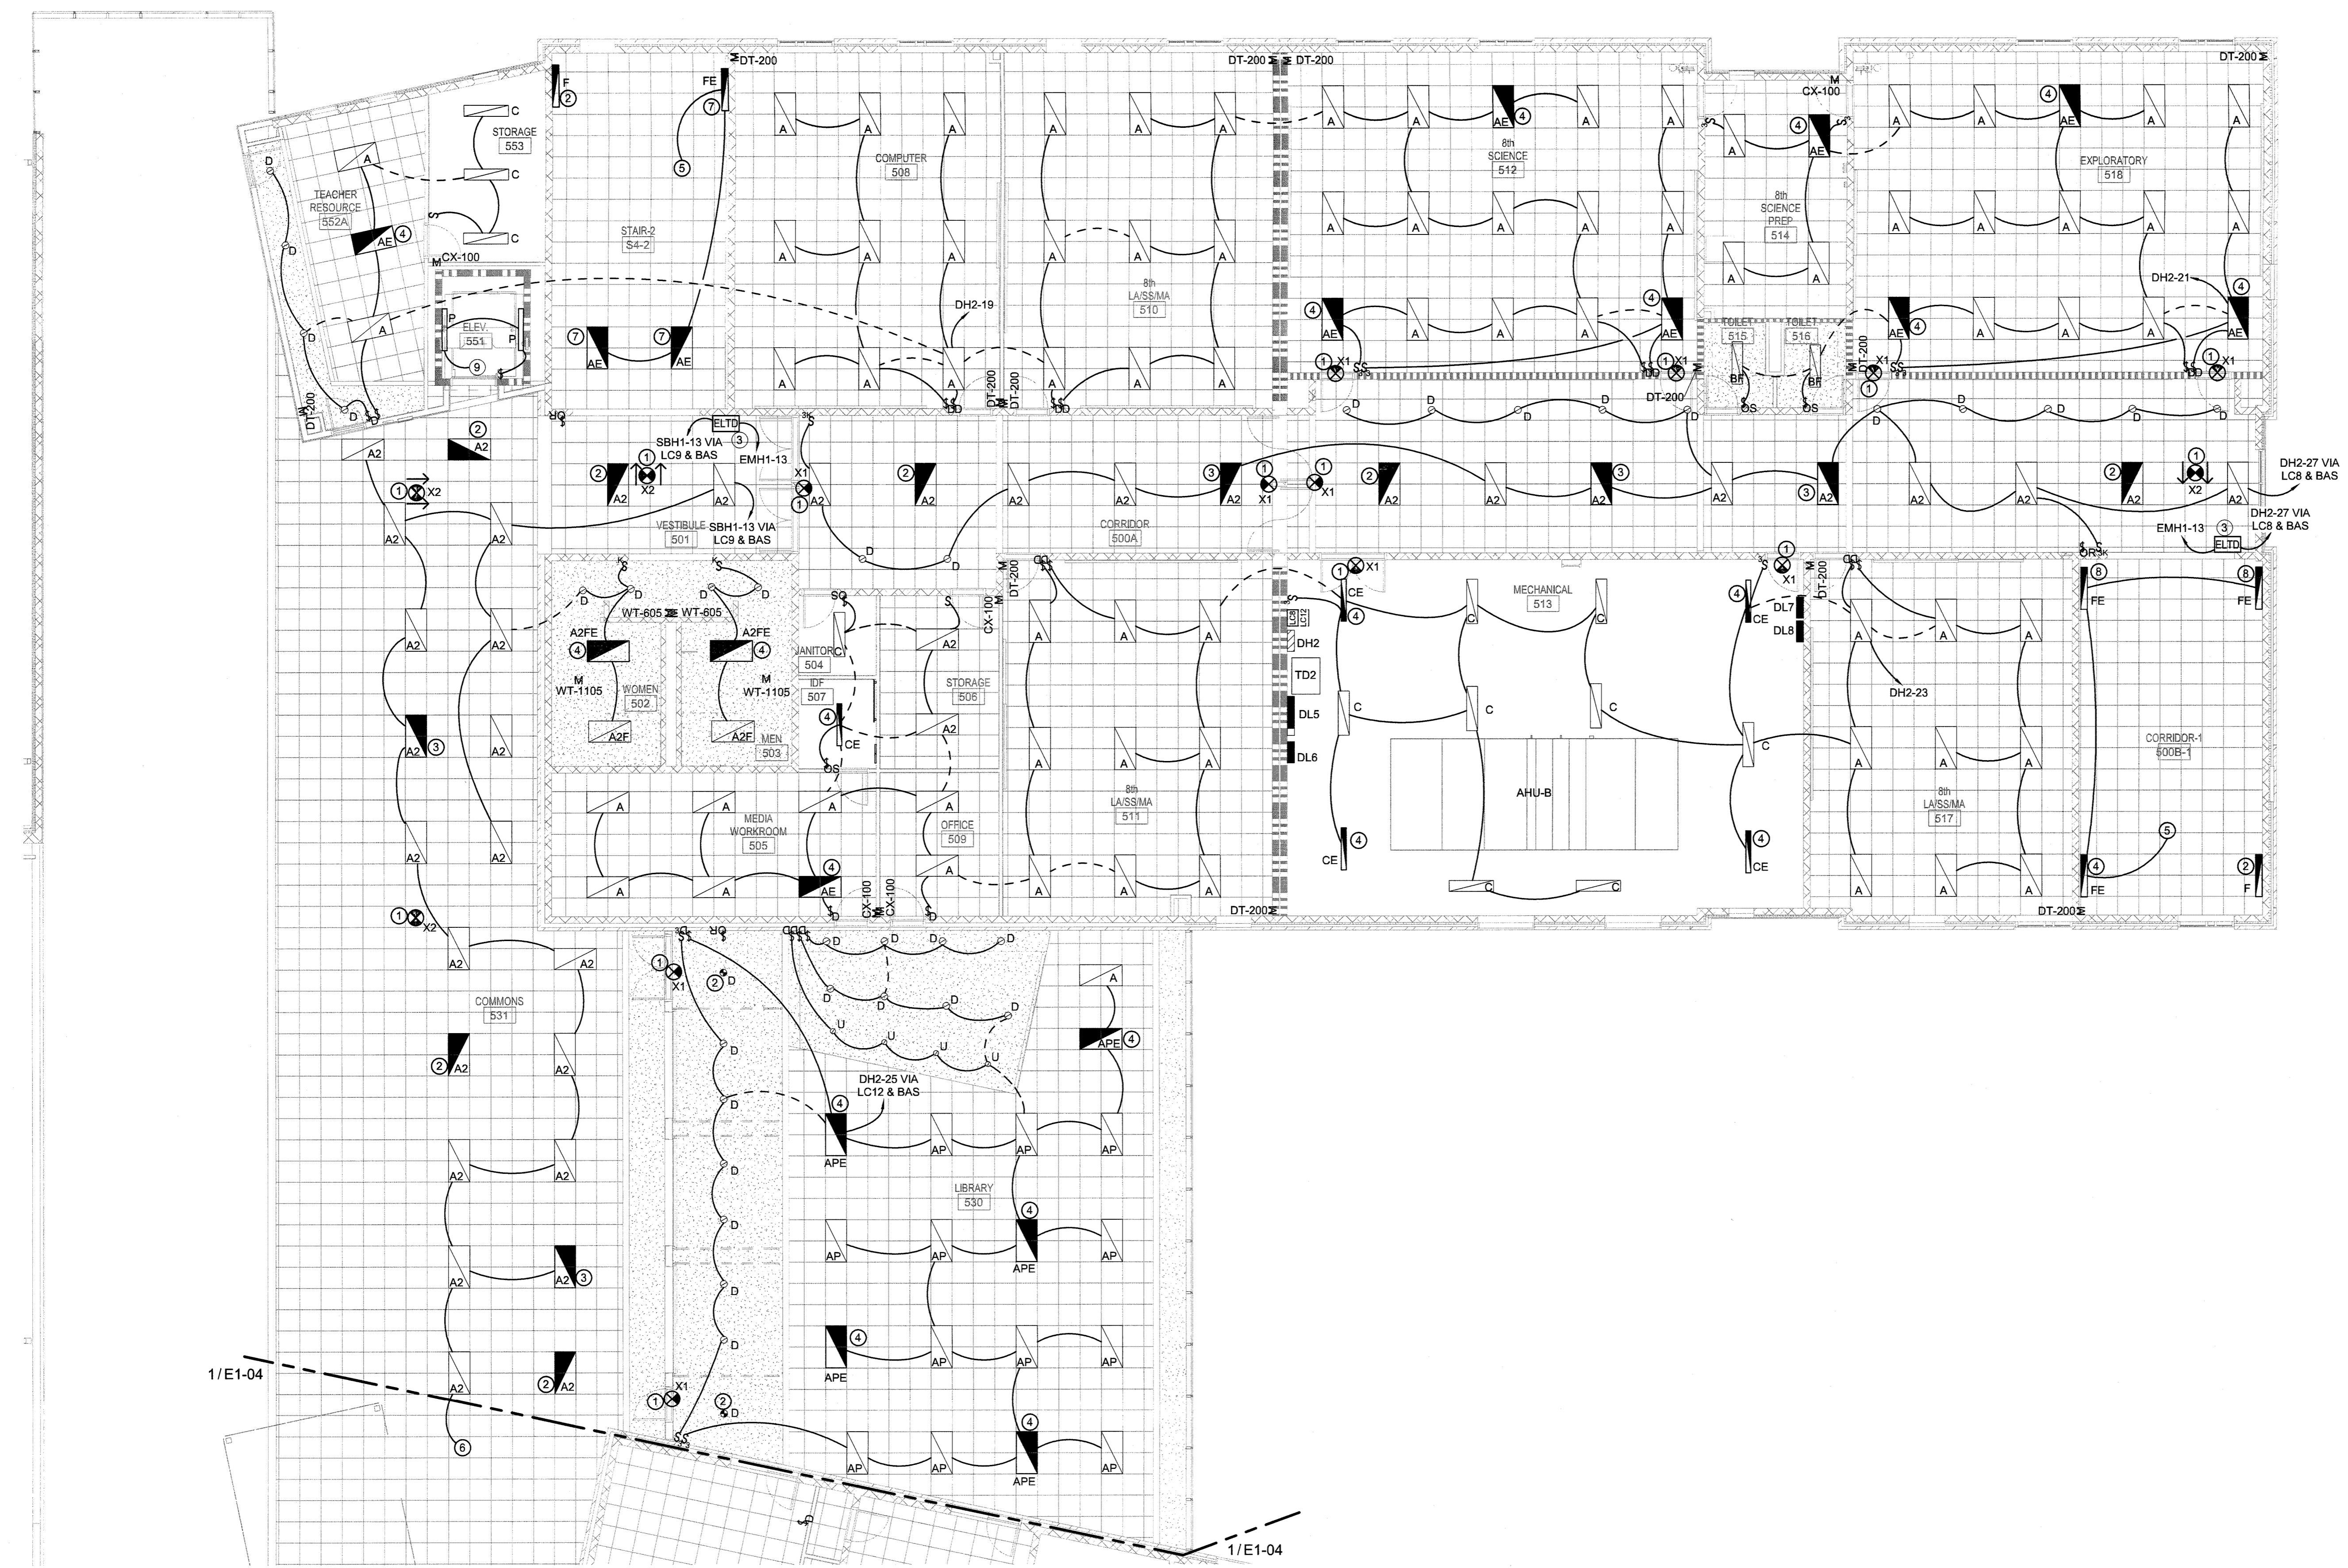

GENERAL NOTES


A. OUTLET BOXES AT MECHANICAL OR ELECTRICAL ROOMS ON FIRE RATED WALLS SHALL BE SURFACE MOUNTED.

- NOTES: (AS SHOWN ON THIS PLAN WITH A NUMBER IN A ○)
- EMERGENCY FIXTURE - WIRE AHEAD OF ALL SWITCHES AND CONNECT TO EMERGENCY CIRCUIT EMH1-13.
 - NIGHT LIGHT - WIRE TO EMERGENCY CIRCUIT EMH1-13.
 - EMERGENCY FIXTURE IN CORRIDOR - WIRE FIXTURE VIA 20A UL 924 ELTD SO THAT FIXTURE TURNS OFF WITH OTHER FIXTURES BUT FIXTURE ILLUMINATES UPON LOSS OF NORMAL POWER. WIRE TO NORMAL CIRCUIT AS INDICATED AND EMERGENCY CIRCUIT EMH1-13.
 - EMERGENCY FIXTURE WITH INTERNAL UL924 ELTD - WIRE SO FIXTURE TURNS ON/OFF WITH OTHER FIXTURES BUT FIXTURE ILLUMINATES UPON LOSS OF NORMAL POWER. WIRE TO NORMAL CIRCUIT AS SHOWN AND EMERGENCY CIRCUIT EMH1-13.
 - CONTINUED DOWN TO FIRST FLOOR STAIRWELL LIGHTING CIRCUIT.
 - REFER TO DRAWING E1-041 FOR CONTINUATION.
 - EMERGENCY FIXTURE WITH INTERNAL UL924 ELTD - WIRE SO FIXTURE TURNS ON/OFF WITH OTHER FIXTURES BUT FIXTURE ILLUMINATES UPON LOSS OF NORMAL POWER. WIRE TO NORMAL CIRCUIT SBH1-9 AND EMERGENCY CIRCUIT EMH1-9.
 - EMERGENCY FIXTURE WITH INTERNAL UL924 ELTD - WIRE SO FIXTURE TURNS ON/OFF WITH OTHER FIXTURES BUT FIXTURE ILLUMINATES UPON LOSS OF NORMAL POWER. WIRE TO NORMAL CIRCUIT DH1-11 AND EMERGENCY CIRCUIT EMH1-11.
 - CONNECT TO SECOND FLOOR ELEVATOR RECEPTACLE CIRCUIT AHEAD OF GFCI.

1 SECOND FLOOR LIGHTING PLAN - AREA 500
1/8" = 1'-0"

**NEW TRINITY MIDDLE SCHOOL
RANDOLPH COUNTY SCHOOL SYSTEM**

Parcel PIN 7708118367
Surrett Drive
Trinity, NC 27370

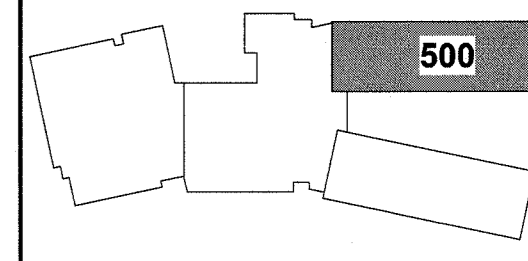


KEY PLAN
NO SCALE

ID	DATE	DESCRIPTION
1	06/14/19	ADDENDUM 03


DRAWN BY: Author
CHECKED BY: RA

**SECOND FLOOR
LIGHTING PLAN -
AREA 500**

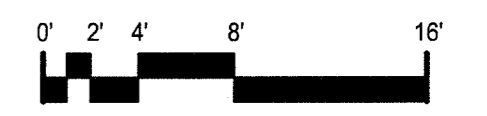

C:\Users\jchick\Documents\17104_TRINITYMS_PDC_Central_Chickoo.rvt
6/13/2019 11:56:45 AM

WALL RATINGS LEGEND	
	1 HR RATED WALL
	2 HR RATED WALL

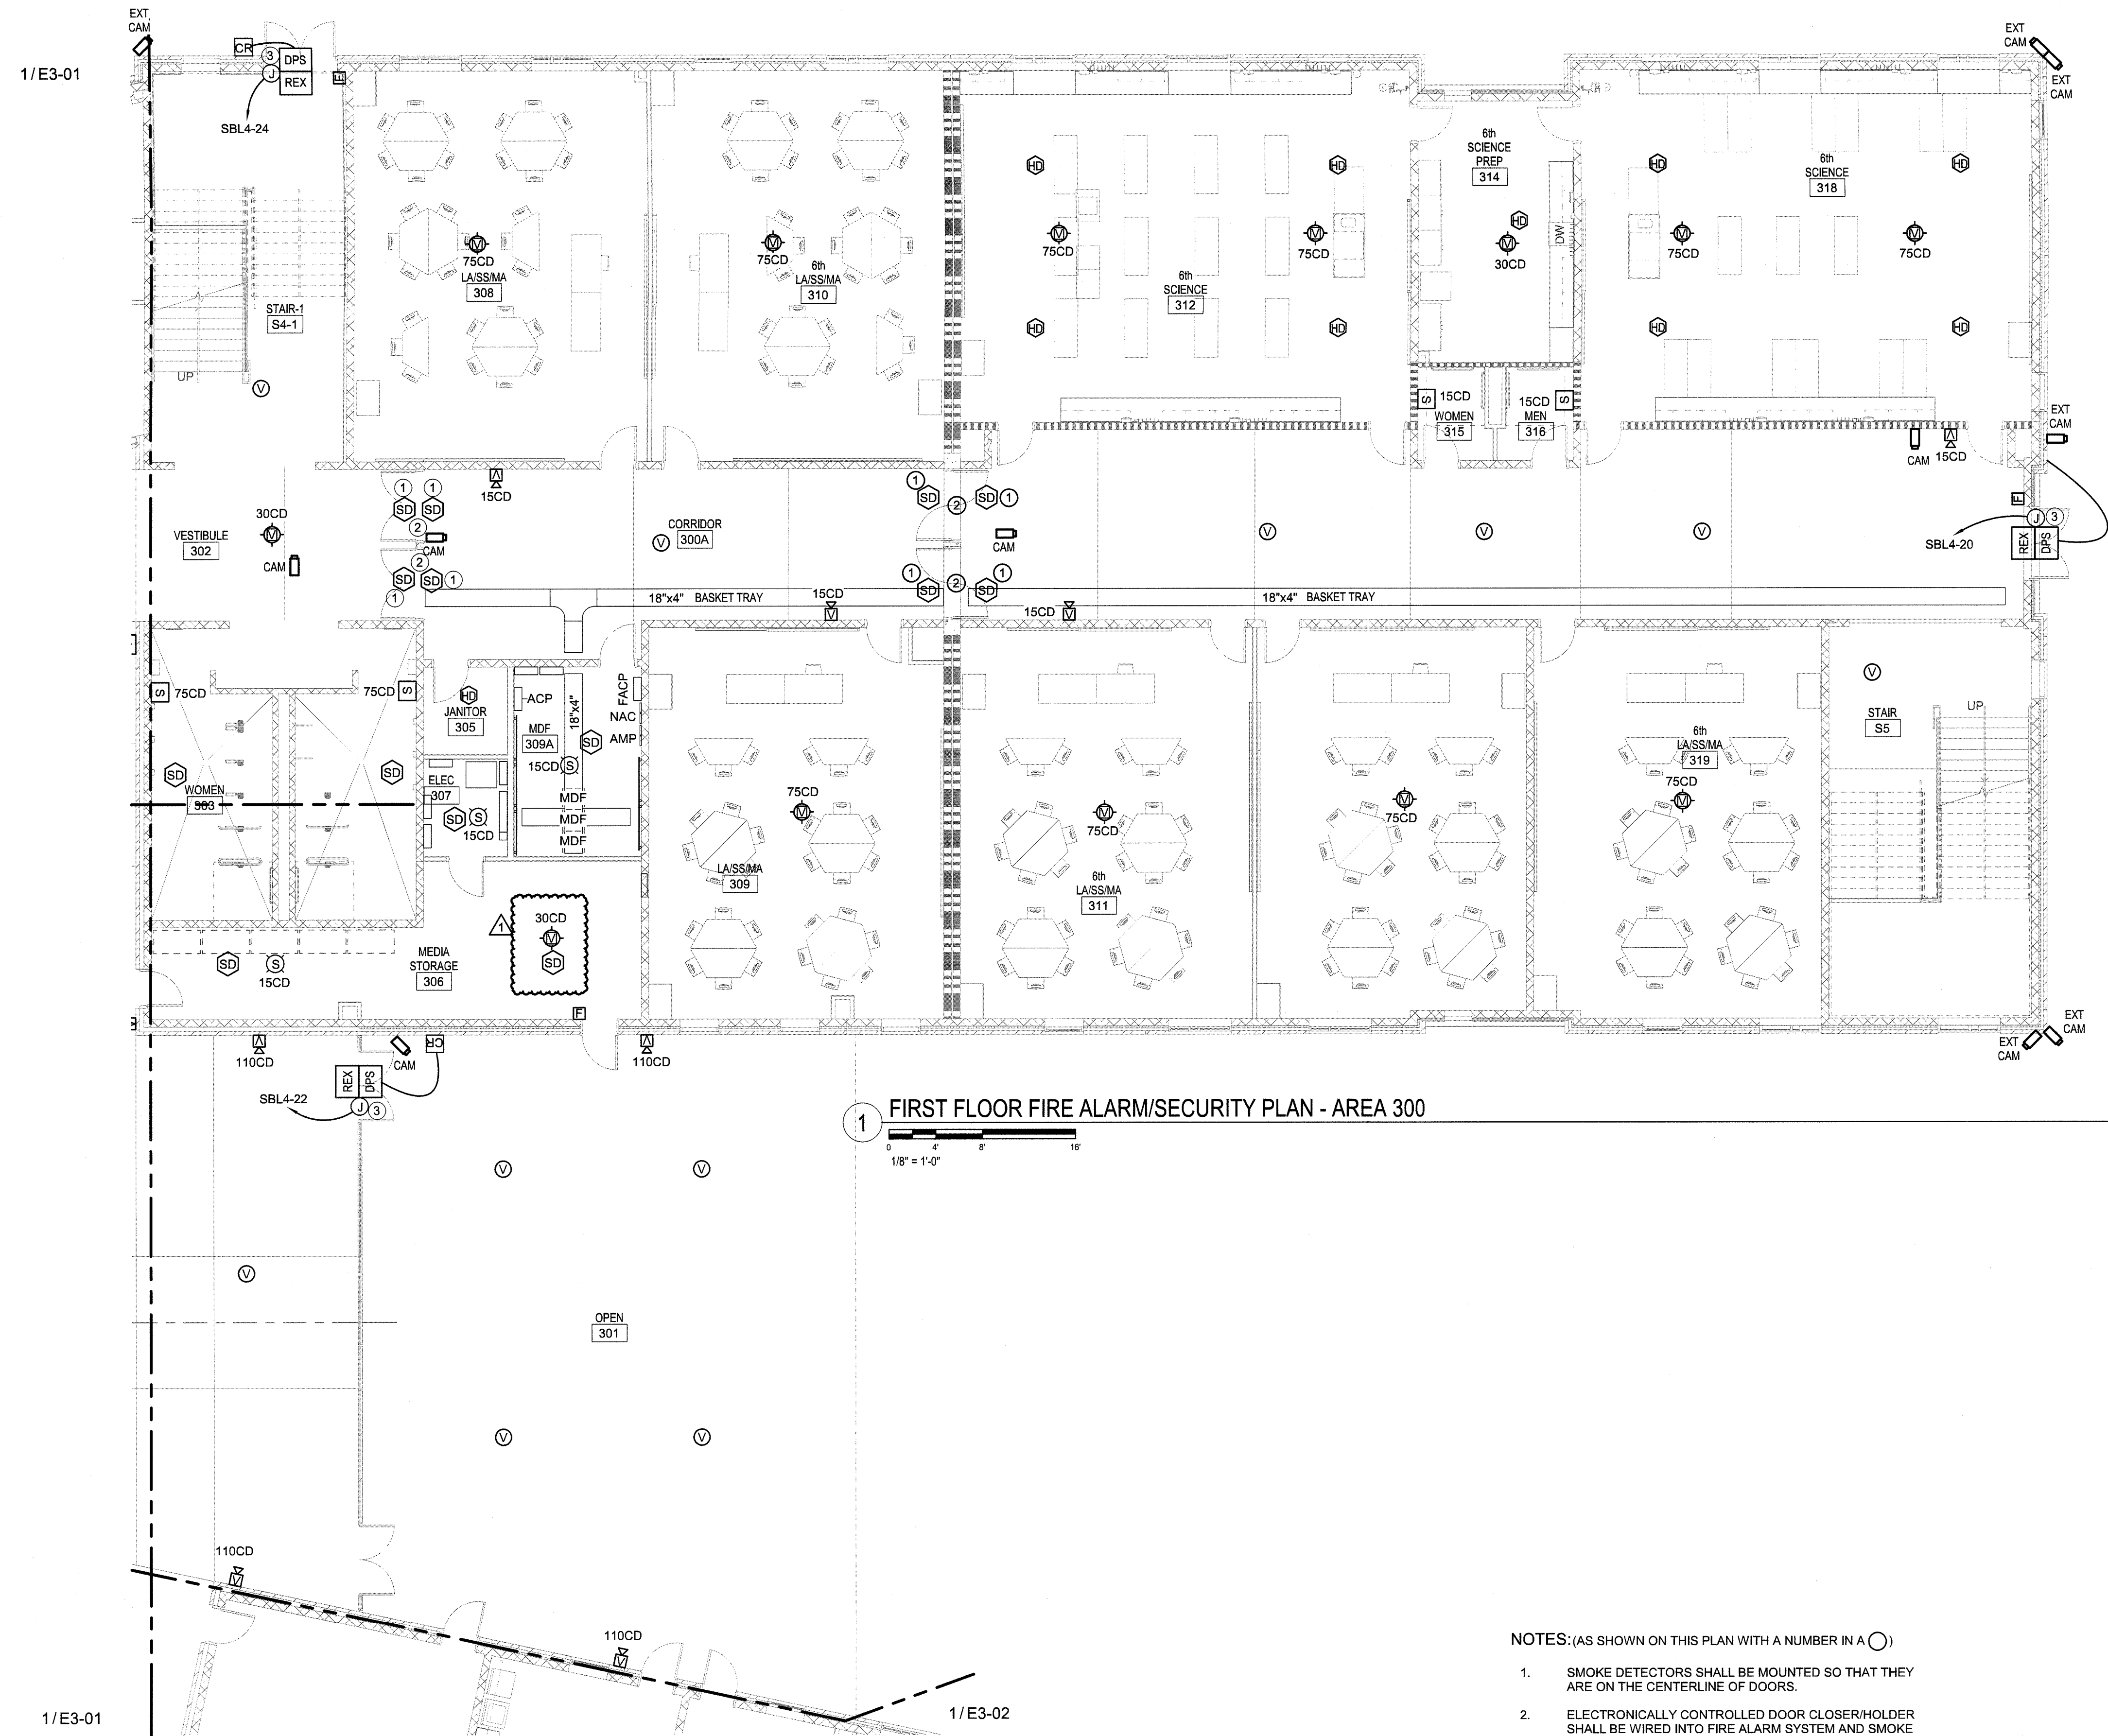

1 FIRST FLOOR FIRE ALARM/SECURITY PLAN - AREA 300
1/8" = 1'-0"

NOTES: (AS SHOWN ON THIS PLAN WITH A NUMBER IN A ○)


- SMOKE DETECTORS SHALL BE MOUNTED SO THAT THEY ARE ON THE CENTERLINE OF DOORS.
- ELECTRONICALLY CONTROLLED DOOR CLOSER/HOLDER SHALL BE WIRED INTO FIRE ALARM SYSTEM AND SMOKE DETECTORS SO THAT DOORS RELEASE UPON ACTIVATION OF SYSTEM.
- PROVIDE 120VAC POWER FOR ACCESS CONTROLLED DOOR. COORDINATE EXACT LOCATION WITH ARCHITECT/OWNER/DOOR HARDWARE CONTRACTOR PRIOR TO ROUGH-IN.

GENERAL NOTES:

- ALL FIRE ALARM WIRING SHALL BE IN CONDUIT. REFER TO SPECIFICATIONS.
- CABLE TRAY IS FOR NETWORK CABLING.
- REFER TO E2 SERIES OF DRAWINGS FOR CONDUIT SLEEVES.
- CARD READERS AND ACCESS CONTROL DEVICES SHALL BE PROVIDED BY OWNER'S SECURITY CONTRACTOR. **NOTE:** ALL ROUGH-IN SHALL BE BY THE ELECTRICAL CONTRACTOR.
- ALL CAMERAS AND MOUNTS SHALL BE PROVIDED BY THE OWNER'S SECURITY CONTRACTOR. THE CAT-6 WIRING FOR THE CAMERAS SHALL BE BY THE DIVISION 27 CONTRACTOR. THIS INCLUDES THE SMB CONNECTORS. THE 3FT CAT-6 PATCH CABLES TO THE CAMERAS SHALL BE BY THE DIVISION 27 CONTRACTOR.

**NEW TRINITY MIDDLE SCHOOL
RANDOLPH COUNTY SCHOOL SYSTEM**

Parcel PIN 7708118367
Surrett Drive
Trinity, NC 27370

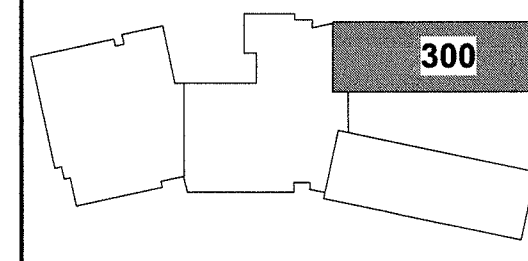



KEY PLAN
NO SCALE

ID	DATE	DESCRIPTION
1	06/14/19	ADDENDUM 03

DRAWN BY: _____ Author
CHECKED BY: _____ RA


FIRST FLOOR FIRE ALARM/SECURITY PLAN - AREA 300

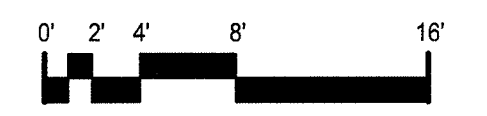

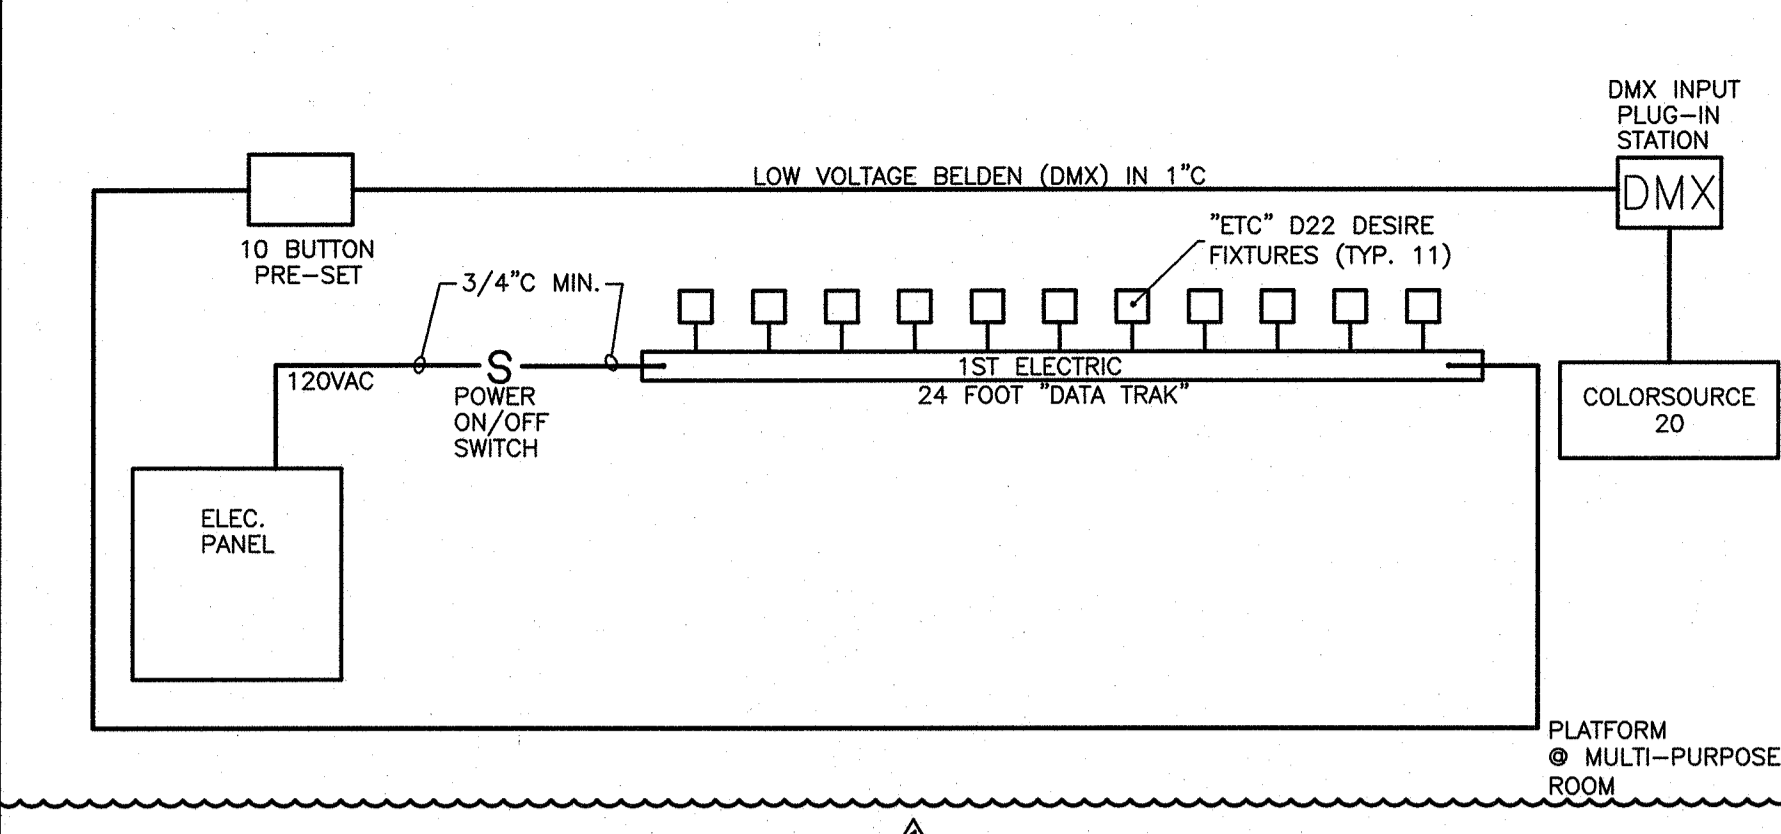


- NOTES:
- THIS PLATFORM LIGHTING SYSTEM DESIGN BASIS IS SYSTEM AS MANUFACTURED BY ELECTRONIC THEATER CONTROLS ("ETC") OR APPROVED EQUAL. EQUAL MANUFACTURERS SHALL BE RESPONSIBLE FOR FURNISHING ALL PARTS, PIECES AND COMPONENTS REQUIRED SO THAT THE EQUAL PRODUCT PERFORMS IN AN EQUIVALENT MANNER AS THE SYSTEM SPECIFIED. EQUIVALENT SYSTEMS SHALL BE SUBMITTED TO DAYS PRIOR TO BID FOR CONSIDERATION AND APPROVAL.
 - THIS SYSTEM SHALL INCLUDE ALL DEVICES, CONSOLE AND EQUIPMENT FOR A 100% COMPLETE AND OPERABLE SYSTEM.
 - THE ELECTRICAL CONTRACTOR SHALL PROVIDE AND INSTALL ALL CONDUIT, POWER CABLE, LOW VOLTAGE CABLES, SWITCHES AND MOUNT AND INSTALL ALL EQUIPMENT. THE ELECTRICAL CONTRACTOR SHALL COORDINATE WITH THE EQUIPMENT SUPPLIER FOR THIS INSTALLATION SUCH THAT THE SUPPLIER (ETC) IS INVOLVED CLOSELY WITH THE INSTALLATION. THE LIGHTING SYSTEM SHALL BE PURCHASED THRU A SYSTEMS INTEGRATOR (BARBIZON, ATLAS-STAGEWORKS OR BANDIT).
 - THE SYSTEM SHALL BE 100% TESTED AND VERIFIED PRIOR TO OWNER TRAINING.
 - LOCATIONS OF DATA TRAK SHALL BE COORDINATED CLOSELY TO AVOID INTERFERENCES. INTEGRATOR EQUIPMENT PROVIDER SHALL LOCATE TRAK FOR OPTIMUM PERFORMANCE. TRACKS SHALL BE SUPPORTED SECURELY FROM STRUCTURE.
 - ALL WIRING SHALL BE IN CONDUIT.
 - THE SYSTEM SHALL BE PROVIDED WITH ALL BUTTON STATION, CONTROL CONSOLE, DMX CONNECTION, LOW VOLTAGE WIRING, LINE VOLTAGE WIRING, CONNECTORS, FEEDERS, FIXTURES, TRACKS, SUPPORT ACCESSORIES, ETC FOR A COMPLETE AND OPERATIONAL TRACK LIGHTING SYSTEM.

NOT USED

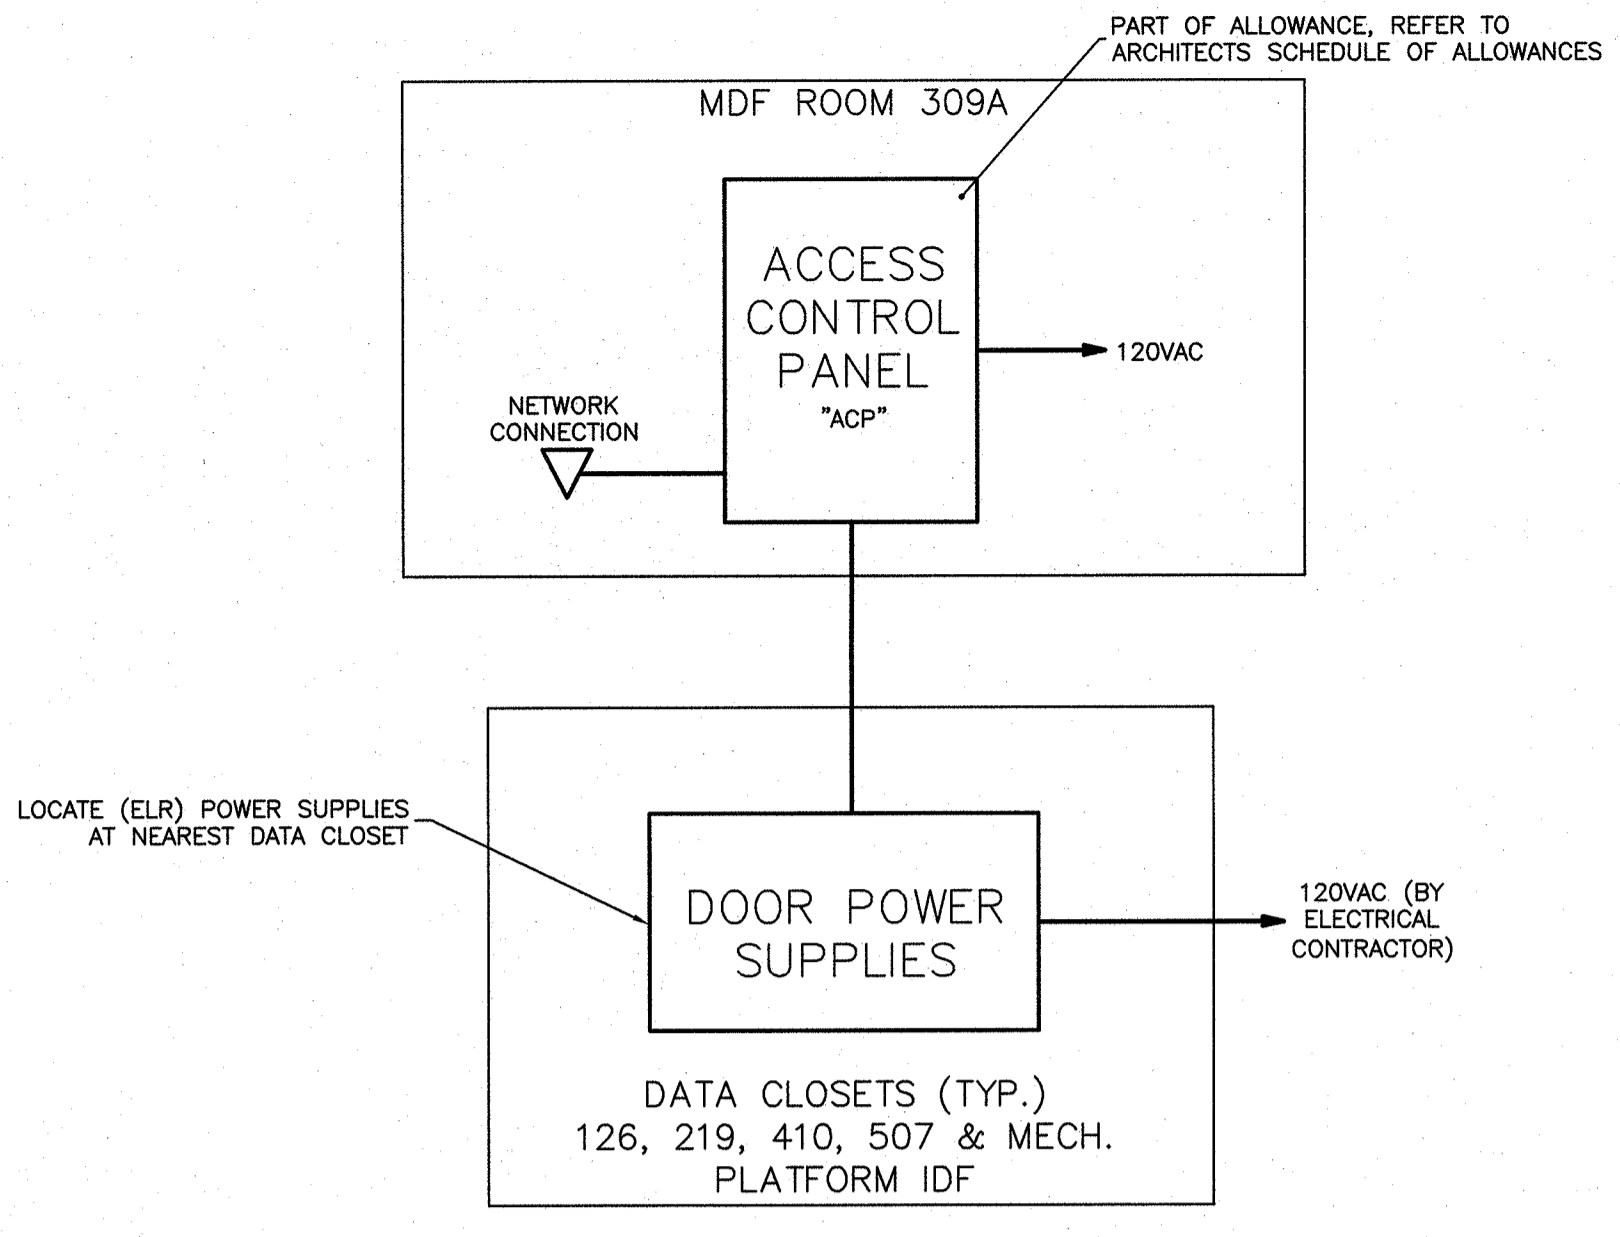


- GENERAL NOTES:
- ALL WORK SHALL BE COORDINATED BETWEEN OWNER, ARCHITECT, ELECTRICAL CONTRACTOR, OWNER'S ACCESS CONTROL CONTRACTOR AND DOOR HARDWARE CONTRACTOR PRIOR TO ROUGH-IN. A PRE-INSTALLATION MEETING SHALL OCCUR PRIOR TO INSTALLATION. AN ALLOWANCE AS IDENTIFIED IN THE ARCHITECTS SCHEDULE OF ALLOWANCES IS PROVIDED FOR THE ACCESS CONTROL SYSTEM. ALL ROUGH-INS, CONDUIT OUTLET BOXES, 120VAC SHALL BE PROVIDED AS PART OF THE CONTRACT AND NOT THE ALLOWANCE. THE ALLOWANCE WILL COVER ALL CARD READERS, HEAD-END EQUIPMENT, LOW VOLTAGE WIRING, AND ANY ACCESSORIES REQUIRED FOR A 100% COMPLETE SYSTEM. REFER TO THE DOOR HARDWARE SPECIFICATION / SCHEDULE. IF THERE ARE ANY COMPONENTS THAT ARE NOT SPECIFIED IN THE DOOR HARDWARE SPECIFICATIONS THEN IT SHALL BE INCLUDED IN THE ALLOWANCE. SEE ARCHITECTS SCHEDULE FOR ALLOWANCES.
 - REFER TO DOOR HARDWARE SPECIFICATION.
 - ALL ROUGH-INS SHALL BE COORDINATED WITH THE OWNER AND ACCESS CONTROL SYSTEM CONTRACTOR HIRED UNDER THE ALLOWANCE.
 - AS-BUILT DRAWINGS SHALL BE SUBMITTED AS PART OF O&M MANUALS.
 - POWER SUPPLIES SHALL BE LOCATED AT IDF/MDF CLOSETS AS REQUIRED FOR EASE OF MAINTENANCE BY RANDOLPH MAINTENANCE.
 - ALL 120VAC POWER THAT IS REQUIRED FOR SYSTEM SHALL BE COORDINATED AND PROVIDED BY THE ELECTRICAL CONTRACTOR.
 - DOOR DETAILS E0-07/05/07 & /09 ARE FOR REFERENCE ONLY. THE INSTALLATION REQUIREMENTS SHALL BE AS PER DOOR HARDWARE REQUIREMENTS. CARD READERS, STRIKES, POWER SUPPLIES, REX MOTIONS AND ASSOCIATED CONDUIT AND WIRING SHALL BE COORDINATED CLOSELY BETWEEN TRADES.
 - CARD READERS MOUNTED IN SINGLE GANG BOX WITH 3/4" CONDUIT TO JUNCTION BOX AND/OR CEILING VOID. COORDINATE CLOSELY.
 - ALL REX LOCATIONS, DOOR POSITION SWITCHES SHALL BE COORDINATED AND ROUGHED-IN BY THE ELECTRICAL CONTRACTOR.
 - REFER TO ARCHITECTURAL DOOR SCHEDULE AND ELECTRICAL PLANS FOR DOOR ACCESS CONTROL LOCATIONS.
 - THE ELECTRICAL CONTRACTOR SHALL COORDINATE WITH THE OWNER/OTHERS AND PROVIDE 3/4" RACEWAY FROM DOOR FRAMES TO ALLOW FOR THE DOOR CLOSER/HOLDERS TO BE WIRED INTO THE OWNER'S ACCESS CONTROL SYSTEM. APPLICABLE AREAS: (2) DOUBLE DOORS VESTIBULE 201, (2) DOUBLE DOORS VESTIBULE 302, (2) DOUBLE DOORS VESTIBULE 402, (2) DOUBLE DOORS VESTIBULE 501.


DETAIL NOT TO SCALE DOOR ACCESS CONTROL SYSTEM RISER 08

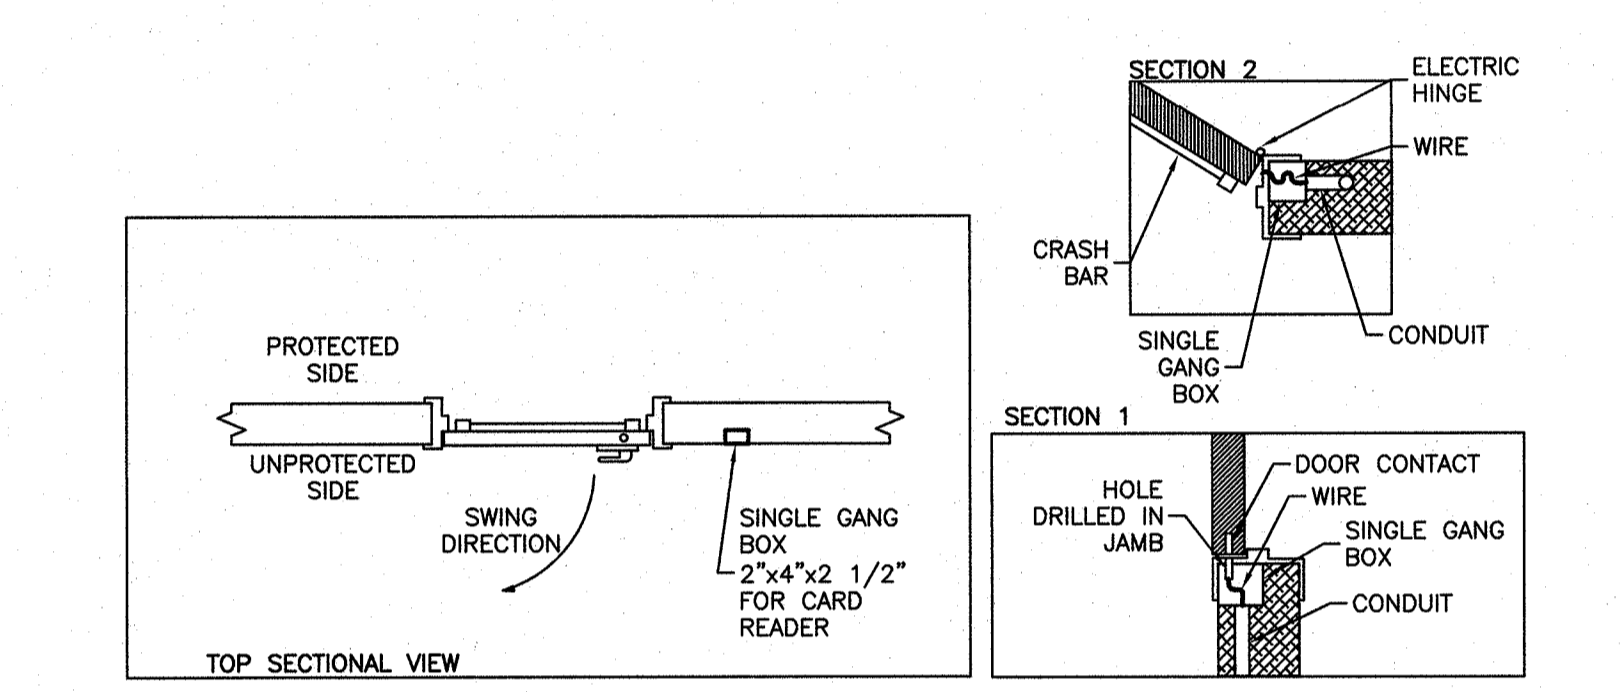


DETAIL NOT TO SCALE CHORUS 615 LED DIMMING RISER 06

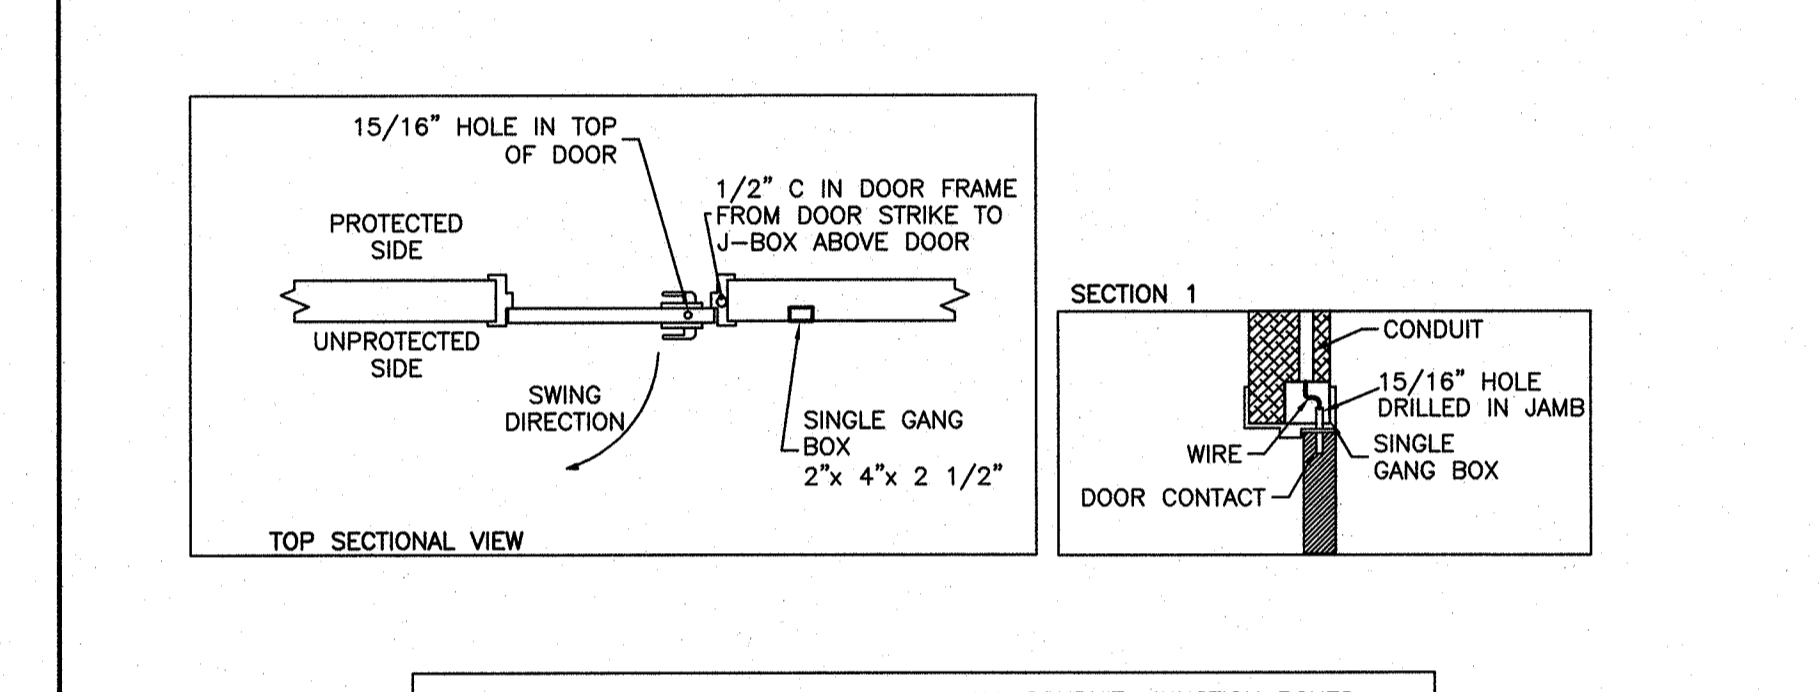


DETAIL NOT TO SCALE 03

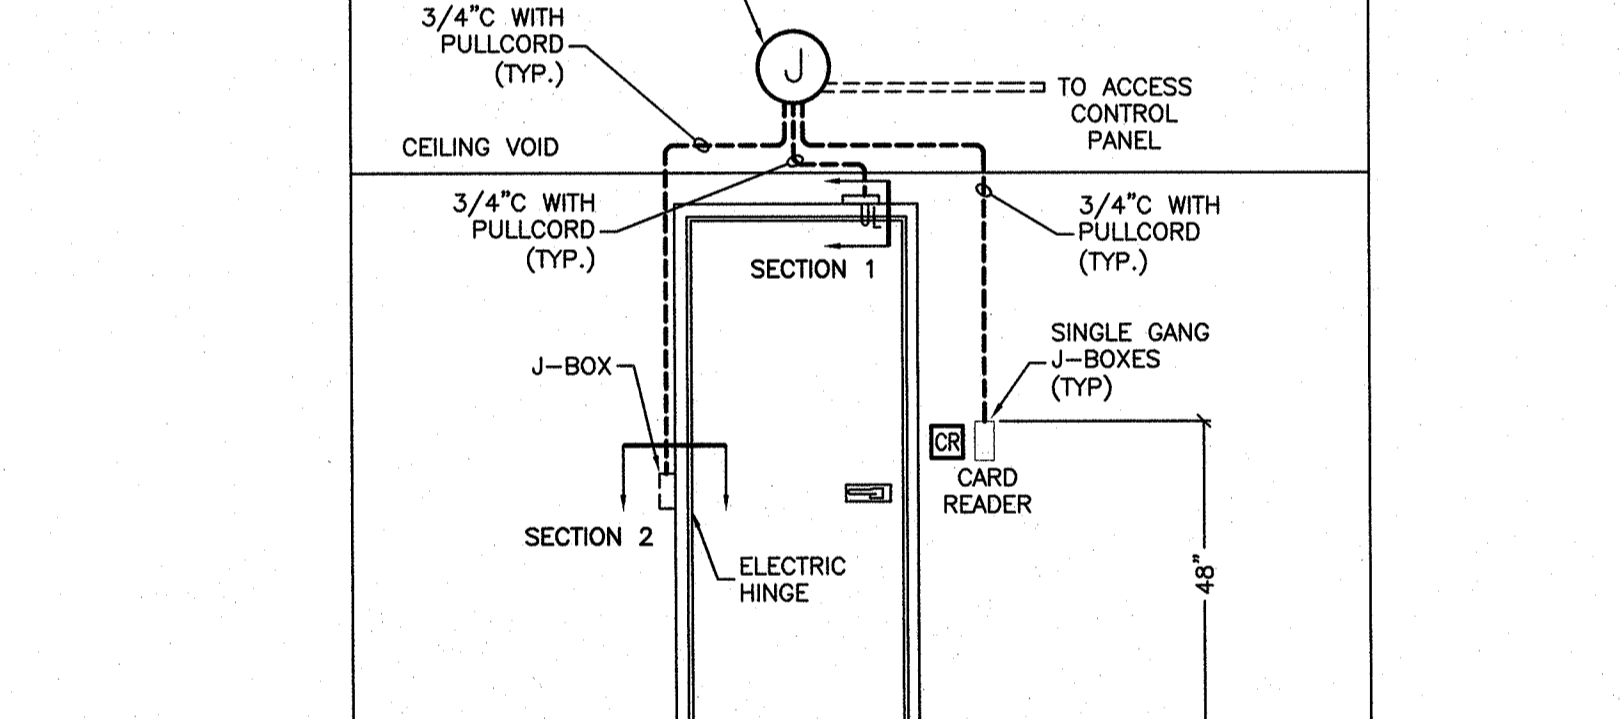


DETAIL NOT TO SCALE 02

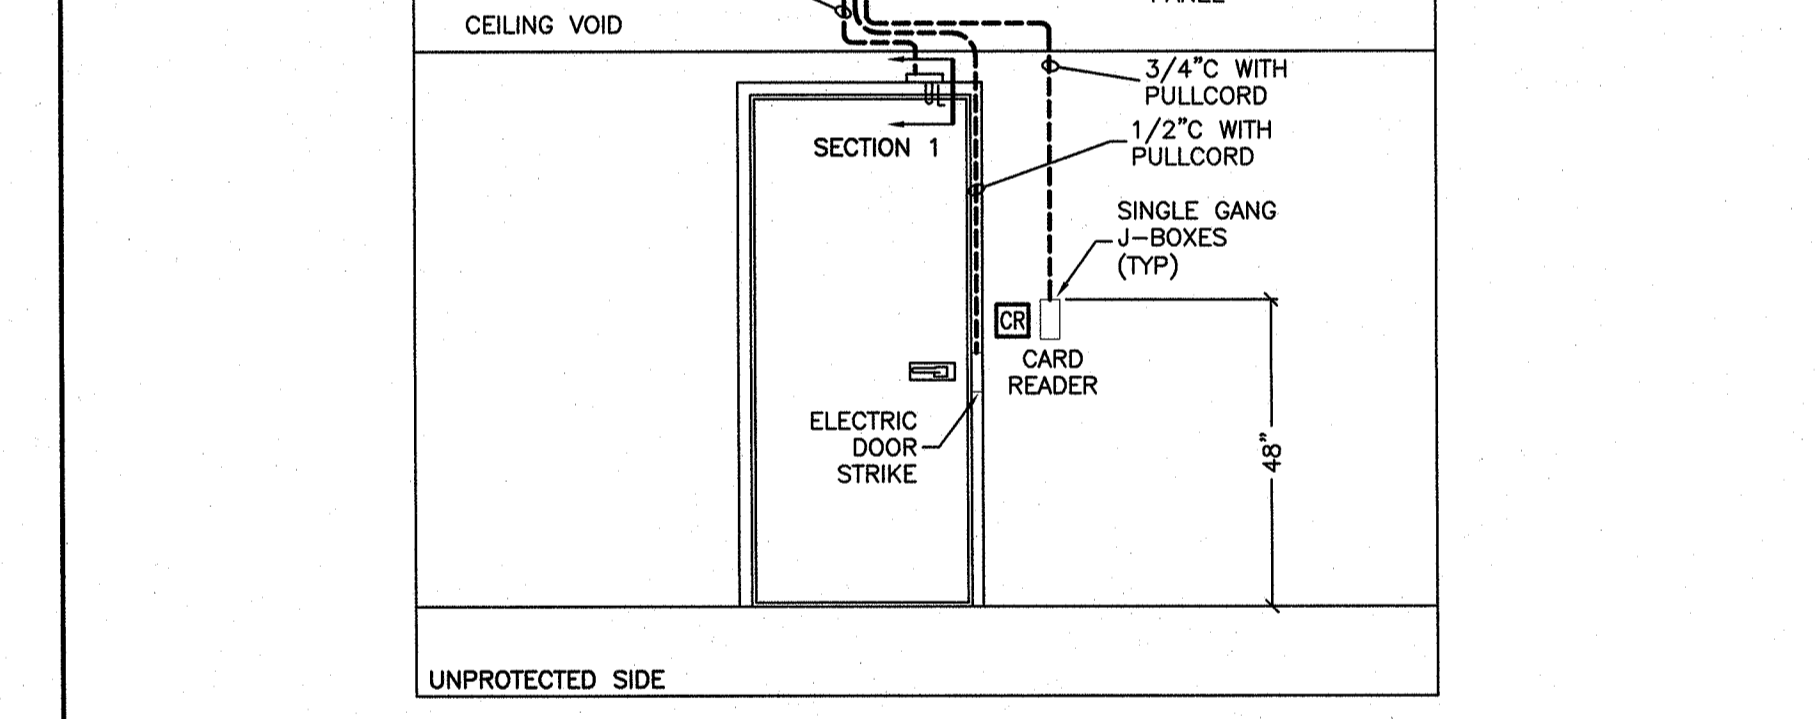

DETAIL NOT TO SCALE 09

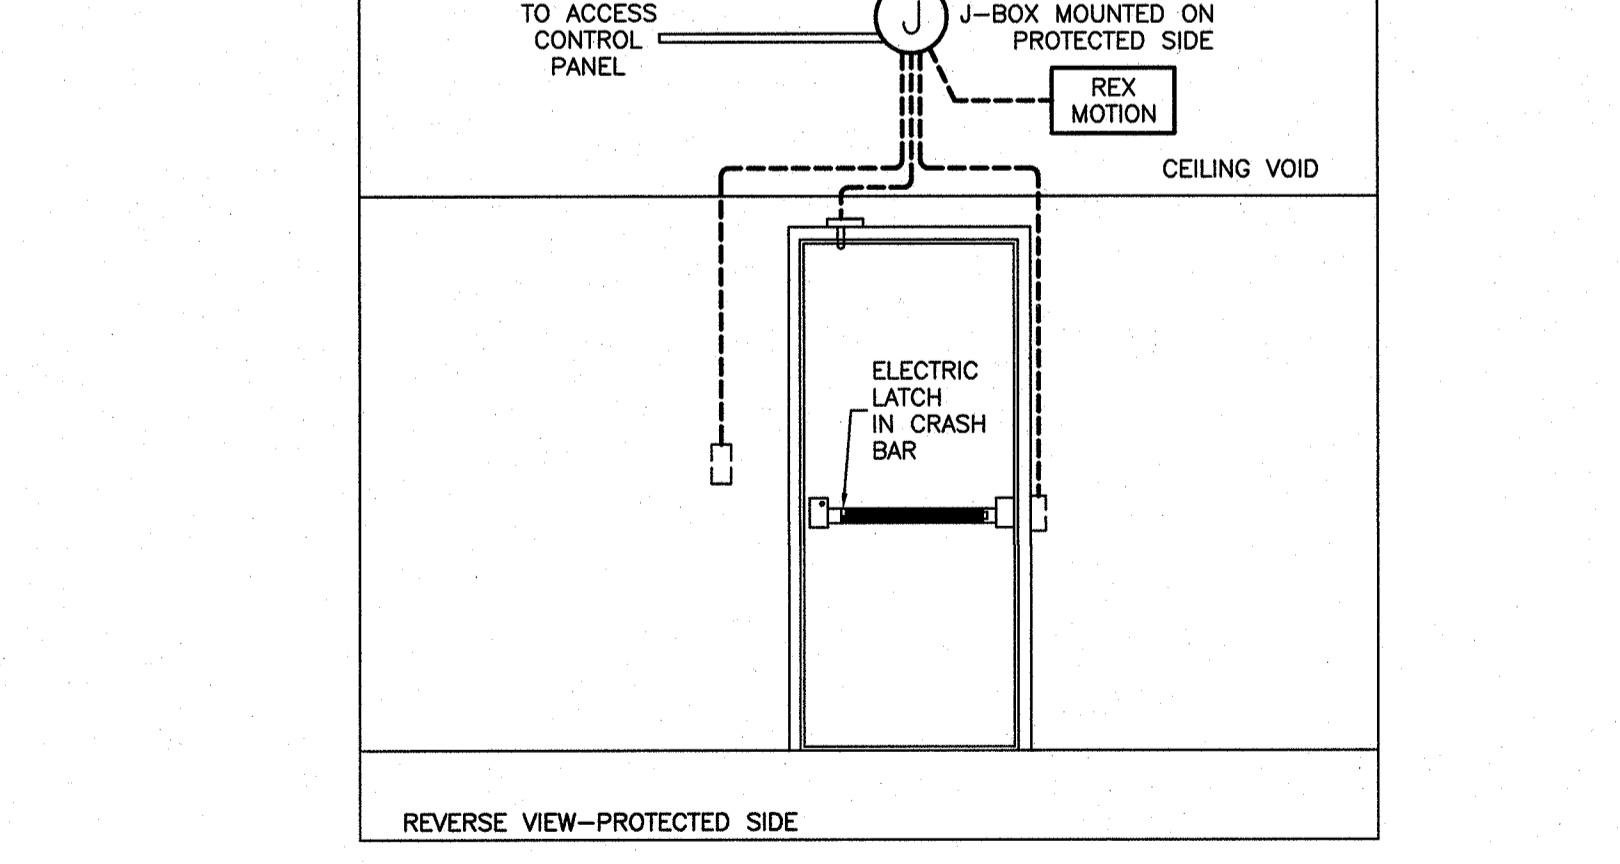

DETAIL NOT TO SCALE 07

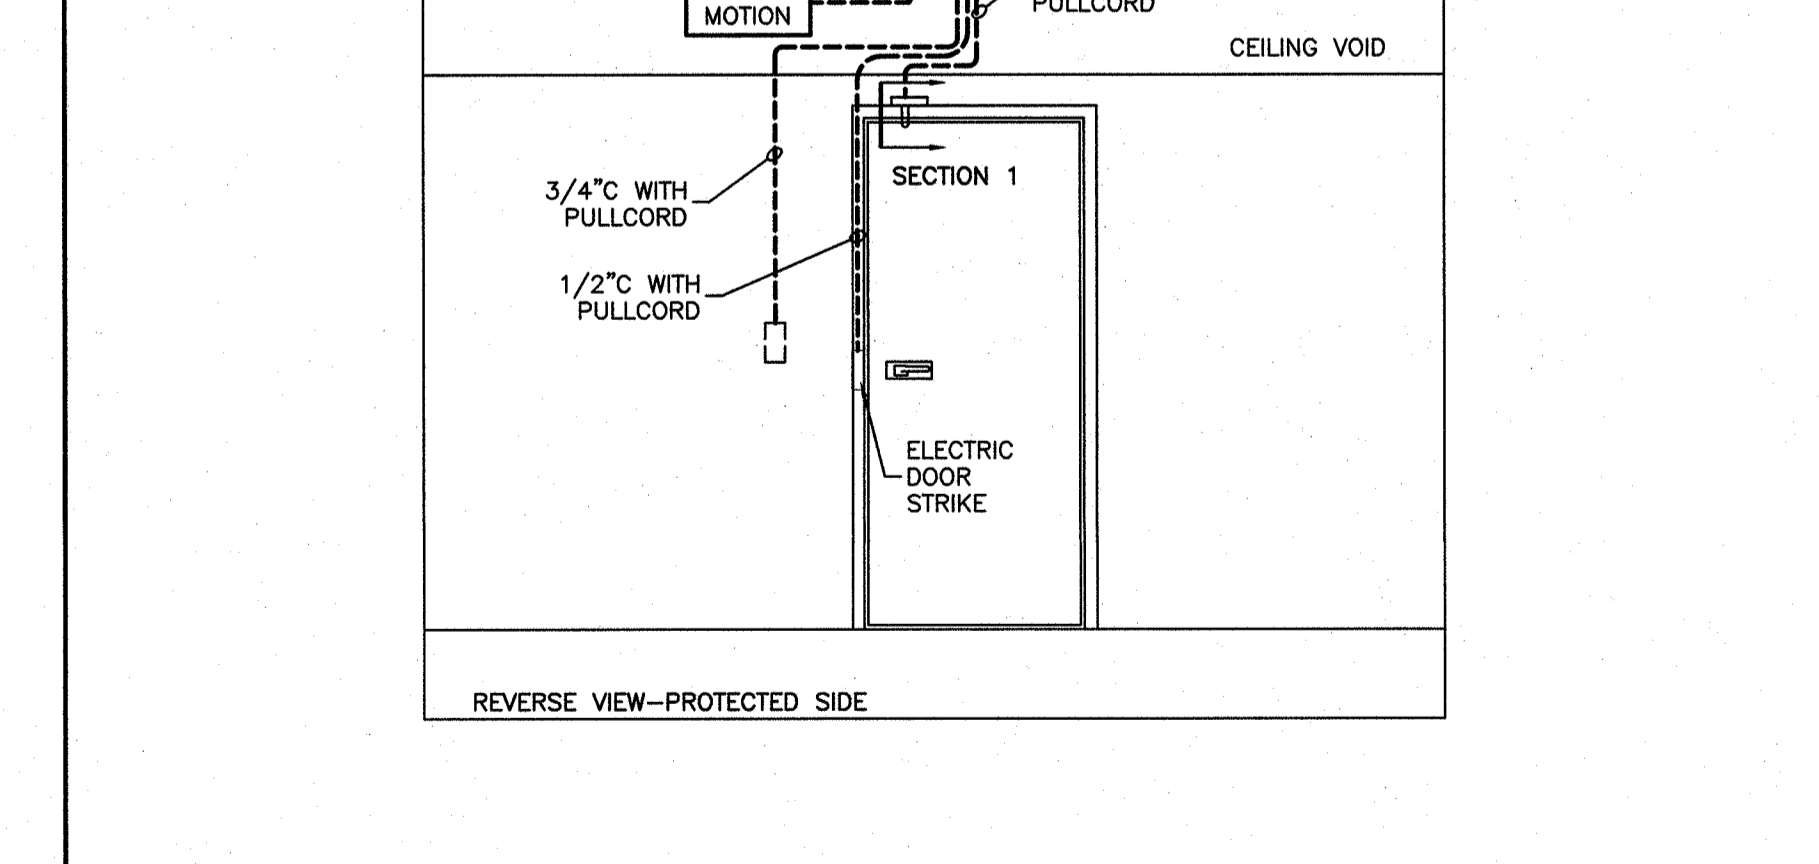

- GENERAL NOTES:
- REFER TO DOOR HARDWARE SPECIFICATION FOR DOOR HARDWARE.
 - THE INSTALLATION OF ALL CONDUIT, WIRING, JUNCTION BOXES, TERMINATIONS, CARD READERS AND ICI EQUIPMENT SHALL BE COORDINATED BETWEEN THE ELECTRICAL, SECURITY AND DOOR HARDWARE CONTRACTORS PRIOR TO INSTALLATION.
 - POWER SUPPLIES SHALL BE LOCATED IN READILY ACCESSIBLE LOCATION AT NEAREST NETWORK CLOSET, NOT ABOVE CEILINGS.
 - COORDINATE CLOSELY, PRIOR TO ROUGH-IN WITH THE SECURITY CONTRACTOR HIRED UNDER THE ALLOWANCE.


- GENERAL NOTES:
- REFER TO DOOR HARDWARE SPECIFICATION FOR DOOR HARDWARE.
 - THE INSTALLATION OF ALL CONDUIT, WIRING, JUNCTION BOXES, TERMINATIONS, CARD READERS AND ACCESS CONTROL EQUIPMENT SHALL BE COORDINATED BETWEEN THE ELECTRICAL, SECURITY AND DOOR HARDWARE CONTRACTORS PRIOR TO INSTALLATION.
 - POWER SUPPLIES SHALL BE LOCATED IN READILY ACCESSIBLE LOCATION AT NEAREST NETWORK CLOSET, NOT ABOVE CEILINGS.
 - THIS DOOR DETAIL IS A GENERAL DETAIL AND DOES NOT REFLECT THE ACTUAL DOOR PROVIDED. THE CONTRACTORS SHALL COORDINATE WITH ALL APPLICABLE TRADES AND INCORPORATE ALL REQUIRED ACCESS CONTROLS FOR A COMPLETE AND 100% OPERATIONAL DOOR.
 - COORDINATE CLOSELY, PRIOR TO ROUGH-IN WITH THE SECURITY CONTRACTOR HIRED UNDER THE ALLOWANCE.

DETAIL NOT TO SCALE EXTERIOR SINGLE DOORS W/CRASH BAR 09


DETAIL NOT TO SCALE EXTERIOR SINGLE DOORS W/ELECTRICK STRIKE 07

DETAIL NOT TO SCALE EXTERIOR DOUBLE DOORS W/CRASH BARS 05


DETAIL NOT TO SCALE H-FRAME FOR PANEL MOUNTING 01

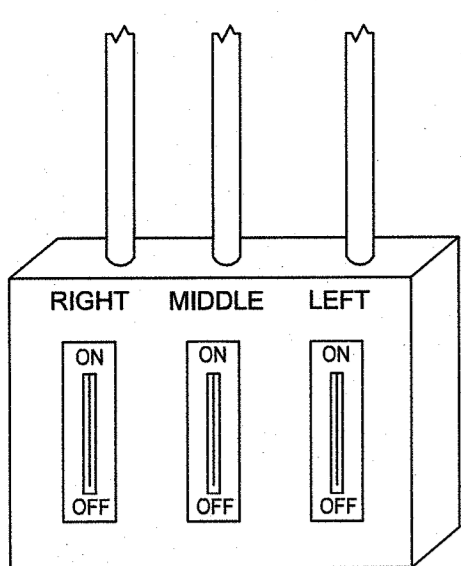

SWITCH BANK 'C'
NOTE: ALL SWITCHES SHALL BE 4-WAY KEYED SWITCHES.

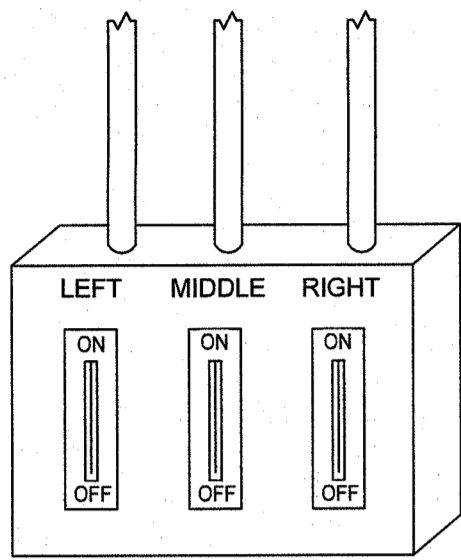


SWITCH BANK 'B'
NOTE: ALL SWITCHES SHALL BE 3-WAY KEYED SWITCHES.

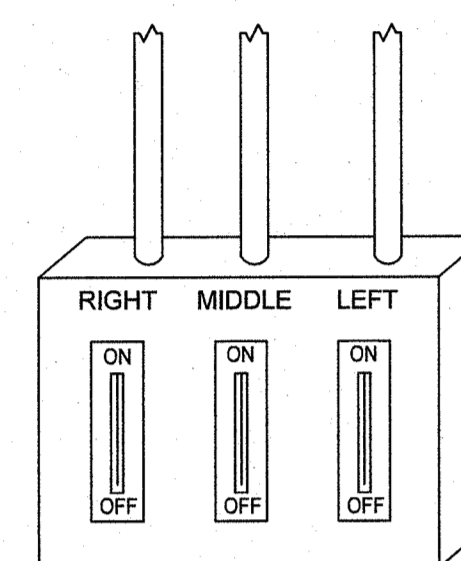


SWITCH BANK 'A'
NOTE: ALL SWITCHES SHALL BE 3-WAY KEYED SWITCHES.


4 MULTIPURPOSE ROOM SWITCH BANKS
NOT TO SCALE

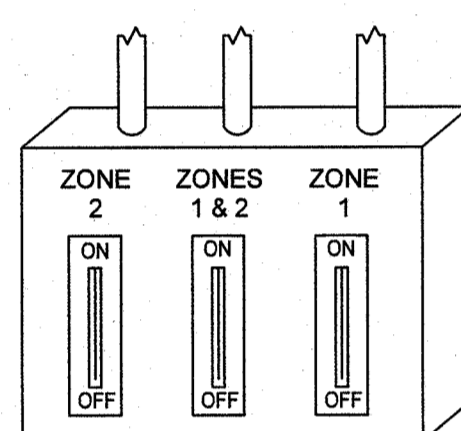

SWITCH BANK '3'
NOTE: ALL SWITCHES SHALL BE 4-WAY KEYED SWITCHES.

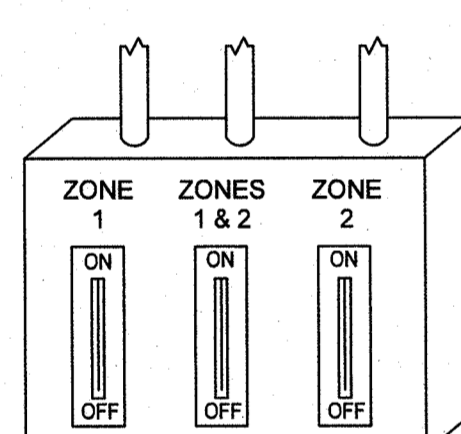


SWITCH BANK '2'
NOTE: ALL SWITCHES SHALL BE 3-WAY KEYED SWITCHES.

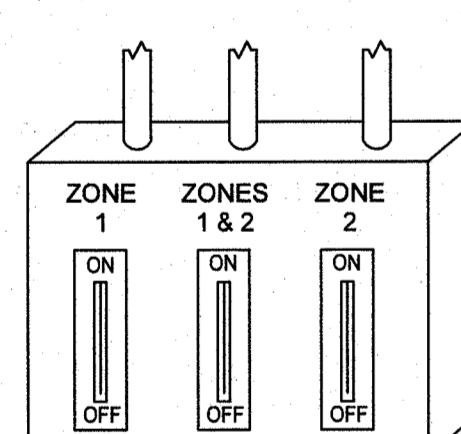

SWITCH BANK '1'
NOTE: ALL SWITCHES SHALL BE 3-WAY KEYED SWITCHES.

5 CAFETERIA SWITCH BANKS
NOT TO SCALE

WALL RATINGS LEGEND	
	1 HR RATED WALL
	2 HR RATED WALL

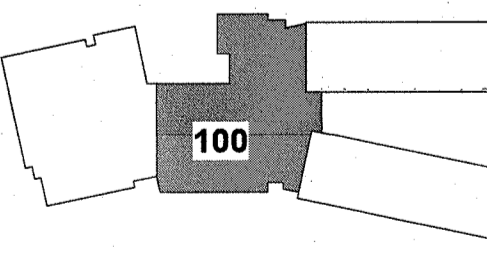

KEY PLAN
NO SCALE


ID	DATE	DESCRIPTION
1	06/14/19	ADDENDUM 03

DRAWN BY: JPT
CHECKED BY: RA

FIRST FLOOR
LIGHTING PLAN -
AREA 100

2017032 20 MAY 2019
E1-01


1 FIRST FLOOR LIGHTING PLAN - AREA 100
1/8" = 1'-0"

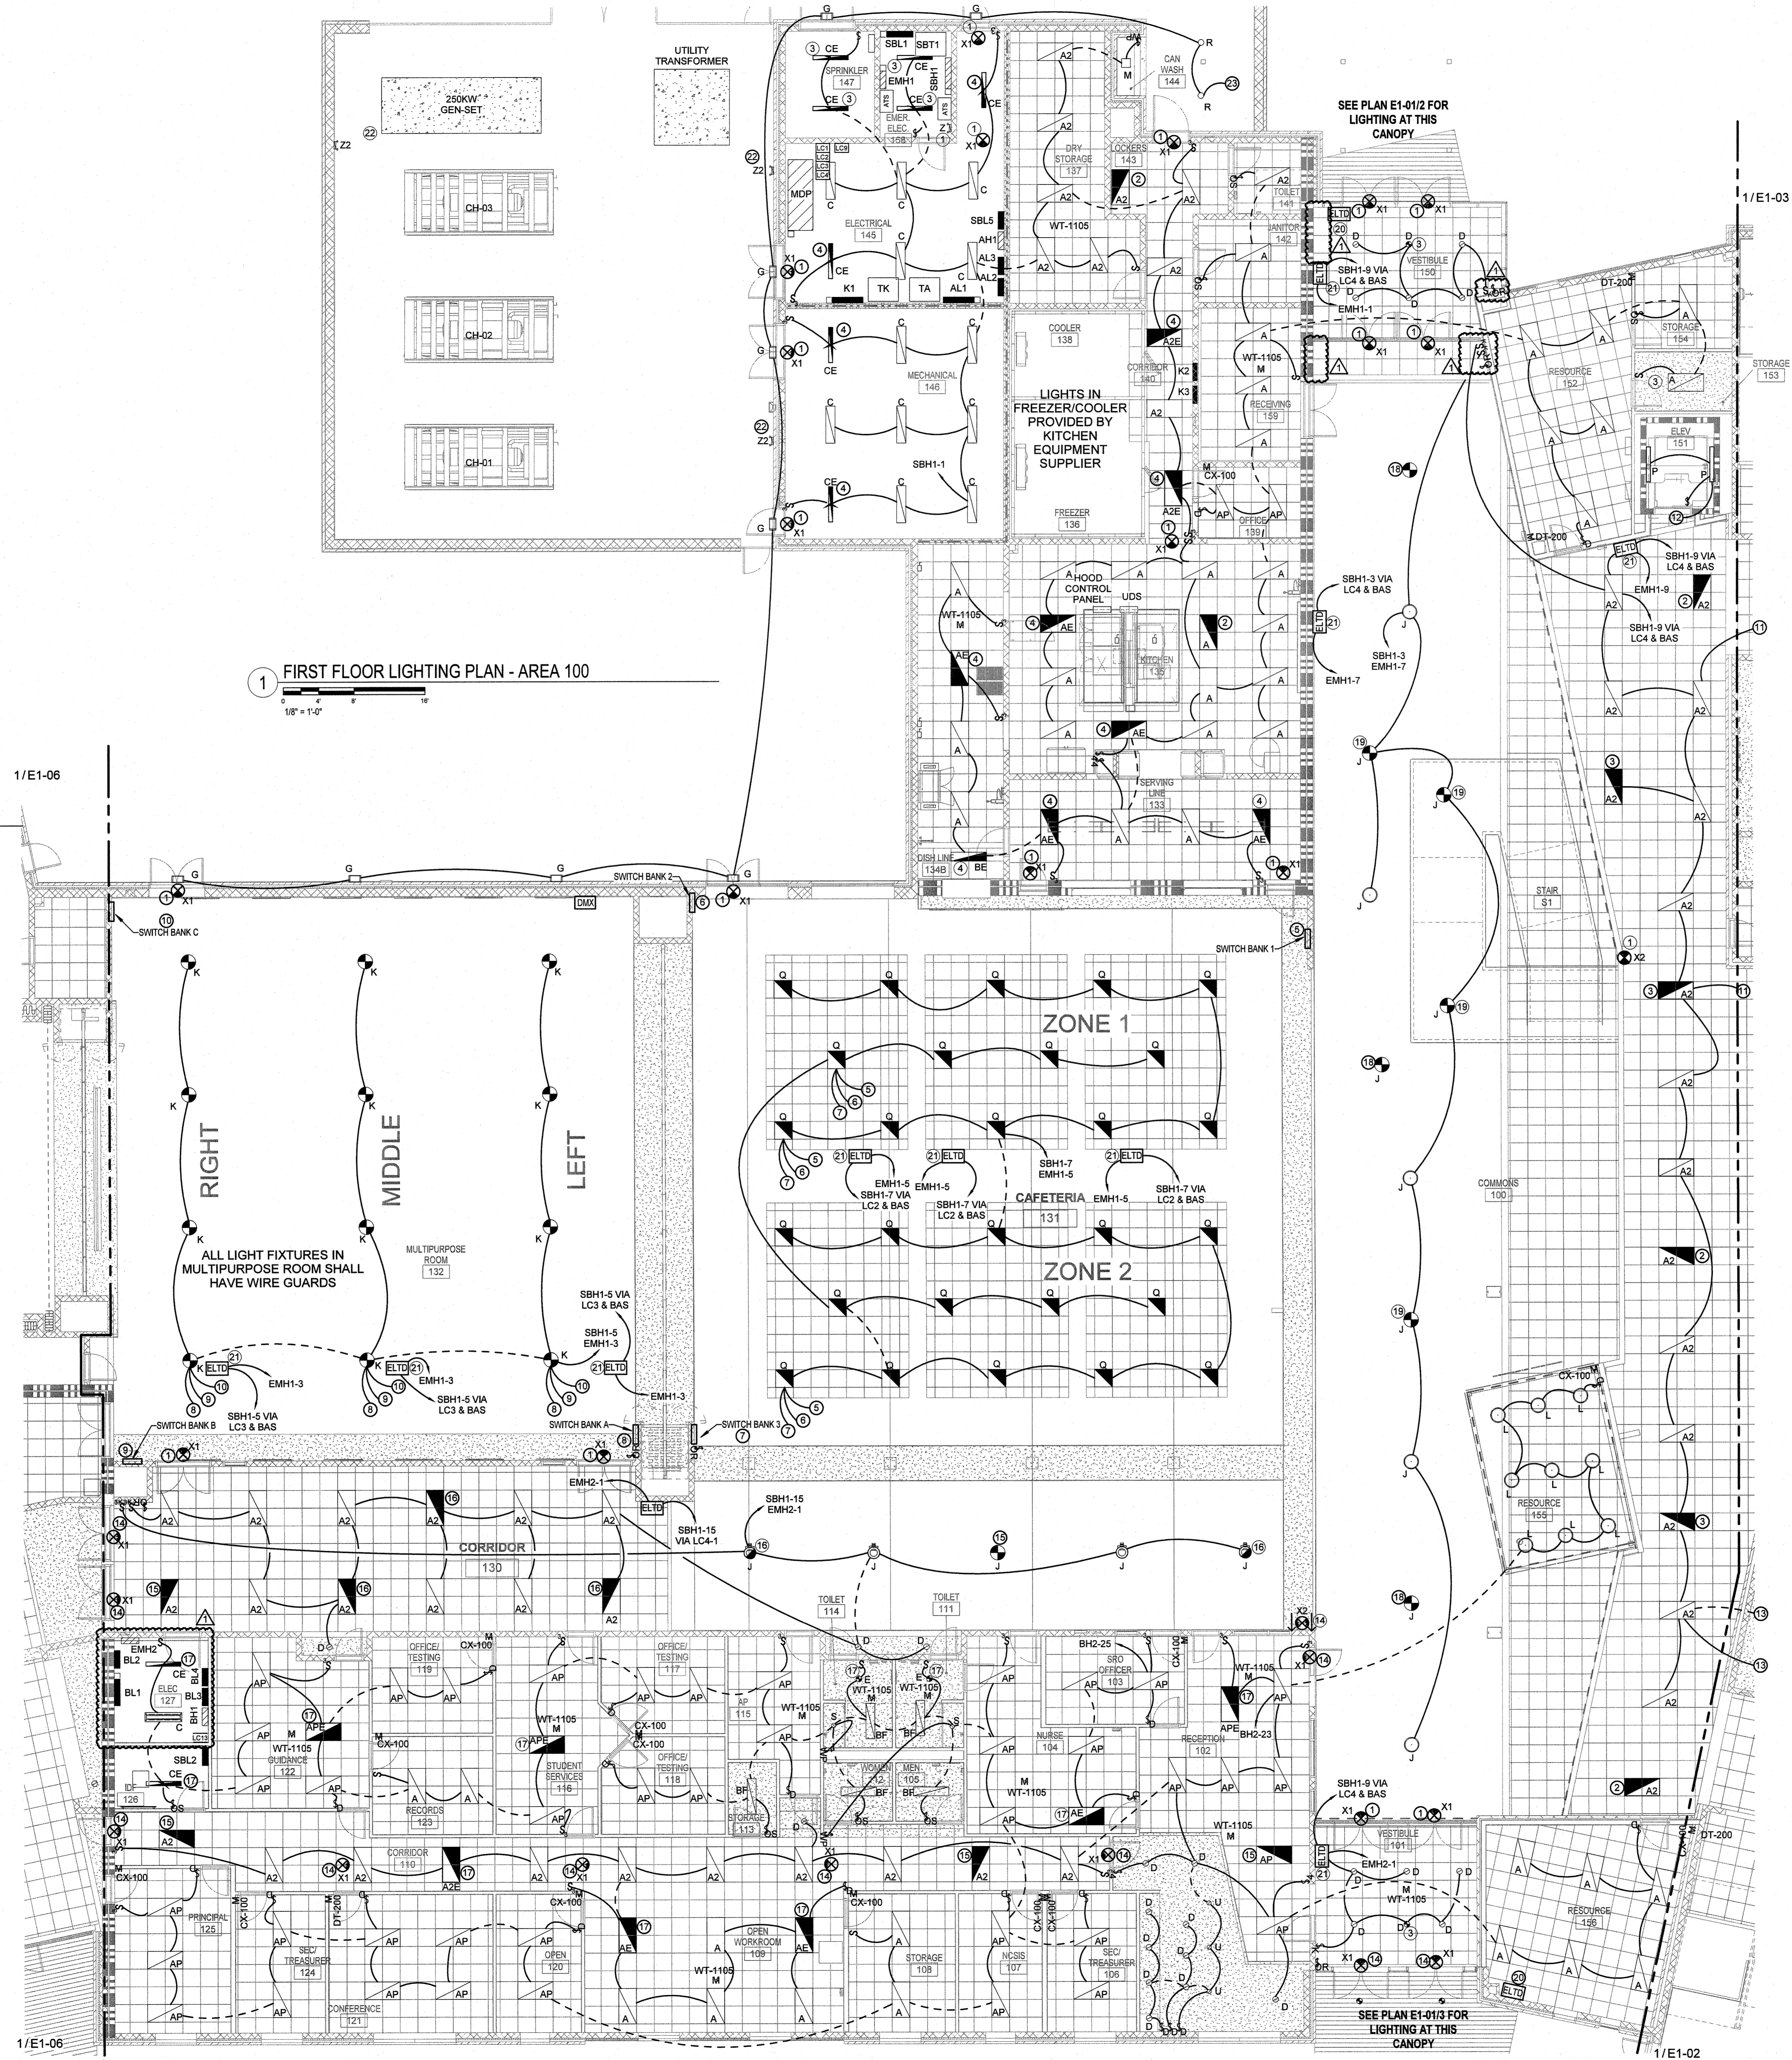

2 AREA 100 - VESTIBULE 150 CANOPY
1/8" = 1'-0"

- NOTES: (AS SHOWN ON THIS PLAN WITH A NUMBER IN A ○)
- EMERGENCY FIXTURE - WIRE AHEAD OF ALL SWITCHES AND CONNECT TO EMERGENCY CIRCUIT EMH1-1.
 - NIGHT LIGHT/EMERGENCY LIGHT - WIRE TO EMERGENCY CIRCUIT EMH1-1.
 - EMERGENCY FIXTURE IN CORRIDOR - WIRE FIXTURE VIA 20A UL924 ELTD SO THAT FIXTURE TURNS ON/OFF WITH OTHER FIXTURES BUT FIXTURE ILLUMINATES UPON LOSS OF NORMAL POWER. WIRE TO EMERGENCY CIRCUIT EMH1-1.
 - EMERGENCY FIXTURE WITH INTERNAL UL924 ELTD - WIRE SO FIXTURE TURNS ON/OFF WITH OTHER FIXTURES BUT FIXTURE ILLUMINATES UPON LOSS OF NORMAL POWER. WIRE TO NORMAL CIRCUIT AS SHOWN AND EMERGENCY CIRCUIT EMH1-1.
 - WIRE TO SWITCH BANK 1 - REFER TO DETAIL E1-01/5.
 - WIRE TO SWITCH BANK 2 - REFER TO DETAIL E1-01/5.
 - WIRE TO SWITCH BANK 3 - REFER TO DETAIL E1-01/5.
 - WIRE TO SWITCH BANK A - REFER TO DETAIL E1-01/4.
 - WIRE TO SWITCH BANK B - REFER TO DETAIL E1-01/4.
 - WIRE TO SWITCH BANK C - REFER TO DETAIL E1-01/4.
 - REFER TO DRAWING E1-03 FOR CONTINUATION.
 - CONNECT TO RECEPTACLE CIRCUIT IN ROOM AHEAD OF GFCI.
 - REFER TO DRAWING E1-02 FOR CONTINUATION.
 - EMERGENCY FIXTURE - WIRE AHEAD OF ALL SWITCHES AND CONNECT TO EMERGENCY CIRCUIT EMH2-1.
 - NIGHT LIGHT/EMERGENCY LIGHT - WIRE TO EMERGENCY CIRCUIT EMH2-1.
 - EMERGENCY FIXTURE IN CORRIDOR - WIRE FIXTURE VIA 20A UL924 ELTD SO THAT FIXTURE TURNS ON/OFF WITH OTHER FIXTURES BUT FIXTURE ILLUMINATES UPON LOSS OF NORMAL POWER. WIRE TO EMERGENCY CIRCUIT EMH2-1.
 - EMERGENCY FIXTURE WITH INTERNAL UL924 ELTD - WIRE SO FIXTURE TURNS ON/OFF WITH OTHER FIXTURES BUT FIXTURE ILLUMINATES UPON LOSS OF NORMAL POWER. WIRE TO NORMAL CIRCUIT AS SHOWN AND EMERGENCY CIRCUIT EMH2-1.
 - NIGHT LIGHT/EMERGENCY LIGHT - WIRE TO EMERGENCY CIRCUIT EMH1-7.
 - EMERGENCY FIXTURE IN CORRIDOR - WIRE FIXTURE VIA 20A UL924 ELTD SO THAT FIXTURE TURNS ON/OFF WITH OTHER FIXTURES BUT FIXTURE ILLUMINATES UPON LOSS OF NORMAL POWER. WIRE TO EMERGENCY CIRCUIT EMH1-7.
 - EXTERIOR EMERGENCY CANOPY FIXTURE - WIRE TO NORMAL AND EMERGENCY CIRCUITS VIA EMERGENCY LIGHTING TRANSFER DEVICE AS SHOWN. FIXTURE CONTROLLED ON/OFF THROUGH BAS. UPON LOSS OF NORMAL POWER FIXTURE SHALL ILLUMINATE.
 - EMERGENCY FIXTURE - WIRE TO NORMAL AND EMERGENCY CIRCUITS VIA EMERGENCY LIGHTING TRANSFER DEVICE AS SHOWN. FIXTURE CONTROLLED ON/OFF THROUGH BAS. UPON LOSS OF NORMAL POWER FIXTURE SHALL ILLUMINATE.
 - EMERGENCY FIXTURE WITH BATTERY BACK-UP - WIRE AHEAD OF SWITCHES AND/OR BAS. FIXTURE SHALL OPERATE UPON LOSS OF NORMAL POWER.
 - REFER TO CANOPY LIGHTING PLAN E1-01/2 FOR CONTINUATION.
 - REFER TO AREA 100 LIGHTING PLAN E1-01/1 FOR CONTINUATION.

3 AREA 100 - VESTIBULE 101 CANOPY
1/8" = 1'-0"

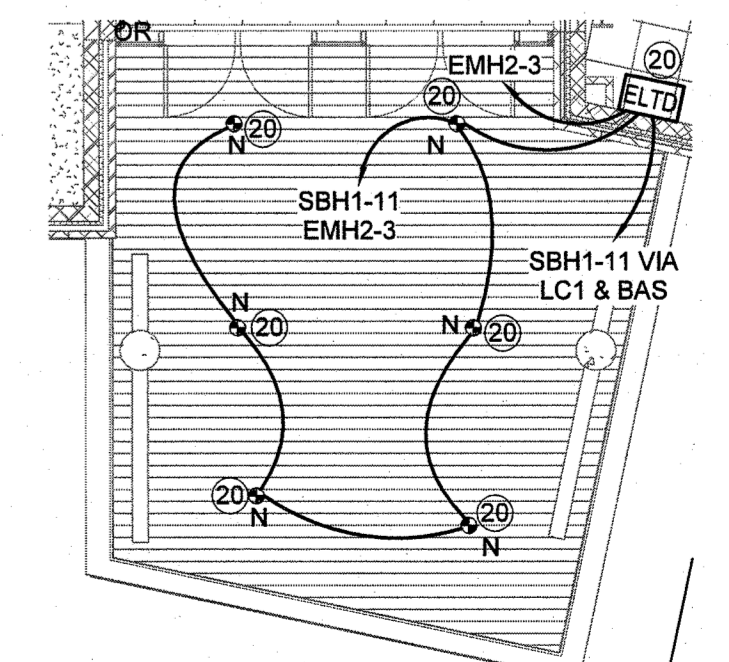


WALL RATINGS LEGEND	
	1 HR RATED WALL
	2 HR RATED WALL

- NOTES: (AS SHOWN ON THIS PLAN WITH A NUMBER IN A ○)
- EMERGENCY FIXTURE - WIRE AHEAD OF ALL SWITCHES AND CONNECT TO EMERGENCY LIGHTING CIRCUIT EMH1-9.
 - NIGHT LIGHT/EMERGENCY LIGHT - WIRE TO EMERGENCY CIRCUIT EMH1-9.
 - EMERGENCY FIXTURE IN CORRIDOR - WIRE FIXTURE VIA 20A UL 924 ELTD SO THAT FIXTURE TURNS OFF WITH OTHER FIXTURES BUT FIXTURE ILLUMINATES UPON LOSS OF NORMAL POWER. WIRE TO NORMAL CIRCUIT INDICATED AND EMERGENCY CIRCUIT EMH1-11.
 - EMERGENCY FIXTURE WITH INTERNAL UL924 ELTD - WIRE SO FIXTURE TURNS OFF WITH OTHER FIXTURES BUT FIXTURE ILLUMINATES UPON LOSS OF NORMAL POWER. WIRE TO NORMAL CIRCUIT AS SHOWN AND EMERGENCY CIRCUIT EMH1-9.
 - CONTINUE UP TO LIGHTS IN SECOND FLOOR STAIRWELL.
 - REFER TO DRAWING E1-01 FOR CONTINUATION.
 - EMERGENCY FIXTURE - WIRE AHEAD OF ALL SWITCHES AND CONNECT TO EMERGENCY LIGHTING CIRCUIT EMH1-11.
 - NIGHT LIGHT/EMERGENCY LIGHT - WIRE TO EMERGENCY CIRCUIT EMH1-11.
 - EMERGENCY FIXTURE WITH INTERNAL UL924 ELTD - WIRE SO FIXTURE TURNS OFF WITH OTHER FIXTURES BUT FIXTURE ILLUMINATES UPON LOSS OF NORMAL POWER. WIRE TO NORMAL CIRCUIT AS SHOWN AND EMERGENCY CIRCUIT EMH1-11.
 - CONTINUED TO EXTERIOR LIGHTING ON DRAWING E1-02.
 - EMERGENCY FIXTURE IN OPEN AREA - WIRE FIXTURE VIA 20A UL 924 ELTD SO THAT FIXTURE TURNS OFF WITH OTHER FIXTURES BUT FIXTURE ILLUMINATES UPON LOSS OF NORMAL POWER. WIRE TO NORMAL CIRCUIT INDICATED AND EMERGENCY CIRCUIT EMH1-11.



1 FIRST FLOOR LIGHTING PLAN - AREA 300
1/8" = 1'-0"

NEW TRINITY MIDDLE SCHOOL
RANDOLPH COUNTY SCHOOL SYSTEM
Parcel PIN 7708118367
Surrett Drive
Trinity, NC 27370

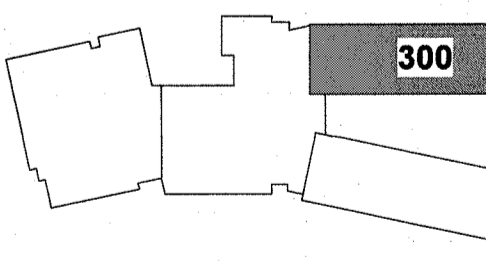


KEY PLAN
NO SCALE


ID	DATE	DESCRIPTION
1	06/14/19	ADDENDUM 03

DRAWN BY: JPT
CHECKED BY: RA

FIRST FLOOR
LIGHTING PLAN -
AREA 300

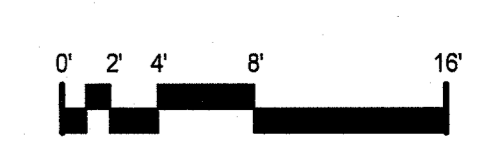


WALL RATINGS LEGEND

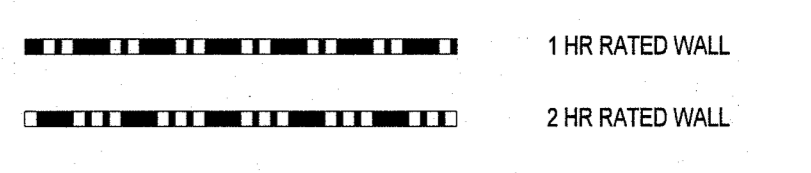


NOTES: (AS SHOWN ON THIS PLAN WITH A NUMBER IN A ○)


- EMERGENCY FIXTURE - WIRE AHEAD OF ALL SWITCHES AND CONNECT TO EMERGENCY CIRCUIT EMH2-9.
- NIGHT LIGHT/EMERGENCY LIGHT - WIRE TO EMERGENCY CIRCUIT EMH2-9.
- EMERGENCY FIXTURE IN CORRIDOR - WIRE FIXTURE VIA 20A UL924 ELTD SO THAT FIXTURE TURNS OFF WITH OTHER FIXTURES BUT FIXTURE ILLUMINATES UPON LOSS OF NORMAL POWER. WIRE TO NORMAL CIRCUIT AS INDICATED AND TO EMERGENCY CIRCUIT EMH2-11.
- EMERGENCY FIXTURE WITH INTERNAL UL924 ELTD - WIRE SO FIXTURE TURNS OFF WITH OTHER FIXTURES BUT FIXTURE ILLUMINATES UPON LOSS OF NORMAL POWER. WIRE TO NORMAL CIRCUIT AS SHOWN AND EMERGENCY CIRCUIT EMH2-9.
- WIRE TO SWITCH BANK #1 - REFER TO SWITCH BANK DETAILS ON THIS SHEET.
- WIRE TO SWITCH BANK #2 - REFER TO SWITCH BANK DETAILS ON THIS SHEET.
- WIRE TO SWITCH BANK #3 - REFER TO SWITCH BANK DETAILS ON THIS SHEET.
- WIRE TO SWITCH BANK #4 - REFER TO SWITCH BANK DETAILS ON THIS SHEET.
- UP TO FIXTURES/SWITCH/CIRCUIT ON MECHANICAL PLATFORM.
- REFER TO DRAWING E1-01 FOR CONTINUATION.
- REFER TO THE CHORUS PLATFORM LED DIMMING RISER DIAGRAM E1-07/8.
- PROVIDE ELTD. WIRE NORMAL AS SHOWN AND WIRE TO EMERGENCY CIRCUIT EMH2-4. FIXTURE SHALL TURN ON/OFF WITH OTHER FIXTURES, BUT UPON LOSS OF NORMAL POWER, FIXTURE SHALL ILLUMINATE.
- PROVIDE ELTD. WIRE NORMAL AS SHOWN AND WIRE TO EMERGENCY CIRCUIT EMH2-8. FIXTURE SHALL TURN ON/OFF WITH OTHER FIXTURES, BUT UPON LOSS OF NORMAL POWER, FIXTURE SHALL ILLUMINATE.
- EMERGENCY FIXTURE - WIRE AHEAD OF ALL SWITCHES AND CONNECT TO EMERGENCY CIRCUIT EMH2-11.
- NIGHT LIGHT/EMERGENCY LIGHT - WIRE TO EMERGENCY CIRCUIT EMH2-11.
- EMERGENCY FIXTURE WITH INTERNAL UL924 ELTD - WIRE SO FIXTURE TURNS ON/OFF WITH OTHER FIXTURES BUT FIXTURE ILLUMINATES UPON LOSS OF NORMAL POWER. WIRE TO NORMAL CIRCUIT AS SHOWN AND EMERGENCY CIRCUIT EMH2-11.
- PROVIDE UL924 ELTD. WIRE NORMAL AS SHOWN AND WIRE TO EMERGENCY CIRCUIT EMH2-8. FIXTURE SHALL TURN ON/OFF WITH OTHER FIXTURES, BUT UPON LOSS OF NORMAL POWER, FIXTURE SHALL ILLUMINATE.
- PROVIDE UL924 ELTD. WIRE NORMAL AS SHOWN AND WIRE TO EMERGENCY CIRCUIT EMH2-10. FIXTURE SHALL TURN ON/OFF WITH OTHER FIXTURES, BUT UPON LOSS OF NORMAL POWER, FIXTURE SHALL ILLUMINATE.

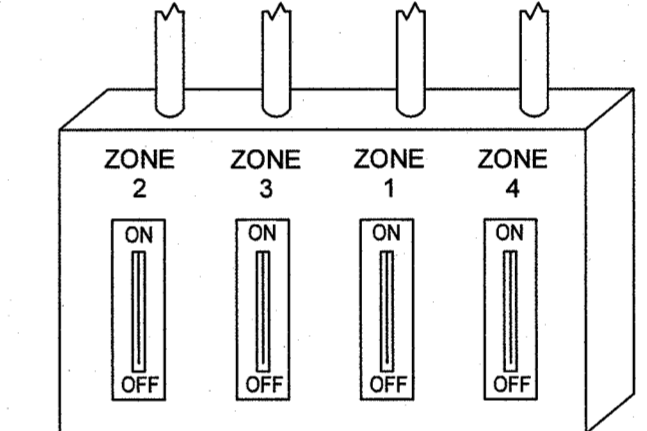


SWITCH BANK #4
NOTE: ALL SWITCHES SHALL BE 4-WAY KEYED SWITCHES.

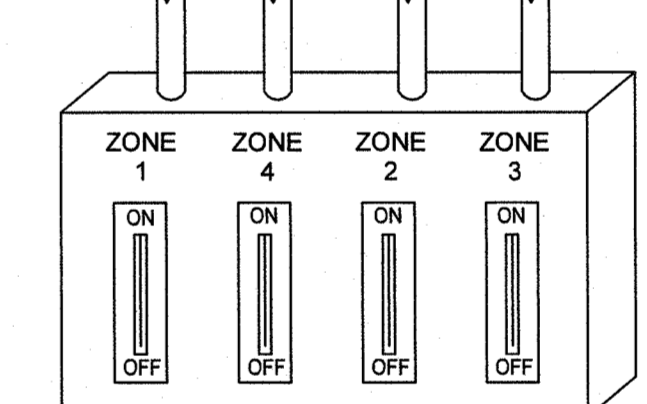

SWITCH BANK #3
NOTE: ALL SWITCHES SHALL BE 4-WAY KEYED SWITCHES.

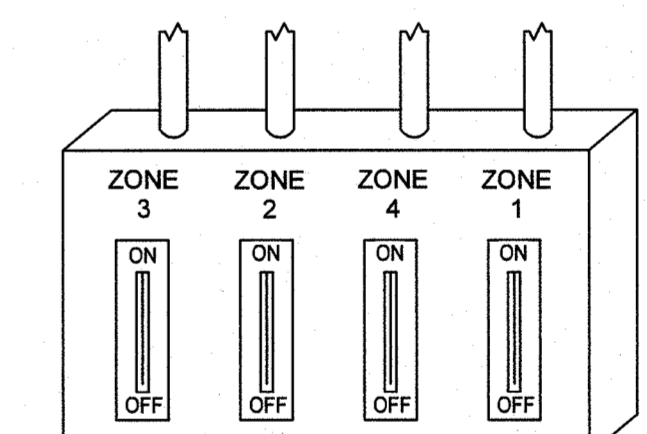


SWITCH BANK #2
NOTE: ALL SWITCHES SHALL BE 3-WAY KEYED SWITCHES.

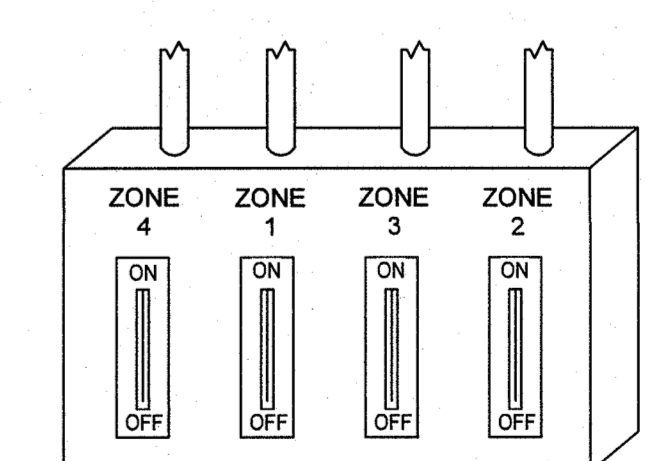



SWITCH BANK #1
NOTE: ALL SWITCHES SHALL BE 3-WAY KEYED SWITCHES.

② GYMNASIUM SWITCH BANKS
1/8" = 1'-0"

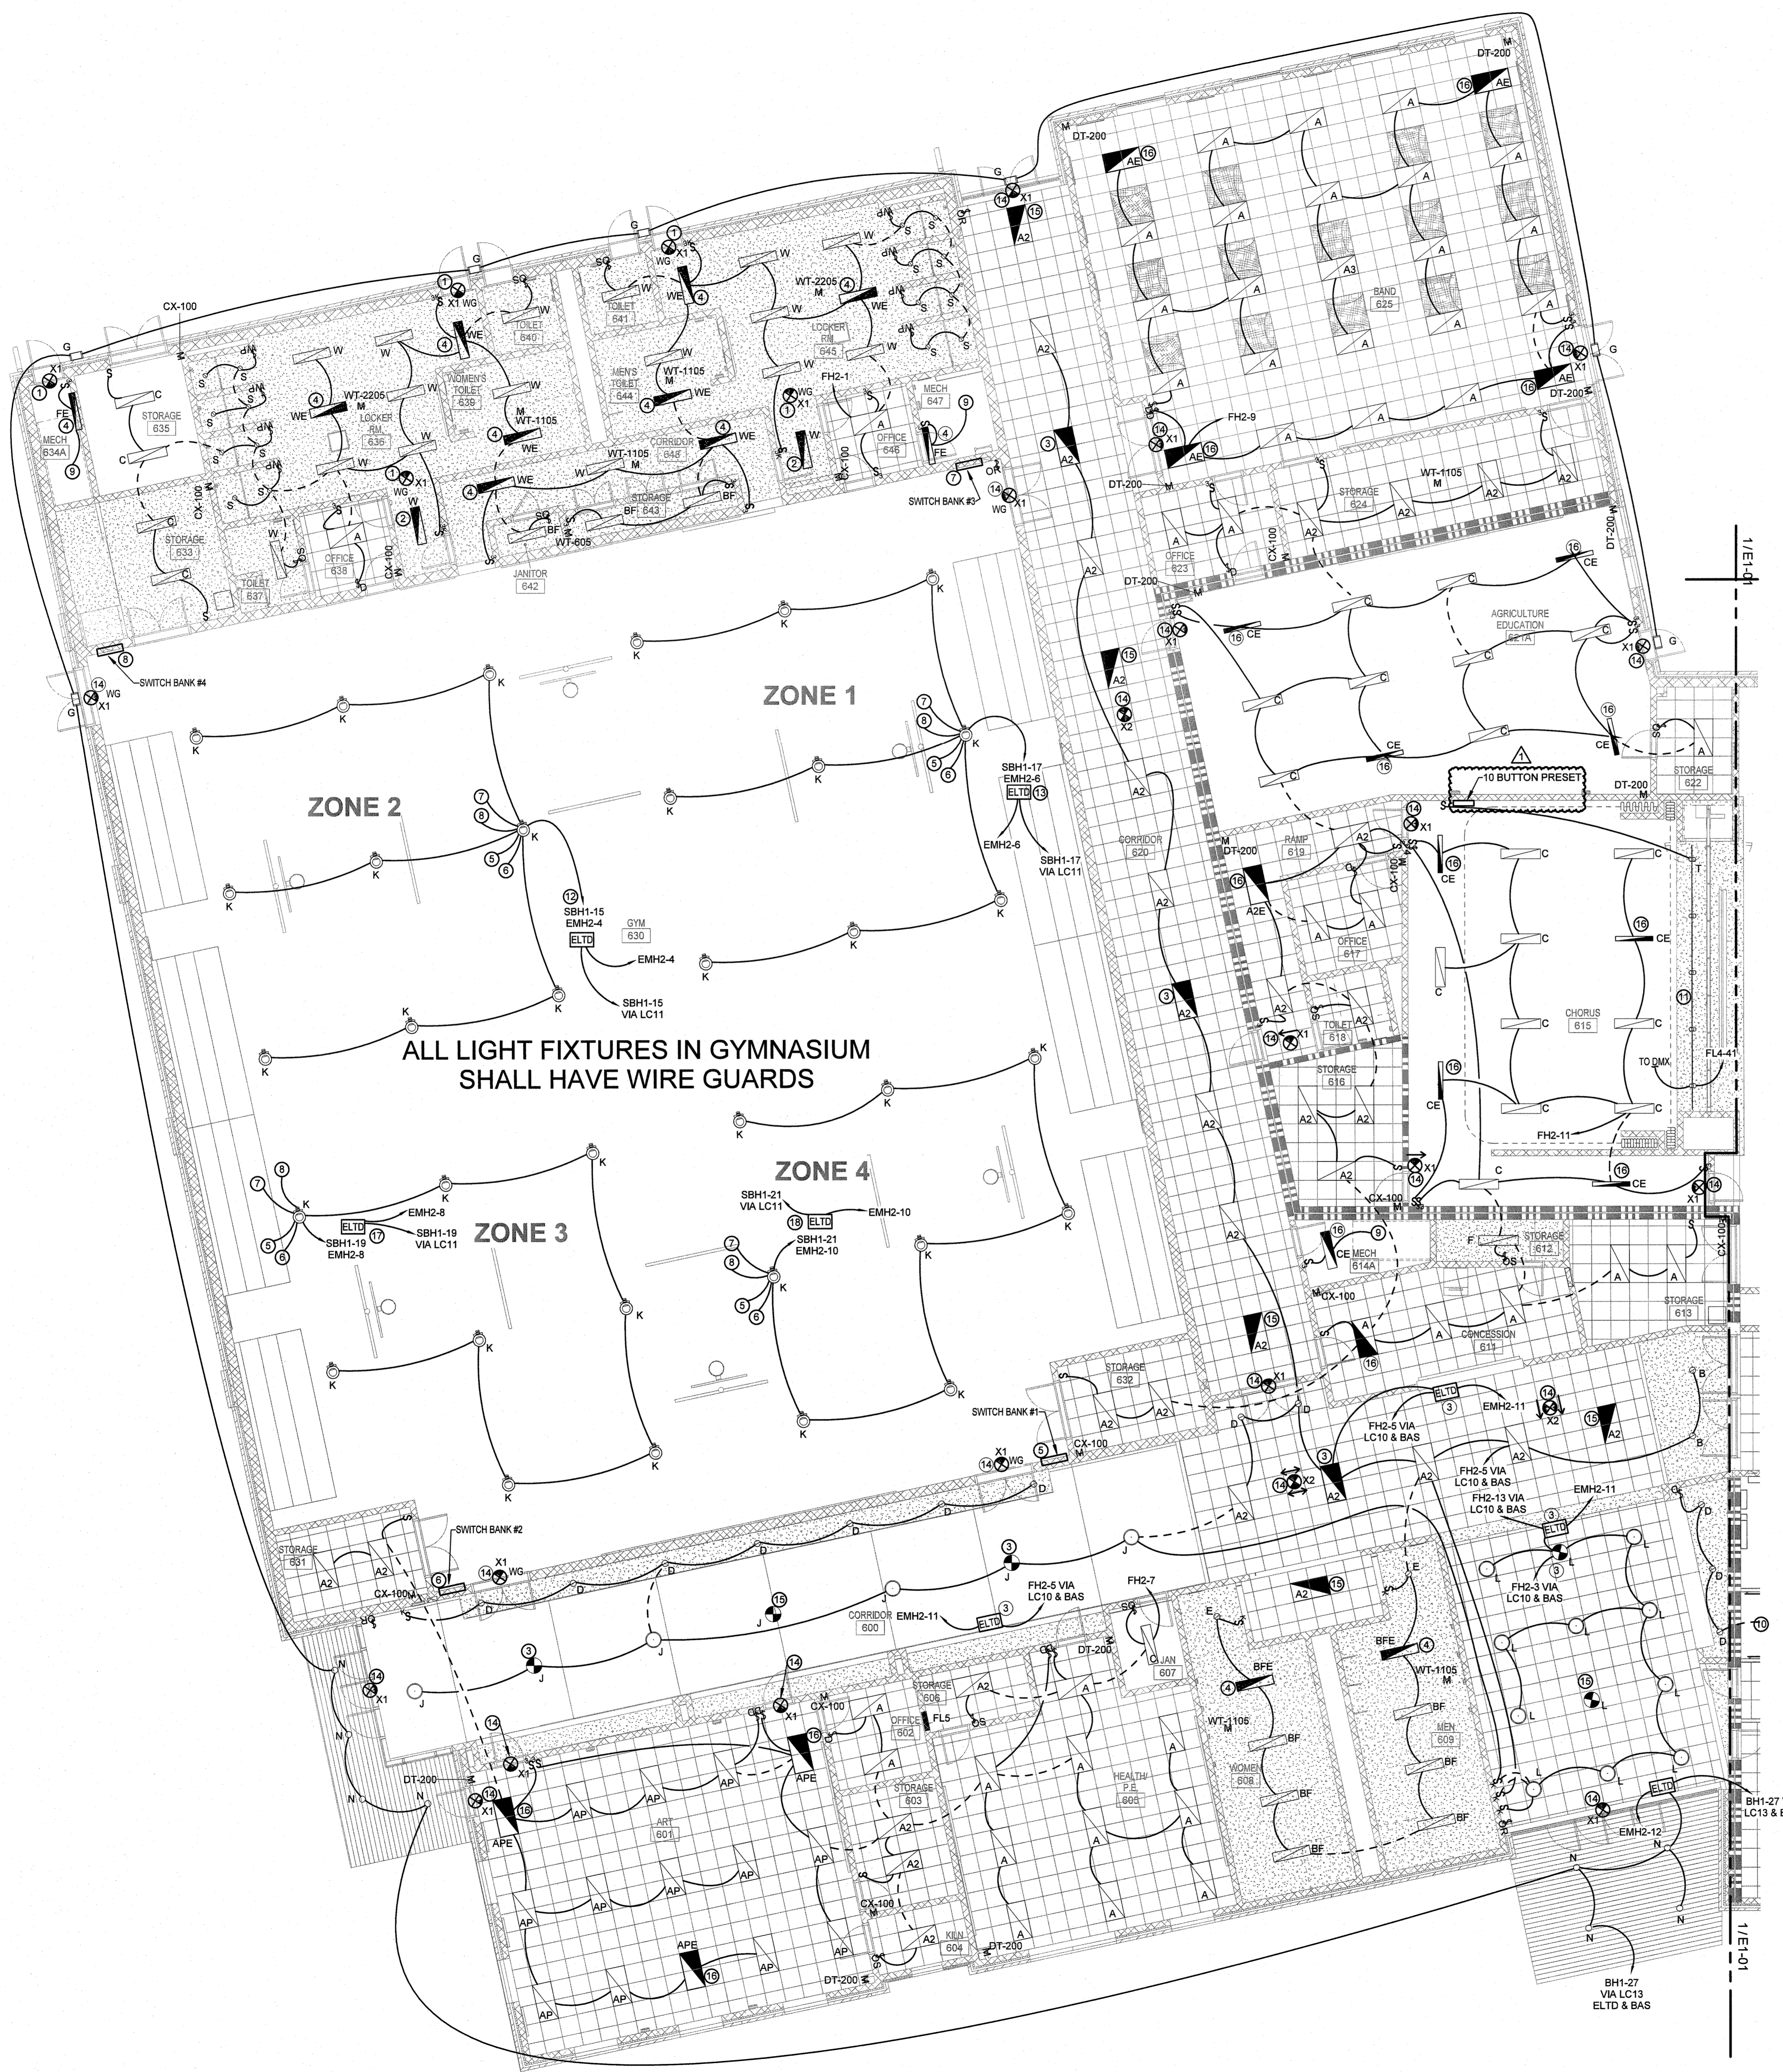

ALL LIGHT FIXTURES IN GYMNASIUM SHALL HAVE WIRE GUARDS

① FIRST FLOOR LIGHTING PLAN - AREA 600
1/8" = 1'-0"

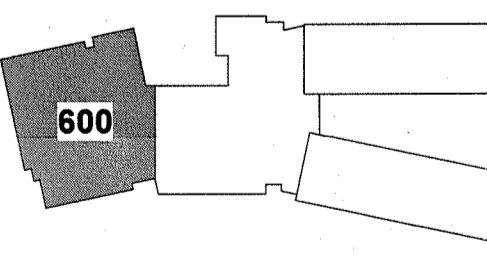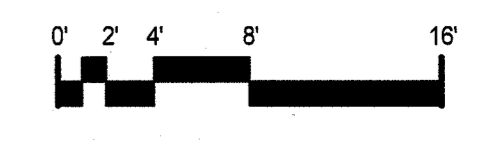

KEY PLAN
NO SCALE


ID	DATE	DESCRIPTION
1	06/14/19	ADDENDUM 03

DRAWN BY: Author
CHECKED BY: RA

FIRST FLOOR LIGHTING PLAN - AREA 600


C:\Users\j\Documents\Local\17104_TRINITYMS_PDC_Central_Blangon\SC06.rvt
6/20/19 4:52:15 PM

WALL RATINGS LEGEND	
	1 HR RATED WALL
	2 HR RATED WALL

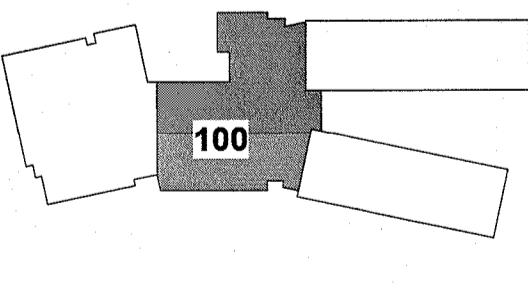


ID	DATE	DESCRIPTION	Author	RA
2	06/14/19	ADDENDUM 03		
1	05/30/19	ADDENDUM 01		

DRAWN BY: _____
CHECKED BY: _____

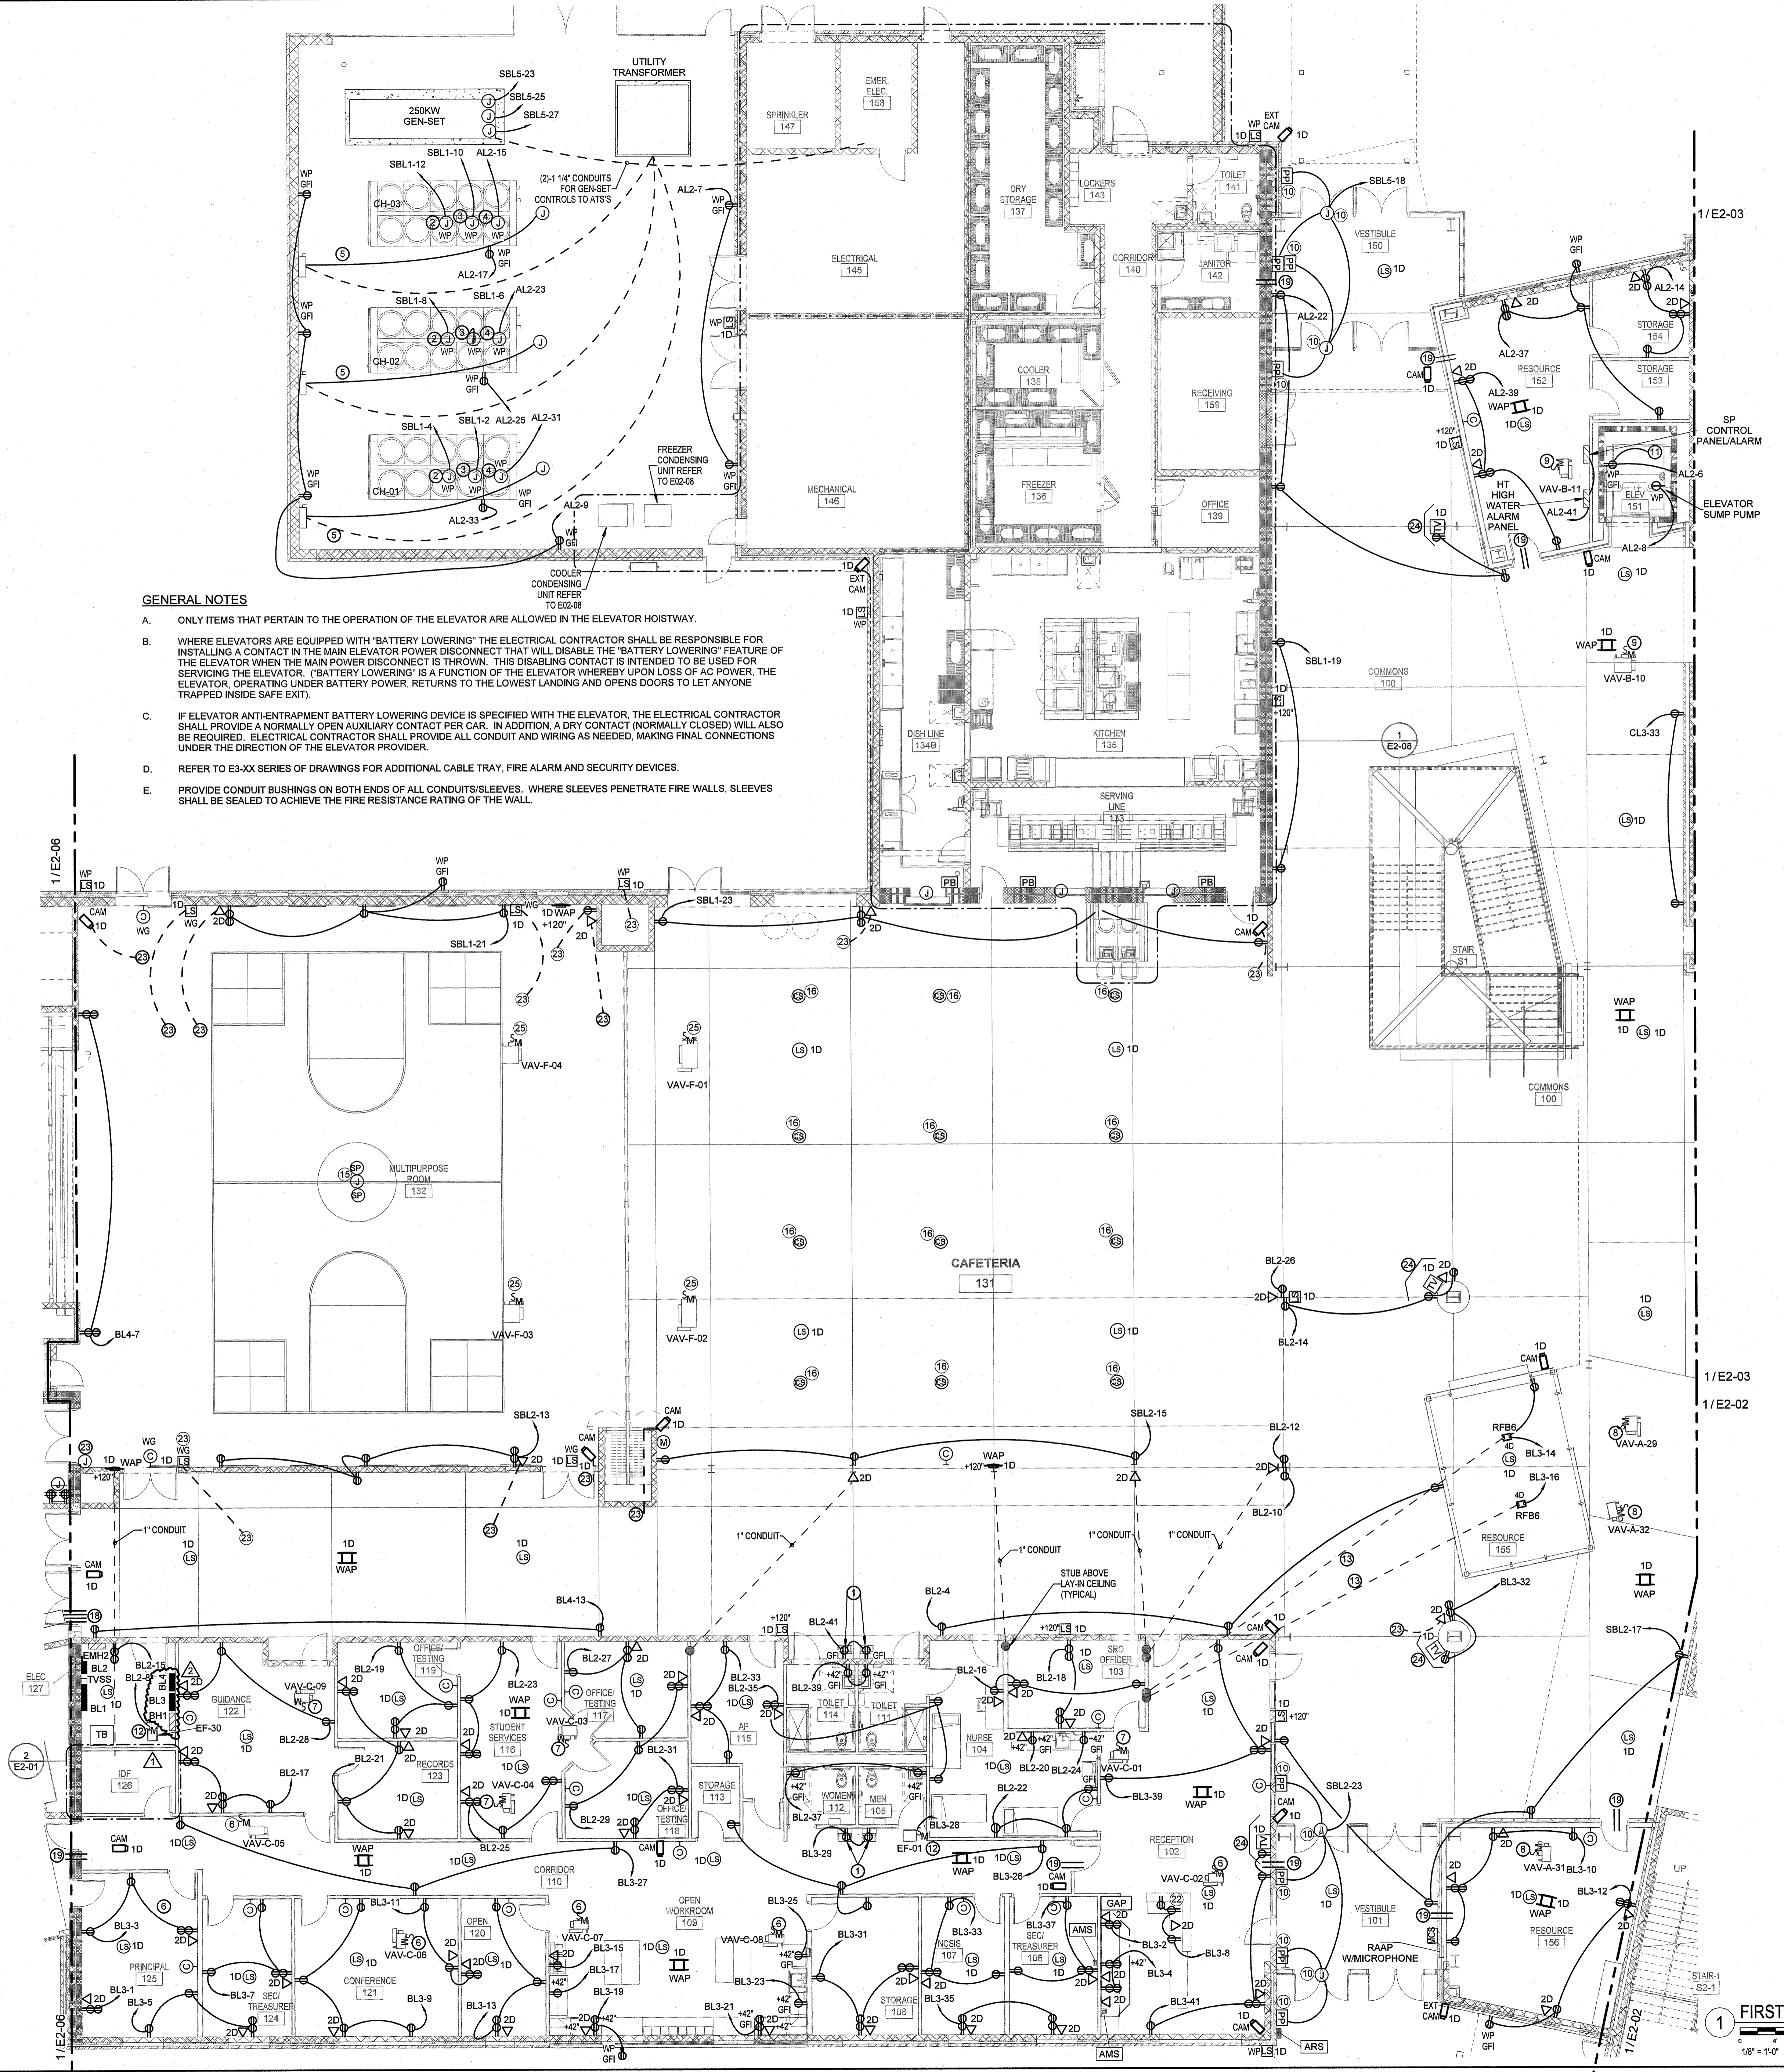


- NOTES: (AS SHOWN ON THIS PLAN WITH A NUMBER IN A ○)
- COORDINATE RECEPTACLE FOR WATER COOLER WITH PLUMBING CONTRACTOR SO CORD DOES NOT SHOW. PROVIDE GFI BREAKER IN PANEL.
 - WEATHERPROOF JUNCTION BOX FOR 120VAC CHILLER HEAT TRACE. COORDINATE EXACT LOCATION WITH MECHANICAL CONTRACTOR.
 - WEATHERPROOF JUNCTION BOX FOR 120VAC CHILLER PIPING HEAT TRACE. COORDINATE EXACT LOCATION WITH MECHANICAL CONTRACTOR.
 - WEATHERPROOF JUNCTION BOX FOR 120VAC CHILLER CONTROLS. COORDINATE EXACT LOCATION WITH MECHANICAL CONTRACTOR.
 - 600 VOLT, 400 AMP, 3 POLE, NEMA-3R, SERVICE ENTRANCE RATED FUSIBLE DISCONNECT SWITCH FOR CHILLER. MOUNT ON GALVANIZED STEEL ANGLE-TRUSS FRAME EMBEDDED IN CONCRETE.
 - 120VAC MOTOR RATED TOGGLE DISCONNECT SWITCH WITH NEMA-1 JUNCTION BOX FOR VAV BOX. COORDINATE EXACT LOCATION WITH MECHANICAL CONTRACTOR. WIRE VAV BOXES INDICATED TO CIRCUIT "BL-20".
 - 120VAC MOTOR RATED TOGGLE DISCONNECT SWITCH WITH NEMA-1 JUNCTION BOX FOR VAV BOX. COORDINATE EXACT LOCATION WITH MECHANICAL CONTRACTOR. WIRE VAV BOXES INDICATED TO CIRCUIT "BL-22".
 - 120VAC MOTOR RATED TOGGLE DISCONNECT SWITCH WITH NEMA-1 JUNCTION BOX FOR VAV BOX. COORDINATE EXACT LOCATION WITH MECHANICAL CONTRACTOR. WIRE VAV BOXES INDICATED TO CIRCUIT "BL-24".
 - 120VAC MOTOR RATED TOGGLE DISCONNECT SWITCH WITH NEMA-1 JUNCTION BOX FOR VAV BOX. COORDINATE EXACT LOCATION WITH MECHANICAL CONTRACTOR. WIRE VAV BOXES INDICATED TO CIRCUIT "BL-26".
 - COORDINATE EXACT LOCATION OF POWER ACTUATOR AND PUSH PADS FOR HANDICAP DOORS WITH DOOR HARDWARE PROVIDER.
 - CONTINUE TO LIGHT CIRCUIT IN ELEVATOR PIT. WIRE SO THAT LIGHT IS CONNECTED AHEAD OF GFCI RECEPTACLE.
 - 120VAC, 20 AMP, MOTOR RATED TOGGLE DISCONNECT SWITCH WITH NEMA-1 JUNCTION BOX FOR EXHAUST FAN. COORDINATE EXACT LOCATION WITH MECHANICAL CONTRACTOR.
 - (2)-1" COMMUNICATIONS CONDUITS FROM FLOORBOX TO ABOVE FINISHED LAY-IN CEILING AT RECEPTION 102.
 - 240 VOLT, 30 AMP, 2 POLE, NEMA-1, FUSIBLE DISCONNECT SWITCH FOR DS UNIT. FUSE PER MANUFACTURER'S RECOMMENDATIONS. COORDINATE EXACT LOCATION WITH MECHANICAL CONTRACTOR. NOTE: INDOOR DS UNIT IS POWERED BY ASSOCIATED OUTDOOR DSC UNIT. COORDINATE CLOSELY.
 - PROVIDE 1 1/2" CONDUIT FOR SOUND SYSTEM. COORDINATE ROUTING AND LOCATION WITH SOUND SYSTEM CONTRACTOR. REFER TO DETAIL E0-05/08.
 - CAFETERIA SOUND SYSTEM SPEAKERS. REFER TO SOUND SYSTEM RISER E0-05-8.
 - 277VAC, 20 AMP, MOTOR RATED TOGGLE DISCONNECT SWITCH WITH NEMA-1 JUNCTION BOX FOR UNIT HEATER. COORDINATE EXACT LOCATION WITH MECHANICAL CONTRACTOR. DISCONNECT PROVIDED WITH UNIT HEATER.
 - (4)-3" CONDUIT SLEEVES. LOCATE ABOVE ACCESSIBLE LAY-IN CEILING.
 - (2)-3" CONDUIT SLEEVES. LOCATE ABOVE ACCESSIBLE LAY-IN CEILING.
 - (2)-2" CONDUIT SLEEVES. LOCATE ABOVE ACCESSIBLE LAY-IN CEILING.
 - 240 VOLT, 30 AMP, 3 POLE, NEMA-3R, FUSIBLE DISCONNECT SWITCH FOR CONDENSING UNIT. FUSE PER MANUFACTURER'S RECOMMENDATIONS. COORDINATE EXACT LOCATION WITH KITCHEN EQUIPMENT PROVIDER.
 - COORDINATE ROUTING OF CONDUIT AND PLACEMENT OF OUTLET AT COUNTER WITH ARCHITECT PRIOR TO ROUGH-IN.
 - ROUTE CONDUIT FROM DEVICE OUTLET LOCATION, CONCEALED, TO IDF ROOM 126.
 - COORDINATE TV LOCATIONS WITH ARCHITECT PRIOR TO ANY ROUGH-IN. ROUTE COMMUNICATION CONDUIT TO NEAREST LAY-IN CEILING LOCATION.
 - 120VAC MOTOR RATED TOGGLE DISCONNECT SWITCH WITH NEMA-1 JUNCTION BOX FOR VAV BOX. COORDINATE EXACT LOCATION WITH MECHANICAL CONTRACTOR. WIRE VAV BOXES INDICATED TO CIRCUIT "BL-34".
 - (2)-3" CONDUITS UNDERGROUND TO MDF ROOM 308A.
 - TELECOMMUNICATIONS GROUND BAR. REFER TO DETAIL E0-02/04.
 - 4x8x3/4" FIRE RETARDANT PLYWOOD BACK BOARD.

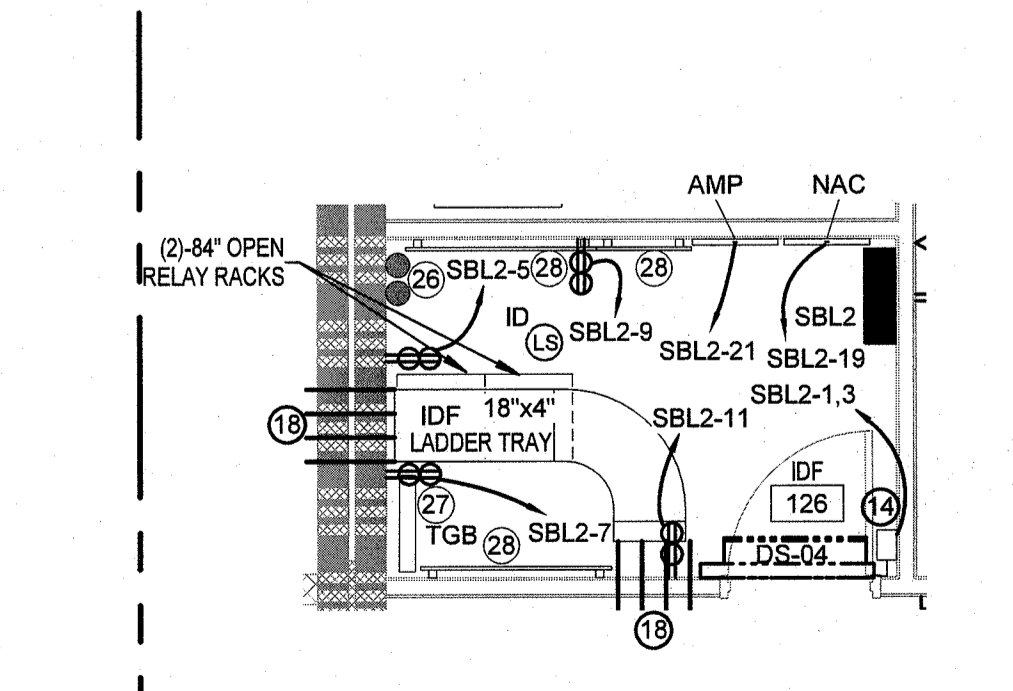

ENLARGED POWER PLAN - IDF 126

FIRST FLOOR POWER PLAN - AREA 100

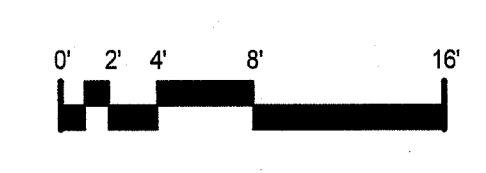


- GENERAL NOTES
- ONLY ITEMS THAT PERTAIN TO THE OPERATION OF THE ELEVATOR ARE ALLOWED IN THE ELEVATOR HOISTWAY.
 - WHERE ELEVATORS ARE EQUIPPED WITH "BATTERY LOWERING" THE ELECTRICAL CONTRACTOR SHALL BE RESPONSIBLE FOR INSTALLING A CONTACT IN THE MAIN ELEVATOR POWER DISCONNECT THAT WILL DISABLE THE "BATTERY LOWERING" FEATURE OF THE ELEVATOR WHEN THE MAIN POWER DISCONNECT IS THROWN. THIS DISABLING CONTACT IS INTENDED TO BE USED FOR SERVICING THE ELEVATOR. ("BATTERY LOWERING" IS A FUNCTION OF THE ELEVATOR WHEREBY UPON LOSS OF AC POWER, THE ELEVATOR OPERATING UNDER BATTERY POWER, RETURNS TO THE LOWEST LANDING AND OPENS DOORS TO LET ANYONE TRAPPED INSIDE SAFE EXIT).
 - IF ELEVATOR ANTI-ENTRAPMENT BATTERY LOWERING DEVICE IS SPECIFIED WITH THE ELEVATOR, THE ELECTRICAL CONTRACTOR SHALL PROVIDE A NORMALLY OPEN AUXILIARY CONTACT PER CAR. IN ADDITION, A DRY CONTACT (NORMALLY CLOSED) WILL ALSO BE REQUIRED. ELECTRICAL CONTRACTOR SHALL PROVIDE ALL CONDUIT AND WIRING AS NEEDED, MAKING FINAL CONNECTIONS UNDER THE DIRECTION OF THE ELEVATOR PROVIDER.
 - REFER TO E3-XX SERIES OF DRAWINGS FOR ADDITIONAL CABLE TRAY, FIRE ALARM AND SECURITY DEVICES.
 - PROVIDE CONDUIT BUSHINGS ON BOTH ENDS OF ALL CONDUITS/SLEEVES. WHERE SLEEVES PENETRATE FIRE WALLS, SLEEVES SHALL BE SEALED TO ACHIEVE THE FIRE RESISTANCE RATING OF THE WALL.

NOTES: (AS INDICATED ON THIS PLAN BY A NUMBER IN A ○)


- 1 SEE POWER RISER ON SHEET E4-01.
- 2 SEE MANHOLE DETAIL E0-06/01.
- 3 (3)-4" COMMUNICATION CONDUITS FROM MDF ROOM 309A TO PROPERTY LINE VIA MANHOLES. BURY CONDUITS A MINIMUM OF 36" BELOW GRADE.
- 4 (3)-4" COMMUNICATION CONDUITS STUBBED OUT AND CAPPED FROM MANHOLE. MARK LOCATION ON AS-BUILT PLANS.
- 5 (2)-3" CONDUIT SLEEVES - BURY A MINIMUM OF 36" BELOW GRADE. COORDINATE WITH POWER COMPANY FOR FINAL LOCATIONS.
- 6 2" CONDUIT SLEEVE - BURY A MINIMUM OF 24" BELOW GRADE.
- 7 PROPOSED PRIMARY UNDERGROUND POWER LINE BY DUKE ENERGY. COORDINATE CLOSELY. CONTRACTOR SHALL PROVIDE AND INSTALL (2) 6" CONDUITS FROM TRANSFORMER PAD TO GRASS AREA FOR DUKE ENERGY PRIMARY. COORDINATE EXACT REQUIREMENTS WITH DUKE ENERGY PRIOR TO ANY ROUGH-IN.
- 8 WEATHERPROOF JUNCTION BOX AND GFCI RECEPTACLE FOR DOMESTIC WATER BFP HEATER. CIRCUIT AS SHOWN.
- 9 WEATHERPROOF JUNCTION BOX AND GFCI RECEPTACLE FOR FIRELINE BFP HEATER. CIRCUIT AS SHOWN.
- 10 TAMPER SWITCH FOR POST INDICATOR VALVE (PIV). PROVIDE AND INSTALL 1" CONDUIT AND FIRE ALARM WIRING TO FIRE ALARM SYSTEM TO MONITOR TAMPER SWITCHES.
- 11 TAMPER SWITCHES FOR FIRELINE BFP. PROVIDE AND INSTALL 1" CONDUIT AND FIRE ALARM WIRING TO FIRE ALARM SYSTEM FOR MONITORING TAMPER SWITCHES.
- 12 TEMPERATURE SENSOR (POTTER OR EQUAL) FOR FIRELINE BFP HOT BOX. PROVIDE AND INSTALL 1" CONDUIT AND FIRE ALARM WIRING TO FIRE ALARM SYSTEM FOR MONITORING TEMPERATURE SENSOR. THE ELECTRICAL CONTRACTOR SHALL PROVIDE AND INSTALL ALL CONDUIT, WIRING, TEMPERATURE SENSOR (POTTER OR EQUAL) FOR A COMPLETE INSTALLATION.
- 13 ELECTRICAL CONTRACTOR SHALL PROVIDE SEPARATE ELECTRICAL SERVICE FOR SCHOOL SIGN. REFER TO DETAIL 02 ON THIS SHEET.
- 14 REFERENCE LOCATION FOR DUKE ENERGY SITE LIGHTING. REFER TO CIVIL DRAWINGS.
- 15 PROVIDE AND INSTALL (2) 2" (SPARE) CONDUITS FROM ELECTRICAL ROOM 127 FOR FUTURE USE. BURY A MINIMUM OF 24" BELOW GRADE, CAP BOTH ENDS AND LOCATE ON AS-BUILT PLANS USING DIMENSIONS.
- 16 PROVIDE AND INSTALL (2) 2" (SPARE) CONDUITS FROM ELECTRICAL ROOM 145-1 FOR FUTURE USE. BURY A MINIMUM OF 24" BELOW GRADE, CAP BOTH ENDS AND LOCATE ON AS-BUILT PLANS USING DIMENSIONS.
- 17 PROVIDE AND INSTALL (2) 2" (SPARE) CONDUITS FROM ELECTRICAL ROOM 209 FOR FUTURE USE. BURY A MINIMUM OF 24" BELOW GRADE, CAP BOTH ENDS AND LOCATE ON AS-BUILT PLANS USING DIMENSIONS.
- 18 PROVIDE AND INSTALL (2) 2" (SPARE) CONDUITS FROM ELECTRICAL ROOM 307 FOR FUTURE USE. BURY A MINIMUM OF 24" BELOW GRADE, CAP BOTH ENDS AND LOCATE ON AS-BUILT PLANS USING DIMENSIONS.
- 19 PROVIDE AND INSTALL (2) 2" (SPARE) CONDUITS FROM MECHANICAL ROOM 634B FOR FUTURE USE. BURY A MINIMUM OF 24" BELOW GRADE, CAP BOTH ENDS AND LOCATE ON AS-BUILT PLANS USING DIMENSIONS.
- 20 PROVIDE AND INSTALL (2) 2" (SPARE) CONDUITS FROM MDF ROOM 309A FOR FUTURE USE. BURY A MINIMUM OF 24" BELOW GRADE, CAP BOTH ENDS AND LOCATE ON AS-BUILT PLANS USING DIMENSIONS.
- 21 PROVIDE AND INSTALL (3) 3" (SPARE) CONDUITS FROM MDF ROOM 309A TO MANHOLE FOR OUTLYING FACILITIES. BURY A MINIMUM OF 24" BELOW GRADE, CAP BOTH ENDS AND LOCATE ON AS-BUILT PLANS USING DIMENSIONS.
- 22 PROVIDE AND INSTALL (2) 3" (SPARE) CONDUITS FROM MANHOLE TO OUTLYING STRUCTURE, FOR FUTURE COMMUNICATIONS CABLING. LOCATE ON AS-BUILT PLANS.
- 23 REFER TO PANEL SCHEDULE FOR CONDUIT AND WIRE SIZE.
- 24 PROVIDE AND INSTALL WEATHERPROOF DISCONNECT SWITCH FOR SCOREBOARD. PROVIDE AN EXTRA HEAVY DUTY IN-USE COVER. COORDINATE EXACT LOCATION WITH THE SCOREBOARD PROVIDER.
- 25 STUB-OUT (2) 3" SPARE CONDUITS FROM THE TRANSFORMER PAD FOR FUTURE SPORTSFIELD LIGHTING. CAP ENDS OF CONDUITS AND LOCATE ON ASBUILT PLANS.
- 26 PROVIDE AND INSTALL (2) 3" CONDUITS UNDERGROUND BETWEEN MDF-309A AND NETWORK CLOSETS. LOCATE ROUTE ON ASBUILT PLANS.
- 27 GREENHOUSE PANEL. REFER TO POWER RISER ON E4-01. COORDINATE EXACT LOCATION WITH OWNER/ARCHITECT PRIOR TO ROUGH-IN.
- 28 PROVIDE AND INSTALL (1) 2" CONDUIT UNDERGROUND BETWEEN IDF-219 AND SCHOOL SIGN FOR FUTURE COMMUNICATIONS. ROUTE CONDUIT USING QUAZITE# PC1212H000, TIER 15, 2-BOLTS, GASKETED HANDHOLES AT LOCATIONS SHOWN.

GENERAL NOTES:

1. ALL COPPER COMMUNICATIONS, FIRE ALARM, ETC. CONDUCTORS EXISTING THE BUILDING ENVELOPE SHALL BE PROVIDED WITH LIGHTNING SURGE SUPPRESSION AS REQUIRED PER NEC ARTICLE 800. REFER TO SPECIFICATIONS.
2. ELECTRICAL CONTRACTOR SHALL PROVIDE PULL CORDS IN ALL EMPTY CONDUITS. PLEASE NOTE, THE PULL CORDS FOR THE COMMUNICATIONS SERVICE ENTRANCE FROM THE PROPERTY LINE WILL BE REQUIRED TO MEET THEIR REQUIREMENTS. PLEASE COORDINATE CLOSELY.
3. THE MAINTENANCE BUILDING SHALL BE AN ALTERNATE IN THE PROJECT. REFER TO ARCHITECT'S ALTERNATE SECTION 012300. THE ELECTRICAL CONTRACTOR SHALL STUB-OUT & CAP (2)-3" COMMUNICATION CONDUITS 5'-0" FROM THE MANHOLE TOWARDS THE MAINTENANCE BUILDING IF THE ALTERNATE IS NOT ACCEPTED. LOCATE ON AS-BUILT PLANS.

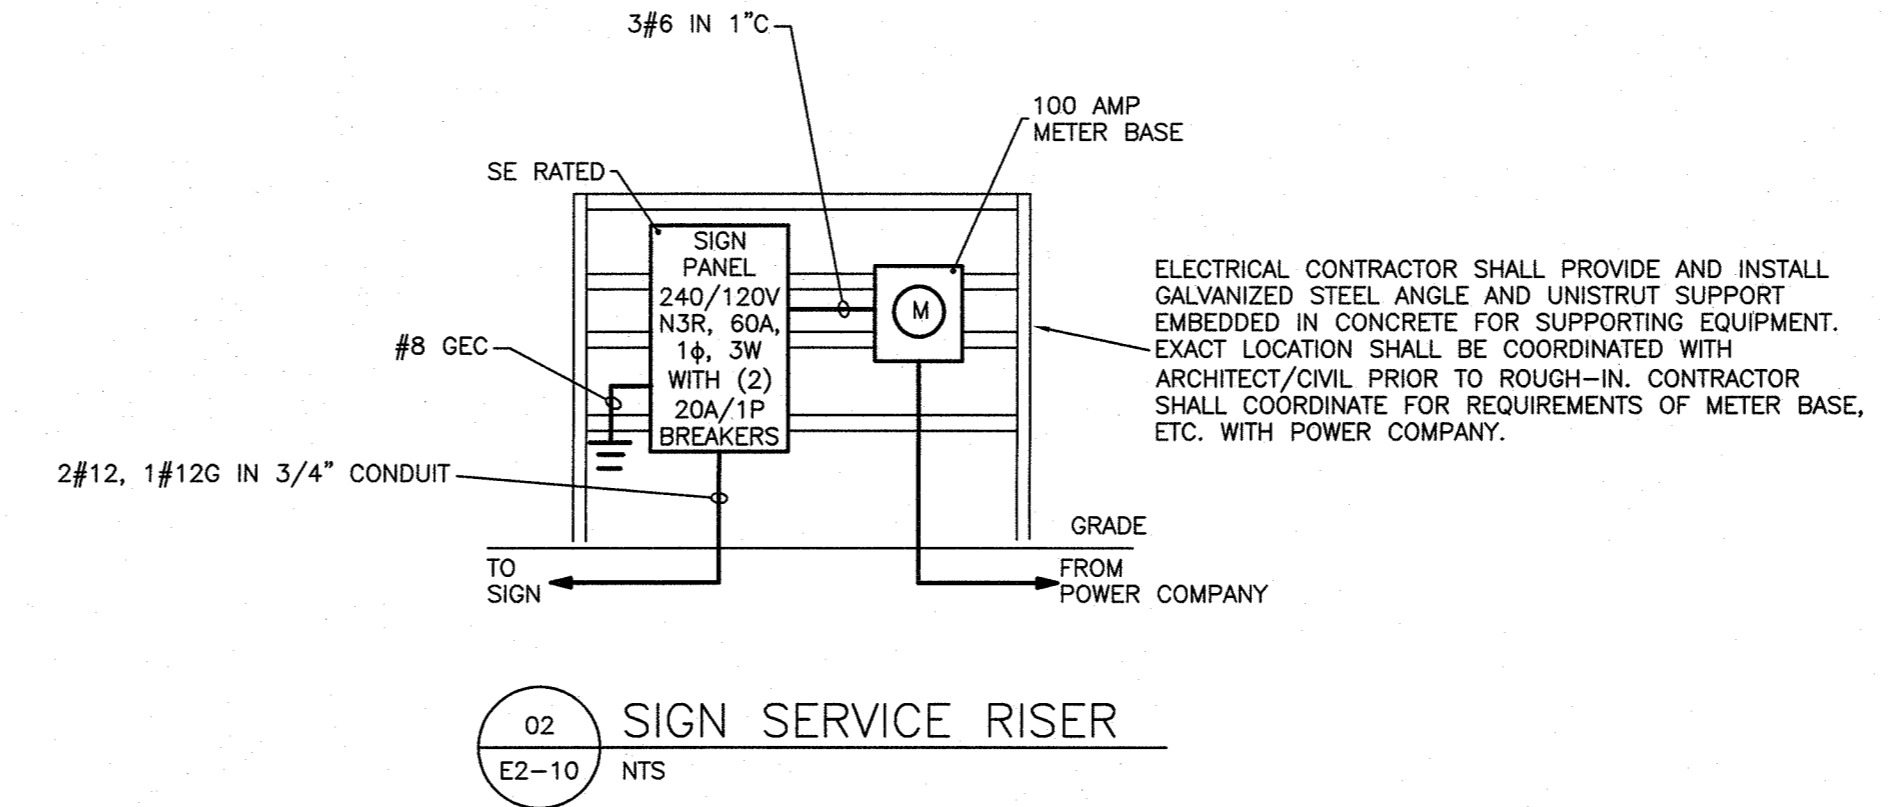

02 SIGN SERVICE RISER
E2-10 NTS

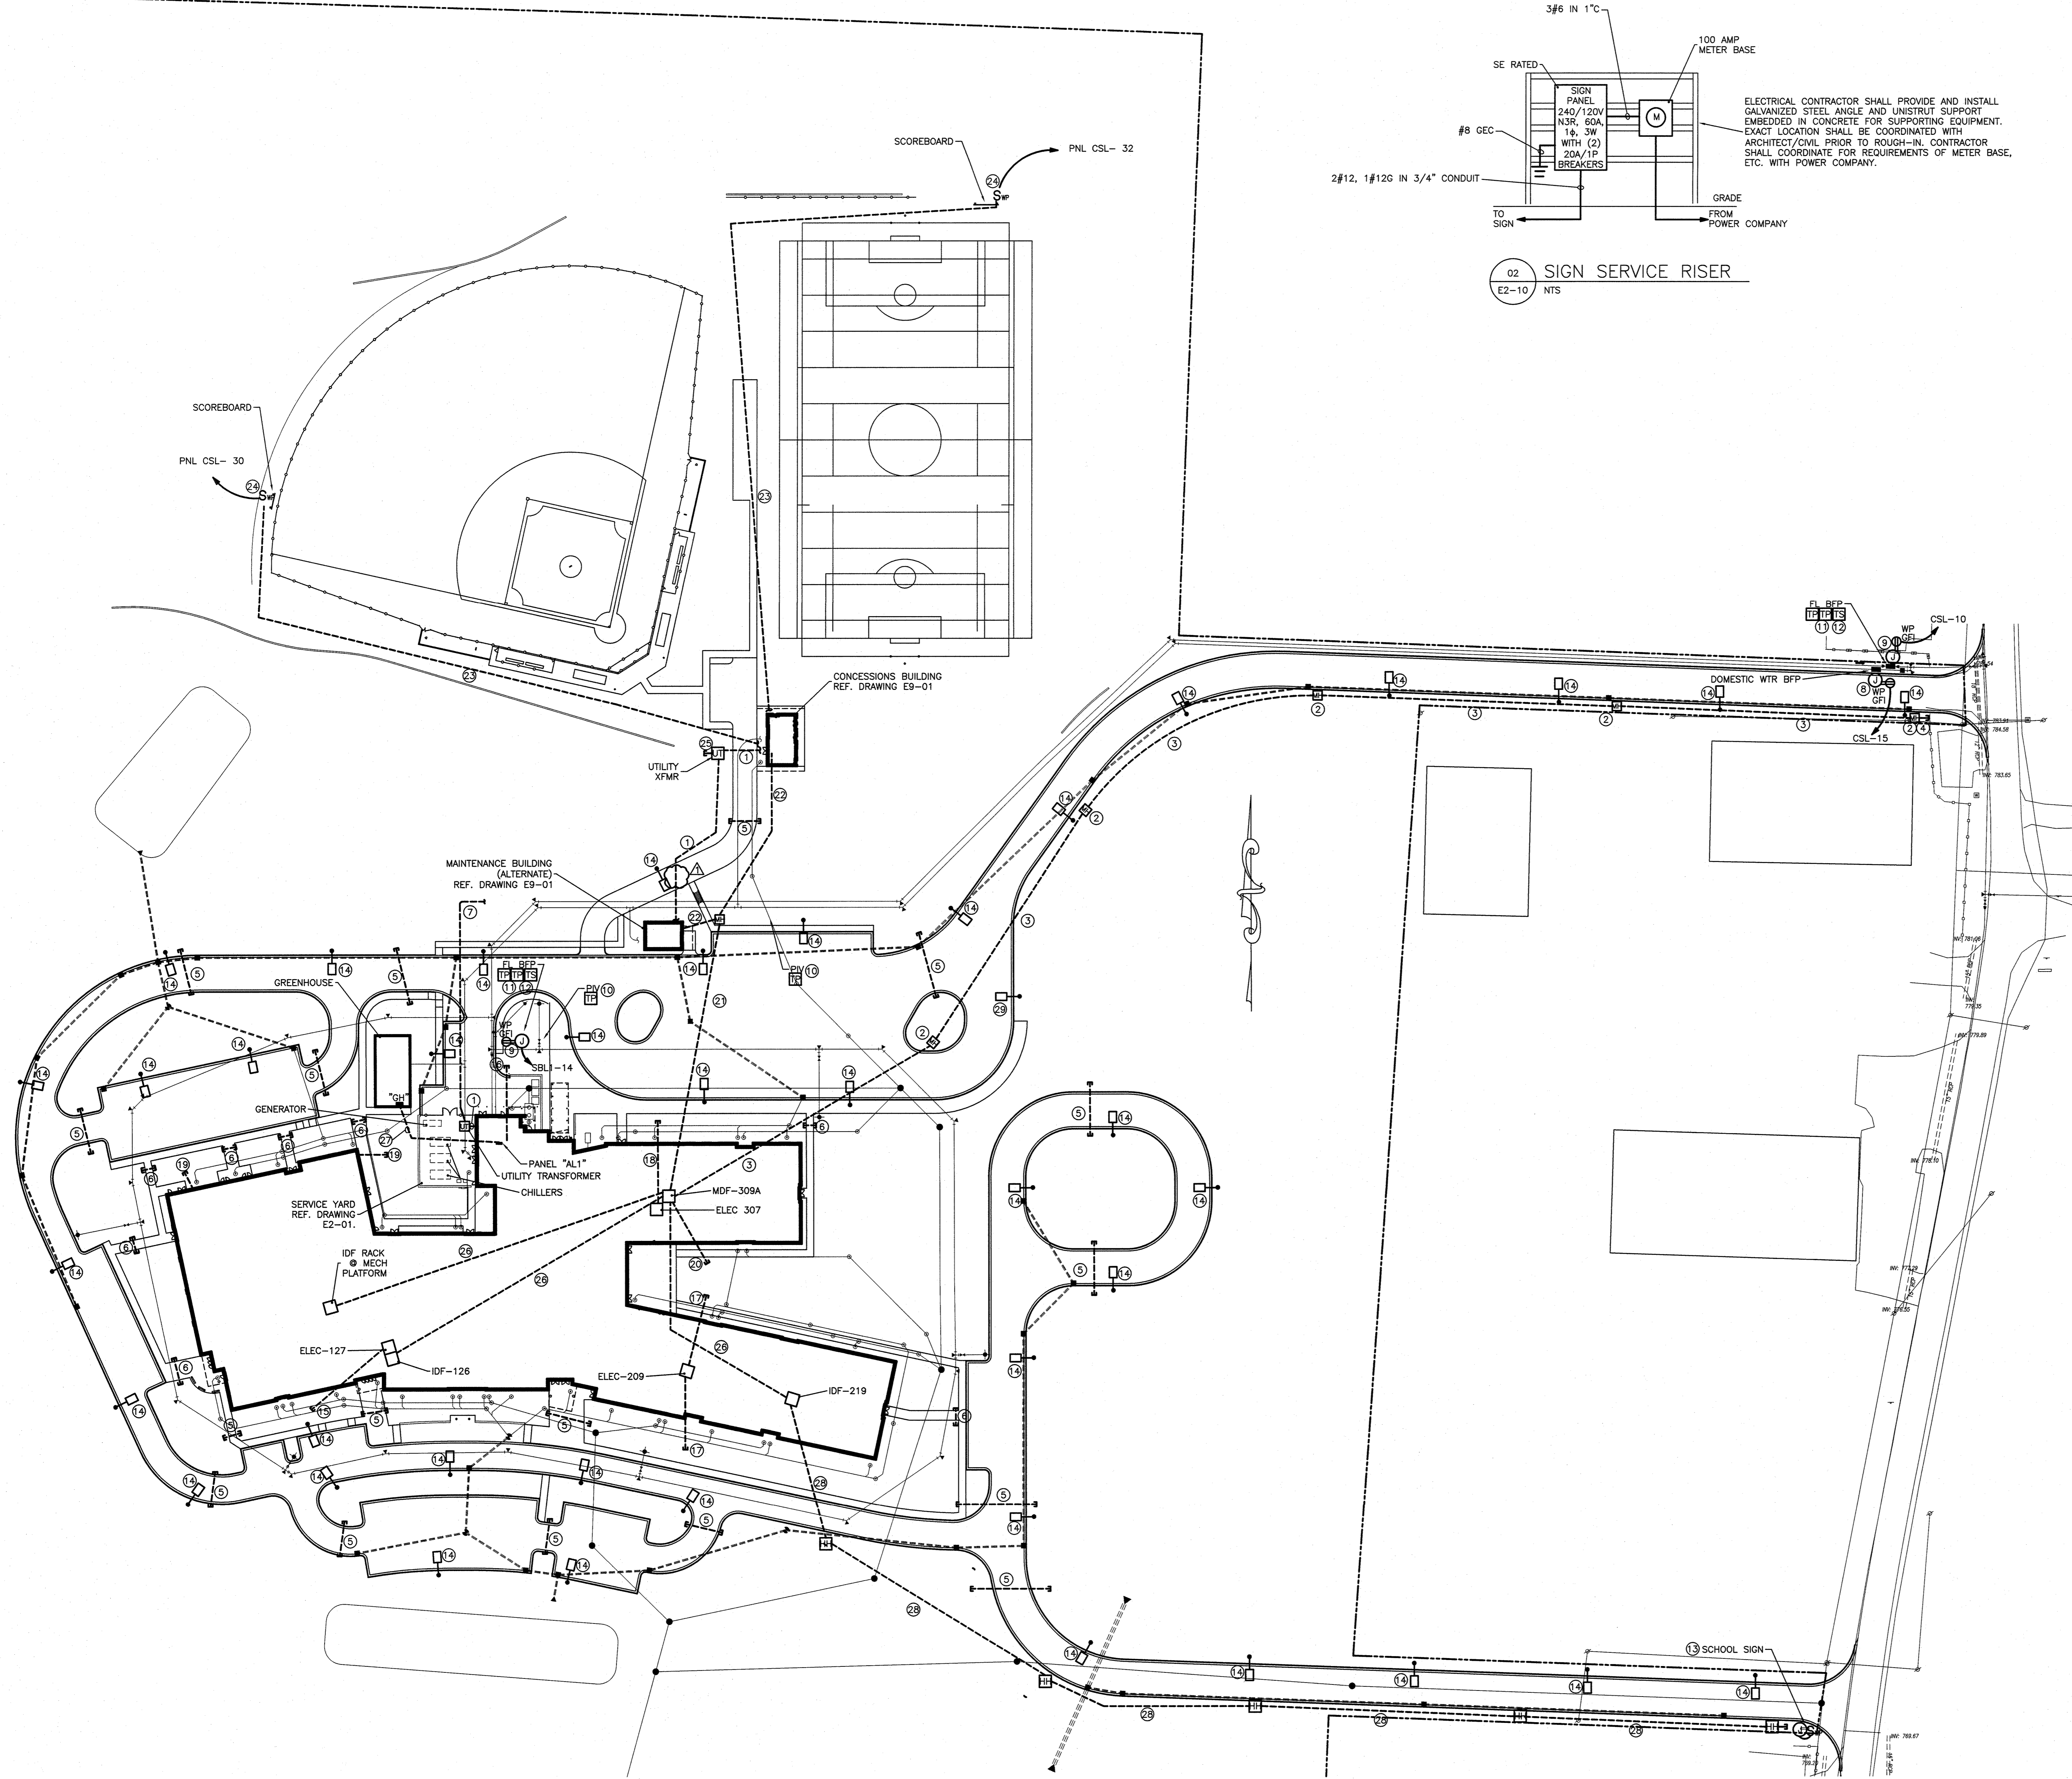


01 ELECTRICAL SITE PLAN
E2-10 1" = 60'-0"



WALL RATINGS LEGEND	
	1 HR RATED WALL
	2 HR RATED WALL



T 919 791 8832
F 919 791 8879
4000 Lake Boone Trail
Suite 205
Raleigh, NC 27607
info@smithsinnett.com

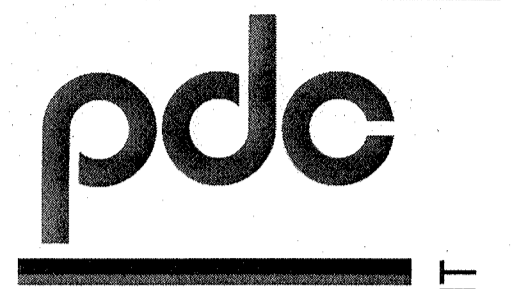


Progressive Design Collaborative, Inc.
3101 Poplarwood Court, Suite 300
Raleigh, North Carolina 27604
PROJECT #17184
PROJECT #17184
Location: C-0103
pdc@pdc.com

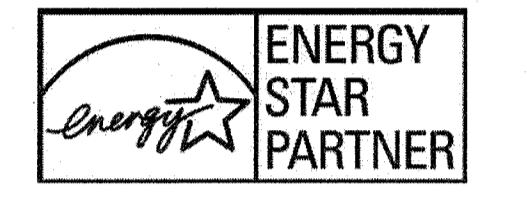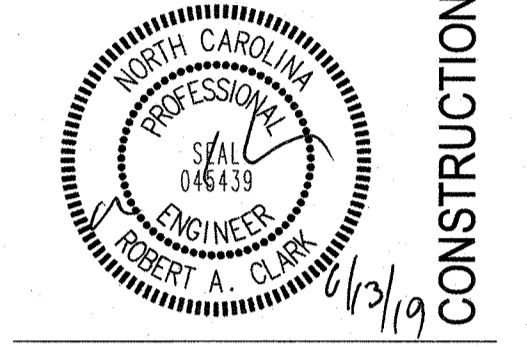

VOLUME II

The liability of the design shown is the property of Smith Sinnett Architects, P.A. The reproduction or use of this drawing without the consent of the Architect is prohibited. Any infringement of the copyright of this drawing shall be the responsibility of the user. The Architect of the completion of the contract.
Smith Sinnett Architects, P.A. 2019
THIS DRAWING IS FORMATTED TO BE PRINTED ON A 36" X 48" SHEET

NEW TRINITY MIDDLE SCHOOL
RANDOLPH COUNTY SCHOOL SYSTEM
Parcel PIN 7708118367
Surrett Drive
Trinity, NC 27370

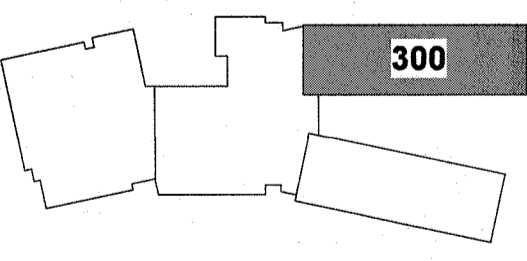

KEY PLAN
NO SCALE


ID	DATE	DESCRIPTION
1	06/14/19	ADDENDUM 03

DRAWN BY: Author
CHECKED BY: RA

FIRST FLOOR FIRE ALARM/SECURITY PLAN - AREA 300

2017032 20 MAY 2019

E3-03

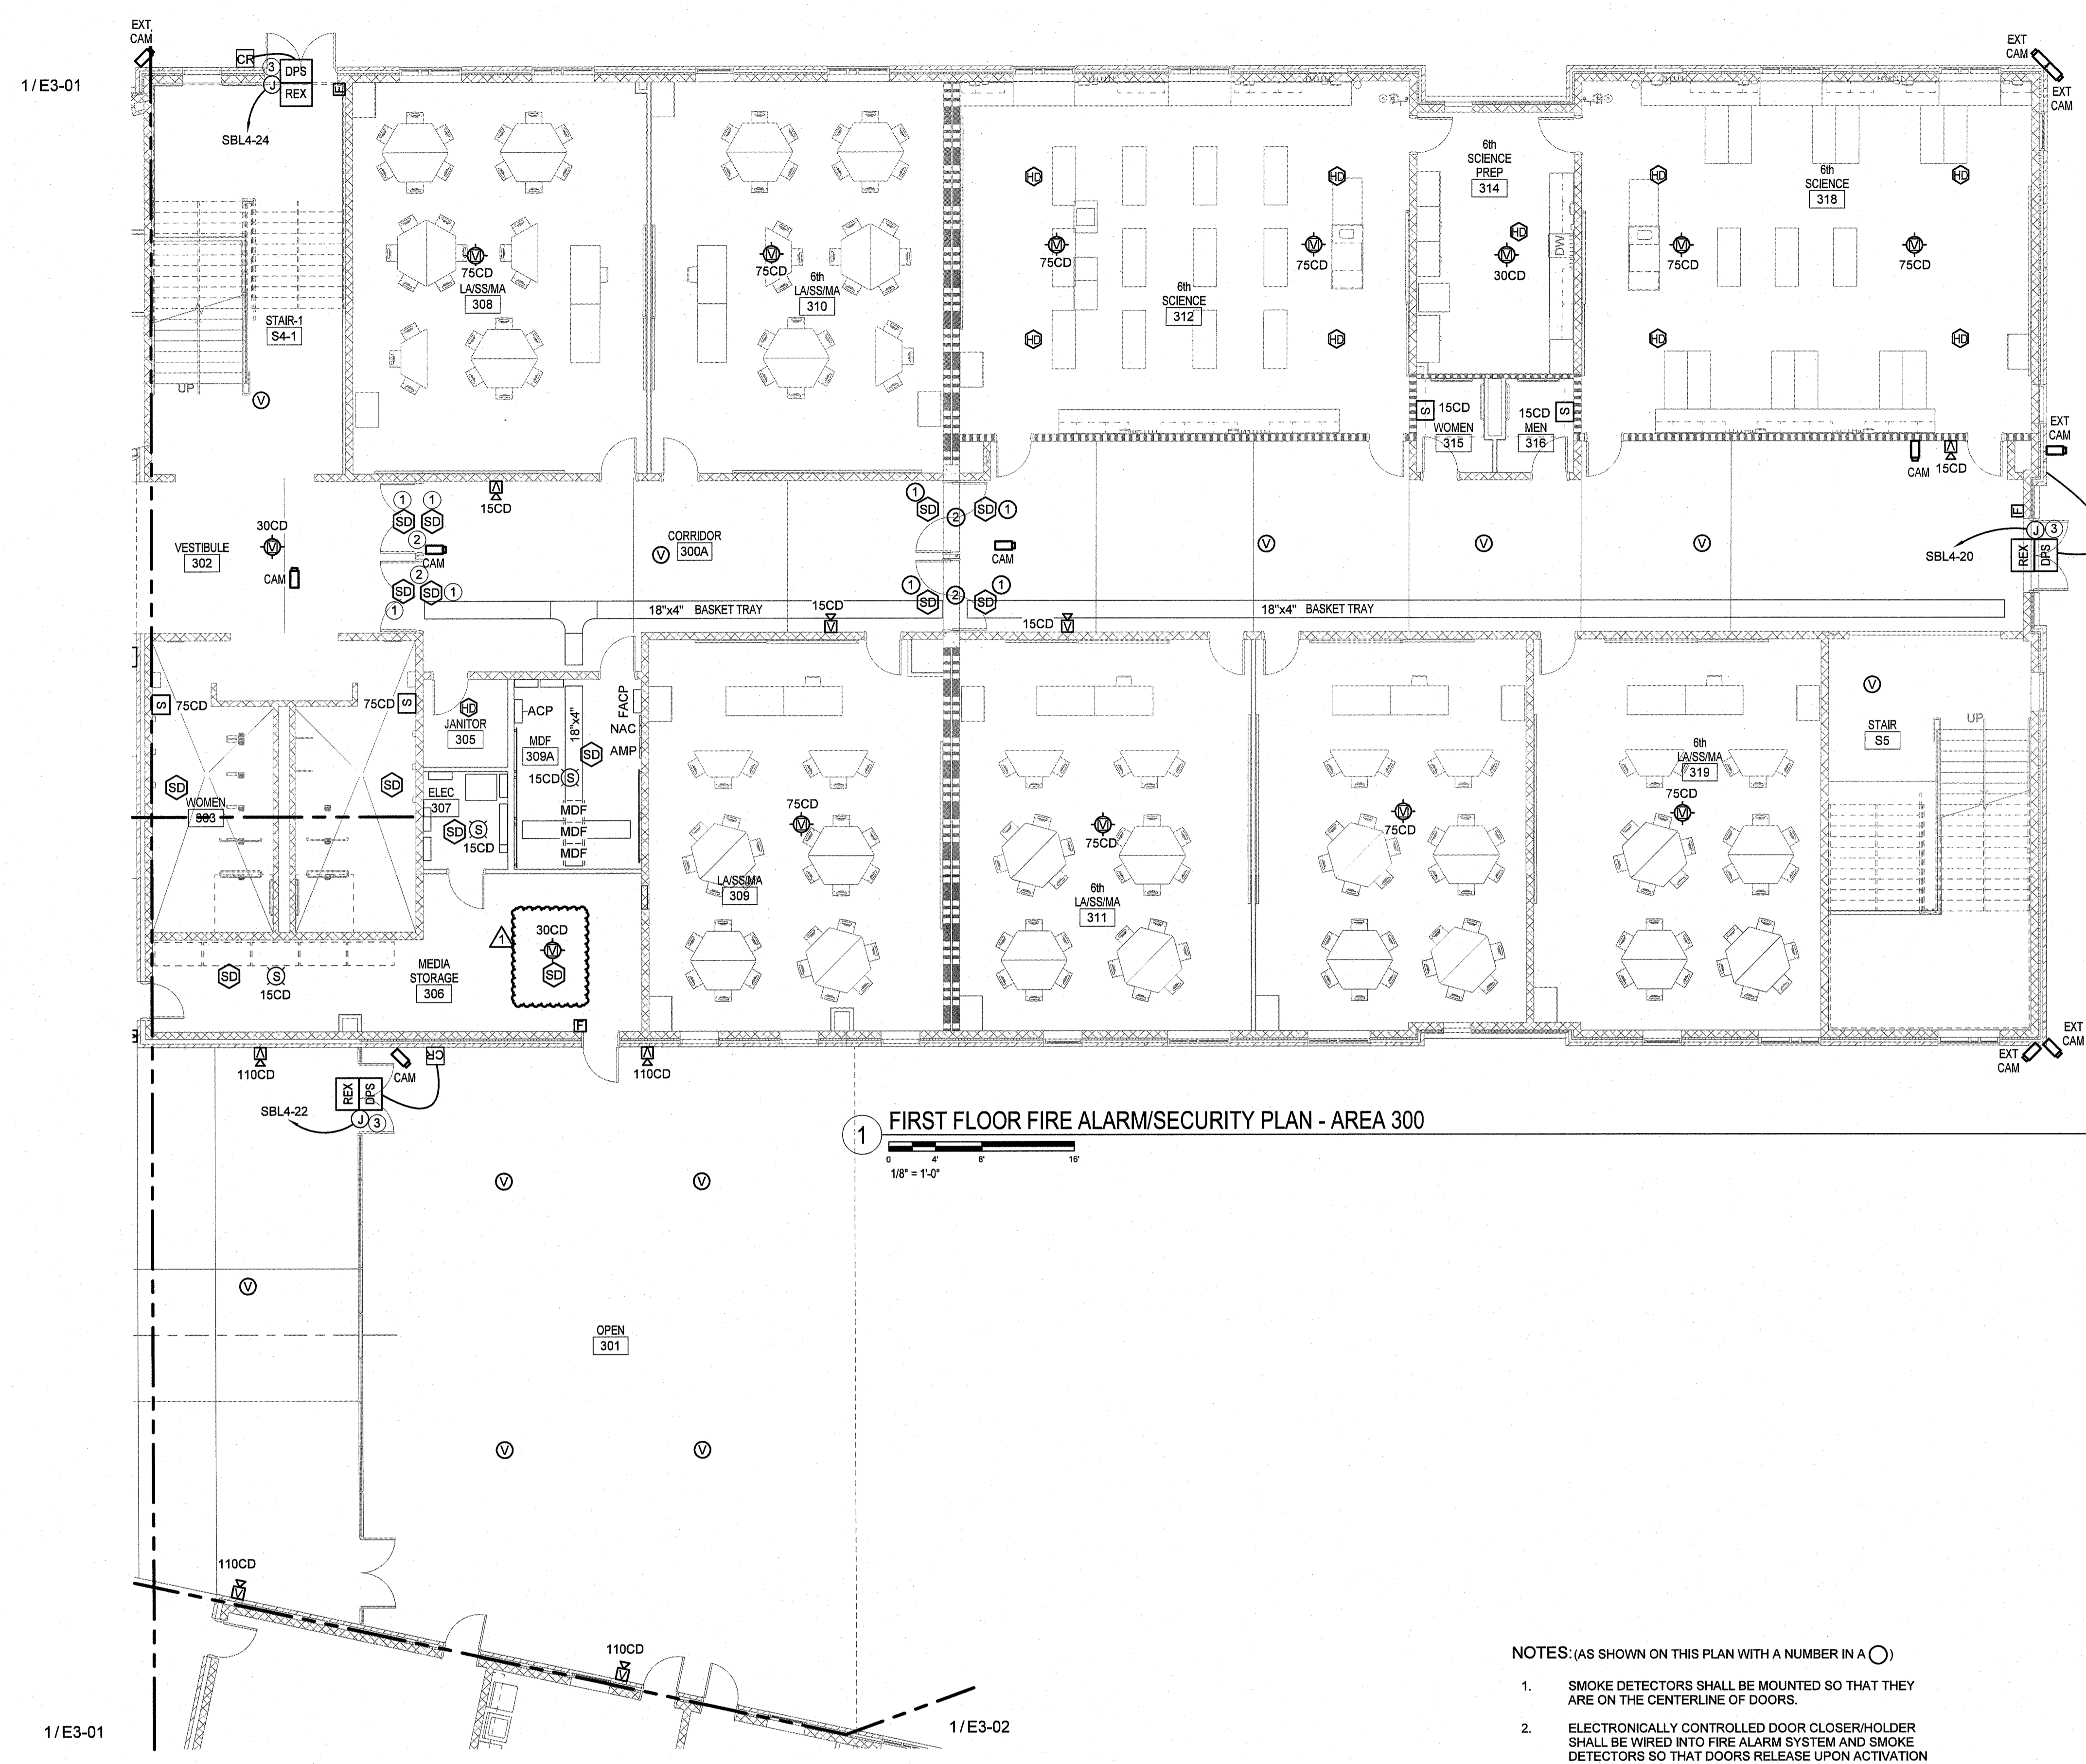


1 FIRST FLOOR FIRE ALARM/SECURITY PLAN - AREA 300
1/8" = 1'-0"

NOTES: (AS SHOWN ON THIS PLAN WITH A NUMBER IN A ○)


- SMOKE DETECTORS SHALL BE MOUNTED SO THAT THEY ARE ON THE CENTERLINE OF DOORS.
- ELECTRONICALLY CONTROLLED DOOR CLOSER/HOLDER SHALL BE WIRED INTO FIRE ALARM SYSTEM AND SMOKE DETECTORS SO THAT DOORS RELEASE UPON ACTIVATION OF SYSTEM.
- PROVIDE 120VAC POWER FOR ACCESS CONTROLLED DOOR. COORDINATE EXACT LOCATION WITH ARCHITECT/OWNER/DOOR HARDWARE CONTRACTOR PRIOR TO ROUGH-IN.

GENERAL NOTES:


- ALL FIRE ALARM WIRING SHALL BE IN CONDUIT. REFER TO SPECIFICATIONS.
- CABLE TRAY IS FOR NETWORK CABLING.
- REFER TO E2 SERIES OF DRAWINGS FOR CONDUIT SLEEVES.
- CARD READERS AND ACCESS CONTROL DEVICES SHALL BE PROVIDED BY OWNER'S SECURITY CONTRACTOR. NOTE: ALL ROUGH-IN SHALL BE BY THE ELECTRICAL CONTRACTOR.
- ALL CAMERAS AND MOUNTS SHALL BE PROVIDED BY THE OWNER'S SECURITY CONTRACTOR. THE CAT-6 WIRING FOR THE CAMERAS SHALL BE BY THE DIVISION 27 CONTRACTOR. THIS INCLUDES THE SMB CONNECTORS. THE 3FT CAT-6 PATCH CABLES TO THE CAMERAS SHALL BE BY THE DIVISION 27 CONTRACTOR.

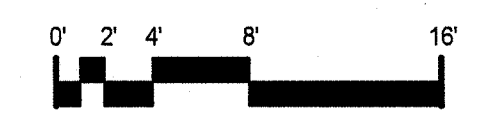

C:\Users\jbl\Documents\Local\17184_TRINITYMS_PDC_Central_Blanckley\SC20R.nt
6/20/19 4:52:27 PM

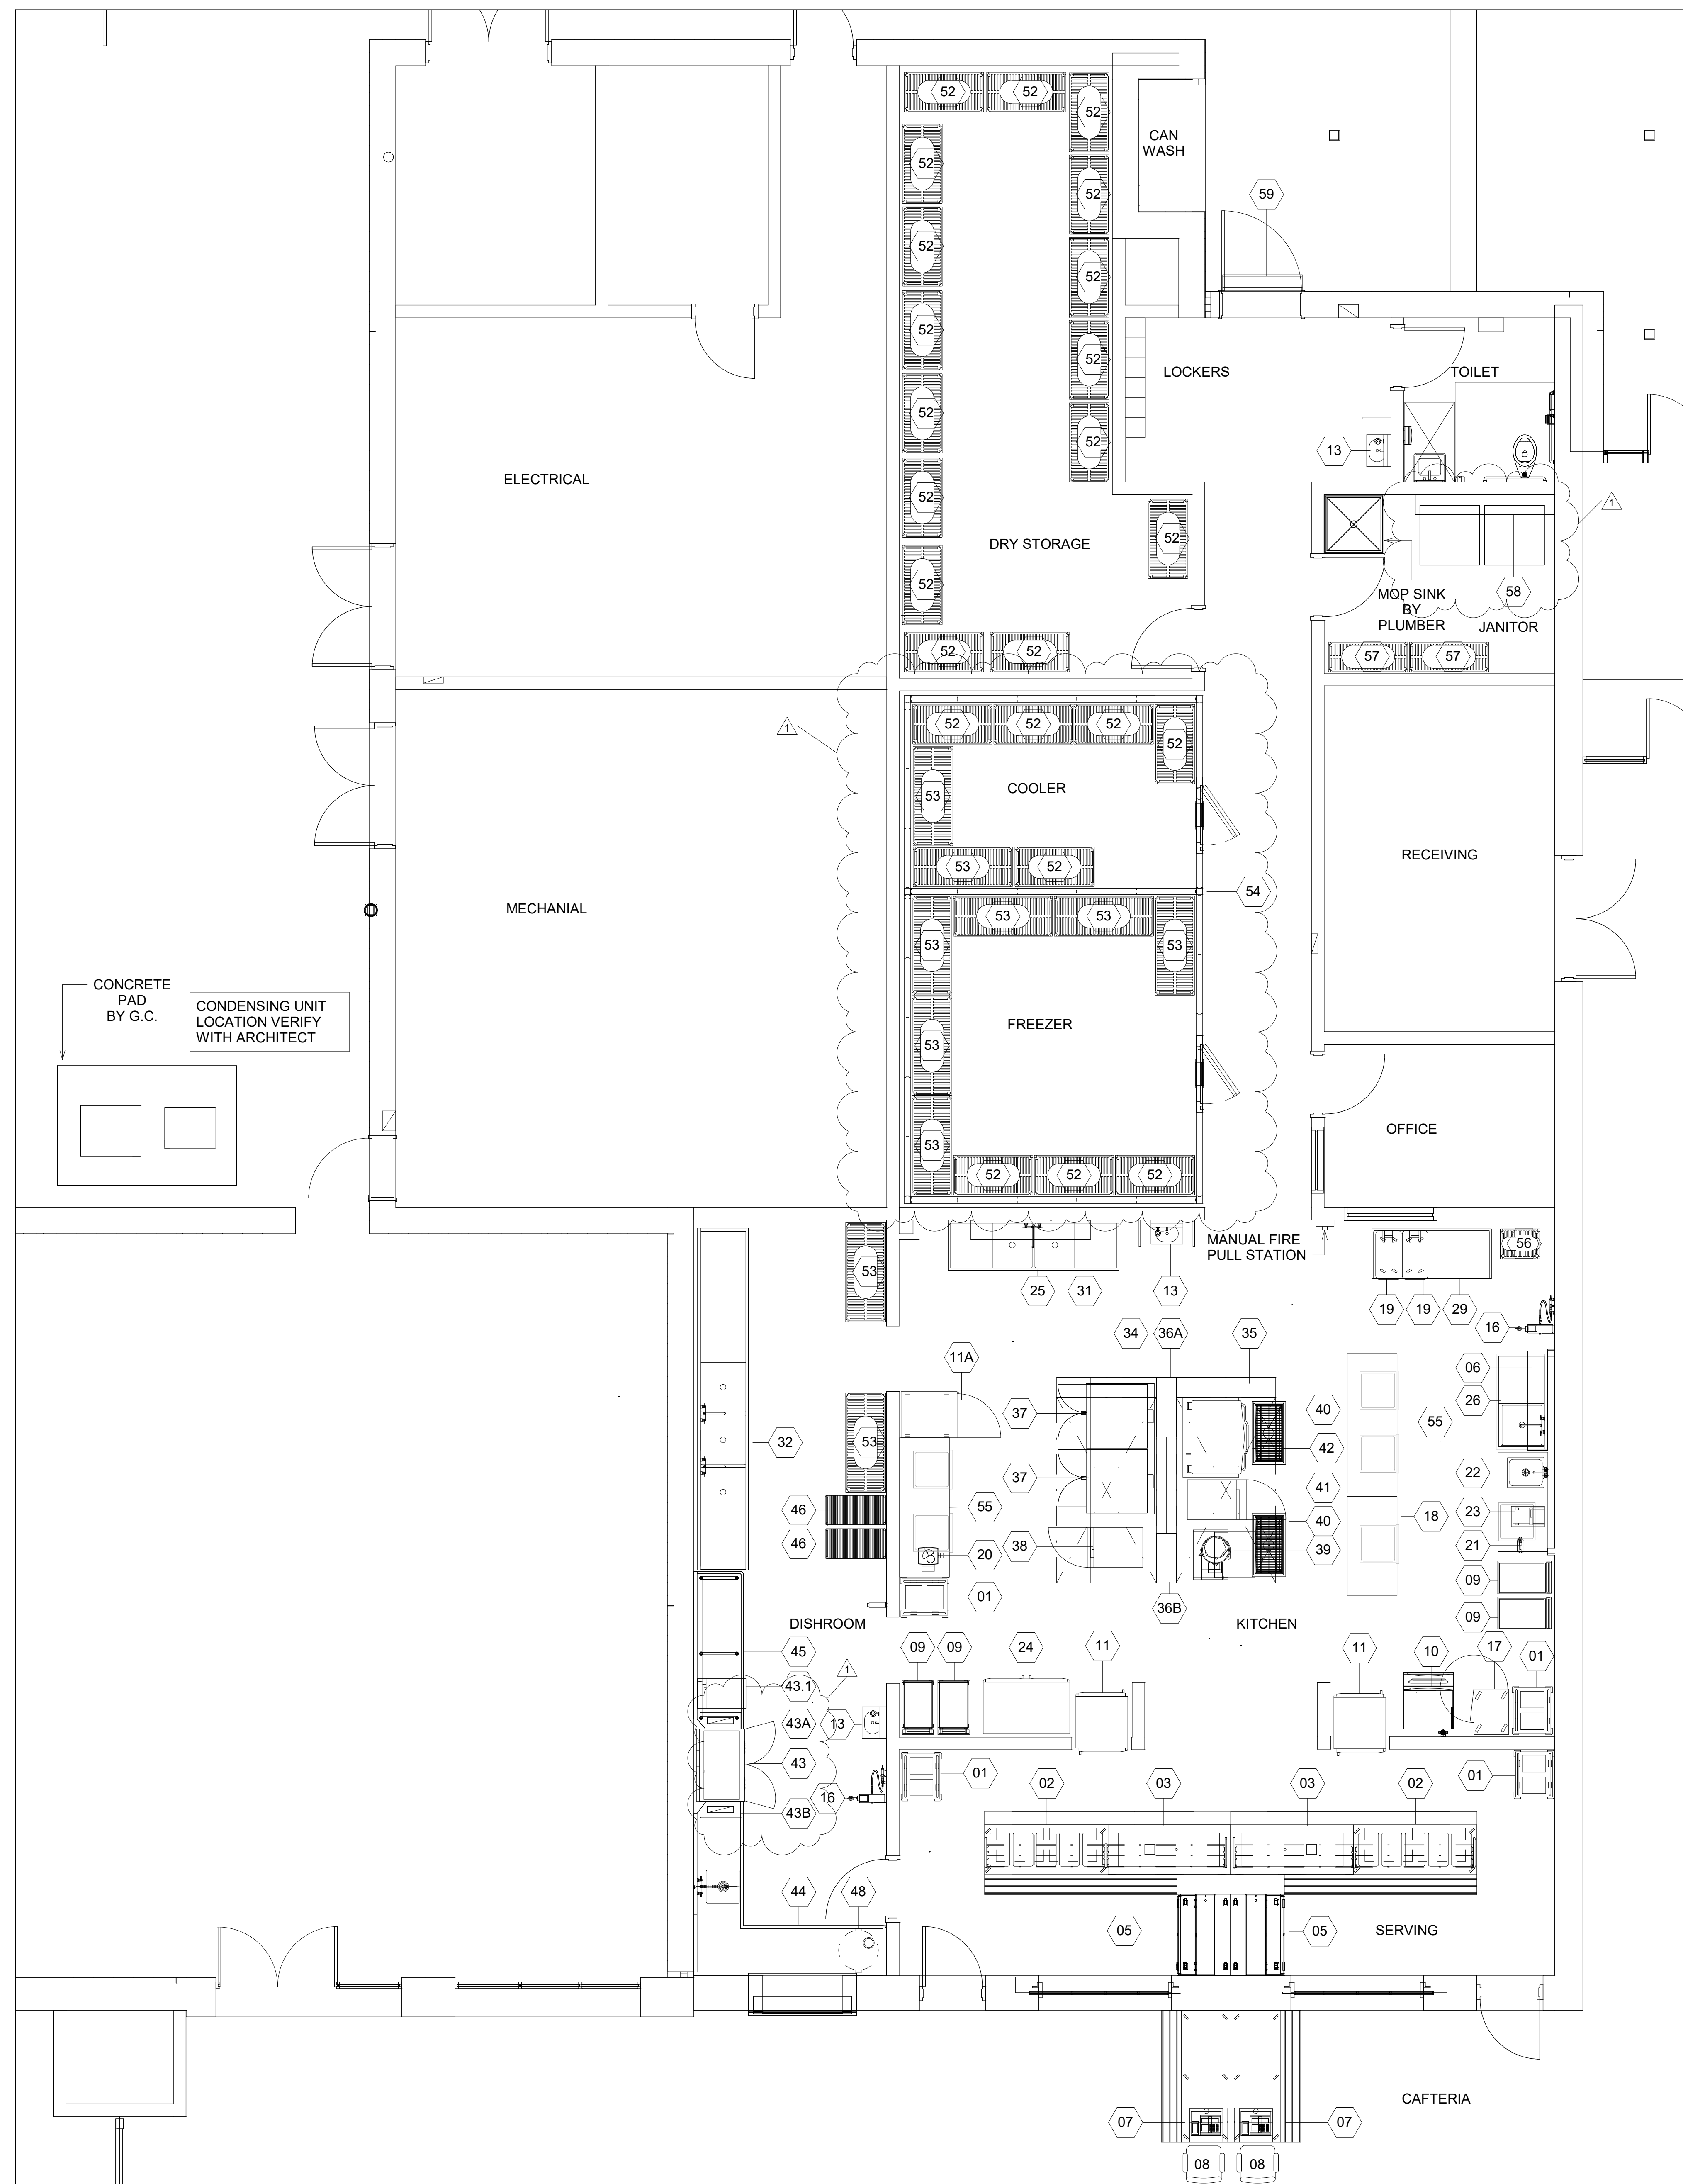


1 FOOD SERVICE EQUIPMENT PLAN
 FS.01 1/4" = 1'-0"

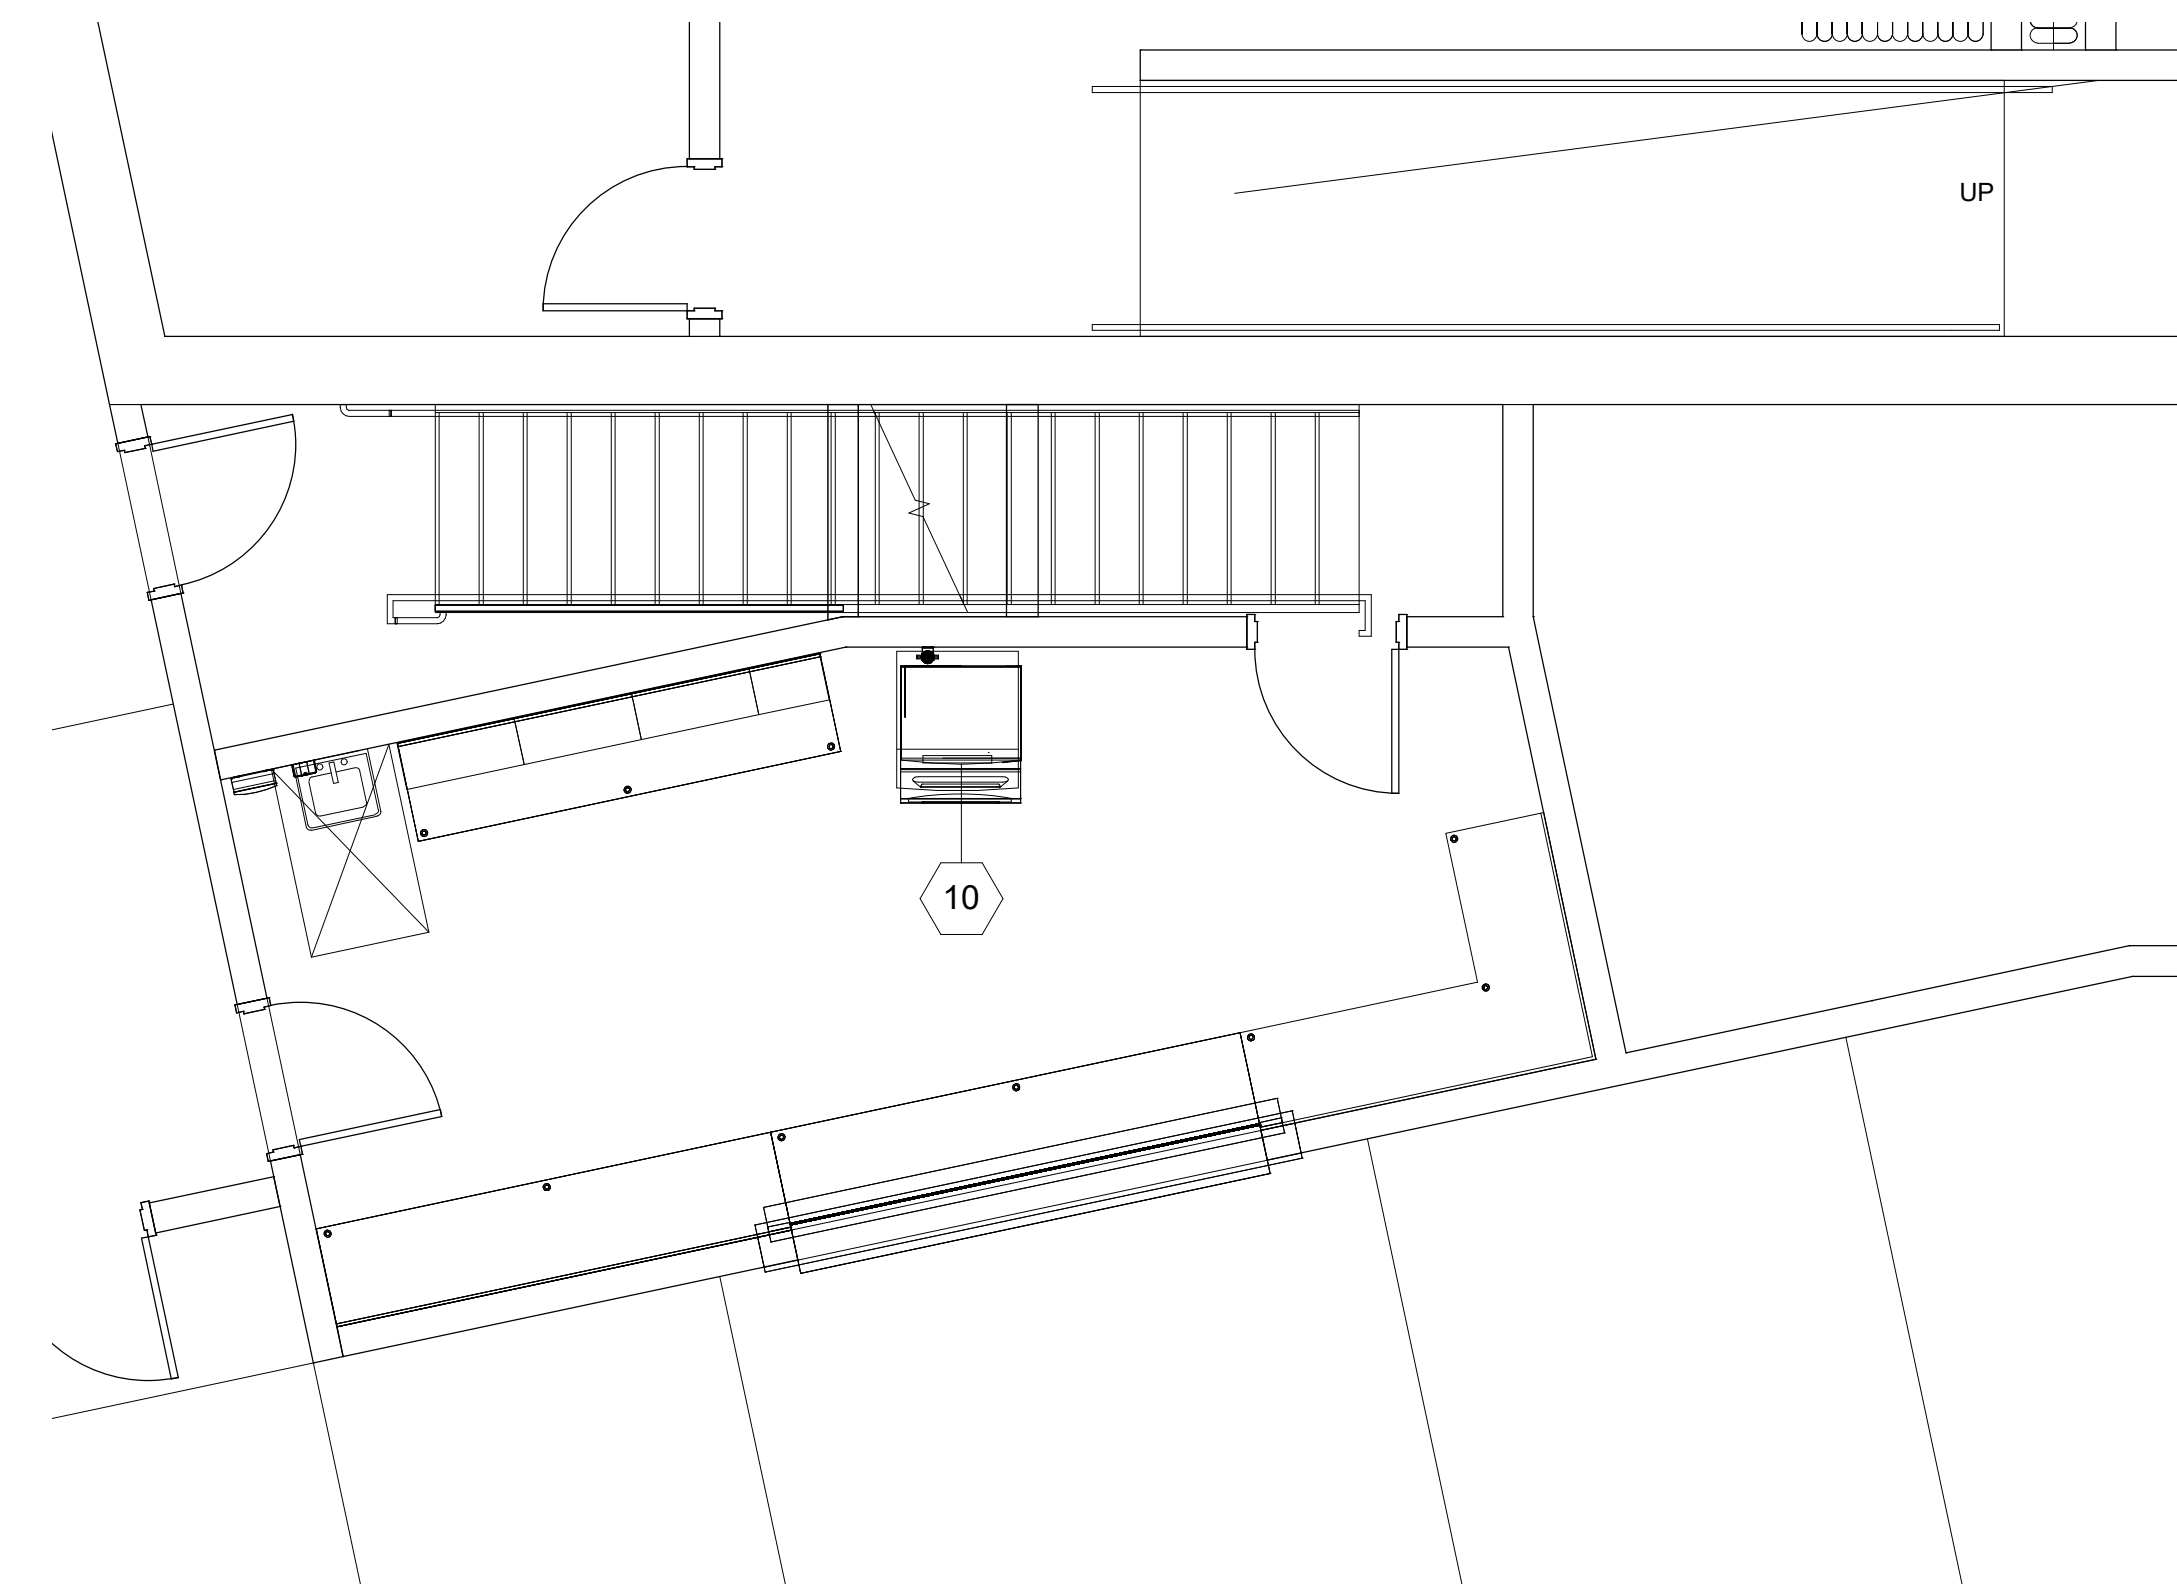

2 FOOD SERVICE CONCESSION PLAN
 FS.01 1/4" = 1'-0"

C:\Users\Owner\Desktop\FoodService\PROJECTS\TRINITY MIDDLEBIRD SET\20170321_Trimly Middle_FS_0119019nvt.rvt
 5/2/2019 11:52:28 AM

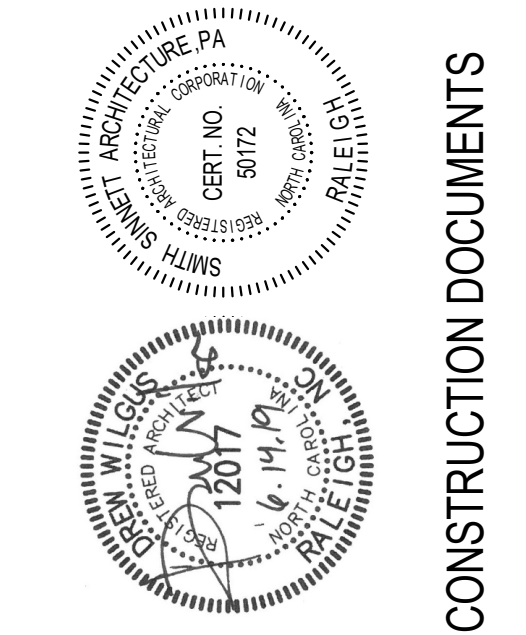


The drawings and information shown here are the property of Smith Sinnett Architecture, P.A. The reproduction or use of this information without the written consent of Smith Sinnett Architecture, P.A. is prohibited. Any infringement of the copyright rights will be subject to legal action. All copies are subject to the terms and conditions of the contract.
 Smith Sinnett Architecture, P.A. 2018
 THIS DRAWING IS FORMATTED TO BE PRINTED ON A 30" x 42" SHEET

**NEW TRINITY MIDDLE SCHOOL
 RANDOLPH COUNTY SCHOOL SYSTEM**
 Parcel PIN 7708118367
 Surratt Drive
 Trinity, NC 27370

KEY PLAN
 NO SCALE

ID	DATE	DESCRIPTION
DRAWN BY:		JA
CHECKED BY:		KM

**FOODSERVICE
EQUIPMENT PLAN**

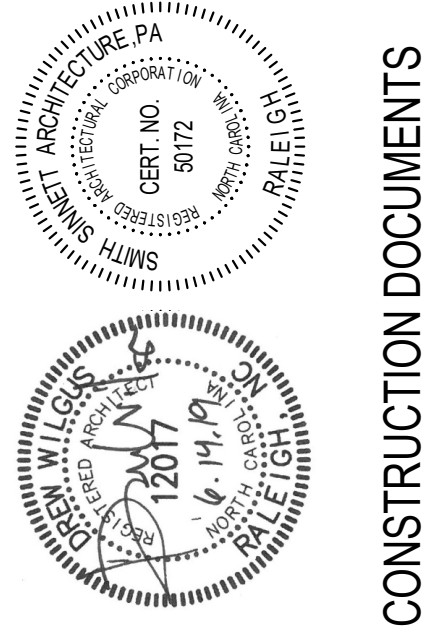

The drawings and specifications herein are the property of Smith Sinnett Architecture, P.A. No reproduction or use of this project without the written consent of Smith Sinnett Architecture, P.A. is prohibited. Any infringement of the copyright rights will be subject to legal action. All copies of these drawings must be made from the original drawings. Smith Sinnett Architecture, P.A. 2018
THIS DRAWING IS FORMATTED TO BE PRINTED ON A 30" x 42" SHEET

FOODSERVICE EQUIPMENT SCHEDULE

QTY	ITEM	DESCRIPTION	MANUFACTURER	MODEL	ELECT. A.F.F.	ELECTRICAL					PLUMBING					REMARKS	Item #					
						KW	HP	AMPS	VOLTS	PHASE	NEMA	HW SIZE	HW/A.F.F.	CW SIZE	CW/A.F.F.			IW	DRAIN TYPE	DW	DW A.F.F.	
4	01	TUBULAR TRAY DRISPENSER	COLORPOINT	CPM-MTD-2-1014														TRAY SLIDE, CUTTING BOARD, SNNEZE GUARD, CASTERS	01			
2	02	HOT FOOD TABLE	COLORPOINT	EF5-CPA-EB	STUB			27.5 A	120	1	5-15P							TRAY SLIDE, CUTTING BOARD, SNNEZE GUARD, CASTERS	02			
2	03	COLD FOOD TABLE	COLORPOINT	36-CFMA-74	STUB			7.6 A	120	1	5-15P							TRAY SLIDE, CUTTING BOARD, SNNEZE GUARD, CASTERS	03			
1	04	NOT USED	-	-															04			
2	05	MILK COOLER	TRAUlsen	RMC49S4	24"			7.2 A	120	1	5-15P							CASTERS	05			
1	06	WALL MOUNTED SHELF	EAGLE GORUP	SWS1260-16/4														MOUNT AT 4' - 6" A.F.F.	06			
2	07	CASHIER STAND	COLORPOINT	36-CSE-MOD	24"													CASTERS	07			
2	08	CASHIER CHAIR	KRUEGER	BY OWNER															08			
4	09	UTILITY CART	METRO	MY1627-24BL															09			
2	10	ICE MAKER W/ BIN	MANITOWOC	ID0302A				10.8 A	120	1	DIRECT			1/2"	F.S.							
2	11	PASS-THRU HEATED CABINET	VICTORY	HS-1D-1-EW-PT	90"			6.3 A	208	1	C&P							CASTERS	11			
1	11A	HOLDING CABINET	WINSTON	HA4522-HL-3	24"			19.3 A	120	1	5-20P							CASTERS	11A			
1	12	NOT USED	-	-															12			
3	13	HAND SINK	EAGLE GROUP	HSA-10-FDP												1 1/2"		GOOSENECK FAUCET, BASKET LEVER DRAIN, SOAP/PAPER TOWEL DISPENSER	13			
2	14-15	NOT USED	-	-															14-15			
2	16	HOSE REEL	T&S BRASS	B-1433										1/2"	42"	1/2"	42"	1 1/2"	F.D.	30' HOSE, WALL MOUNTING FAUCET W/ LEVER HANDLES, HOSE CONNECTOR AND QUICK DISCONNECT, SPRAY VALVE, WALL BRACKET	16	
1	17	NON-INSULATE CABINET	CRES COR	100-1841D																17		
1	18	WORKTABLE	EAGLE GROUP	T3060SE																18		
2	19	INGREDIENT BINS	CAMBRO	IB36148																19		
1	20	FOOD PROCESSOR	ROBOT COUPE	CL50 GOURMET	24"			13.5 A	120	1	C&P									20		
1	21	CAN OPENER	EDLUND	S-11																21		
1	22	WORKTABLE W/ SINK	EAGLE GROUP	T3060SE										1/2"	14"	1/2"	14"			20" x 20" x 5" DRAWER, SINK W/ FAUCET MODEL # B-0231, LEVER DRAIN, S/S UNDERSHELF	22	
1	23	ELECTRIC CAN OPENER	EDLUND	266	24"			10.0 A	120	1	C&P									23		
1	24	REACH-IN REFRIGERATOR	VICTORY	RSA-2D-S1	24"			10.7 A	120	1	C&P									24		
1	25	TWO-COMPARTMENT SINK	EAGLE GROUP	FFN2740-2-24-14/3										1/2"	14"	1/2"	14"	1 1/2"	F.S.	T&S BRASS FAUCET MODEL# B-0231, (2) LEVER DRAIN, CASTERS	25	
1	26	ONE COMPARTMENT SINK	EAGLE GROUP	FN2424-1-30L-14/3										1/2"	14"	1/2"	14"	1 1/2"	F.S.	T&S BRASS FAUCET MODEL# B-0231, LEVER DRAIN, CASTERS	26	
2	27-28	NOT USED	-	-																27-28		
1	29	BAKERS TABLE	ADVANCE TABCO	BST-306R																3-TIER DRAWERS ON RIGHT	29	
1	30	NOT USED	-	-																30		
1	31	WALL MOUNTED SHELF RACK	EAGLE GROUP	SWS1272-16/3																MOUNT AT 4' - 6" A.F.F.	31	
1	32	THREE (3) COMPARTMENT SINK	EAGLE GROUP	CUSTOM																(2) T&S BRASS FAUCET MODEL # B-0231, (3) LEVER DRAINS	32	
1	33	NOT USED	-	-																	33	
1	34	EXHAUST HOOD	CAPTIVE-AIRE	ND-PSP	(2)ABV			20.0 A	120	1	DIRECT									SEE VENTILATION SCHEDULE	34	
1	35	FIRE SUPPRESSION SYSTEM	ANSUL	R-102	ABV															WET CHEMICAL	35	
1	36A	UTILITY DISTRIBUTION SYSTEM	CAPTIVE-AIRE	UDS	ABV			225.0 A	120/208	3	DIRECT	3/4"	ABV.	1"	ABV						36	
1	36B	UTILITY DISTRIBUTION SYSTEM	CAPTIVE-AIRE	UDS	ABV			100.0 A	480	3	DIRECT	3/4"	ABV	1"	ABV						36B	
2	37	CONVECTION OVEN	BLODGETT	MARK V-100 DBL	UDS			51.0 A	480	3	C&P										37	
1	38	ELECTRIC STEAMER	VULCAN	C24EA5-PLUS	UDS			72.0 A	208	1	C&P	3/4"	ABV	3/4"	ABV	1 1/2"	F.S.			BACK FLOW PREVENTION, WATER FILTRATION	38	
1	39	TILTING KETTLE	SOUTHBEND	KECT-12	UDS			57.6 A	208	1	C&P	3/8"	ABV	3/8"	ABV	1 1/2"	F.T.			BACK FLOW PREVENTION, WATER FILTRATION, DOUBLE PANTRY FAUCET	39	
2	40	FLOOR TROUGH	EAGLE GROUP	ASFT-1836-SG																	40	
1	41	CONVECTION STEAMER DBL	VULCAN	C24ET10				94.0 A	208	3	DIRECT					4"	F.T.			DRAIN WATER TEMPERING KIT, BACK FLOW PREVENTION	41	
1	42	BRASSING PAN	SOUTHBEND	BELTS-40	UDS			72.1 A	208	1	C&P	3/8"	ABV	3/8"	ABV	1 1/2"	F.T.			DOUBLE PANTRY FAUCET	42	
1	43	DISHWASHER	HOBART	CH44N-BAS1	64"			55.0 A	208	3	DIRECT	3/4"	64"	3/4"	64"	2"	F.S.			DRAIN WATER TEMPERING KIT	43	
1	43.1	BOOSTER SINK HEATER	HATCO	C-36	18"			100.0 A	208	3	DIRECT	3/4"	14"		1/2"						43.1	
1	43A	PANT LEG VENT HOOD - UNLOAD	HOBART	CUSTOM																SEE VENTILATION SCHEDULE	43A	
1	43B	PANT LEG VENT HOOD - LOAD END	HOBART	CUSTOM																SEE VENTILATION SCHEDULE	43B	
1	44	SOILED DISHTABLE	ADVANCE TABCO	CUSTOM																PRE-RINSE SINK, PRE-RINSE UNIT, SCRAP BASKET, LEVER DRAIN	44	
1	45	CLEAN DISHTABLE	ADVANCE TABCO	CUSTOM																	45	
2	46	SHELVING UNIT	NEXEL	C1836RN																	4-TIER POST 63"H, CASTERS	46
1	47	NOT USED	-	-																	47	
1	48	TRASH CAN	BY OWNER	BY OWNER																	48	
2	49-51	NOT USED	-	-																	49-51	
24	52	SHELVING UNIT	METRO	MQ2448G																	EPOXY COATED, 74"H POST	52
10	53	SHELVING UNIT	METRO	MQ2460G																	EPOXY COATED, 74"H POST	53
2	54	COLD STORAGE ASSEMBLY	BALLY	CUSTOM																	SEE REFRIGERATION SCHEDULE	54
2	55	WORKTABLE	EAGLE GROUP	T3084SE																	(2) DRAWERS 20" x 20" x 5", UNDERSHELF, CASTERS	55
1	56	SHELVING UNIT	METRO	MQ1824G																	EPOXY COATED, 74"H POST	56
2	57	SHELVING UNIT	METRO	MQ1848G																	EPOXY COATED, 74"H POST	57
1	58	WALL MOUNTED SHELF	EAGLE GROUP	WS1284-14/3																	MOUNT AT 4' - 6" A.F.F.	58
1	59	AIR CURTAINFLY FAN	MARS AIR SYSTEMS	LPV248-1UA-OB	ABV.			1/6	2.4 A	120	1	DIRECT									MICROSWITCH AT DOOR	59

REFRIGERATION CONNECTION SCHEDULE

CONN.	EQUIPMENT	LOAD	V/PH	REMARKS
54A	LIGHT, COOLER	300 W	120/1	2 EXTRA LIGHTS
54B	EVAP. COIL, COOLER	2.0 AMPS	120/1	--
54C	COND. UNIT, COOLER	6.6 MCA	208/1	--
54D	LIGHTS, DOOR HEAT	800 W	120/1	4 EXTRA LIGHTS
54E	HEAT TAPE, FREEZER	15 AMPS	120/1	DRAINLINE HEAT TAPE
54F	EVAP. COIL, FREEZER	1.8 AMPS	120/1	FEED DEFROST THRU TIMER @ COND. UNIT
54G	COND. UNIT, FREEZER	19.4 MCA	208/1	

***GAS NOTE:
KITCHEN EQUIPMENT WILL BE PROVIDED WITH GAS PRESSURE REGULATORS DESIGNED TO OPERATE WITH 14" W.C. INCOMING GAS PRESSURE OR LESS. PLUMBER TO PROVIDE INTERMEDIATE REGULATORS, AS REQUIRED TO REDUCE INCOMING BUILDING PRESSURE TO LEVEL SUITABLE FOR EQUIPMENT.

ELECTRICAL LOADS ARE BASED ON MANUFACTURER'S INFORMATION. MINIMUM CIRCUIT AMPACITY AND OVERCURRENT PROTECTION TO BE DETERMINED BY CODE REQUIREMENTS AND/OR MANUFACTURER'S DIRECTIONS.

110° F. HOT WATER REQUIREMENTS

	GPH
MOP SINK	1 @ 5
HAND SINK	2 @ 5
TOTAL	15

140° F. HOT WATER REQUIREMENTS


	GPH
POT SINKS	5 @ 30
HOSE STATION	2 @ 45
CAN WASH	1 @ 10
PREP SINK	2 @ 20
DISHMACHINE	FROM BOOSTER @ 20 PSI
PRE-RINSE SINK	1 @ 35
TOTAL	421

ABBREVIATIONS

ABV.	ABOVE
A.F.F.	ABOVE FINISHED FLOOR
CTR.	COUNTER MOUNTED
C.W.	COLD WATER
E.C.	ELECTRICAL CONTRACTOR
F.D.	FLOOR DRAIN
F.S.	FLOOR SINK
F.S.E.C.	FOOD SERVICE EQUIPMENT CONTRACTOR
G.C.	GENERAL CONTRACTOR
H.W.	HOT WATER
I.W.	INDIRECT WASTE
M.C.	MECHANICAL CONTRACTOR
N.I.K.C.	NOT IN KITCHEN CONTRACT
S/S	STAINLESS STEEL
ST.	STUB
U.C.	UTILITY CHASE
W.	WASTE

VENTILATION CONNECTION SCHEDULE

ITEM	CONNECTION	SIZE	CFM	S.P.	QTY.	TOTAL
43A	EXHAUST	4" x 16"	200	0.25"	1	200
43B	EXHAUST	4" x 16"	400	0.25"	1	400
34A	EXHAUST	16" DIA.	2200	-0.689"		

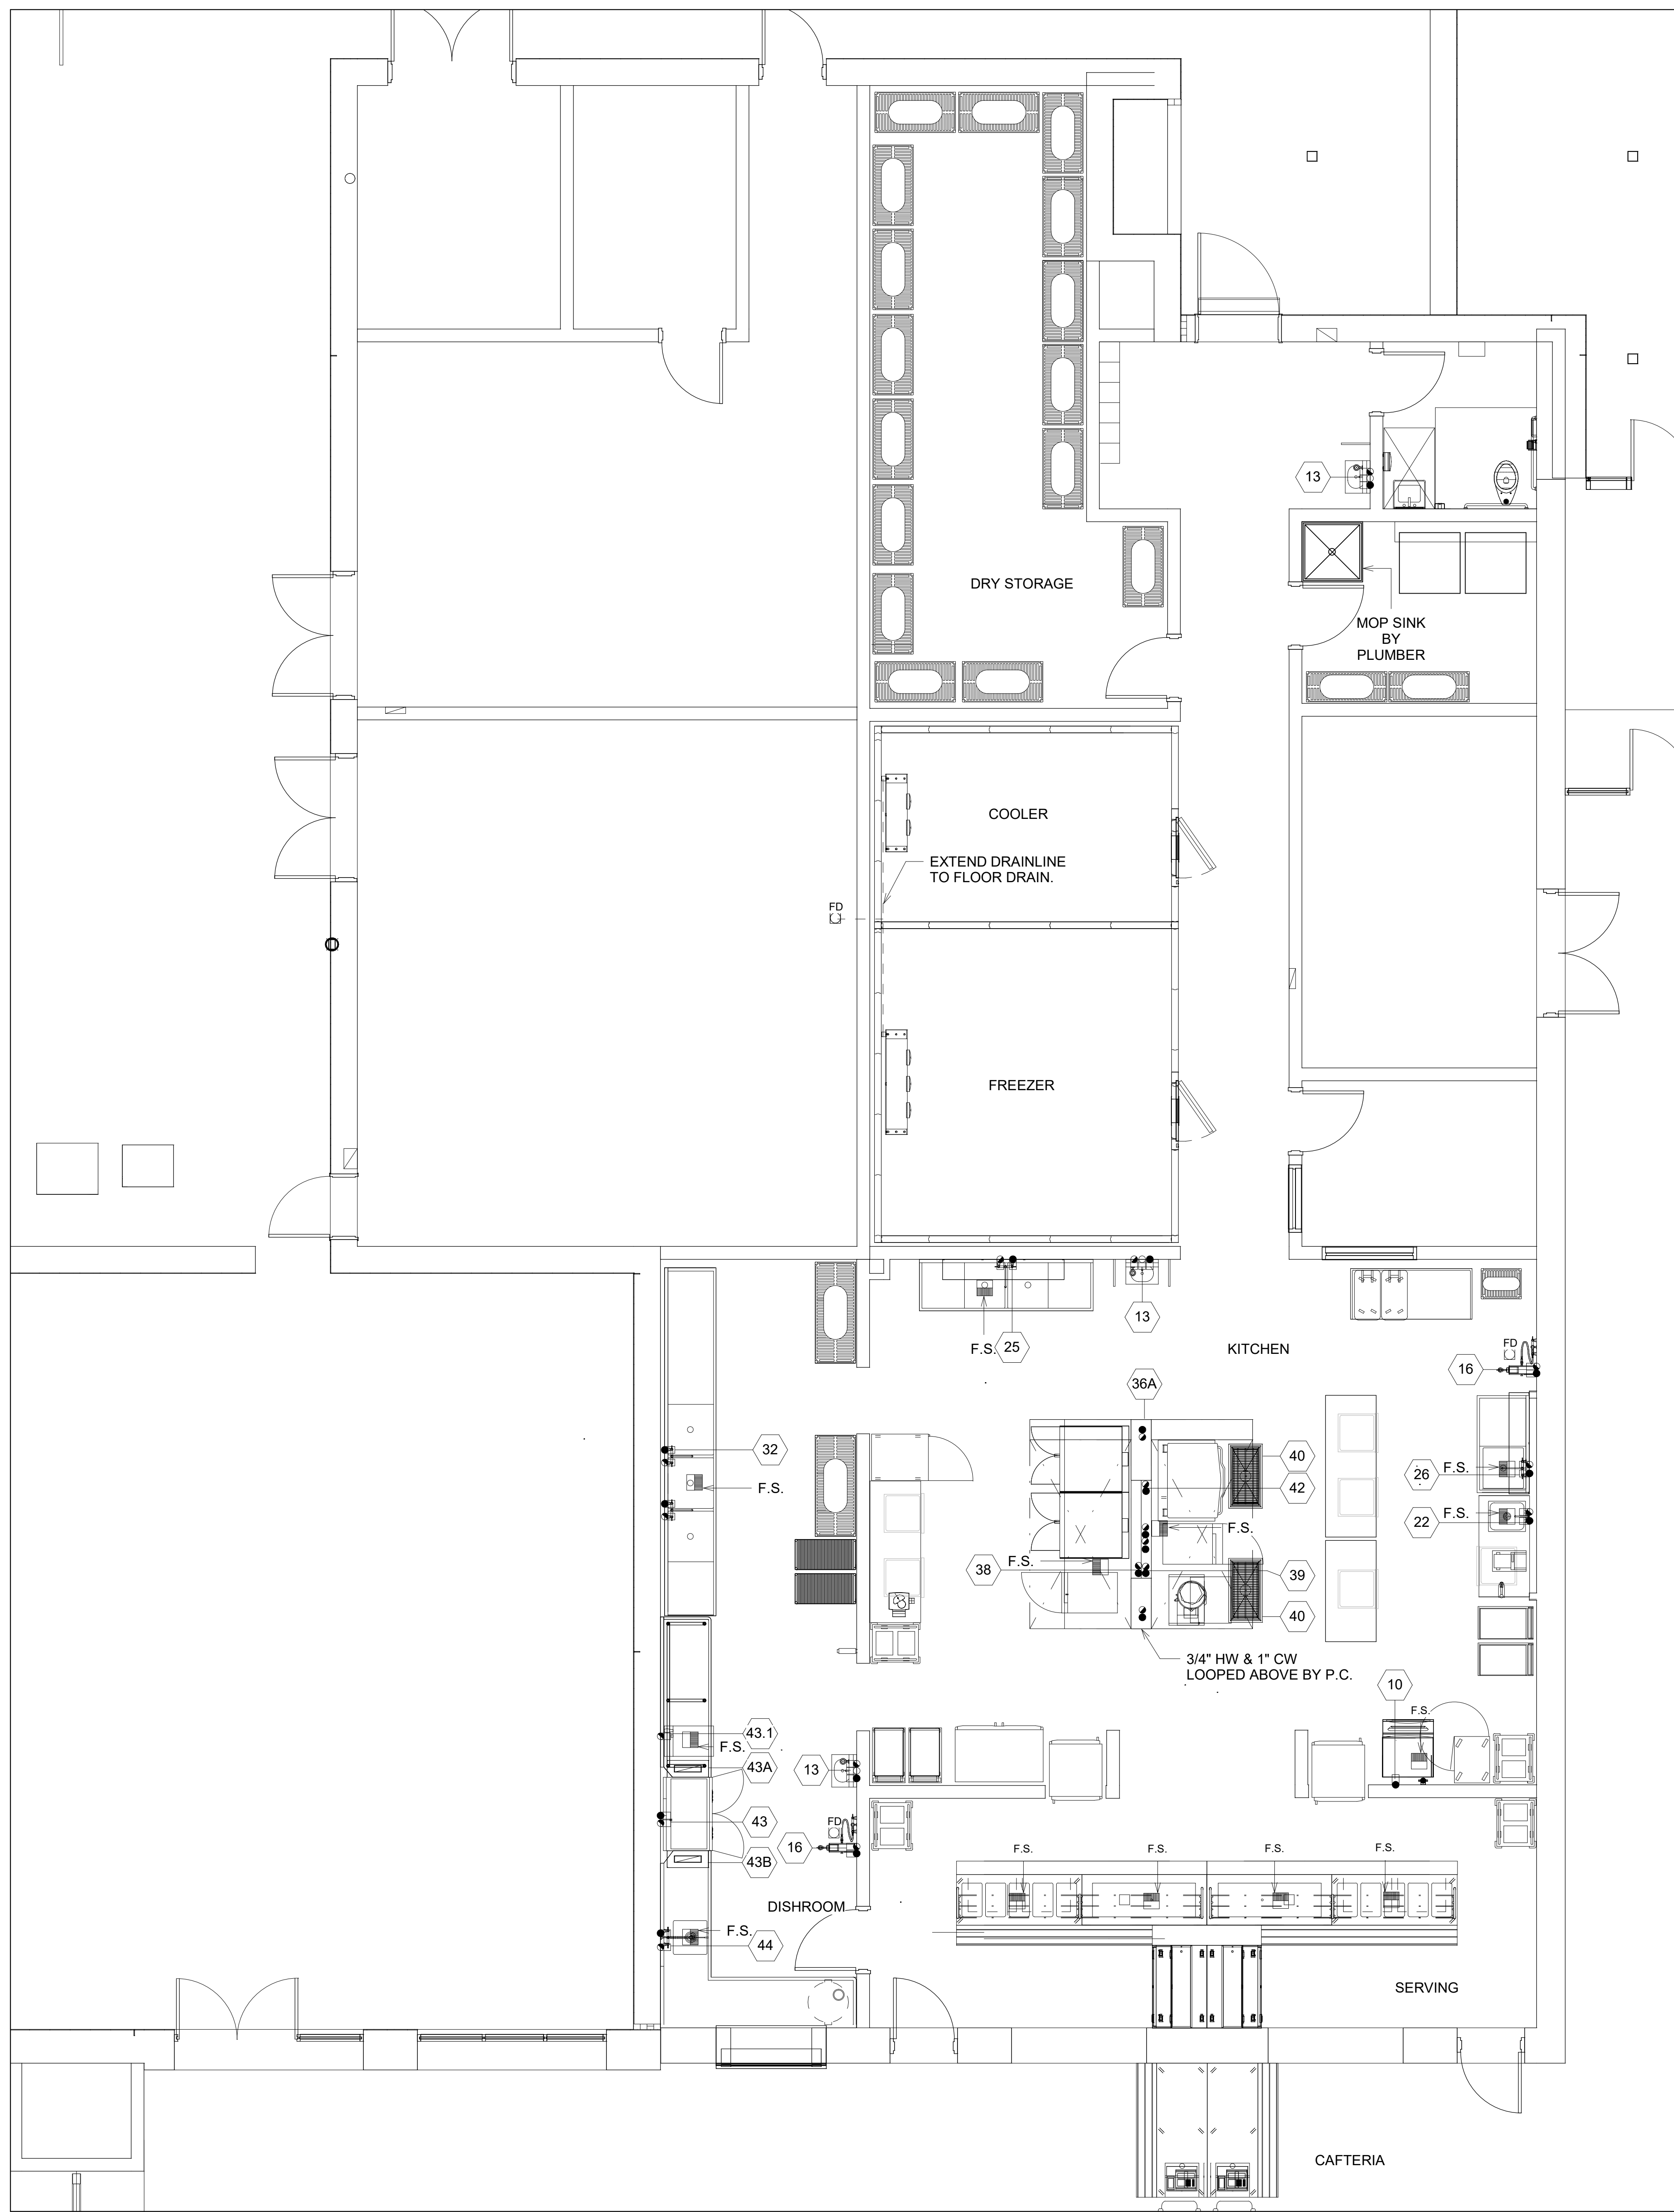

1 FOOD SERVICE PLUMBING PLAN
 FS.03 1/4" = 1'-0"

MECHANICAL SYMBOLS

●	HOT WATER (HW)
●	COLD WATER (CW)
○	WASTE (W)
○	FD FLOOR DRAIN
⊗	FS FLOOR SINK - OPEN
■	FS FLOOR SINK W/HALF GRATE

NOTES
 PLUMBING ROUGHING IN NOTES

THIS PLAN IS INTENDED TO SHOW UTILITY REQUIREMENTS AND APPROXIMATE ROUGHING-IN LOCATIONS ONLY. DO NOT USE FOR ACTUAL ROUGHING-IN. FOR FINAL ROUGHING-IN LOCATIONS SEE DIMENSIONED PLANS PROVIDED BY FOOD SERVICE EQUIPMENT CONTRACTOR.

WHERE EXPOSED PIPES AND CONDUITS ARE NECESSARY THEY SHOULD BE MOUNTED 1 TO 2 INCHES OFF THE WALL AND 6 INCHES OFF THE FLOOR TO ALLOW FOR CLEANING.

PLUMBING NOTES

PLUMBING TRIM SUCH AS FAUCETS AND SINK WASTES SHALL BE FURNISHED WITH EQUIPMENT BY FOOD SERVICE EQUIPMENT CONTRACTOR. PLUMBER TO PROVIDE SERVICE, STOP VALVES, P-TRAPS, ETC., AND MAKE FINAL CONNECTIONS.

COLD STORAGE ASSEMBLY: EVAP. COIL DRAINLINES SHALL BE PROVIDED AND INSTALLED BY FOOD SERVICE EQUIPMENT CONTRACTOR.

BOOSTER HEATER SHALL BE FURNISHED BY FOOD SERVICE EQUIPMENT CONTRACTOR WITH PRESS. REDUCING VALVE TEMP/PRESSURE GAUGE AND SHOCK ABSORBER LOOSE FOR FINAL CONNECTION BY PLUMBER.


HOSE REELS FURNISHED BY FOOD SERVICE EQUIPMENT CONTRACTOR WITH VACUUM BREAKER, MIXING VALVE, SHUT-OFF VALVE, CHECK VALVES, TEMPERED WATER PIPING AND FLANGES. PLUMBER TO PROVIDE SUPPLY LINES AND MAKE FINAL CONNS. (SEE HOSE REEL DETAIL.)

S/S UTILITY CHASE FURNISHED BY FOOD SERVICE EQUIPMENT CONTRACTOR WITH WATER MANIFOLDS. PLUMBER TO MAKE FINAL CONNECTION TO HOSE.


MECHANICAL NOTES

EXHAUST HOOD SHALL BE FURNISHED BY FOOD SERVICE EQUIPMENT CONTRACTOR WITH CONNECTION COLLARS ON TOP. H.V.A.C. CONTRACTOR TO PROVIDE EXHAUST FAN, BUILDING DUCTWORK AND MAKE FINAL CONNECTIONS.


DISHMACHINE SHALL BE FURNISHED BY FOOD SERVICE EQUIPMENT CONTRACTOR WITH VENT COWLS AND STAINLESS STEEL DUCTS TO CEILING, READY FOR FINAL CONNECTIONS BY H.V.A.C. CONTRACTOR.

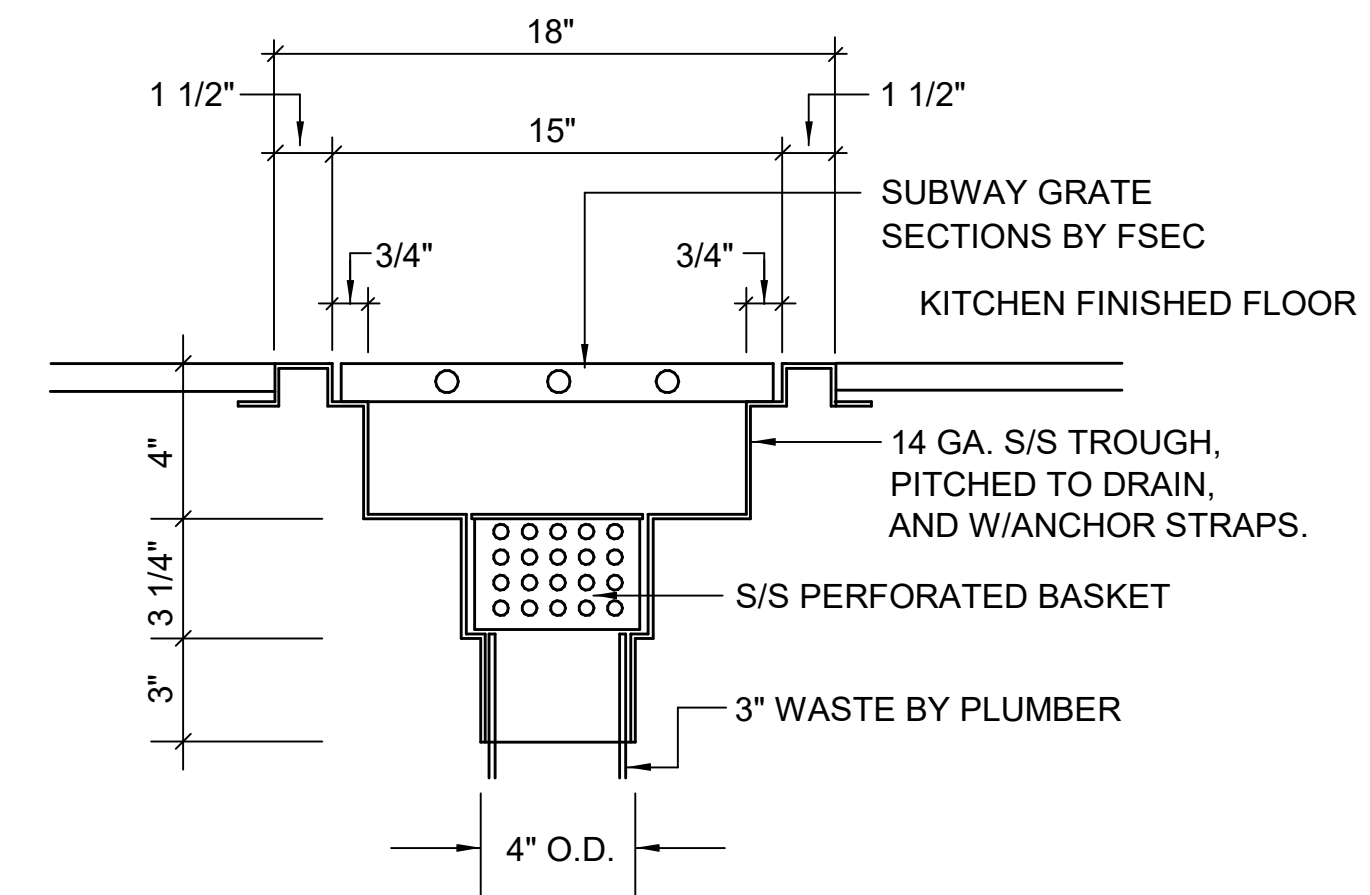

2 FLOOR TROUGH 12" x 18" DETAIL
 FS.03 NO SCALE

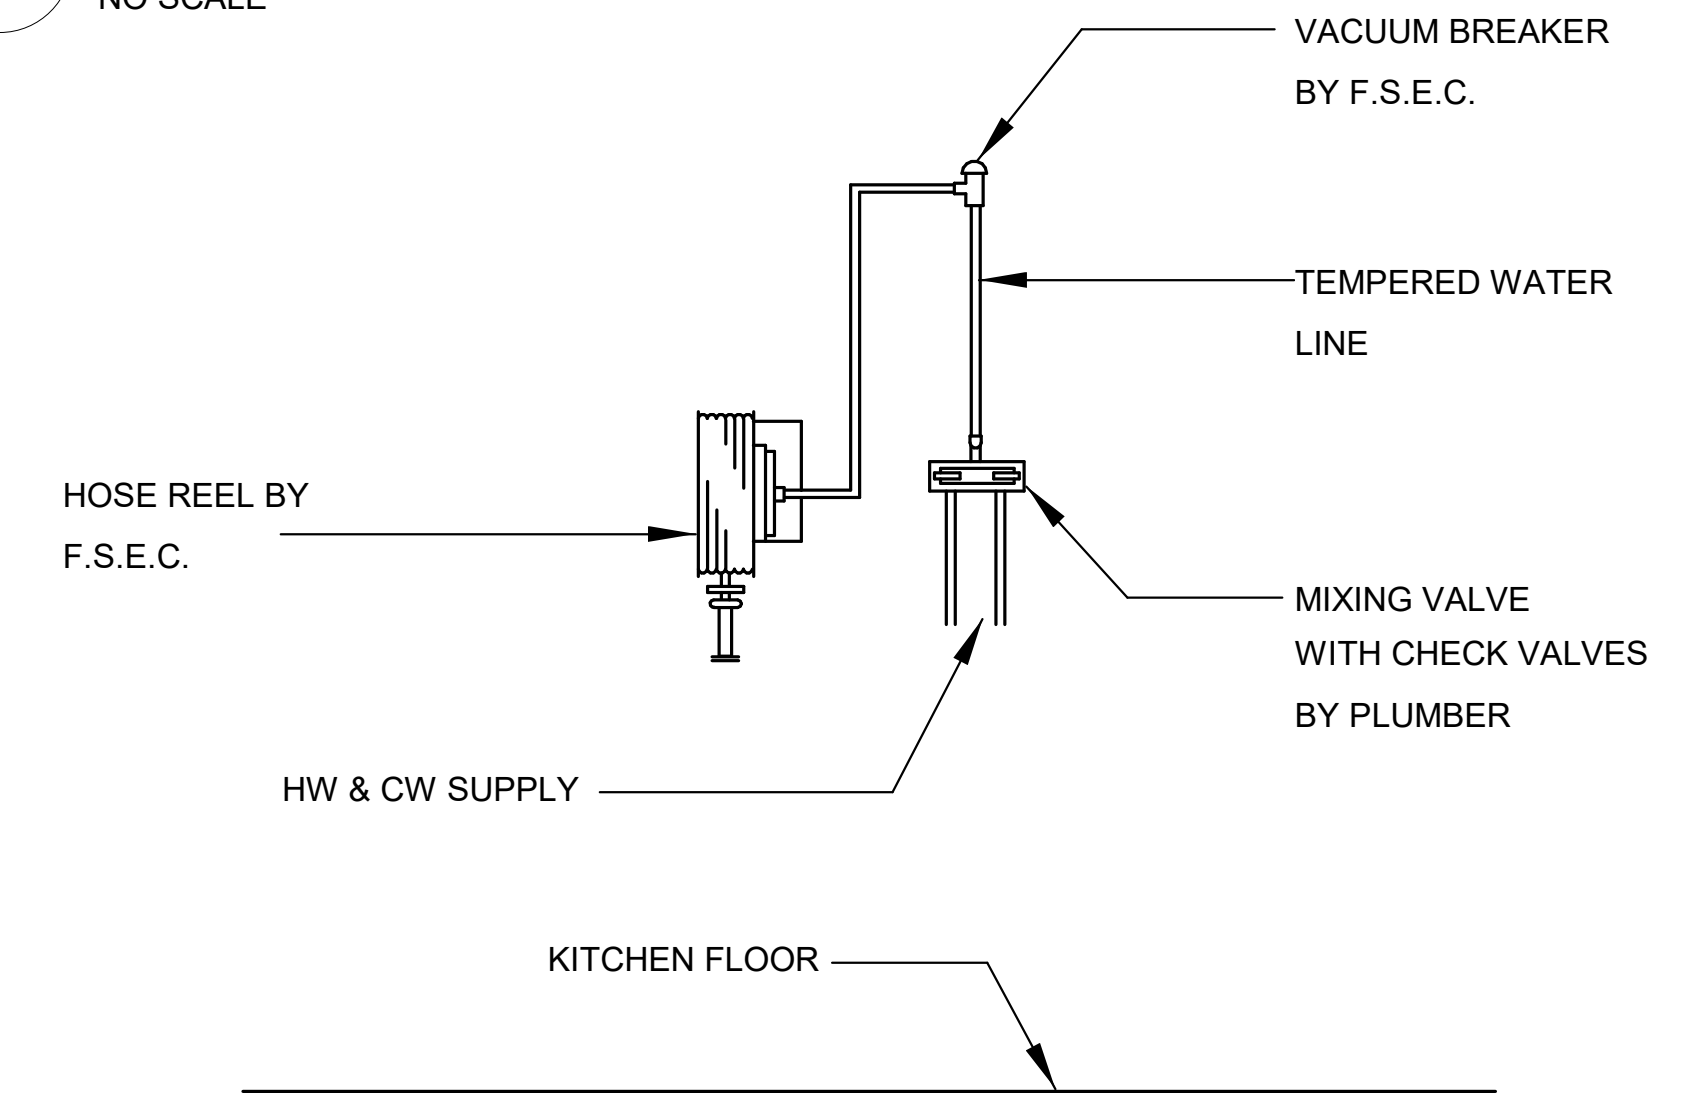


3 HOSE REEL DETAIL
 FS.03 NO SCALE

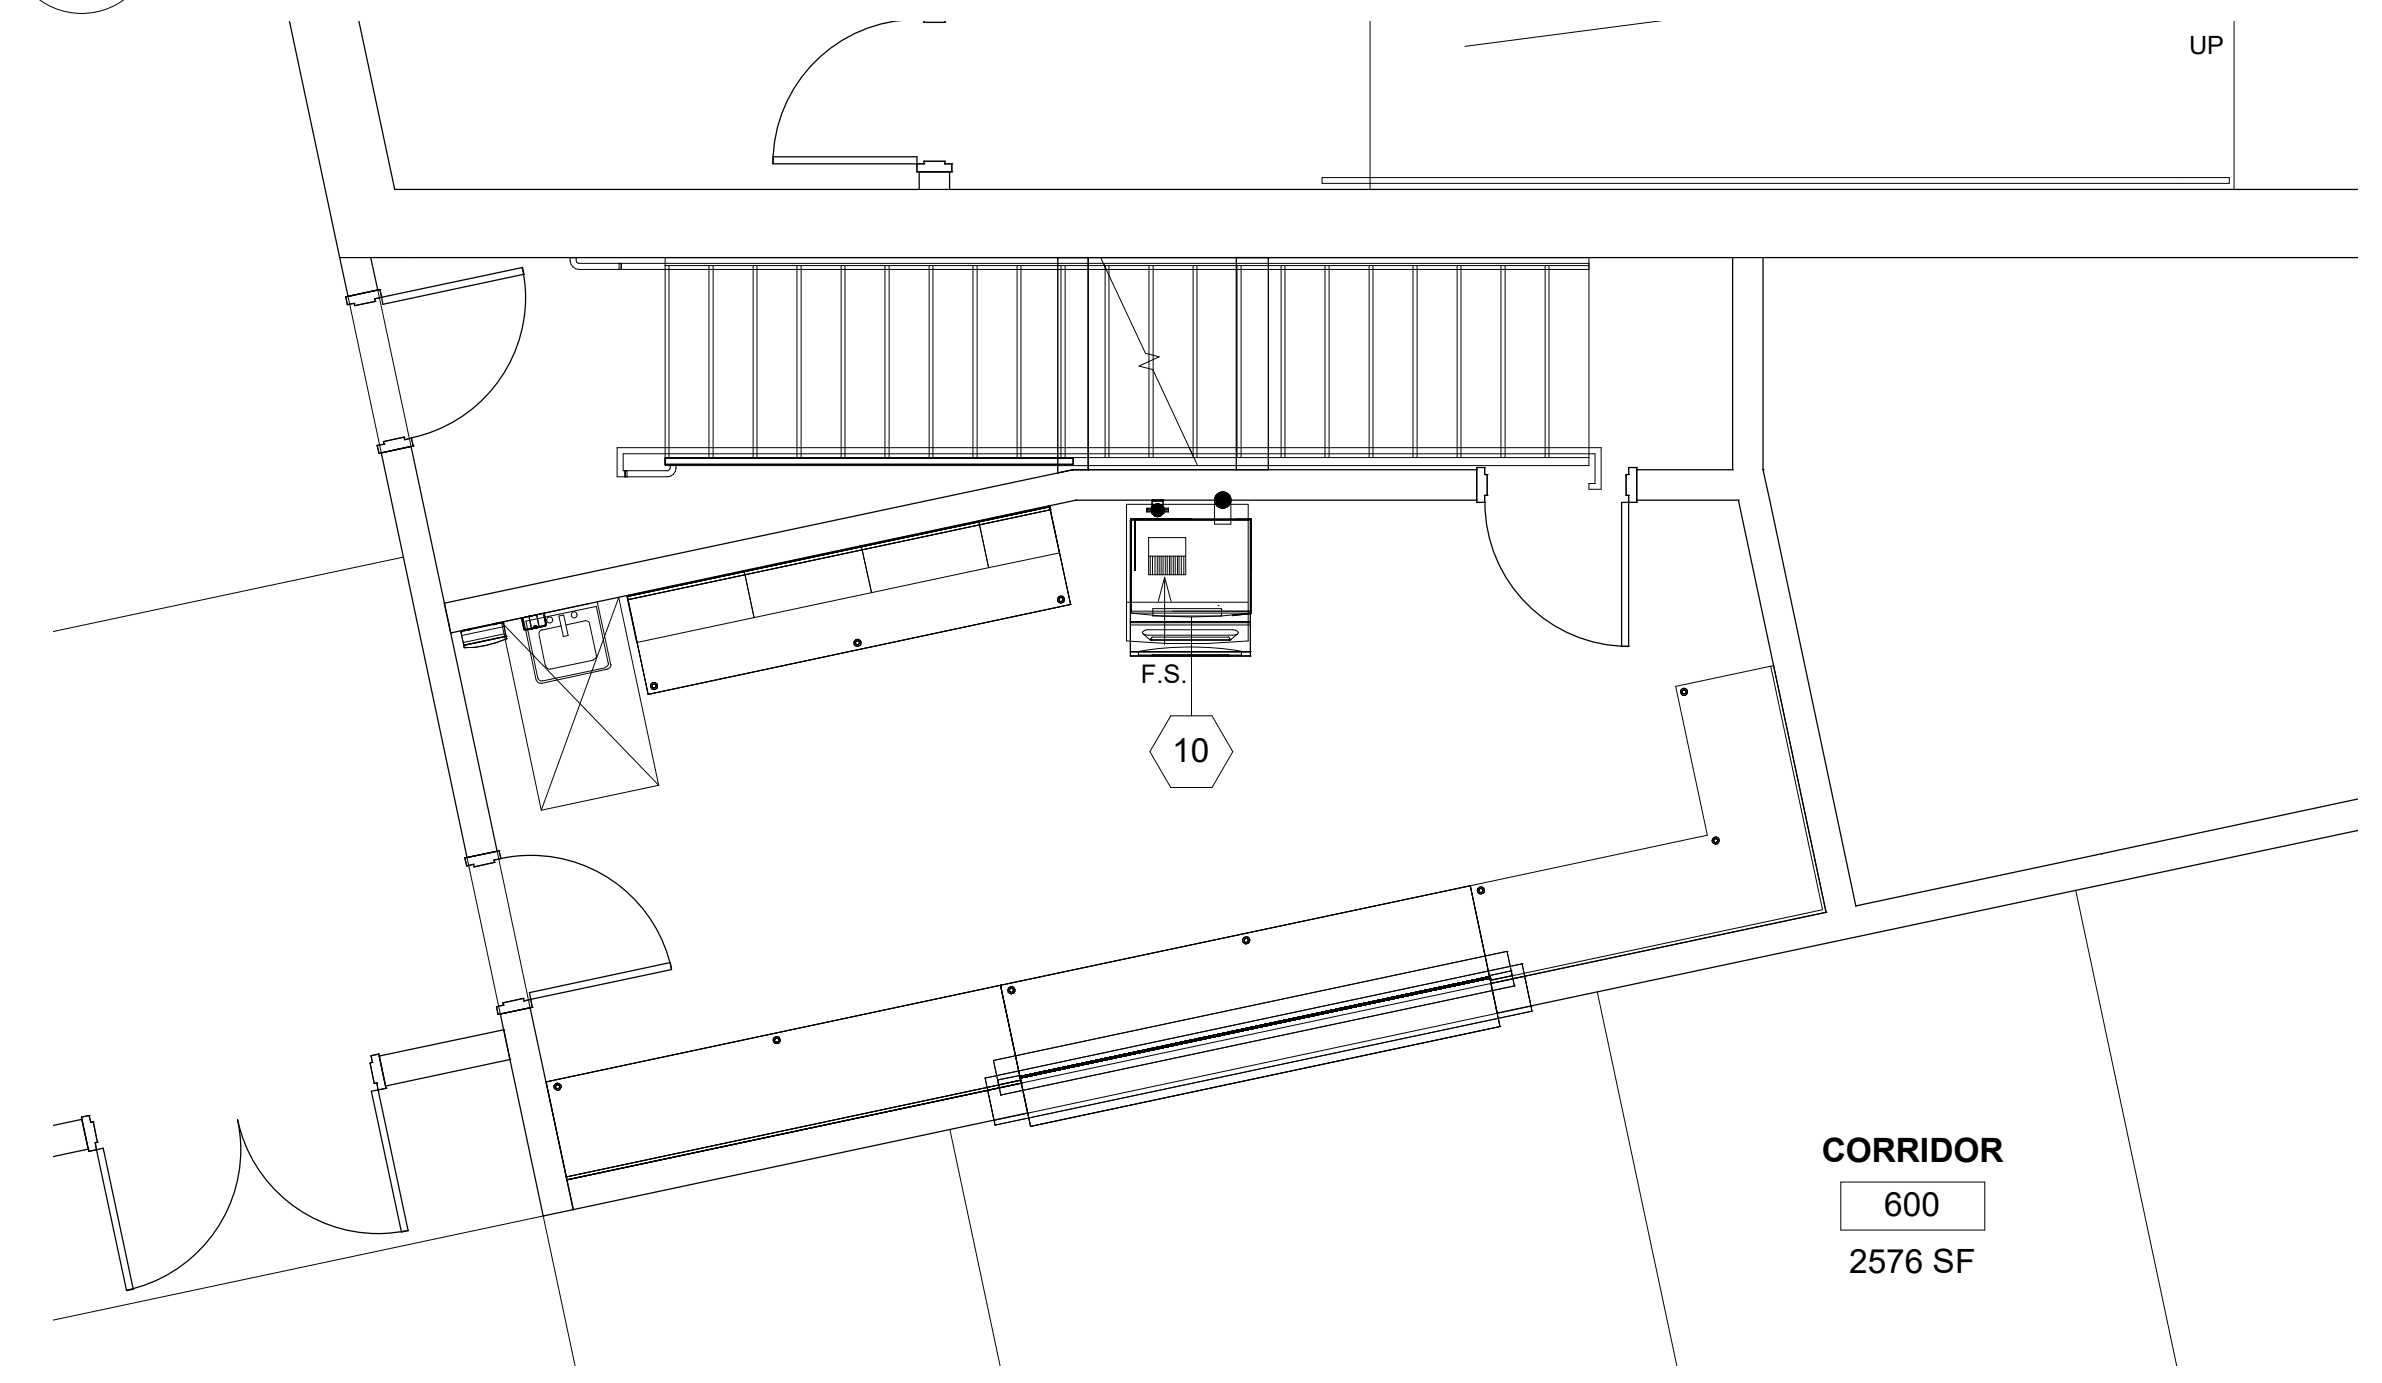

4 FOOD SERVICE PLUMBING PLAN - CONCESSION
 FS.03 1/4" = 1'-0"



T 919 781 8582
 4600 Lake Boone Trail
 Suite 205
 Raleigh, NC 27607
 info@smithsinnett.com

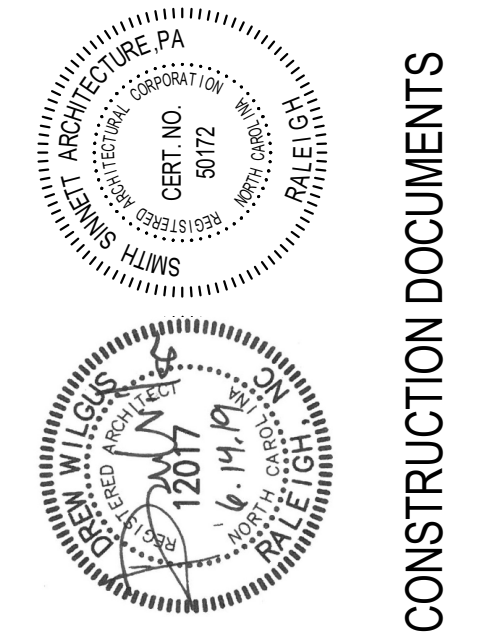

VOLUME I

The drawings on this sheet show a preliminary design and are not to be used for construction. The user of this drawing is responsible for the accuracy of the information shown. Any reproduction of the drawings without the written consent of Smith Sinnett Architecture, P.A. is prohibited. All rights are reserved. The drawings are the property of Smith Sinnett Architecture, P.A. and shall remain the property of Smith Sinnett Architecture, P.A. until the completion of the project.

**NEW TRINITY MIDDLE SCHOOL
 RANDOLPH COUNTY SCHOOL SYSTEM**
 Parcel PIN 7708118367
 Surratt Drive
 Trinity, NC 27370

KEY PLAN
 NO SCALE



ID	DATE	DESCRIPTION
DRAWN BY:		JA
CHECKED BY:		KM

FOOD SERVICE PLUMBING PLAN

2017032 21 MAY 2019

FS.03

C:\Users\Owner\Desktop\FOODESIGN PROJECTS\TRINITY MIDDLEBIO SET\17032_Trimly Middle_FS_019019rev1.rvt
 5/16/2019 11:52:50 AM

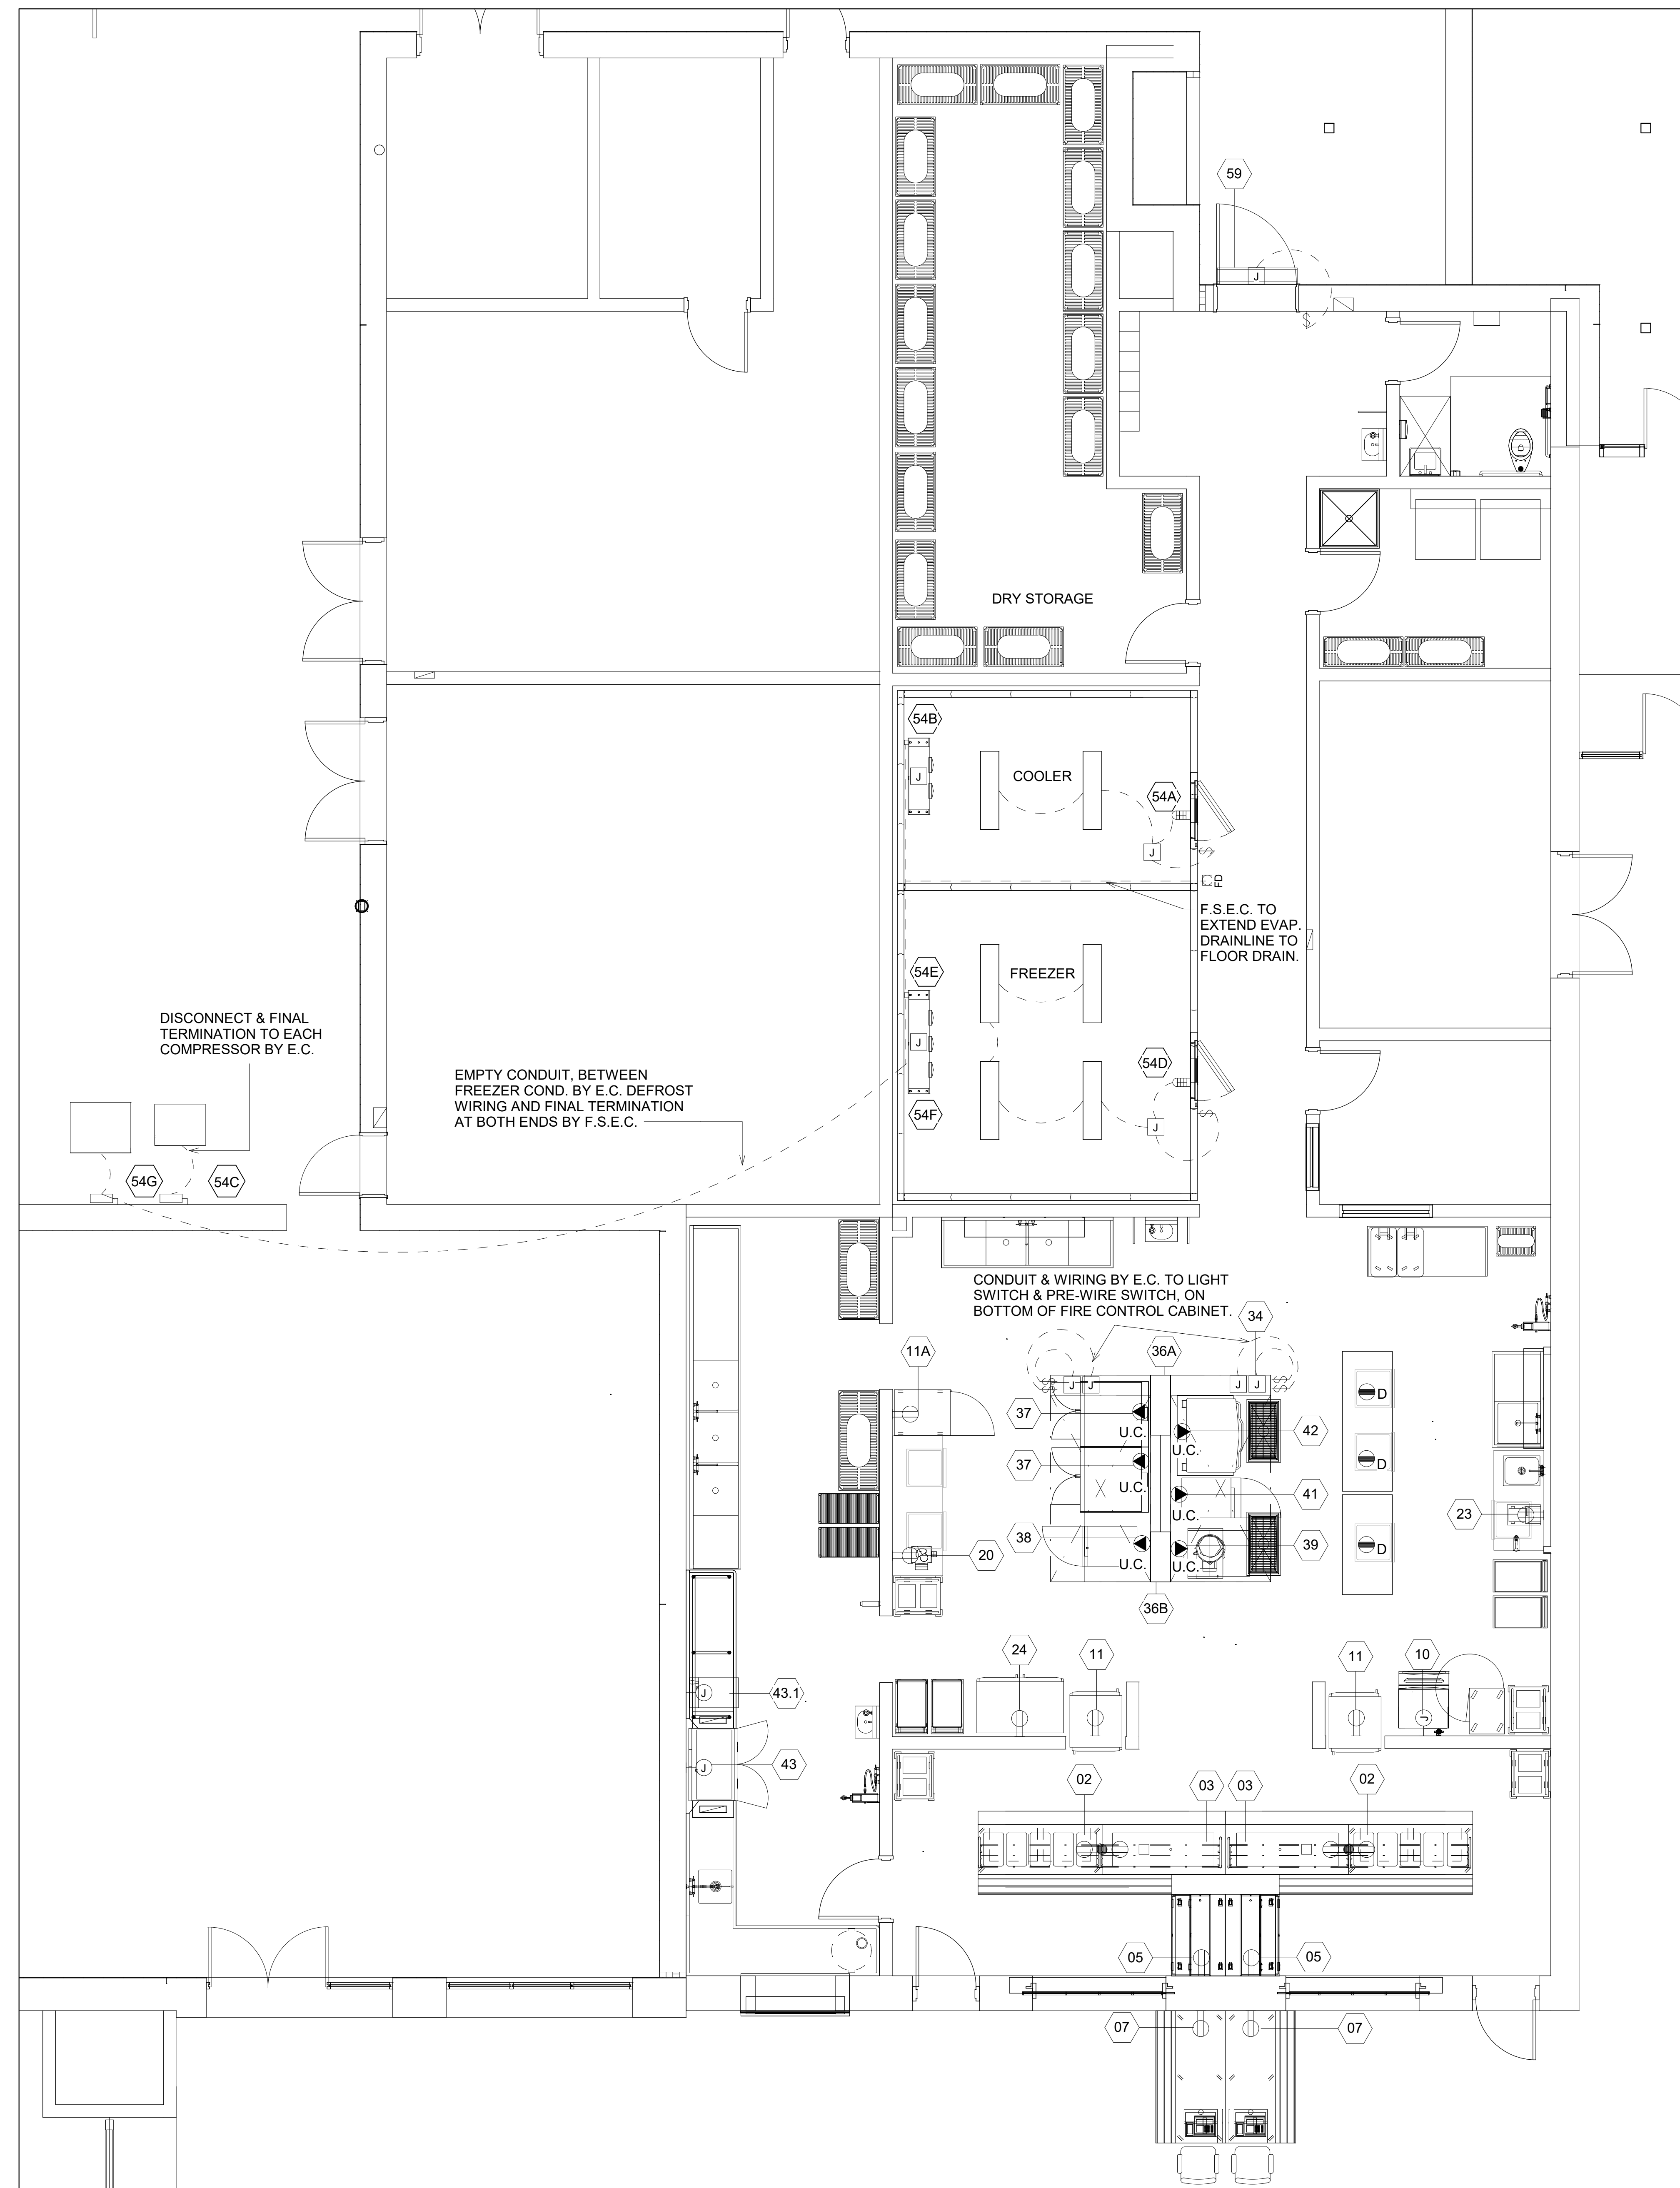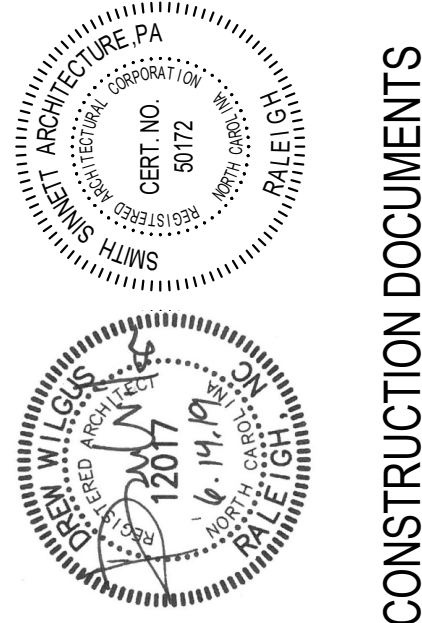

ELECTRICAL SYMBOLS

	J-BOX, FLUSH IN WALL
	J-BOX FROM ABOVE
	WATERPROOF CONDUIT STUB
	DUPLEX OUTLET
	UTILITY CHASE MOUNTED OUTLET
	CONVENIENCE OUTLET, UNASSIGNED
	FLOOR MOUNTED OUTLET BY E.C.
	SPECIAL OUTLET TO MATCH EQUIPMENT
	OUTLET WITH DROP CORD FROM ABOVE

NOTES

ELECTRICAL ROUGHING IN NOTES

THIS PLAN IS INTENDED TO SHOW UTILITY REQUIREMENTS AND APPROXIMATE ROUGHING-IN LOCATIONS ONLY. DO NOT USE FOR ACTUAL ROUGHING IN. FOR FINAL ROUGH-IN LOCATIONS SEE DIMENSIONED PLANS PROVIDED BY FOOD SERVICE EQUIPMENT CONTRACTOR.

WHERE EXPOSED PIPES AND CONDUITS ARE NECESSARY, THEY SHOULD BE MOUNTED 1 TO 2 INCHES OFF THE WALL AND 6 INCHES OFF THE FLOOR TO ALLOW FOR CLEANING.

ELECTRICAL NOTES

DISHMACHINE SHALL BE FURNISHED BY FOOD SERVICE EQUIPMENT CONTRACTOR, PRE-WIRED TO INTEGRAL CONTROL PANEL READY FOR FINAL CONNECTION BY ELECTRICAL CONTRACTOR. COLD STORAGE ROOMS SHALL BE FURNISHED BY FOOD SERVICE EQUIPMENT CONTRACTOR WITH PRE-WIRED LIGHT AND SWITCH AT DOOR PANEL. ELECTRICAL CONTRACTOR TO PROVIDE INTERCONNECTING WIRING TO EXTRA LIGHT FIXTURES AND MAKE FINAL CONNECTIONS.


REFRIGERATION SYSTEMS SHALL BE FURNISHED AND INSTALLED BY FOOD SERVICE EQUIPMENT CONTRACTOR, INCLUDING DEFROST WIRING BETWEEN COND. UNIT AND EVAP. COIL. FINAL POWER DROPS AND DISCONNECTS FOR COND. UNITS AND EVAP. COILS SHALL BE BY ELECTRICAL CONTRACTOR.

EXHAUST HOODS FURNISHED BY FOOD SERVICE EQUIPMENT CONTRACTOR WITH LIGHT FIXTURES AND EMPTY CONDUIT TO J-BOX. ELECTRICAL CONTRACTOR TO INTERCONNECT TO LIGHT SWITCH IN FRONT OF HOOD.

EXHAUST HOOD FURNISHED WITH FAN PREWIRE PACKAGE. ELECTRICAL CONTRACTOR TO INTERCONNECT TO SWITCH IN FRONT OF HOOD.


S/S UTILITY CHASE SHALL BE FURNISHED BY FOOD SERVICE EQUIPMENT CONTRACTOR WITH RECEPTABLES MOUNTED AND CORD & PLUG SET LOOSE. ELECTRICAL CONTRACTOR TO EXTEND WIRING TO EACH RECEPTABLE ON RACEWAY AND CONNECT. ELECTRICAL CONTRACTOR TO CONNECT CORD & PLUG SETS TO EQUIPMENT.

FIRE CONTROL SYSTEM FURNISHED BY FOOD SERVICE EQUIPMENT CONTRACTOR WITH APPLIANCE SHUT-OFF FEATURE. ELECTRICAL CONTRACTOR TO INTERCONNECT TO SHUNT TRIPS PER MANUFACTURERS DIAGRAM, SO AS TO SHUT OFF ALL EQUIPMENT UNDER HOODS WHEN ACTUATED.

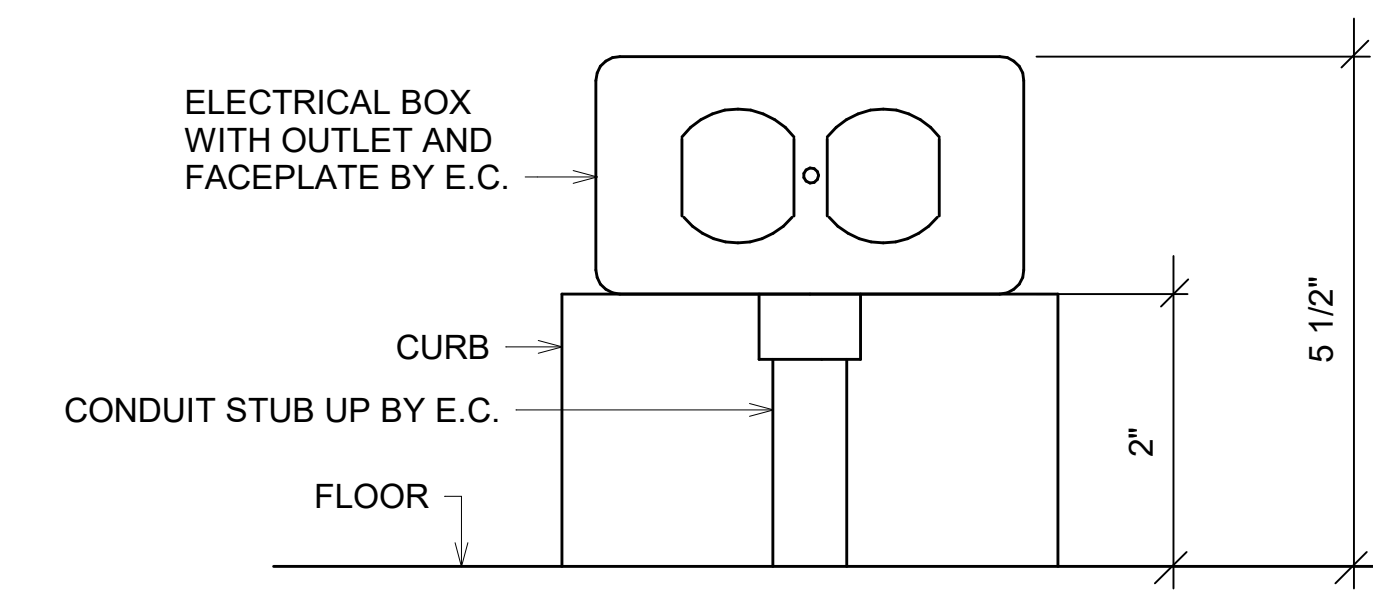

2 TOMBSTONE RECEPTACLE

FS.04 NO SCALE

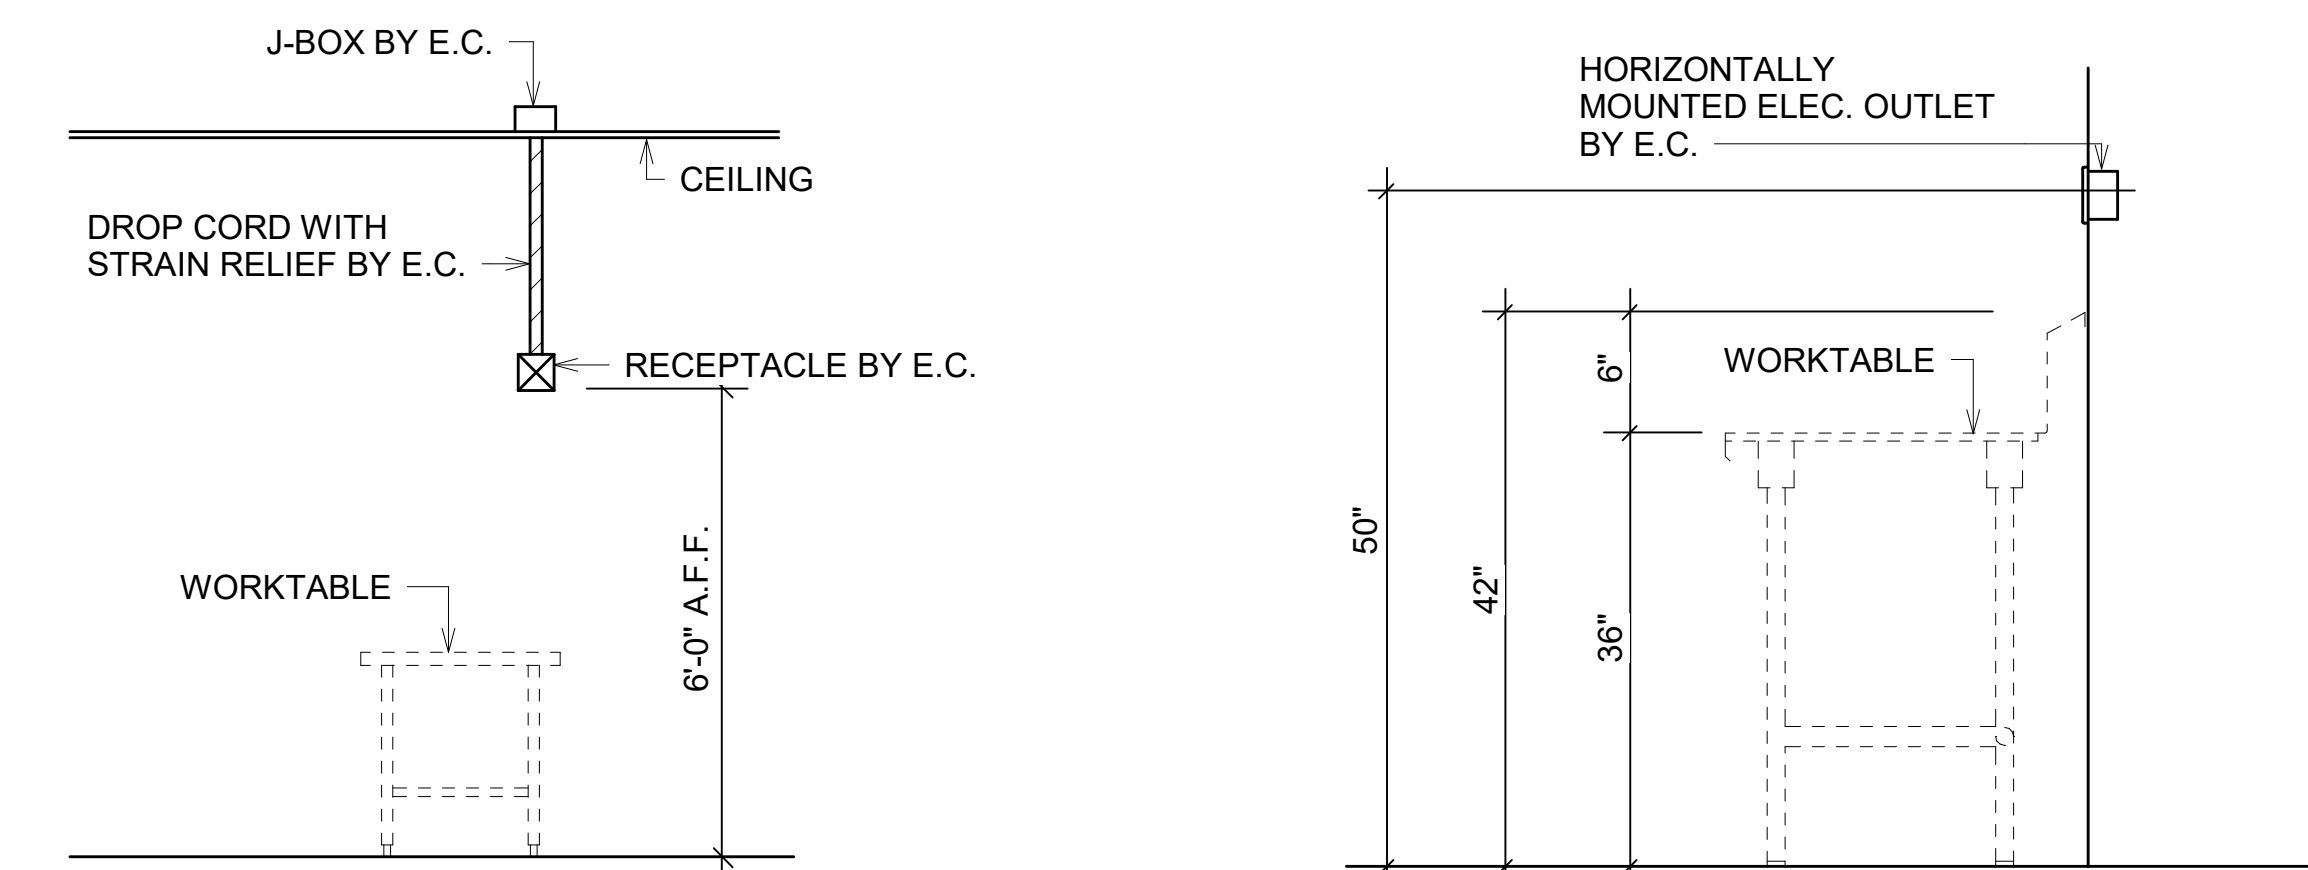


3 CEILING-MOUNTED RECEPTACLE

FS.04 NO SCALE

4 TYP. UNASSIGNED WALL OUTLET DETAIL

FS.04 NO SCALE

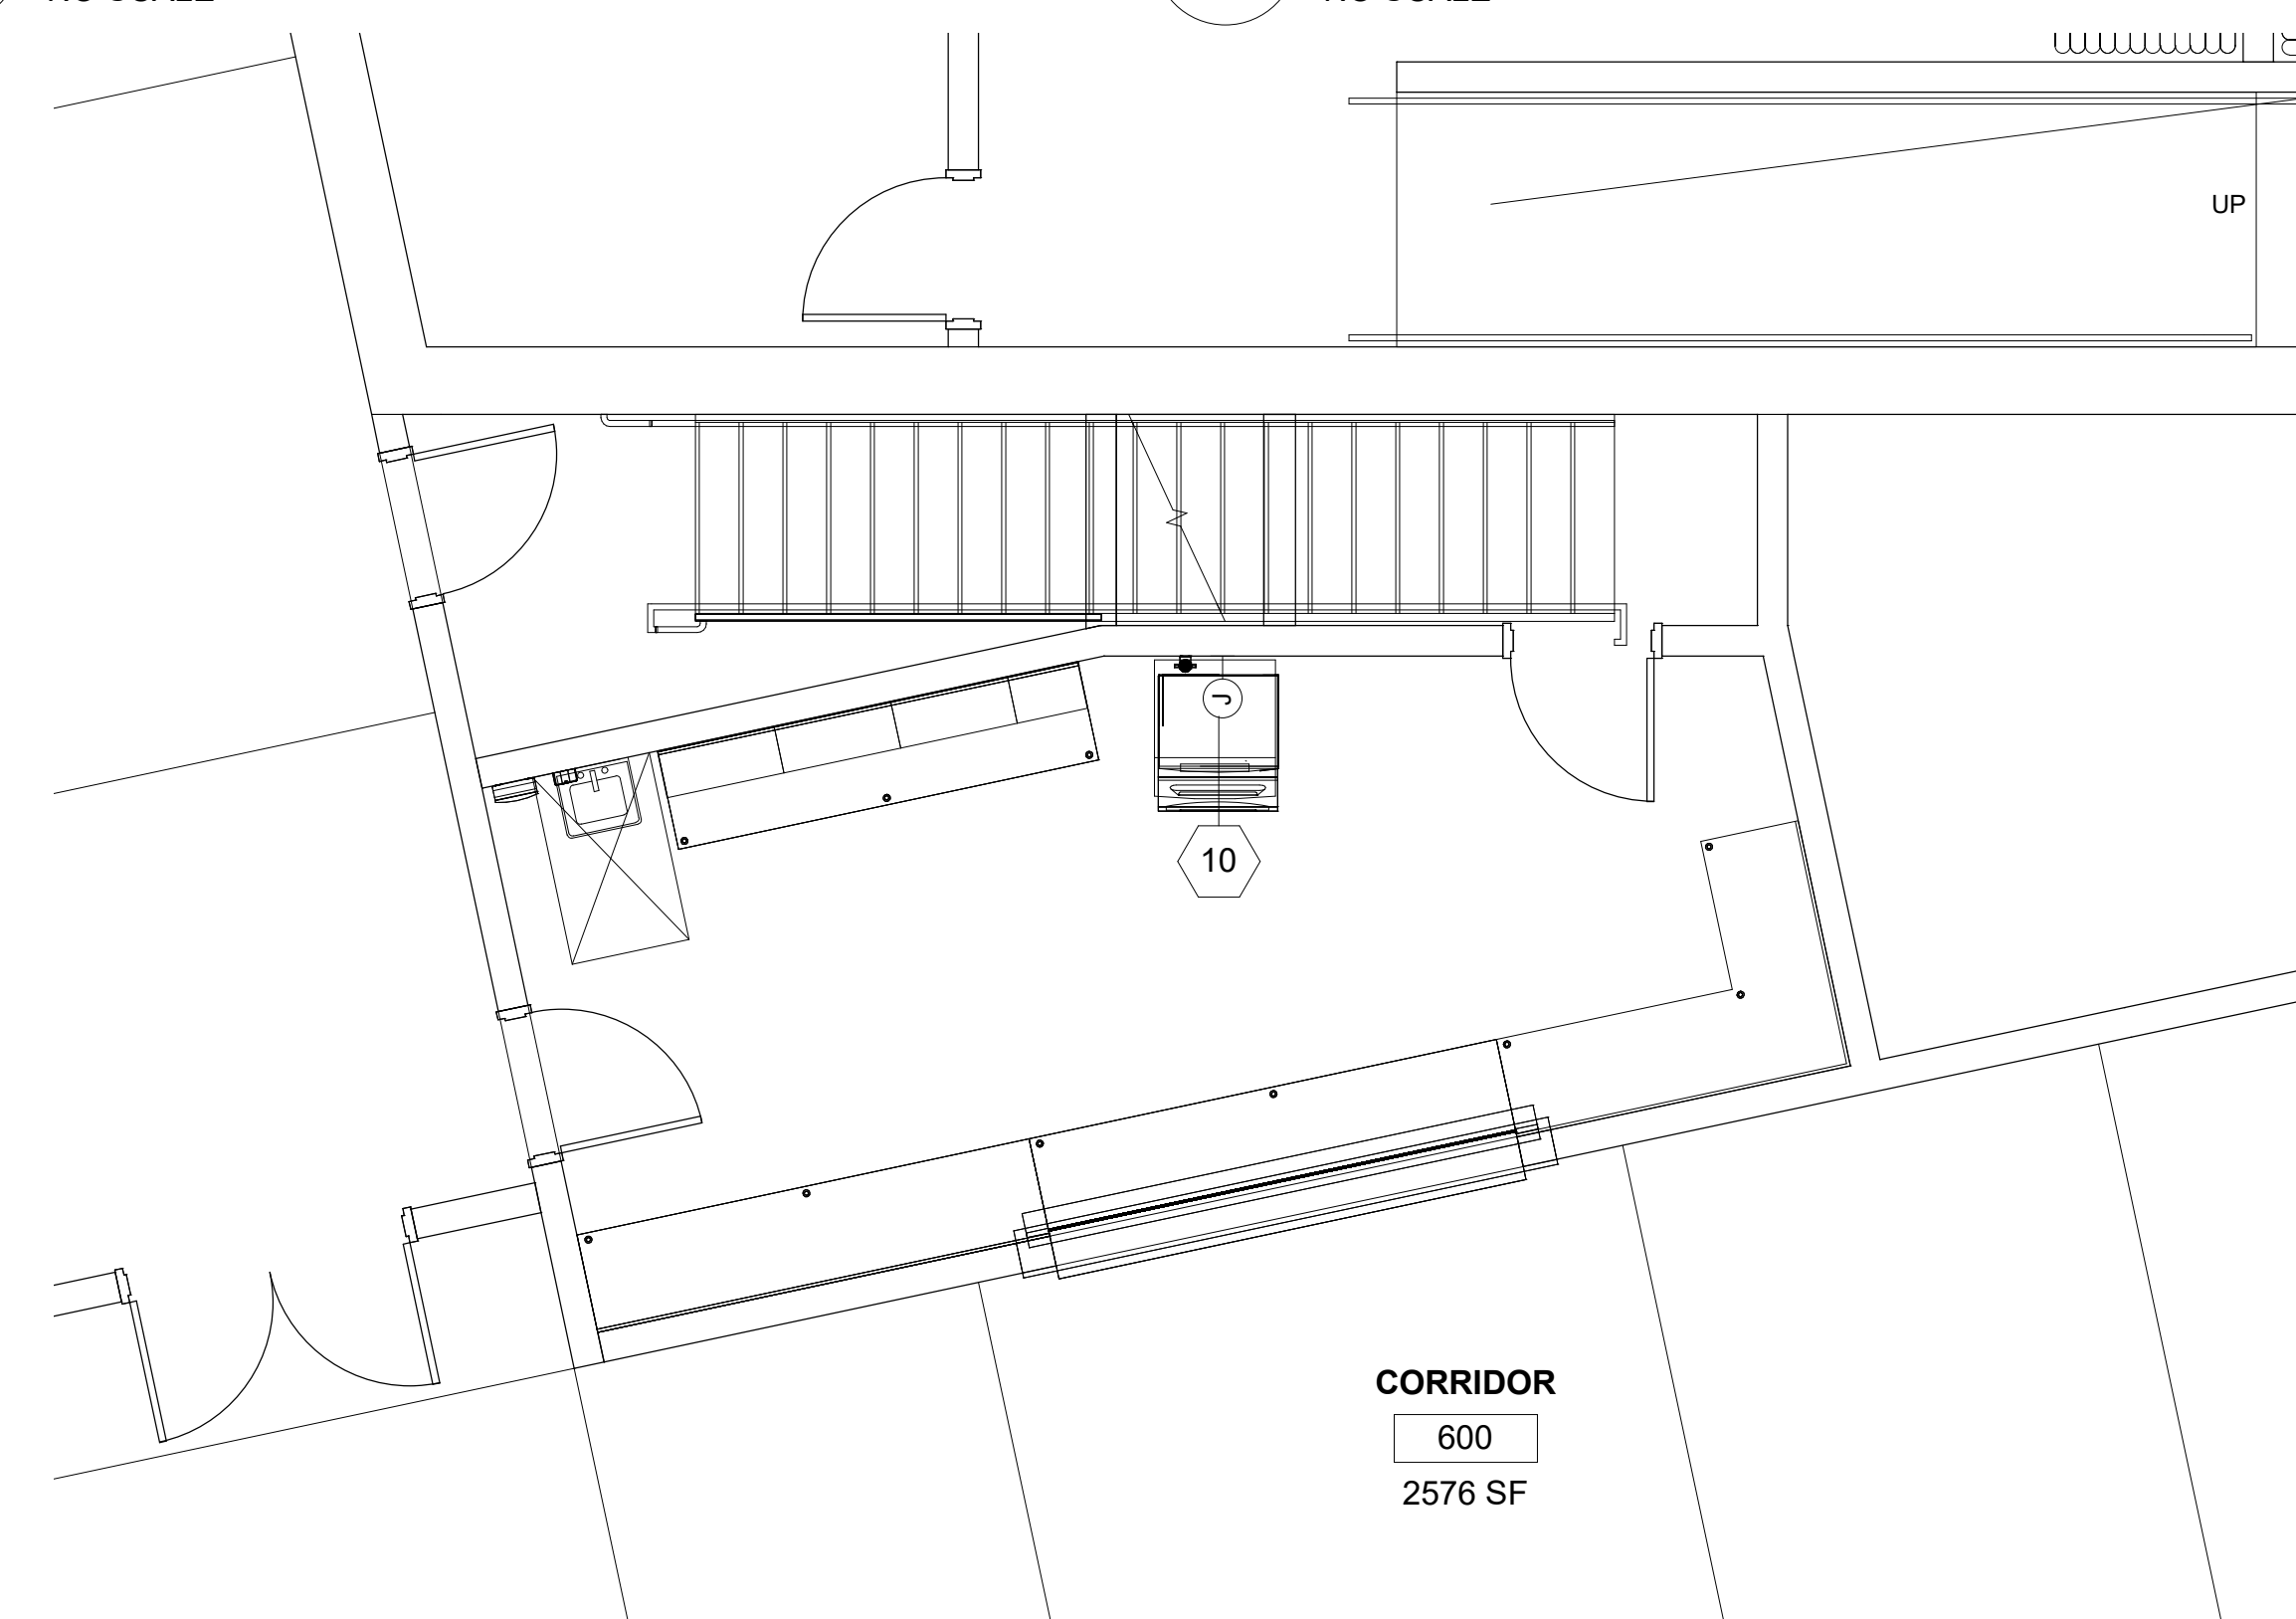

5 FOOD SERVICE ELECTRICAL - CONCESSION

FS.04 1/4" = 1'-0"



1 FOOD SERVICE ELECTRICAL PLAN

FS.04 1/4" = 1'-0"


KEY PLAN
NO SCALE

ID	DATE	DESCRIPTION
DRAWN BY:	JA	
CHECKED BY:	KM	


FOOD SERVICE
ELECTRICAL PLAN

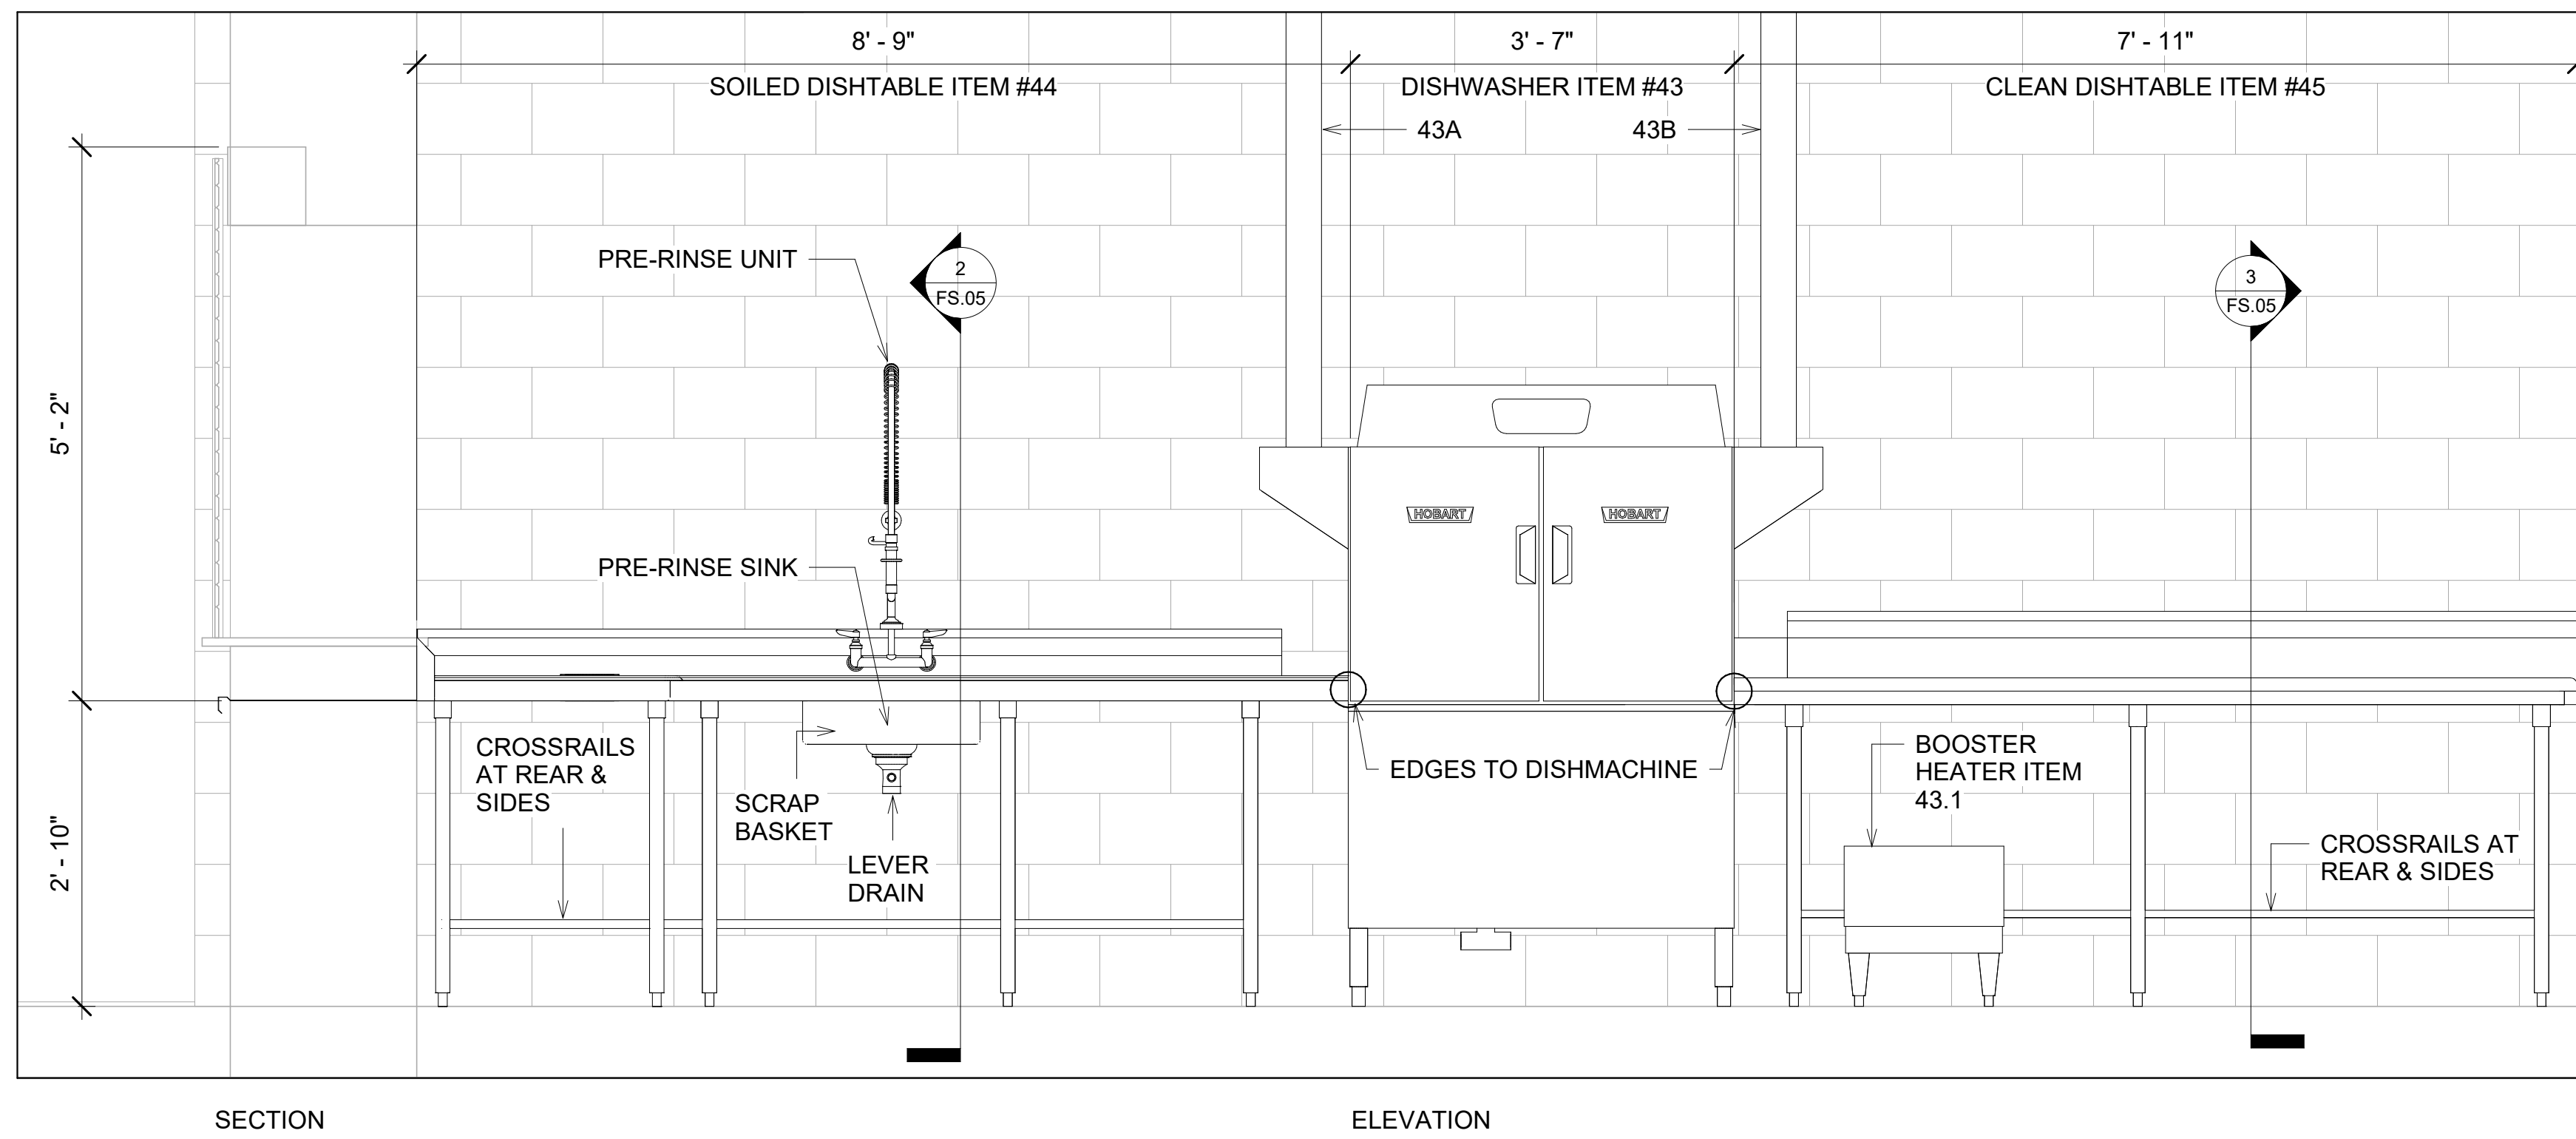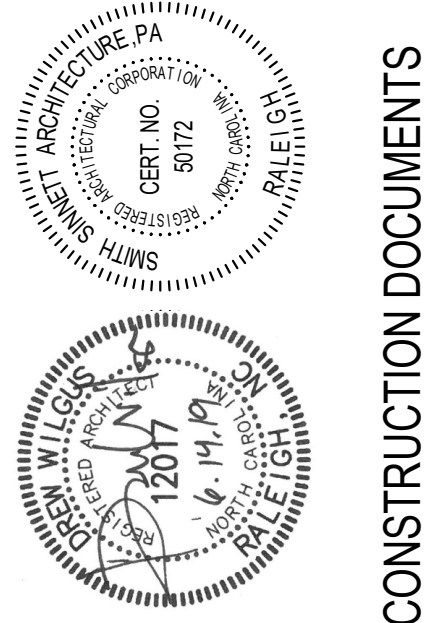


1 DISHTABLE ASSEMBLY DETAIL
3/4" = 1'-0"

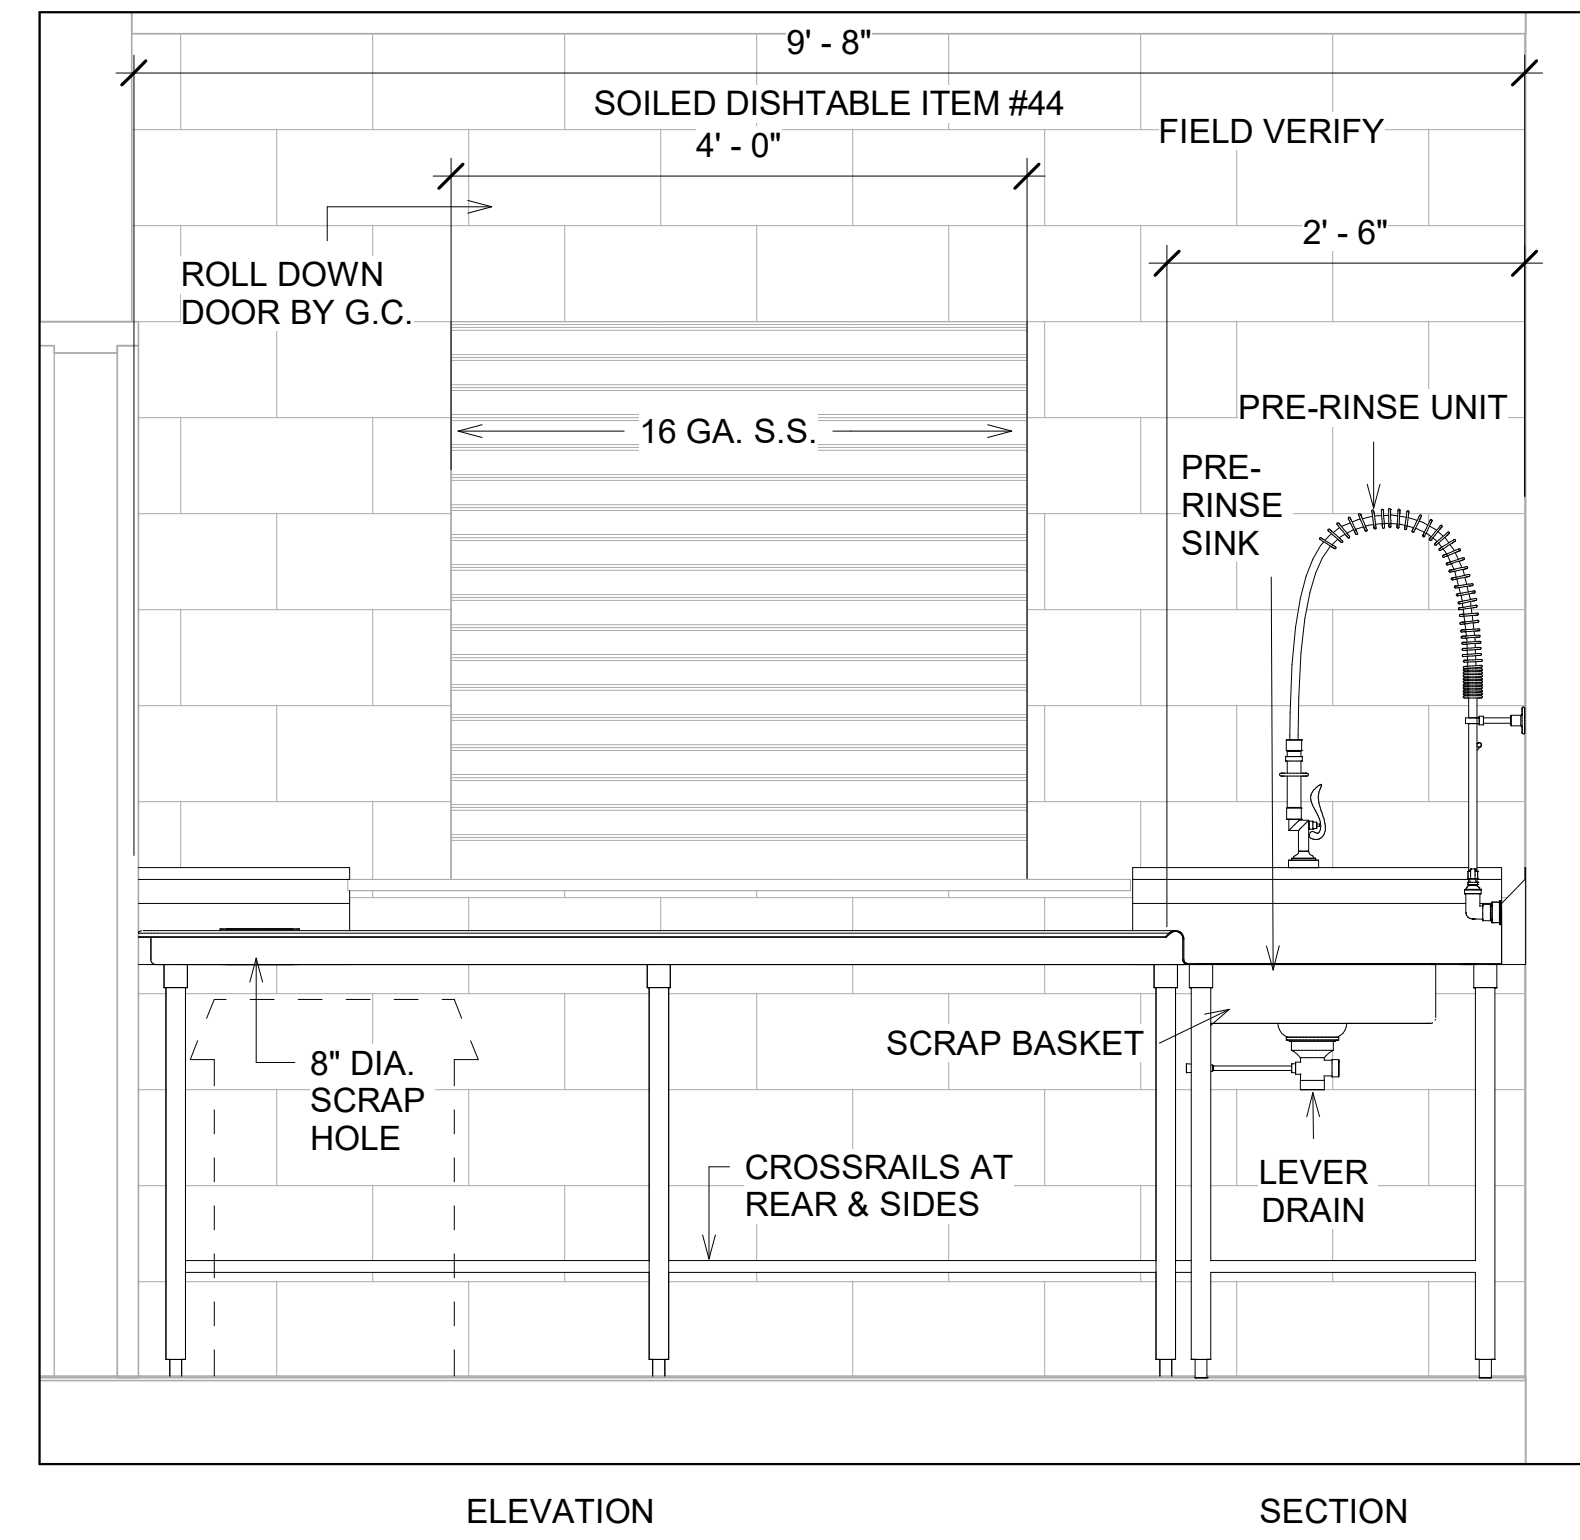


2 SOILED DISHTABLE DETAIL
3/4" = 1'-0"

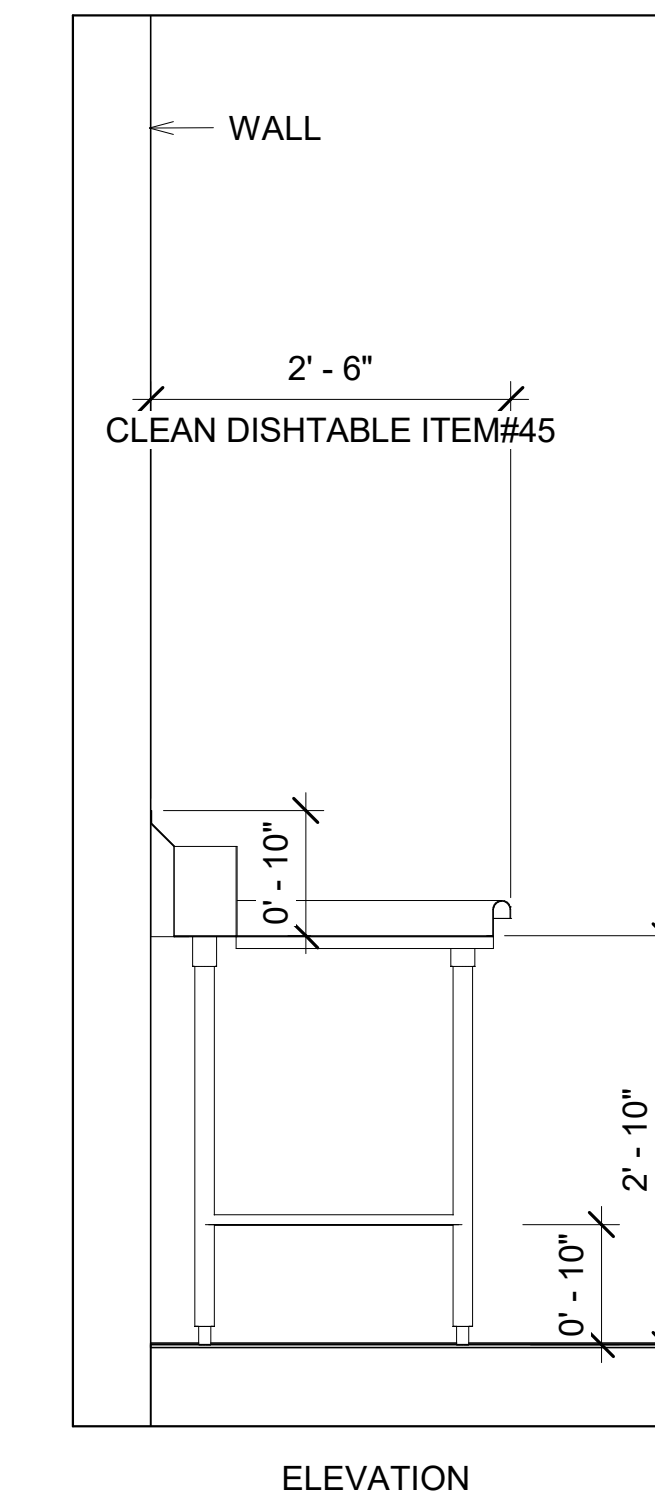


3 CLEAN DISHTABLE DETAIL
3/4" = 1'-0"

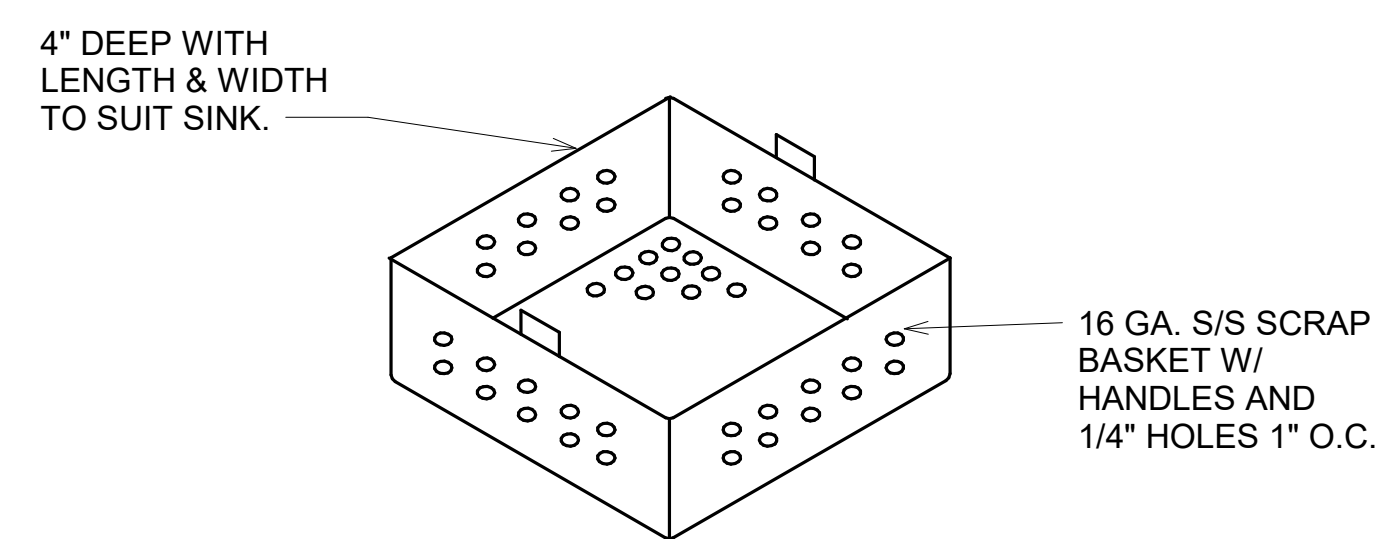


4 SCRAP BASKET DETAIL
NO SCALE

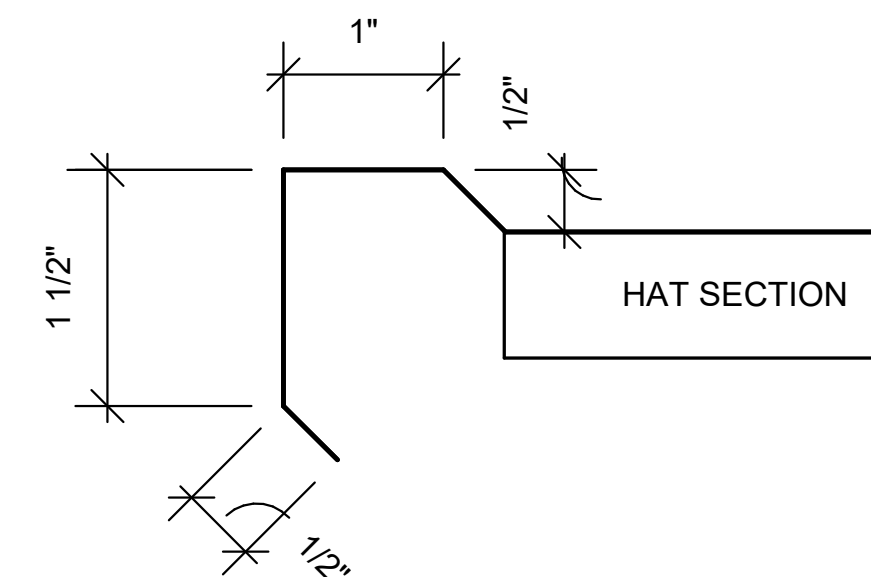


5 NON-SPILL
NO SCALE

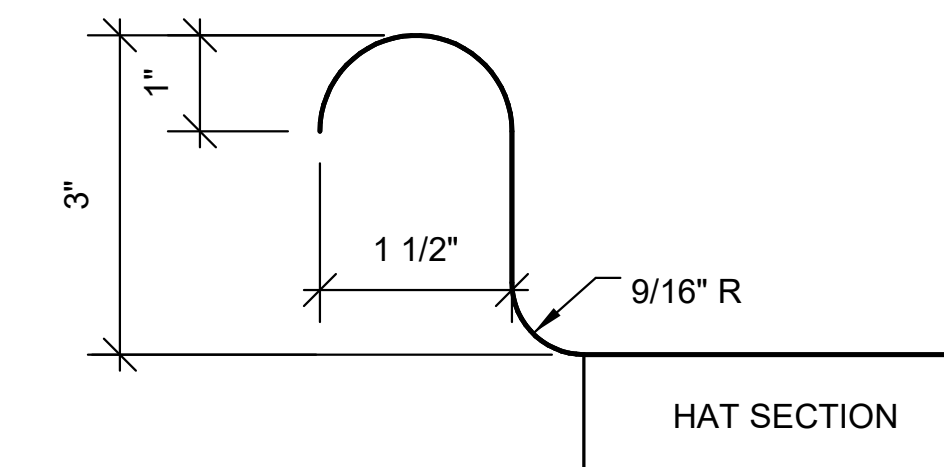


6 ROLLED RIM
NO SCALE

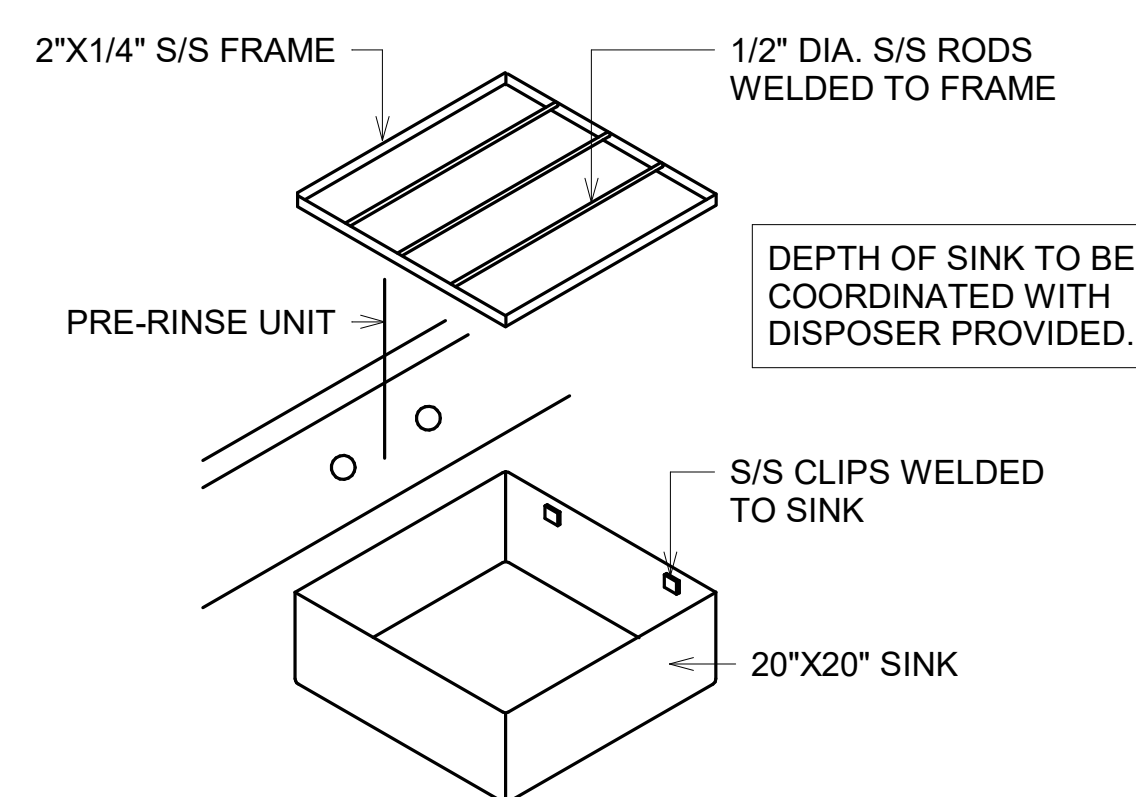


7 PRE-RISE SINK DETAIL
NO SCALE

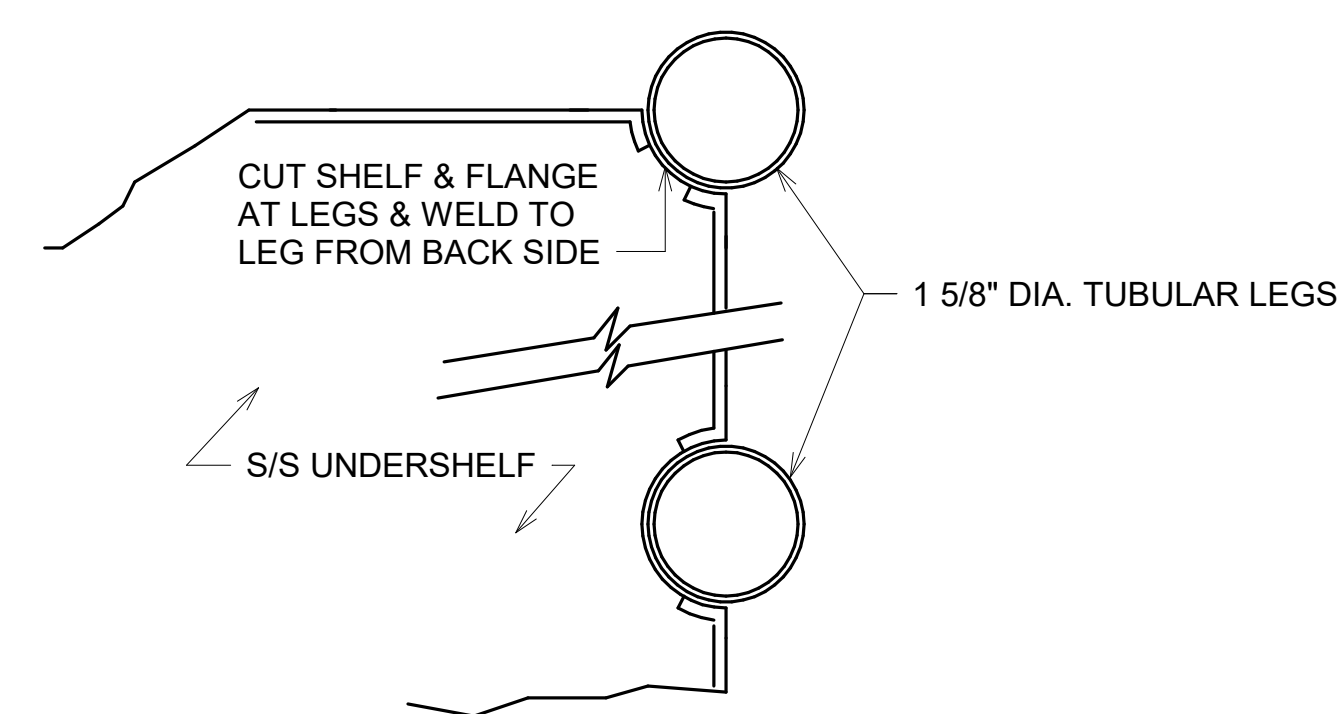


8 PIPE LEG UNDERSHELF
NO SCALE

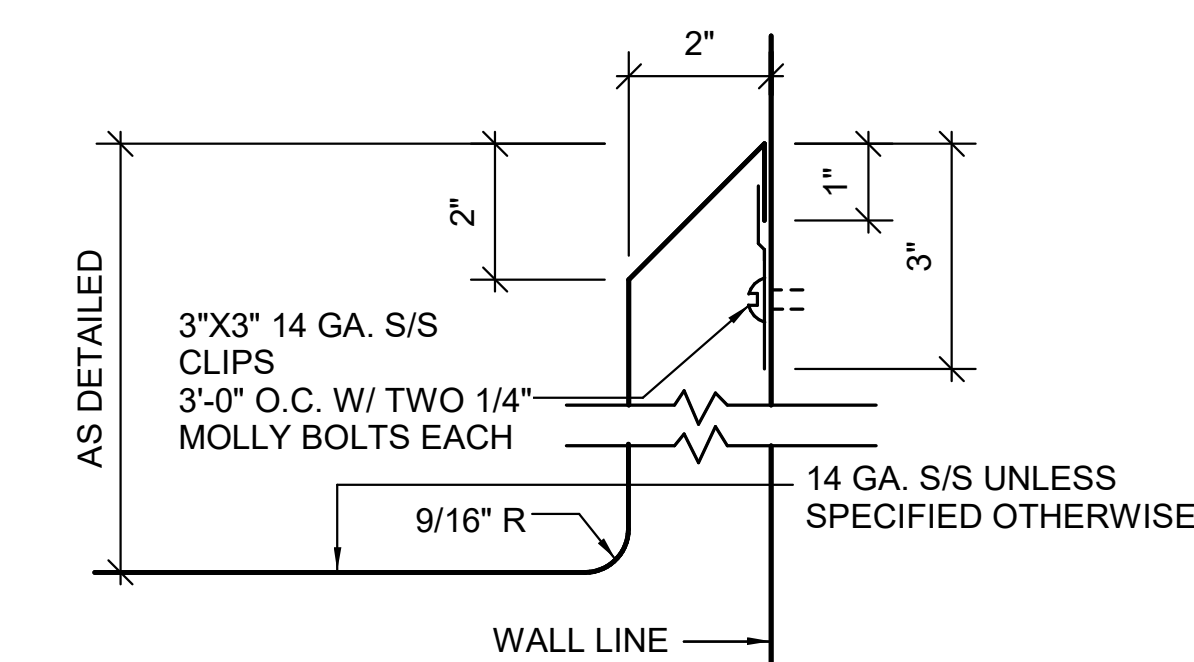

9 BACKSPLASH DETAIL
NO SCALE

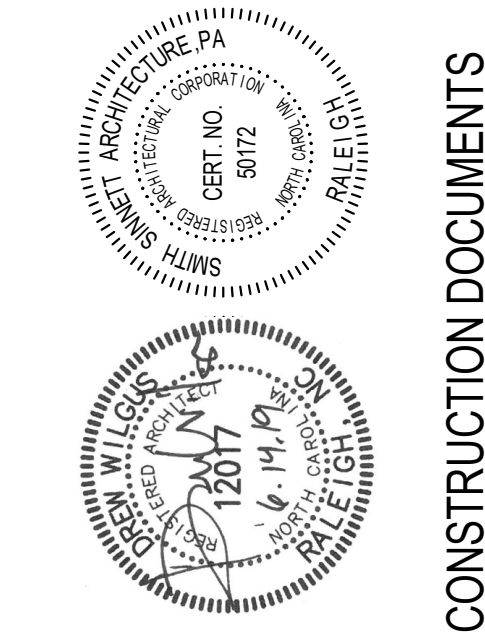

The drawings on this sheet show a preliminary design. It is the responsibility of the user to verify the accuracy of the information shown on this sheet. Any reliance on the information shown on this sheet is at the user's sole risk. Smith Sinnett Architecture, P.A. is not responsible for any errors or omissions on this sheet. THIS DRAWING IS FORMATTED TO BE PRINTED ON A 30" x 42" SHEET.

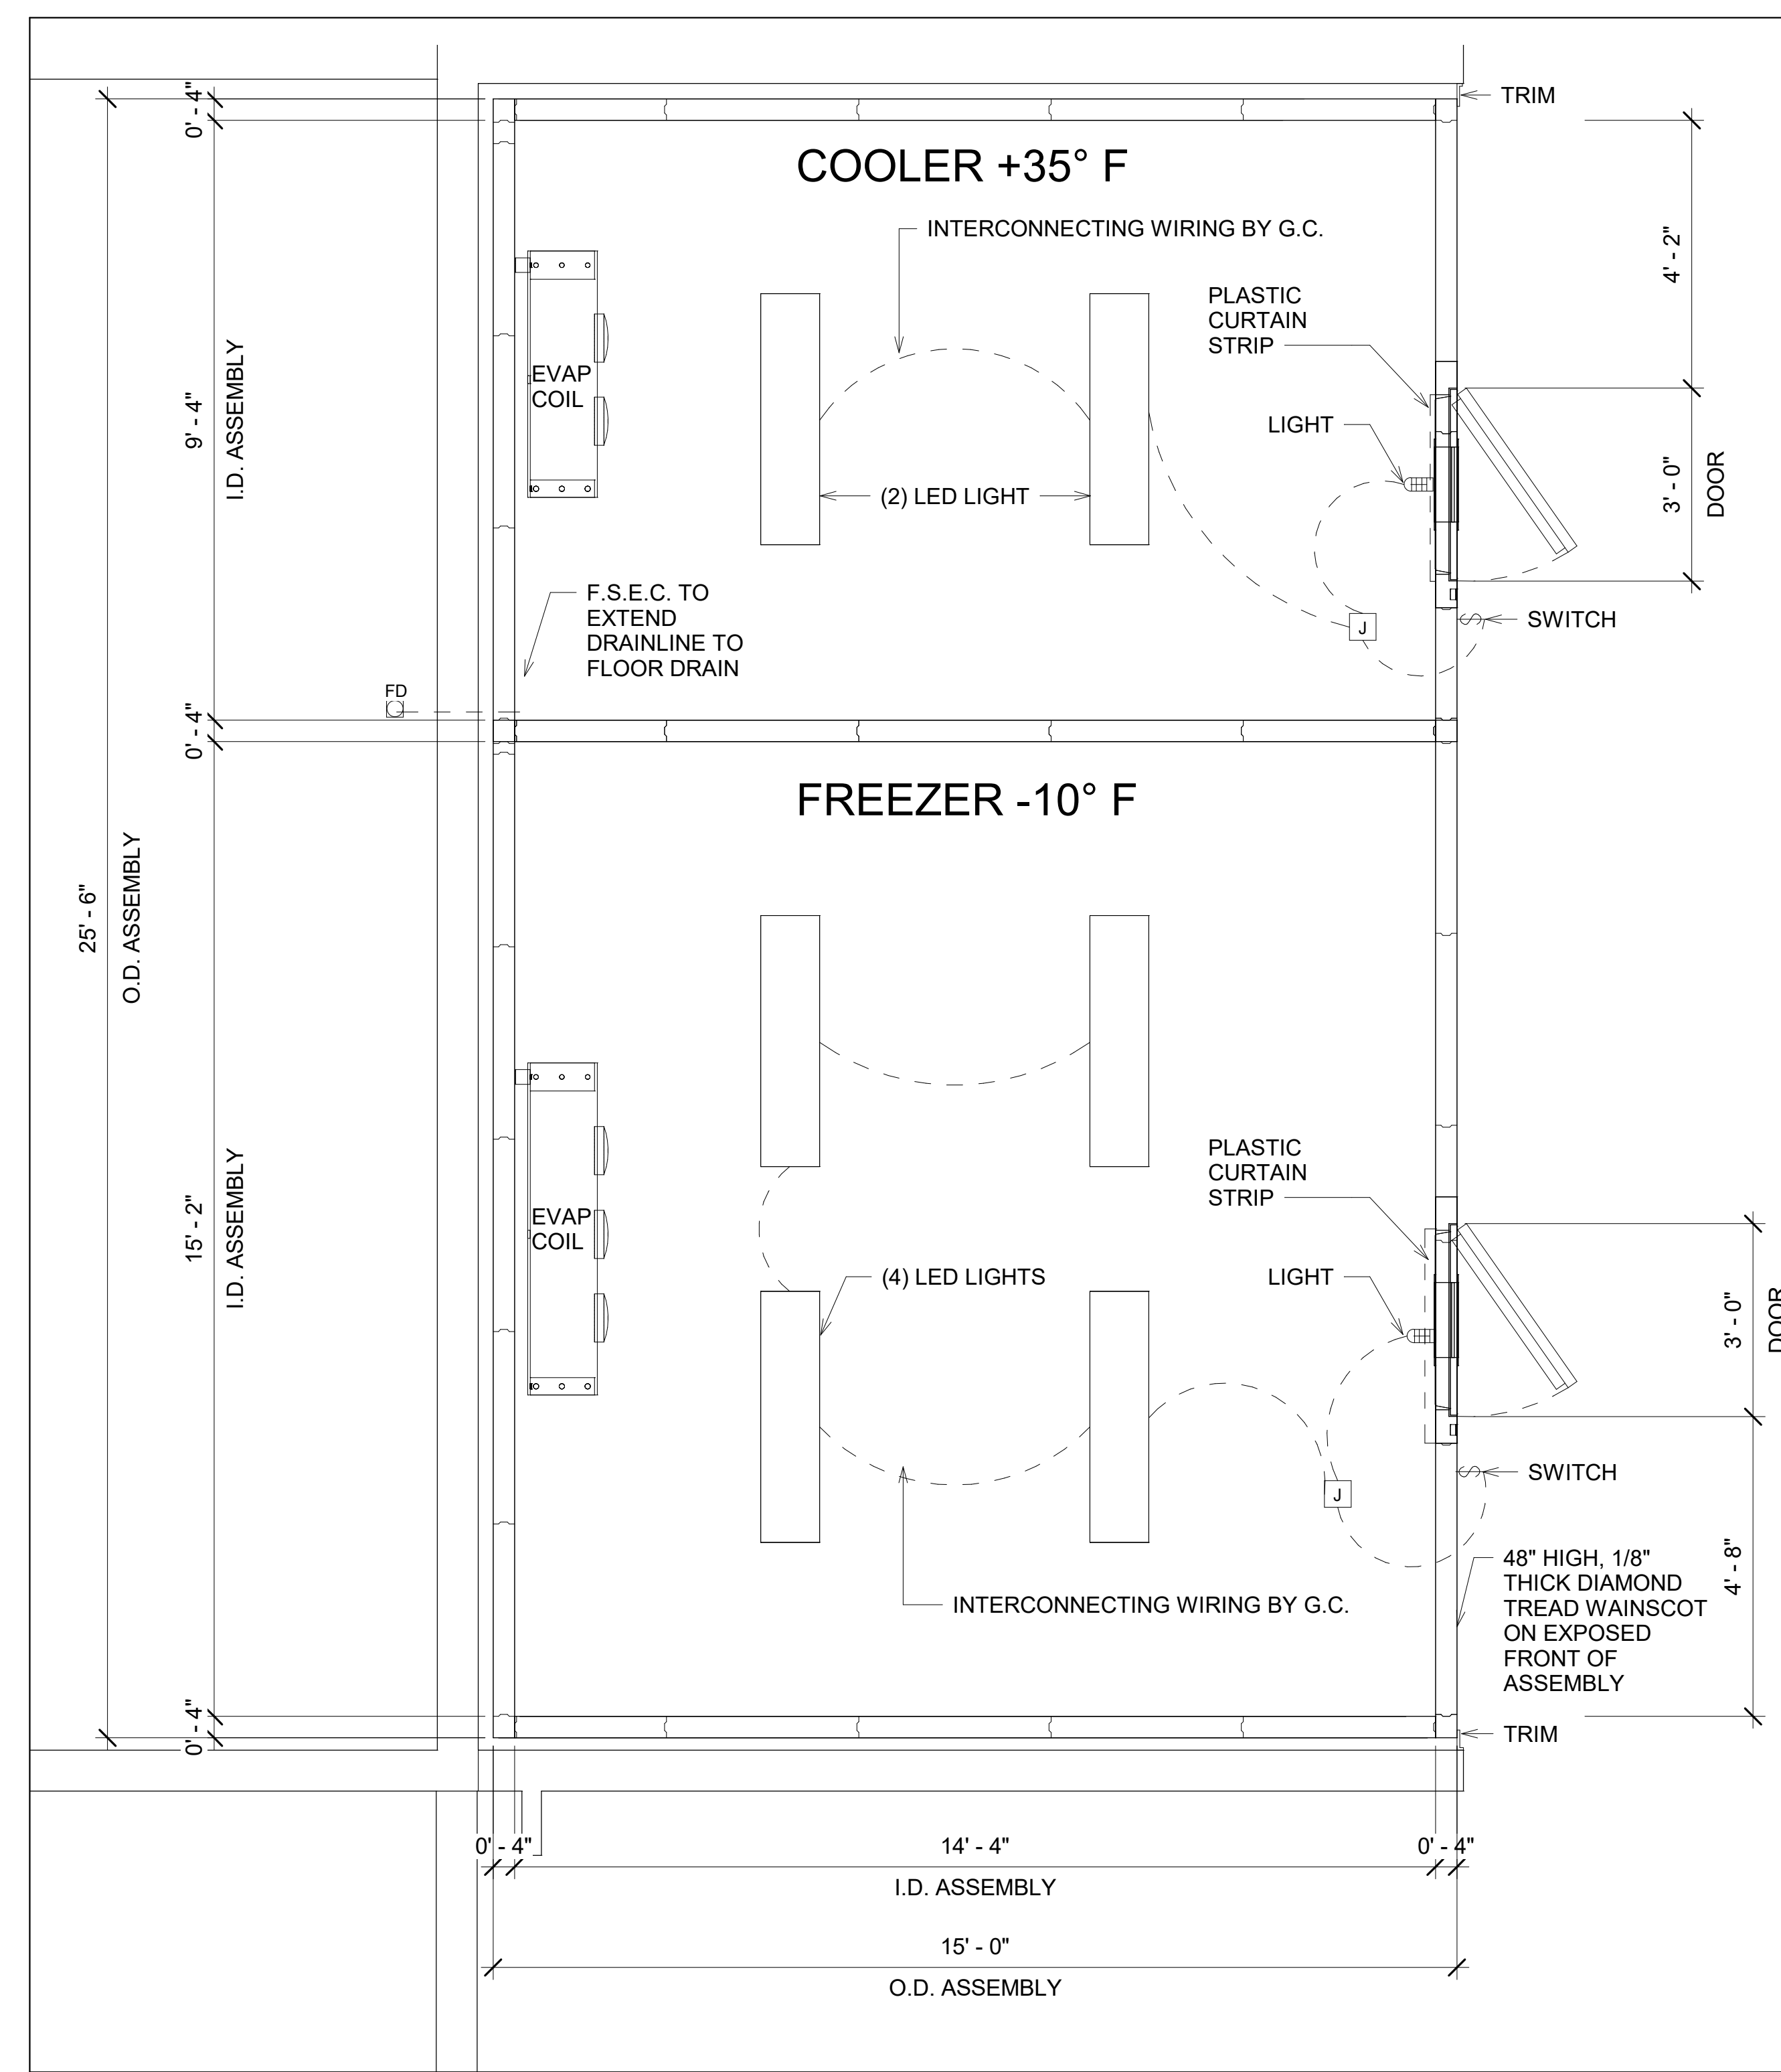

1 COLD STORAGE ASSEMBLY PLAN
FS.06 1/2" = 1'-0"
ITEM # 54

COLD STORAGE ASSEMBLY DATA						
COMPARTMENT	TEMP RANGE	DAILY BTU LOAD	LIGHTS WATTS	DOOR HEAT	VOLT	PHASE
COOLER	+35° F	8,951	0300 W		120	1
FREEZER	-10° F	14,080	500 W	300 W	120	1

REFRIGERATION SYSTEMS									
AMBIENT TEMP.	RUN TIME	COND. UNIT			SUCTION TEMP	EVAP. COIL			DEFROST
		MCA	VOLT	PHASE		AMP	VOLT	PHASE	
100° F	16 HOURS	6.6	208	3	25.9° F	2.0	120	1	OFF-CYCLE
100° F	18 HOURS	15.9	208	3	-19.2° F	1.8	208	1	ELECTRIC

WALK-IN NOTES

EXTERIOR SURFACES
.040 PATTERNED ALUMINUM WITH 48" HIGH WAINSCOT ON EXPOSED SURFACES.

INTERIOR WALLS
.040 PATTERNED ALUMINUM WITH WHITE FINISH.

INTERIOR CEILING
.040 PATTERNED ALUMINUM WITH WHITE ENAMEL.


INTERIOR FLOOR
RECESSED INSULATED FLOOR BY F.S.E.C. WITH .100 DIAMOND TREAD ALUMINUM

DOORS
NOMINAL 36"x78" FINISHED TO MATCH EXTERIOR. CHROME PLATED HARDWARE; 1/8" DIAMOND TREAD KICK PLATE, 48" HIGH, BOTH SIDES.


REFRIGERATION
AIR COOLED REMOTE CONDENSING UNITS WITH ALL WEATHER HOUSING, AND CONTROLS FOR OUTDOOR OPERATION.

MISCELLANEOUS
TRIM STRIPS, EVAPORATOR DRAIN LINES, DIAL THERMOMETERS, TOP CLOSURE PANELS, PLASTIC STRIP CURTAINS AND 1/8" DIAMOND TREAD WAINSCOT ACROSS FRONT OF ASSEMBLY.

LIGHTS
MANUFACTURER TO FURNISH EXTRA LIGHT FIXTURES AS REQUIRED TO PROVIDE 50 FT. CANDLES 30" ABOVE FLOOR MINIMUM. F.S.E.C. TO INSTALL AND E.C. TO CONNECT.

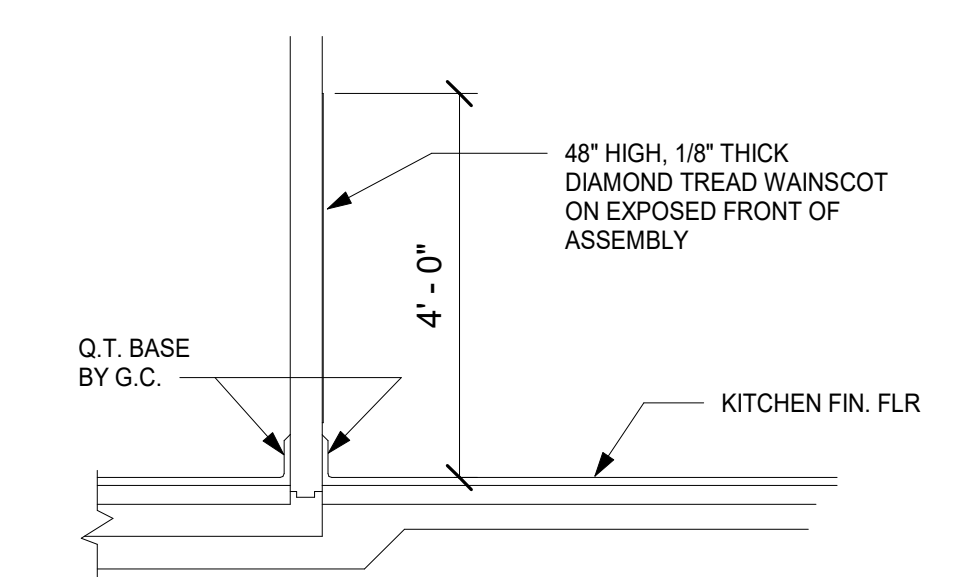

2 WAINSCOT DETAIL - QUARRY TILE
FS.06 NO SCALE

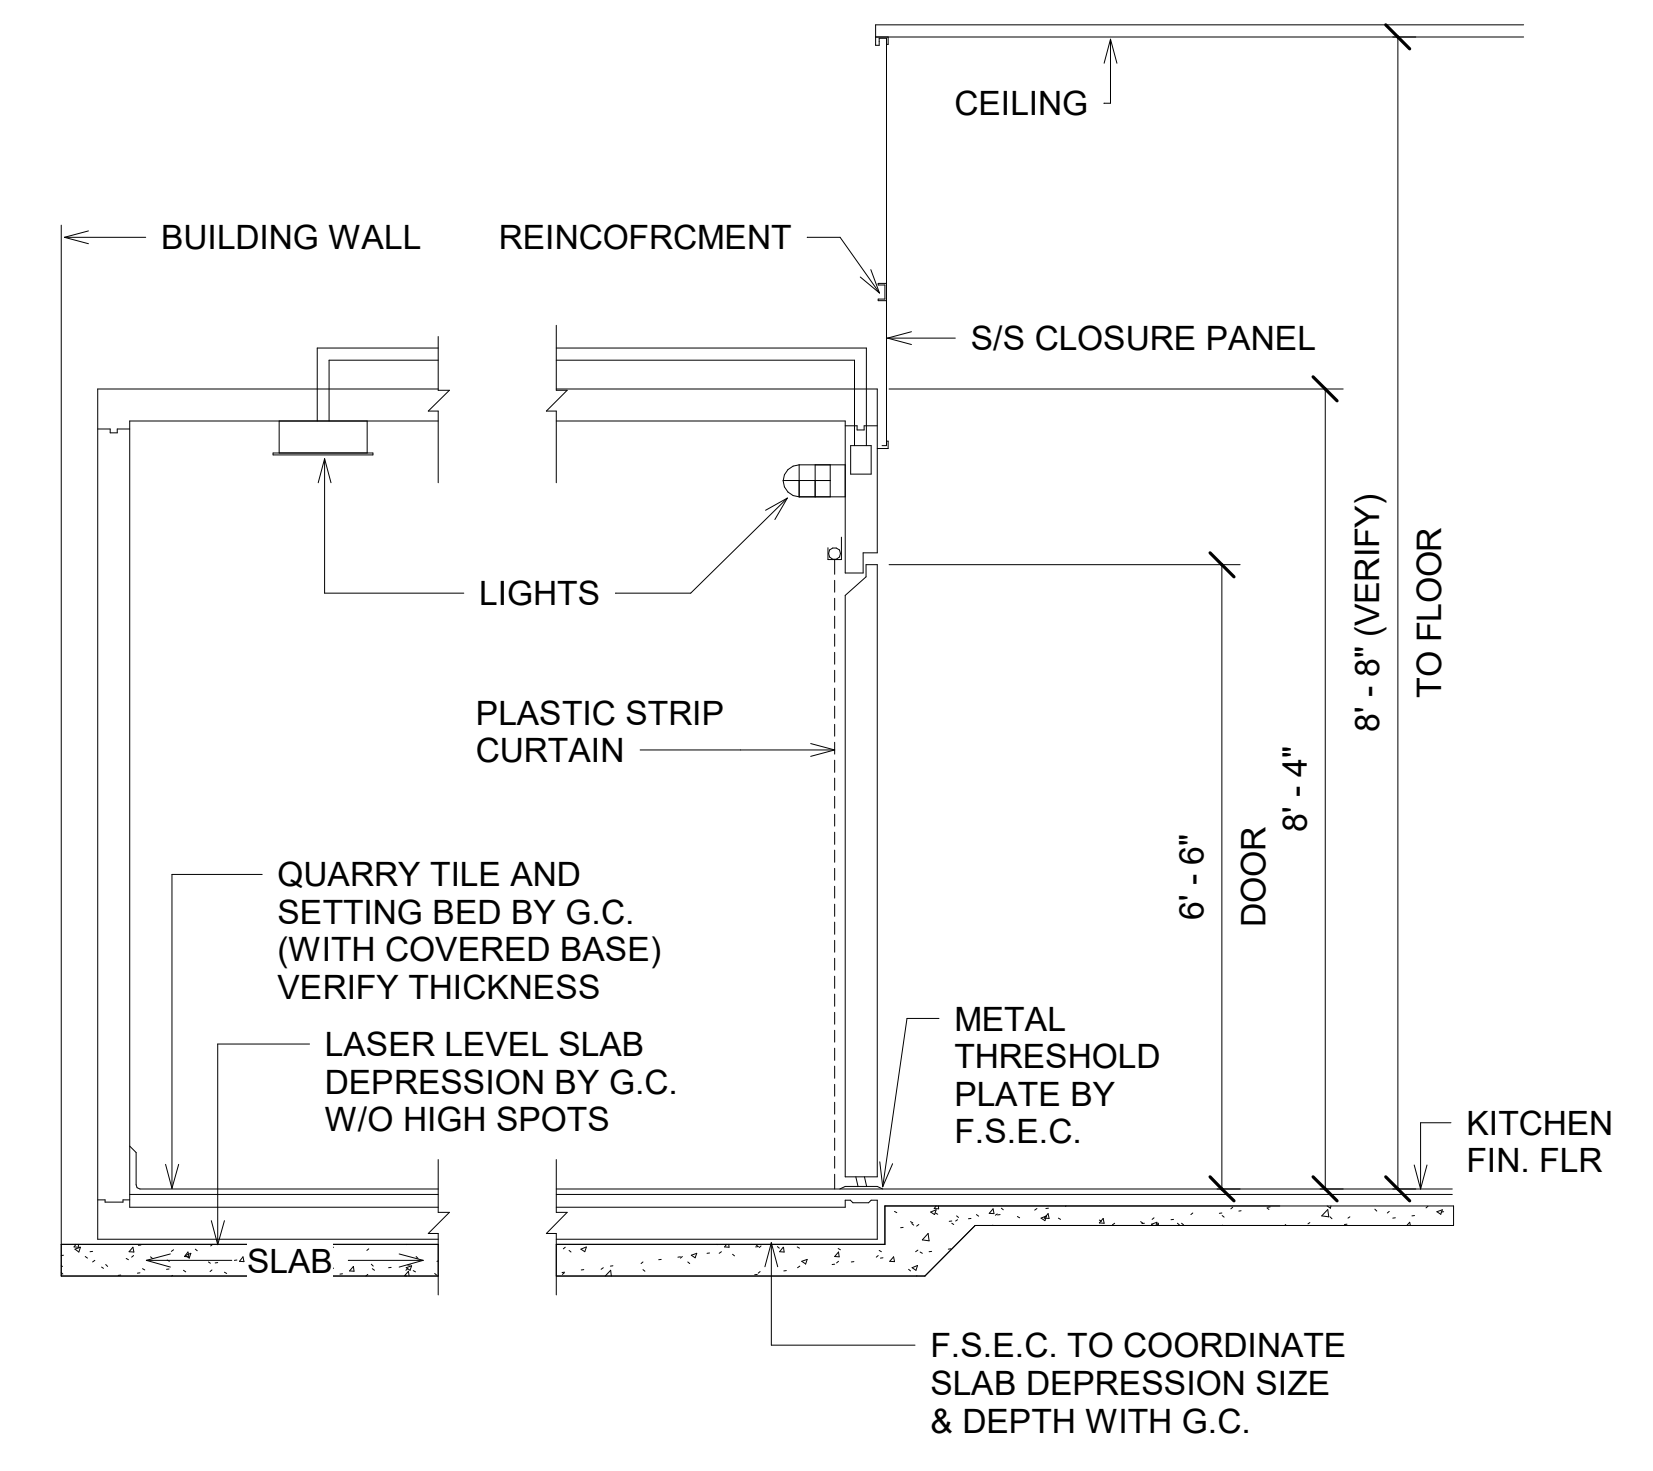


3 COLD STORAGE ASSEMBLY SECTION - QUARRY TILE
FS.06 NO SCALE
ITEM # 54

NEW TRINITY MIDDLE SCHOOL
RANDOLPH COUNTY SCHOOL SYSTEM
Parcel PIN 7708118367
Surrett Drive
Trinity, NC 27370

KEY PLAN
NO SCALE


ID	DATE	DESCRIPTION
DRAWN BY:	JA	
CHECKED BY:	KM	

FOOD SERVICE
COLD STORAGE
DETAILS

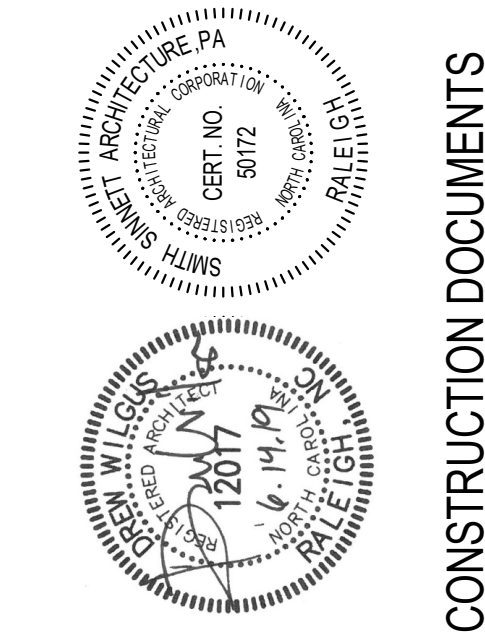


The drawings are the property of Smith Sinnett Architecture, P.A. The reproduction or use of this project without the written consent of Smith Sinnett Architecture, P.A. is prohibited. Any infringement of the copyright rights will be subject to legal action. All copies are subject to the terms and conditions of the Architect at the completion of the contract.
Smith Sinnett Architecture, P.A. 2018
THIS DRAWING IS FORMATTED TO BE PRINTED ON A 30" x 42" SHEET


ID	DATE	DESCRIPTION
DRAWN BY:		Author
CHECKED BY:		

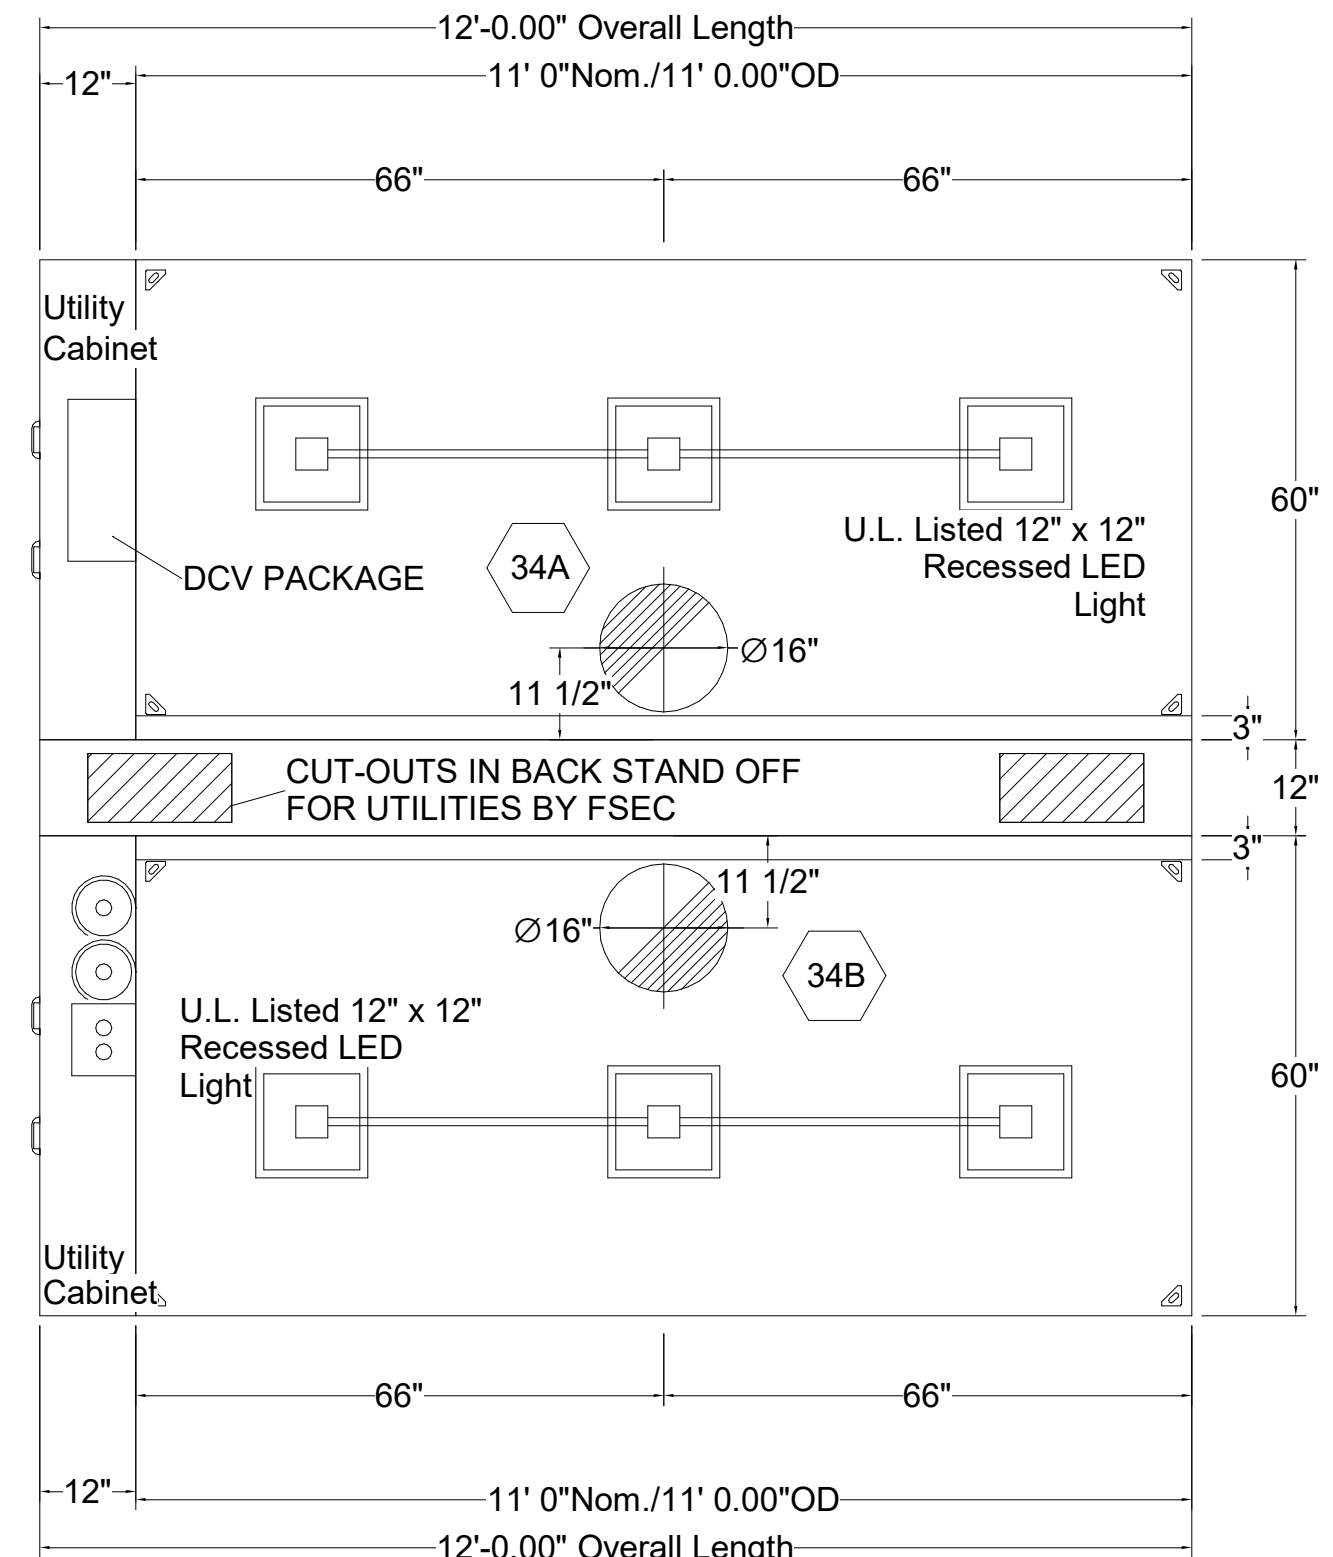


1 EXHAUST HOOD PLAN VIEW
1/2" = 1'-0"

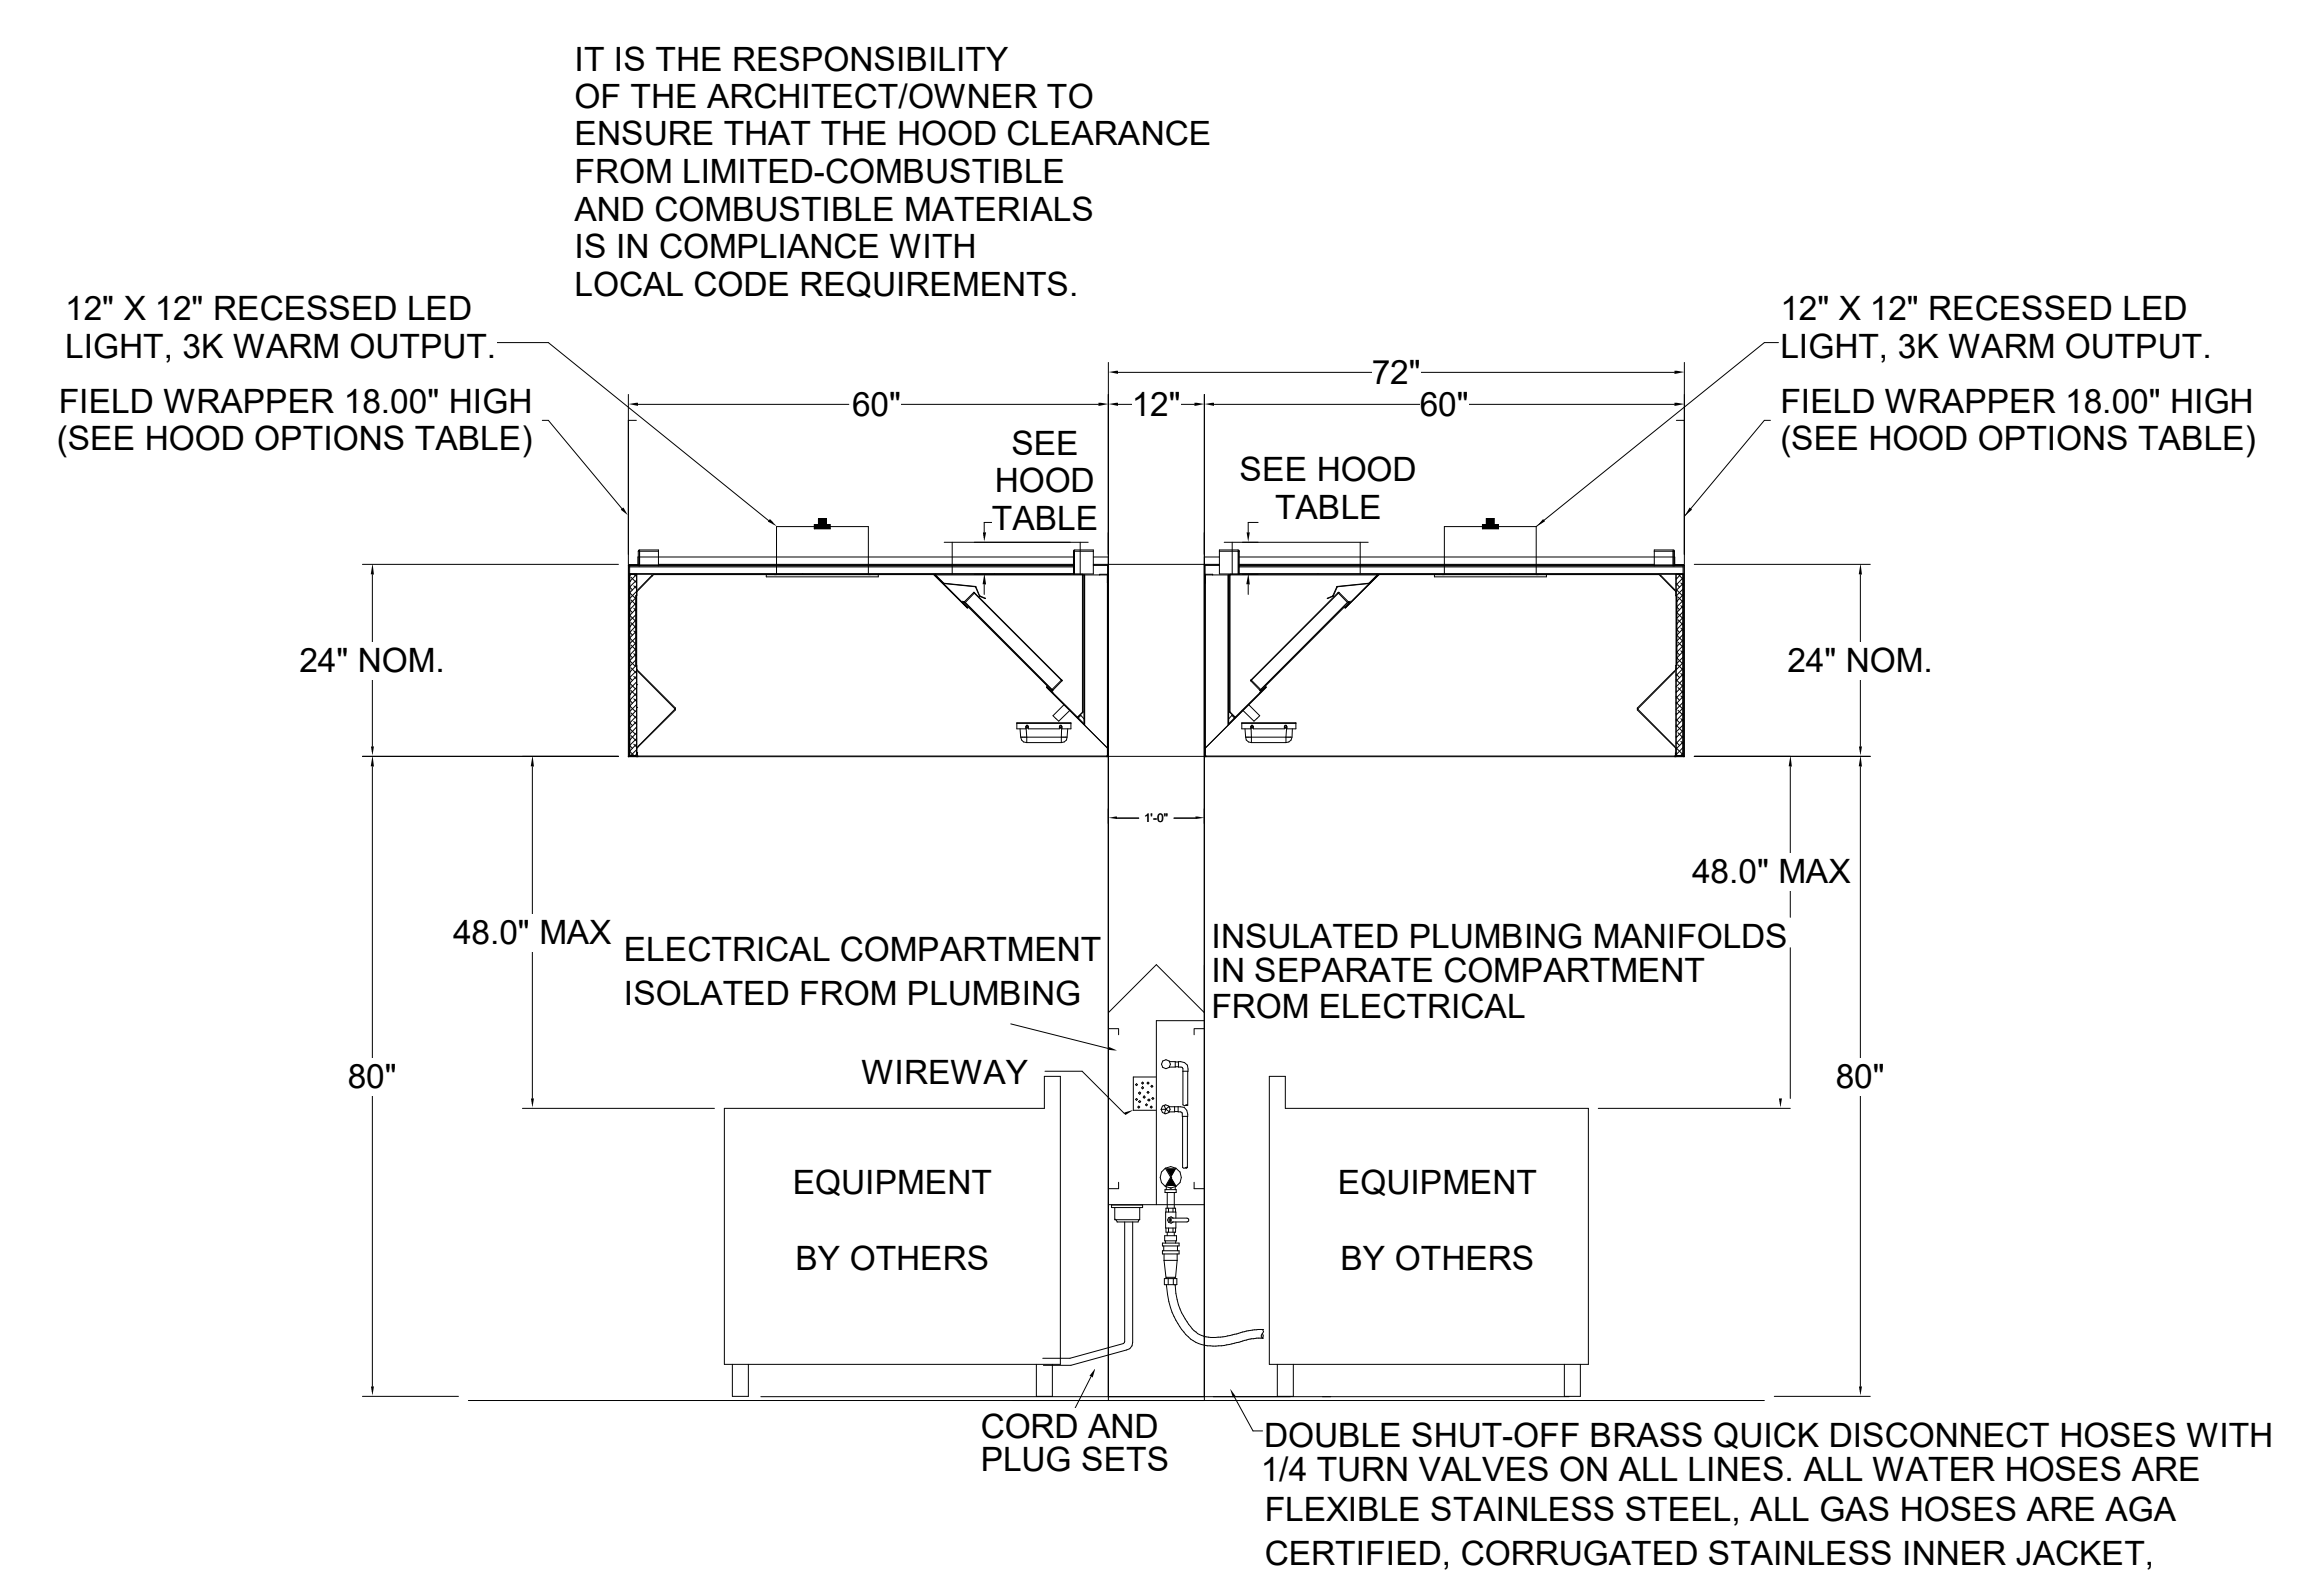

2 EXHAUST HOOD SECTION VIEW
1/2" = 1'-0"

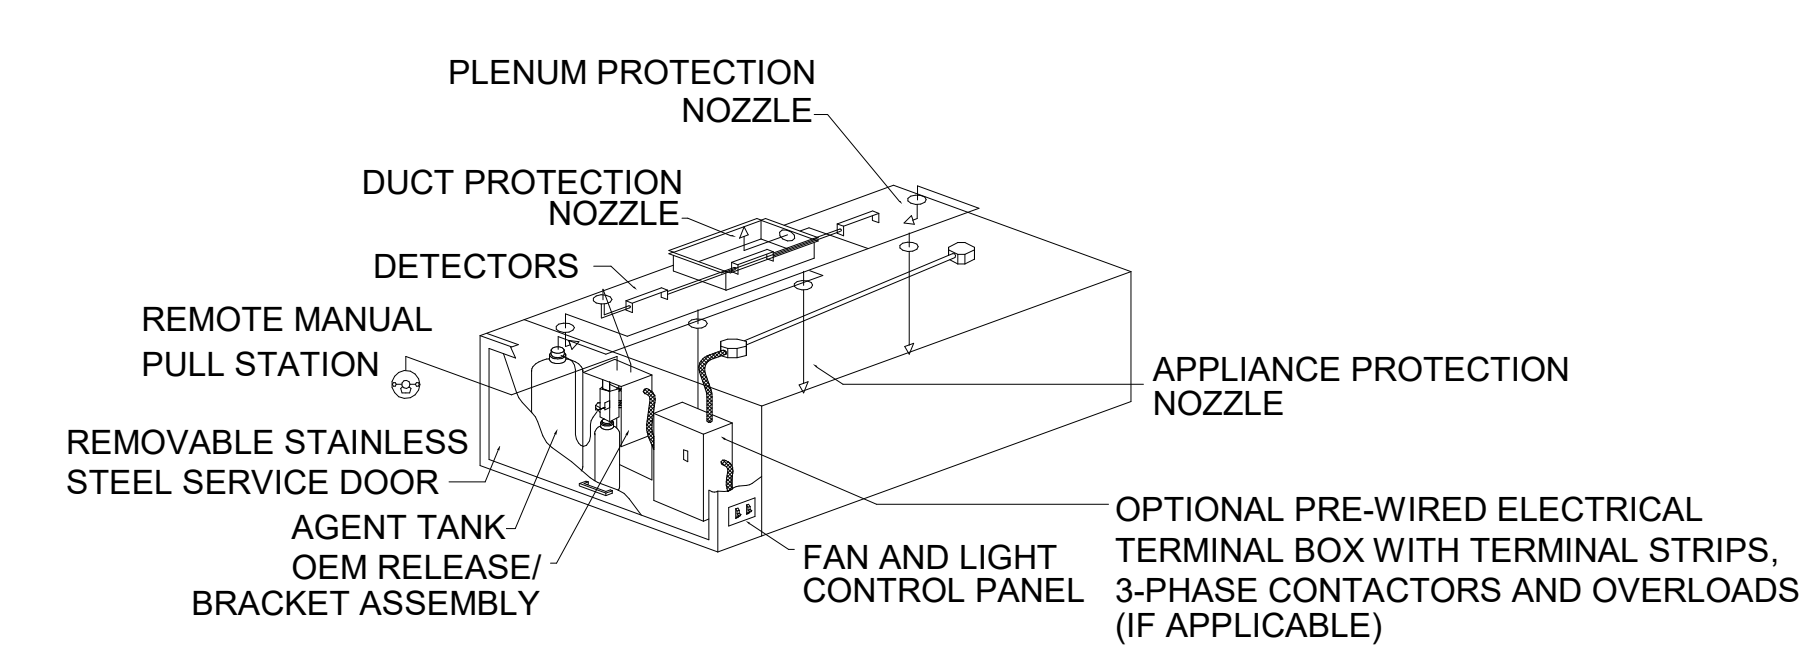

3 FIRE SUPPRESSION SYSTEM
1/2" = 1'-0"

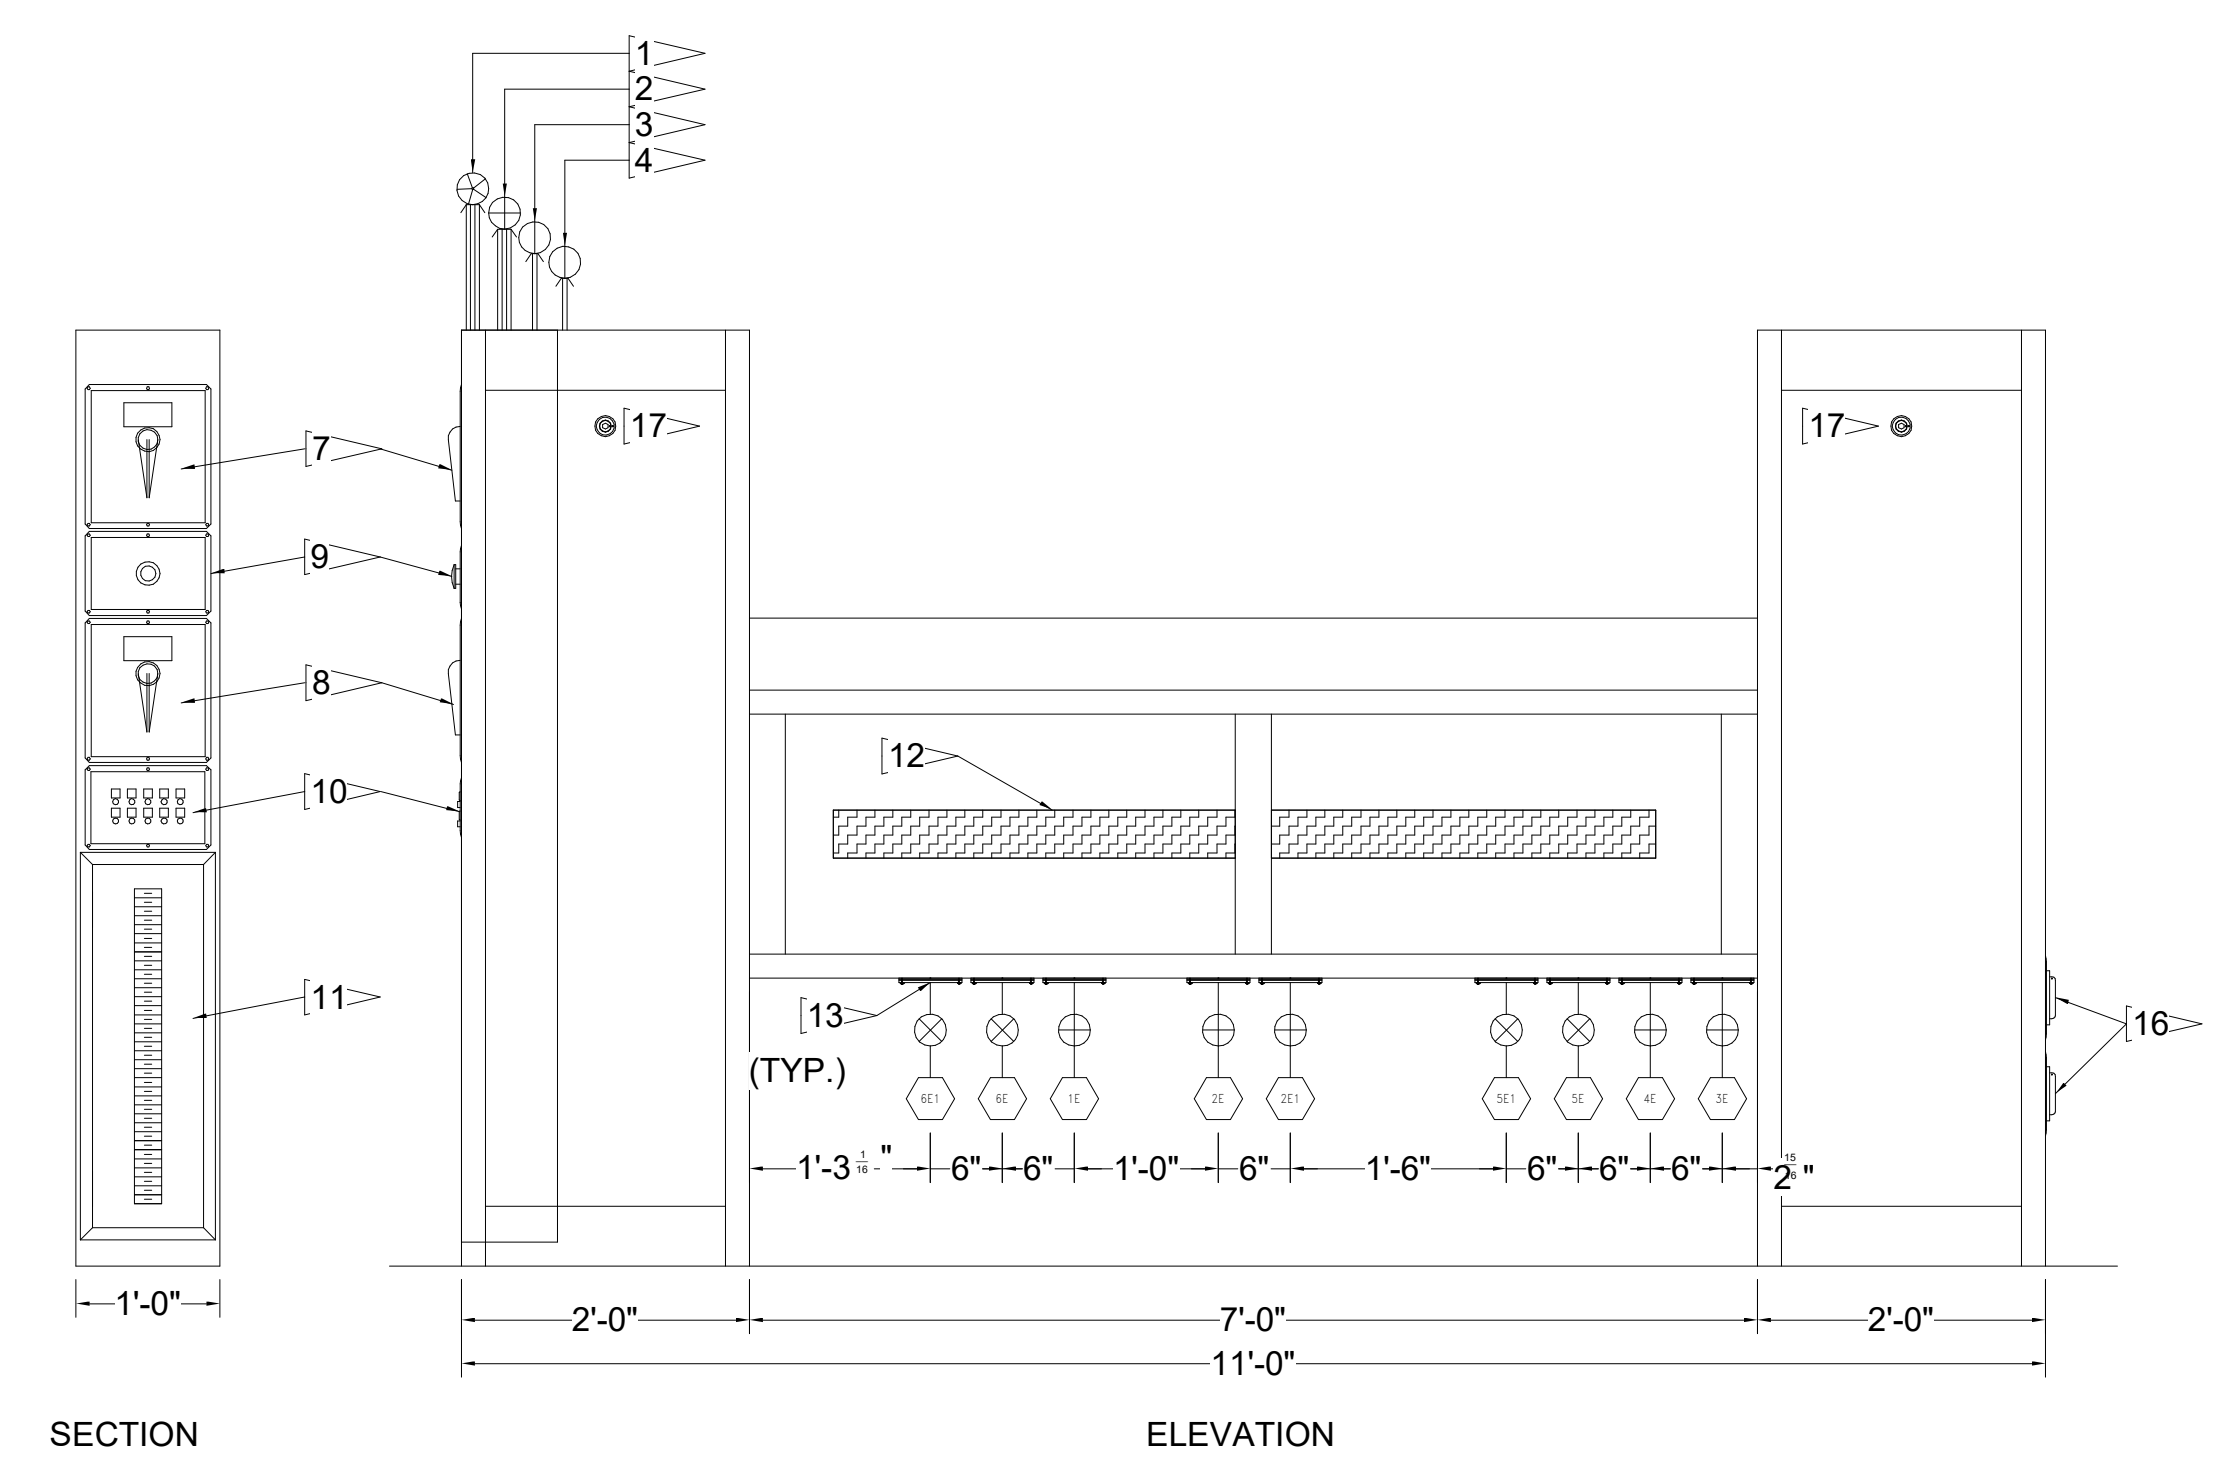

4 UDS SECTION & ELEVATION VIEW
3/4" = 1'-0"

FLAG NOTES

- [1] 480V/3PH/100AMP ELECTRICAL SERVICE FROM ABOVE. PROVIDED BY ELECTRICAL CONTRACTOR.
- [2] 120/208V/3PH/225AMP ELECTRICAL SERVICE FROM ABOVE. PROVIDED BY ELECTRICAL CONTRACTOR.
- [3] 120V/1PH/15A DEDICATED ELECTRICAL CIRCUIT INTO UDS TERMINALS "H1 & N1" FOR FIRE/FUEL SHUT OFF CONTROL. (PROVIDED BY ELECTRICAL CONTRACTOR) SEE MASTER DRAWING FOR WIRING DETAILS.
- [4] 2-WIRE ELECTRICAL CIRCUIT FROM UDS SYSTEM TERMINALS "KTS & ST" TO LIKE TERMINALS "KTS & ST" LOCATED IN EMS SYSTEM. PROVIDED BY JOBSITE ELECTRICAL CONTRACTOR. SEE MASTER DRAWING FOR WIRING DETAILS.
- [5] 1" COLD WATER SERVICE FROM ABOVE (PROVIDED BY PLUMBING CONTRACTOR)
- [6] 3/4" HOT WATER SERVICE FROM ABOVE (PROVIDED BY PLUMBING CONTRACTOR)
- [7] 480V/3PH/100A MAIN SERVICE BREAKER WITH SHUNT TRIP BUILT IN.
- [8] 120/208V/3PH/225A MAIN SERVICE BREAKER WITH SHUNT TRIP BUILT IN.
- [9] EMERGENCY KILL SWITCH.
- [10] STATUS INDICATOR LIGHTS.
- [11] ELECTRICAL LOAD CENTER W/ INDIVIDUAL CIRCUIT BREAKERS.
- [12] ELECTRICAL WIRING INSIDE PROTECTIVE PANDUIT.
- [13] ELECTRICAL CONNECTION W/WEATHERPROOF COVER AS SPECIFIED ON THE EQUIPMENT SCHEDULE THIS SHEET.
- [14] MANUAL SHUT OFF VALVE.
- [15] PLUMBING CONNECTIONS AS SPECIFIED ON THE EQUIPMENT SCHEDULE THIS SHEET.
- [16] DUPLEX CONVENIENT OUTLET.
- [17] REMOVEABLE DOORS.