

Orange County

Health Department

Renovations

Hillsborough, North Carolina



no.	revisions
-----	-----------

RECORD

DOCUMENT

1-31-12

THESE DOCUMENTS HAVE BEEN PREPARED FROM INFORMATION RECEIVED FROM THE CONTRACTOR.

The use of these plans and specifications and be restricted to the original site for which they were prepared and publication thereof is expressly limited to such use. Re-use, reproduction, or publication by any method, in whole or in part, is prohibited. Title to the plans and specifications remain in the architect without prejudice. It is to be returned upon request to the architect. Specifications shall constitute prime rule evidence of the acceptance of these restrictions.

drawn	checked
-------	---------

BUILDING A

BASEMENT LEVEL

EXISTING PALN



sheet

A1.0

of total

project no. 1001

date 12-20-2010

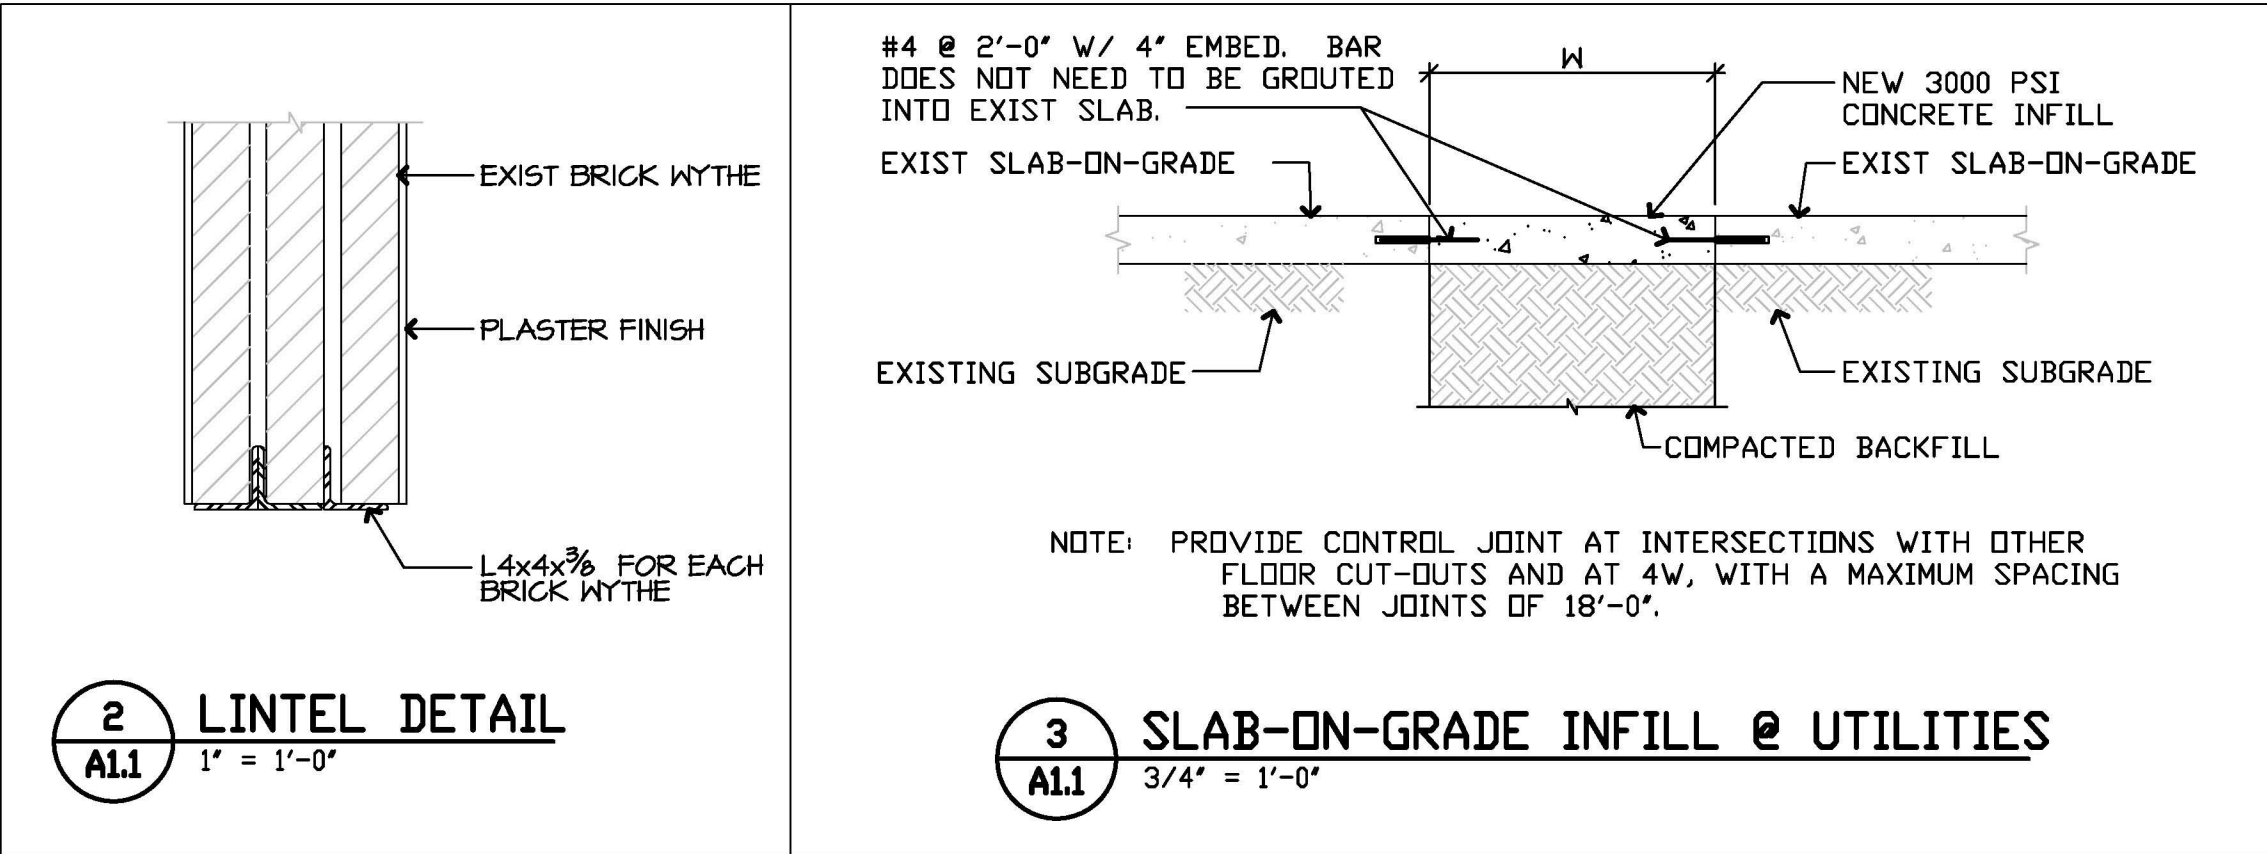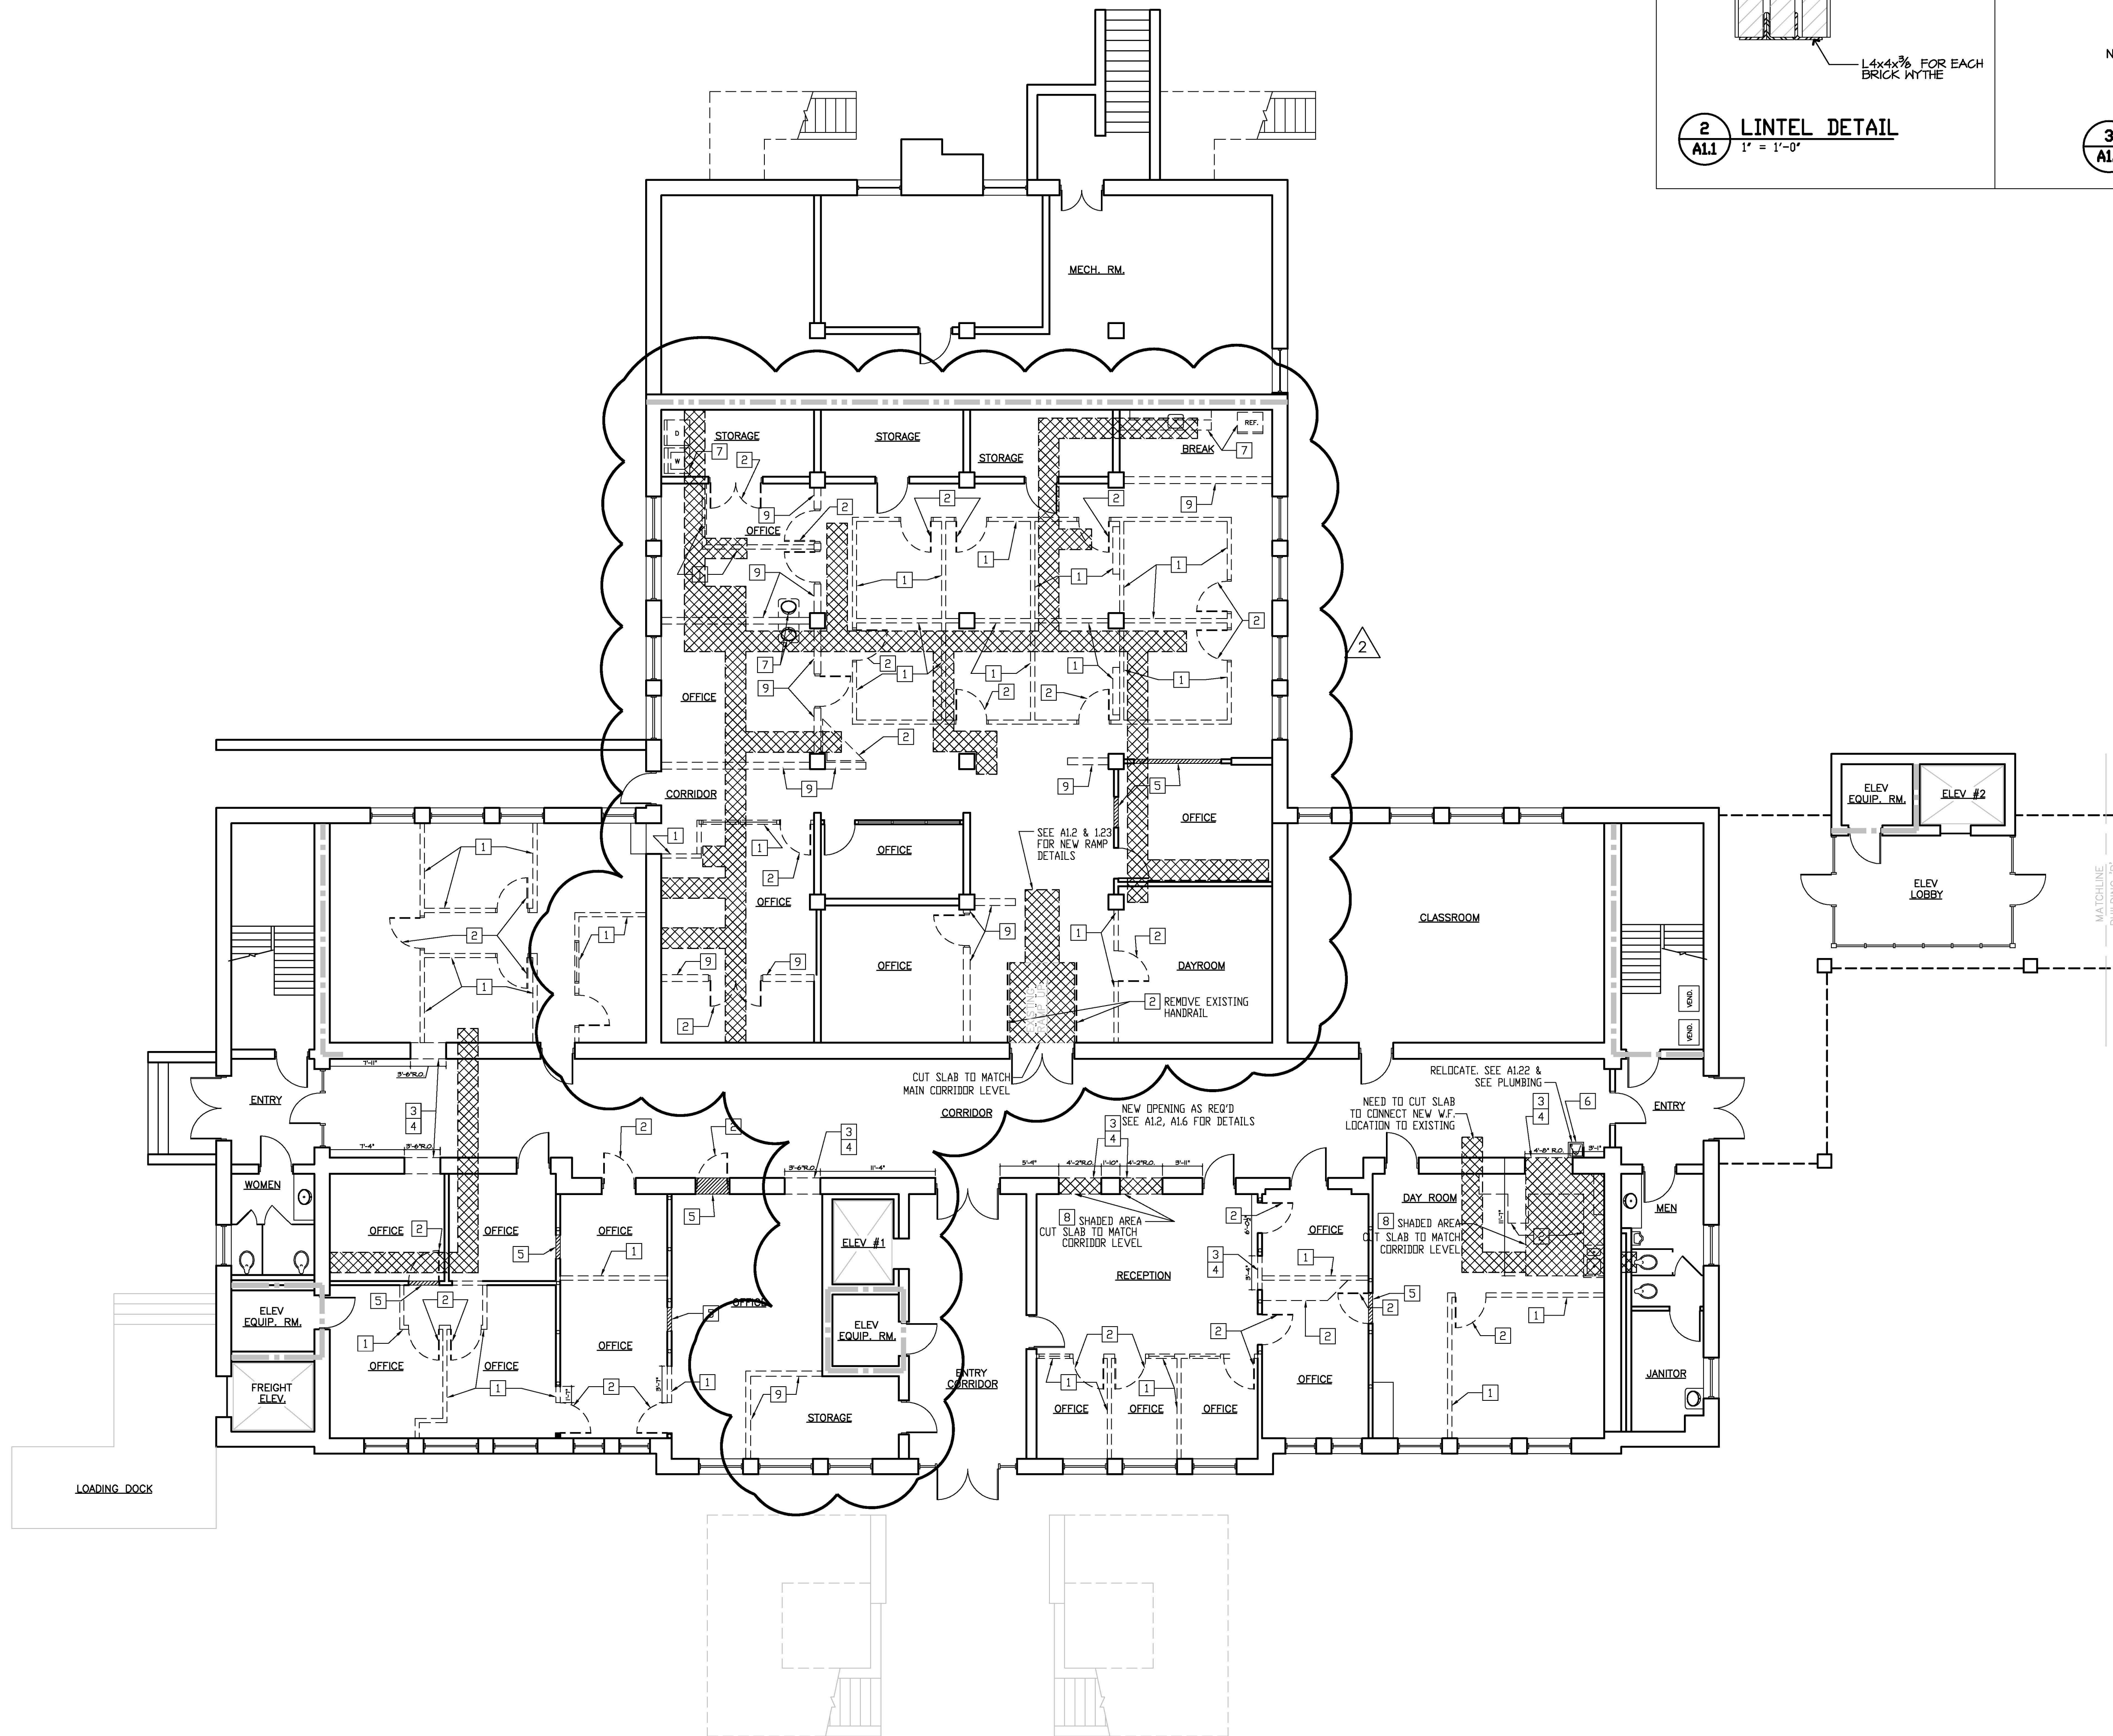



DEMOLITION NOTES:

- 1 REMOVE EXISTING GYPSUM BOARD & METAL STUD PARTITION; PATCH FLOOR, CEILING & ABUTTING WALLS TO MATCH EXISTING FINISHES IN ADJACENT SPACES. REMOVE ALL ELECTRICAL, TELEPHONE, DATA, PLUMBING, ETC. IN WALL TO BE DEMOLISHED
- 2 REMOVE EXISTING DOOR, FRAME & HARDWARE.
- 3 NEW OPENING AS REQ'D
- 4 NEW LINTEL AS REQ'D
- 5 FILL EXISTING OPENING WITH CONSTRUCTION IDENTICAL TO THAT OF PARTITION IN WHICH IT OCCURS & FINISH TO MATCH FINISHES IN ADJACENT SPACES.
- 6 RELOCATE
- 7 EXISTING EQUIP./PLUMBING FIXTURE AND/OR MILLWORK TO BE REMOVED
- 8 CUT SLAB AND REPLACE WITH NEW SLAB AT LEVEL OF MAIN CORRIDOR
- 9 REMOVE EXISTING CMU PARTITION; PATCH FLOOR, CEILING & ABUTTING WALLS TO MATCH EXISTING FINISHES IN ADJACENT SPACES. REMOVE ALL ELECTRICAL, TELEPHONE, DATA, PLUMBING, ETC. IN WALL TO BE DEMOLISHED
- 10 UNDER ALTERNATE #3 - SEE STRUCTURAL DWG S21 & S22 FOR REMOVAL OF EXISTING SLAB-ON-GRADE TO INSTALL COLUMN FOOTINGS
- 11 UNDER ALTERNATE #1: SEE STRUCTURAL DWG S22 FOR STRUCTURAL STEEL TO BE INSTALLED. UNDER ALTERNATE #3: SEE STRUCTURAL DWG S21 FOR STRUCTURAL STEEL TO BE INSTALLED, INCLUDE REMOVAL & REINSTALLATION OF EXISTING WINDOWS & BASEMENT AS REQ'D TO INSTALL STEEL FRAMING

SYMBOL LEGEND:

- EXISTING WALL TO REMAIN
- EXISTING WALL TO BE REMOVED
- EXISTING DOOR & FRAME TO REMAIN
- EXISTING DOOR & FRAME TO BE REMOVED
- EXISTING OPENING TO BE INFILLED
- CUT AND PATCH EXISTING CONCRETE SLAB. SEE DTL. 3/A1.1 FOR REPAIR
- EXISTING MILLWORK TO REMAIN
- EXISTING MILLWORK TO BE REMOVED

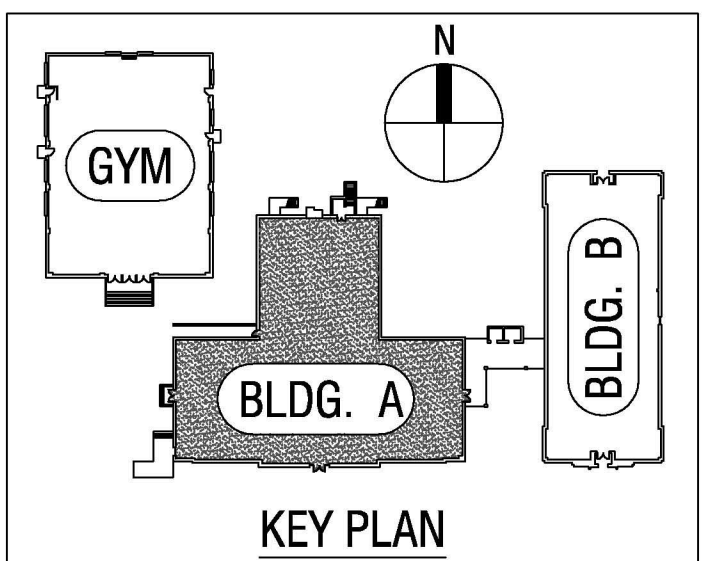

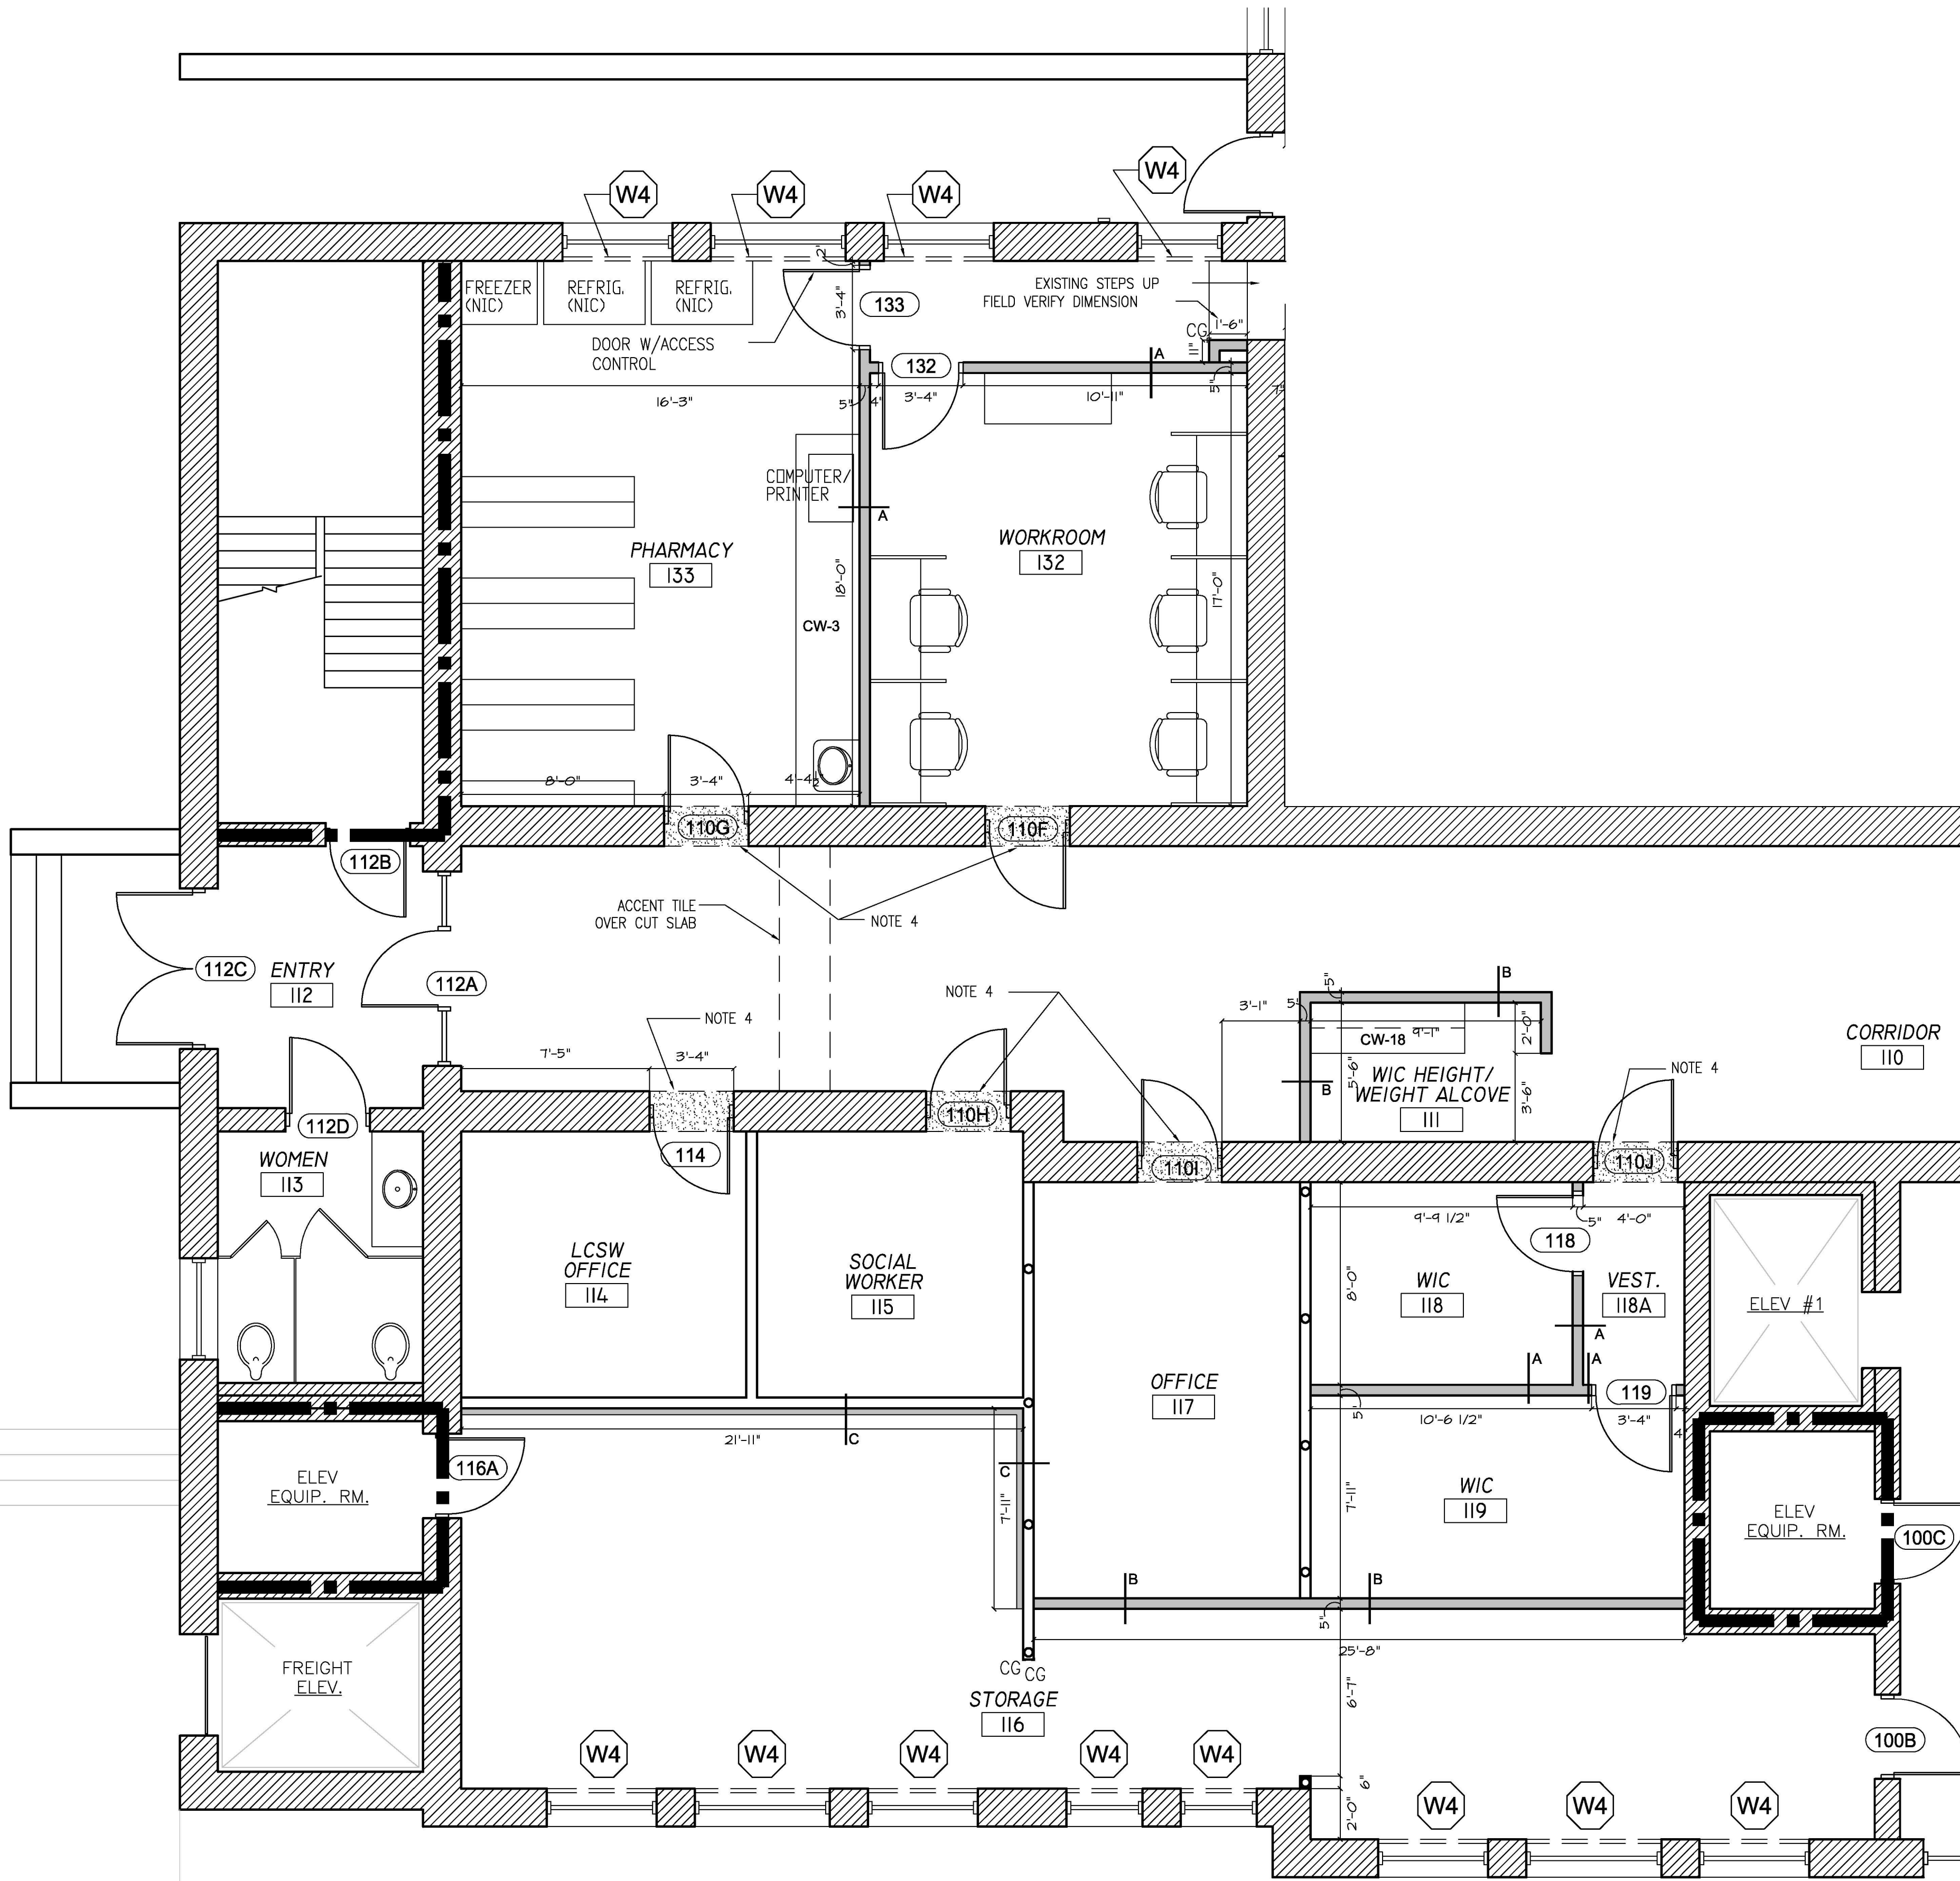

LOADING DOCK

#### GENERAL NOTES

- NEW FINISH FLOOR SHALL MATCH EXISTING FINISH FLOOR. FIELD VERIFY EXISTING FINISH FLOOR ELEVATION OF 100.42.
- STANDARD WALL TYPE OF NEW INTERIOR PARTITIONS IS TYPE "A" UNLESS OTHERWISE NOTED.
- FIELD VERIFY EXISTING CONDITIONS AND NOTIFY ARCHITECT OF ANY DISCREPANCIES ON THE DRAWINGS.
- PROVIDE CONTRASTING COLOR STRIP (RTI) WHERE INDICATED.
- MAINTAIN THE EXISTING BUILDING IN A WEATHER TIGHT CONDITION THROUGHOUT THE CONSTRUCTION PERIOD AND REPAIR ANY DAMAGE CAUSED BY CONSTRUCTION OPERATIONS.


#### LEGEND

- A WALL TYPE, SEE SCHEDULE  
103 DOOR NUMBER  
ALU ALUMINUM FRAME / WINDOW TYPE  
CW-1 CASEWORK (SEE DETAILS)  
TA-1 TOILET ACCESSORY  
REC FIRE EXTINGUISHER CABINET  
Detail Number  
103-42 DETAIL REFERENCE  
Sheet Number  
CG CORNER GUARD  
F.D. FLOOR DRAIN, SEE PLUMBING  
NEW COLOR CONTRAST TRANSITION RUBBER  
SPOT  
NIC. NICK  
UD. UNLESS OTHERWISE NOTED  
F.V. FIELD VERIFY  
NEW WALL  
EXISTING STUD WALL  
EXISTING MASONRY WALL

#### WALL TYPES SCHEDULE

			THICKNESS	
			ACTUAL	NOMINAL
A	STANDARD WALL TYPE UNLESS OTHERWISE NOTED. 3 5/8" METAL STUDS @ 16" O.C. WITH 5/8" GYP. BD. EACH SIDE. EXTEND TO 4" ABOVE CEILING. UO.N. PROVIDE "SOUND BATTS" AS NOTED.		4 7/8"	5"
B	2 1/2" METAL STUDS @ 16" O.C. WITH 5/8" GYP. BD. EACH SIDE. EXTEND TO 4" ABOVE CEILING. UO.N. PROVIDE "SOUND BATTS" AS NOTED.		4 7/8"	5"
C	2 1/2" METAL STUDS @ 16" O.C. WITH 5/8" GYP. BD. EACH SIDE. EXTEND TO 4" ABOVE CEILING. UO.N. PROVIDE "SOUND BATTS" AS NOTED.		3 1/8"	3"
D	3 5/8" METAL STUDS @ 16" O.C. WITH 5/8" GYP. BD. EACH SIDE. EXTEND TO 4" ABOVE CEILING. UO.N. PROVIDE "SOUND BATTS" AS NOTED.		6 5/8"	7"
E	3 5/8" METAL STUDS @ 16" O.C. WITH 5/8" GYP. BD. EACH SIDE. EXTEND TO 4" ABOVE CEILING. UO.N. PROVIDE "SOUND BATTS" AS NOTED.		5 7/8"	6"

NOTE: PROVIDE "SOUND BATTS" IN ALL WALLS AND ABOVE CEILING OF THE FOLLOWING ROOMS: TOILETS, SHOWERS, MECHANICAL ROOMS, EXAM ROOMS, X-RAY PROCESSING, SWING EXAM, EXAM TREATMENT, SUCTON STORAGE.

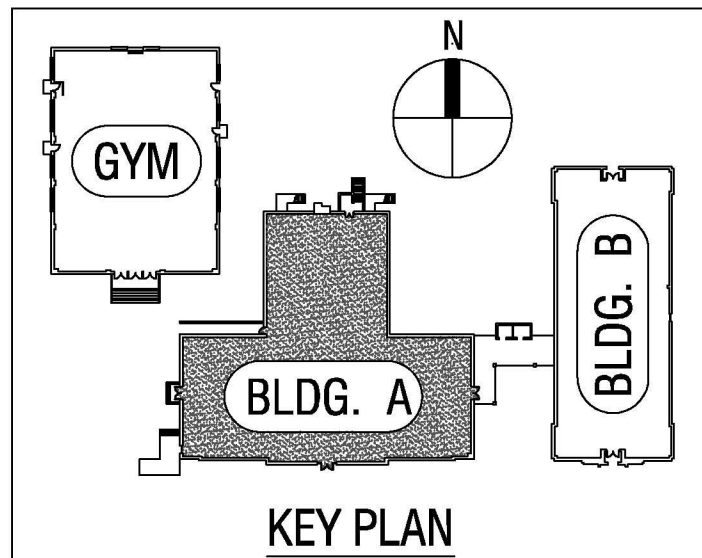

no. revisions

#### RECORD DOCUMENT 1-31-12

THESE DOCUMENTS HAVE BEEN PREPARED FROM INFORMATION RECEIVED FROM THE CONTRACTOR. The use of these plans and specifications shall be restricted to the original site for which they were prepared and publication thereof is expressly limited to such use. Re-use, reproduction, or publication by any method, in whole or in part, is prohibited. Title to the plans and specifications remain in the architect without prejudice. It is to be returned upon request to the architect. Visual conflict with those plans and specifications shall constitute prima facie evidence of the acceptance of these restrictions.

drawn checked

#### BUILDING A BASEMENT LEVEL RENOVATIONS PALM

sheet

A1.21

of total

project no. 1001


date 12-20-2010



Orange County  
Health Department  
Renovations  
Hillsborough, North Carolina



CORLEY REDFOOT ZACK, INC.  
ARCHITECTS • ENGINEERS • PLANNERS  
PO Box 2368, Chapel Hill, North Carolina 919 401-8586

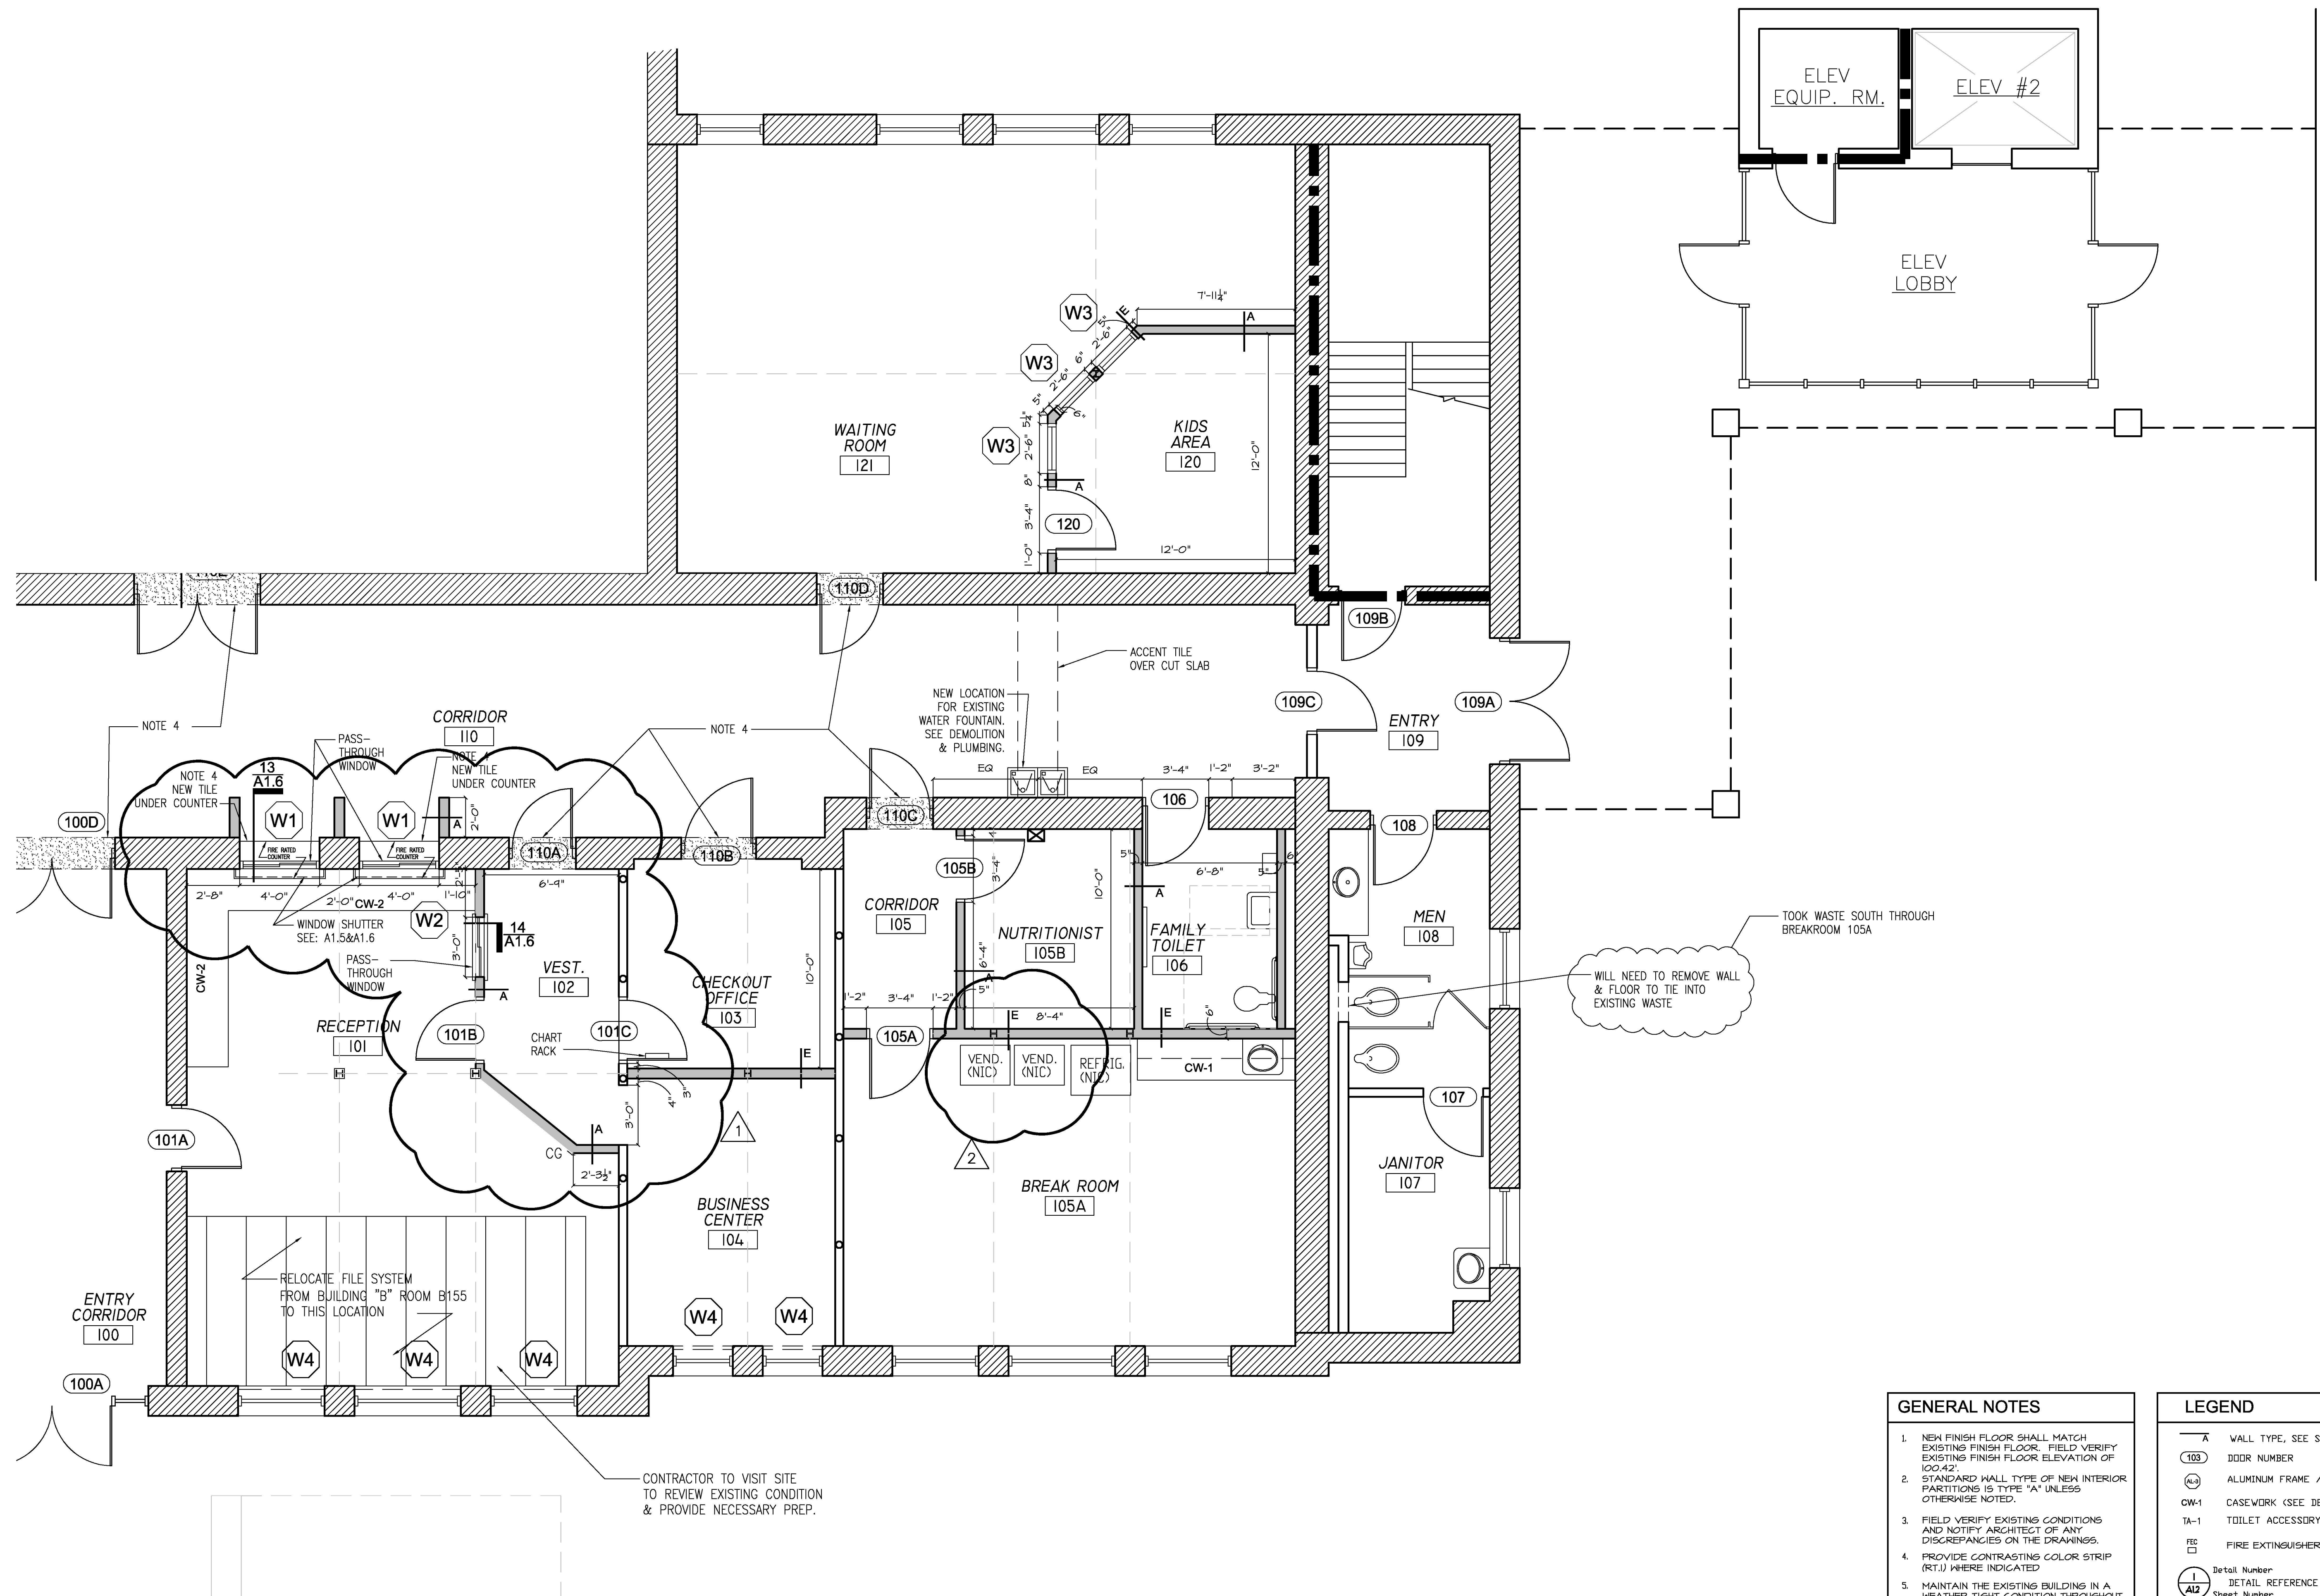


- GENERAL NOTES**
- NEW FINISH FLOOR SHALL MATCH EXISTING FINISH FLOOR. FIELD VERIFY EXISTING FINISH FLOOR ELEVATION OF 100.42.
  - STANDARD WALL TYPE OF NEW INTERIOR PARTITIONS IS TYPE "A" UNLESS OTHERWISE NOTED.
  - FIELD VERIFY EXISTING CONDITIONS AND NOTIFY ARCHITECT OF ANY DISCREPANCIES ON THE DRAWINGS.
  - PROVIDE CONTRASTING COLOR STRIP (RT/J) WHERE INDICATED.
  - MAINTAIN THE EXISTING BUILDING IN A WEATHER TIGHT CONDITION THROUGHOUT THE CONSTRUCTION PERIOD AND REPAIR ANY DAMAGE CAUSED BY CONSTRUCTION OPERATIONS.

- LEGEND**
- WALL TYPE, SEE SCHEDULE
  - DOOR NUMBER
  - ALUMINUM FRAME / WINDOW TYPE
  - CASEWORK (SEE DETAILS)
  - TOILET ACCESSORY
  - FIRE EXTINGUISHER CABINET
  - Detail Number
  - DETAIL REFERENCE
  - Sheet Number
  - CORNER GUARD
  - FLOOR DRAIN, SEE PLUMBING
  - NEW COLOR CONTRAST TRANSITION RUBBER
  - SPOT
  - N.L.C. UNLESS OTHERWISE NOTED
  - U.O.N. FIELD VERIFY
  - NEW WALL
  - EXISTING STUD WALL
  - EXISTING MASONRY WALL

WALL TYPES SCHEDULE		THICKNESS	
		ACTUAL	NOMINAL
A	STANDARD WALL TYPE UNLESS OTHERWISE NOTED. 3 5/8" METAL STUDS @ 16" O.C. WITH 5/8" GYP. BD. EACH SIDE. EXTEND TO 4" ABOVE CEILING U.O.N. PROVIDE "SOUND BATTIS" AS NOTED.	4 7/8"	5"
B	3/4" METAL STUDS W/ (2) LAYER 5/8" TYPE X GYPSUM BOARD EACH SIDE. EXTEND PARTITION TO STRUCTURE ABOVE. (UL DESIGN RUGES, 1 HR.)	4 7/8"	5"
C	2 1/2" METAL "C" CH" OR "E" STUDS W/ (2) LAYER 1" TYPE X GYPSUM LINER PANEL INSERTED BETWEEN STUDS ONE SIDE, (2) LAYERS 5/8" TYPE C GYP. BOARD ON OTHER SIDE. EXTEND PARTITION TO STRUCTURE ABOVE. (UL DESIGN RUGES, 2 HR.)	3 1/8"	3"
D	3 5/8" METAL STUDS @ 16" O.C. WITH 5/8" MOISTURE AND MILD. RESISTANT GYPSUM BOARD. EXTEND TO 4" ABOVE CEILING U.O.N. PROVIDE "SOUND BATTIS" AS NOTED.	6 5/8"	7"
E	3 5/8" METAL STUDS @ 16" O.C. WITH 5/8" GYP. BD. EACH SIDE. EXTEND TO 4" ABOVE CEILING U.O.N. PROVIDE "SOUND BATTIS" AS NOTED.	5 7/8"	6"

NOTE: PROVIDE "SOUND BATTIS" IN ALL HALLS AND ABOVE CEILING OF THE PROVIDER OFFICES, EXAM ROOMS, SHINE EXAM, EXAM/TREATMENT, TOILETS, SINKS, X-RAY PROCESSING, SUCTION/STORAGE, MECHANICAL ROOMS.

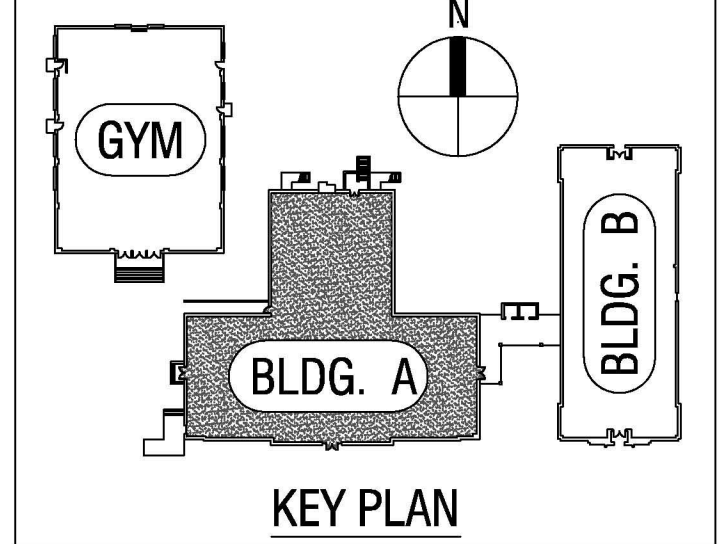

no. revisions

- ADDENDUM #4, 01/13/11
- BLDG CODE REVIEW, 01/25/11

**RECORD DOCUMENT**  
1-31-12

THESE DOCUMENTS HAVE BEEN PREPARED FROM INFORMATION RECEIVED FROM THE CONTRACTOR.

The use of these plans and specifications shall be restricted to the original site for which they were prepared and publication thereof is expressly limited to such use. Re-use, reproduction, or publication by any means, in whole or in part, is prohibited. Title to the plans and specifications remain in the architect's office. If it is to be returned upon request to the architect. Field contact with these plans and specifications shall constitute prima facie evidence of the acceptance of these restrictions.

drawn checked

**BUILDING A  
BASEMENT LEVEL  
RENOVATIONS PLAN**


sheet

**A1.22**


of total

project no. 1001

date 12-20-2010

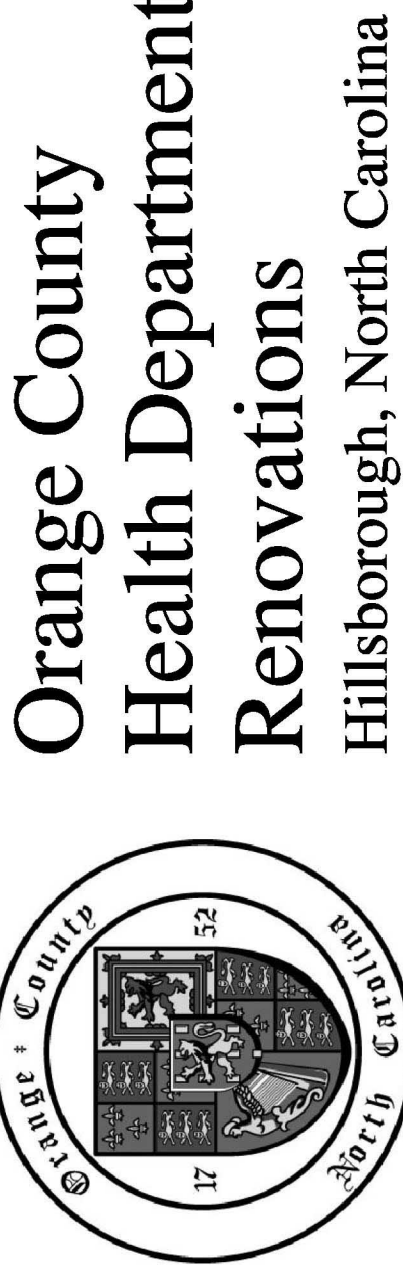

1 Basement Level - Renovations Plan  
A1.23 Scale: 1/4" = 1'-0" BUILDING A

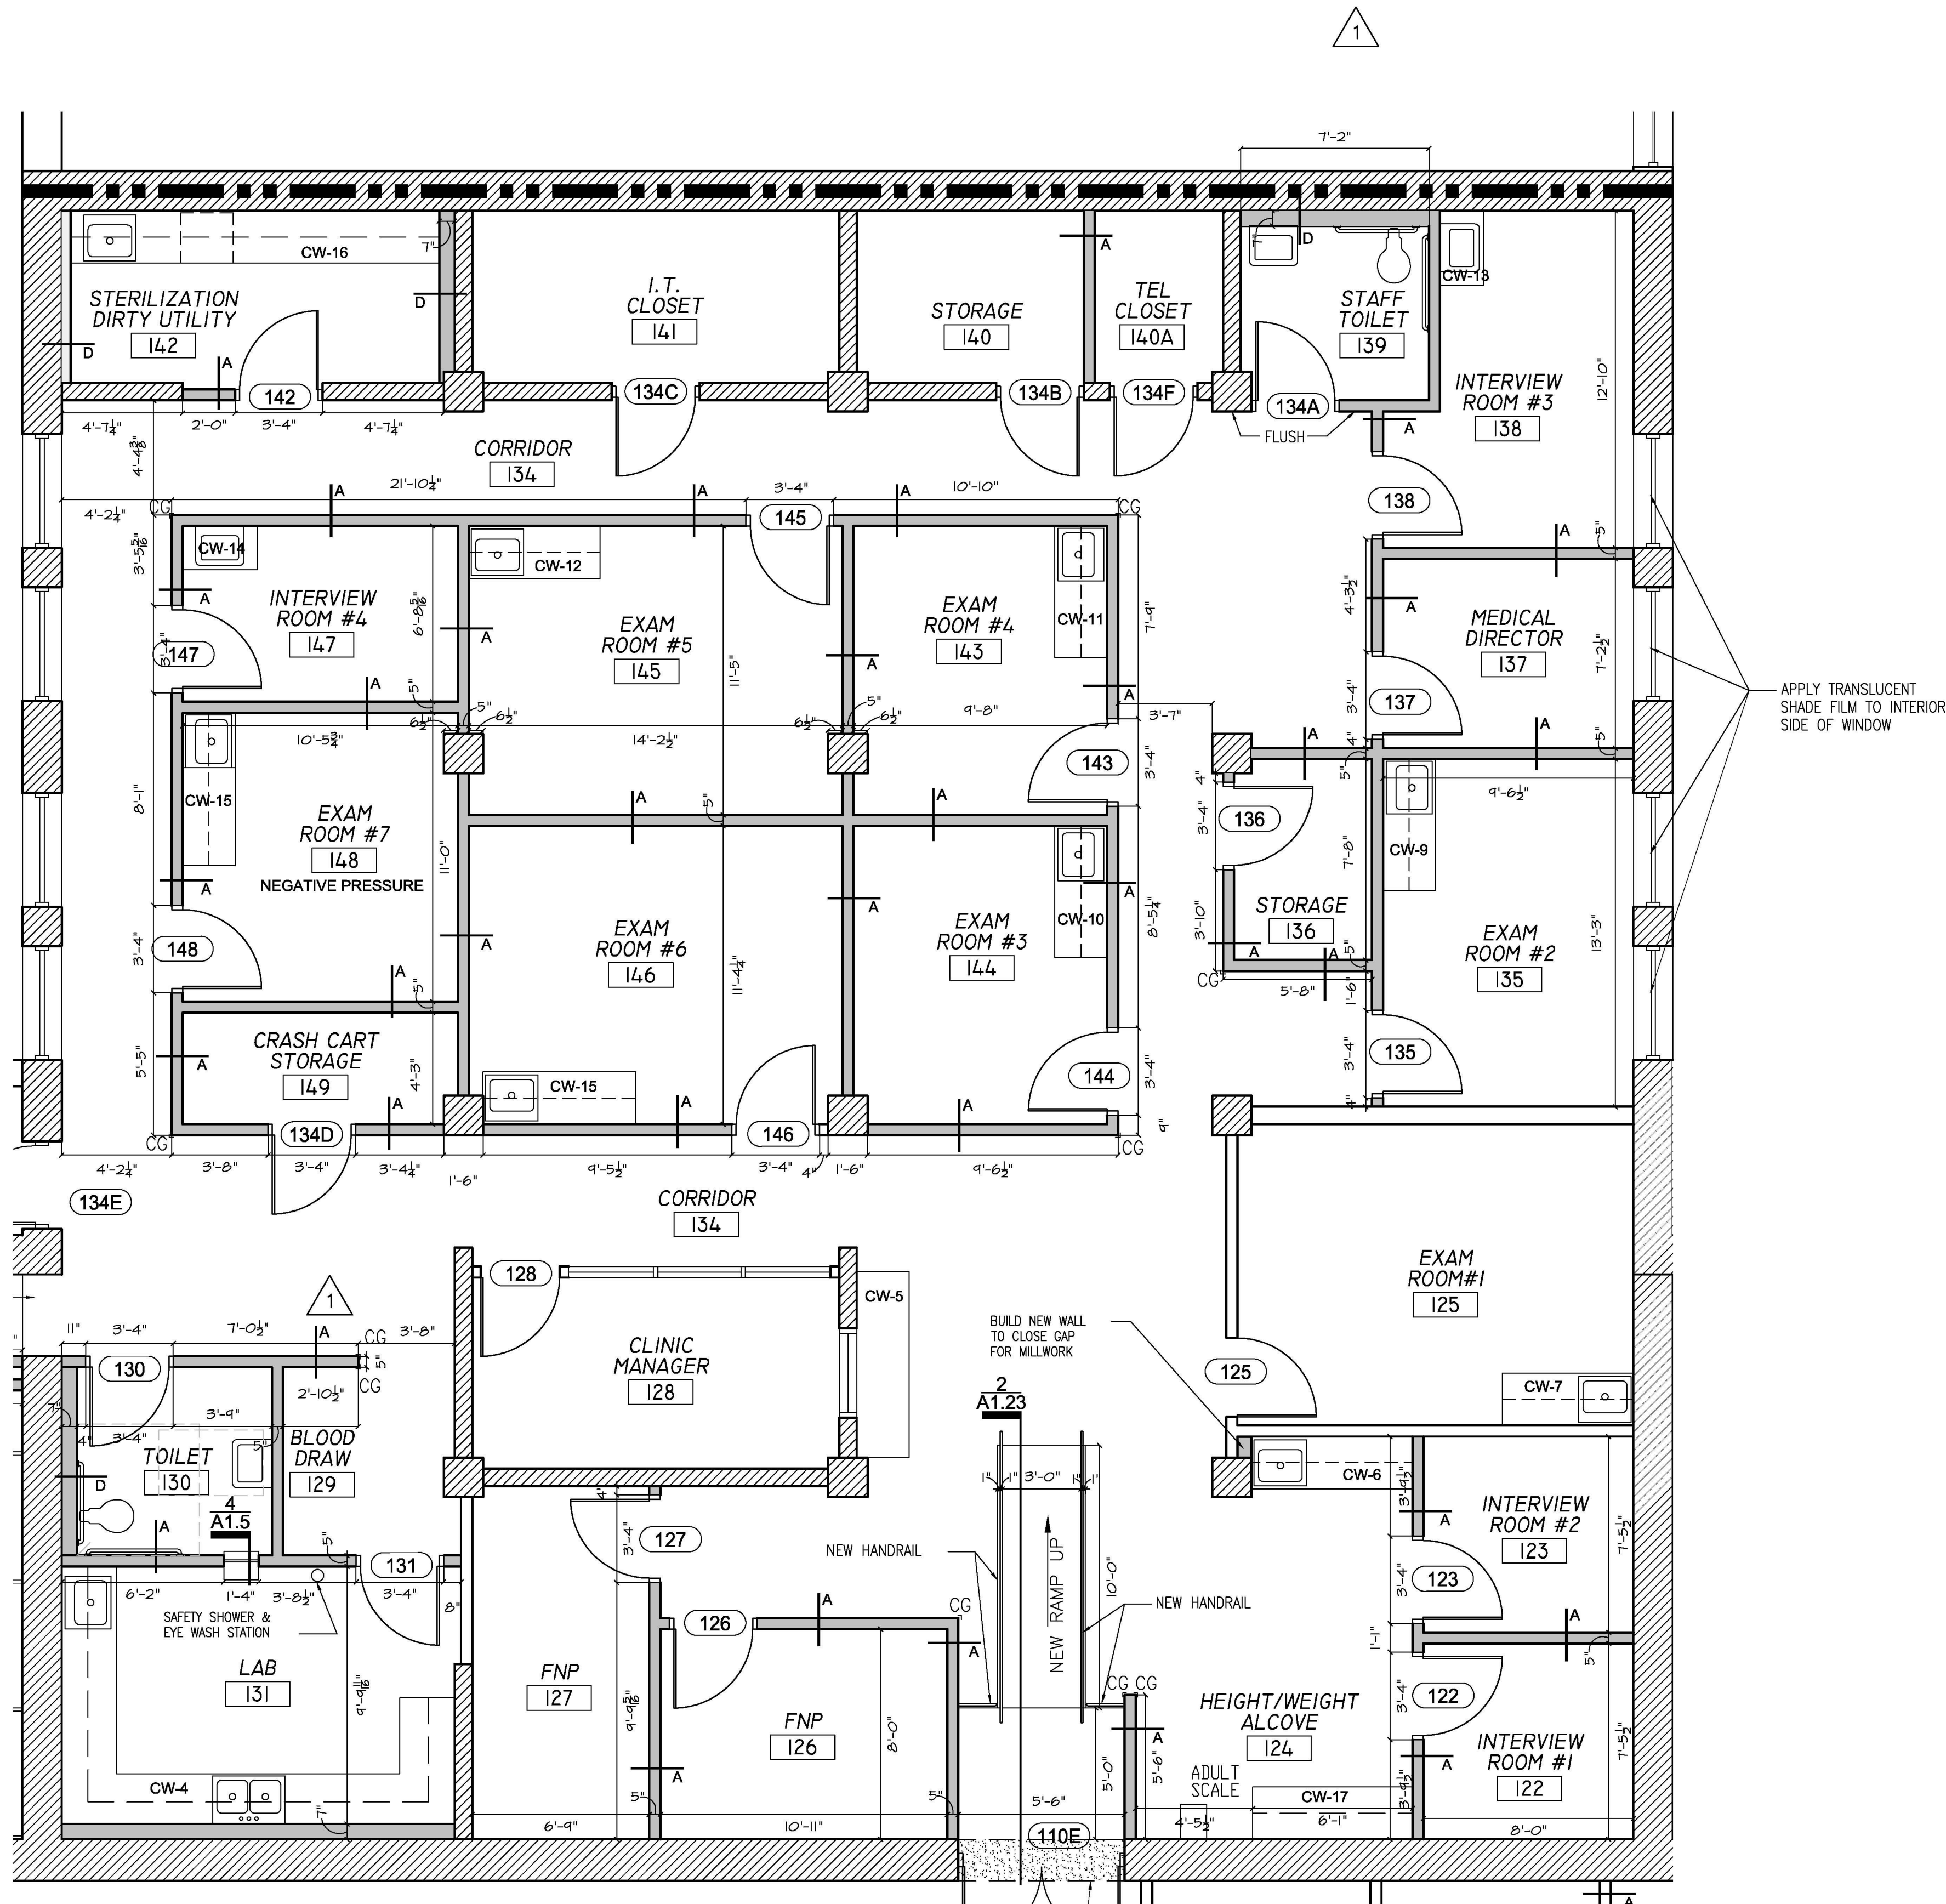


GENERAL NOTES

- NEW FINISH FLOOR SHALL MATCH EXISTING FINISH FLOOR. FIELD VERIFY EXISTING FINISH FLOOR ELEVATION OF 100.42.
- STANDARD WALL TYPE OF NEW INTERIOR PARTITIONS IS TYPE "A" UNLESS OTHERWISE NOTED.
- FIELD VERIFY EXISTING CONDITIONS AND NOTIFY ARCHITECT OF ANY DISCREPANCIES ON THE DRAWINGS.
- PROVIDE CONTRASTING COLOR STRIP (RTI) WHERE INDICATED
- MAINTAIN THE EXISTING BUILDING IN A WEATHER TIGHT CONDITION THROUGHOUT THE CONSTRUCTION PERIOD AND REPAIR ANY DAMAGE CAUSED BY CONSTRUCTION OPERATIONS.

LEGEND

- WALL TYPE, SEE SCHEDULE
- 103 DOOR NUMBER
- ALUMINUM FRAME / WINDOW TYPE
- CW-1 CASEWORK (SEE DETAILS)
- TA-1 TOILET ACCESSORY
- REC FIRE EXTINGUISHER CABINET
- Detail Number
- 1 ALZ DETAIL REFERENCE
- Sheet Number
- CORNER GUARD
- FLOOR DRAIN, SEE PLUMBING
- NEW COLOR CONTRAST TRANSITION RUBBER
- SPOT
- N.L.C. CONTRACT
- U.D.N. UNLESS OTHERWISE NOTED
- F.V. FIELD VERIFY
- NEW WALL
- EXISTING STUD WALL
- EXISTING MASONRY WALL

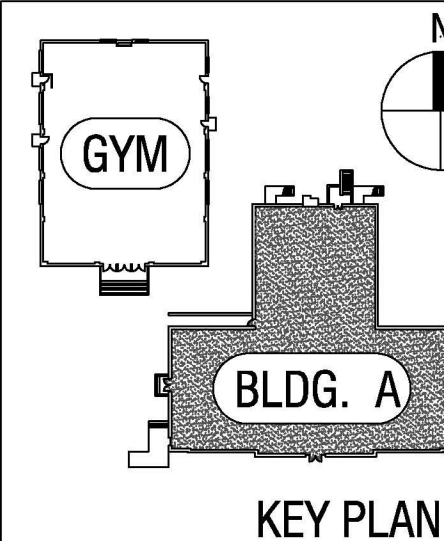

WALL TYPES SCHEDULE

			THICKNESS	
			ACTUAL	NOMINAL
A	STANDARD WALL TYPE UNLESS OTHERWISE NOTED. 3 5/8" METAL STUDS @ 16" O.C. WITH 5/8" GYP. BO. EACH SIDE. EXTEND TO 4" ABOVE CEILING UO.N. PROVIDE "SOUND BATTS" AS NOTED.		4 7/8"	5"
B	2 3/4" METAL STUDS W/ (1) LAYER 5/8" TYPE X GYPSUM BOARD EACH SIDE. EXTEND PARTITION TO STRUCTURE ABOVE. (UL DESIGN #14380, 2 HR.)		4 7/8"	5"
C	2 3/4" METAL STUDS W/ (1) LAYER 1" TYPE X GYPSUM LINER PANEL INSERTED BETWEEN STUDS ONE SIDE. (2) LAYERS 5/8" TYPE C GYP. BOARD ON OTHER SIDE. EXTEND PARTITION TO STRUCTURE ABOVE. (UL DESIGN #14380, 2 HR.)		3 1/8"	3"
D	3 5/8" METAL STUDS @ 16" O.C. WITH 5/8" MOISTURE AND MOLD RESISTANT GYPSUM BOARD EXTEND TO 4" ABOVE CEILING UO.N. PROVIDE "SOUND BATTS" AS NOTED.		6 5/8"	7"
E	3 5/8" METAL STUDS @ 16" O.C. WITH 5/8" GYP. BO. EACH SIDE. EXTEND TO 4" ABOVE CEILING UO.N. PROVIDE "SOUND BATTS" AS NOTED.		5 7/8"	6"

NOTE: PROVIDE "SOUND BATTS" IN ALL WALLS AND ABOVE CEILING OF THE FOLLOWING ROOMS: EXAM ROOMS, EXAM TREATMENT, TOILETS, SHOWER, X-RAY PROCESSING, STORAGE, MECHANICAL ROOMS.

- no. revisions
- PLAN REVIEW COMMENTS, 01/31/11
  - OWNER REQUEST, 02/25/11

RECORD DOCUMENT

1-31-12

THESE DOCUMENTS WERE PREPARED FROM INFORMATION RECEIVED FROM THE CONTRACTOR.

The use of these plans and specifications shall be restricted to the original plan for which they were prepared and publication thereof is expressly limited to such use. Re-use, reproduction, or publication by any method in whole or in part is prohibited. Title to the plans and specifications remain in the architect without prejudice. It is to be returned upon request to the architect. Visual contact with these plans and specifications shall constitute prima facie evidence of the acceptance of these restrictions.

drawn checked

BUILDING A BASEMENT LEVEL RENOVATIONS PALM


sheet

A1.23

of total

project no. 1001

date 12-20-2010

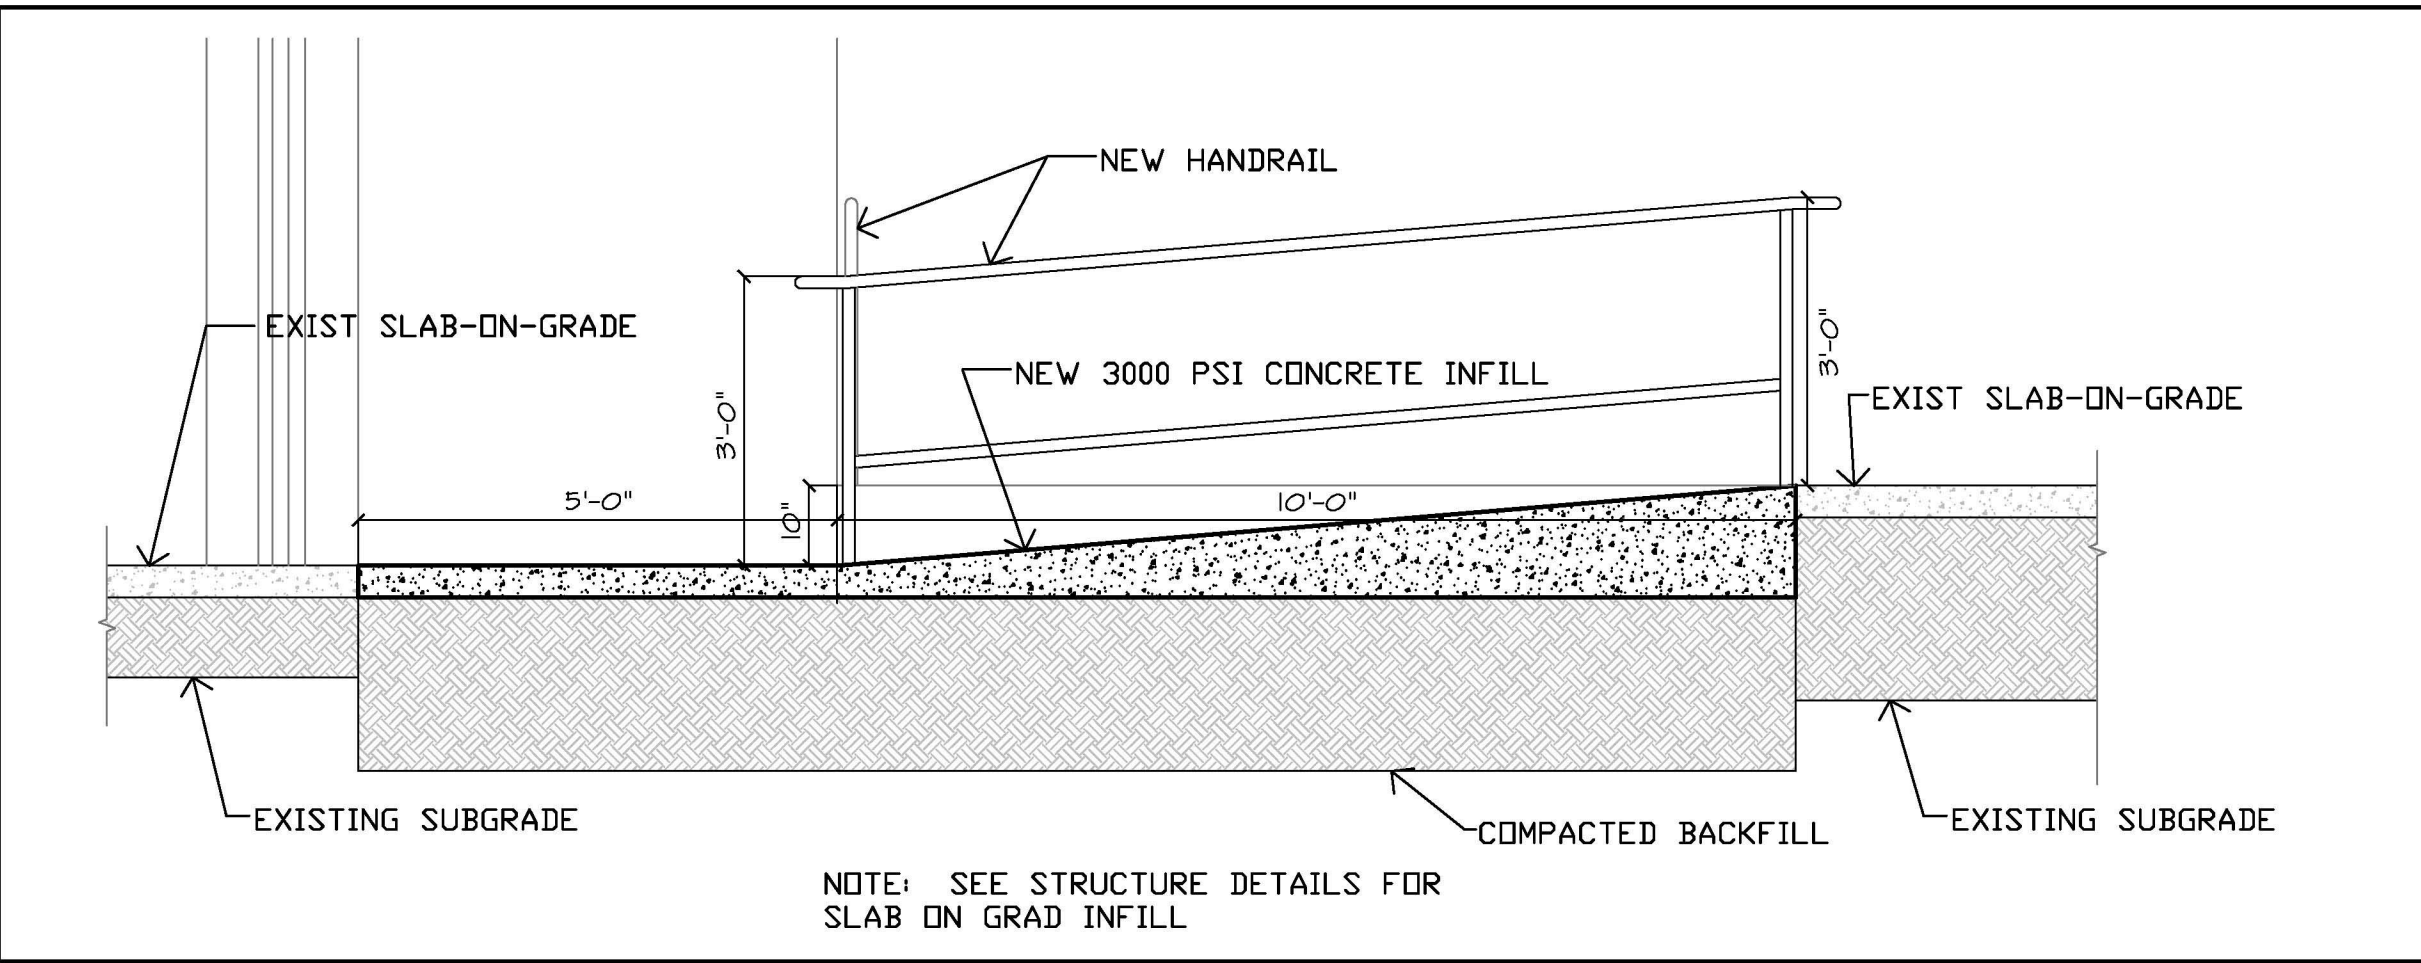


2


A1.23

Section @ New Ramp

Scale: 1/2" = 1'-0"

BUILDING A

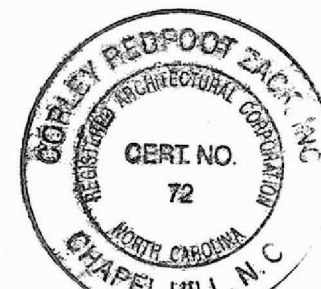

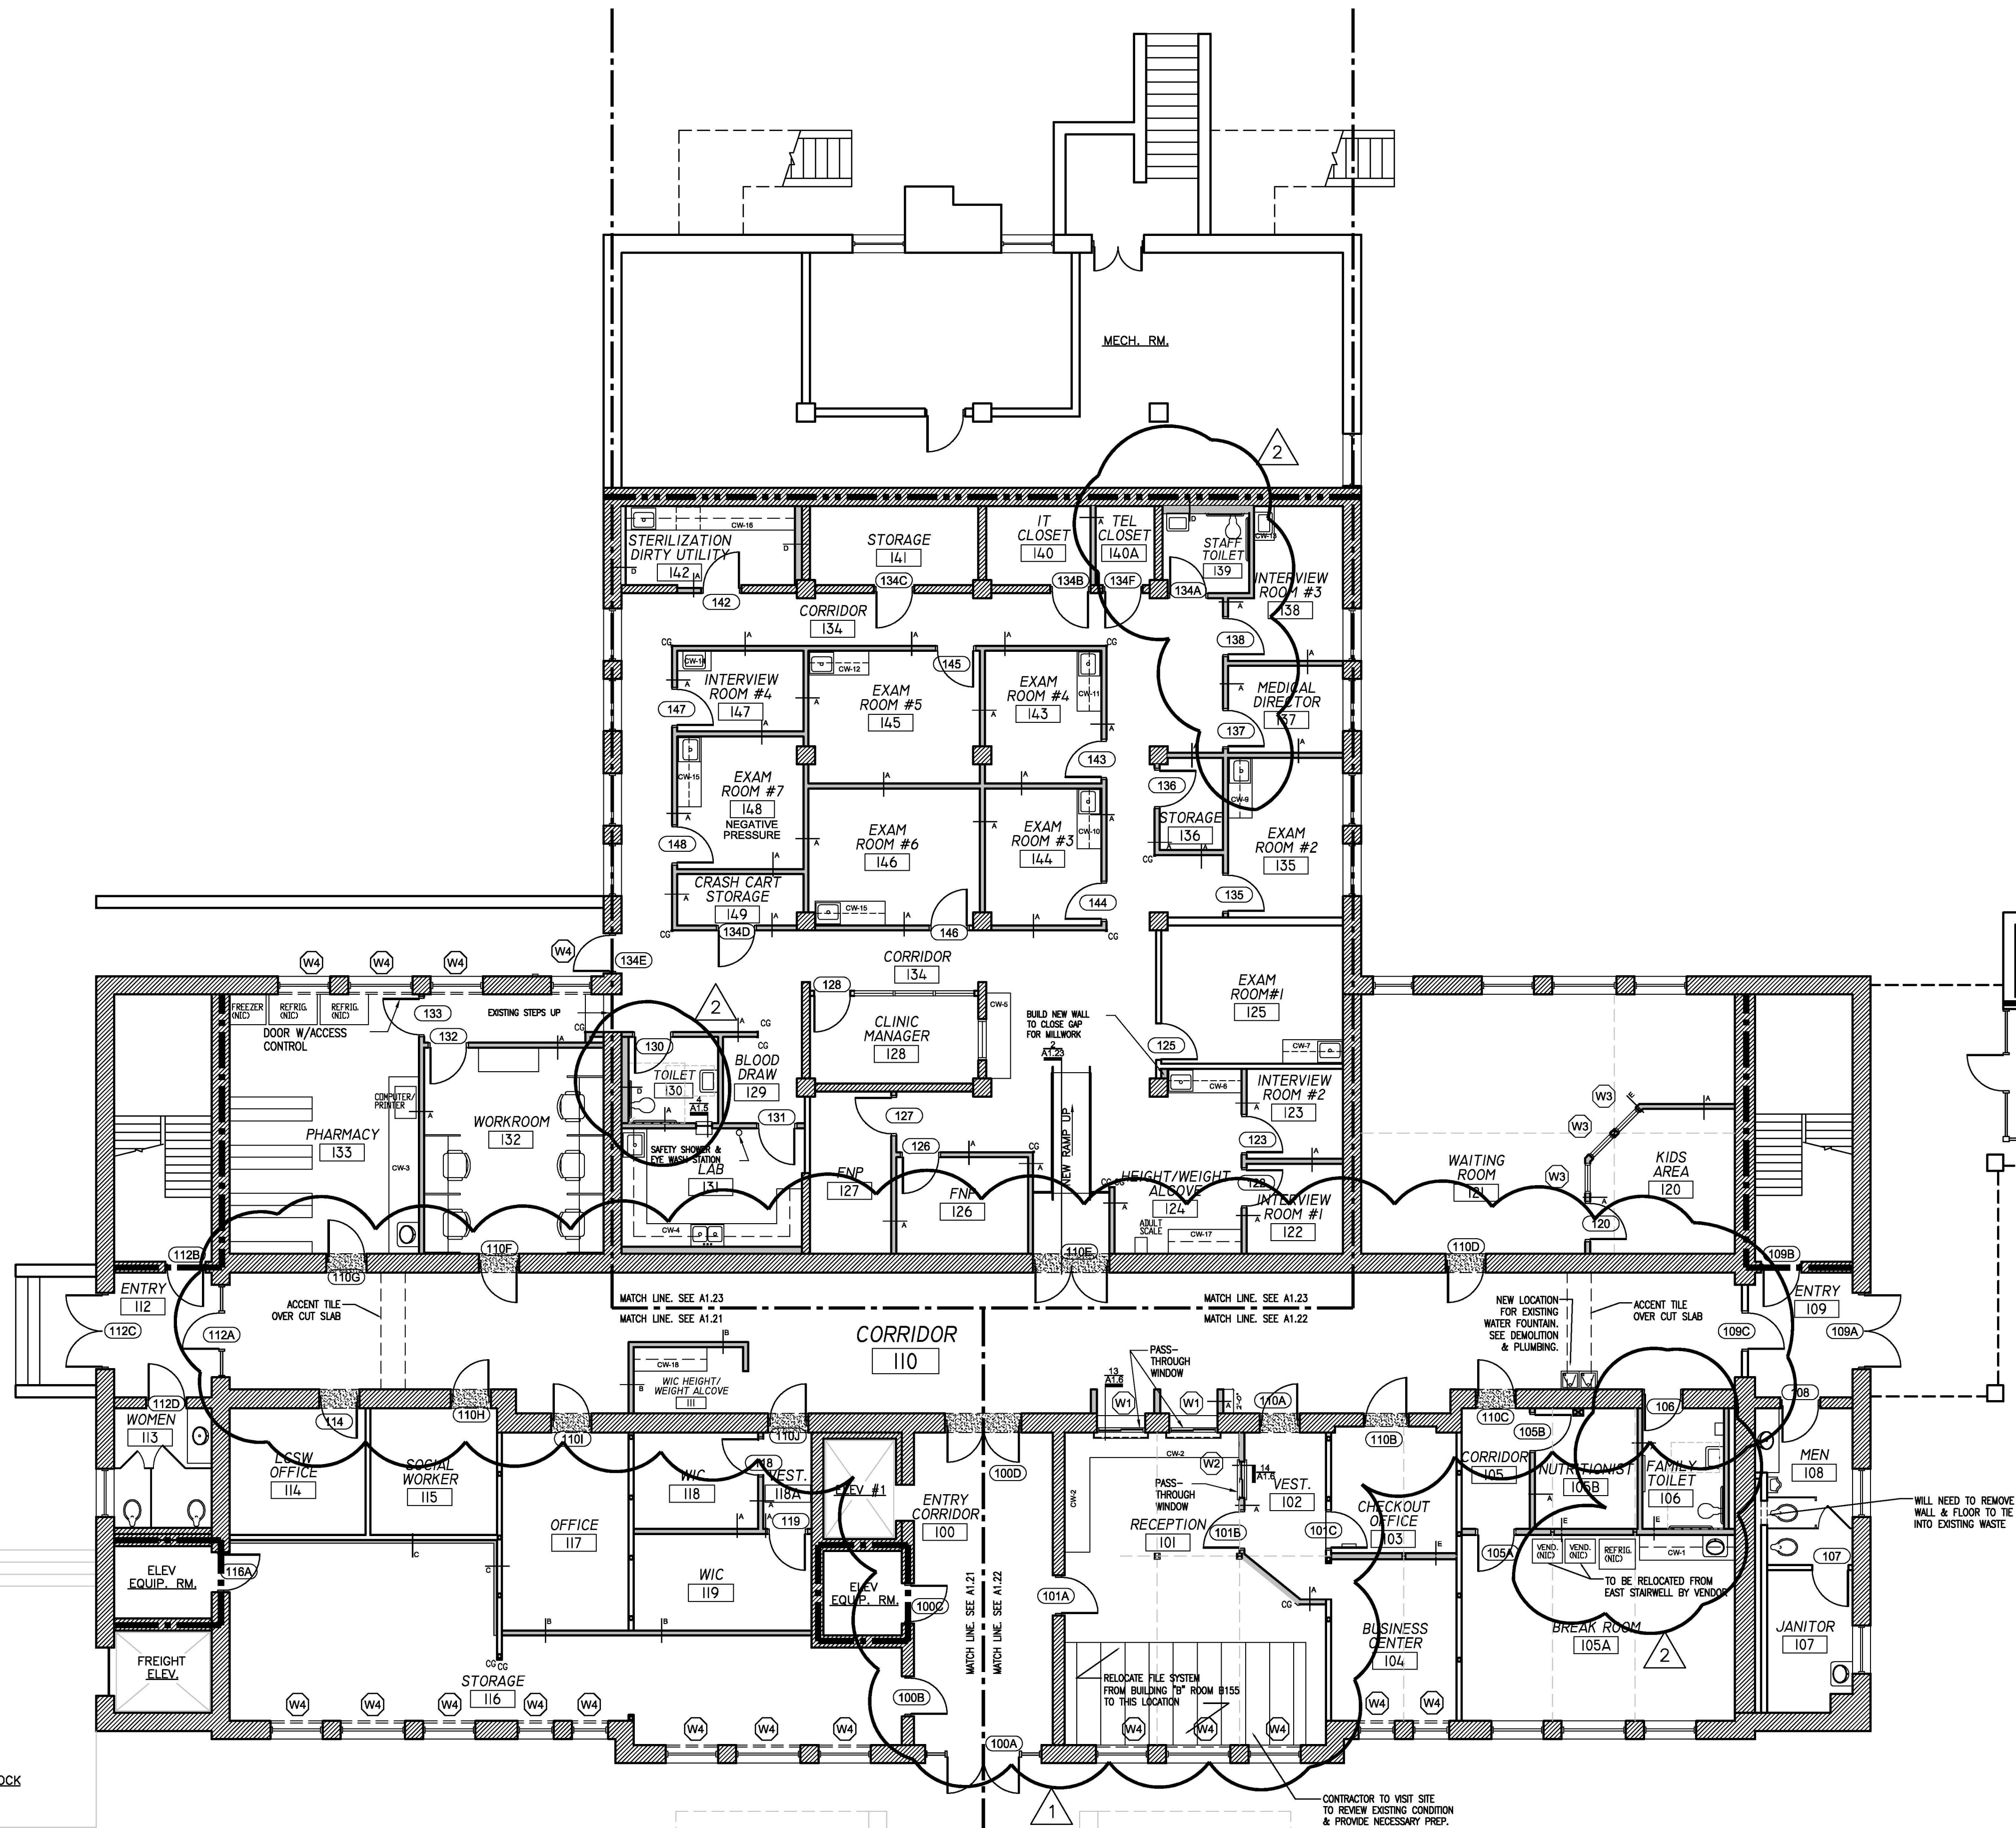

**GENERAL NOTES**


- NEW FINISH FLOOR SHALL MATCH EXISTING FINISH FLOOR. FIELD VERIFY EXISTING FINISH FLOOR ELEVATION OF 100.42.
- STANDARD HALL TYPE OF NEW INTERIOR PARTITIONS IS TYPE "A" UNLESS OTHERWISE NOTED.
- FIELD VERIFY EXISTING CONDITIONS AND NOTIFY ARCHITECT OF ANY DISCREPANCIES ON THE DRAWINGS.
- PROVIDE CONTRASTING COLOR STRIP (RTU) WHERE INDICATED.
- MAINTAIN THE EXISTING BUILDING IN A WEATHER TIGHT CONDITION THROUGHOUT THE CONSTRUCTION PERIOD AND REPAIR ANY DAMAGE CAUSED BY CONSTRUCTION OPERATIONS.

**LEGEND**

— A WALL TYPE, SEE SCHEDULE  
103 DOOR NUMBER  
ALU ALUMINUM FRAME / WINDOW TYPE  
CW-1 CASEWORK (SEE DETAILS)  
1A-1 TOILET ACCESSORY  
FIC FIRE EXTINGUISHER CABINET  
Detail Number:  
Sheet Number:  
CORNER GUARD  
F.D. FLOOR DRAIN, SEE PLUMBING  
NEW COLOR CONTRAST TRANSITION RUBBER  
SPOT REFINISH CONTRACT  
UNLESS OTHERWISE NOTED  
F.V. FIELD VERIFY  
NEW WALL  
EXISTING MASONRY WALL  
1-HOUR RATED PARTITION

WALL TYPES SCHEDULE		THICKNESS	
		ACTUAL	NOMINAL
A	STANDARD WALL TYPE UNLESS OTHERWISE NOTED. 3 5/8" METAL STUDS @ 16" O.C. WITH 5/8" GYP. BD. EACH SIDE. EXTEND TO 4" ABOVE CEILING U.O.N. PROVIDE "SOUND BATTIS" AS NOTED.	4 7/8"	5"
B	3/4" METAL STUDS W/ (2) LAYER 5/8" TYPE X GYPSUM BOARD EACH SIDE. EXTEND PARTITION TO STRUCTURE ABOVE. (UL DESIGN R445B), 1 HR.	4 7/8"	5"
C	2 1/2" METAL "C" CH" DR. "E" STUDS W/ (2) LAYER 1" TYPE X GYPSUM LINER PANEL INSERTED BETWEEN STUDS ONE SIDE, (2) LAYERS 5/8" TYPE C GYP. BOARD ON OTHER SIDE. EXTEND PARTITION TO STRUCTURE ABOVE. (UL DESIGN R445B), 2 HR.	3 1/8"	3"
D	3 5/8" METAL STUDS @ 16" O.C. WITH 5/8" MOISTURE AND MILD. RESISTANT GYPSUM BOARD EXTEND TO 4" ABOVE CEILING U.O.N. PROVIDE "SOUND BATTIS" AS NOTED.	6 5/8"	7"
E	3 5/8" METAL STUDS @ 16" O.C. WITH 5/8" GYP. BD. EACH SIDE. EXTEND TO 4" ABOVE CEILING U.O.N. PROVIDE "SOUND BATTIS" AS NOTED.	5 7/8"	6"

NOTE: PROVIDE "SOUND BATTIS" IN ALL HALLS AND ABOVE CEILING OF THE PROVIDER OFFICES, EXAM ROOMS, SHINE EXAM, EXAM/TREATMENT, TOILETS, SINKERS, X-RAY PROCESSING, SUCTION/STORAGE, MECHANICAL ROOMS.

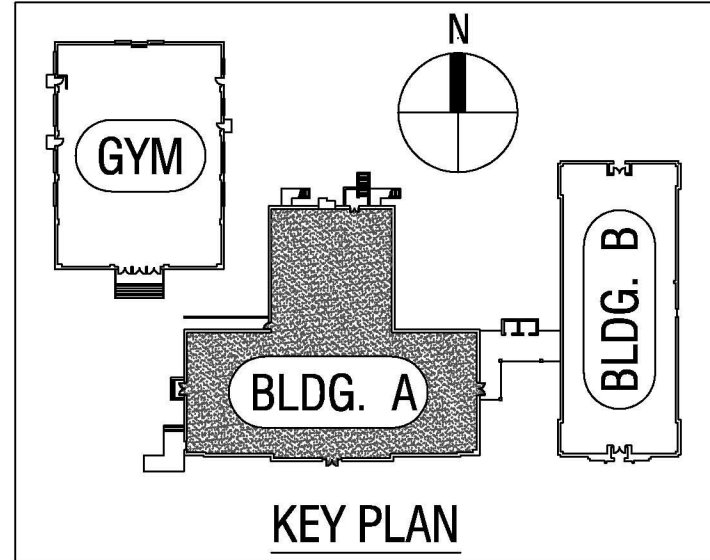

no. revisions

- ADDENDUM #4, 01/13/11
- PLAN REVIEW COMMENTS, 01/31/11

**RECORD DOCUMENT 1-31-12**

THESE DOCUMENTS HAVE BEEN PREPARED FROM INFORMATION RECEIVED FROM THE CONTRACTOR.

The use of these plans and specifications shall be restricted to the original site for which they were prepared and publication thereof is expressly limited to such use. Re-use, reproduction, or publication by any means, in whole or in part, is prohibited. Title to the plans and specifications remain in the architect without prejudice. It is to be returned upon request to the architect. Work conform with these plans and specifications shall constitute prima facie evidence of the acceptance of these restrictions.

drawn checked

**BUILDING A BASEMENT LEVEL RENOVATIONS PALN**

sheet

**A1.2**

of total

project no. 1001

date 12-20-2010

**CORLEY REDFOOT ZACK INC.**  
ARCHITECTS • ENGINEERS • PLANNERS  
P.O. Box 2368, Chapel Hill, North Carolina 919 401-8586

**Orange County Health Department Renovations**  
Hillsborough, North Carolina

**RECORD DOCUMENT 1-31-12**

THESE DOCUMENTS HAVE BEEN PREPARED FROM INFORMATION RECEIVED FROM THE CONTRACTOR.

The use of these plans and specifications shall be restricted to the original site for which they were prepared and publication thereof is expressly limited to such use. Re-use, reproduction, or publication by any means, in whole or in part, is prohibited. Title to the plans and specifications remain in the architect without prejudice. It is to be returned upon request to the architect. Work conform with these plans and specifications shall constitute prima facie evidence of the acceptance of these restrictions.

drawn checked

**BUILDING A BASEMENT LEVEL RENOVATIONS PALN**

sheet

**A1.2**

of total

project no. 1001

date 12-20-2010



Orange County  
Health Department  
Renovations  
Hillsborough, North Carolina



- no. revisions
1. ADDENDUM #3, 01/7/11
  2. ADDENDUM #4, 01/13/11
  3. PLAN REVIEW COMMENTS, 01/31/11

RECORD  
DOCUMENT  
1-31-12

THESE DOCUMENTS HAVE BEEN PREPARED FROM INFORMATION RECEIVED FROM THE CONTRACTOR.

The use of these plans and specifications shall be restricted to the original site for which they were prepared and publication thereof is prohibited. In no case shall re-use, reproduction, or publication by any method, in whole or in part, be permitted. Title to the plans and specifications remain in the architect without prejudice. It is to be returned upon request to the architect. Visual contact with these plans and specifications shall constitute prima facie evidence of the acceptance of these restrictions.

drawn checked

BUILDING A  
ENLARGED PLANS &  
TOILET ACCESSORIES


sheet

A1.3


of total

project no. 1001


date 12-20-2010

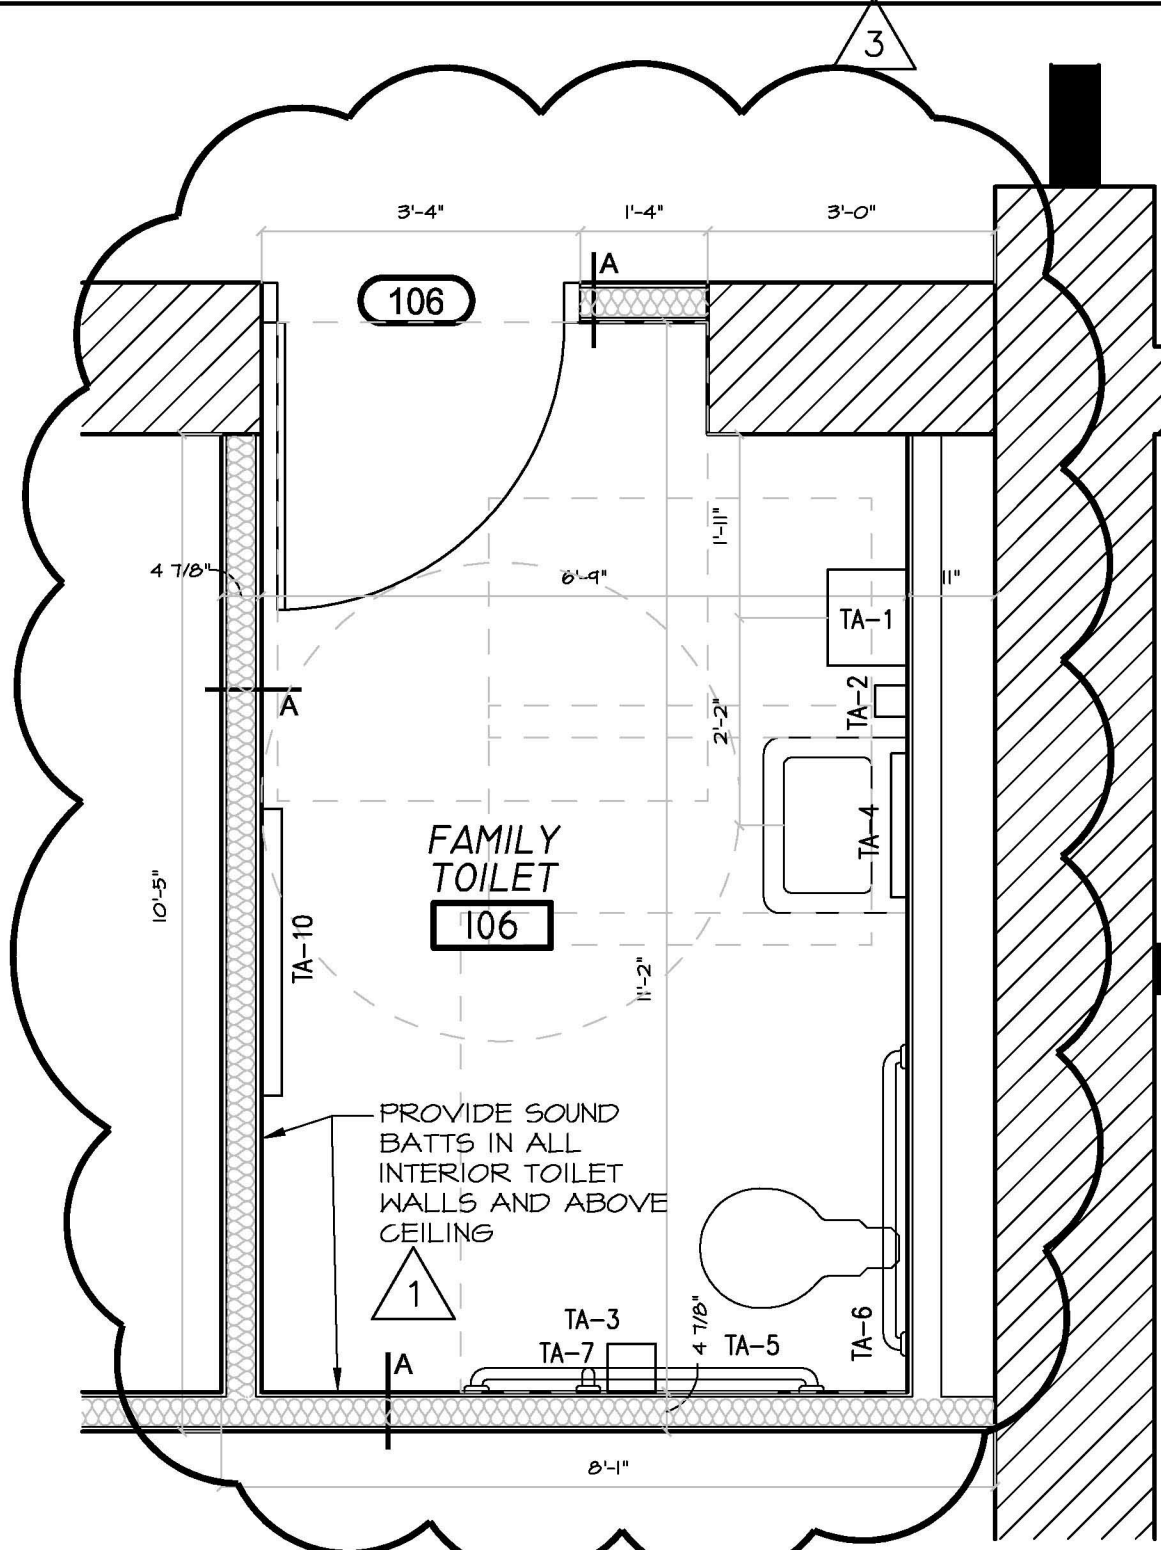


1 Family Toilet # 106 Enlarged Plan  
A1.3 Scale: 1/2" = 1'-0" BUILDING A

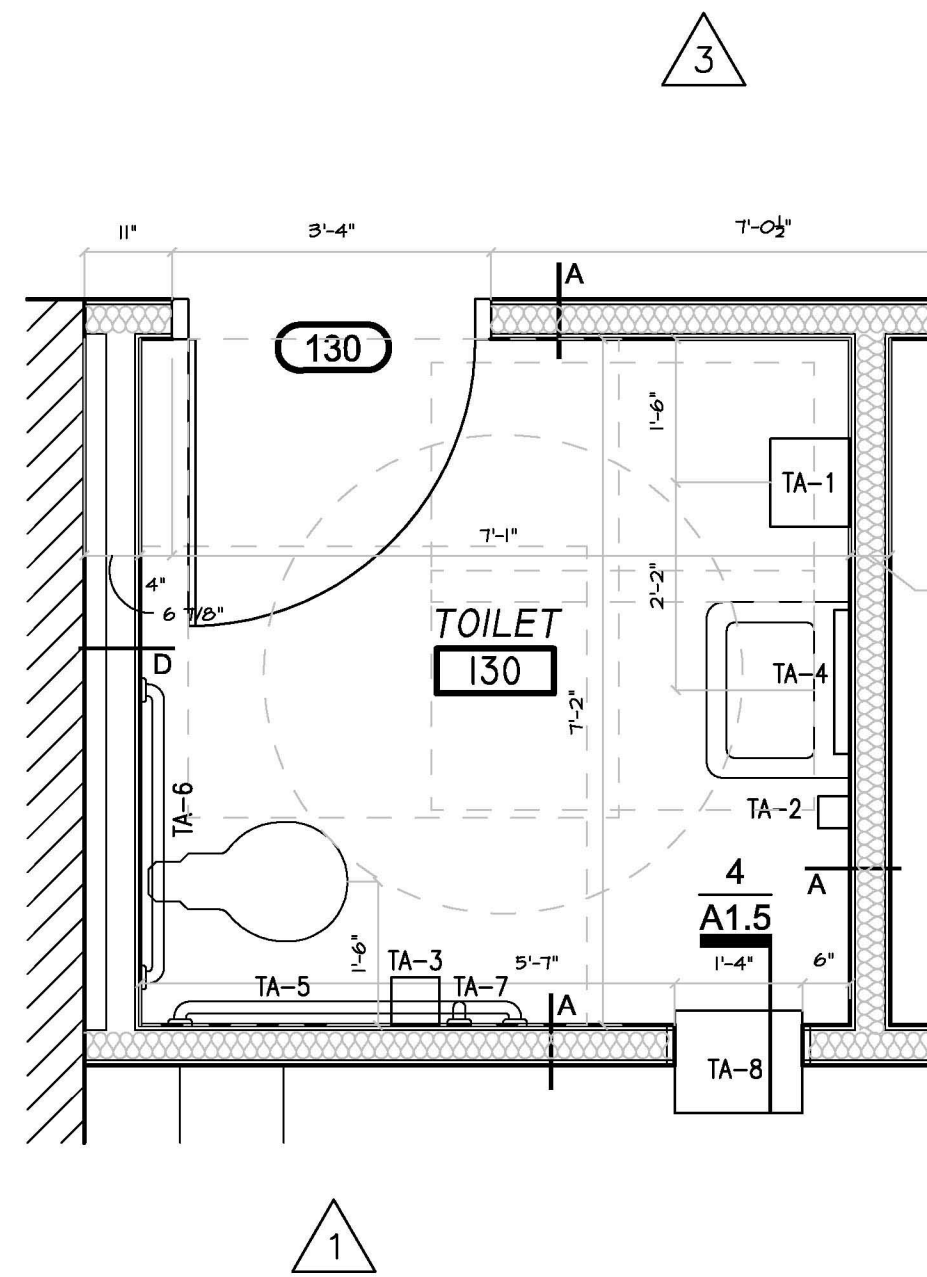

2 Toilet # 130 Enlarged Plan  
A1.3 Scale: 1/2" = 1'-0" BUILDING A

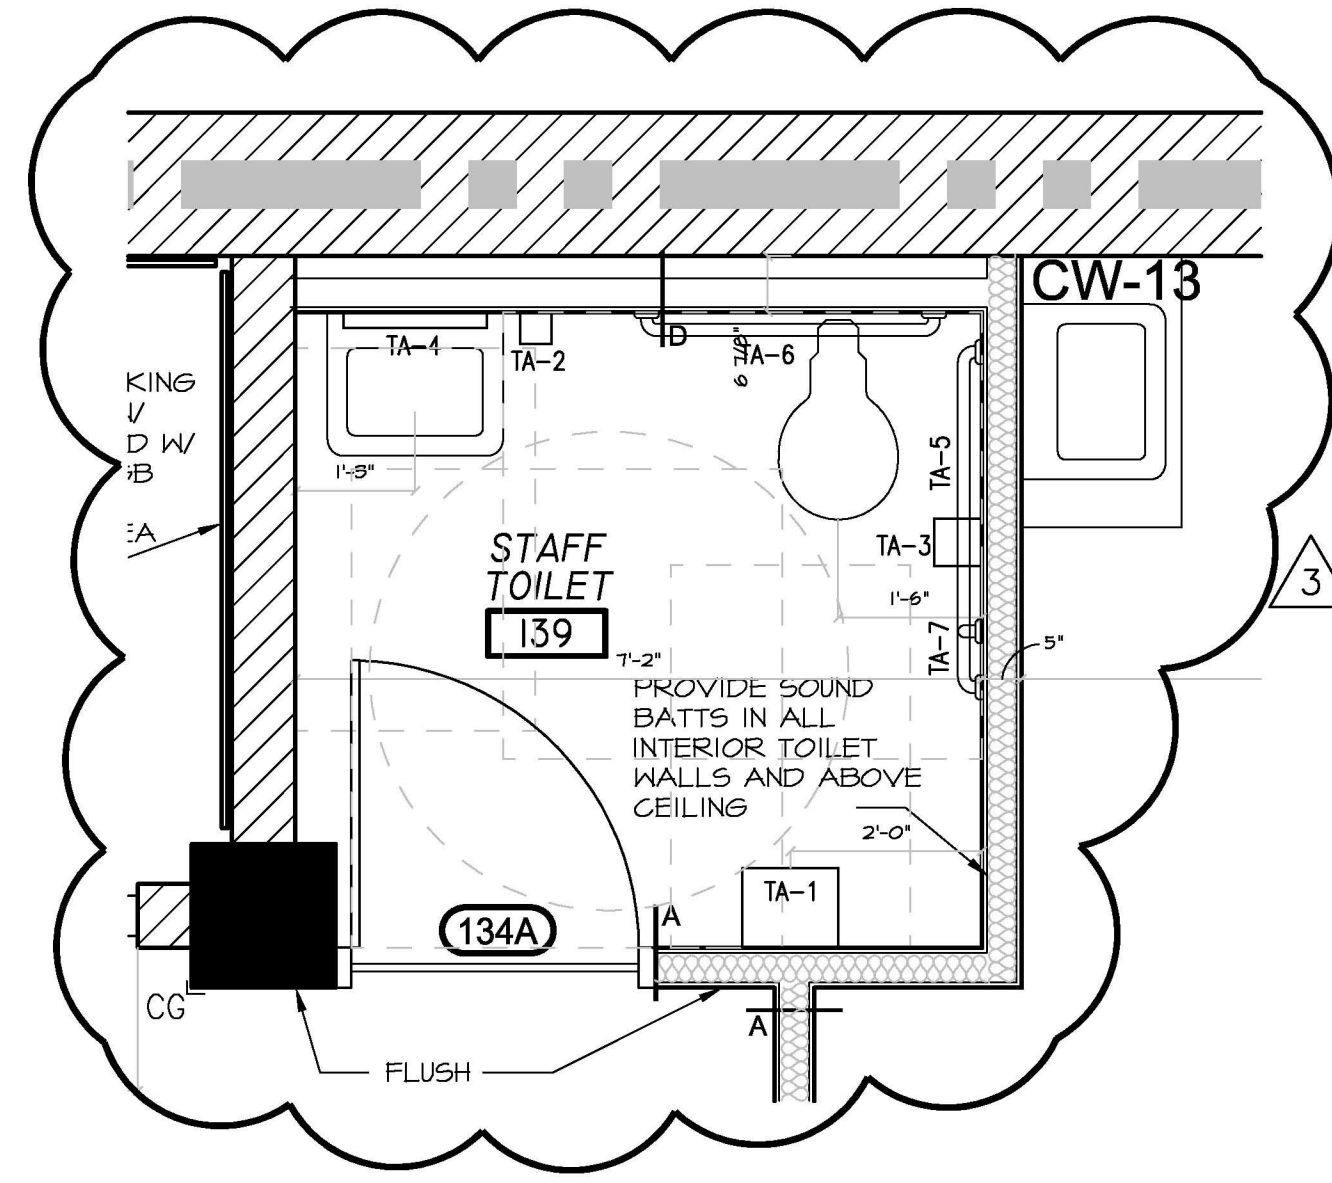


3 Staff Toilet # 139 Enlarged Plan  
A1.3 Scale: 1/2" = 1'-0" BUILDING A

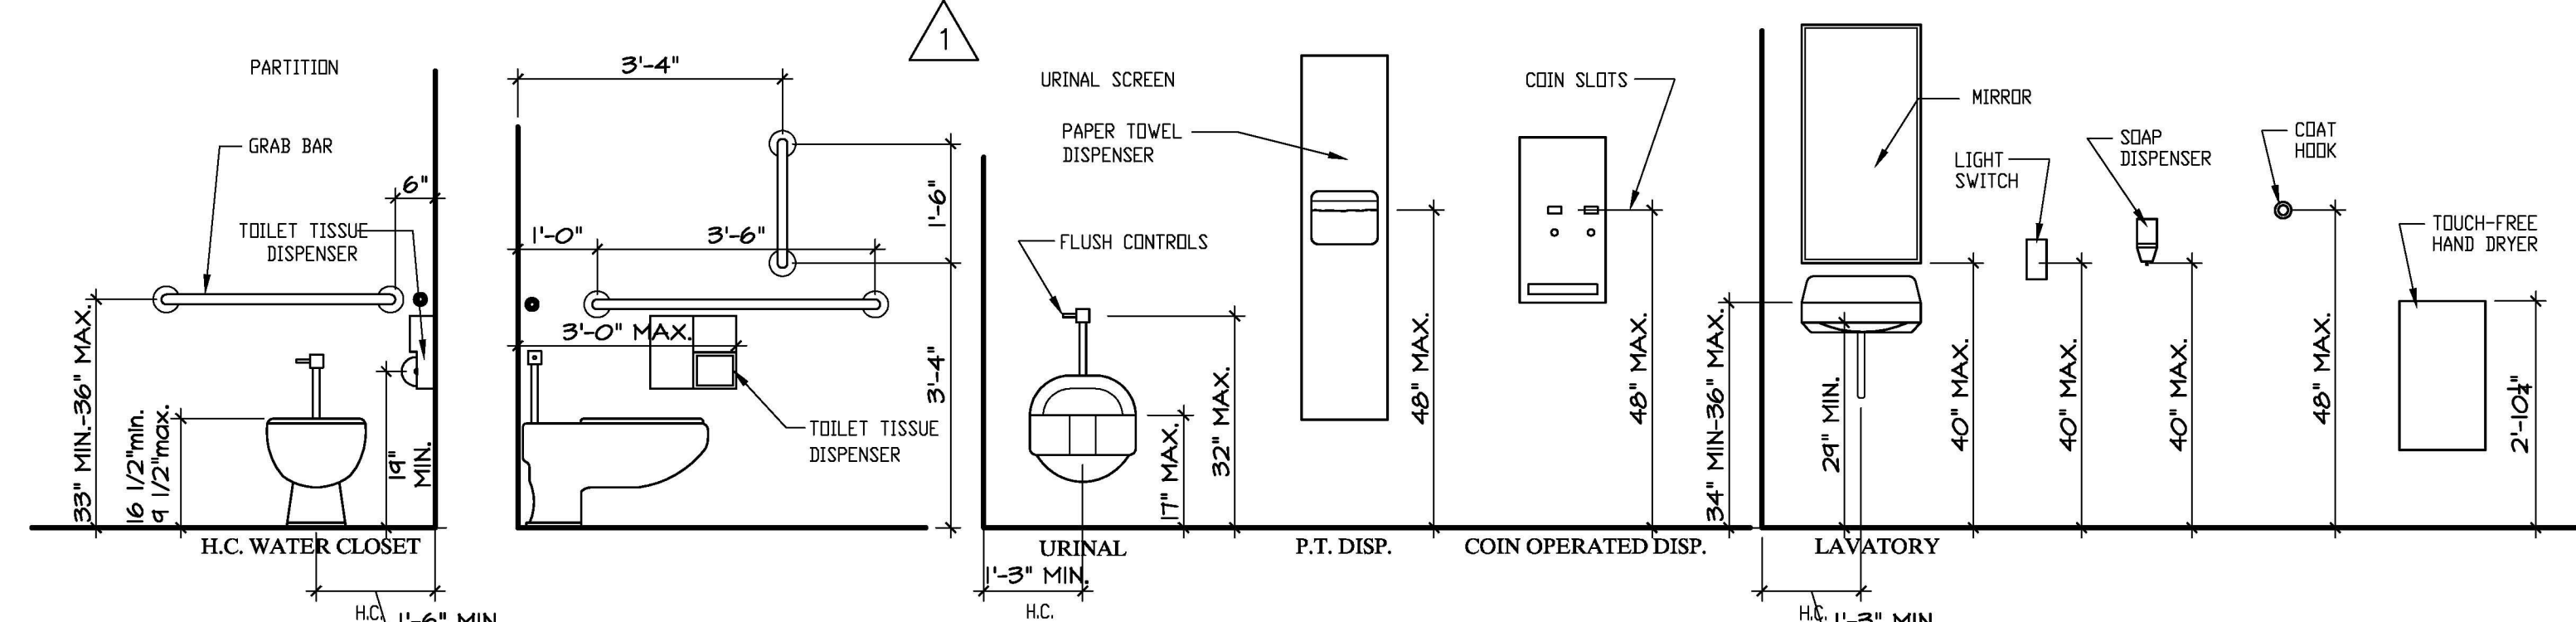


Typical Mounting Heights  
Scale: 1/2" = 1'-0" BUILDING A

Toilet Accessories Schedule

NO.	MANUFACTURER	MODEL #	DESCRIPTION	REMARKS
TA-1	DYSON	AIRBLADE AB04	TOUCH-FREE AUTOMATIC HAND DRYER - surface mounted, grey	OWNER FURNISHED
TA-2	STERIS CORP.	SDS *	SOAP DISPENSER * Steris Corporation (phone 1-800-548-4873)	OWNER FURNISHED
TA-3	BOBRICK	B-288	TOILET TISSUE DISPENSER - surface mounted, double-roll	OWNER FURNISHED
TA-4	BOBRICK	B-165-1836	MIRROR - polished stainless steel 18" X 36"	
TA-5	BOBRICK	B-5806.99-42	42" GRAB BAR - 1 1/4" diam, stainless steel with snap-flange cover	
TA-6	BOBRICK	B-5806.99-36	36" GRAB BAR - 1 1/4" diam, stainless steel with snap-flange cover	
TA-7	BOBRICK	B-5806.99-18	18" VERTICAL GRAB BAR - 1 1/4" diam, stainless steel with snap-flange cover	
TA-8	BRADLEY	9813	SPECIMEN PASS-THRU CABINET	
TA-9				NOT USED
TA-10	RUBBERMAID	7818-88	DIAPER-CHANGING STATION	
TA-11	BOBRICK	B-270	SANITARY NAPKIN DISPOSAL - surface mounted	

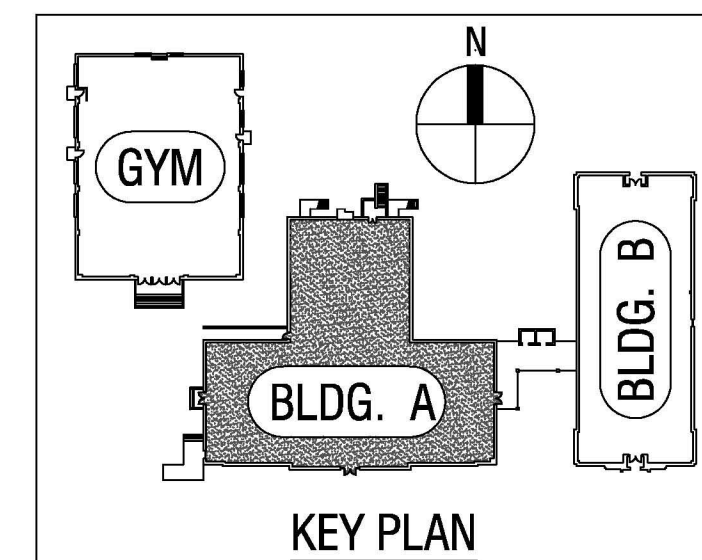

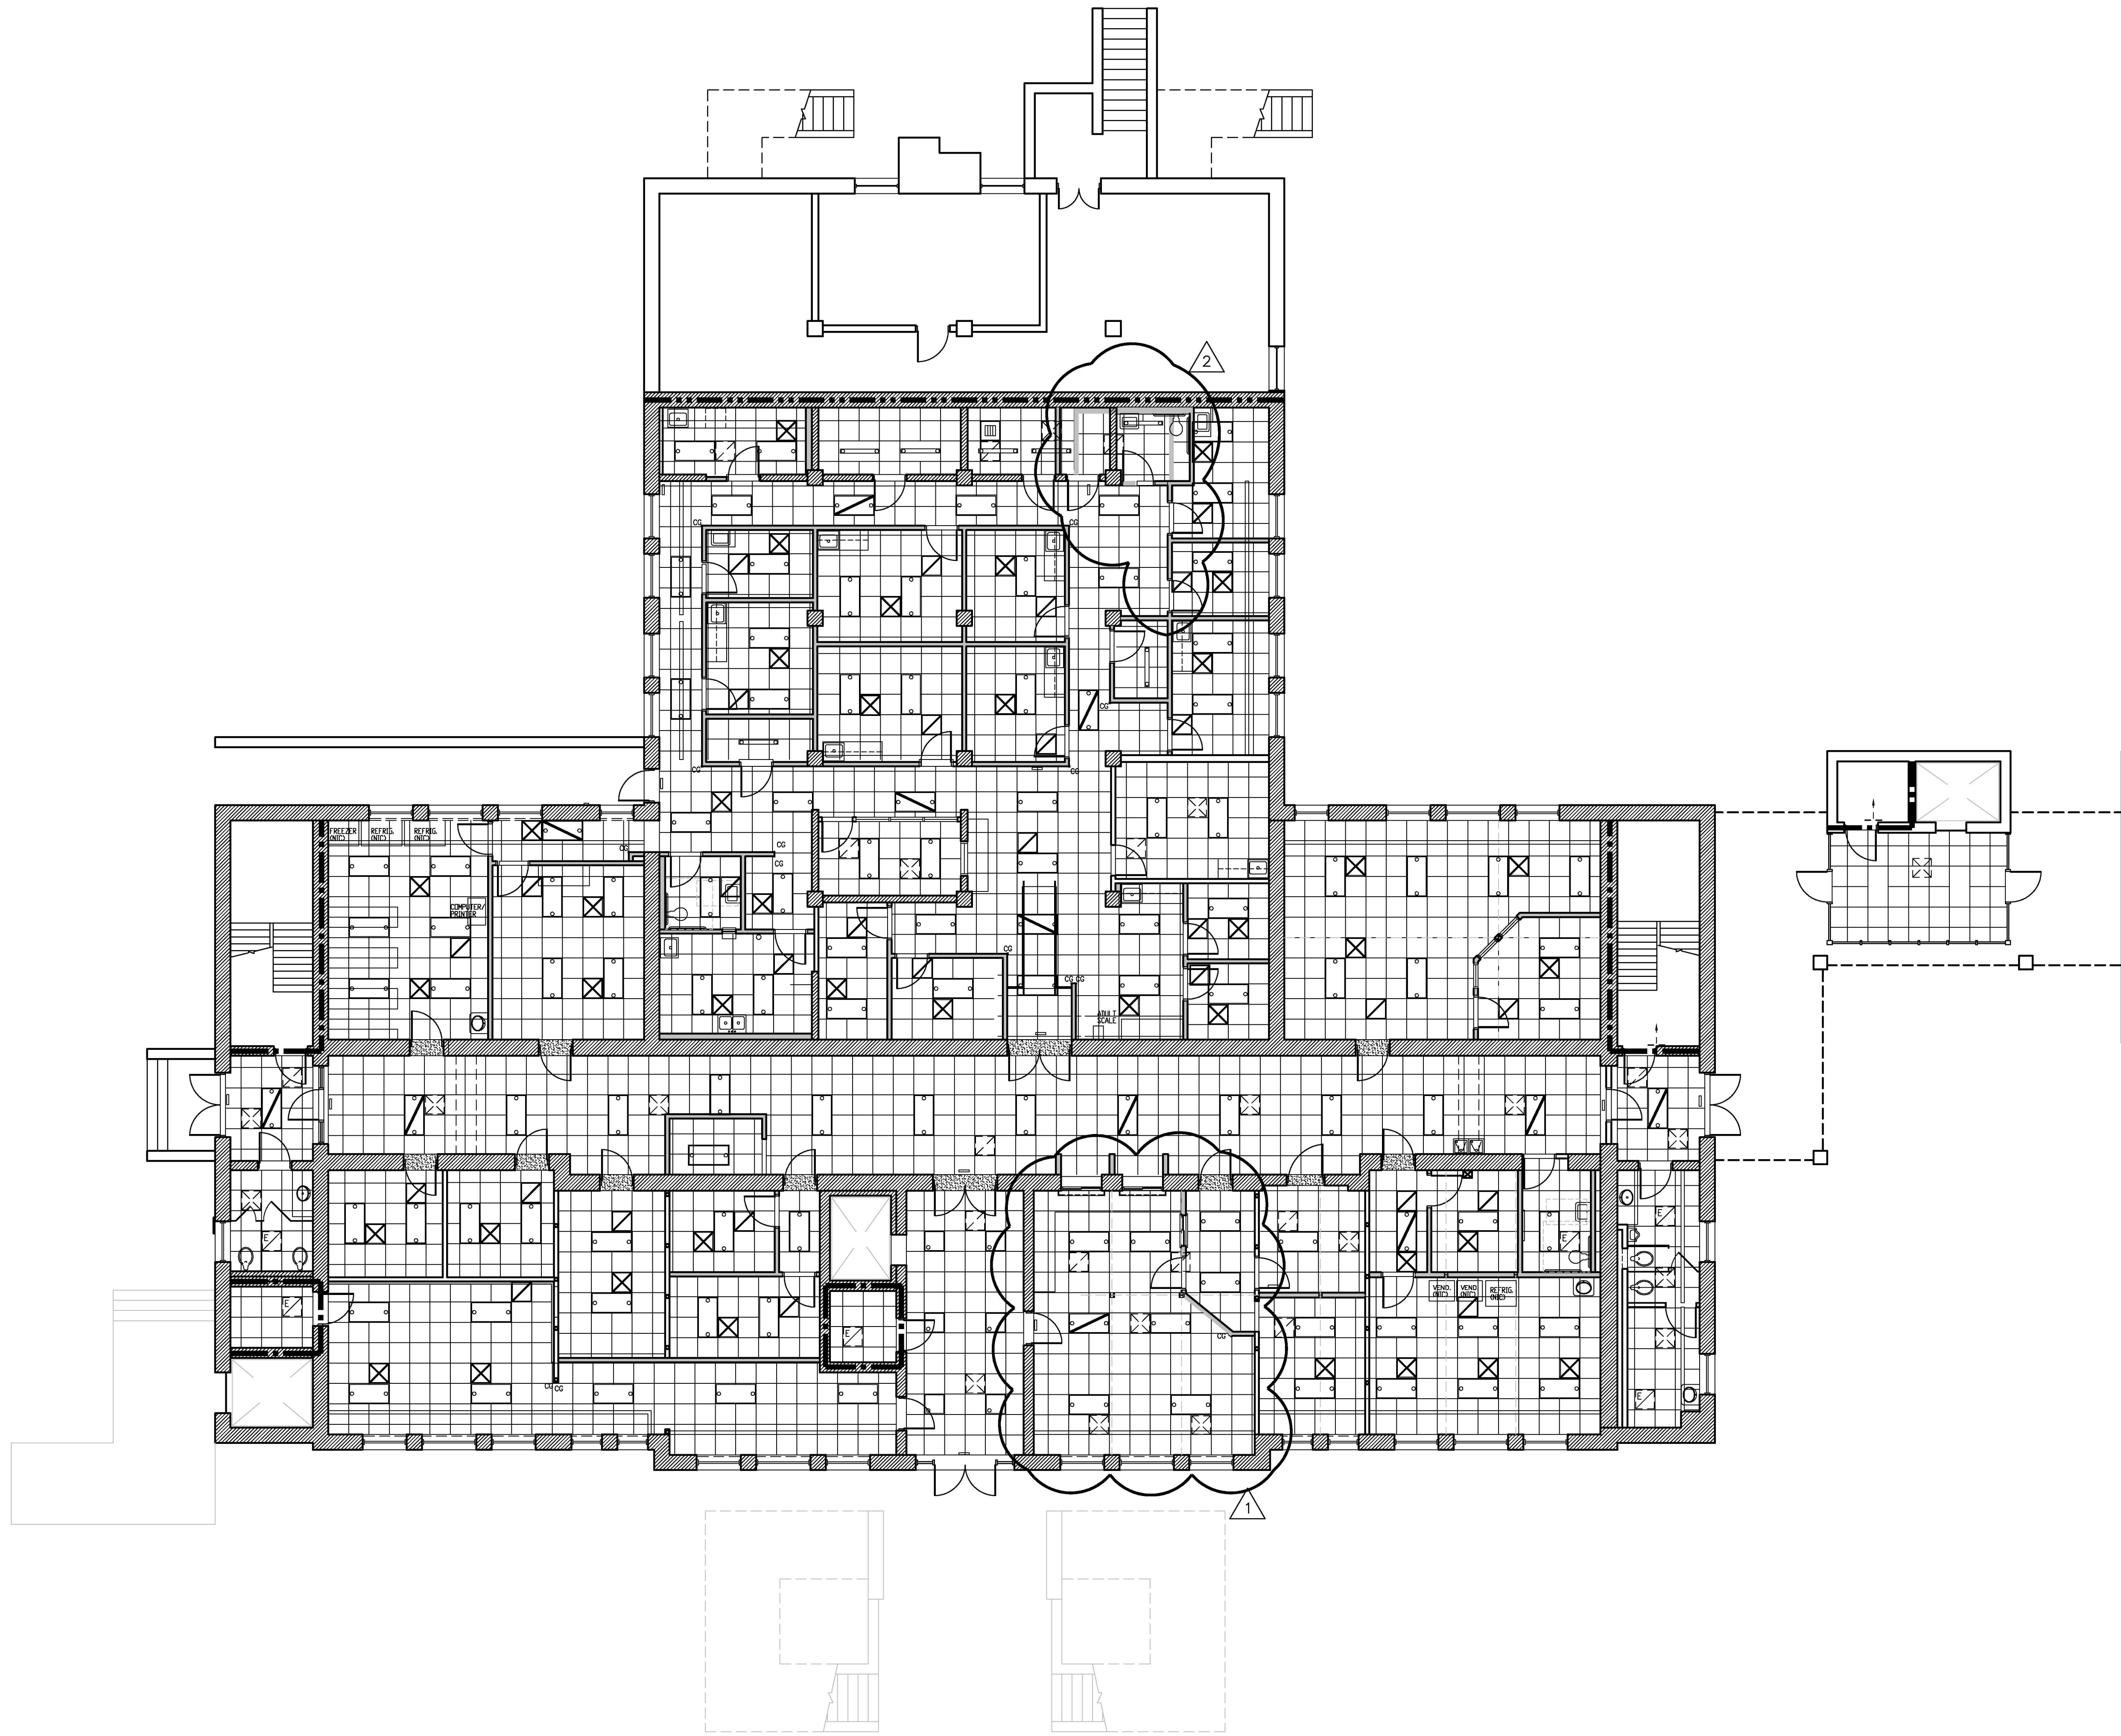


1  
A1.4

Basement Level - Reflected Ceiling Plan

Scale: 1/8" = 1'-0"

BUILDING A

CEILING LEGEND	
	LIGHT FIXTURE - SEE ELECTRICAL DWGS
	EXIT SIGN - SEE ELECTRICAL DWGS
	SUPPLY AIR DIFFUSER - SEE MECHANICAL DWGS
	RETURN/EXHAUST GRILLE - SEE MECHANICAL DWGS
	EMERGENCY LIGHT FIXTURE - SEE ELECTRICAL DWGS

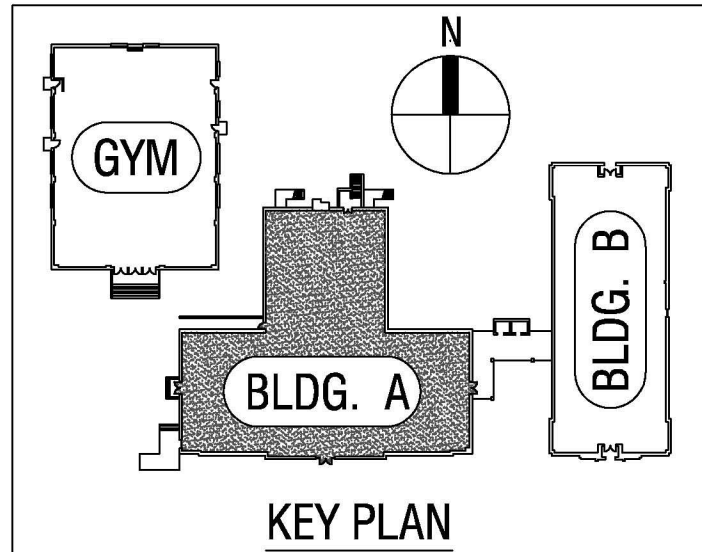

no.	revisions
1.	ADDENDUM #4, 01/13/11
2.	PLAN REVIEW COMMENTS, 01/31/11

RECORD DOCUMENT  
1-31-12

THESE DOCUMENTS HAVE BEEN PREPARED FROM INFORMATION RECEIVED FROM THE CONTRACTOR.

The use of these plans and specifications shall be restricted to the original use for which they were prepared and publication thereof is expressly limited to such use. Re-use, reproduction, or publication by any method in whole or in part, is prohibited. Title to the plans and specifications remain in the architect without prejudice. It is to be returned upon request to the architect. Visual contact with these plans and specifications shall constitute prima facie evidence of the acceptance of these restrictions.

drawn checked

BUILDING A  
BASEMENT LEVEL  
REFLECTED CEILING  
PLAN

sheet

A1.4

of total

project no. 1001

















date 12-20-2010



Orange County  
Health Department  
Renovations  
Hillsborough, North Carolina



CORLEY REDFOOT ZACK, INC.  
ARCHITECTS • ENGINEERS • PLANNERS  
PO Box 2368, Chapel Hill, North Carolina 27514-2368  
919.401.8586

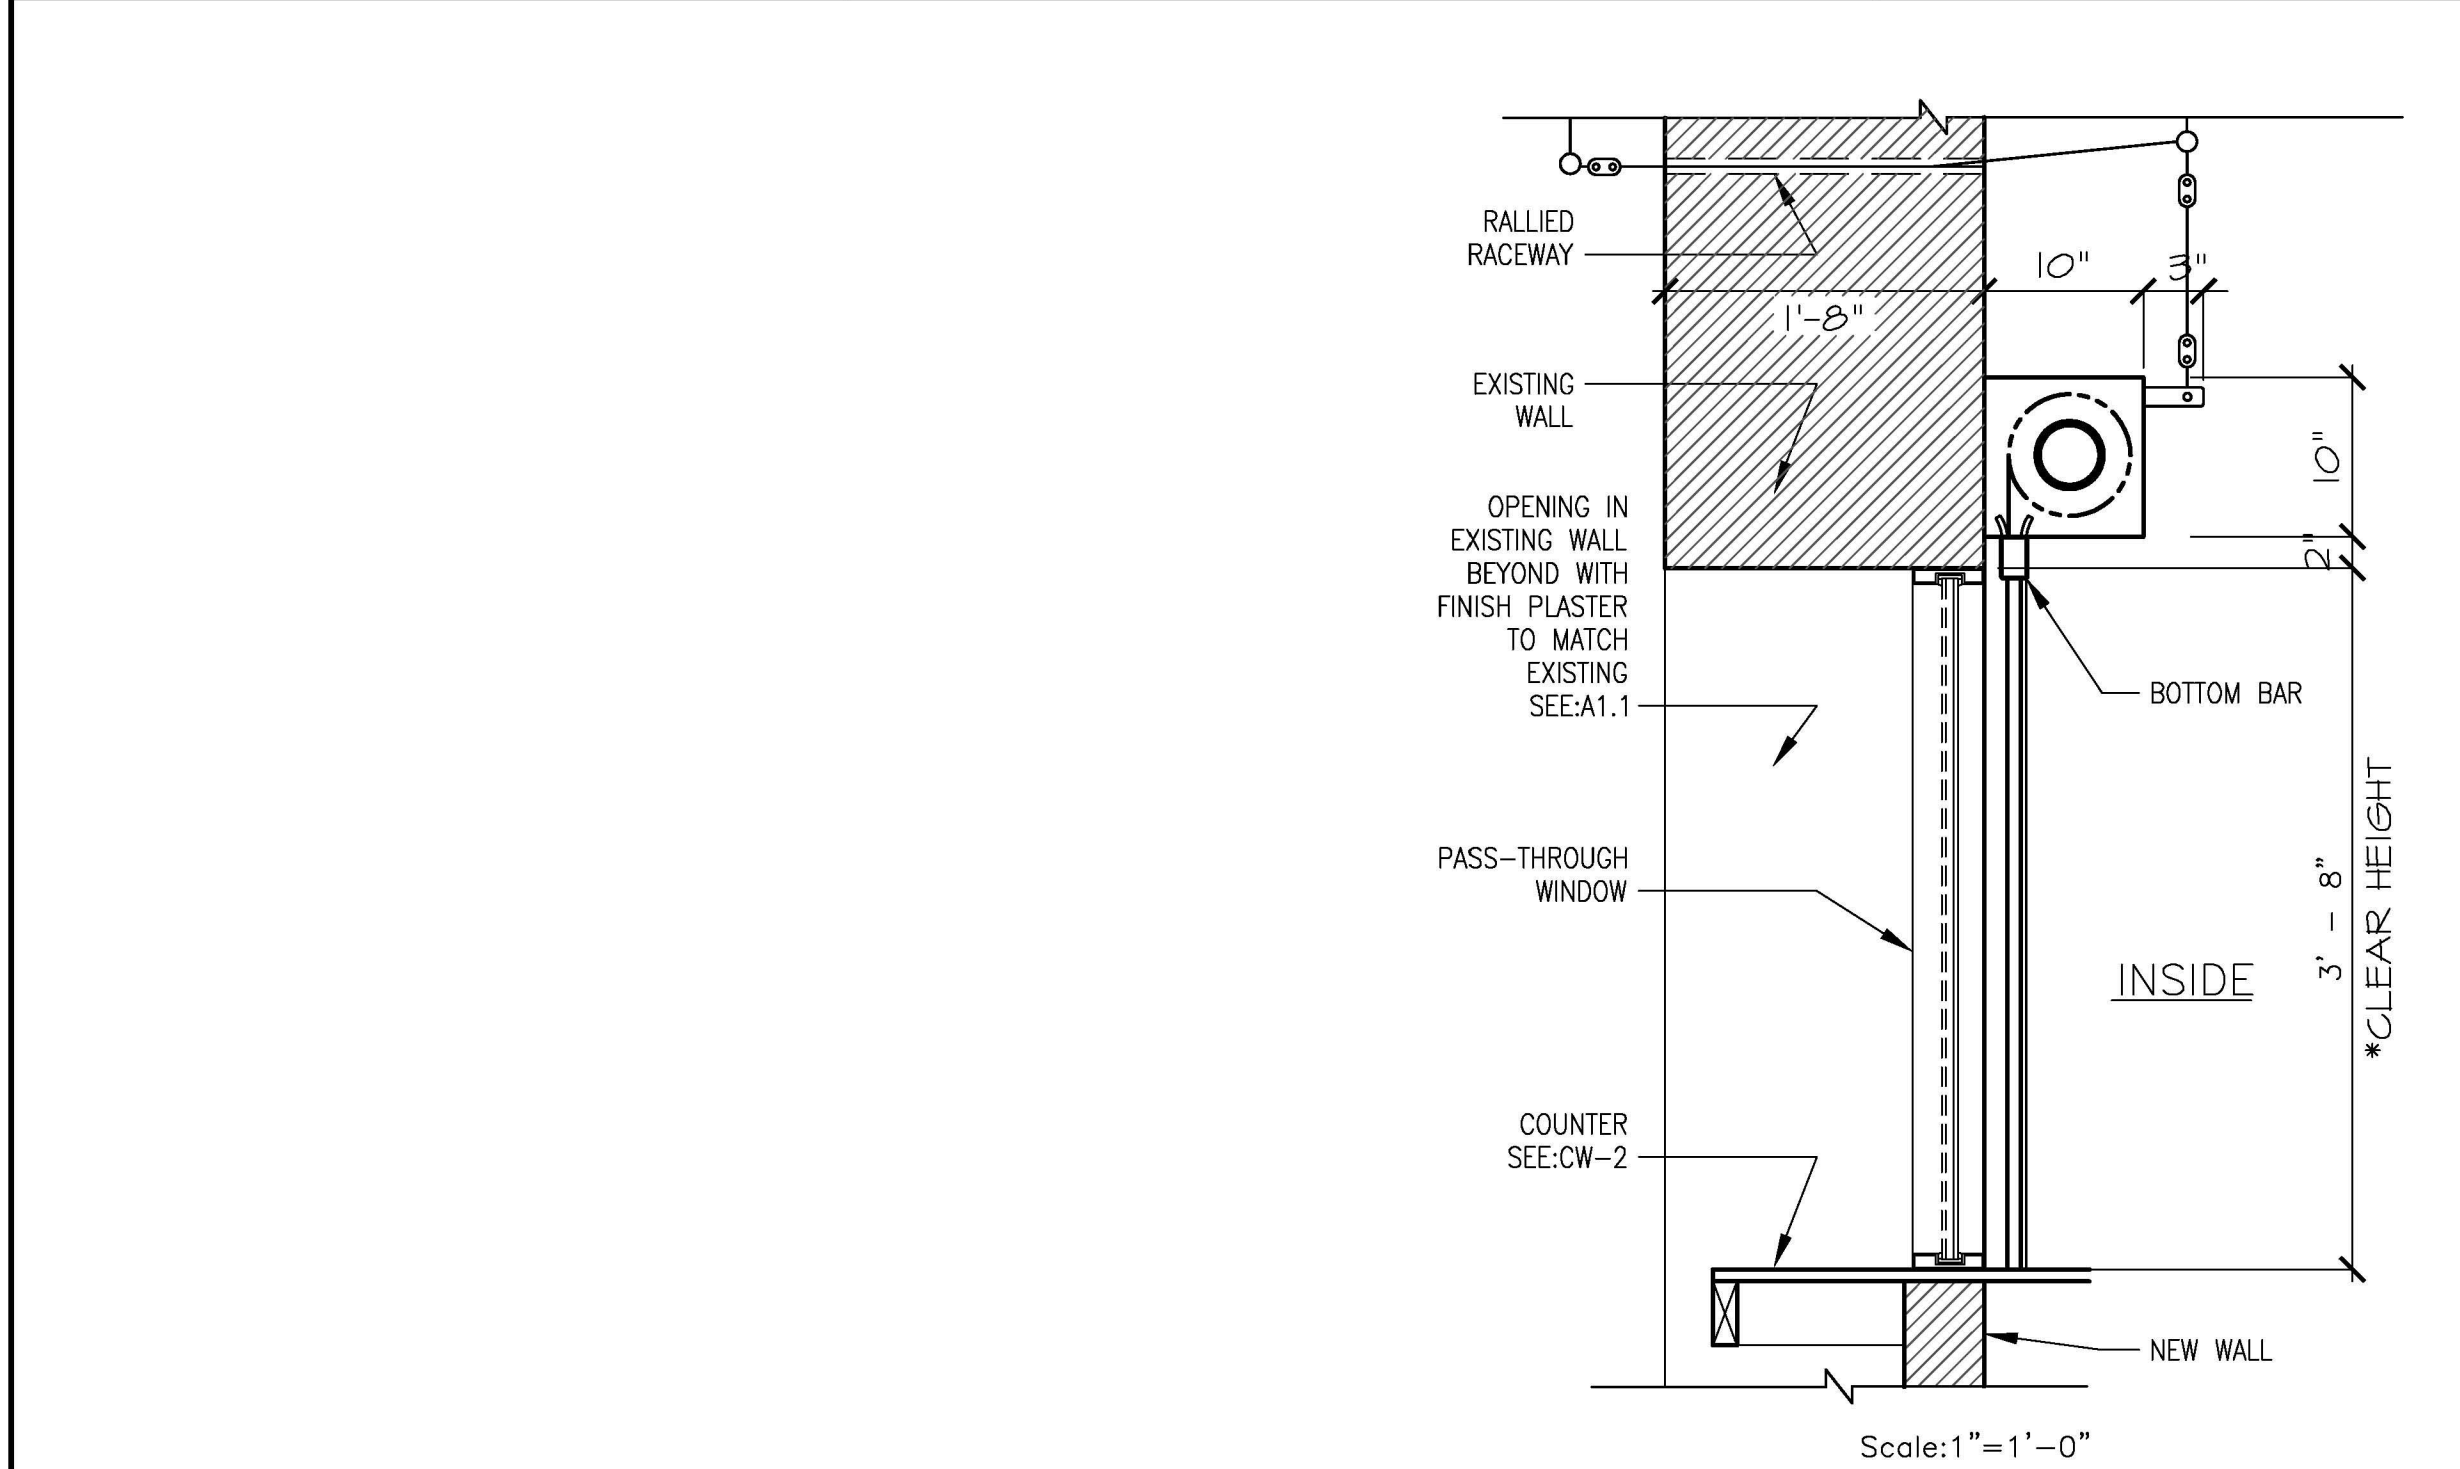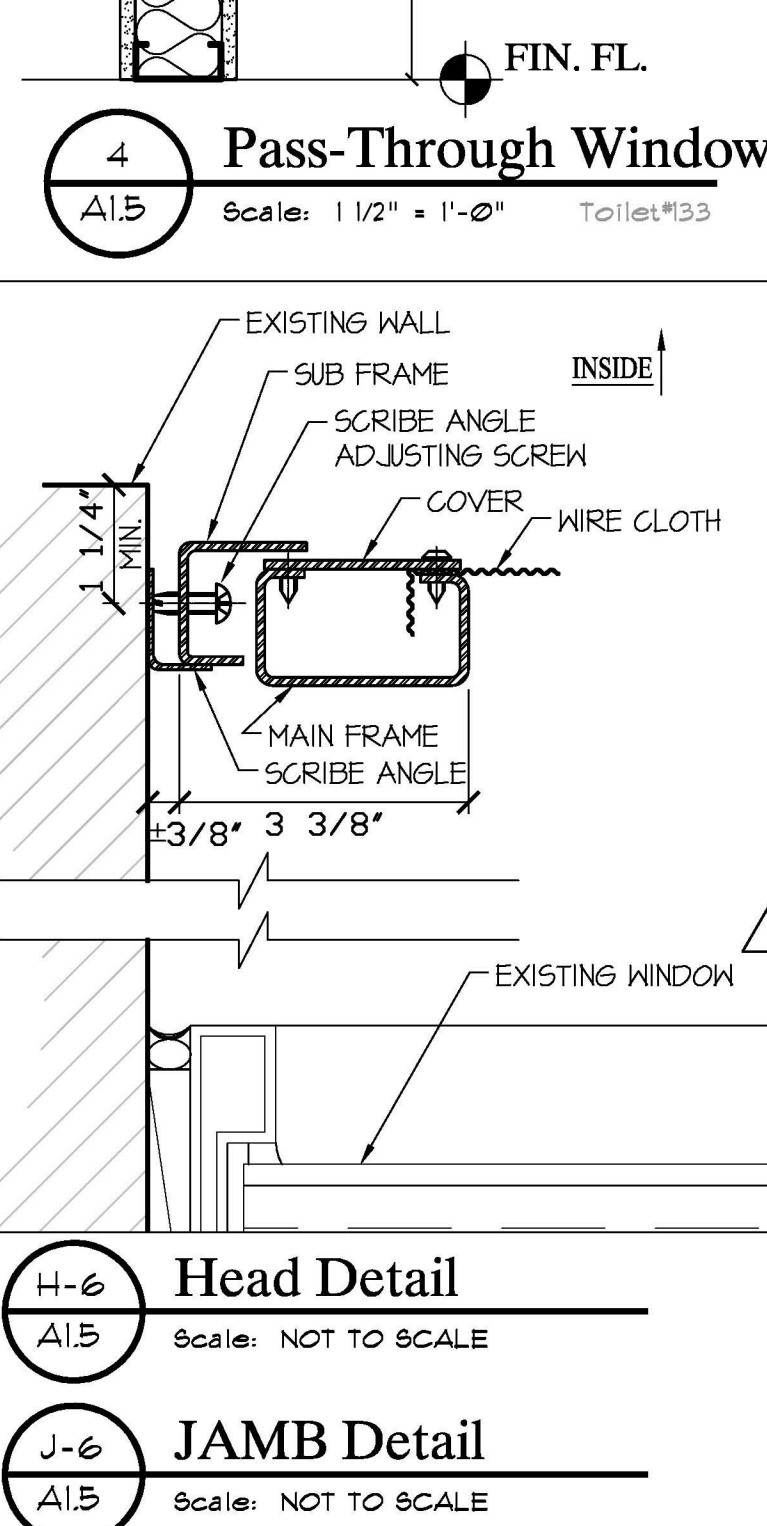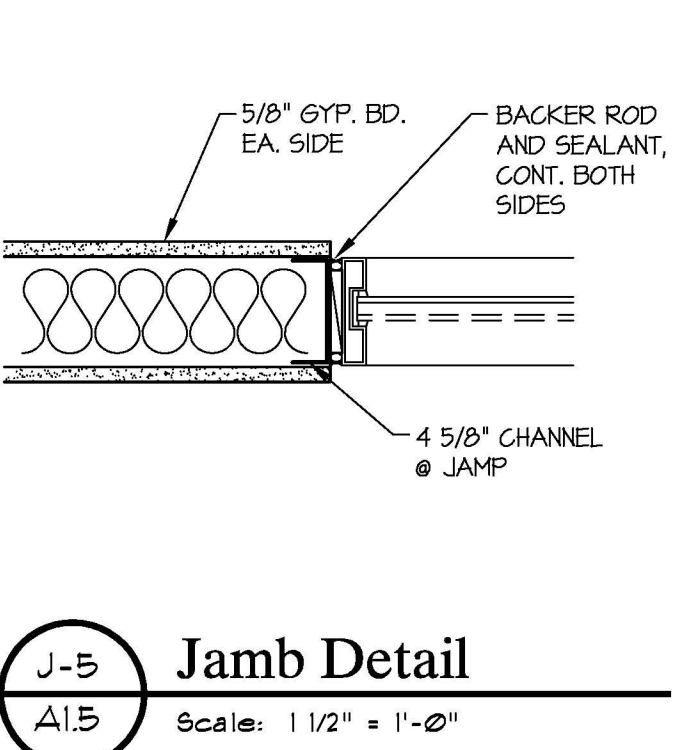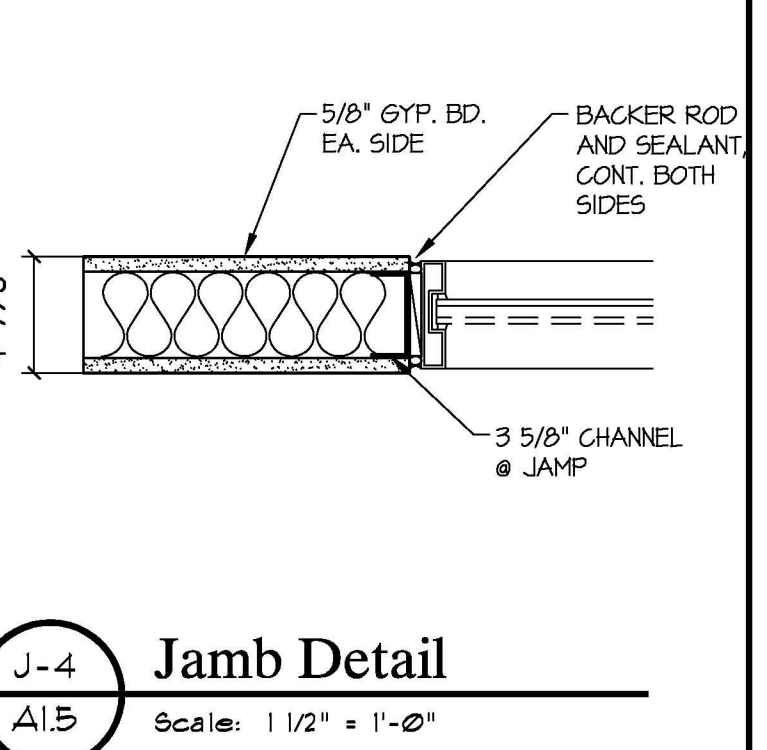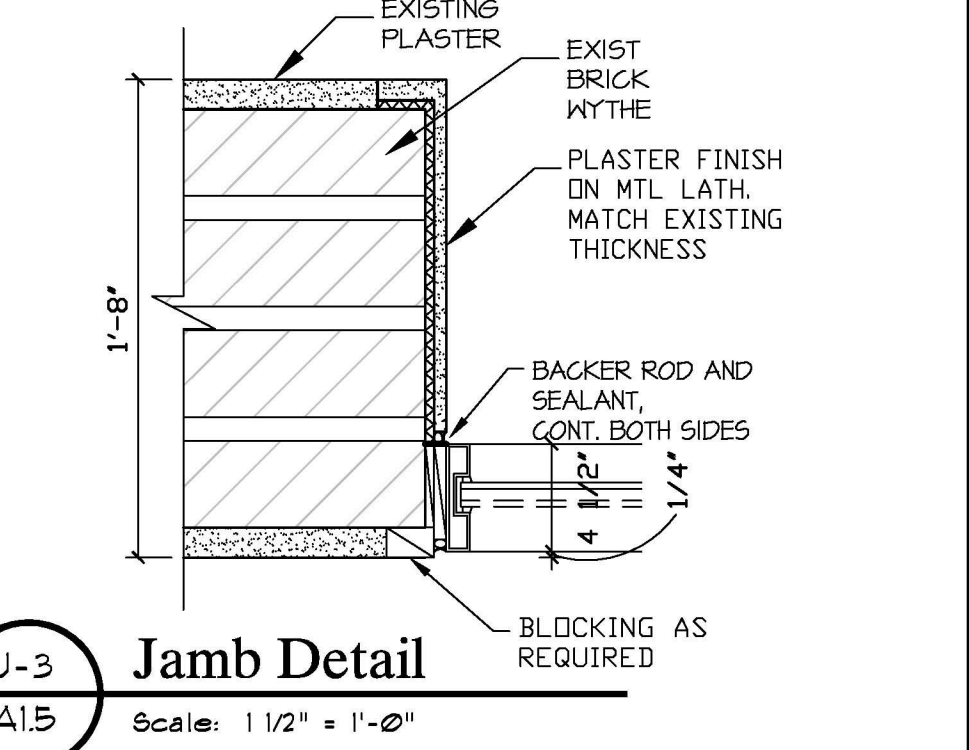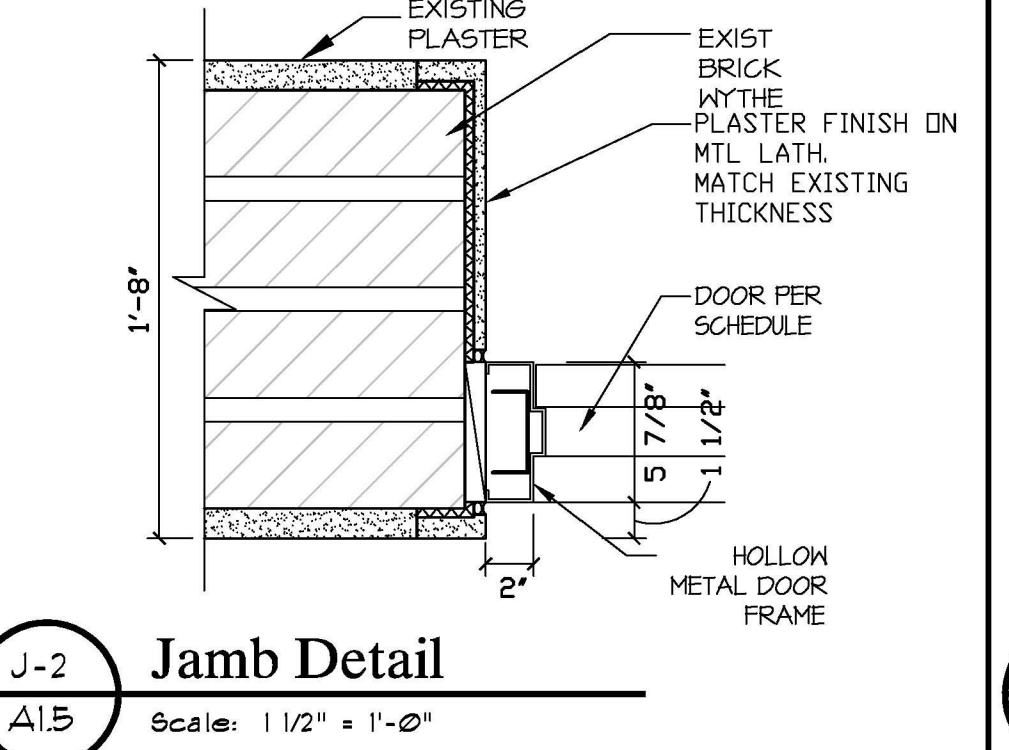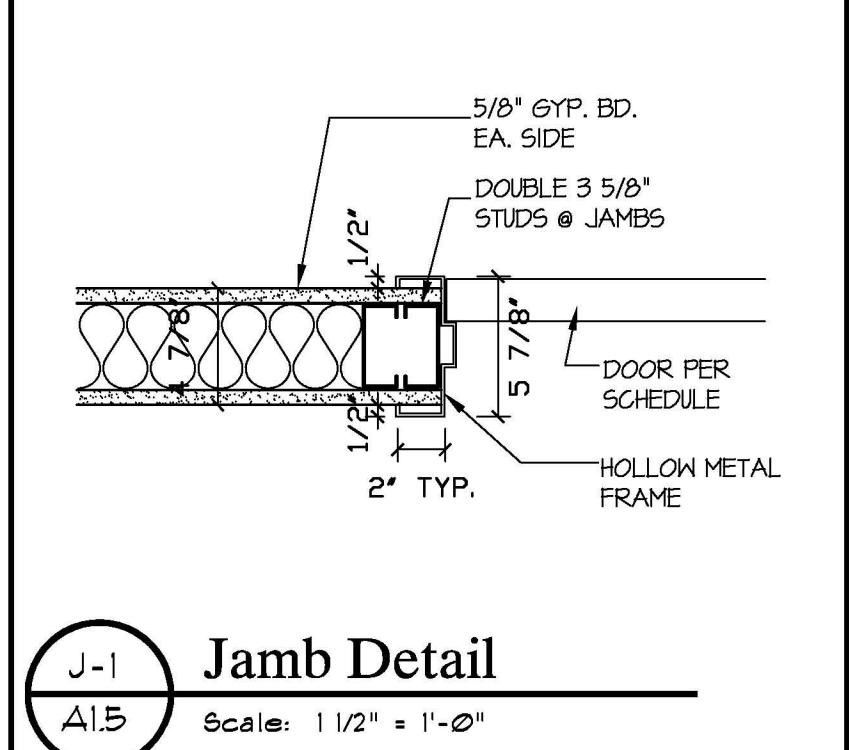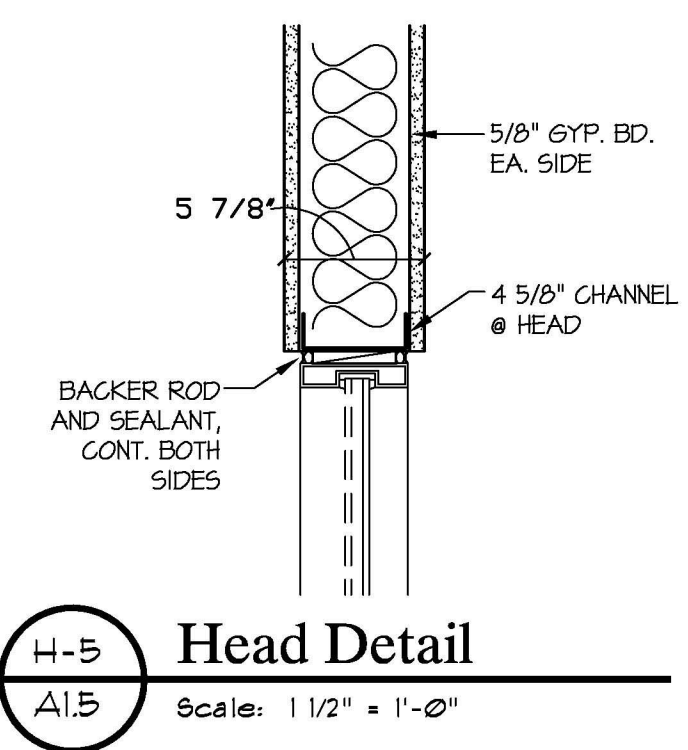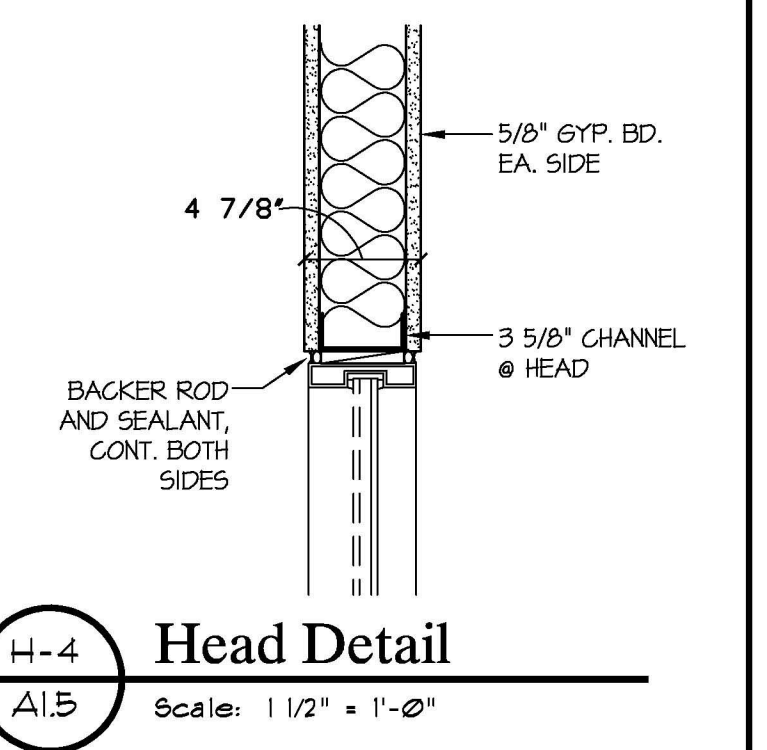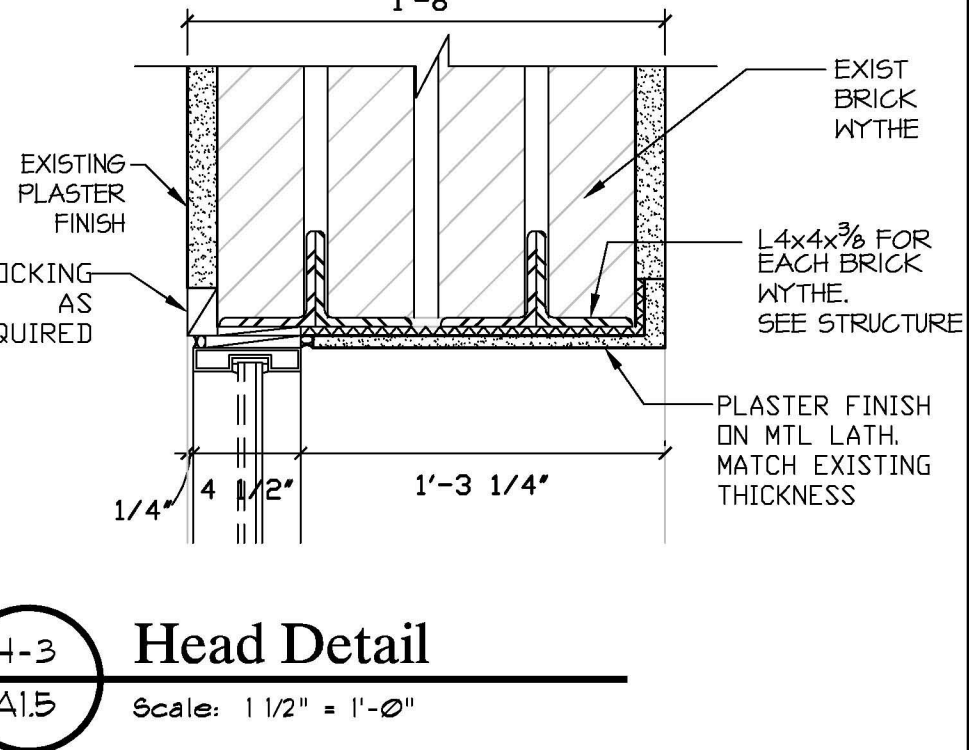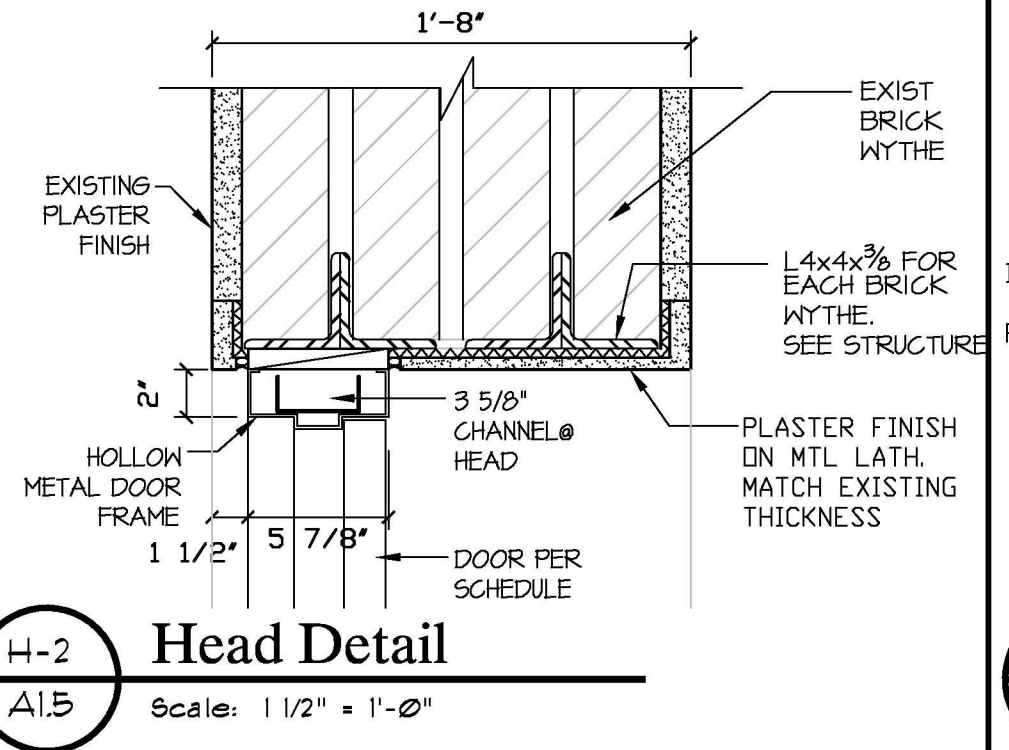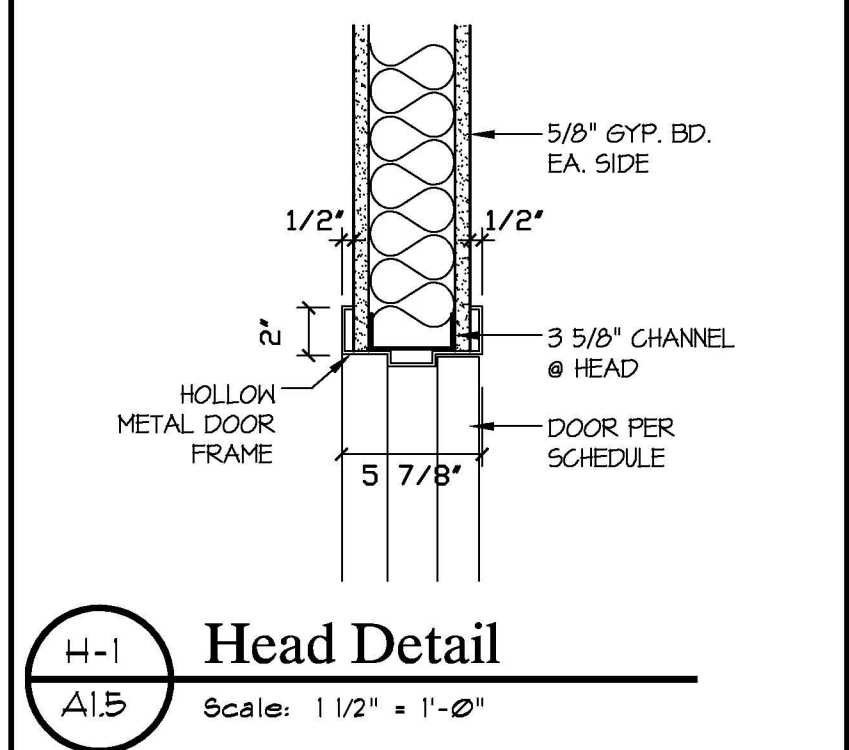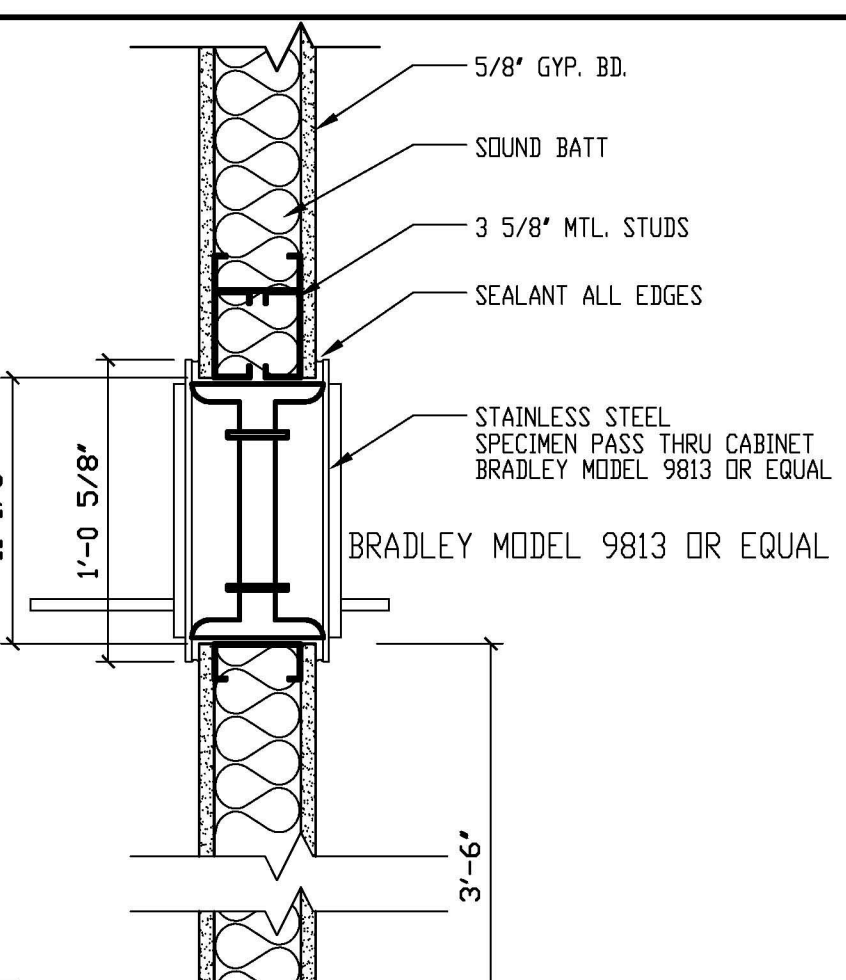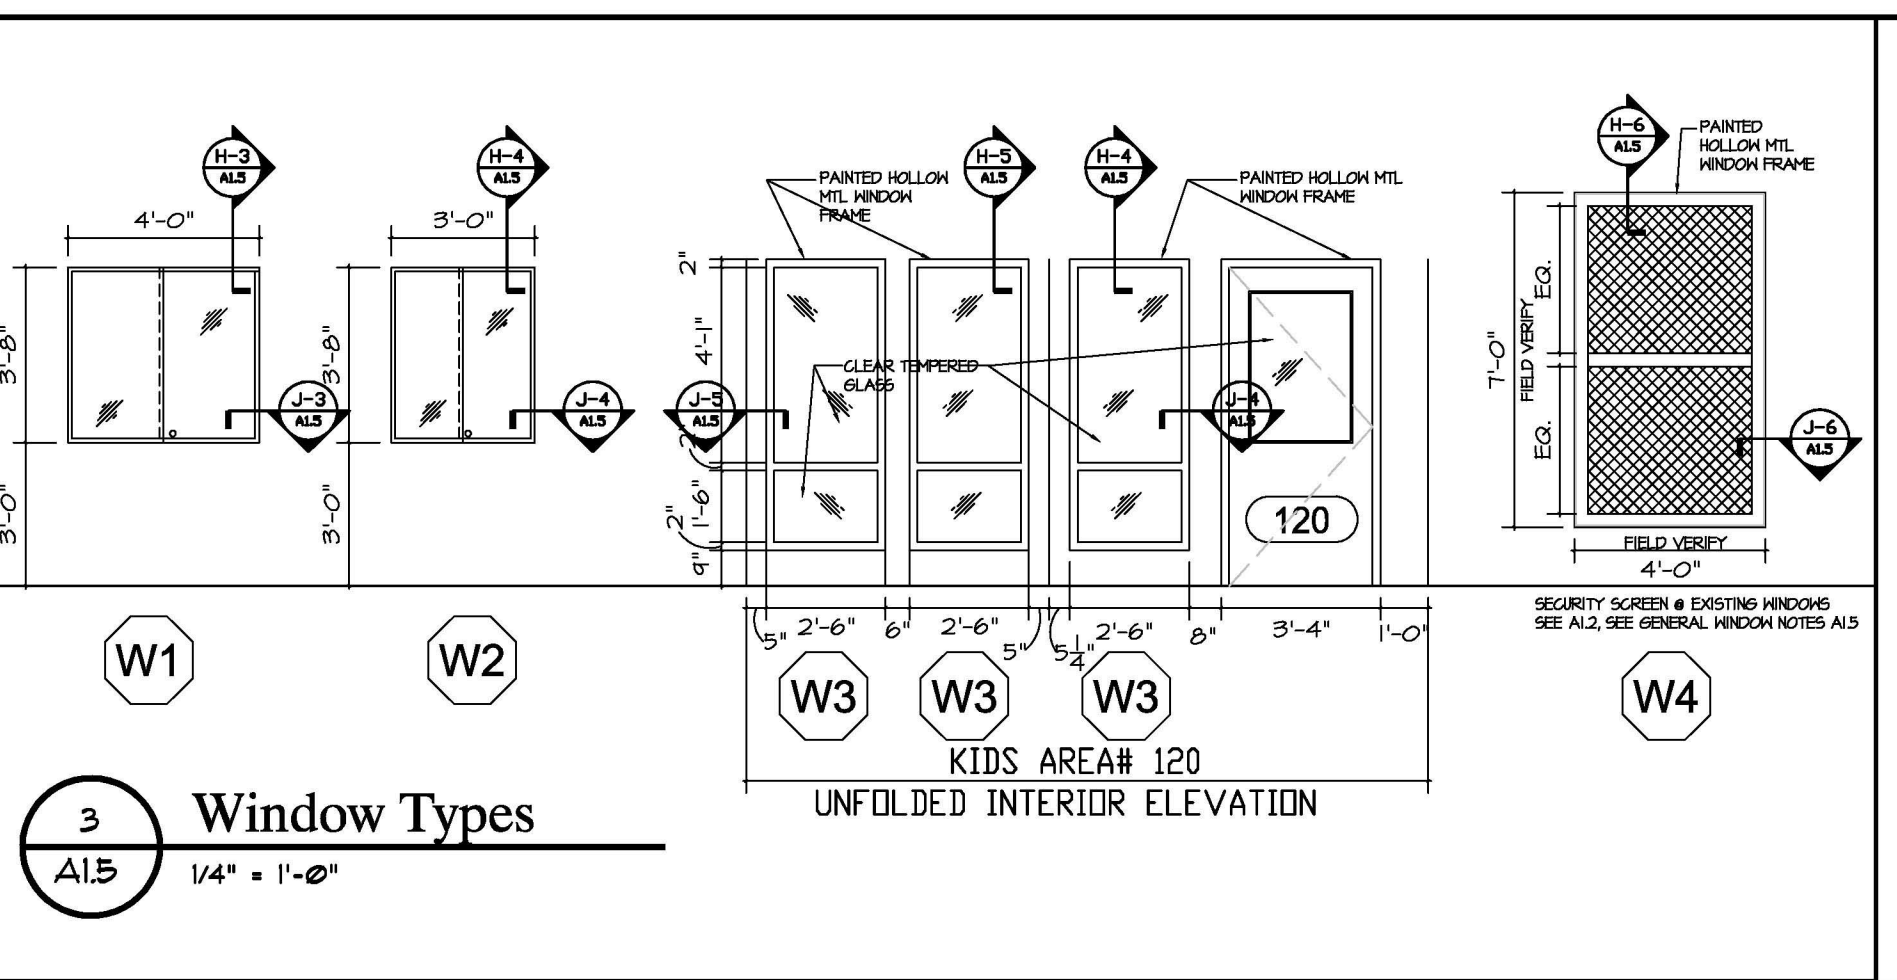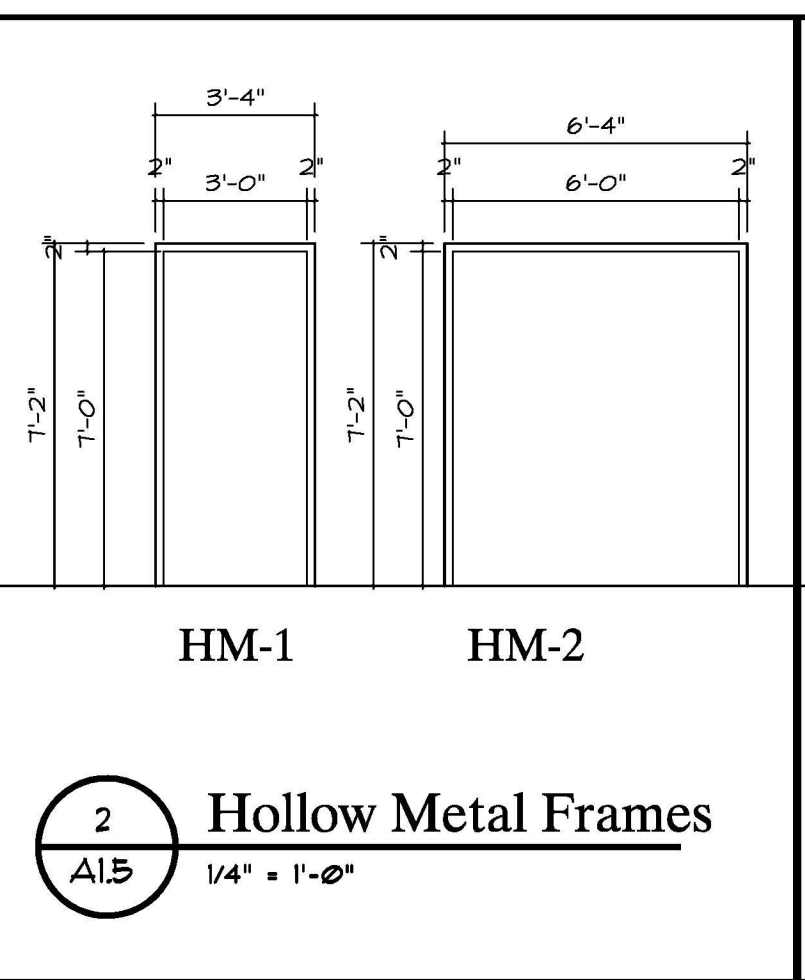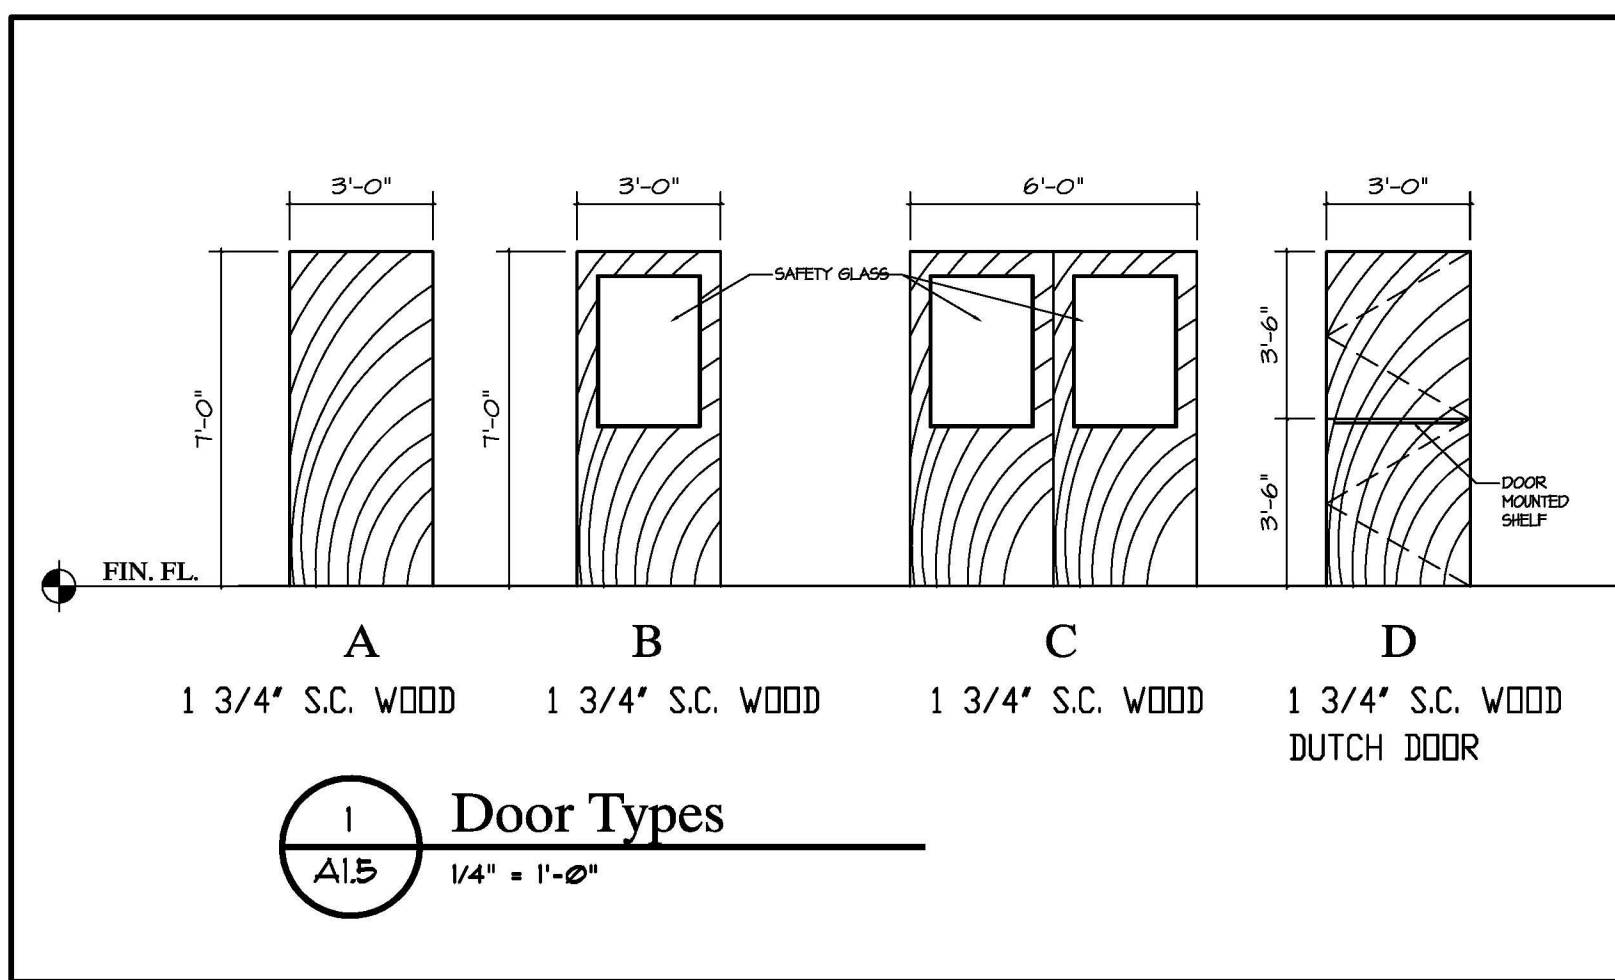

ROOM FINISH SCHEDULE						
MARK	ROOM NAME	FLOOR	BASE	WALLS	CEILING TYPE	CLG. HT.
100	ENTRY CORRIDOR	EXISTING	EXISTING	TO REMAIN	EXISTING ACP	FIELD VER.
101	RECEPTION	C	4\" RUBBER	PE, PG		
102	VEST.	RF	4\" RUBBER	PE, PG		
103	CHECKOUT OFFICE	C	4\" RUBBER	PE, PG		
104	BUSINESS CENTER	C	4\" RUBBER	PE, PG		
105	CORRIDOR	RF	4\" RUBBER	PE, PG		
105A	BREAK ROOM	RF	4\" RUBBER	PE, PG		
105B	NUTRITIONST	C	4\" RUBBER	PE		
106	FAMILY TOILET	CT	4\" RUBBER	PG		
107	JANITOR	EXISTING	EXISTING	TO REMAIN		
108	EXISTING MEN TOILET	EXISTING	EXISTING	TO REMAIN		
109	ENTRY	EXISTING	EXISTING	TO REMAIN		
110	CORRIDOR	EXISTING	EXISTING	TO REMAIN		
111	WIC ALCOVE	EXISTING	4\" RUBBER	PG		
112	ENTRY	EXISTING	EXISTING	TO REMAIN		
113	EXISTING WOMEN TOILET	EXISTING	EXISTING	TO REMAIN		
114	LCSW OFFICE	C	4\" RUBBER	PE		
115	SOCIAL WORKER	C	4\" RUBBER	PE		
116	STORAGE	RF	4\" RUBBER	PE, PG		
117	OFFICE	RF	4\" RUBBER	PE, PG		
118	WIC	RF	4\" RUBBER	PE, PG		
118A	VEST.	RF	4\" RUBBER	PE, PG		
119	WIC	RF	4\" RUBBER	PE, PG		
120	KIDS AREA	RF	4\" RUBBER	PE, PG		
121	WAITING ROOM	RF	4\" RUBBER	PE, PG		
122	INTERVIEW ROOM#1	SF	4\" RUBBER	PE, PG		
123	INTERVIEW ROOM#2	SF	4\" RUBBER	PE, PG		
124	HEIGHT/WEIGHT ALCOVE	RF	4\" RUBBER	PE, PG		
125	EXAM ROOM#1	SF	4\" RUBBER	PE		
126	FNP	RF	4\" RUBBER	PE, PG		
127	FNP	RF	4\" RUBBER	PE, PG		
128	CLINIC MANAGER	RF	4\" RUBBER	PE		
129	BLOOD DRAW	RF	4\" RUBBER	PE, PG		
130	TOILET	CT	4\" RUBBER	PG		
131	LAB	SF	4\" RUBBER	PE, PG		
132	WORK ROOM	RF	4\" RUBBER	PE, PG		
133	PHARMACY	SF	4\" RUBBER	PE, PG		
134	CORRIDOR	RF	4\" RUBBER	PE, PG		
135	EXAM ROOM#2	SF	4\" RUBBER	PE, PG		
136	STORAGE	RF	4\" RUBBER	PG		
137	MEDICAL DIRECTOR	RF	4\" RUBBER	PE, PG		
138	EXAM ROOM#3	SF	4\" RUBBER	PE, PG		
139	TOILET	CT	4\" RUBBER	PE, PG		
140	STORAGE	EXISTING	EXISTING	TO REMAIN		
141	I.T. CLOSET	EXISTING	EXISTING	TO REMAIN		
142	STERILIZATION/DIRTY UTIL.	SF	4\" RUBBER	PE, PG		
143	EXAM ROOM#4	SF	4\" RUBBER	PG		
144	INTERVIEW ROOM#3	SF	4\" RUBBER	PG		
145	EXAM ROOM#5	SF	4\" RUBBER	PG		
146	EXAM ROOM#6	SF	4\" RUBBER	PG		
147	INTERVIEW ROOM#4	SF	4\" RUBBER	PG		
148	EXAM ROOM#7 (NEG. PRESS)	SF	4\" RUBBER	PG		
149	CRASH CART STORAGE	RF	4\" RUBBER	PG		

DOOR AND FRAME SCHEDULE									
MARK	DOOR			FRAME			LABEL	HDWR GROUP	REMARKS
	TYPE	MAT'L	FINISH	TYPE	FINISH	HEAD			
100A	EXISTING DOOR AND FRAME TO REMAIN								
100B	EXISTING DOOR AND FRAME TO REMAIN						F. RATED		
100C	EXISTING DOOR AND FRAME TO REMAIN						F. RATED		
100D	C SC WD STAIN HM-2 PAINT H-2 J-2						F. RATED		NOTE 4
101A	EXISTING DOOR AND FRAME TO REMAIN						F. RATED		NOTE 6
101B	B SC WD STAIN HM-1 PAINT H-1 J-1								NOTE 6
101C	A SC WD STAIN HM-1 PAINT H-1 J-1								NOTE 6
105A	B SC WD STAIN HM-1 PAINT H-1 J-1								
105B	B SC WD STAIN HM-1 PAINT H-1 J-1								7
106	A SC WD STAIN HM-1 PAINT H-1 J-1						F. RATED		5
107	EXISTING DOOR AND FRAME TO REMAIN								
108	A SC WD STAIN HM-1 PAINT H-1 J-1						F. RATED		
109A	EXISTING DOOR AND FRAME TO REMAIN								
109B	EXISTING DOOR AND FRAME TO REMAIN						F. RATED		NOTE 6
104C	B SC WD STAIN HM-1 PAINT H-1 J-1						F. RATED		
110A	B SC WD STAIN HM-1 PAINT H-2 J-2						F. RATED		NOTE 6
110B	D SC WD STAIN HM-1 PAINT H-2 J-2						F. RATED		
110C	B SC WD STAIN HM-1 PAINT H-2 J-2						F. RATED		
110D	B SC WD STAIN HM-1 PAINT H-2 J-2						F. RATED		
110E	C SC WD STAIN HM-2 PAINT H-2 J-2						F. RATED		NOTE 6
110F	A SC WD STAIN HM-1 PAINT H-2 J-2						F. RATED		
110G	D SC WD STAIN HM-1 PAINT H-2 J-2						F. RATED		NOTE 6
110H	B SC WD STAIN HM-1 PAINT H-2 J-2						F. RATED		
110I	B SC WD STAIN HM-1 PAINT H-2 J-2						F. RATED		
110J	B SC WD STAIN HM-1 PAINT H-2 J-2						F. RATED		
112A	EXISTING DOOR AND FRAME TO REMAIN						F. RATED		NOTE 6
112B	EXISTING DOOR AND FRAME TO REMAIN						F. RATED		NOTE 6
112C	EXISTING DOOR AND FRAME TO REMAIN								
112D	A SC WD STAIN HM-1 PAINT H-1 J-1						F. RATED		
114	B SC WD STAIN HM-1 PAINT H-2 J-2						F. RATED		
116A	EXISTING DOOR AND FRAME TO REMAIN								NOTE 10
135	A SC WD STAIN HM-1 PAINT H-1 J-1								
136	A SC WD STAIN HM-1 PAINT H-1 J-1								
137	B SC WD STAIN HM-1 PAINT H-1 J-1								
138	A SC WD STAIN HM-1 PAINT H-1 J-1								
142	A SC WD STAIN HM-1 PAINT H-1 J-1								
143	A SC WD STAIN HM-1 PAINT H-1 J-1								
144	B SC WD STAIN HM-1 PAINT H-1 J-1								
145	A SC WD STAIN HM-1 PAINT H-1 J-1								
146	A SC WD STAIN HM-1 PAINT H-1 J-1								
147	B SC WD STAIN HM-1 PAINT H-1 J-1								
148	A SC WD STAIN HM-1 PAINT H-1 J-1								

**NOTES REFERENCED TO DOOR AND FRAME SCHEDULE**

- NOT USED
- NOT USED
- ACCESS CONTROL SYSTEM
- NOT USED
- NOT USED
- HANDICAP PUSH PAD
- IF EXISTING DOOR NOT RATED, REPLACE WITH NEW RATED DOOR

**GENERAL DOOR AND FRAME NOTES**

- HEAD AND JAMB DETAIL NUMBERS ARE ON SHEET A1.5 UNLESS OTHERWISE NOTED.
- WHERE NEW DOORS ARE BEING INSTALLED IN EXISTING WALLS, FIELD VERIFY EXISTING WALL CONSTRUCTION AND THICKNESS PRIOR TO FABRICATION OF DOOR AND FRAME.

**Notes Referenced to Room Finish Schedule**

- PATCH EXISTING FLOOR FINISH AS REQUIRED.
- PATCH EXISTING FINISHES AS REQUIRED DUE TO NEW CONSTRUCTION.

**General Room Finish Notes**

- CEILING HEIGHT VARIES. FIELD VERIFY EXISTING CEILING HEIGHT.
- GYP. BD. SOFFITS ARE TO BE PAINTED.
- PATCH EXISTING CEILING TO MATCH AS REQUIRED DUE TO NEW CONSTRUCTION.
- FOR WORK IN AREAS WHERE EXISTING FINISHES ARE SHOWN TO REMAIN, SEE SPECIFICATIONS FOR CUTTING & PATCHING.

**General Window Notes**

- WINDOW #4: STEEL SECURITY SCREEN SEE FLOOR PLAN (A1.2) FOR LOCATIONS. VERIFY ACTUAL DIMENSION IN FIELD. SECURITY SCREENS TO BE PROVIDED AT IT LOCATIONS. SEE A1.2
- SECURITY SCREEN @ 5'-4\"/>

**Finish Types**

ACP	ACOUSTICAL CEILING PANEL
CT	CERAMIC TILE
PCMJ	PAINTED CMJ
PG	PAINTED GYPSUM BOARD
PE	PAINTED EXISTING WALL
RB	RUBBER BASE
RF	RUBBER FLOORING
SF	SEAMLESS FLOORING
C	CARPET

**KEY PLAN**

**CORLEY REDFOOT ZACK INC.**  
ARCHITECTS • ENGINEERS • PLANNERS  
PO Box 2368, Chapel Hill, North Carolina 27514-8566

**Orange County Health Department Renovations**  
Hillsborough, North Carolina

**RECORD DOCUMENT**  
1-31-12  
THIS DOCUMENT HAS BEEN PREPARED FROM INFORMATION RECEIVED FROM THE CONTRACTOR.

The use of these plans and specifications and the restriction for the original site for which they were prepared and publication thereof is expressly limited to such use. Re-use, reproduction, or publication by any method, in whole or in part, is prohibited. Title to the plans and specifications remain in the architect without prejudice. It is to be returned upon request to the architect. Visual contact with these plans and specifications shall constitute prima facie evidence of the acceptance of these restrictions.

drawn checked

**DOOR & FRAME TYPES, SCHEDULE & DETAILS**


sheet

**A1.5**


of total

project no. 1001


date 12-20-2010

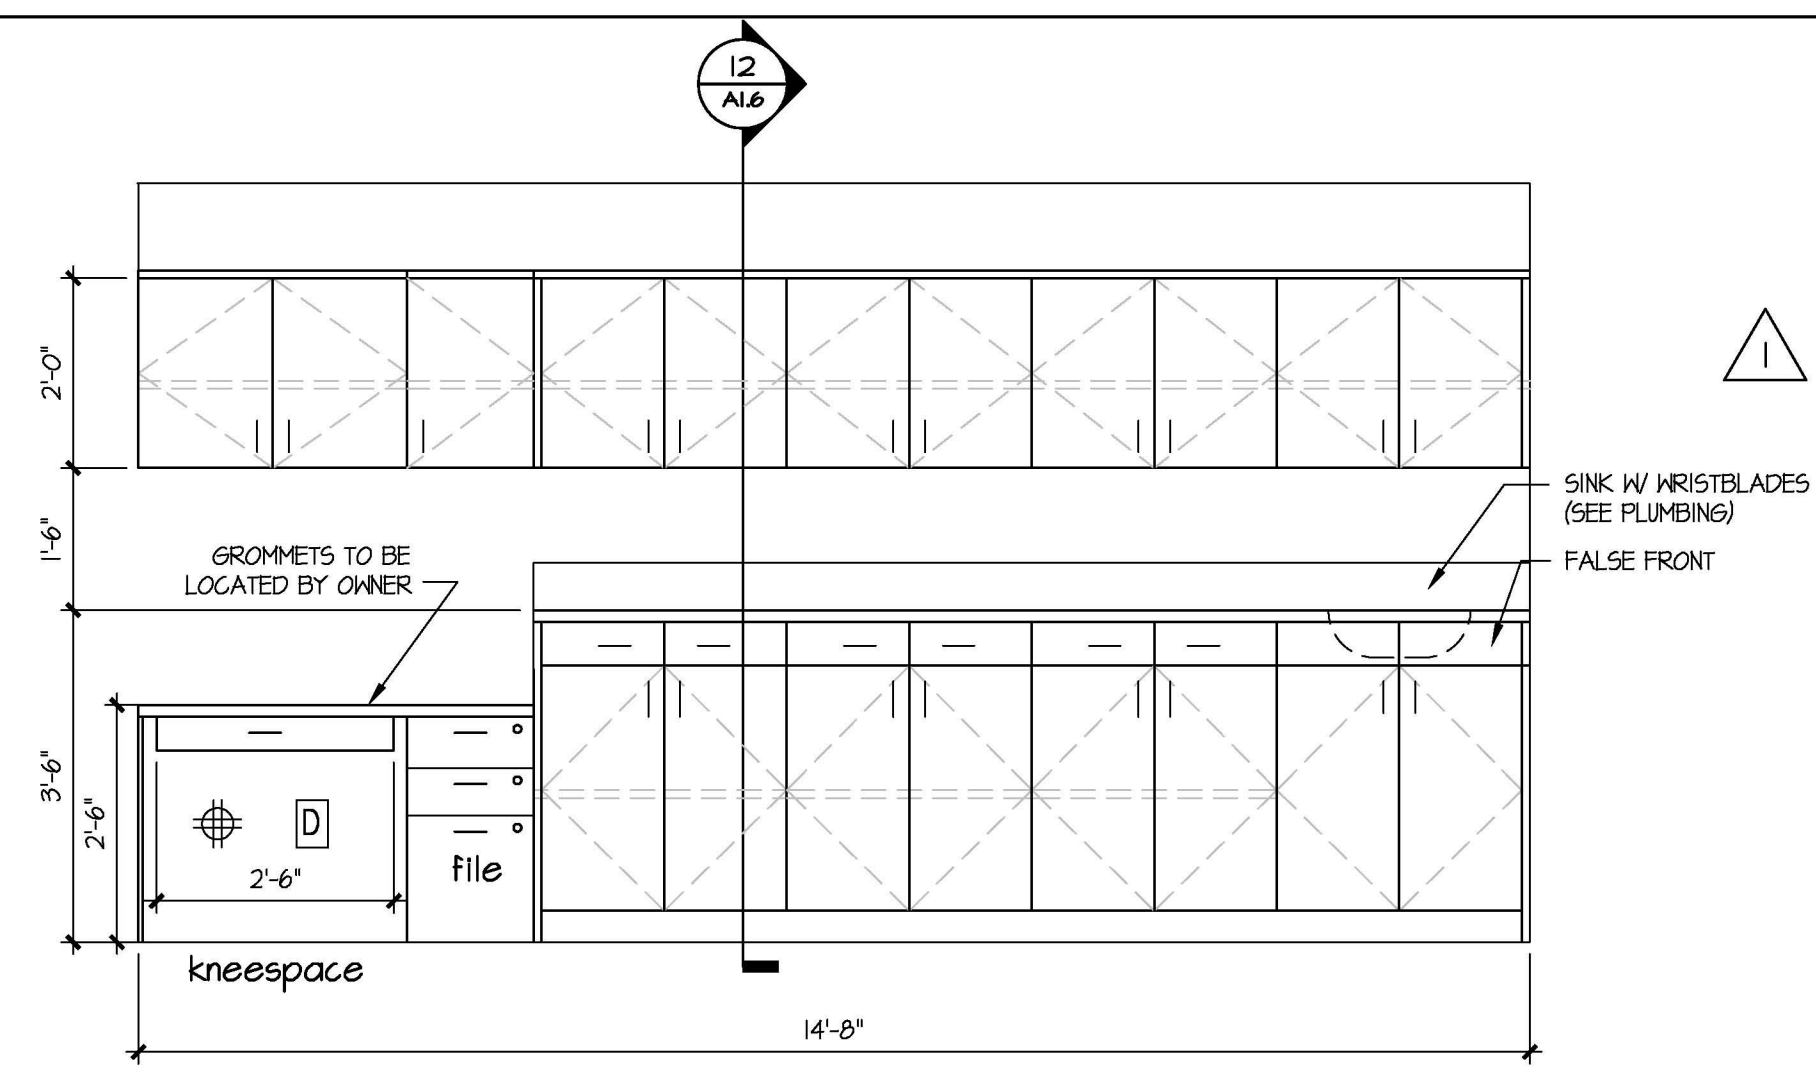


3 Millwork CW3 - (Pharmacy 133)  
A1.6 Scale: 1/2" = 1'-0" BUILDING A

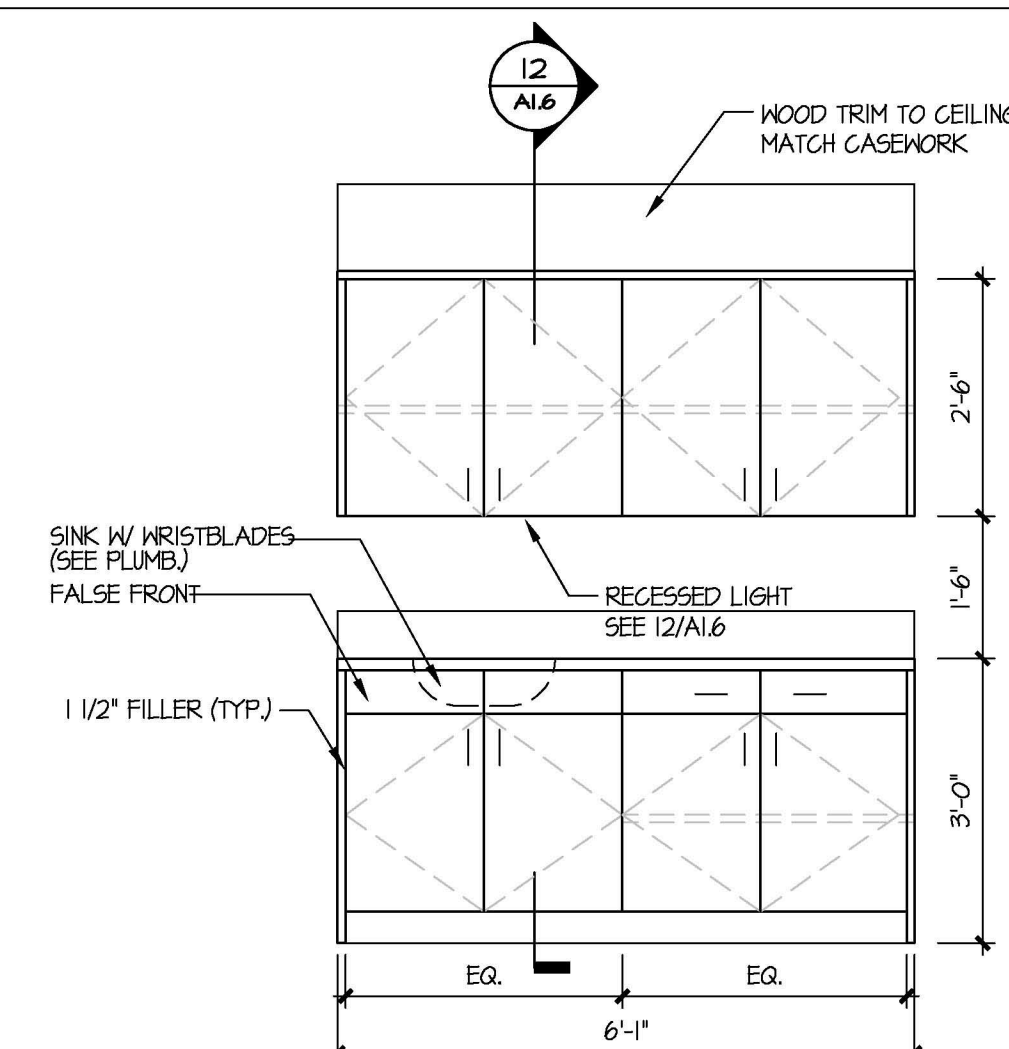



6 Millwork CW6 (outside Interview 123)  
A1.6 Scale: 1/2" = 1'-0" BUILDING A

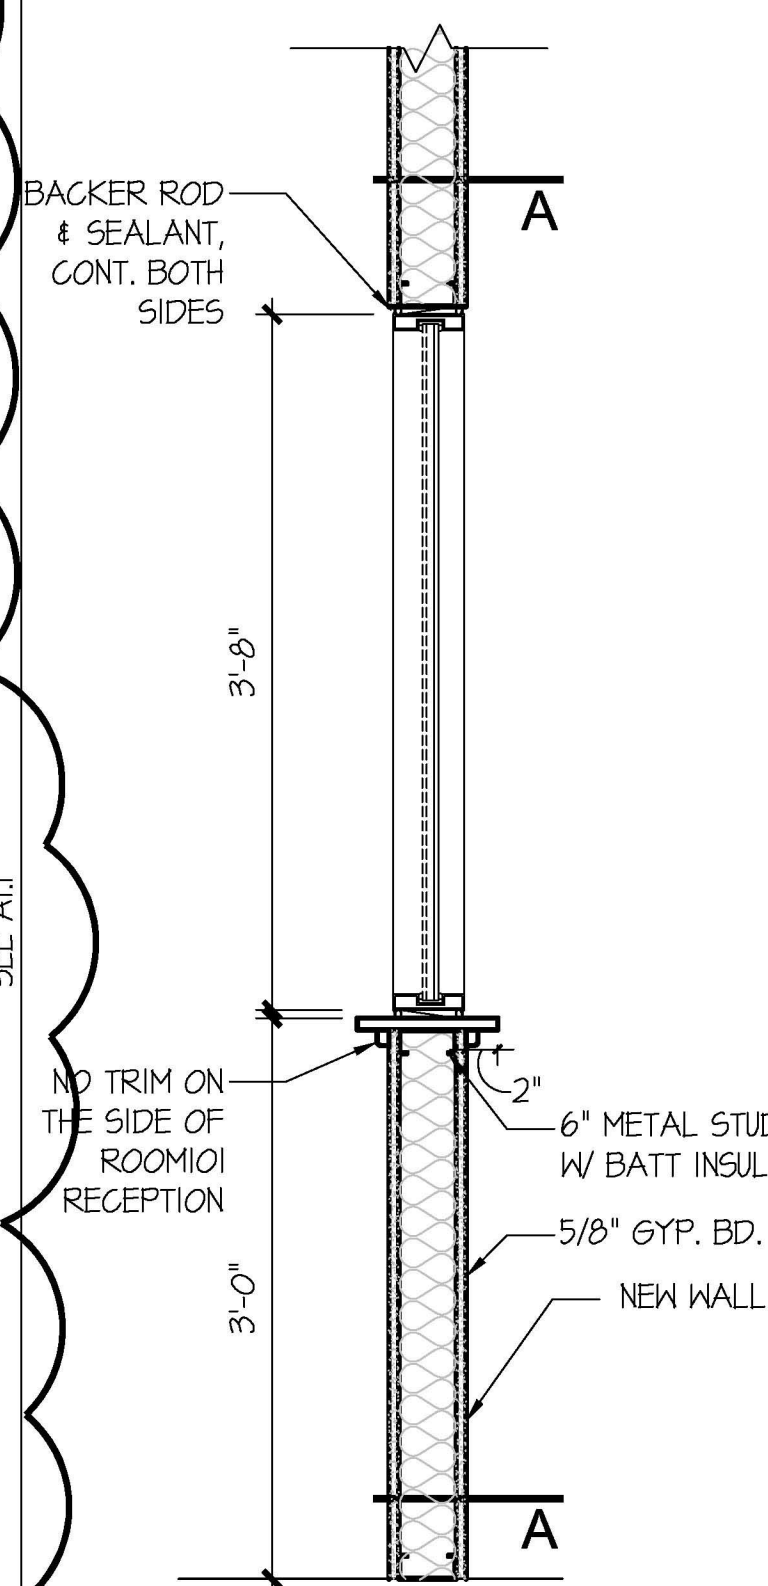


8 Millwork CW13 & 14  
A1.6 Scale: 1/2" = 1'-0" BUILDING /  
(@ Interview Rms 138 & 147)

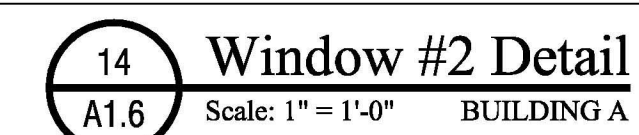

**CORLEY REDFOOT ZACK** INC.  
ARCHITECTS • ENGINEERS • PLANNERS  
PO Box 2368, Chapel Hill, North Carolina 919 401-8586

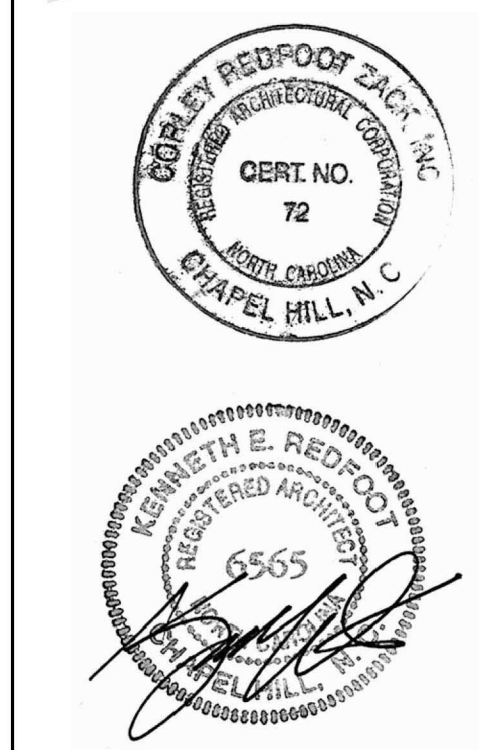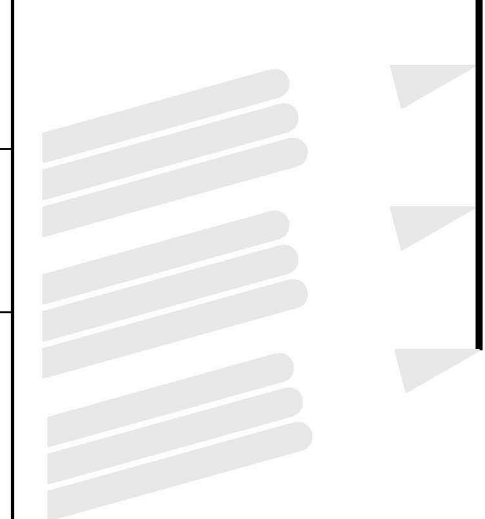

Orange County  
Health Department  
Renovations  
Hillsborough, North Carolina

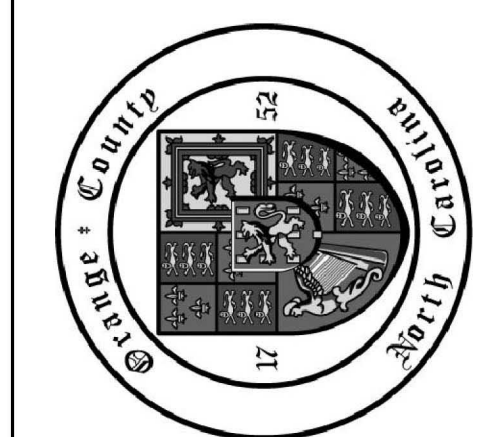

no.	revisions
1.	ADDENDUM #4, 01/13/11
2.	PLAN REVIEW COMMENTS, 01/31/11

**RECORD  
DOCUMENT  
1-31-12**

THESE DOCUMENTS HAVE BEEN PREPARED FROM  
INFORMATION RECEIVED FROM THE CONTRACTOR.

The use of these plans and specifications shall be restricted to the original site for which they were prepared and publication thereof is expressly limited to such use. Re-use, reproduction, or publication by any method, in whole or in part, is prohibited. Title to the plans and specifications remain in the architect without prejudice. It is to be returned upon completion of the project. Visual contact with those plans and specifications shall constitute prima facie evidence of the acceptance of these restrictions.

drawn checked

## BUILDING A MILLWORK DETAILS & ELEVATIONS

sheet


## A1.6

of total


project no. 1001

date 12-20-2010

date 12-20-2010

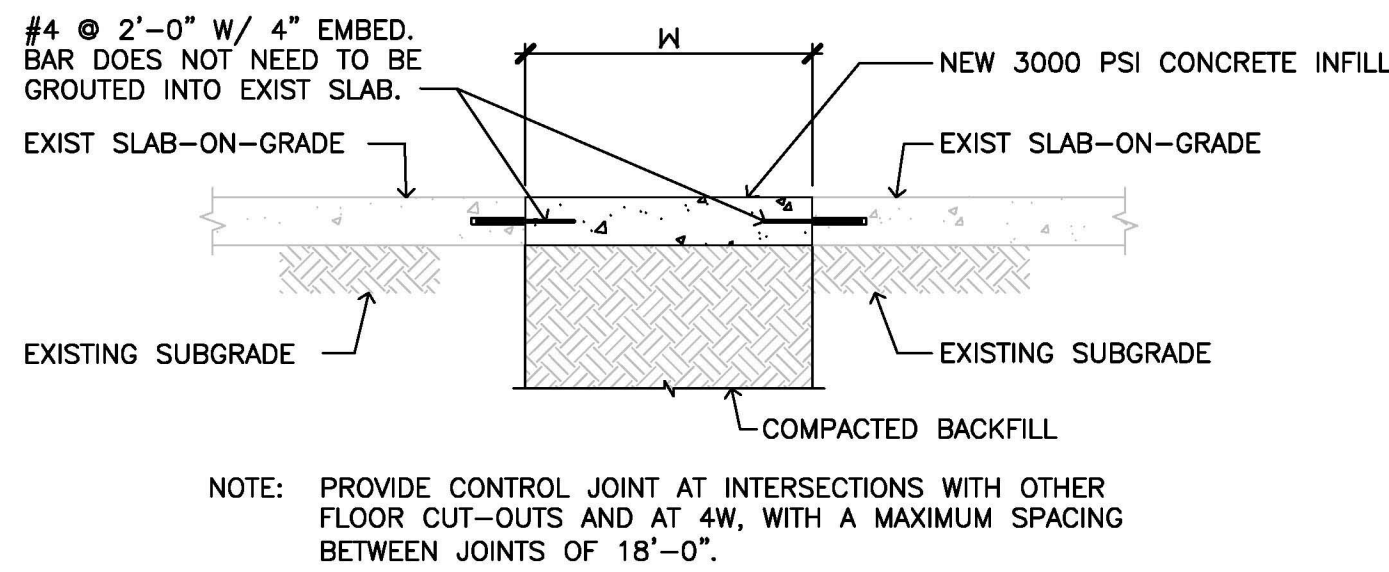

2 Slab-on-Grade @ Utilities  
A2.0 Scale: 3/4" = 1'-0"

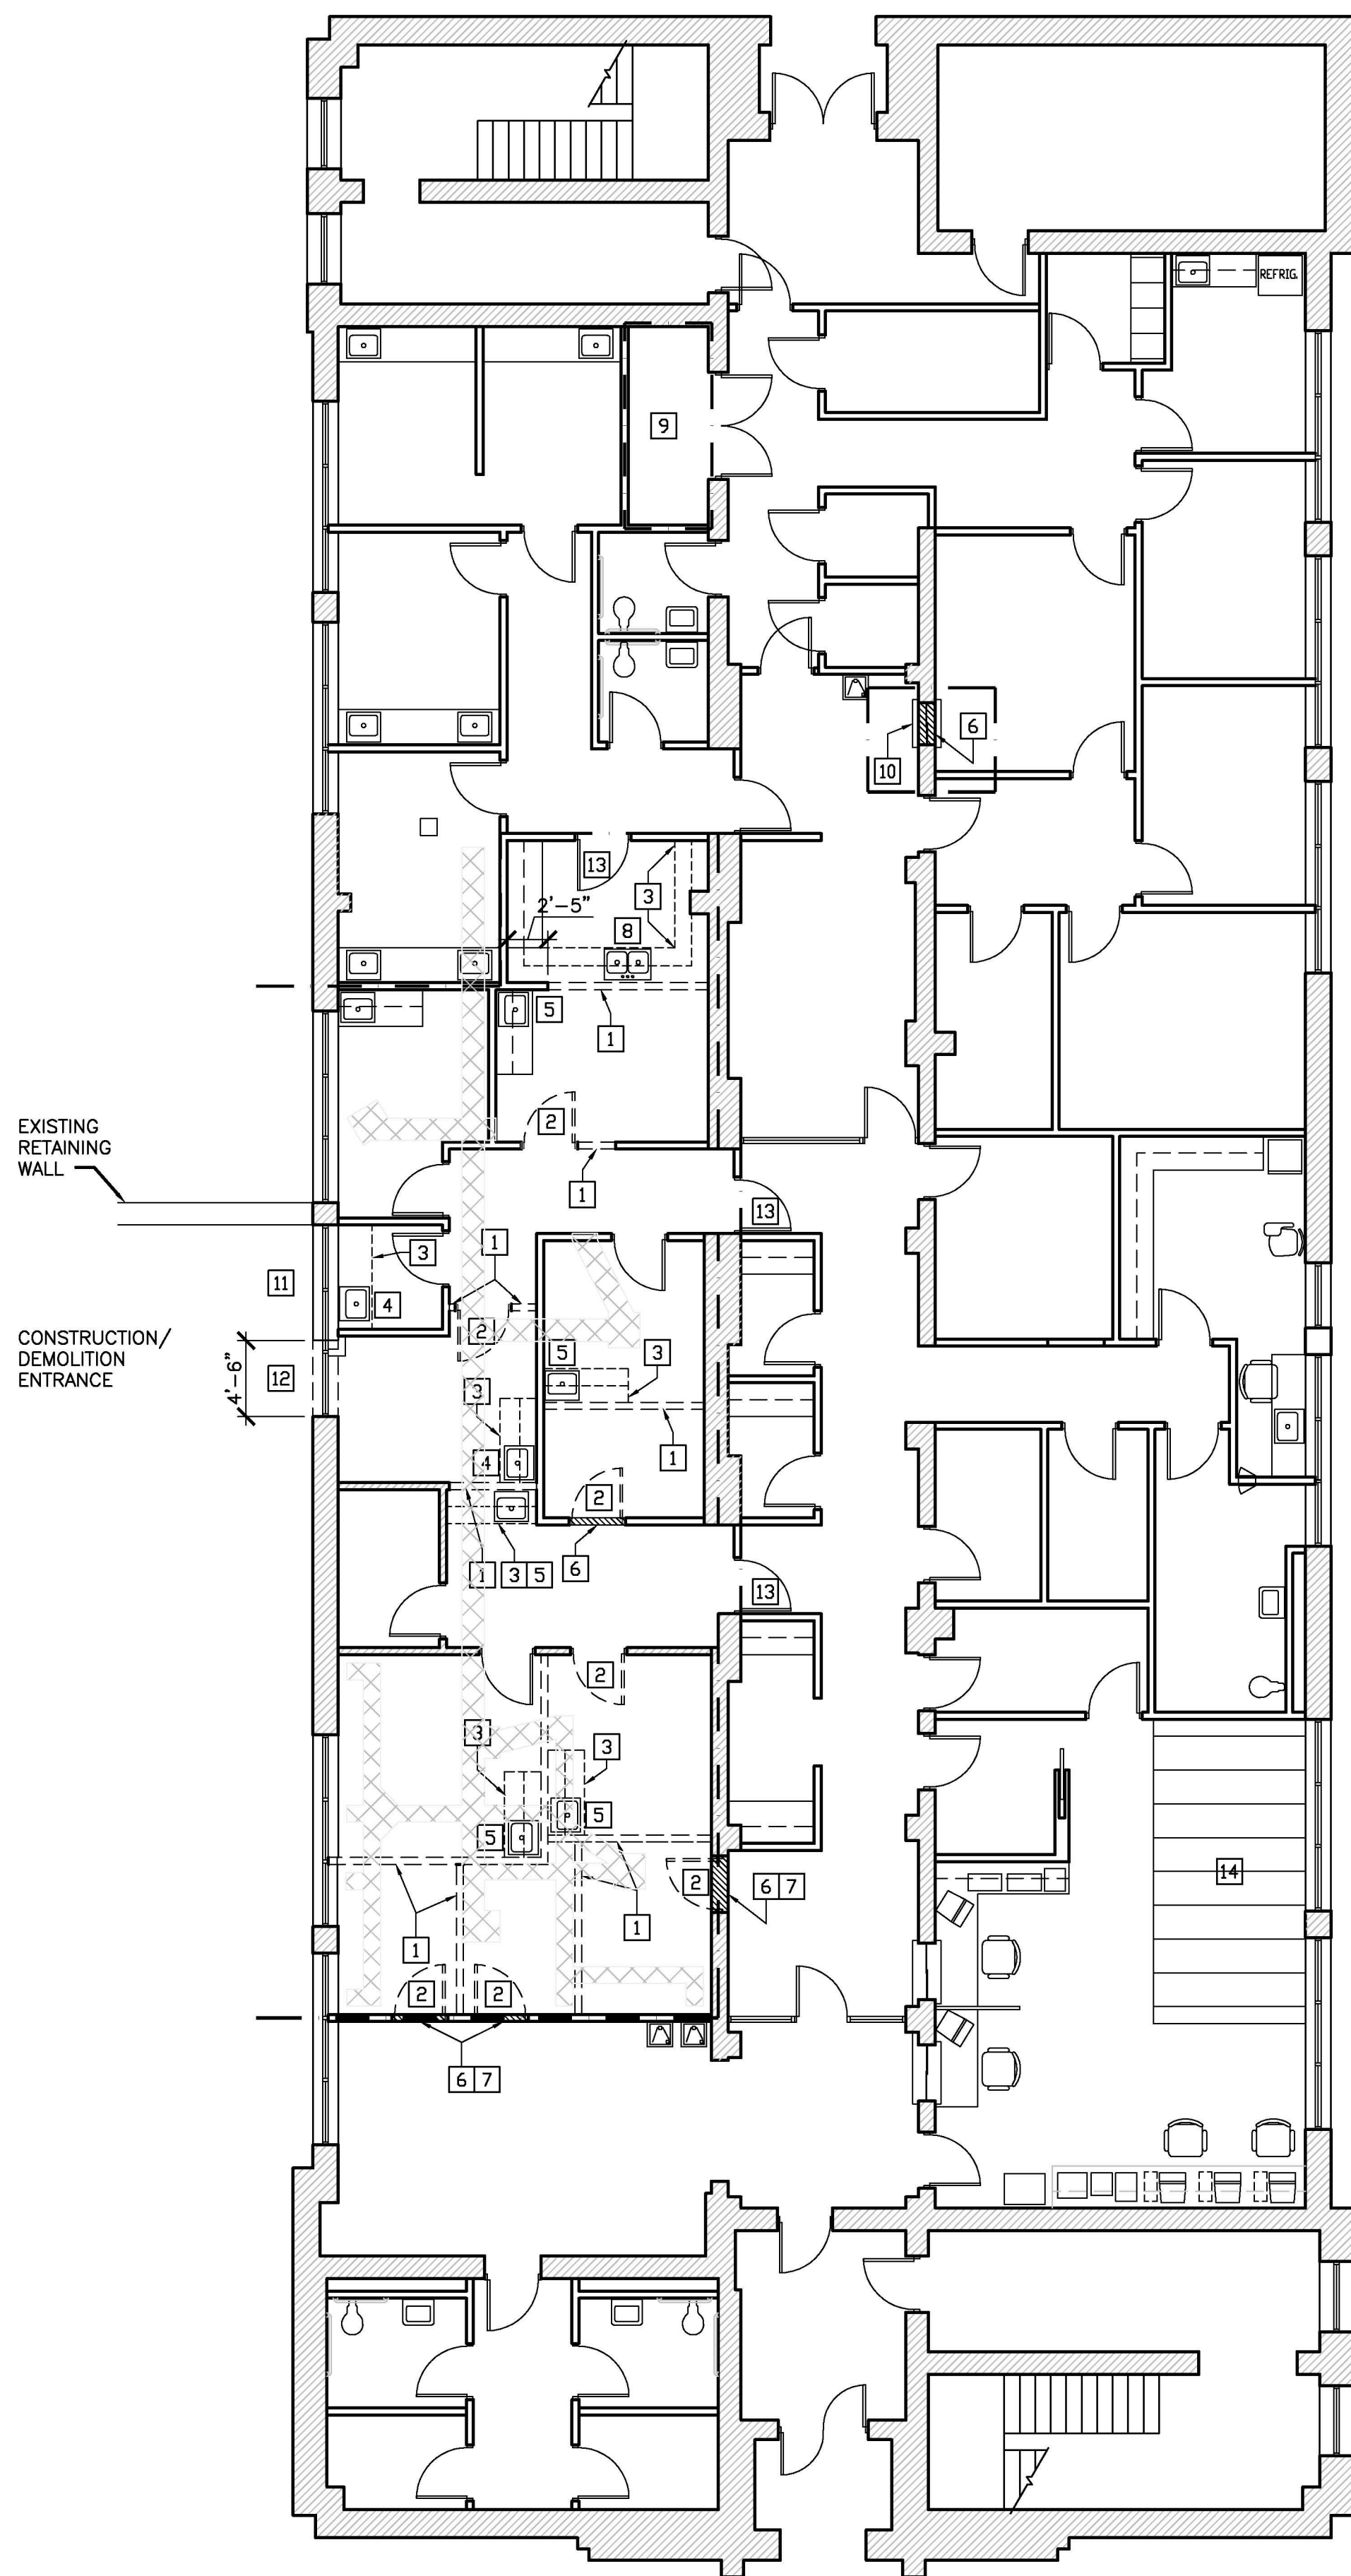


1 Basement Level - Demolition Plan  
A2.0 Scale: 1/8" = 1'-0" BUILDING B

- GENERAL NOTES:
- ACCESS TO WORK AREA SHALL BE VIA TEMPORARY OPENING IN WEST WALL OF BUILDING AT LOCATON INDITIATED ON PLAN. REMOVE WINDOW & STIRE FOR REINSTALLATION AT COMPLETION OF WORK. SAW CUT CONCRETE SILL & MASONRY WALL BELOW WINDOW. SALVAGE UNBROKEN BRICK FOR REINSTALLATION.
  - ACCESS TO STAGING AREA FOR DELIVERIES SHALL BE VIA SIDEWALK FROM WEST TRYON STREET. COORDINATE TIMING OF DELIVERIES SO AS NOT TO IMPEDE TRAFFIC TO ELEVATOR TOWER.
  - PROVIDE TEMPORARY FLOOR COVERING TO PROTECT EXISTING FINISHES IN AREAS WHERE EXISTING FINISHES ARE INDICATED TO REMAIN.

- DEMOLITION NOTES:
- REMOVE EXISTING GYPSUM BOARD & METAL STUD PARTITION; PATCH FLOOR, CEILING & ABUTTING WALLS TO MATCH EXISTING FINISHES IN ADJACENT SPACES. REMOVE ALL ELECTRICAL, TELEPHONE, DATA, PLUMBING, ETC. IN WALL TO BE DEMOLISHED.
  - REMOVE EXISTING DOOR, FRAME & HARDWARE.
  - REMOVE EXISTING MILLWORK.
  - REMOVE EXISTING PLUMBING FIXTURE; CAP SUPPLY & WASTE; PATCH WALL TO MATCH ADJACENT FINISH.
  - REMOVE EXISTING PLUMBING FIXTURE; CAP SUPPLY & WASTE.
  - FILL EXISTING OPENING WITH CONSTRUCTION IDENTICAL TO THAT OF PARTITION IN WHICH IT OCCURS & FINISH TO MATCH FINISHES IN ADJACENT SPACES.
  - PROVIDE TEMPORARY CLOSURE W/ PLYWOOD OR GYPSUM PANEL IF INFILL CANNOT BE COMPLETED IMMEDIATELY AFTER REMOVAL OF DOOR & FRAME.
  - REMOVE EXISTING PLUMBING FIXTURES, CLEAN & PREPARE FOR RELOCATION WITHIN RENOVATED SPACE.
  - REMOVE EXISTING AIR COMPRESSOR & VACUUM; LEAVE ASSOCIATED PLUMBING & ELECTRICAL IN PLACE.
  - REMOVE EXISTING PASS WINDOW & COUNTER.
  - REMOVE WINDOW, CLEAN & PREPARE FOR REINSTALLATION AT COMPLETION OF RENOVATION
  - SAWCUT BRICK WALL & CONCRETE SILL BELOW WINDOW FOR TEMPORARY ACCESS; REINSTALL BRICK OR REPLACE WITH MATCHING BRICK & REPLACE CONCRETE SILL UPON COMPLETION OF RENOVATION
  - LOCK DOORS FOR DURATION OF PROJECT
  - DISASSEMBLE MOBILE FILES & REINSTALL IN ROOM A101 AT COMPLETION OF PHASE 1 & BEFORE START OF PHASE 2. COORDINATE TIMING OF RELOCATION WITH OWNER SO AS NOT TO DISRUPT OWNER OPERATIONS.

- SYMBOL LEGEND:
- EXISTING MASONRY WALL TO REMAIN
  - EXISTING STUD WALL TO REMAIN
  - EXISTING WALL TO BE REMOVED
  - EXISTING DOOR & FRAME TO REMAIN
  - EXISTING DOOR & FRAME TO BE REMOVED
  - EXISTING OPENING TO BE INFILLED
  - EXISTING MILLWORK TO REMAIN
  - EXISTING MILLWORK TO BE REMOVED
  - CUT & PATCH CONCRETE SLAB FOR UNDERSLAB UTILITIES. SEE DETAIL THIS SHEET.
  - LIMITS OF WORK AREA: DEMOLITION/CONSTRUCTION ACTIVITY OUTSIDE OF THESE LIMITS PERMITTED ONLY TO ACCESS PLUMBING SHUT-OFF VALVES OR ELECTRICAL PANELS AS REQUIRED TO SHUT DOWN SERVICES WITHIN WORK AREA

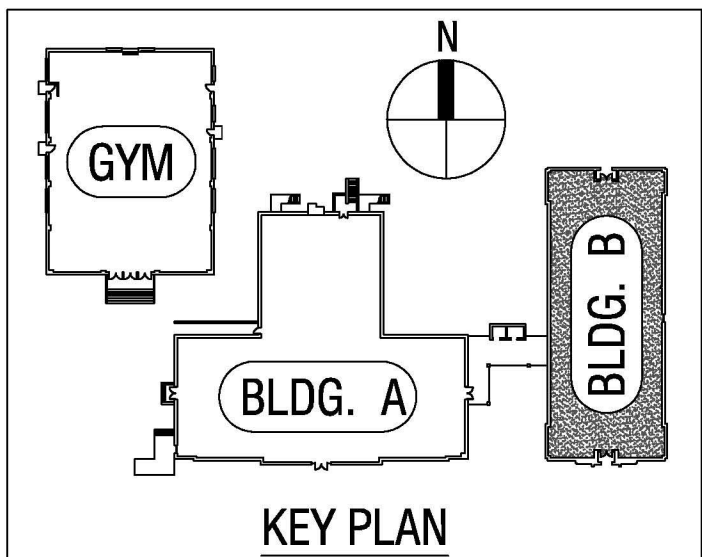

Orange County  
Health Department  
Renovations  
Hillsborough, North Carolina



no. revisions

RECORD  
DOCUMENT  
1-31-12

THESE DOCUMENTS HAVE BEEN PREPARED FROM  
INFORMATION RECEIVED FROM THE CONTRACTOR.

The use of these plans and specifications shall be restricted to the original site for which they were prepared and publication thereof is expressly limited to such use. Re-use, reproduction, or publication by any method, in whole or in part, is prohibited. Title to the plans and specifications remain in the architect without prejudice. It is to be returned upon request to the architect. Visual contact with these plans and specifications shall constitute prima facie evidence of the acceptance of these restrictions.

drawn checked

BUILDING B  
BASEMENT LEVEL  
DEMOLITION PLAN

sheet

A2.0

of total

project no. 1001

date 12-20-2010



CORLEY REDFOOT ZACK  
INC.  
ARCHITECTS • ENGINEERS • PLANNERS  
PO Box 2368, Chapel Hill, North Carolina 919 401-8586